


MISSOURI HIGHWAY AND TRANSPORTATION COMMISSION

STATE	PROJ NO	SHEET NO
MO		50
SEC/SUR 22	TWP 48	RGE 33

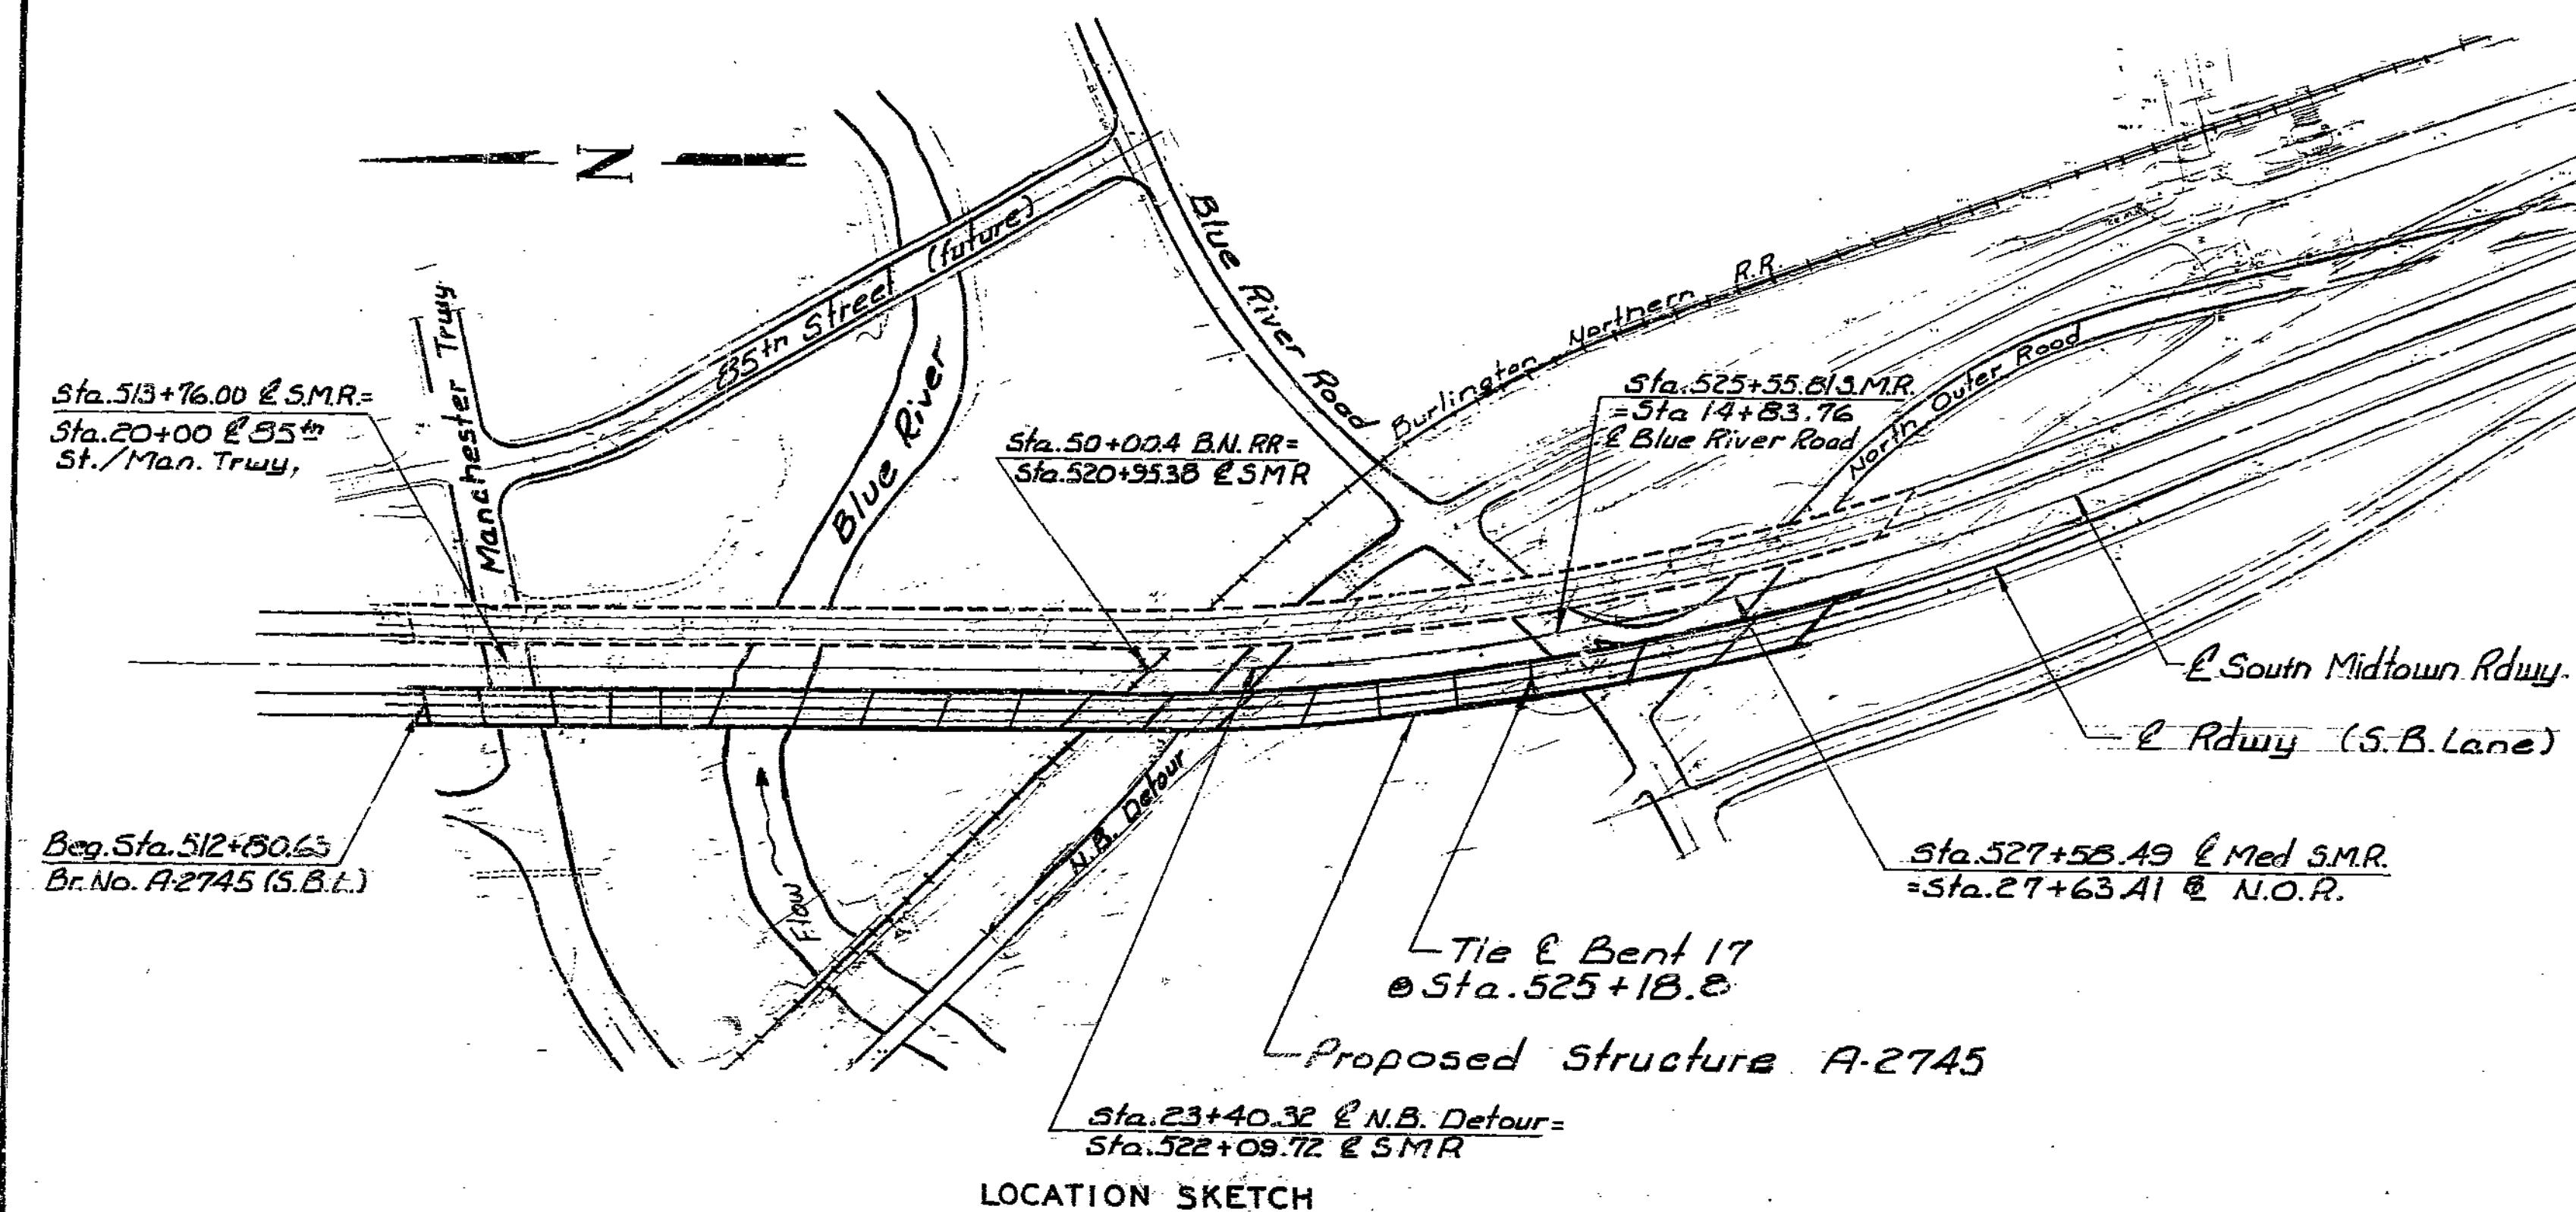

**BRIDGE NO. A-2745**  
**OVER**  
 MANCHESTER TRAFFICWAY, BLUE RIVER,  
 BURLINGTON NORTHERN RR,  
 N.B. DETOUR, BLUE RIVER ROAD  
 & NORTH OUTER ROAD

SUBSTRUCTURE CONTRACT

LOCATION SKETCH

- 1. INDEX OF DRAWINGS
- 2. PART PLAN & ELEVATION
- 3. PART PLAN & ELEVATION
- 4. PART PLAN & ELEVATION
- 5. PART PLAN & ELEVATION
- 6. PART PLAN & ELEVATION
- 7. PART PLAN & ELEVATION
- 8. PART PLAN & ELEVATION
- 9. GENERAL NOTES, QUANTITIES & PILE DATA
- 10. BORINGS
- 11. BORINGS
- 12. SUBSTRUCTURE LAYOUT
- 13. SUBSTRUCTURE LAYOUT
- 14. END BENT NO. 1
- 15. END BENT NO. 1
- 16. DEADMAN ANCHORAGE SYSTEM AT BT. 1
- 17. INT. BENT NO. 2 & NO. 3
- 18. INT. BENT NO. 2 & NO. 3
- 19. INT. BENT NO. 4
- 20. INT. BENT NO. 4
- 21. INT. BENT NO. 3

INDEX OF DRAWINGS

- 22. INT. BENT NO. 5
- 23. INT. BENT NO. 6 & NO. 7
- 24. INT. BENT NO. 6 & NO. 7
- 25. INT. BENT NO. 6 & NO. 7
- 26. INT. BENT NO. 8
- 27. INT. BENT NO. 9
- 28. INT. BENT NO. 9
- 29. INT. BENT NO. 10
- 30. INT. BENT NO. 11
- 31. INT. BENT NO. 11
- 32. INT. BENT NO. 12
- 33. INT. BENT NO. 12
- 34. INT. BENT NO. 13
- 35. INT. BENT NO. 13
- 36. INT. BENT NO. 14
- 37. INT. BENT NO. 14
- 38. INT. BENT NO. 15
- 39. INT. BENT NO. 15
- 40. INT. BENT NO. 16
- 41. INT. BENT NO. 16
- 42. INT. BENT NO. 17
- 43. INT. BENT NO. 17
- 44. INT. BENT NO. 18
- 45. INT. BENT NO. 18
- 46. INT. BENT NO. 19
- 47. END BENT NO. 20
- 48. END BENT NO. 20
- 49. DEADMAN ANCHORAGE SYSTEM AT BT. 20
- 50. EARTHQUAKE RESTRAINTS AT BT. 20
- 51. BAR LIST
- 52. BAR LIST
- 53. BAR LIST
- 54. BAR LIST
- 55. BAR LIST

Note: For Hydrologic Data Table see sheet No. 9.  
 For Curve Data see sheet No. 13.

B.M. TBM-1 Elevation 780.85 S.W. cor.  
 signal base at S.W. cor. 87th St. and  
 Hickman Mills Dr.

STATE ROAD: "SOUTH MIDTOWN ROADWAY"  
 IN KANSAS CITY  
 PROJECT NO. DE-0081 (806) STA. 512+80.63  
 JOB NO. 4-U-71-2D RTE. 71 S.B.L.

JACKSON COUNTY

DATE 9/14/88

STD. 706.35
STD. 677.60
A-2745

DESIGNED Mar. 1988  
 DETAILED July 1988  
 CHECKED August 1988

Note: This drawing is not to scale. Follow dimensions.


Sheet No. 1 of 55

197 311

STATE	PROJ NO	SHEET NO.
MO		57

Note: Refer to the plan view for the roadway section and to the elevation view for the form of the concrete slope protection. The slope of the structure shall be 3 to 1 before piles are driven. For any bents falling within the embankment section.

(64'-82'-65')(65'-65'-82'-82'-82')(82'-67'-90'-90')(79'-79'-85'-85') PRESTRESSED CONCRETE I-GIRDER SPANS  
(123'-123'-93') CONT. COMP. R. GIRDER SPANS

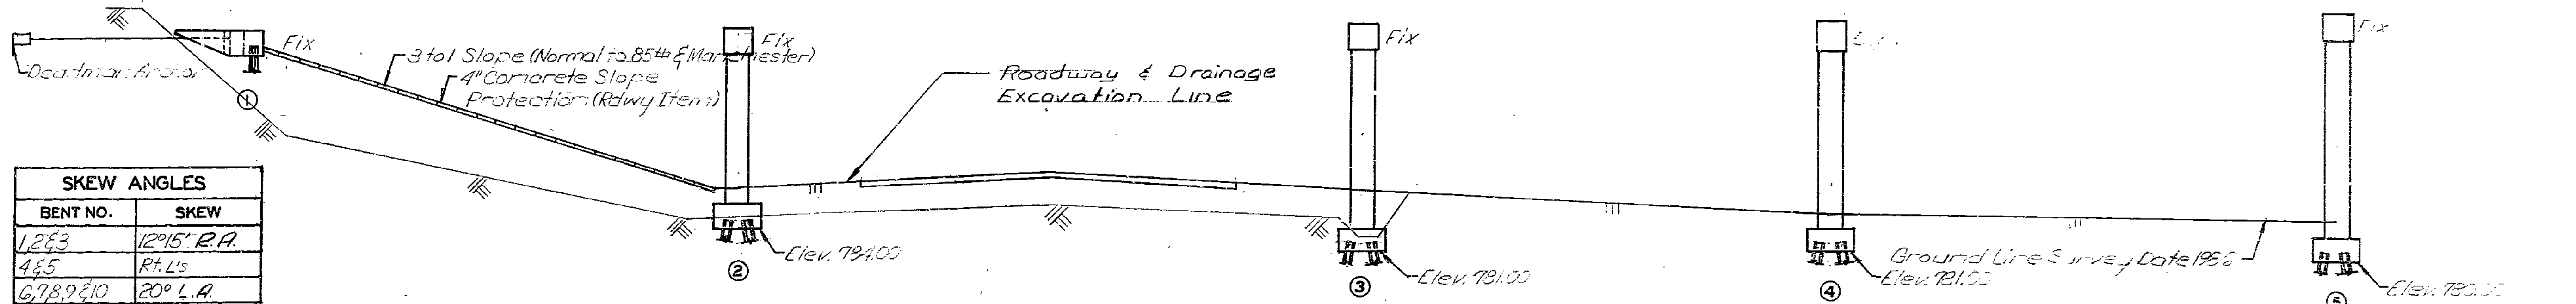


SKEW ANGLES	
BENT NO.	SKEW
1, 2 & 3	12°15' R.A.
4 & 5	Rt. L's
6, 7, 8, 9 & 10	20° L.A.
11	41°46'20" L.A.
12	42°47'38" L.A.
13	44°34'00" L.A.
14	26°18'44" L.A.
15, 16 & 17	Radial
18	35°09'11" L.A.
19	57°25'06" L.A.
20	59°17'55" L.A.

To Radial Line

Note: Skew angles are measured at  $\frac{1}{2}$  S.B.L.

788 310

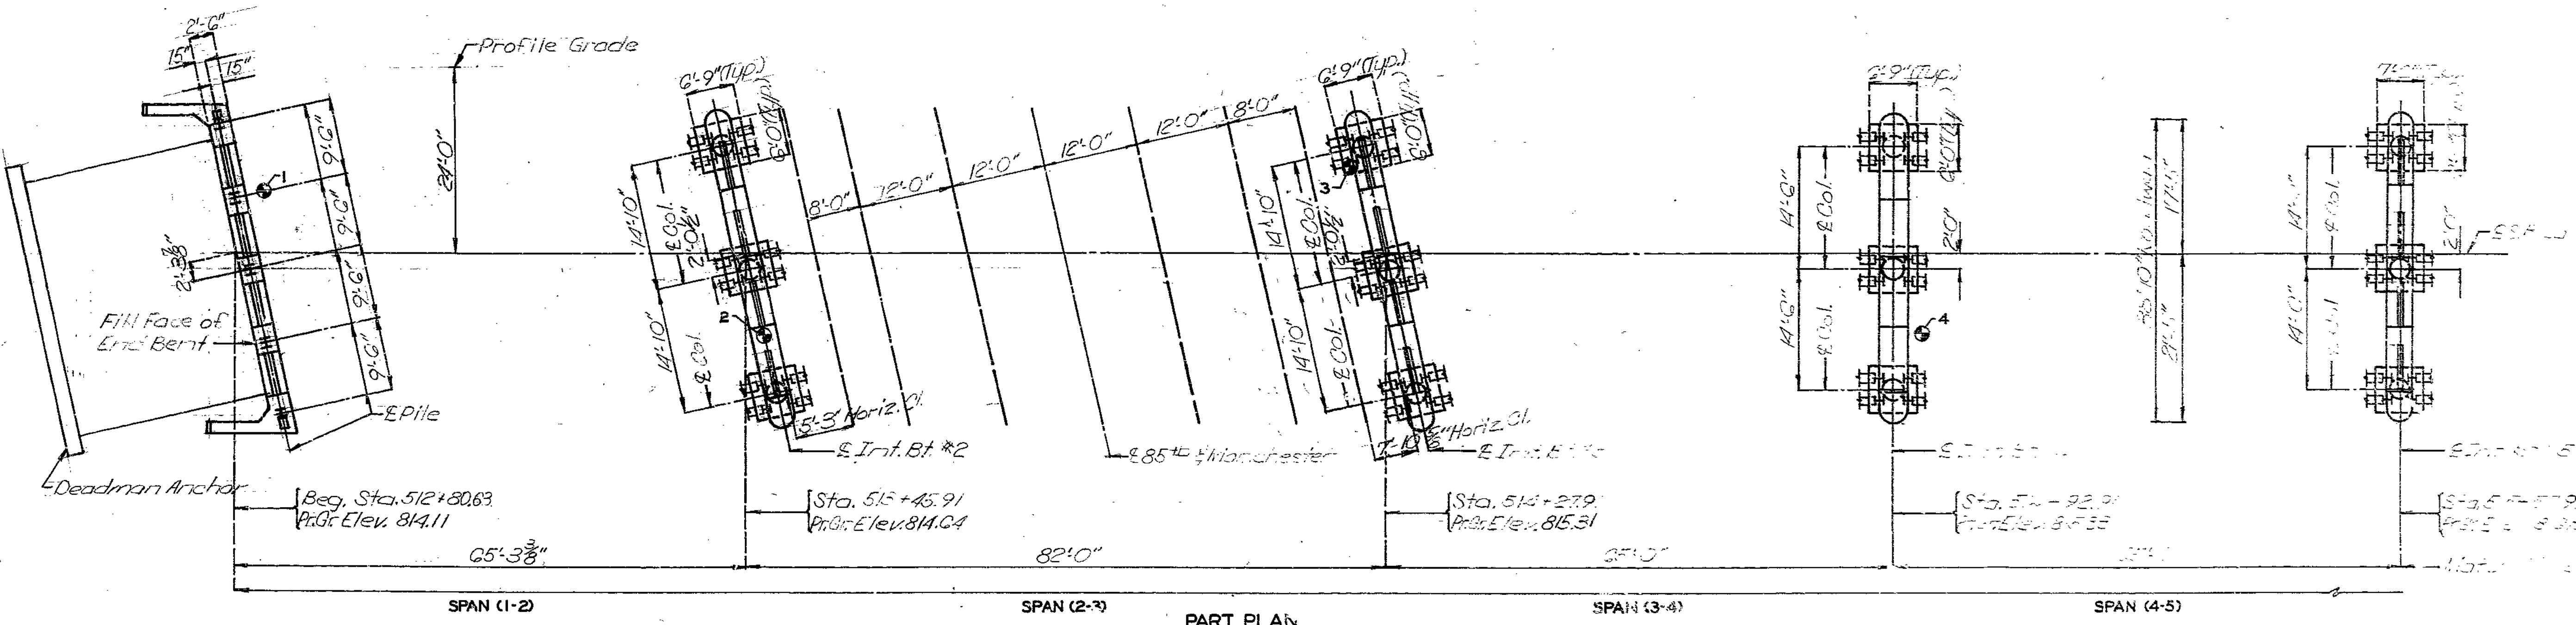

Note: For Boring Data see sheet No. 10 & 11.  
⊙ Indicates location of borings.

09111 DETAILED JULY 1988  
CHECKED Aug 19 88


Note: This drawing is not to scale. Follow dimensions.

Sheet No. 2 of 55


JACKSON COUNTY

A-2745

STATE	PROJ. NO.	SHEET NO.
MO.		53

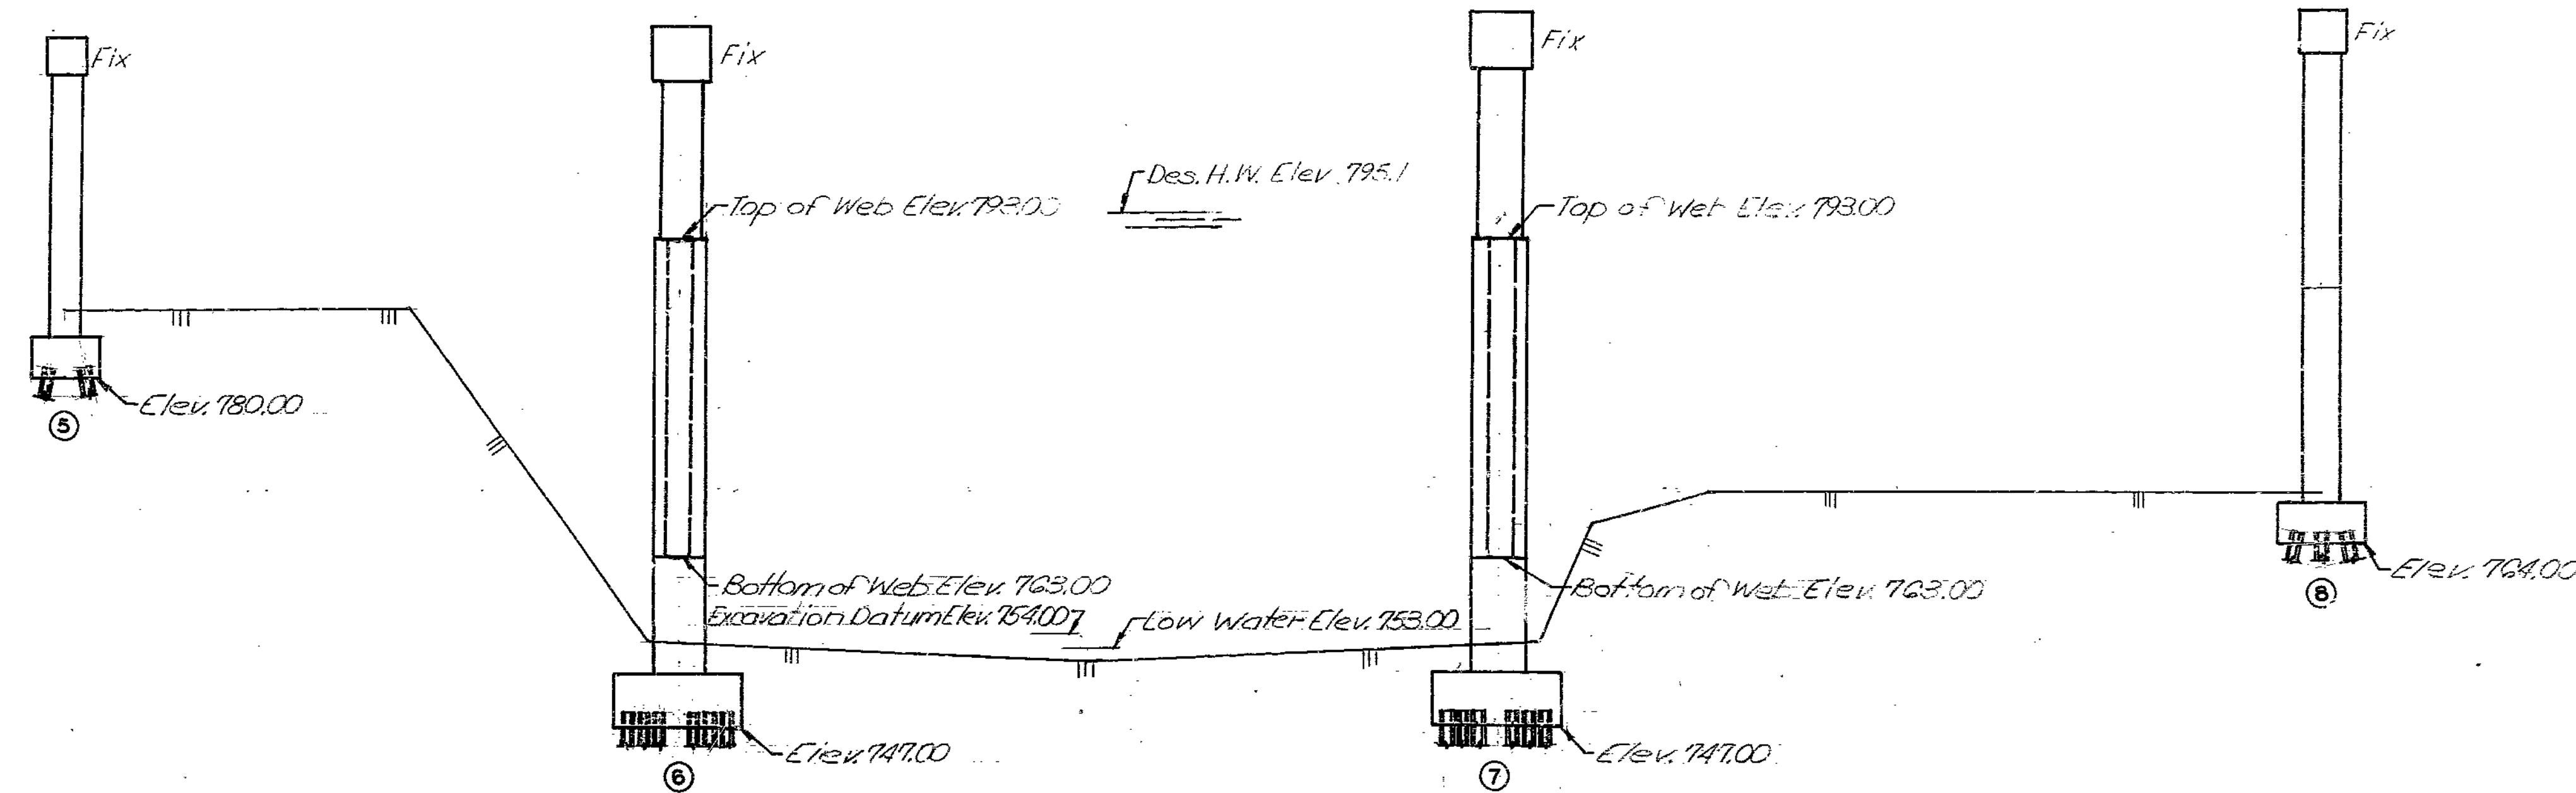

PART GENERAL ELEVATION

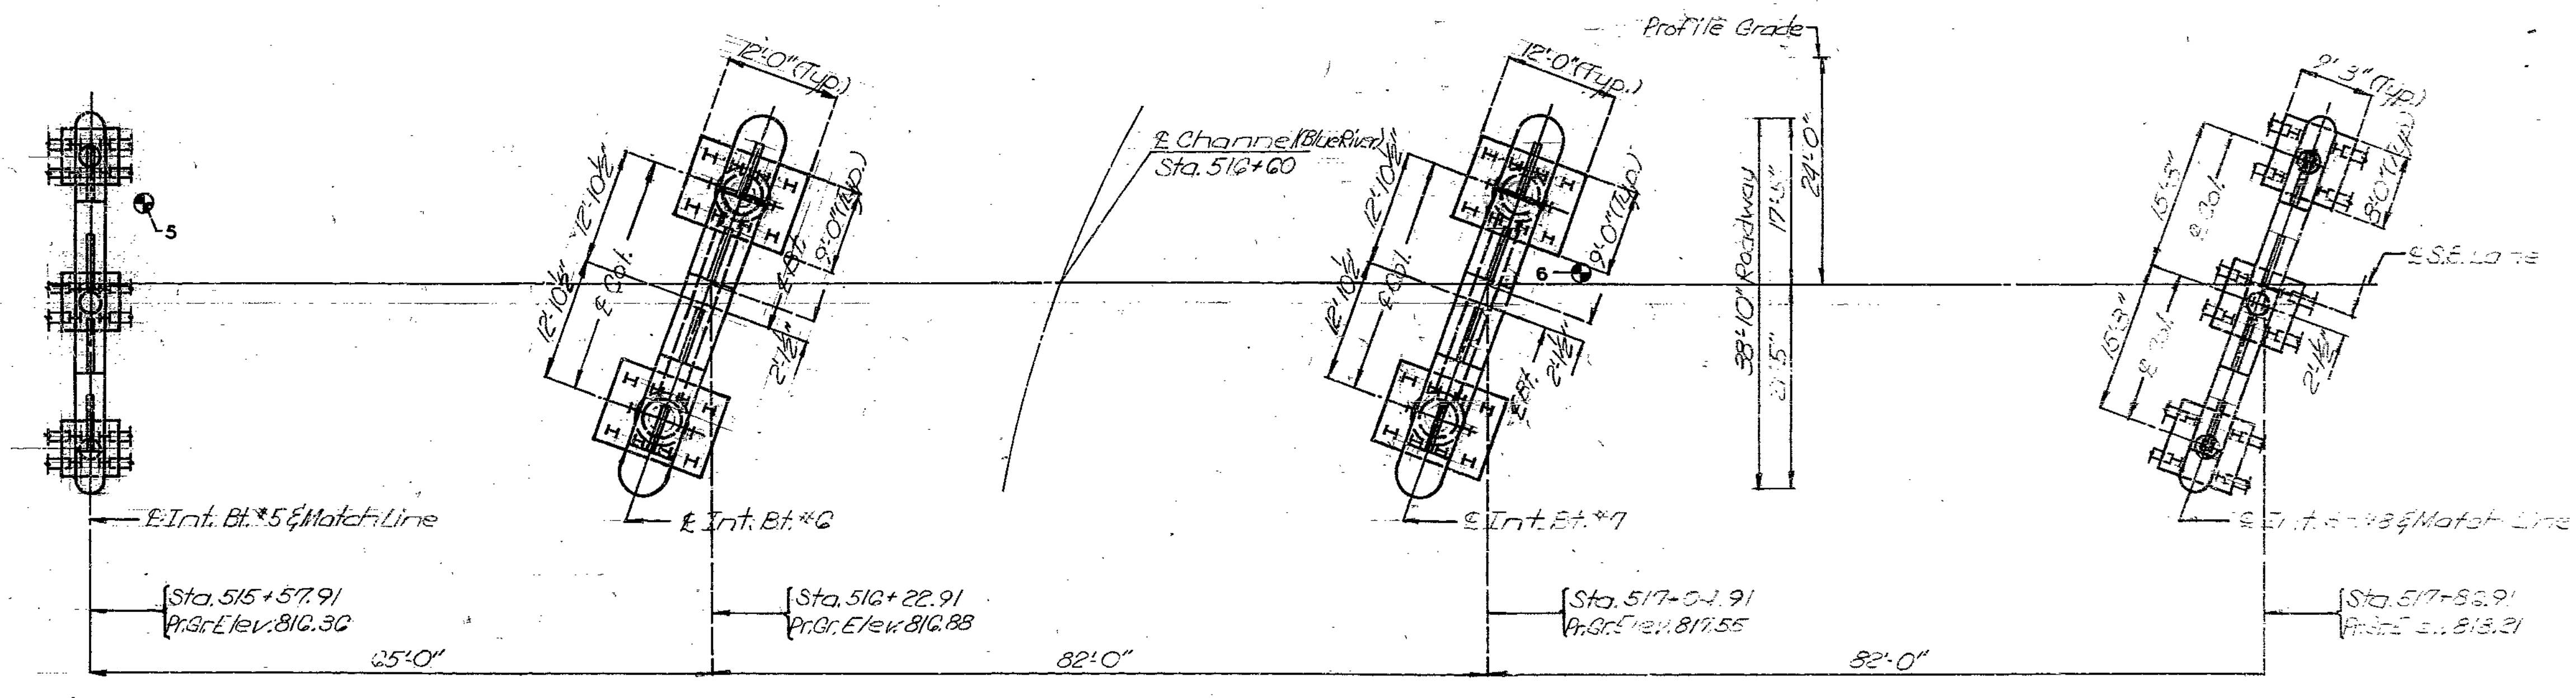

PART PLAN

Note: For Boring Data see sheet No. 10 & 11.  
 \* Indicates location of borings.

799 313

DATE: DETAILED JULY 1988  
 CHECKED Aug. 1988


Note: This drawing is not to scale. Follow dimensions.

Sheet No. 3 of 55


JACKSON COUNTY

A-2745

STATE	PROJ. NO.	SHEET NO.
MO.		59

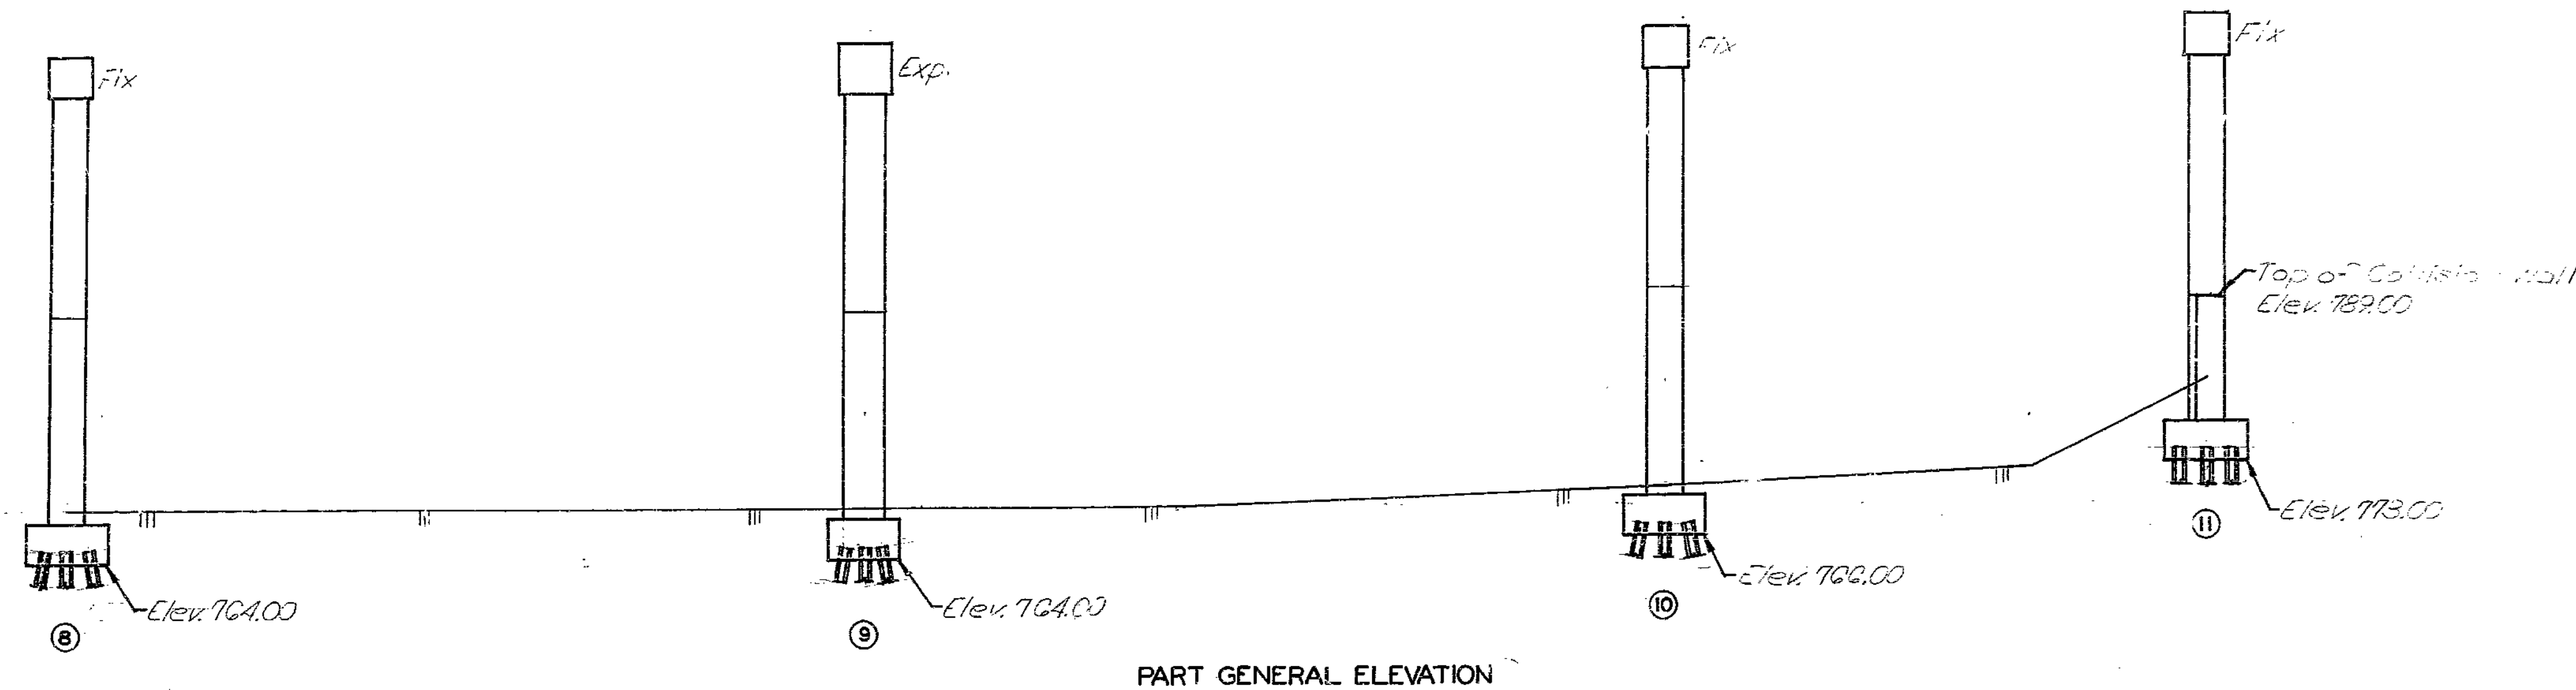

PART GENERAL ELEVATION

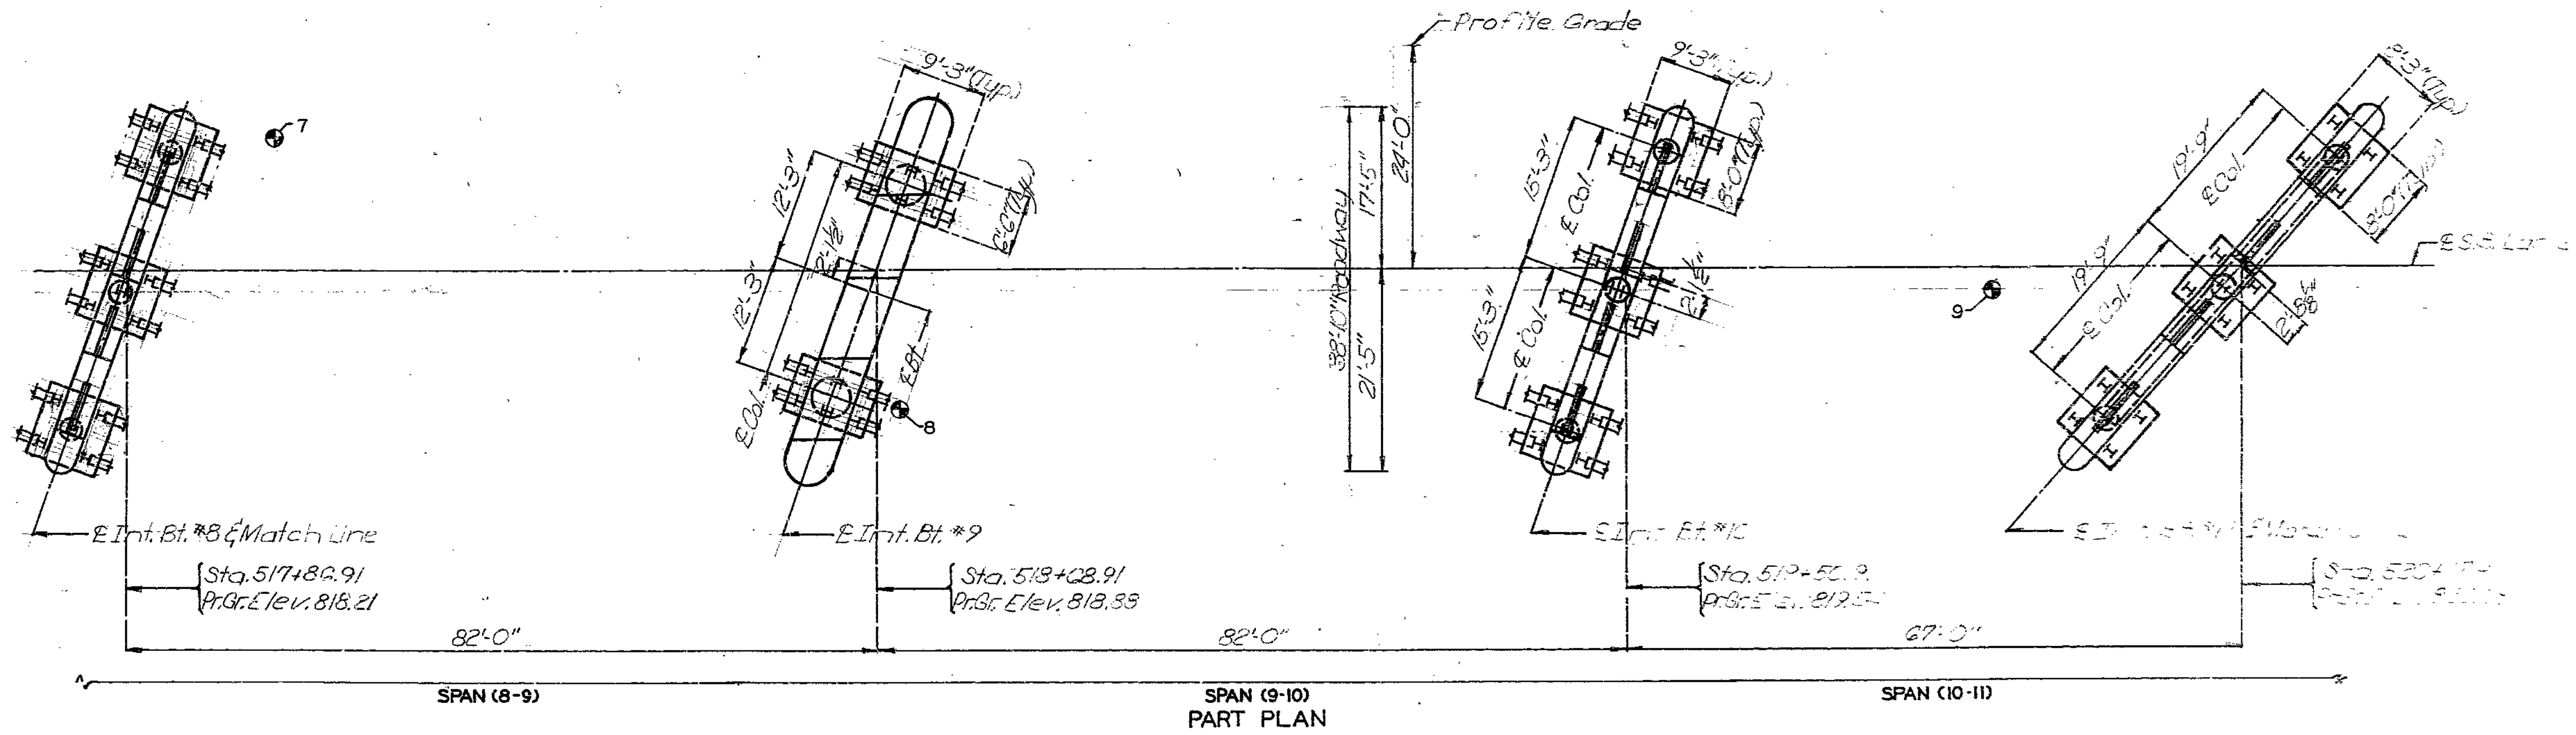

PART PLAN

Note: For Boring Data see sheet No. 10 & 11.  
 ⊕ Indicates location of borings.

200 314

DETAILED JULY 1988  
 CHECKED Aug. 1988



Note: This drawing is not to scale. Follow dimensions.

Sheet No. 4 of 35

JACKSON COUNTY

A-2745

STATE	PROJ. NO.	SHEET NO.
MO.		60

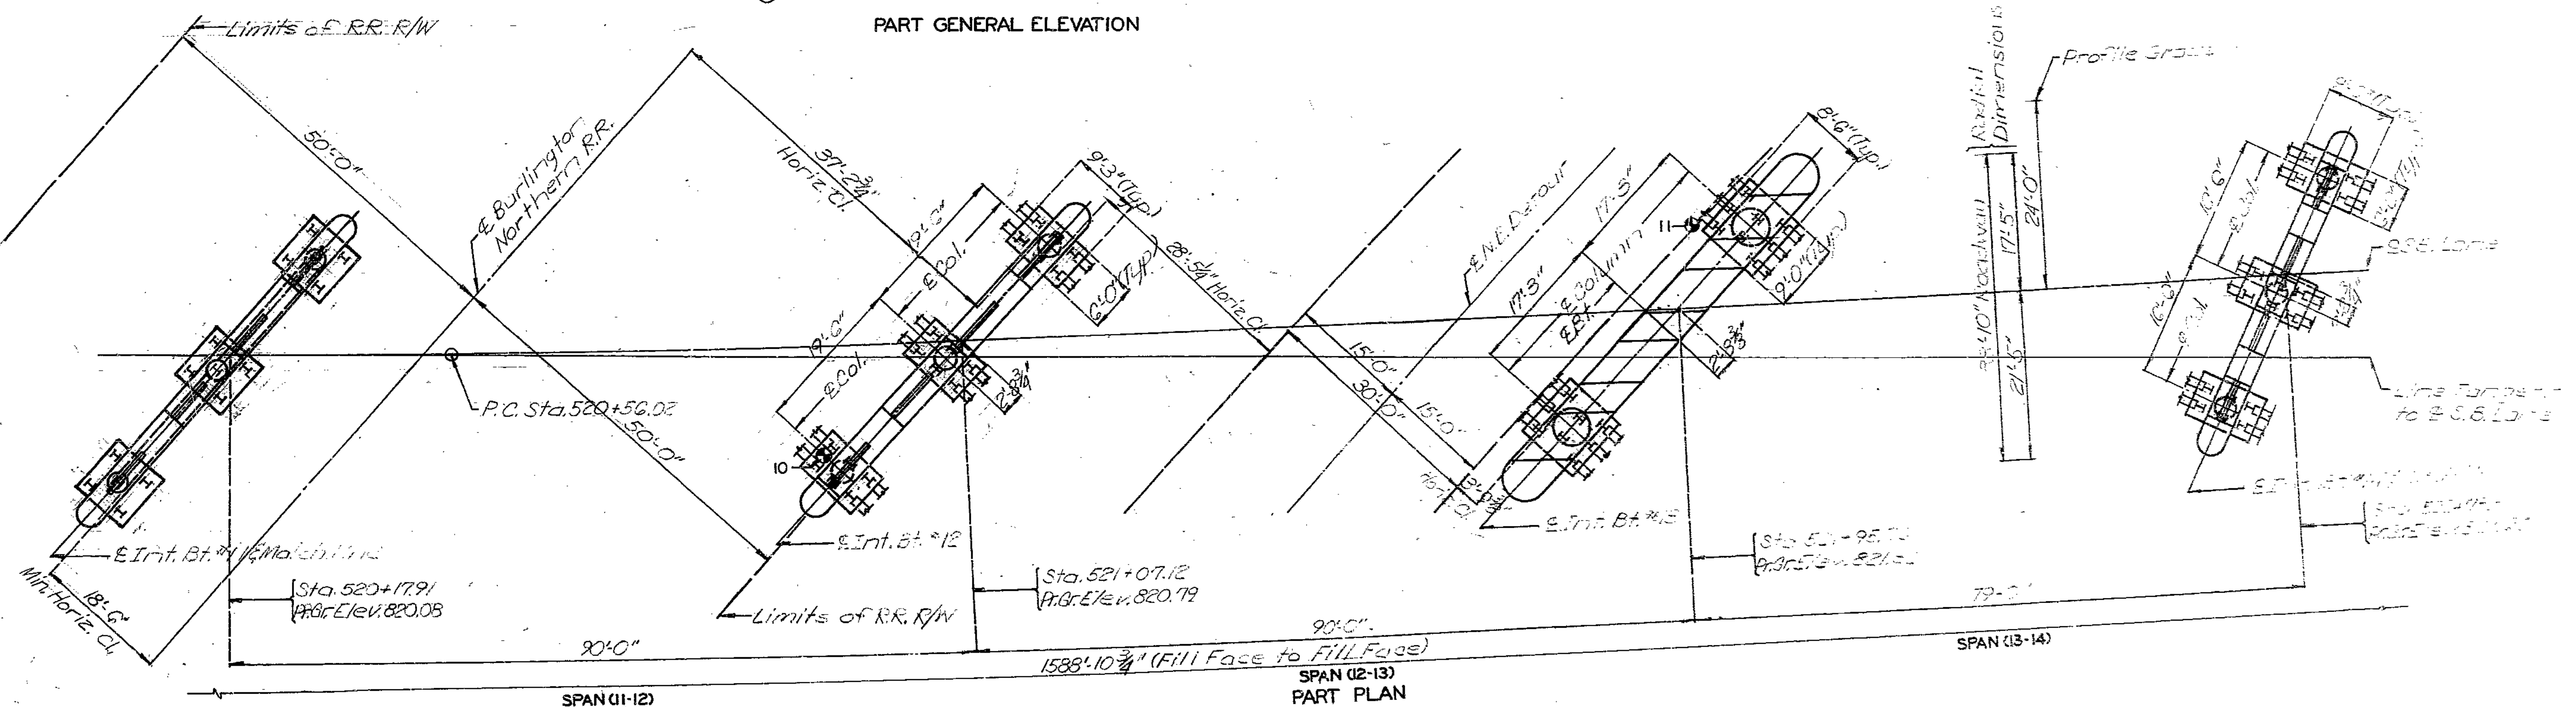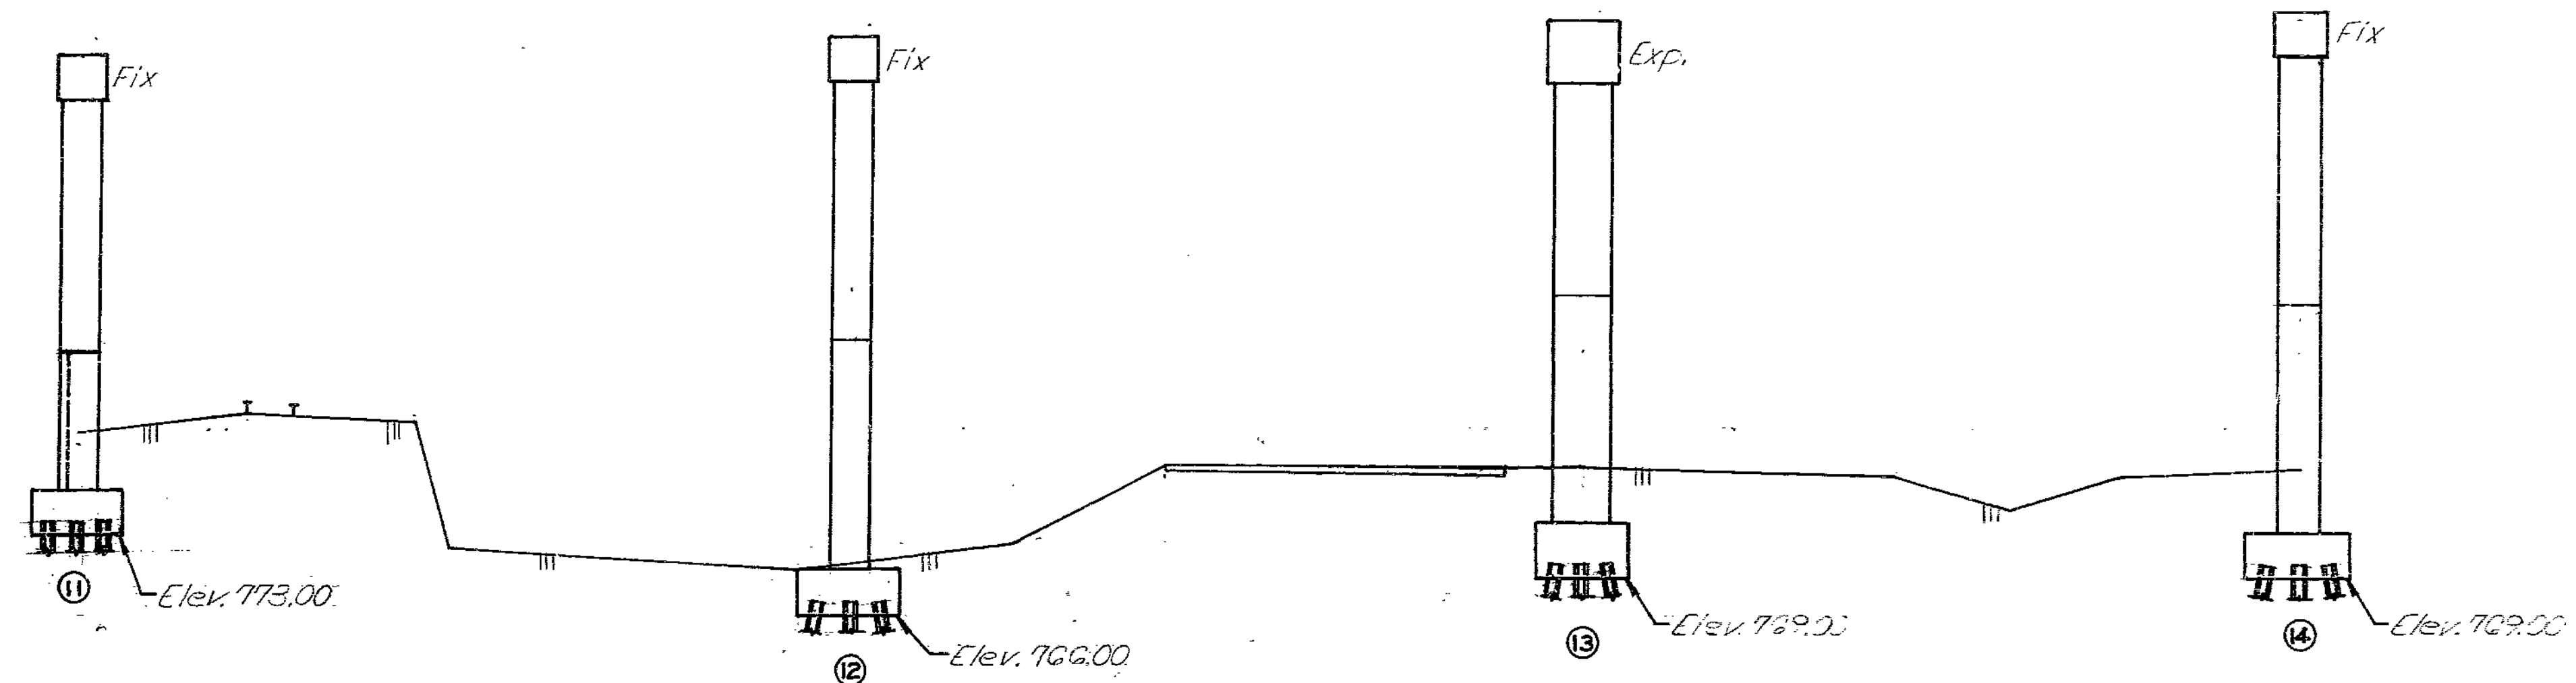

Note: For Boring Data see sheet No. 10 & 11  
 \* Indicates location of borings.

201 315

DATE  
 DETAILED JULY 1988  
 CHECKED Aug. 1988

Note: This drawing is not to scale. Follow dimensions.



SEC. THIRD POINT  
 Sheet No. 5 of 55

JACKSON COUNTY


A-2745



STATE	PROJ. NO.	SHEET NO.
MO		62

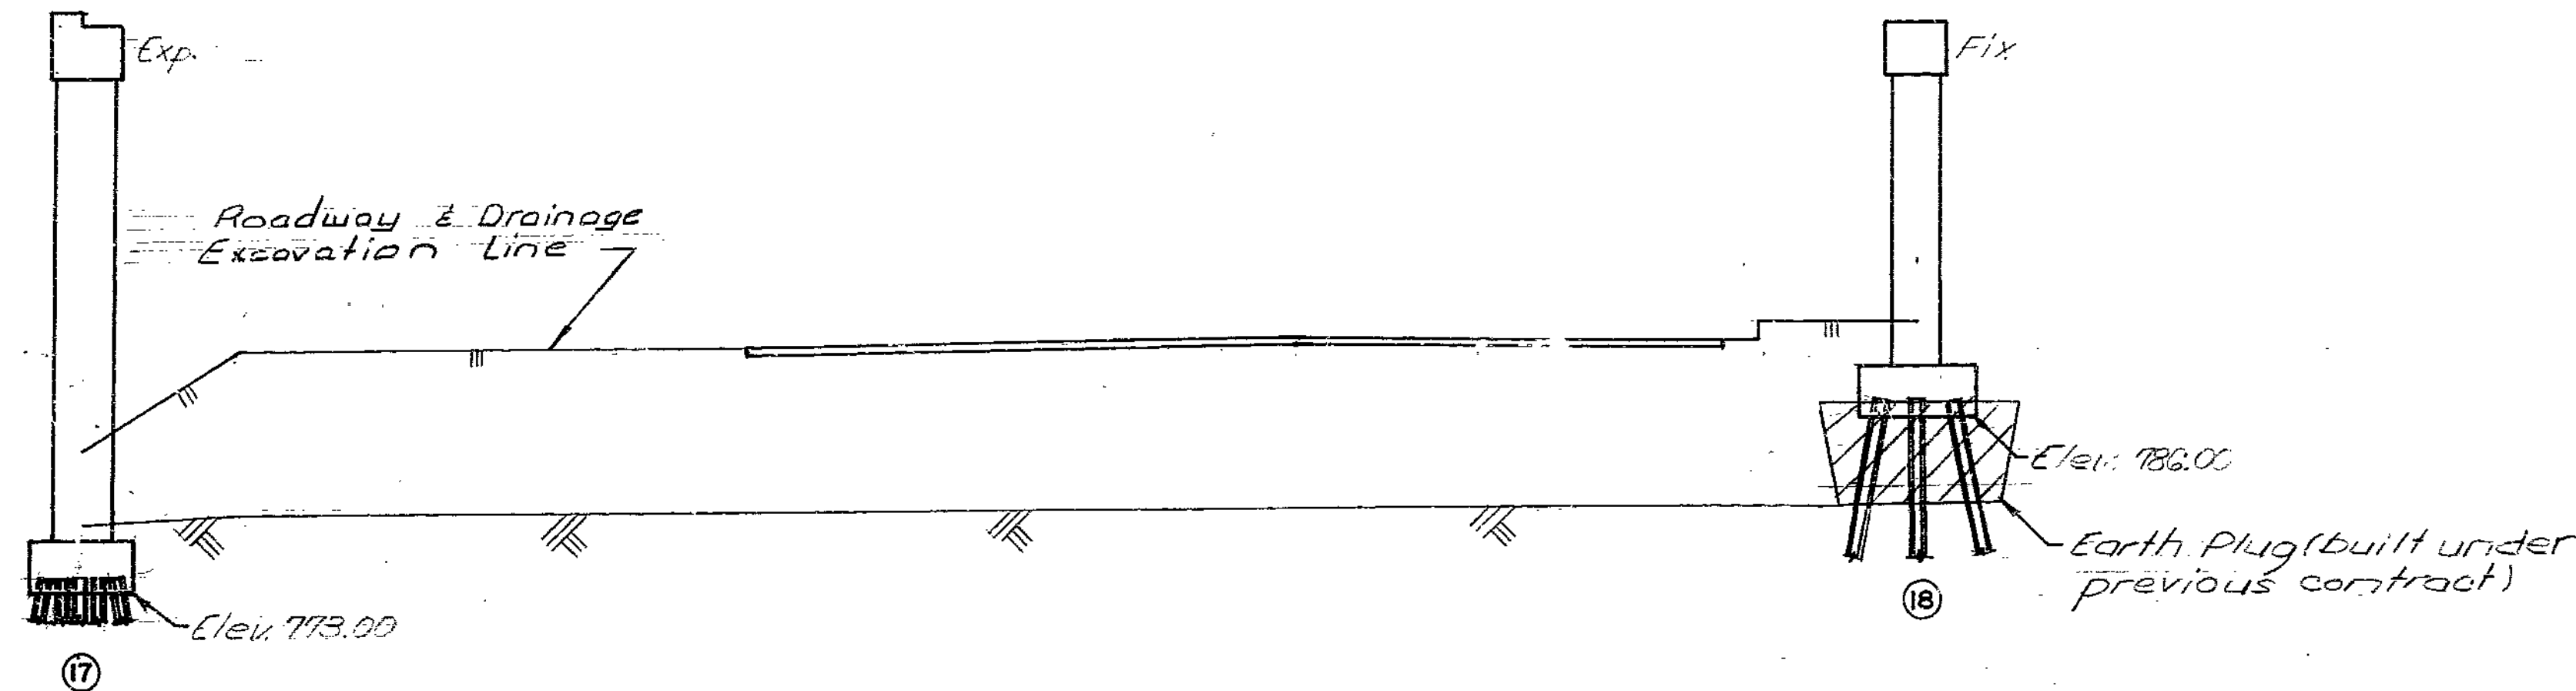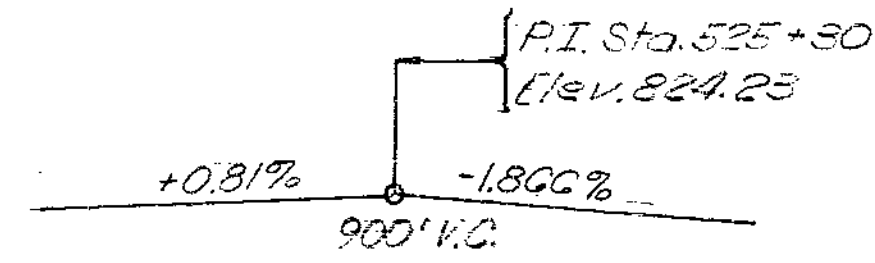

PART GENERAL ELEVATION

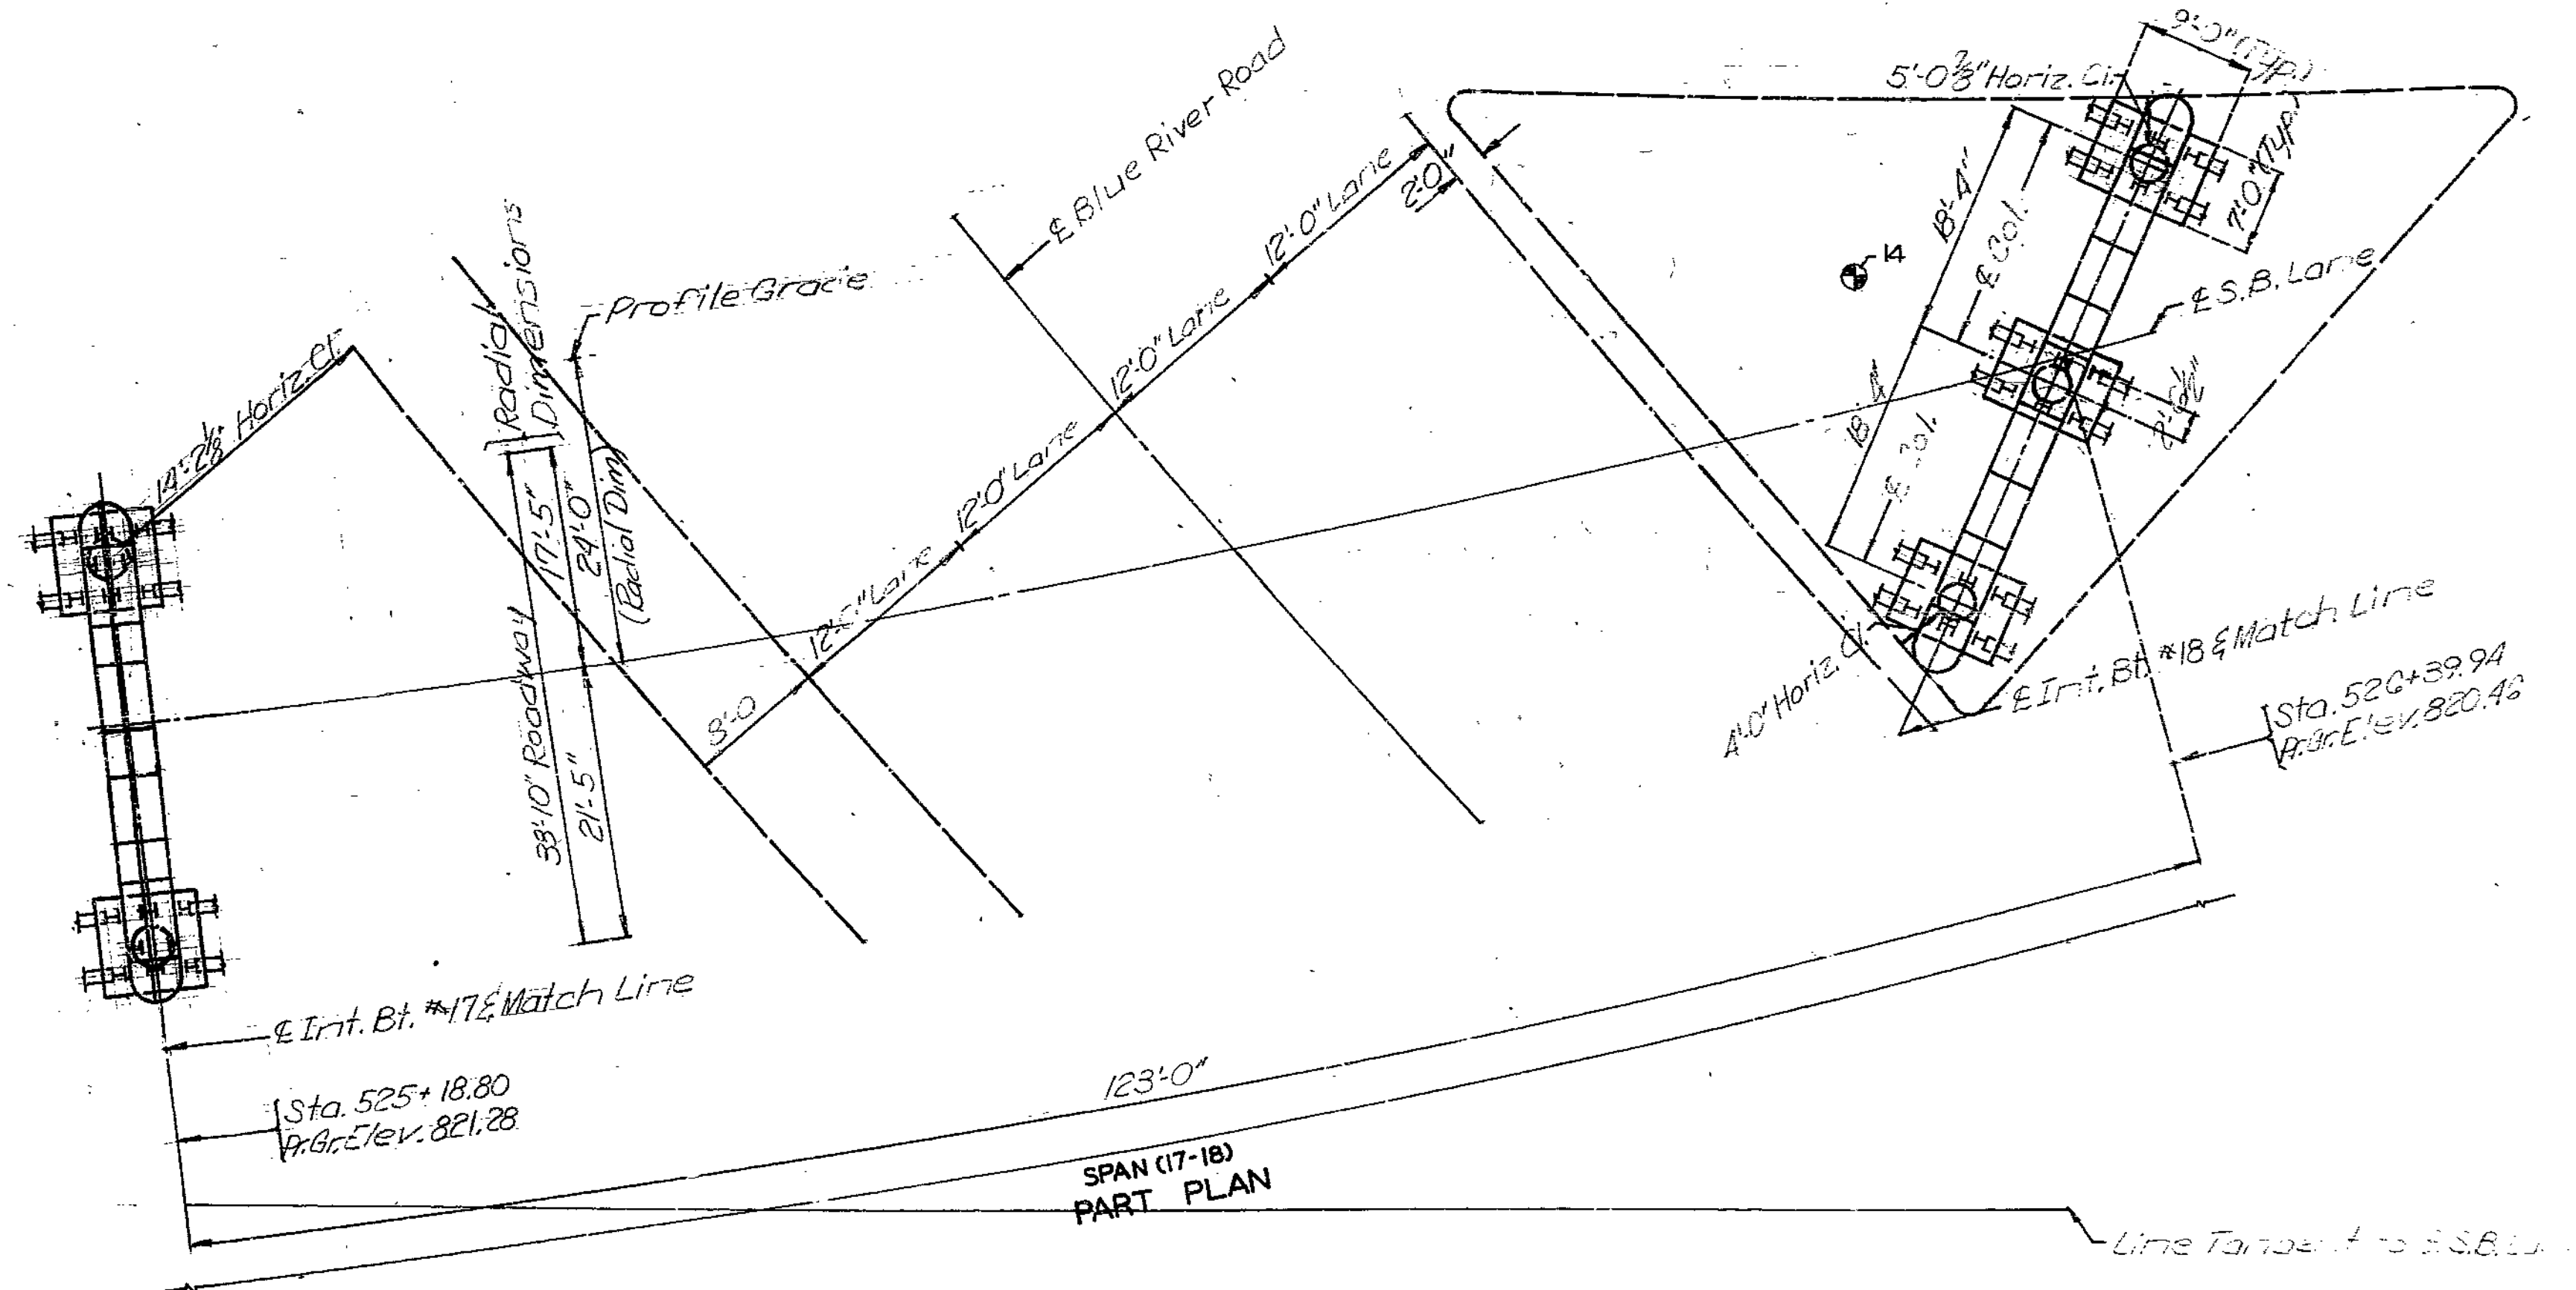

Note: For Boring Data see sheets No 10 & 11.  
Indicates location of borings.

203 317

000119 DETAILED JULY 1988  
CHECKED A.J.G. 1988

Note: This drawing is not to scale. Follow dimensions.


Sheet No. 7 of 55.

JACKSON COUNTY


A-2745

STATE	PROJ. NO.	SHEET NO.
MO.		63


Note: Roadway Fill shall be completed to the finish roadway elevation at all points within the limits of the structure and for a minimum 25' in base of the fill from the end bents before piles are driven for any bridge piers within the structure limits.

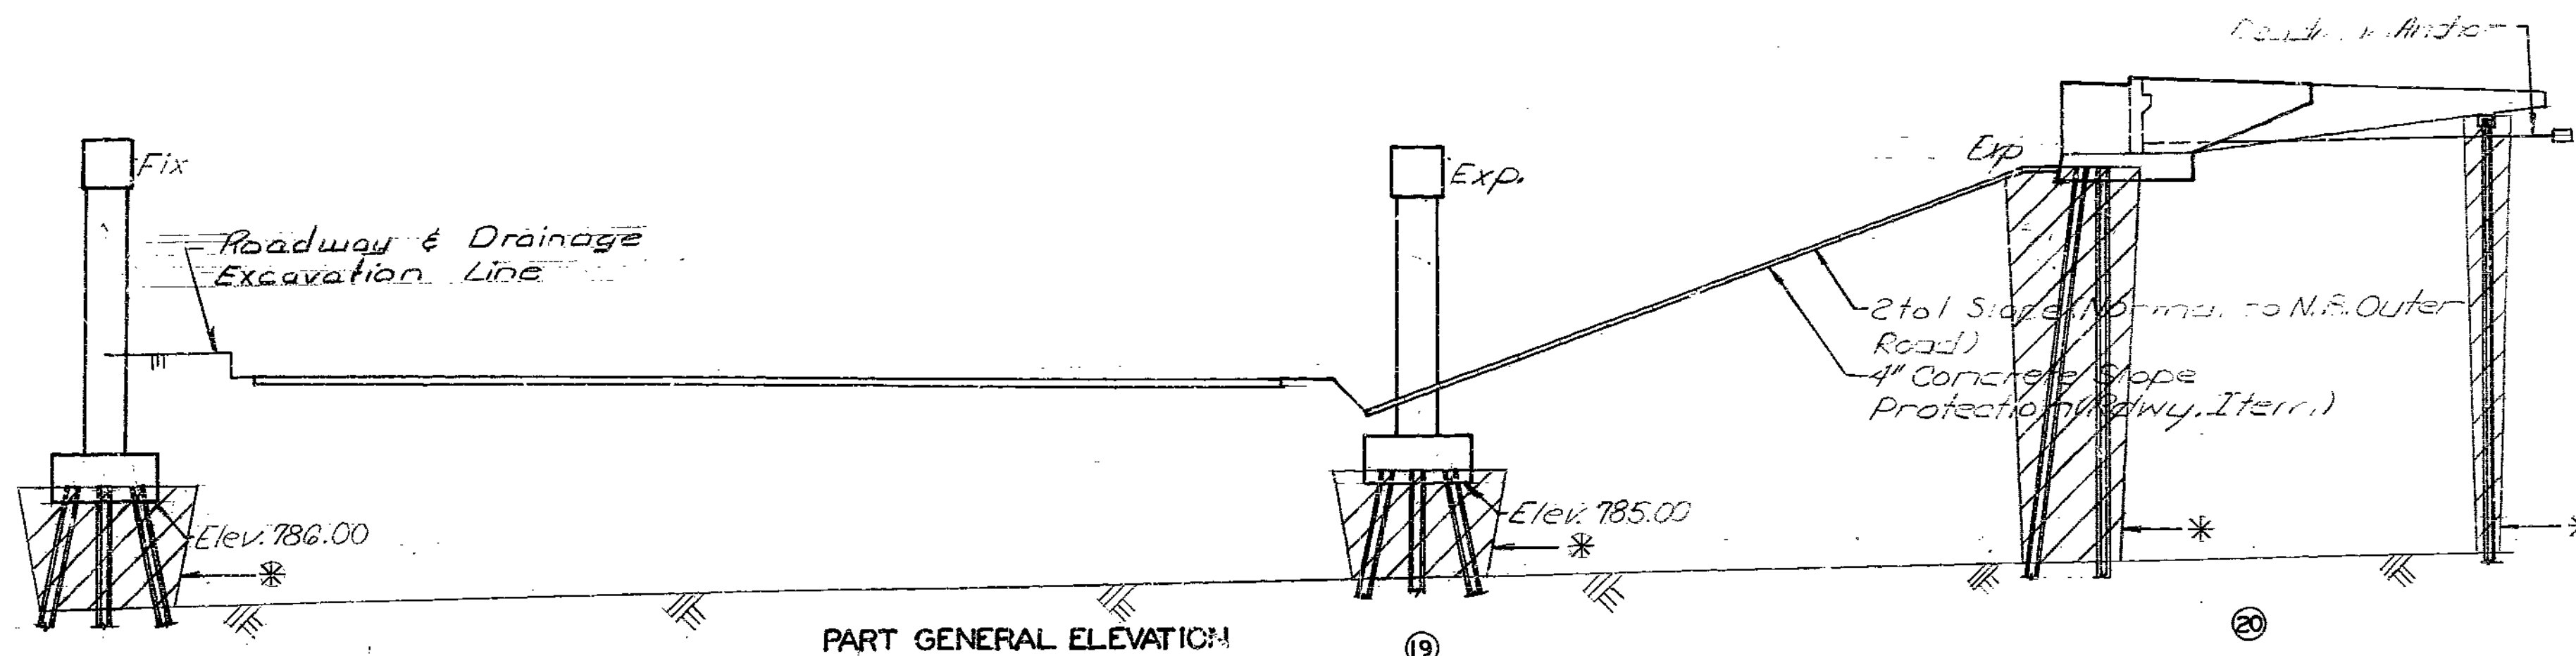

PART GENERAL ELEVATION  
 \*Earth Plug (built under previous contract)

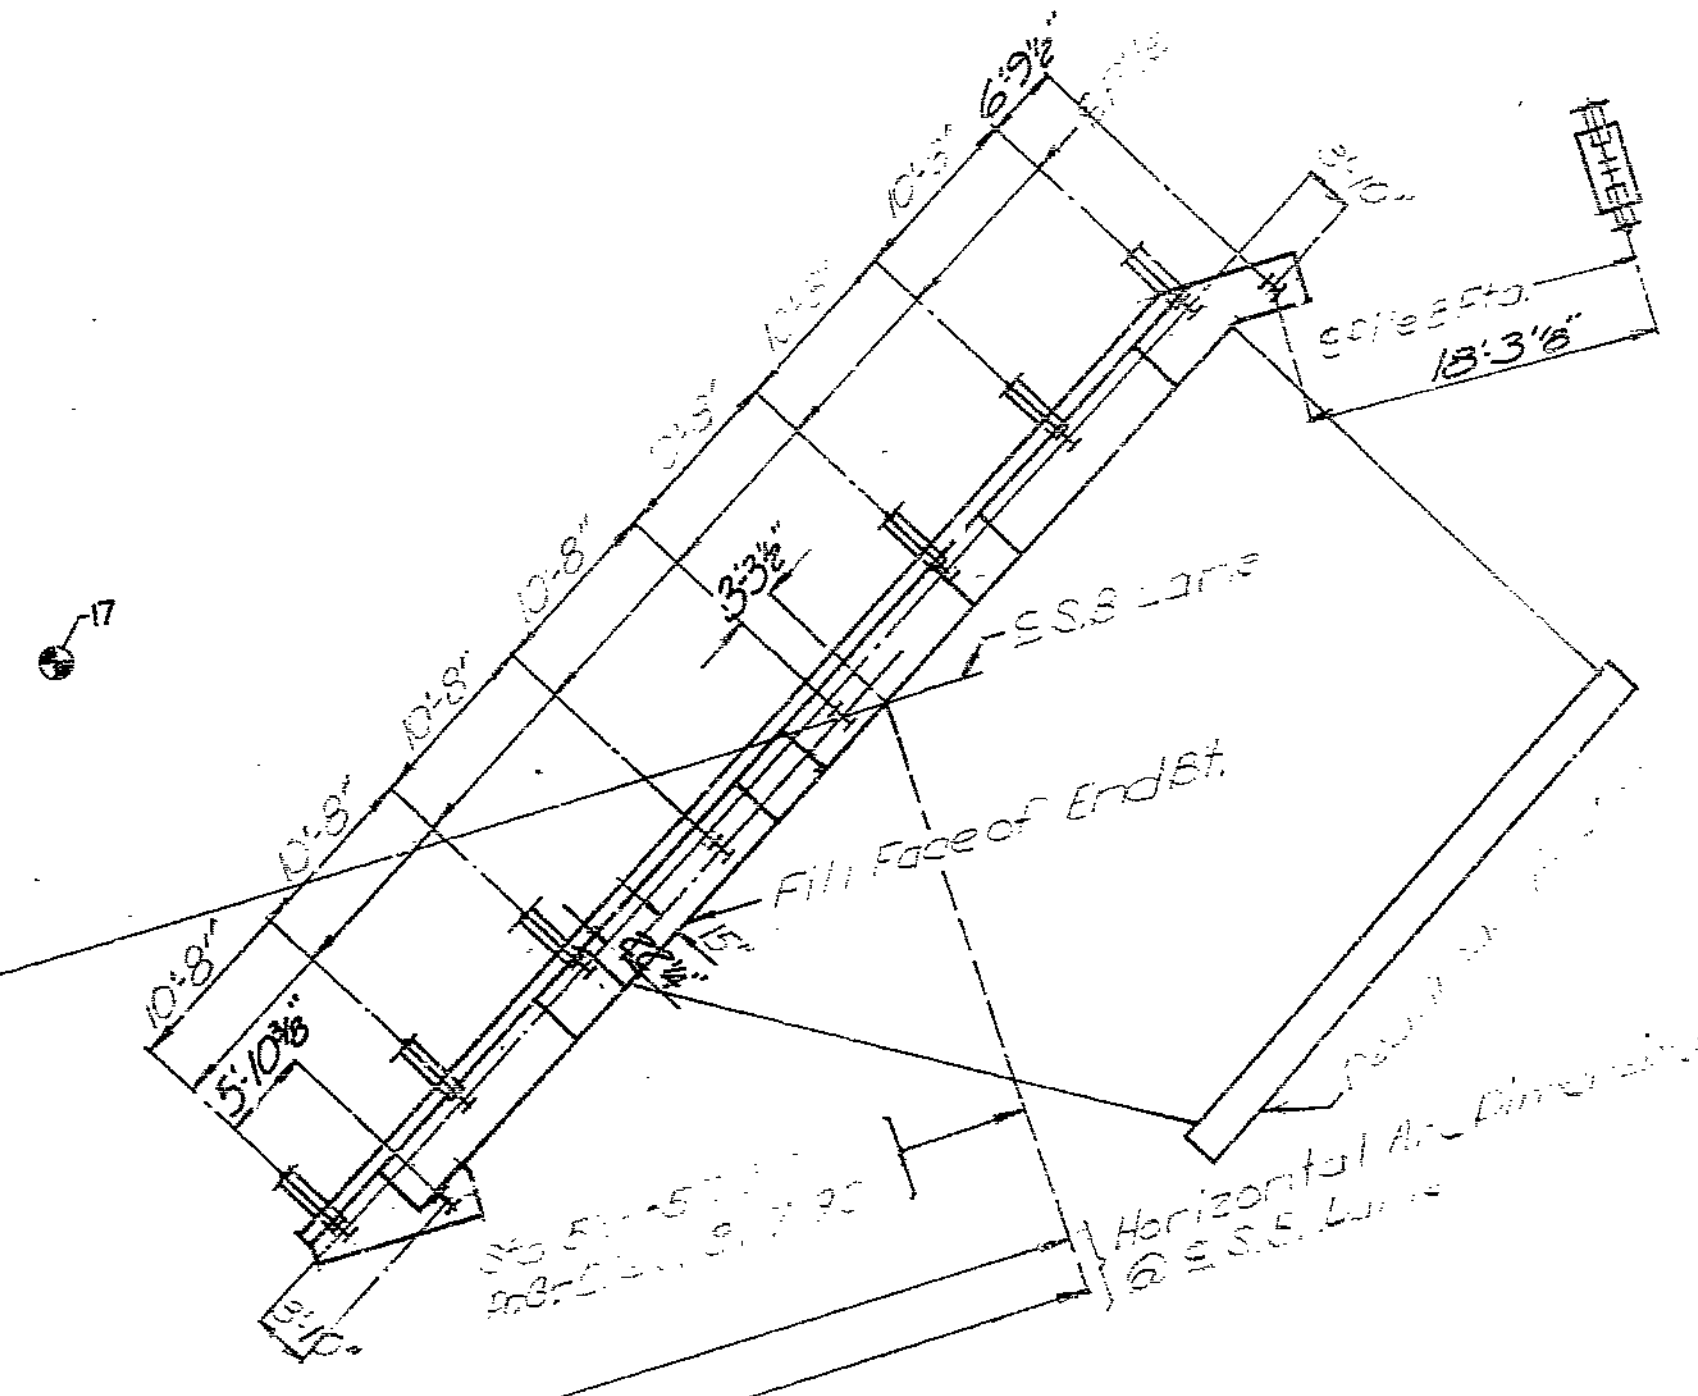

204 318

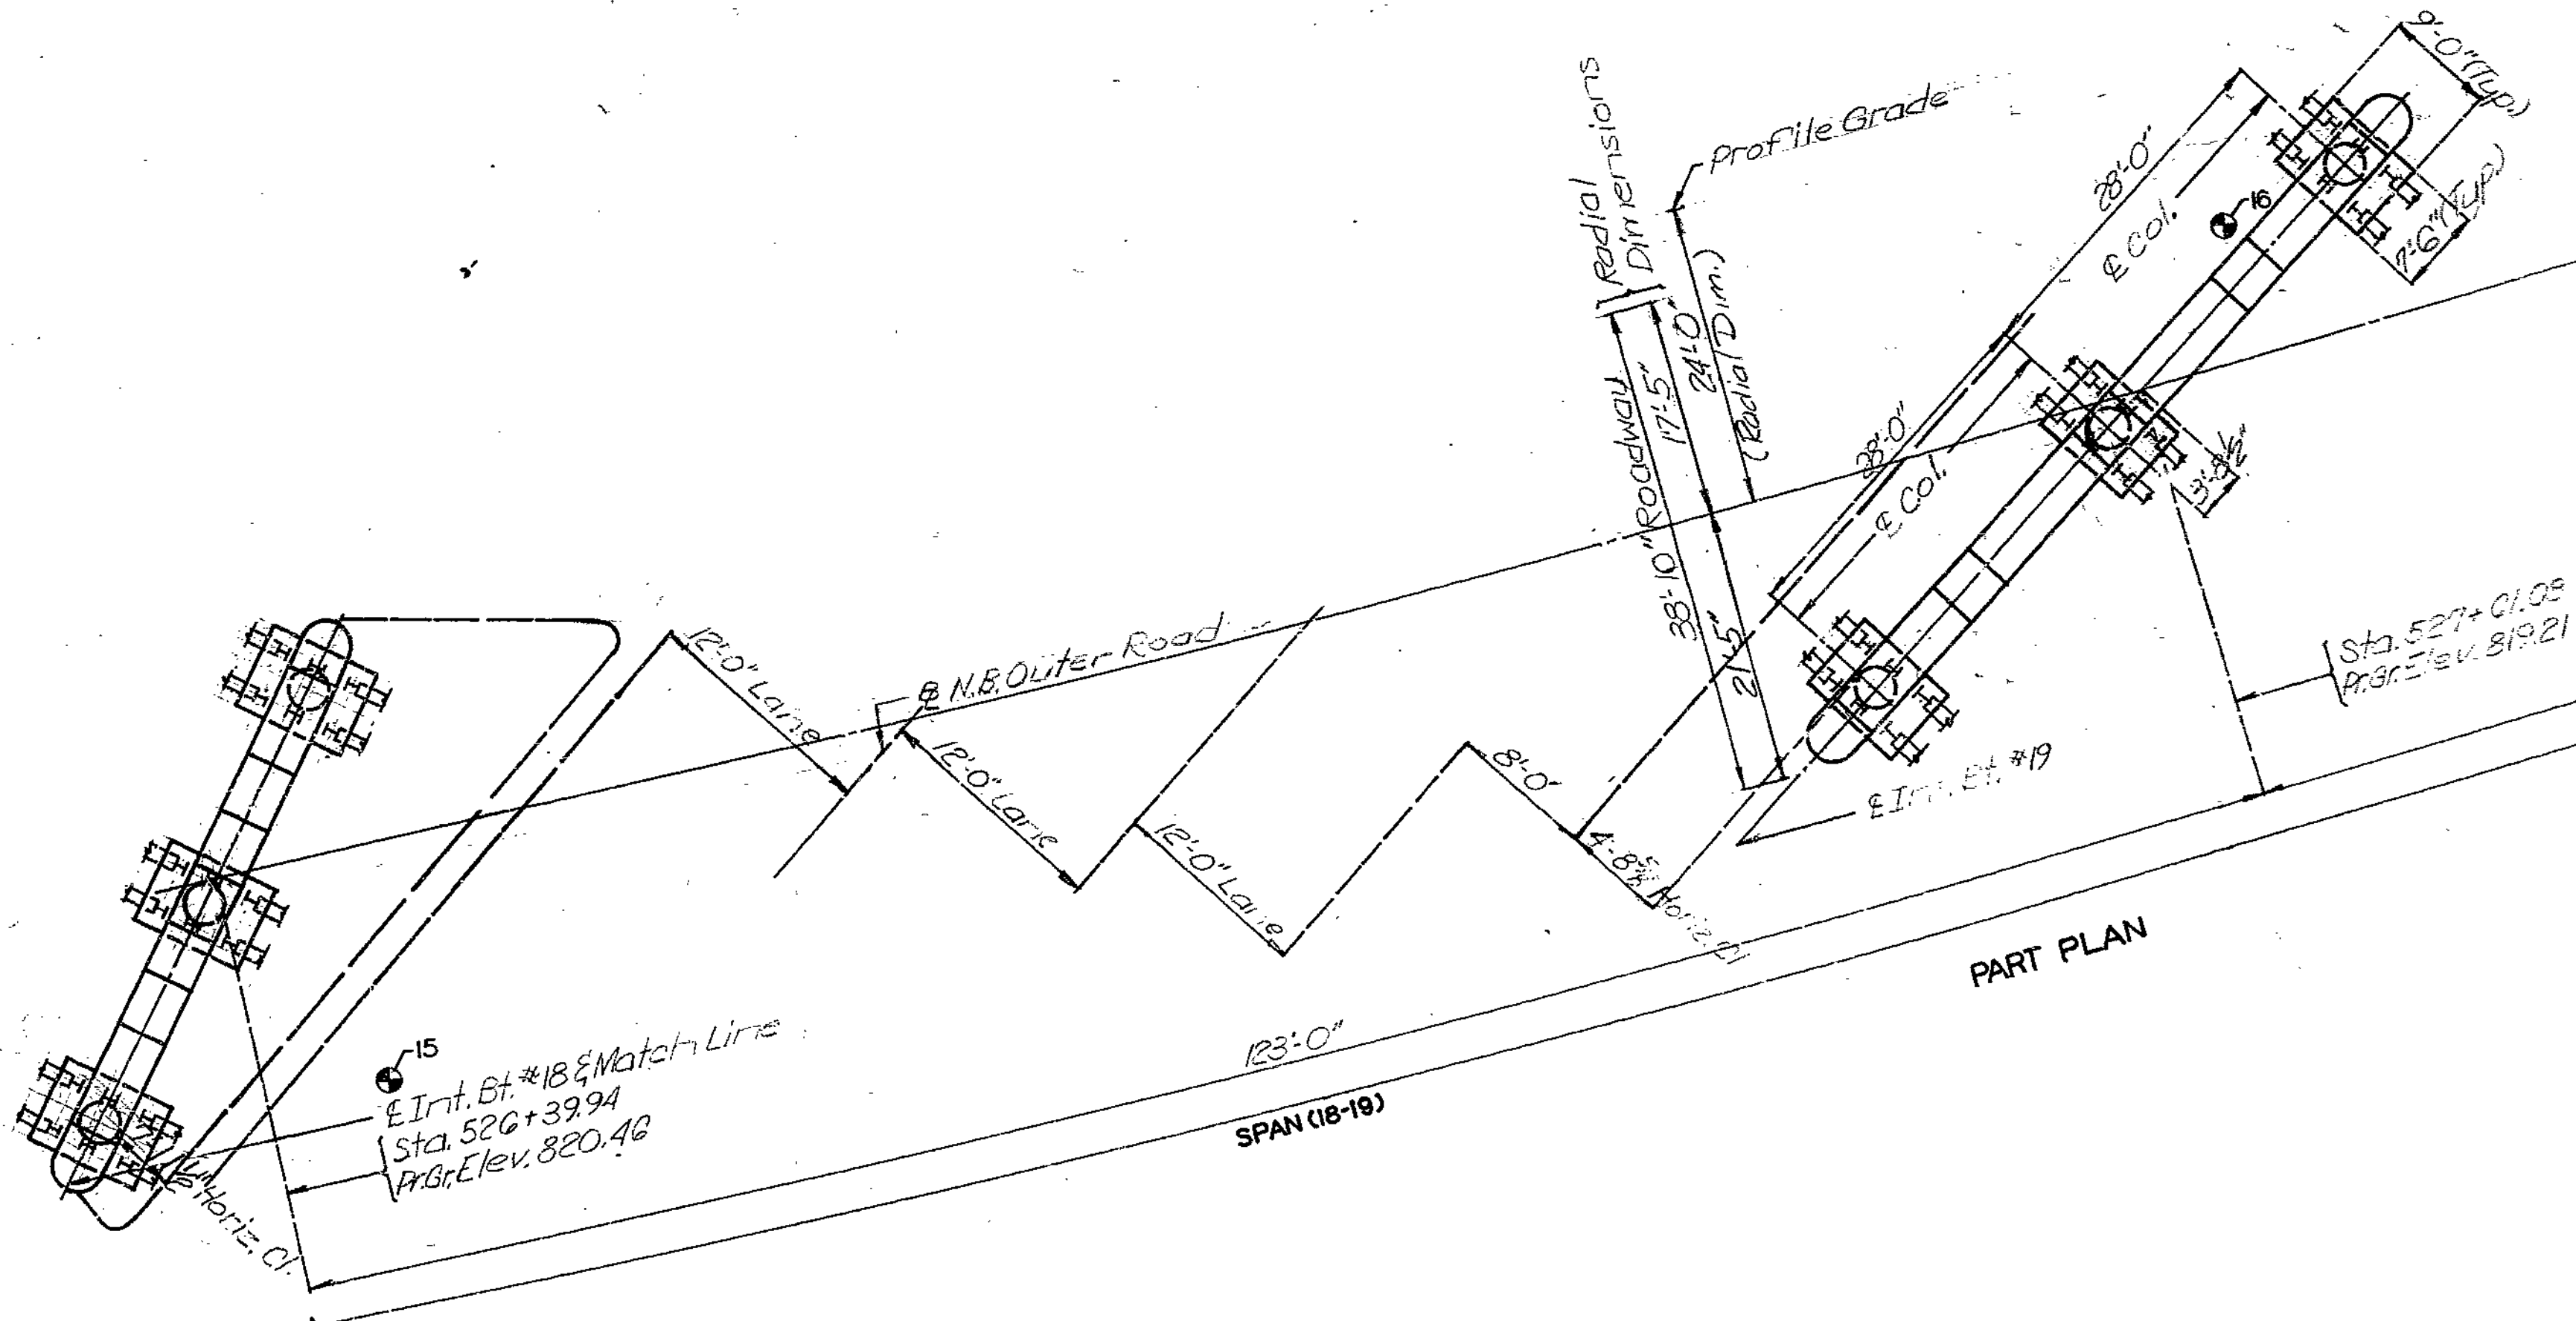

DETAILED JULY 1988  
 CHECKED Aug. 1988

Note: For Boring Data see sheets 10, 10 & 11.  
 \*Indicates location of Pier 19.

Note: This drawing is not to scale. Follow dimensions.

SEE OTHER PLANS

Sheet No. 5 of 33

JACKSON COUNTY

A-2745



STATE	PROJ. NO.	SHEET NO.
MO.		66

ESTIMATED QUANTITIES		
ITEM		
Class 1 Excavation	Cu. Yd.	815
Class 2 Excavation	Cu. Yd.	186
Structural Steel Piles (10")	Lin. Ft.	1,954
Structural Steel Piles (12")	Lin. Ft.	8,651
Pre-Bore for Piling	Lin. Ft.	384
Class B Concrete	Cu. Yd.	1,730.0
Reinforcing Steel	Lb.	257,160
Reinforcing Steel (epoxy coated)	Lb.	1,910
Deadman Anchor Assembly	Each	2

HYDROLOGIC DATA	
Drainage Area	= 199.7 Sq. Mi.
Design Discharge	= 57,500 c.f.s. (100 Years)
Design H.W. Elevation	= 795.1
Backwater is negligible	
BASIC FLOOD DATA	

GENERAL NOTES:

Design Specifications:  
A.A.S.H.T.O. - 1983 and Interims 1984, 1985, 1986 & 1987  
Load Factor Design

Design Loading:  
HS20-44 33" Future Wearing Surface  
Modified 24,000 \* Tandem Axle  
Earth 120#/cu.ft., Equivalent Fluid Pressure 45#/cu.ft.

Design Unit Stresses:  
Class B concrete (Substructure)  $f_c = 3,000$  psi  
Reinforcing Steel (Grade 60)  $f_y = 60,000$  psi  
Steel Pile  $f_b = 3,000$  psi

Note: All reinforcing bars in tops of substructure beams or caps shall be spaced to clear anchor bolts for bearings by at least 1/2".

Reinforcing Steel:  
Minimum clearance to reinforcing steel shall be 1/2", unless otherwise shown.


Construction Clearance:  
Marich Trway, a minimum vert. clearance of 14'-6" from crown of existing lanes and a minimum lateral clearance of 52'-0" centered on existing lanes shall be maintained during construction.  
Burlington Northern R.R. minimum lateral clearance of 12'-0" from E Tracks, shall be in accordance w/ the R.R. contract.

N.B. Rte. 71 Detour a min. vert. clearance of 14'-6" from crown of existing lanes and a min. lateral clearance of 34'-0" centered on lanes.  
Blue River Rd. a min. vert. clearance of 14'-6" from crown of existing lanes and a min. lateral clearance 52'-0" centered on lanes.  
North Outer Road a min. vert. clearance of 14'-6" from crown of existing lanes and a min. lateral clearance of 2'-0" from Pav't. edge (each side).


LOCATION	ANCHOR BOLT SIZE	C	D
BT. NO. 4, 9 & 13 BT. NO. 17 SPAN (16-17) END BENT NO. 20	2" $\phi$ * 1 1/2" $\phi$ * 1 1/2" $\phi$ *	15"	9 1/8"
BT. NO. 17 SPAN (17-18) BENT NO. 19	2" $\phi$ *	18"	9 1/8"
BENT NO. 18	2 1/2" $\phi$ *	25"	9 1/8"

\*\* Bts. No. 4, 9, 13 & Bt. No. 17 Span (16-17) Use 2"  $\phi$  Anchor Bolts. However use the spiral reinforcement (W-Bars) as detailed on Int. Bt. sheets.


\* Anchor Bolts are included in future construction.

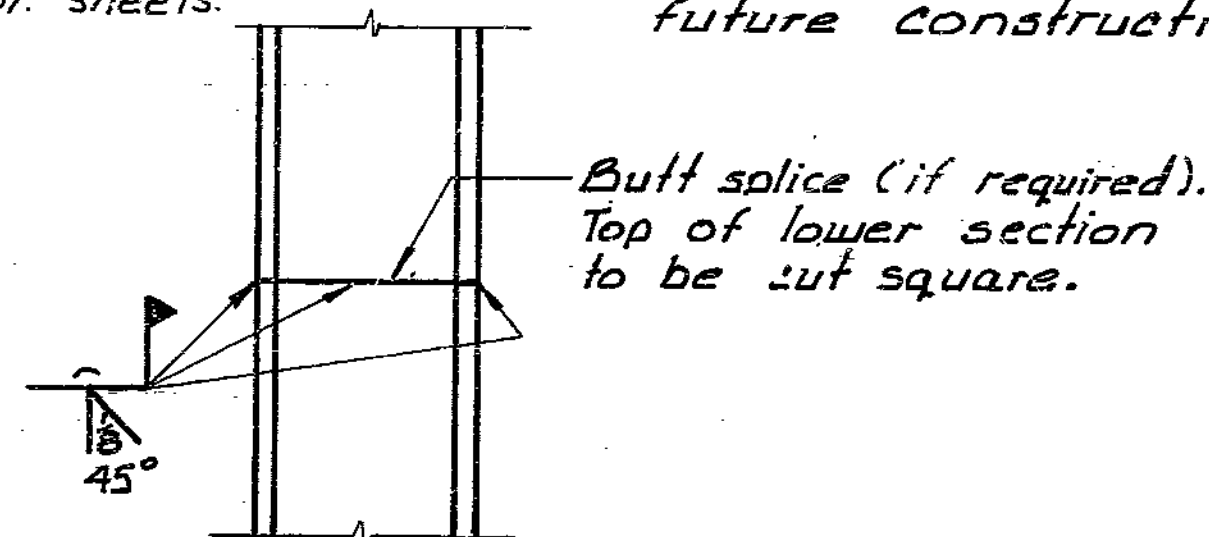

DETAIL OF STEEL PILE SPLICE

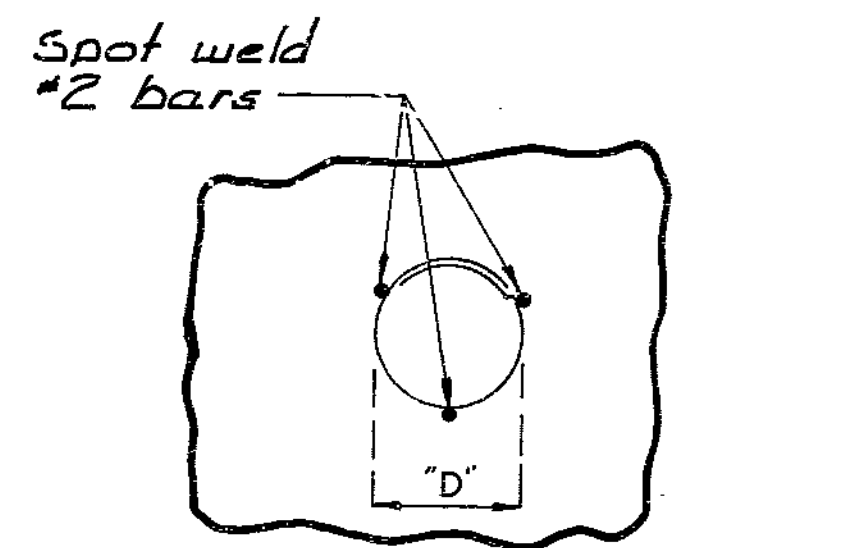

PLAN

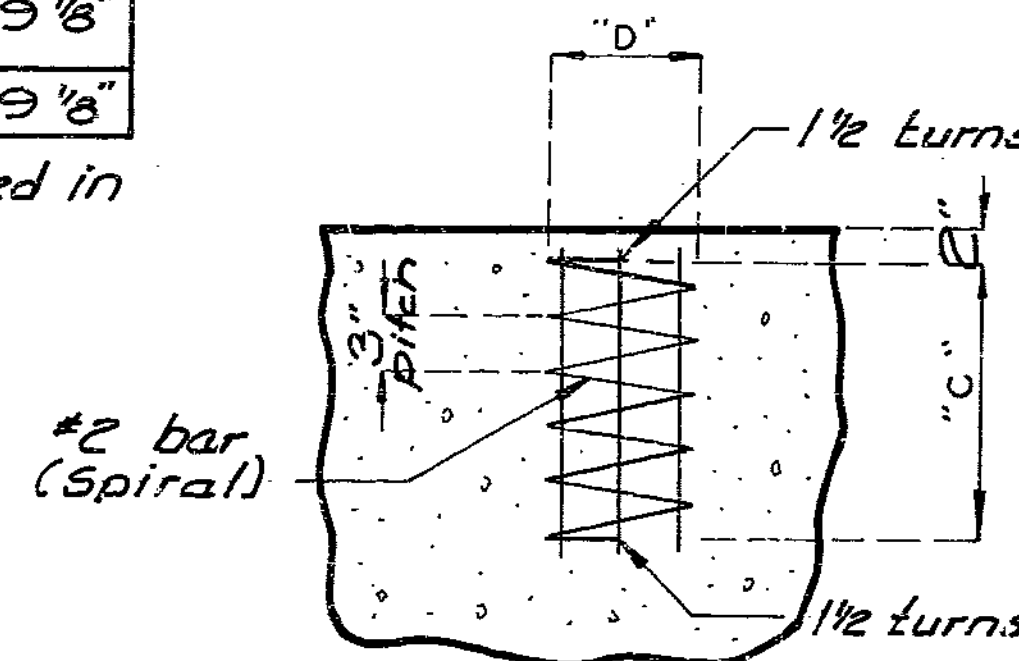

SECTION

DETAILS OF ANCHOR BOLT SPIRALS








BENT NO.	PILE DATA																				
	1	2	3	4	5	6	7	8	9	10	11	12	13	14	15	16	17	18	19	20	
PILE TYPE AND SIZE	HP12x53	HP12x53	HP12x53	HP10x42	HP12x53	HP12x53	HP12x53	HP12x53	HP12x53	HP12x53	HP12x53	HP12x53	HP12x53	HP12x53	HP12x53	HP12x53	HP10x42	HP12x53	HP12x53	HP10x42	
NUMBER	5	12	12	12	12	20	20	15	12	15	15	13	16	15	16	16	16	13	13	10	2
APPROXIMATE LENGTH FT.	71	49	46	46	44	11	11	30	27	29	36	31	33	31	34	34	34	50	50	71	74
DESIGN BEARING TONS	67	61	61	53	57	69	69	61	63	59	67	64	69	70	59	59	55	68	60	53	5
HAMMER ENERGY REQUIRED FT.-LBS.	14900	14300	14300	12400	13400	15400	15400	14300	14800	13300	14900	15000	16200	16500	13800	13800	12900	16000	14100	13100	9300

Note: Minimum energy requirement of hammer is based on plan length and design bearing value of piles.  
All piles shall be driven to practical refusal.  
Prebore for piles at Bents 1 and 20 to elevation 785.00.

205 319



STATE	PROJ. NO.	SHEET NO.
MO.		25

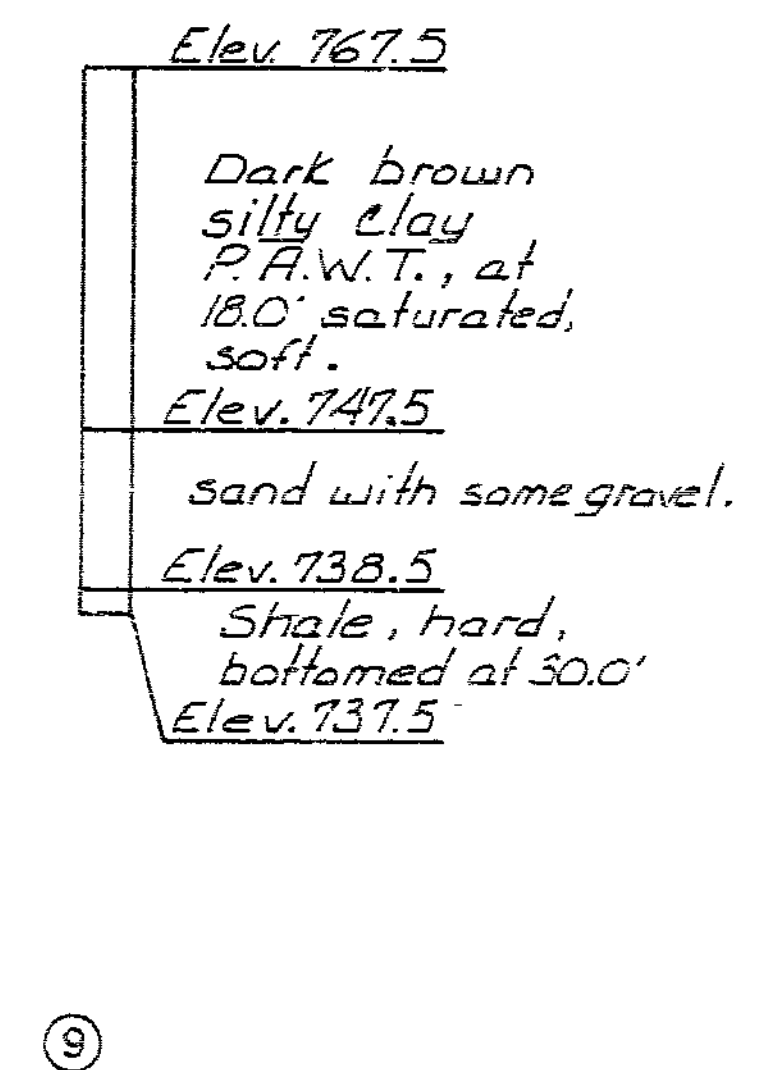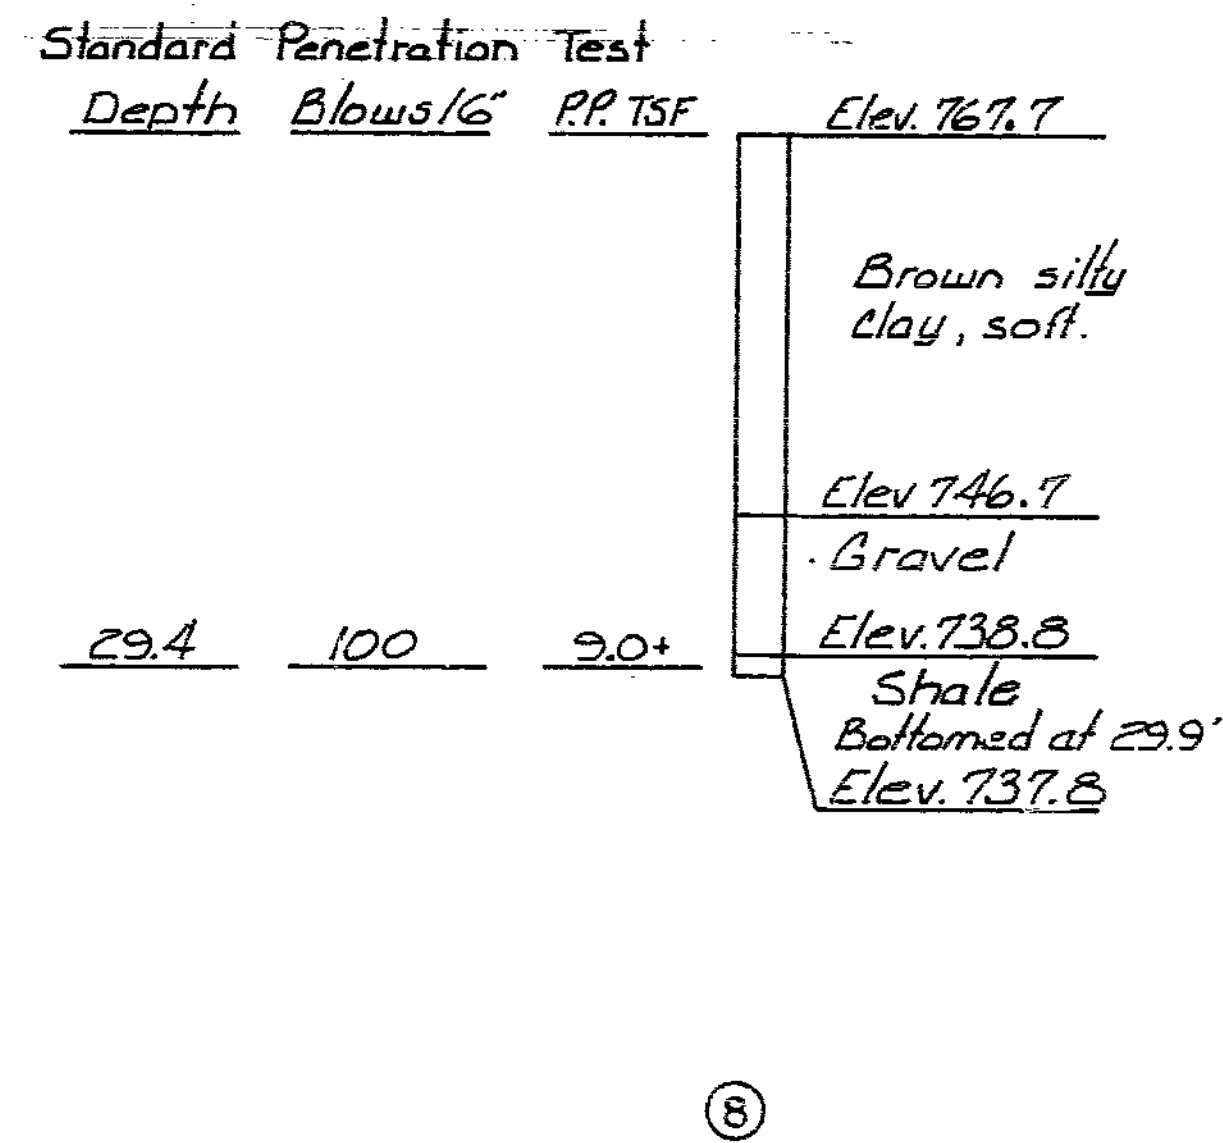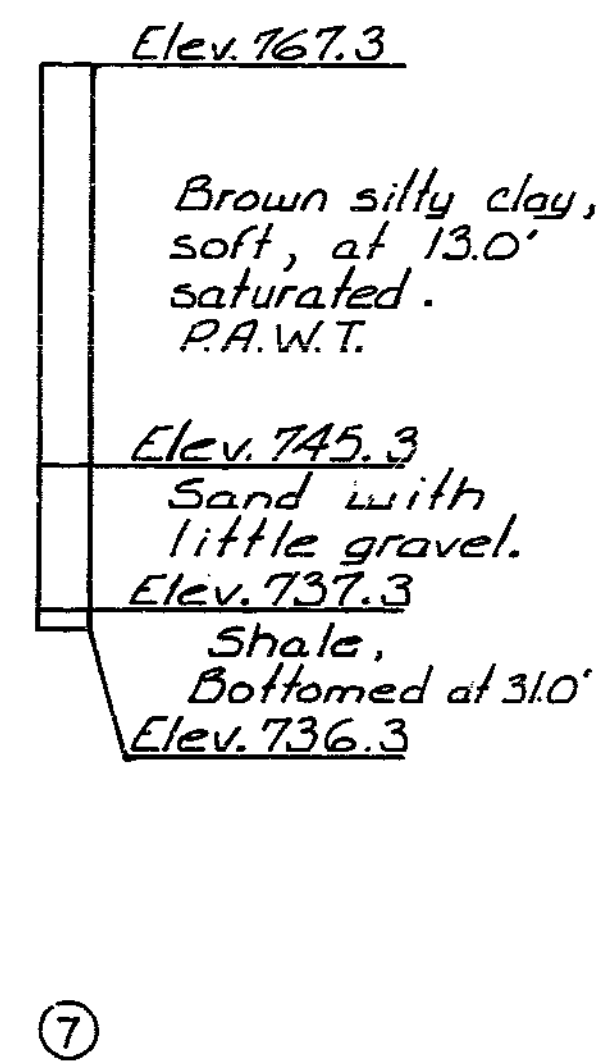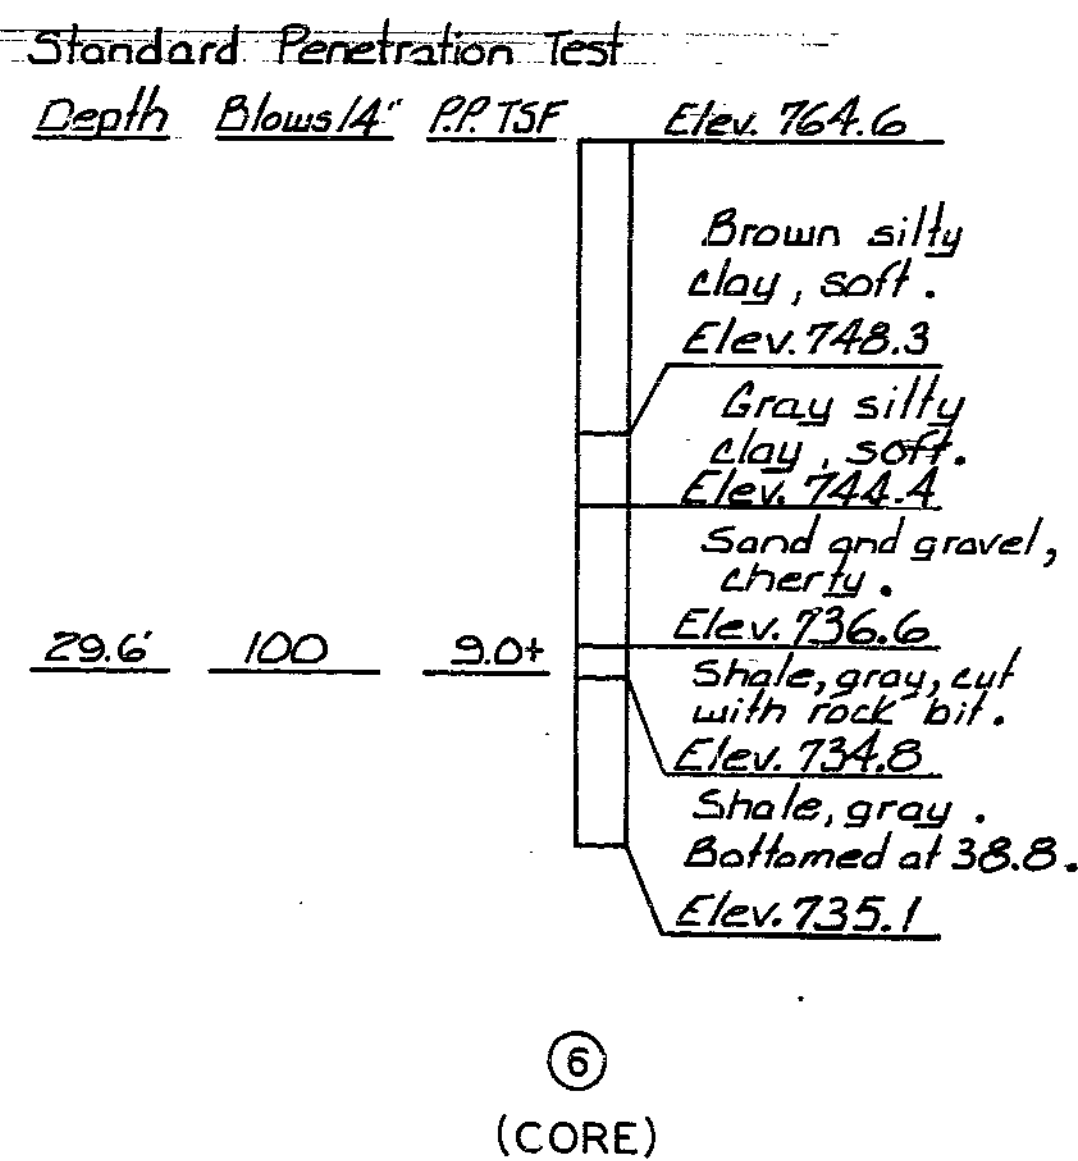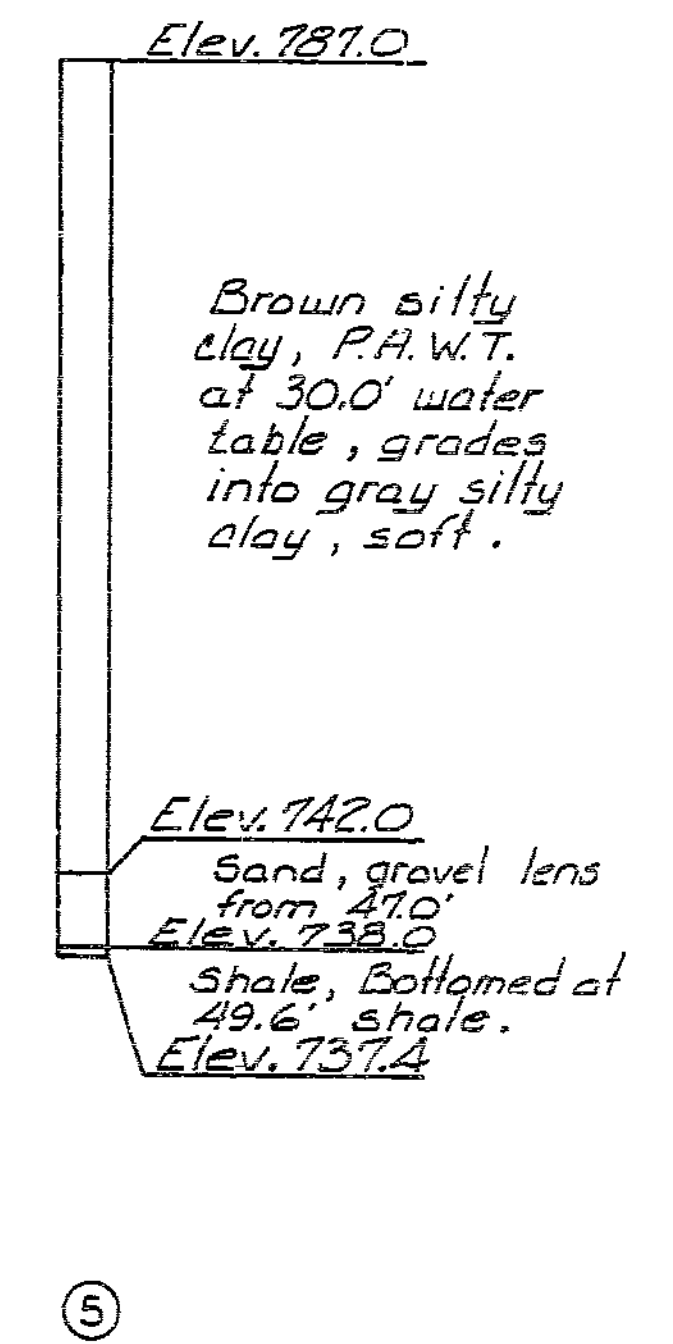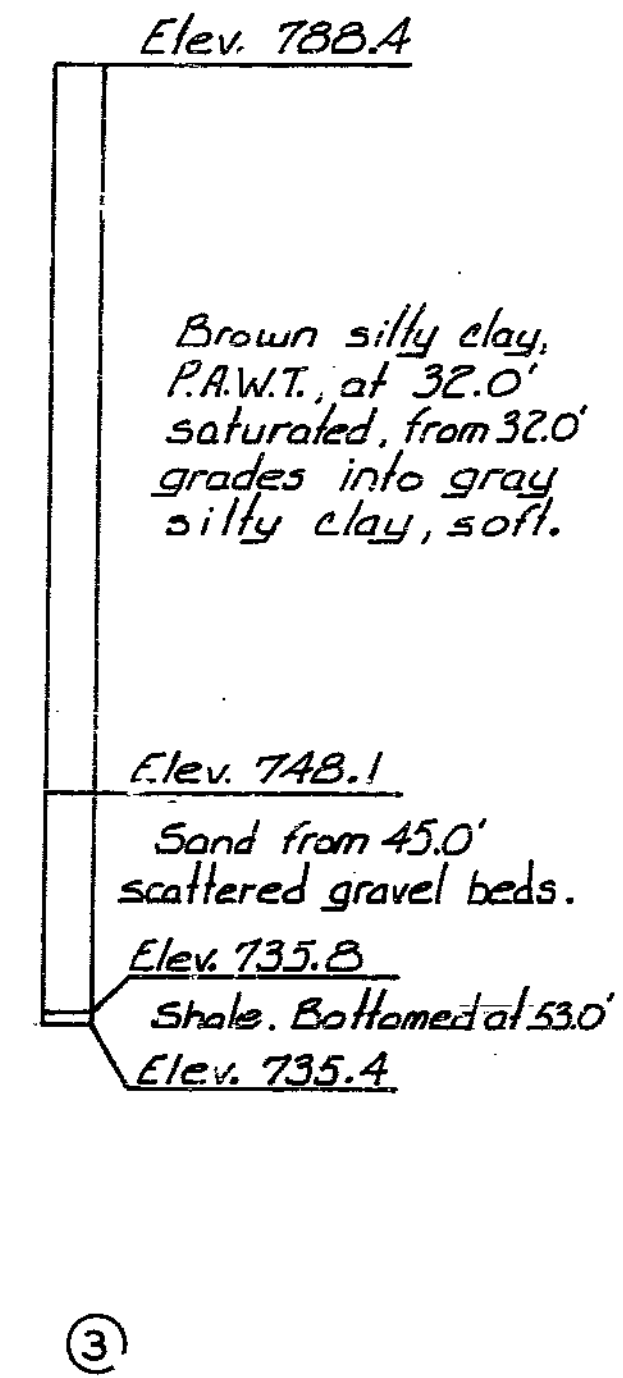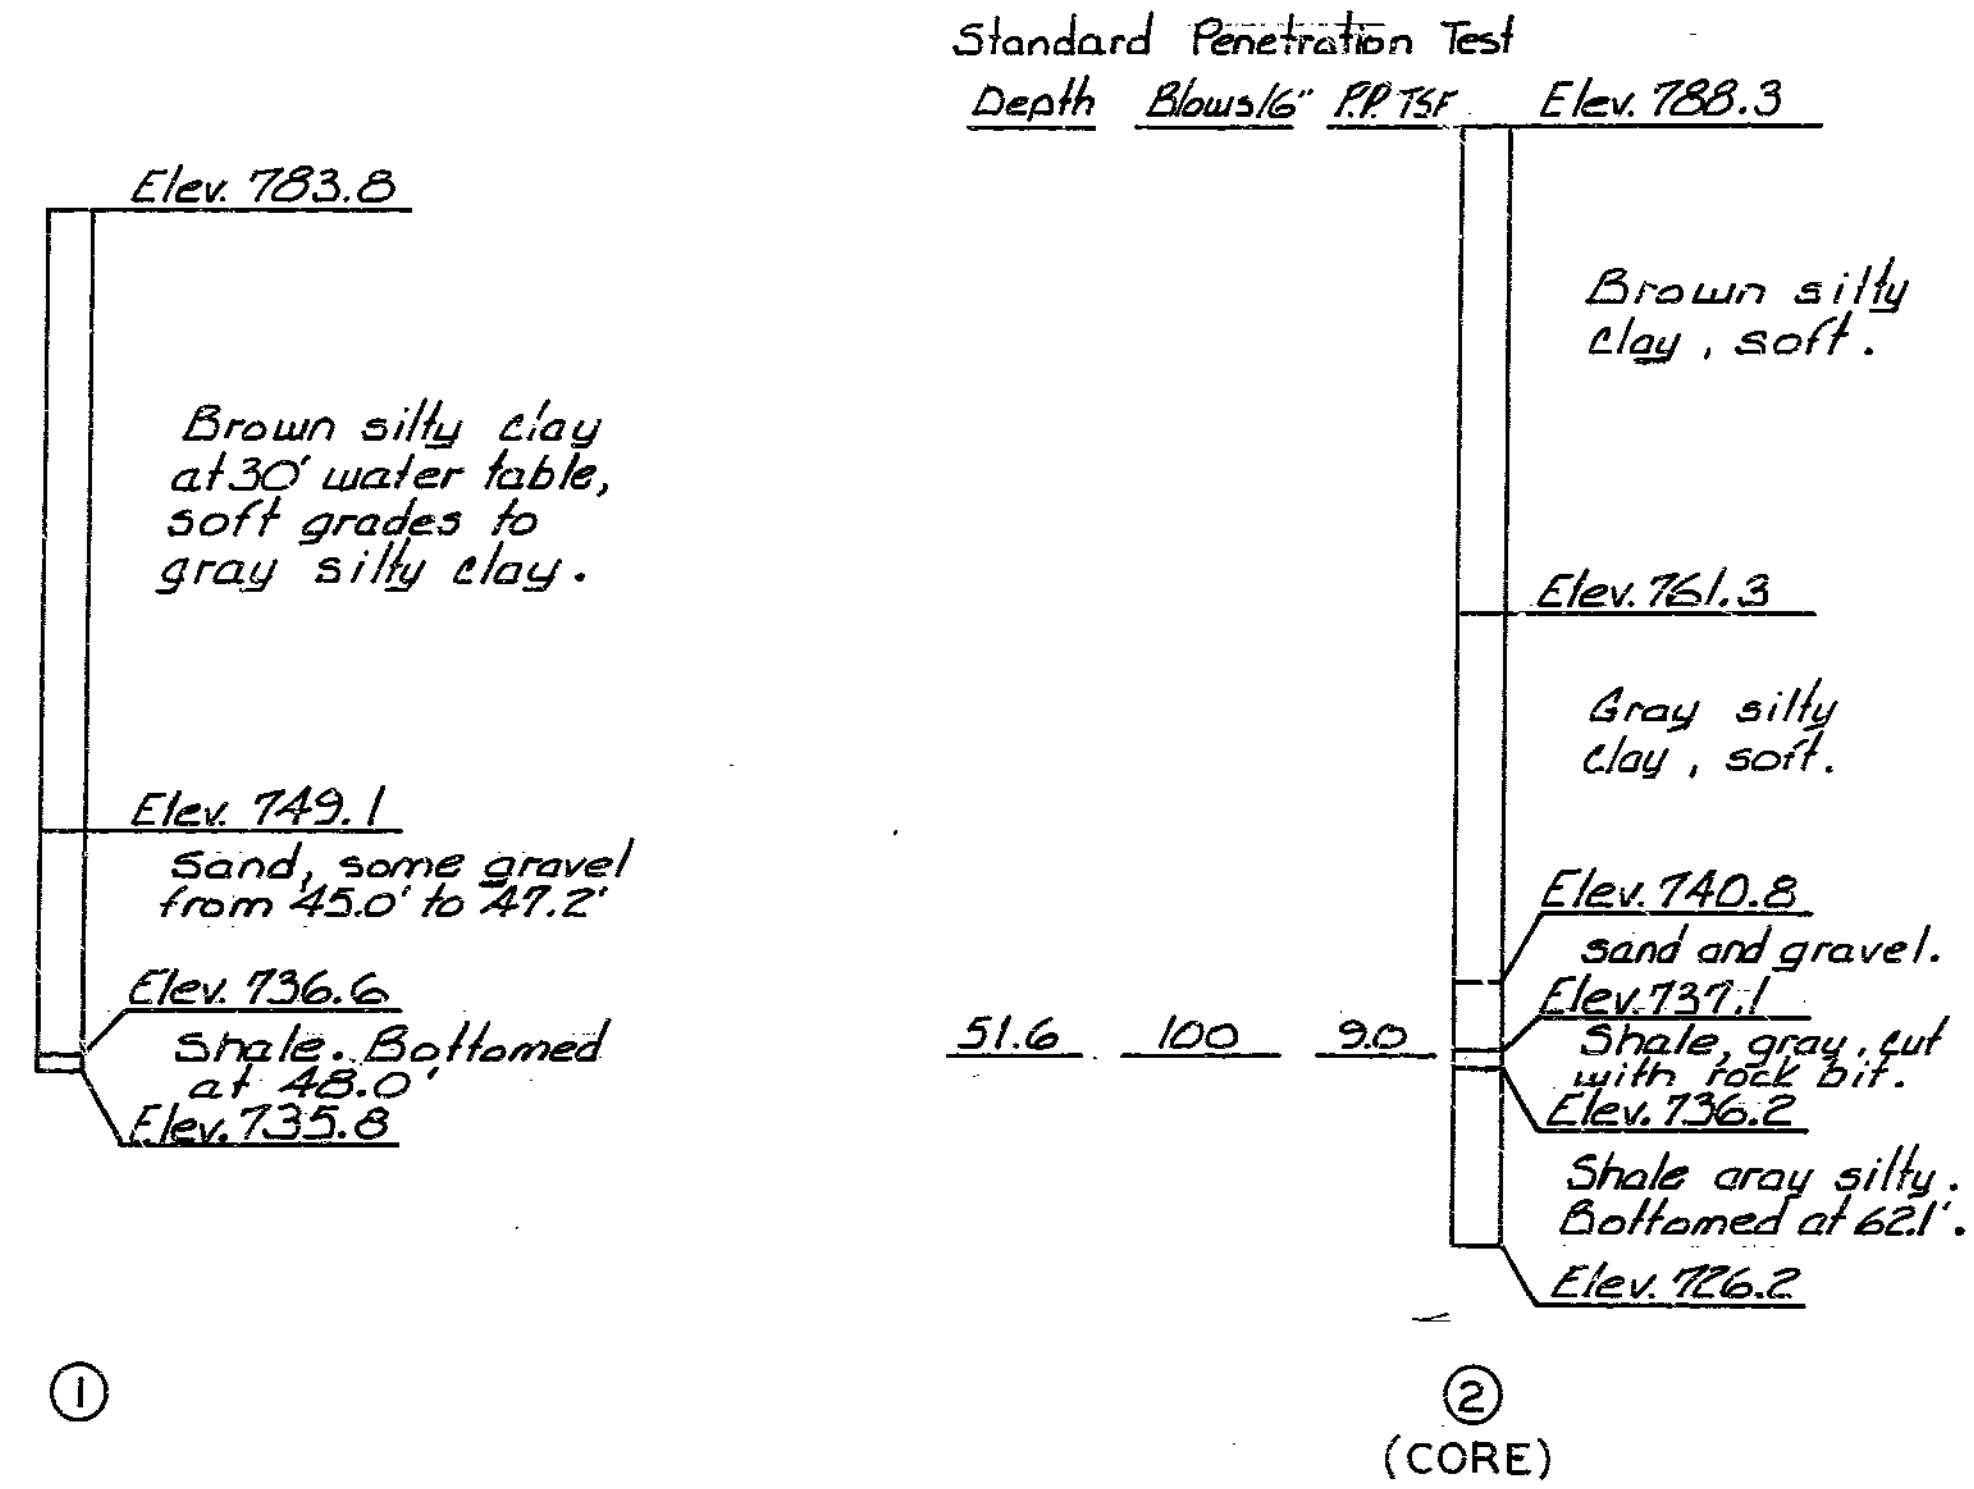


BORING DATA

Note: For location of borings see sheet No. 2 thru 5.

206 320


STATE	PROJ. NO.	SHEET NO.
MO.		66

Standard Penetration Test  
Depth Blows/15" P.P.TSF

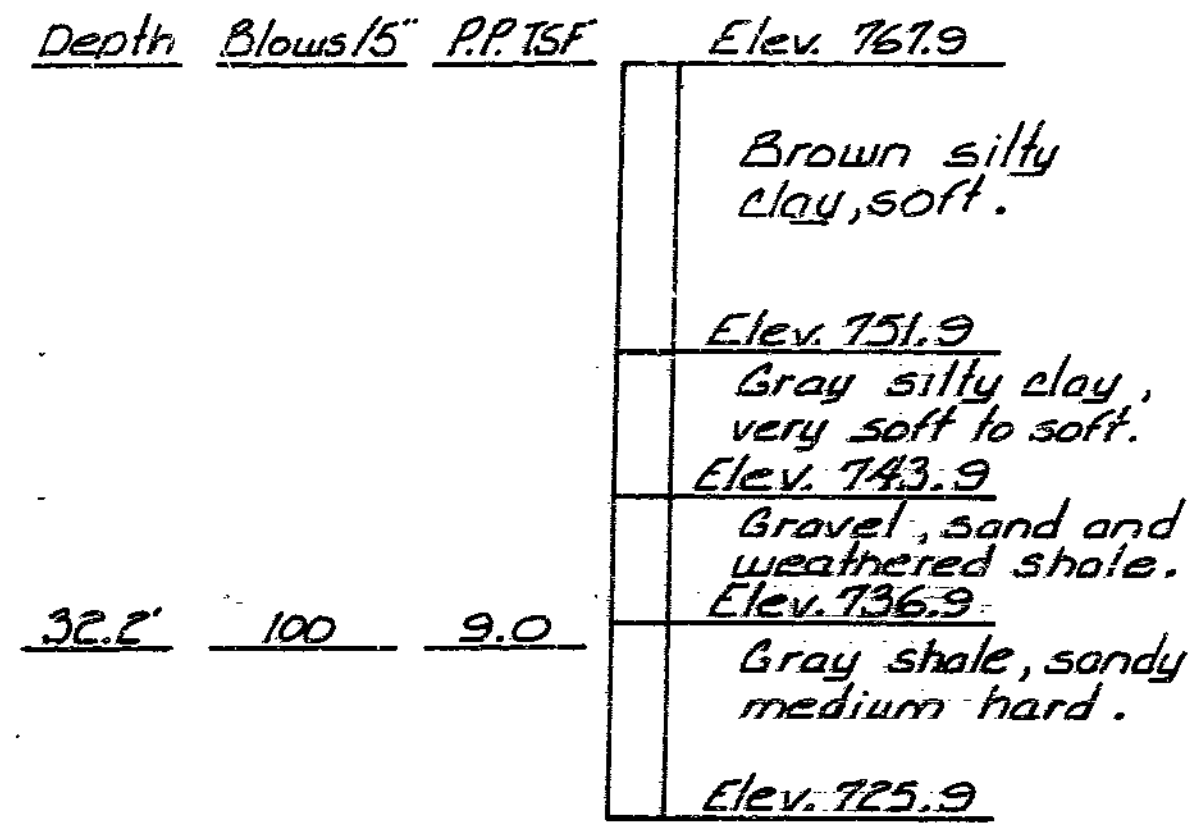


10  
(CORE)

Elev. 775.0

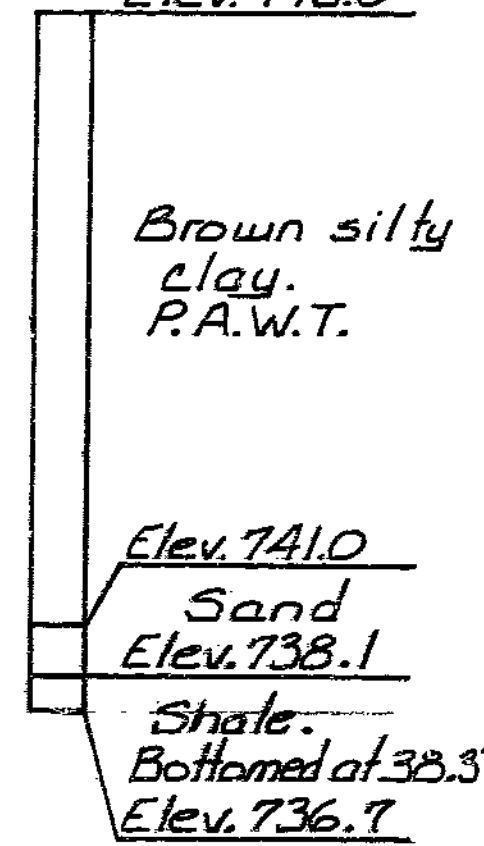


11

Standard Penetration Test  
Depth Blows/14" P.P.TSF

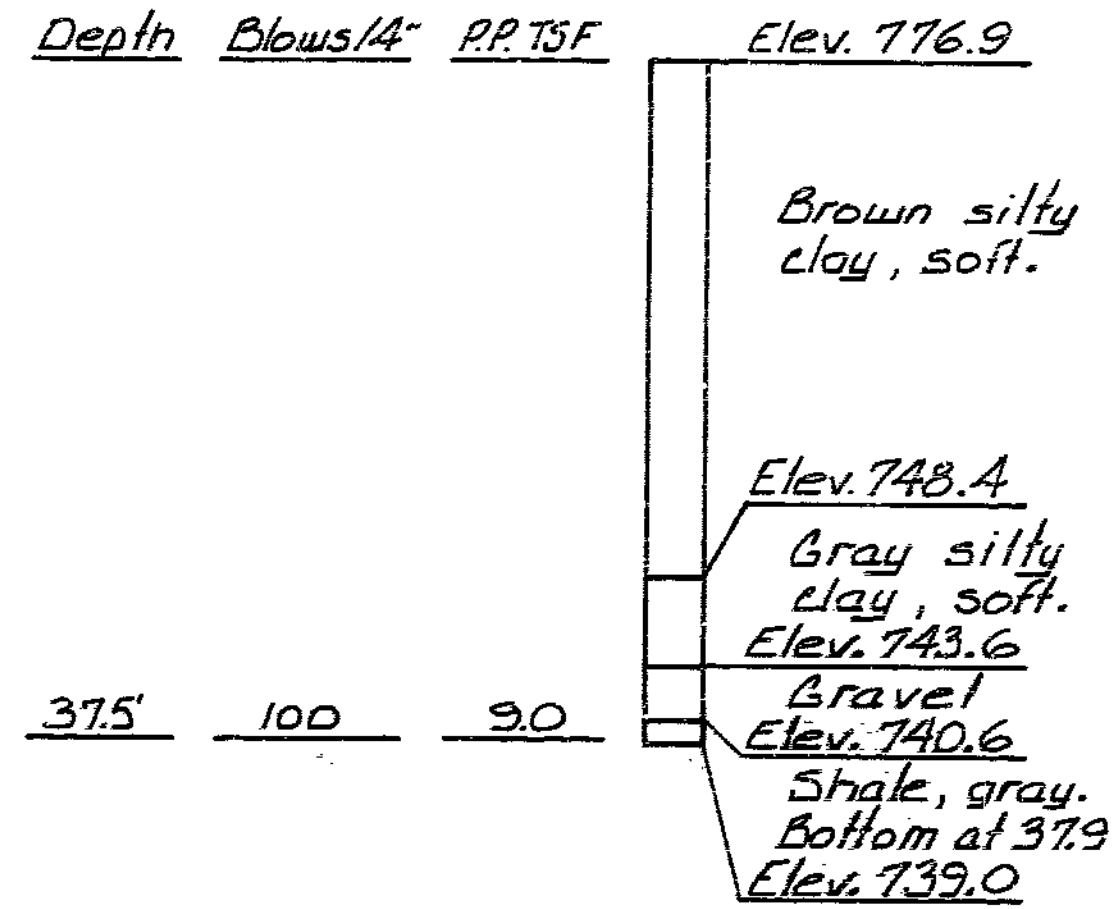


12

Standard Penetration Test  
Depth Blows/14" P.P.TSF

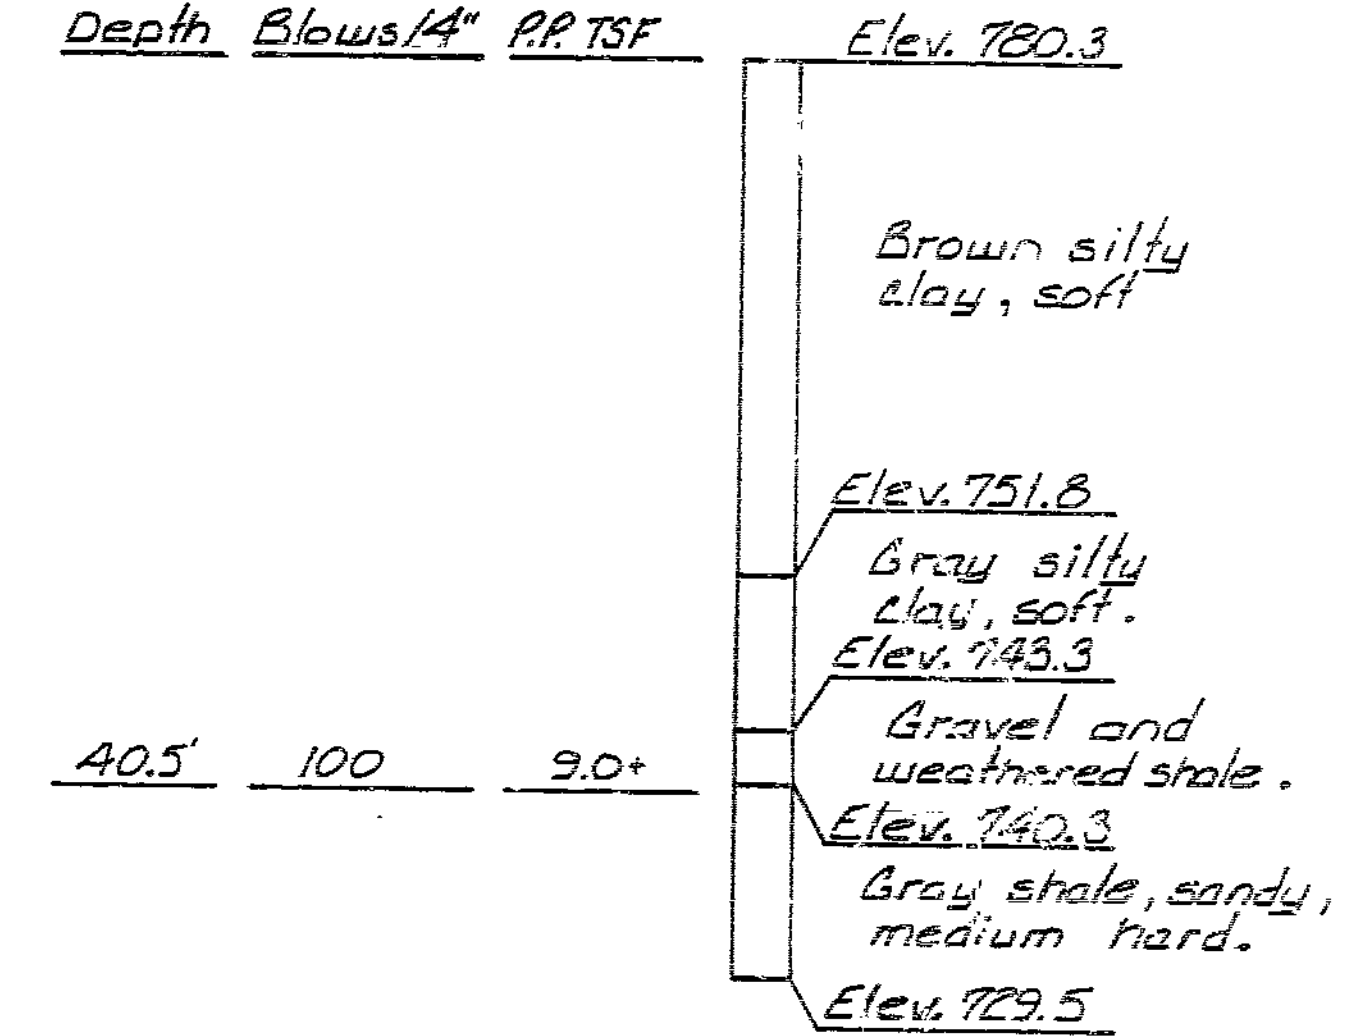

13  
(CORE)


Standard Penetration Test

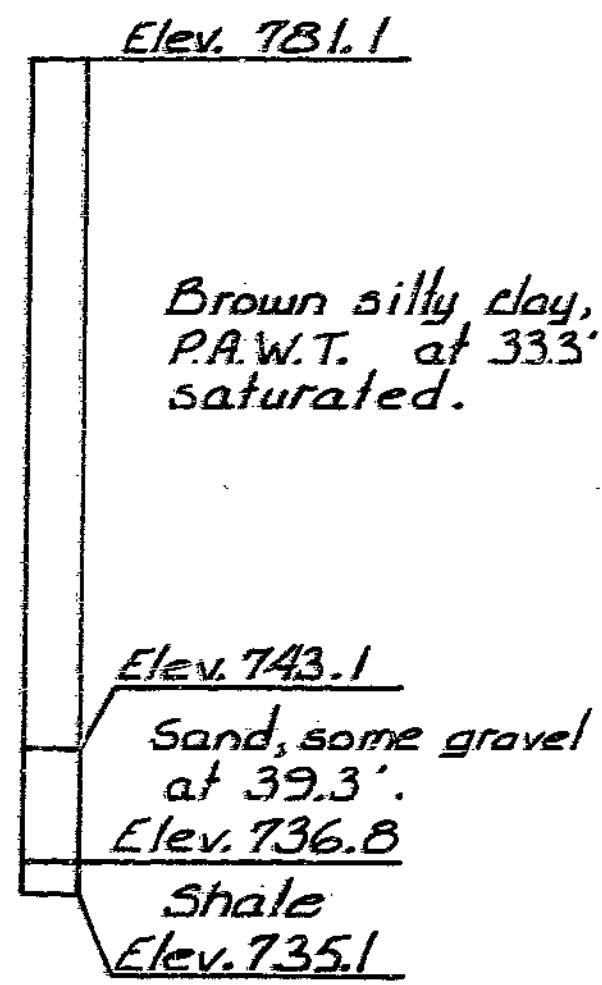

14

Depth	Blows/6"	P.P.TSF	Elev.
5.0'	4/3/4	1.5	783.9
10.0'	3/3/6	1.0	
15.0'	2/2/3	0.8	
20.0'	2/2/3	0.75	
25.0'	1/2/2	0.75	
30.0'	1/3/4	1.1	
35.0'	2/2/6	0.6	
45.6'	100	8.0	

15

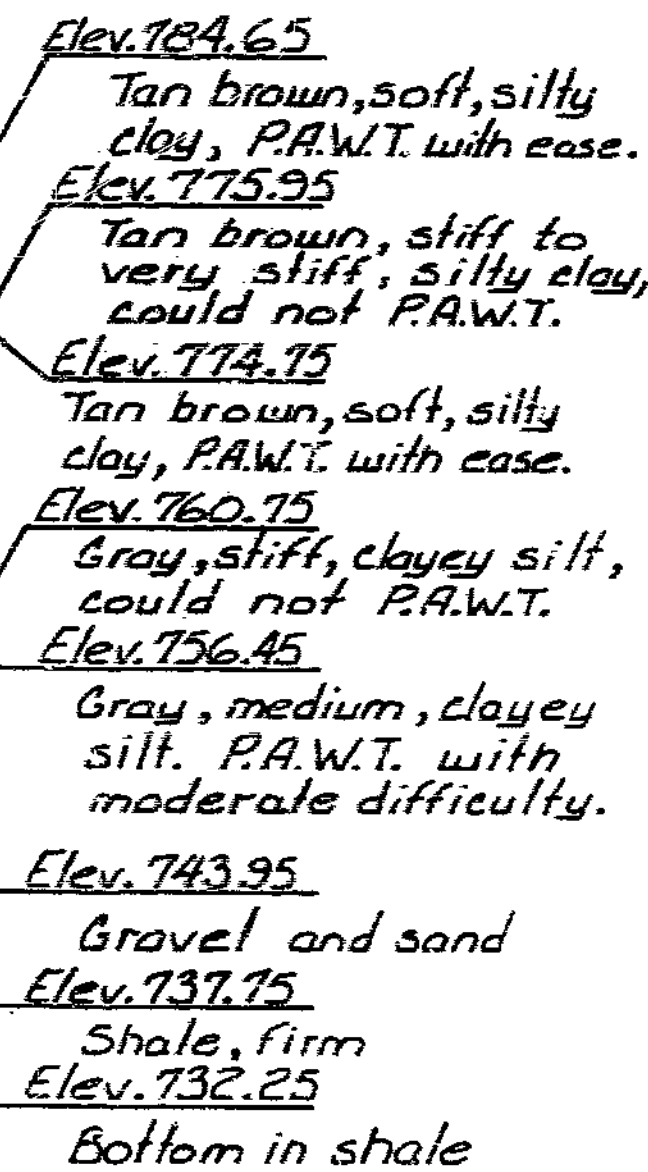

16

Standard Penetration Test

Depth	Blows/6"	P.P.TSF	Elev.
5.0'	6-8-3	2.75	785.2
10.0'	4-5-5	0.75	
15.0'	3-3-5	0.75-1.00	
20.0'	2-2-4	0.50-0.75	
25.0'	2-3-3	0.40-1.00	
30.0'	3-2-3	0.40-0.60	
35.0'	4-4-6	0.40	
40.0'	7-15-14		
45.0'	10-13-13		
46.5'	20-100 in 3"	6.0	
51.5'	100 in 5"	6.8-7.4	


17

BORING DATA

Note: For location of borings see sheet No. 2 thru 5.

207 321


STATE	PROJ. NO.	SHEET NO.
MO		67

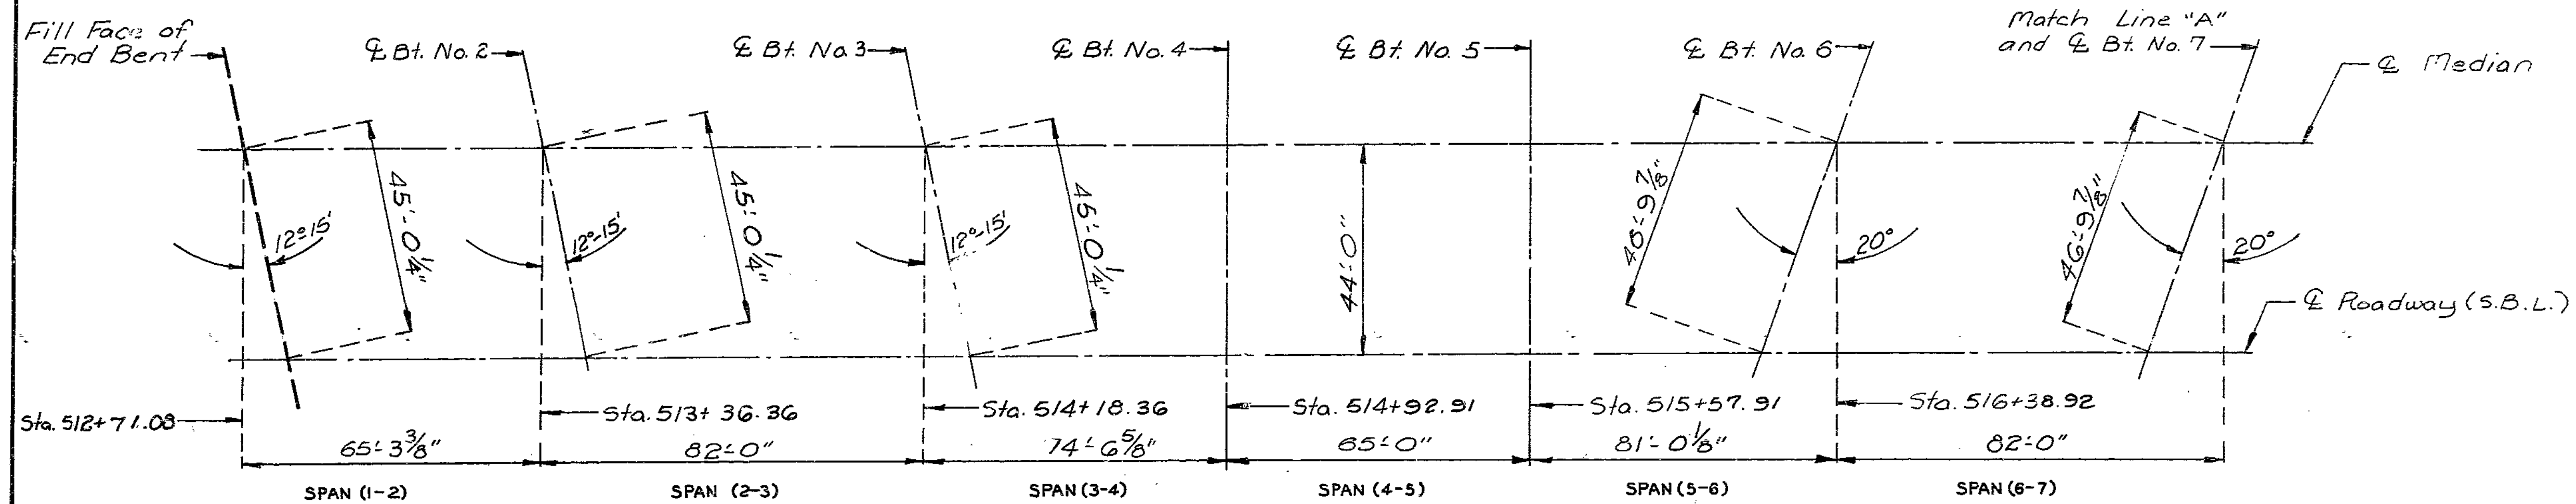

Note: All dimensions are horizontal.

Note: Bents cannot be accurately located from the reference point on the tangent by conventional survey methods based on 100' chords.

208 372

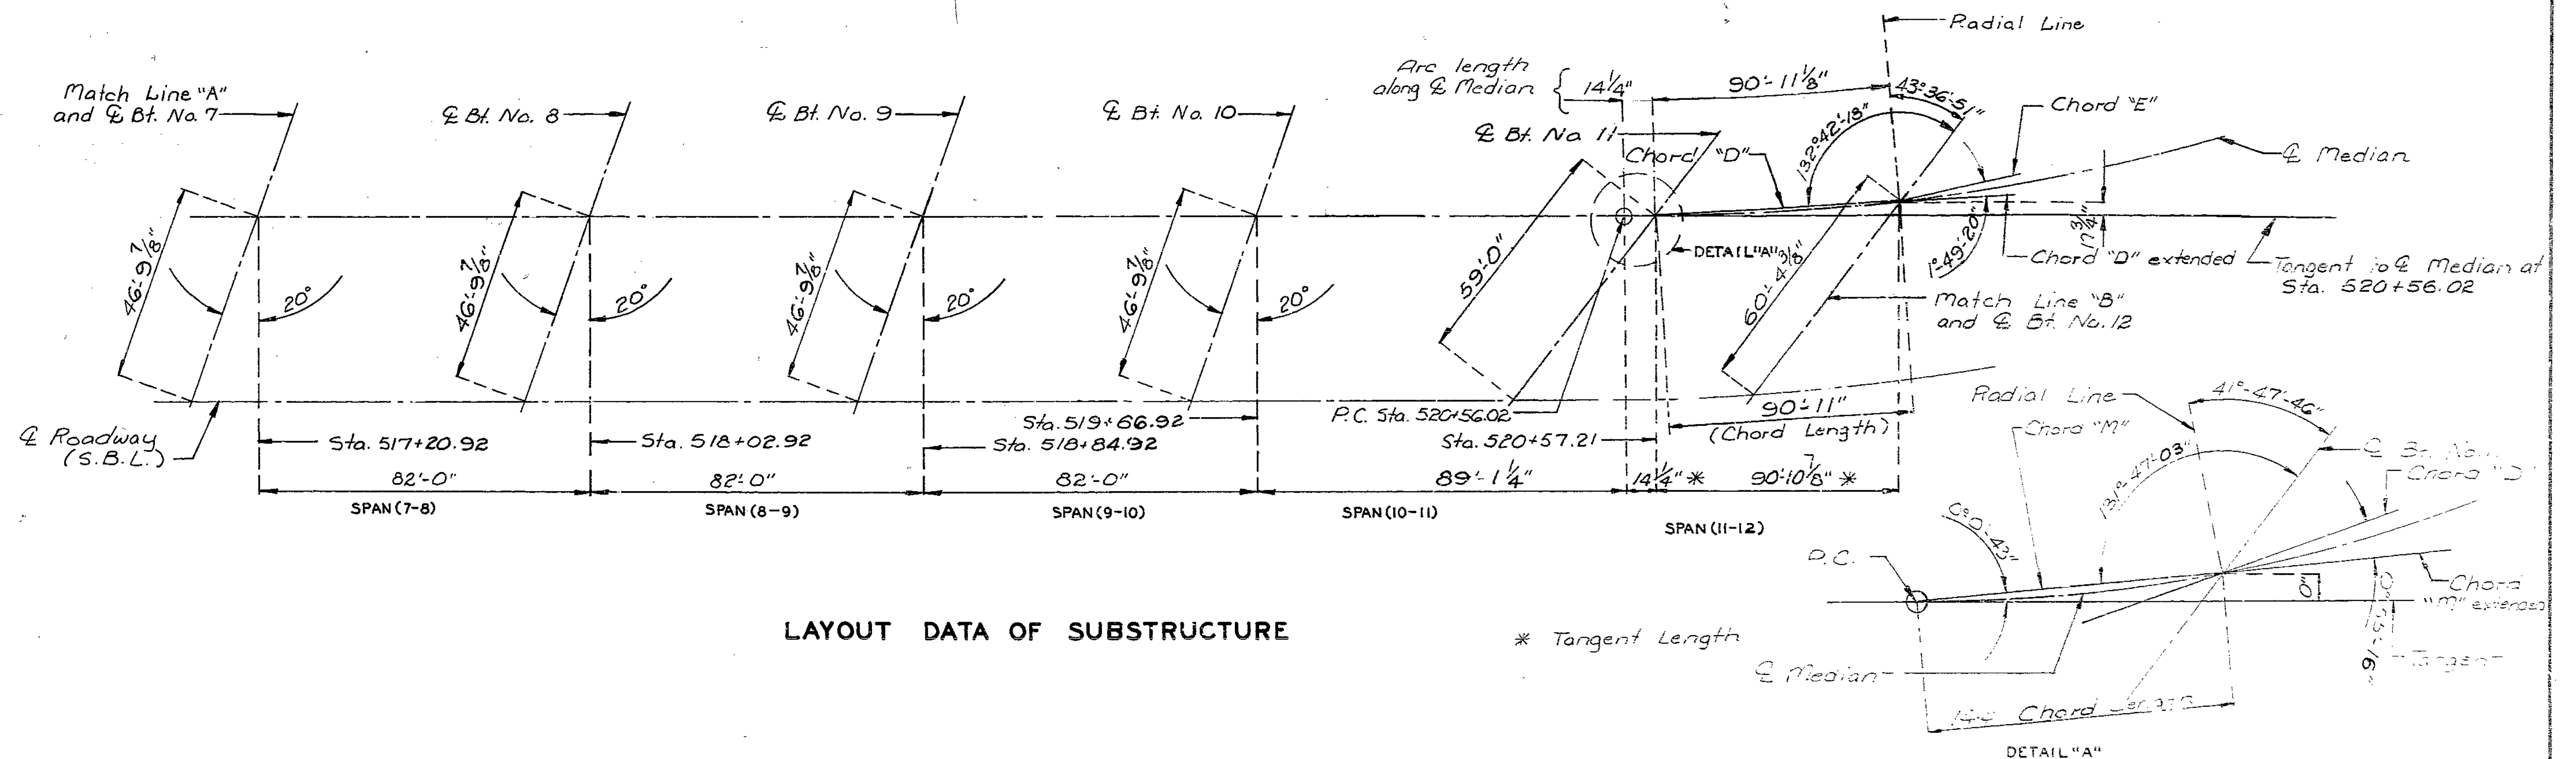

LAYOUT DATA OF SUBSTRUCTURE

\* Tangent Length


DETAILED March 1988  
CHECKED Aug. 1988

Note: This drawing is not to scale. Follow dimensions.

Sheet No. 12 of 55.

Note: All dimensions are horizontal.

STATE	PROJ. NO.	SHEET NO.
MO.		68

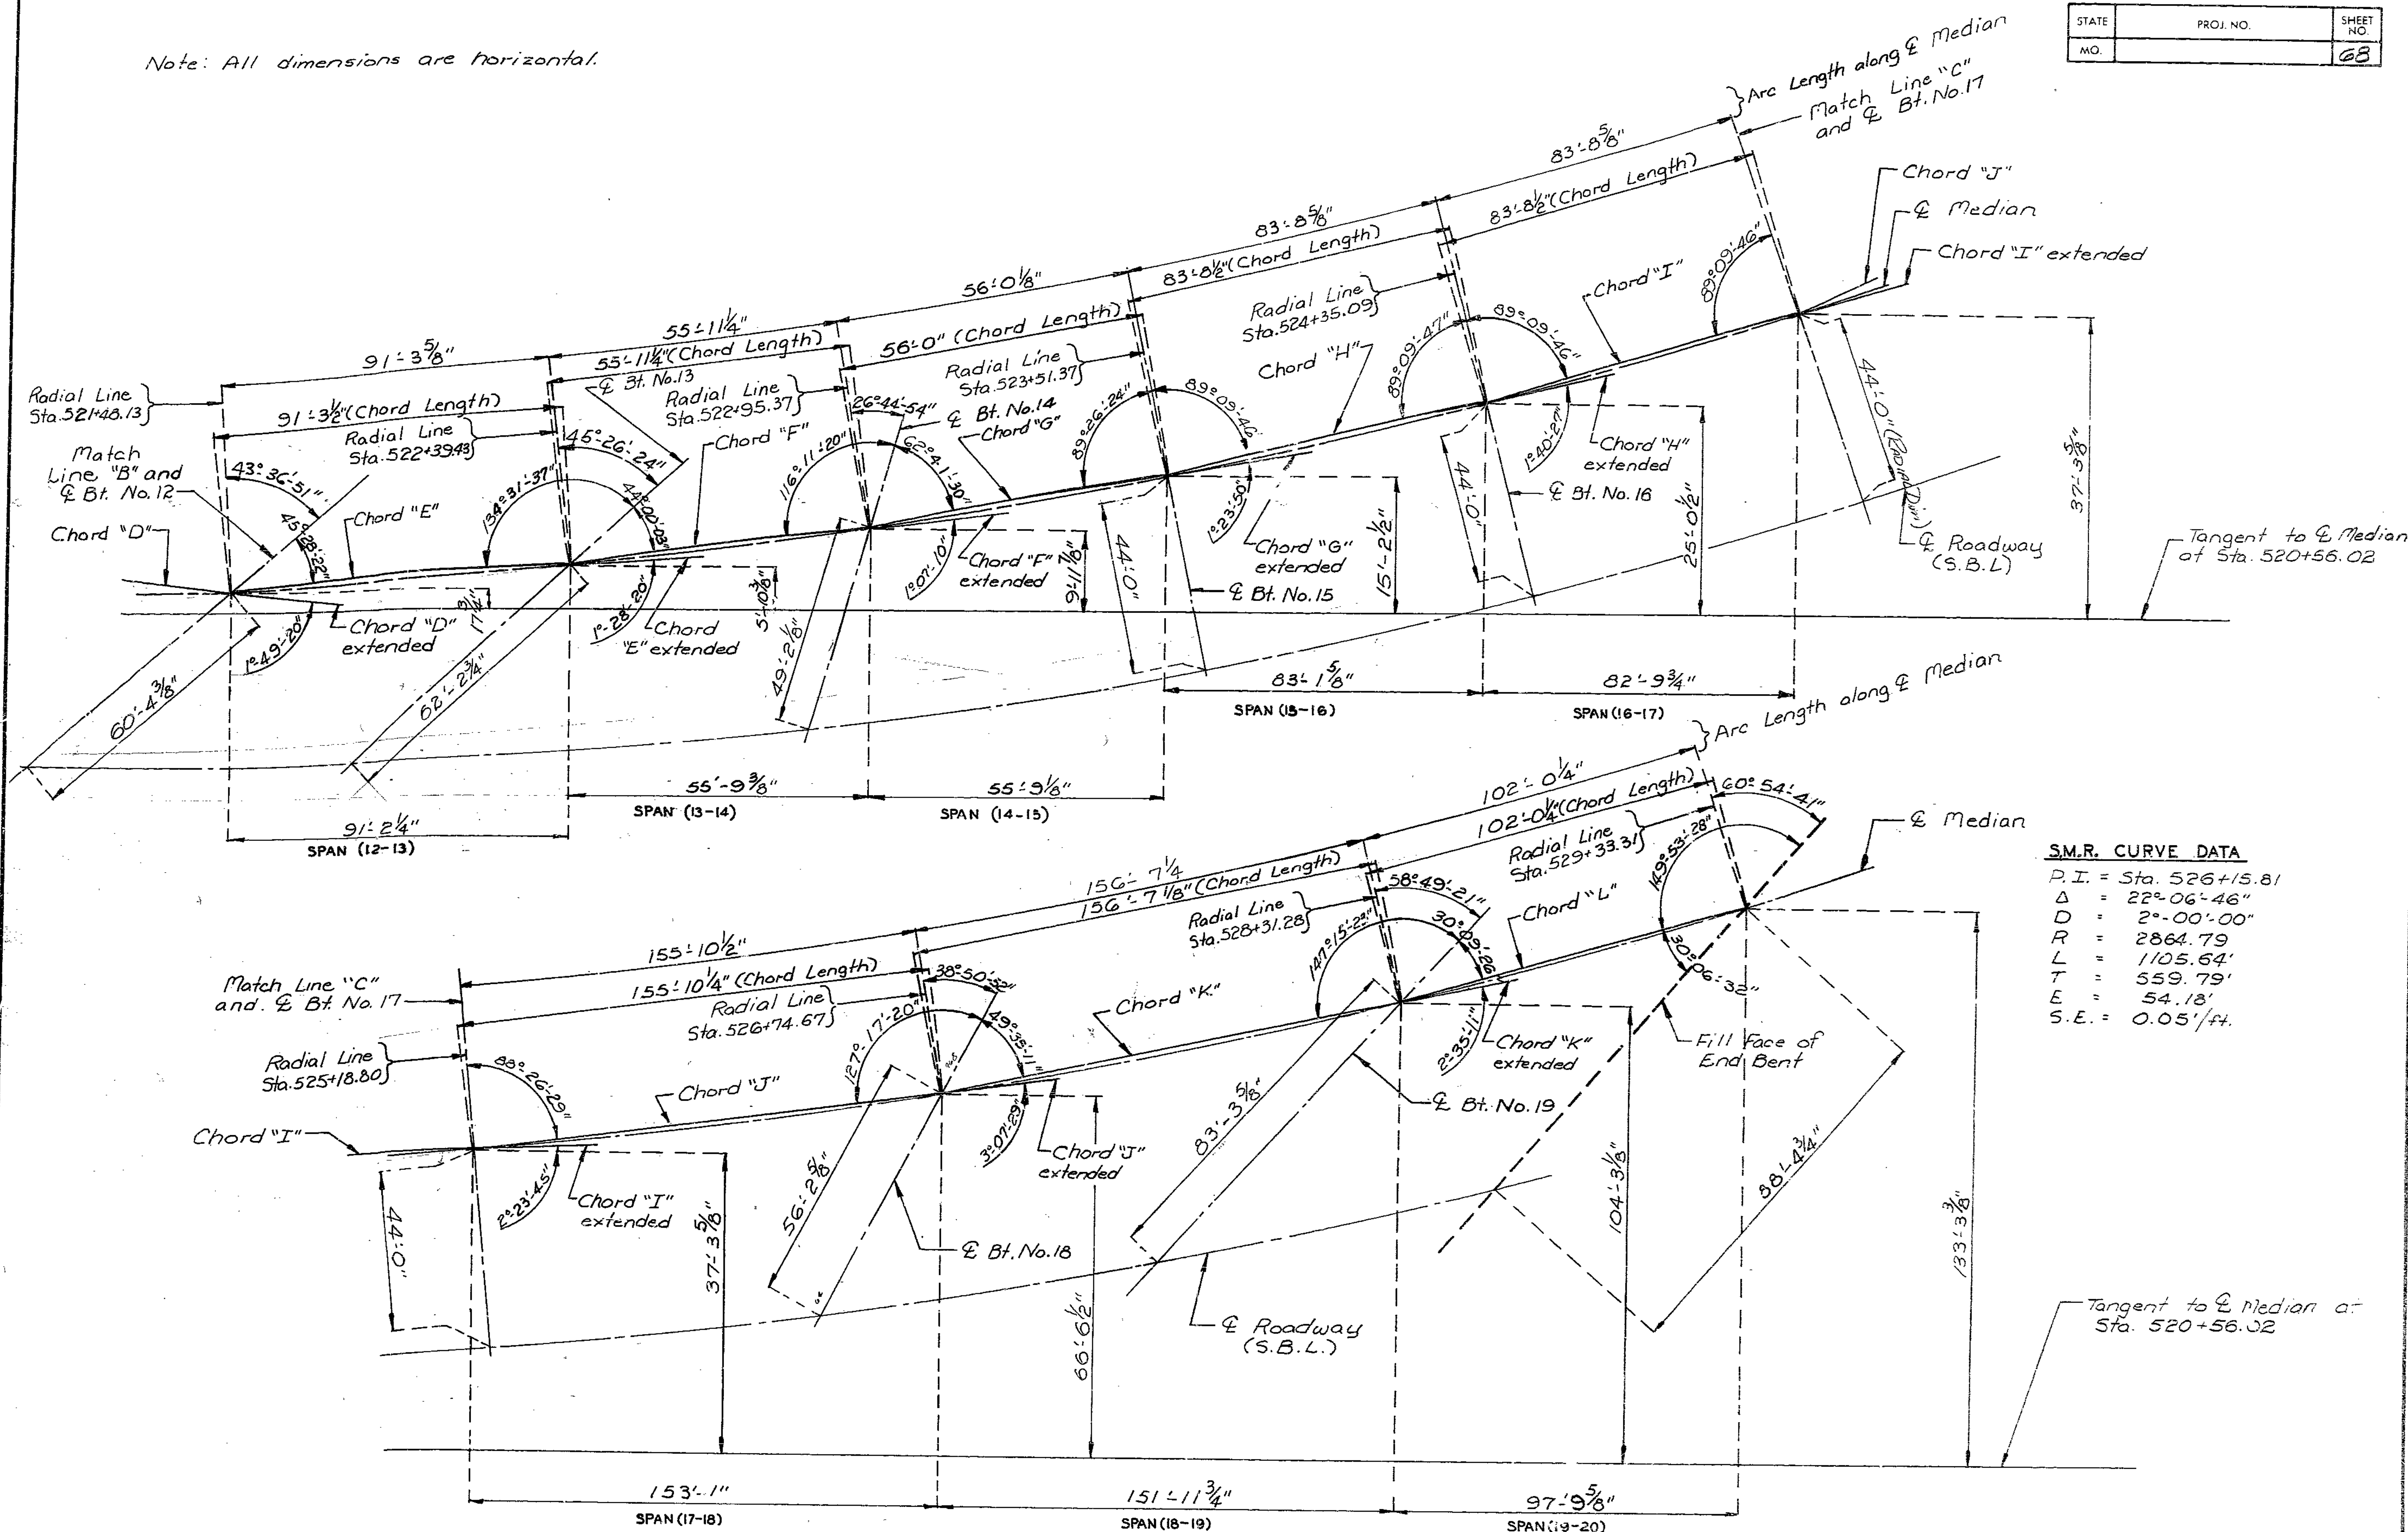

**S.M.R. CURVE DATA**

P.I.	= Sta. 526+15.81
Δ	= 22°-06'-46"
D	= 2°-00'-00"
R	= 2864.79
L	= 1105.64'
T	= 559.79'
E	= 54.18'
S.E.	= 0.05'/ft.

209 383

DETAILED March 1988  
CHECKED Aug. 1988

Note: This drawing is not to scale. Follow dimensions.



LAYOUT DATA OF SUBSTRUCTURE

Sheet No. 13 of 55

JACKSON COUNTY

A-2745

STATE	P.O.J. NO.	SHEET NO.
MO.		69


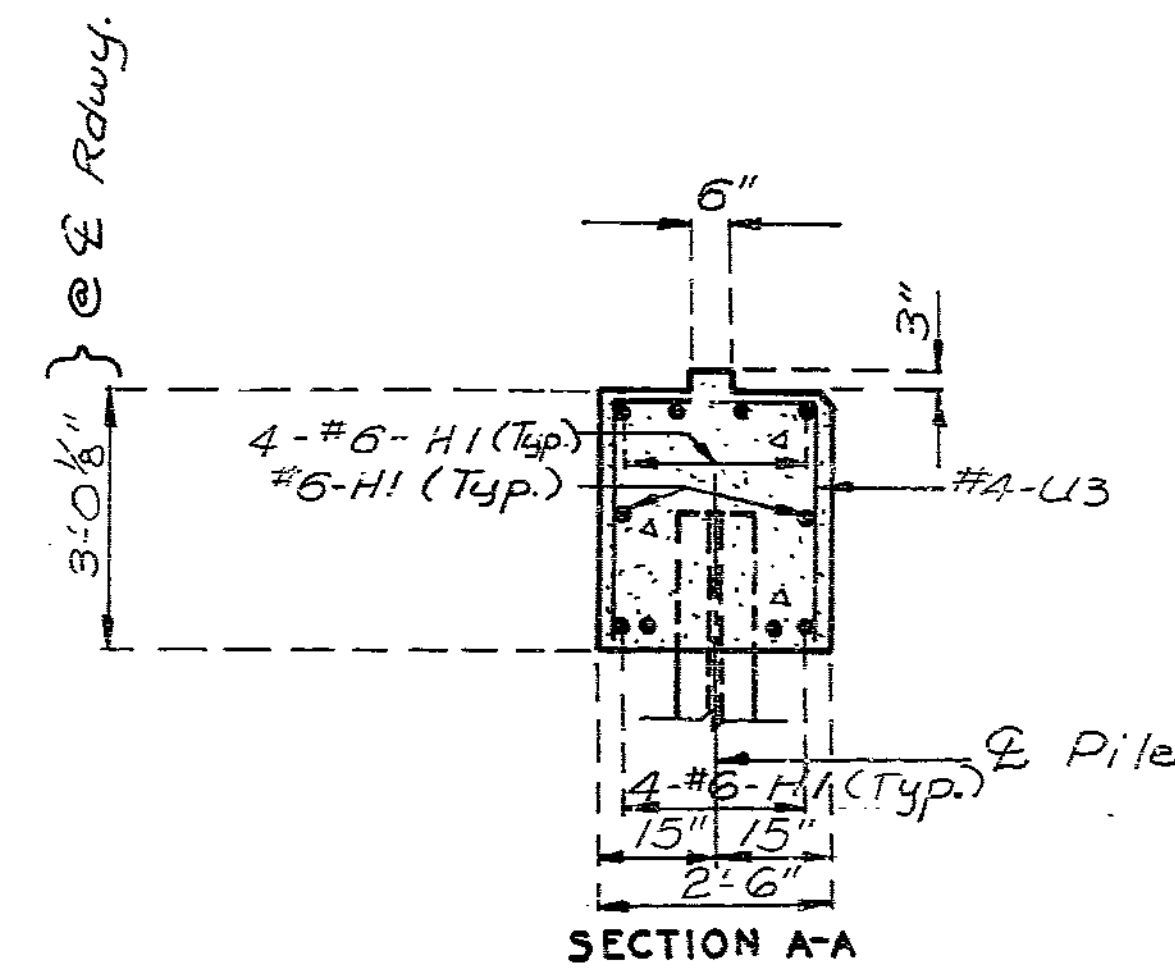
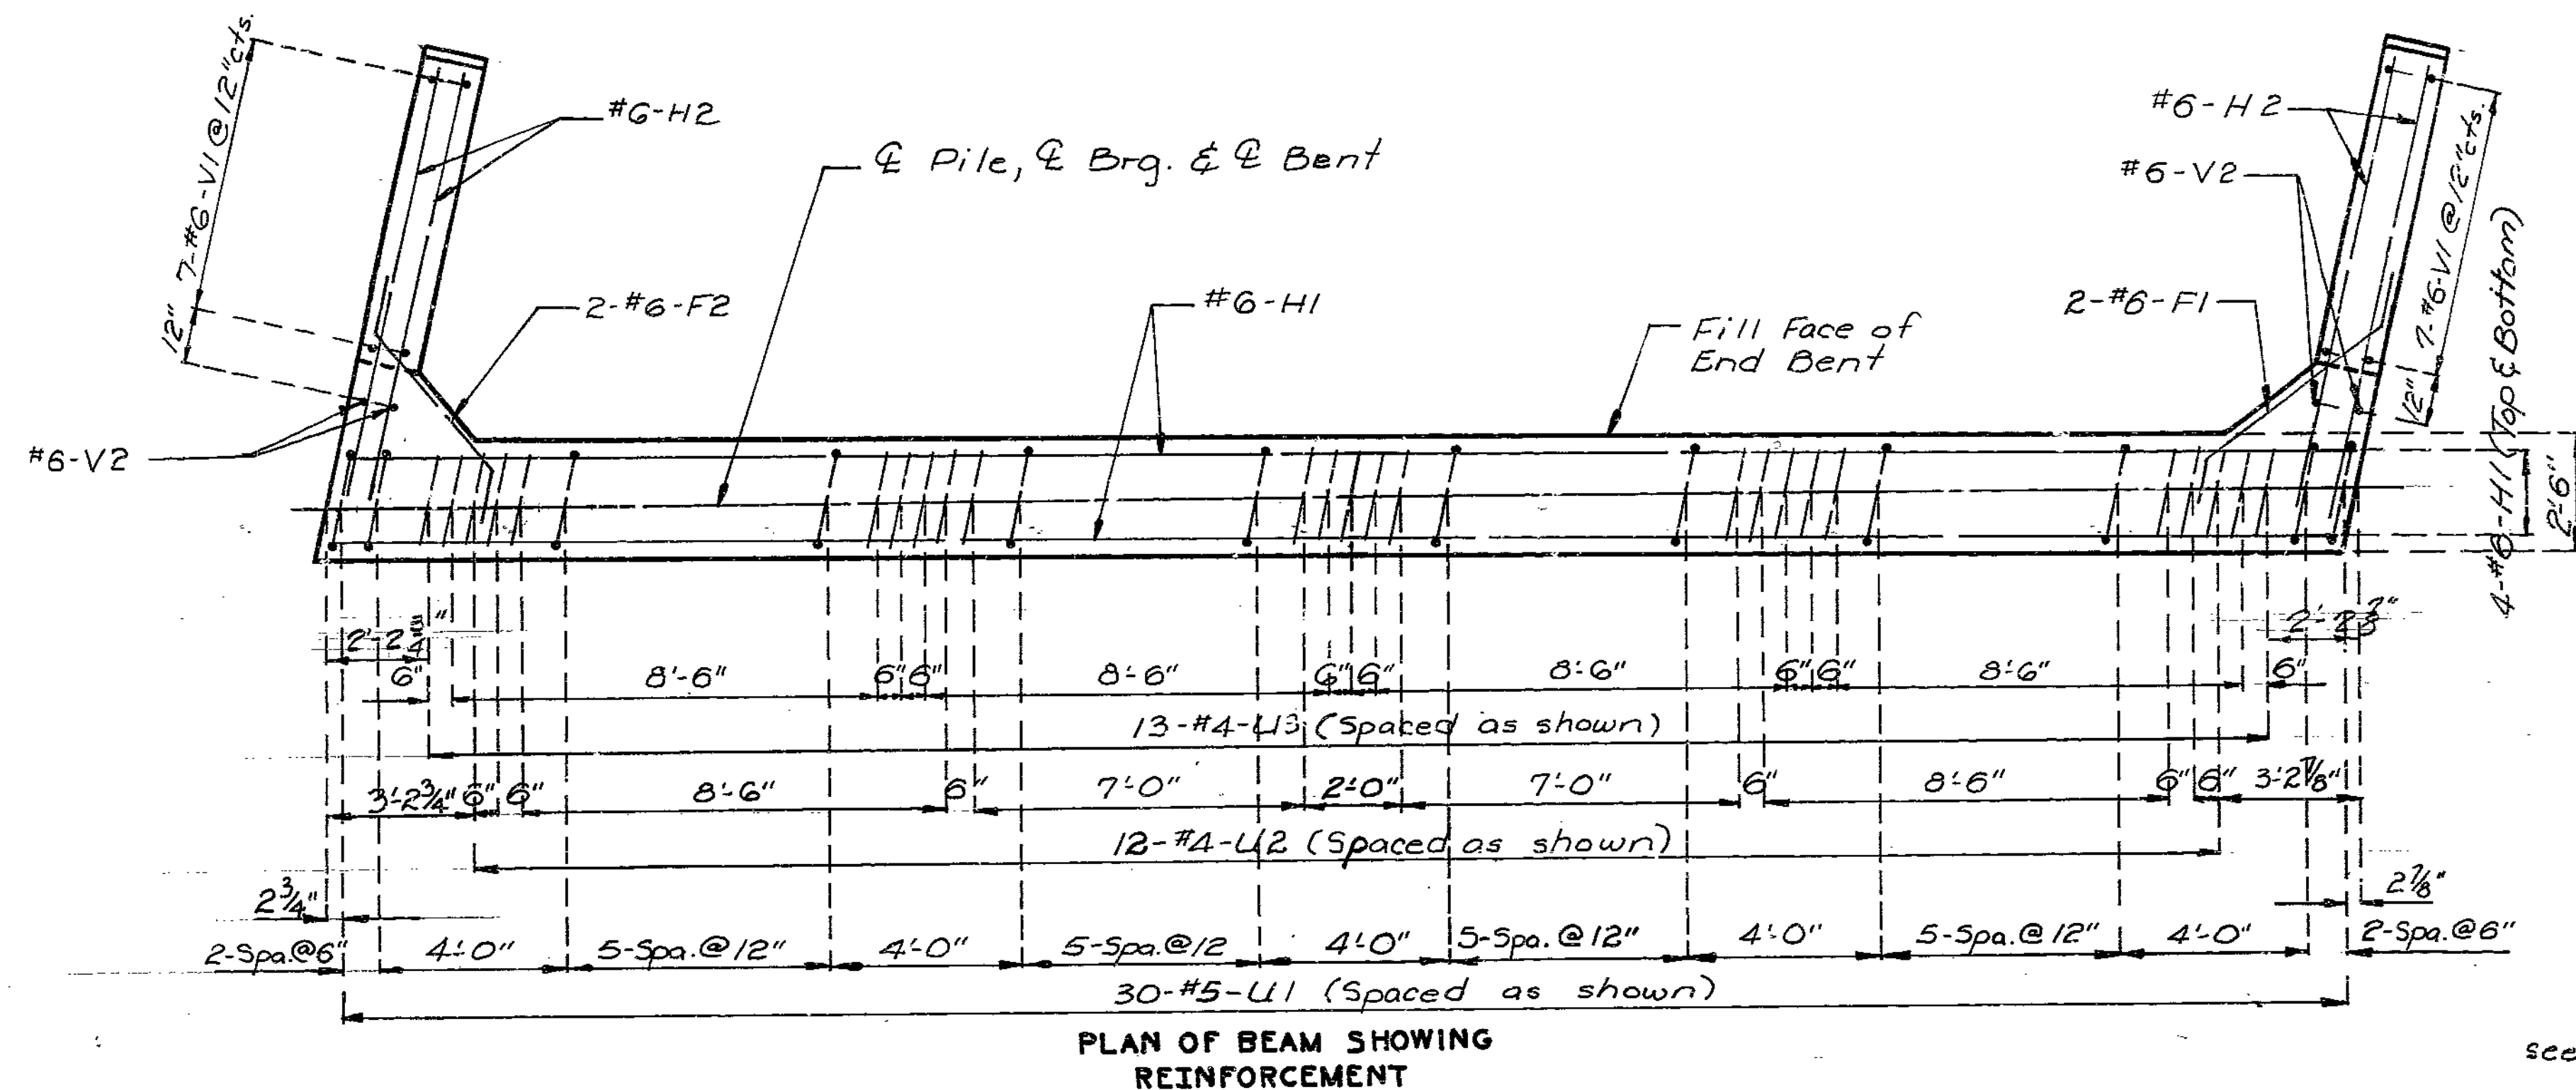


Note: For Elev. E-E & F-F see sheet No. 15.

Note: For location of Sections A-A, B-B and C-C, see sheet No. 15.

\*Jt. Filler & Bearings are in Future Construction.

218 324

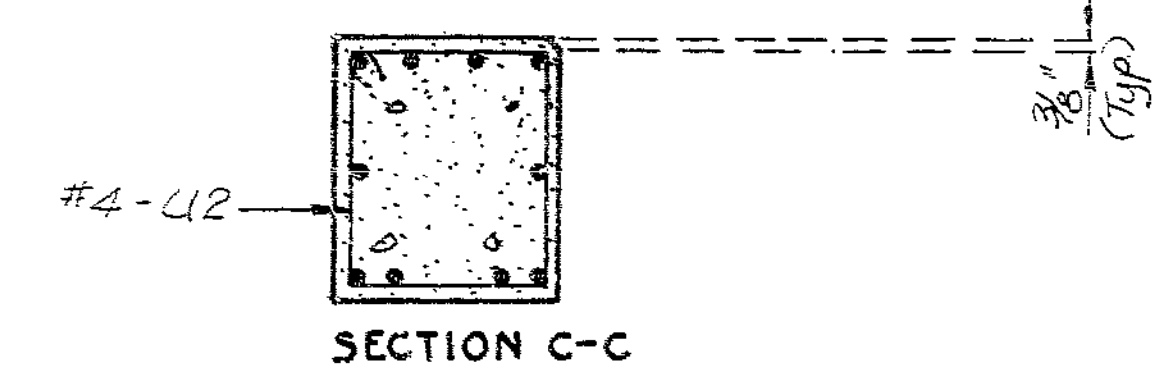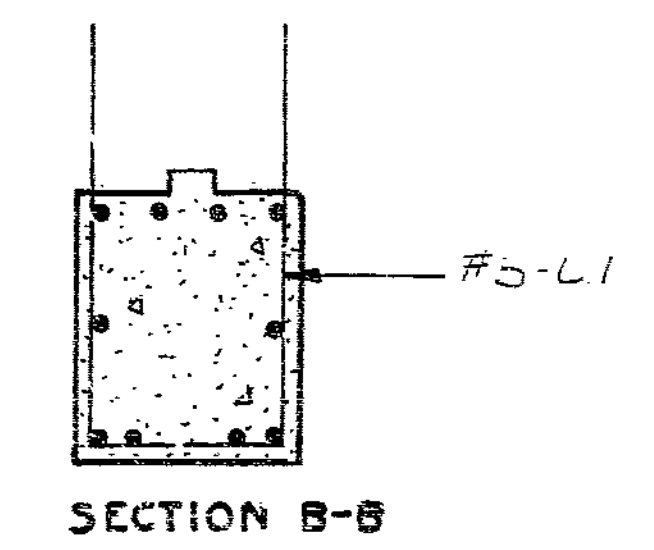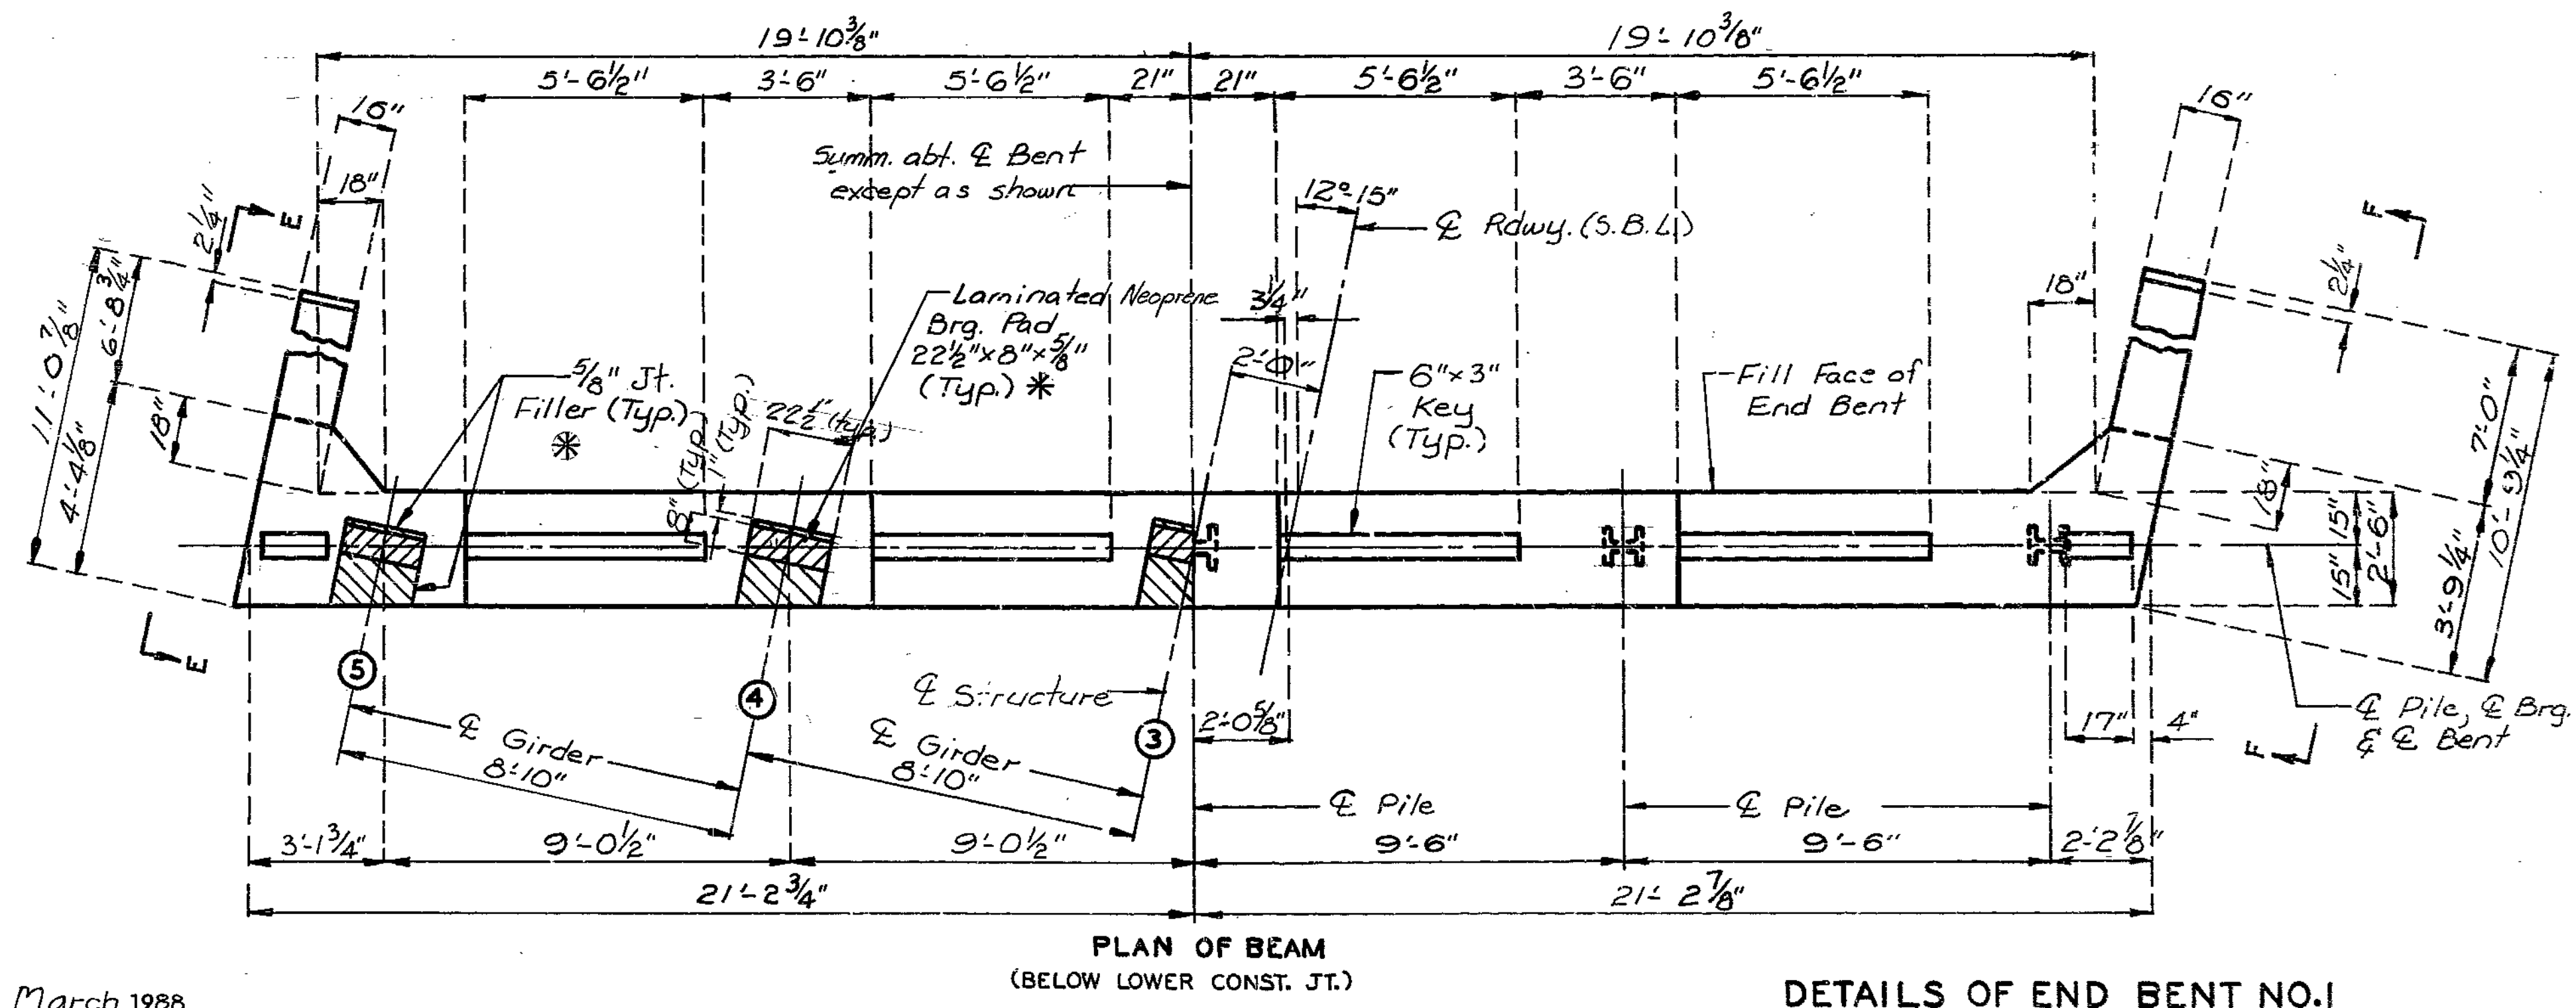

DETAILED March 1988  
CHECKED Aug. 1988

Note: This drawing is not to scale. Follow dimensions.


DETAILS OF END BENT NO.1

Sheet No. 14 of 55

JACKSON COUNTY

A-2745





STATE	PROJ NO	SHEET NO
MO		70

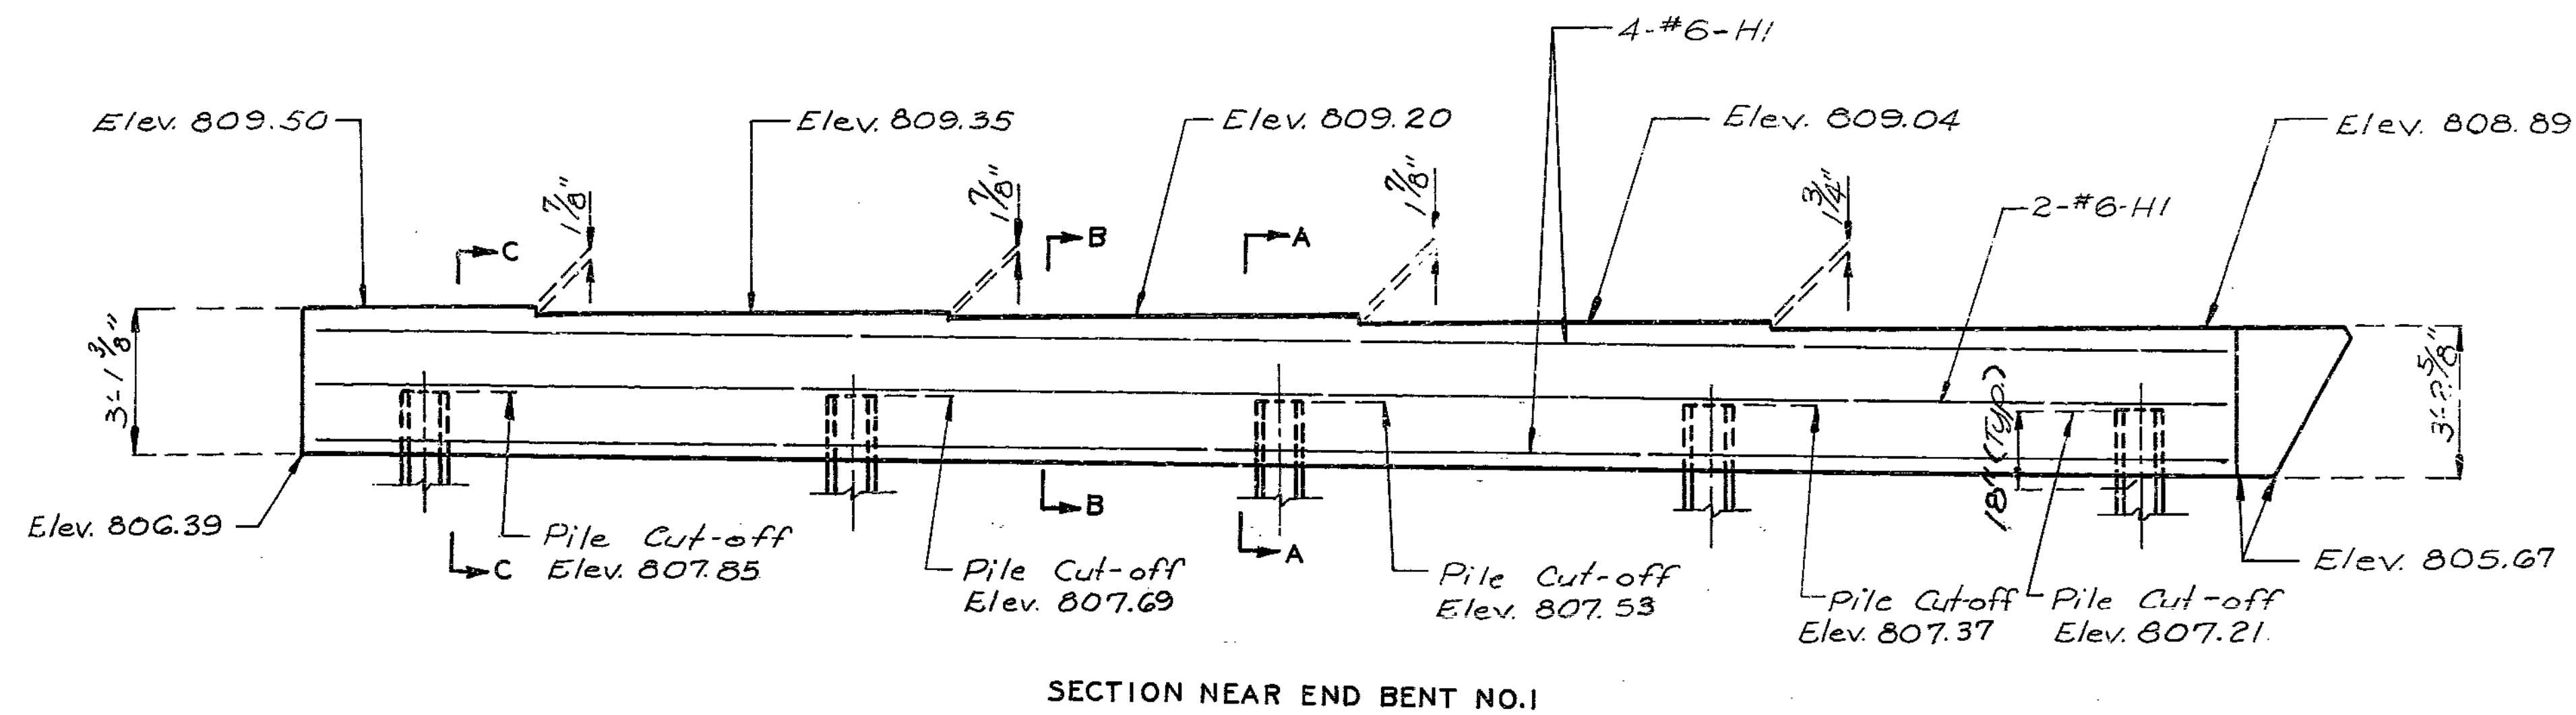

Note: For details of pile splice see sheet No. 9.

Note: For Sections A-A, B-B & C-C, see sheet No. 14.

211 325

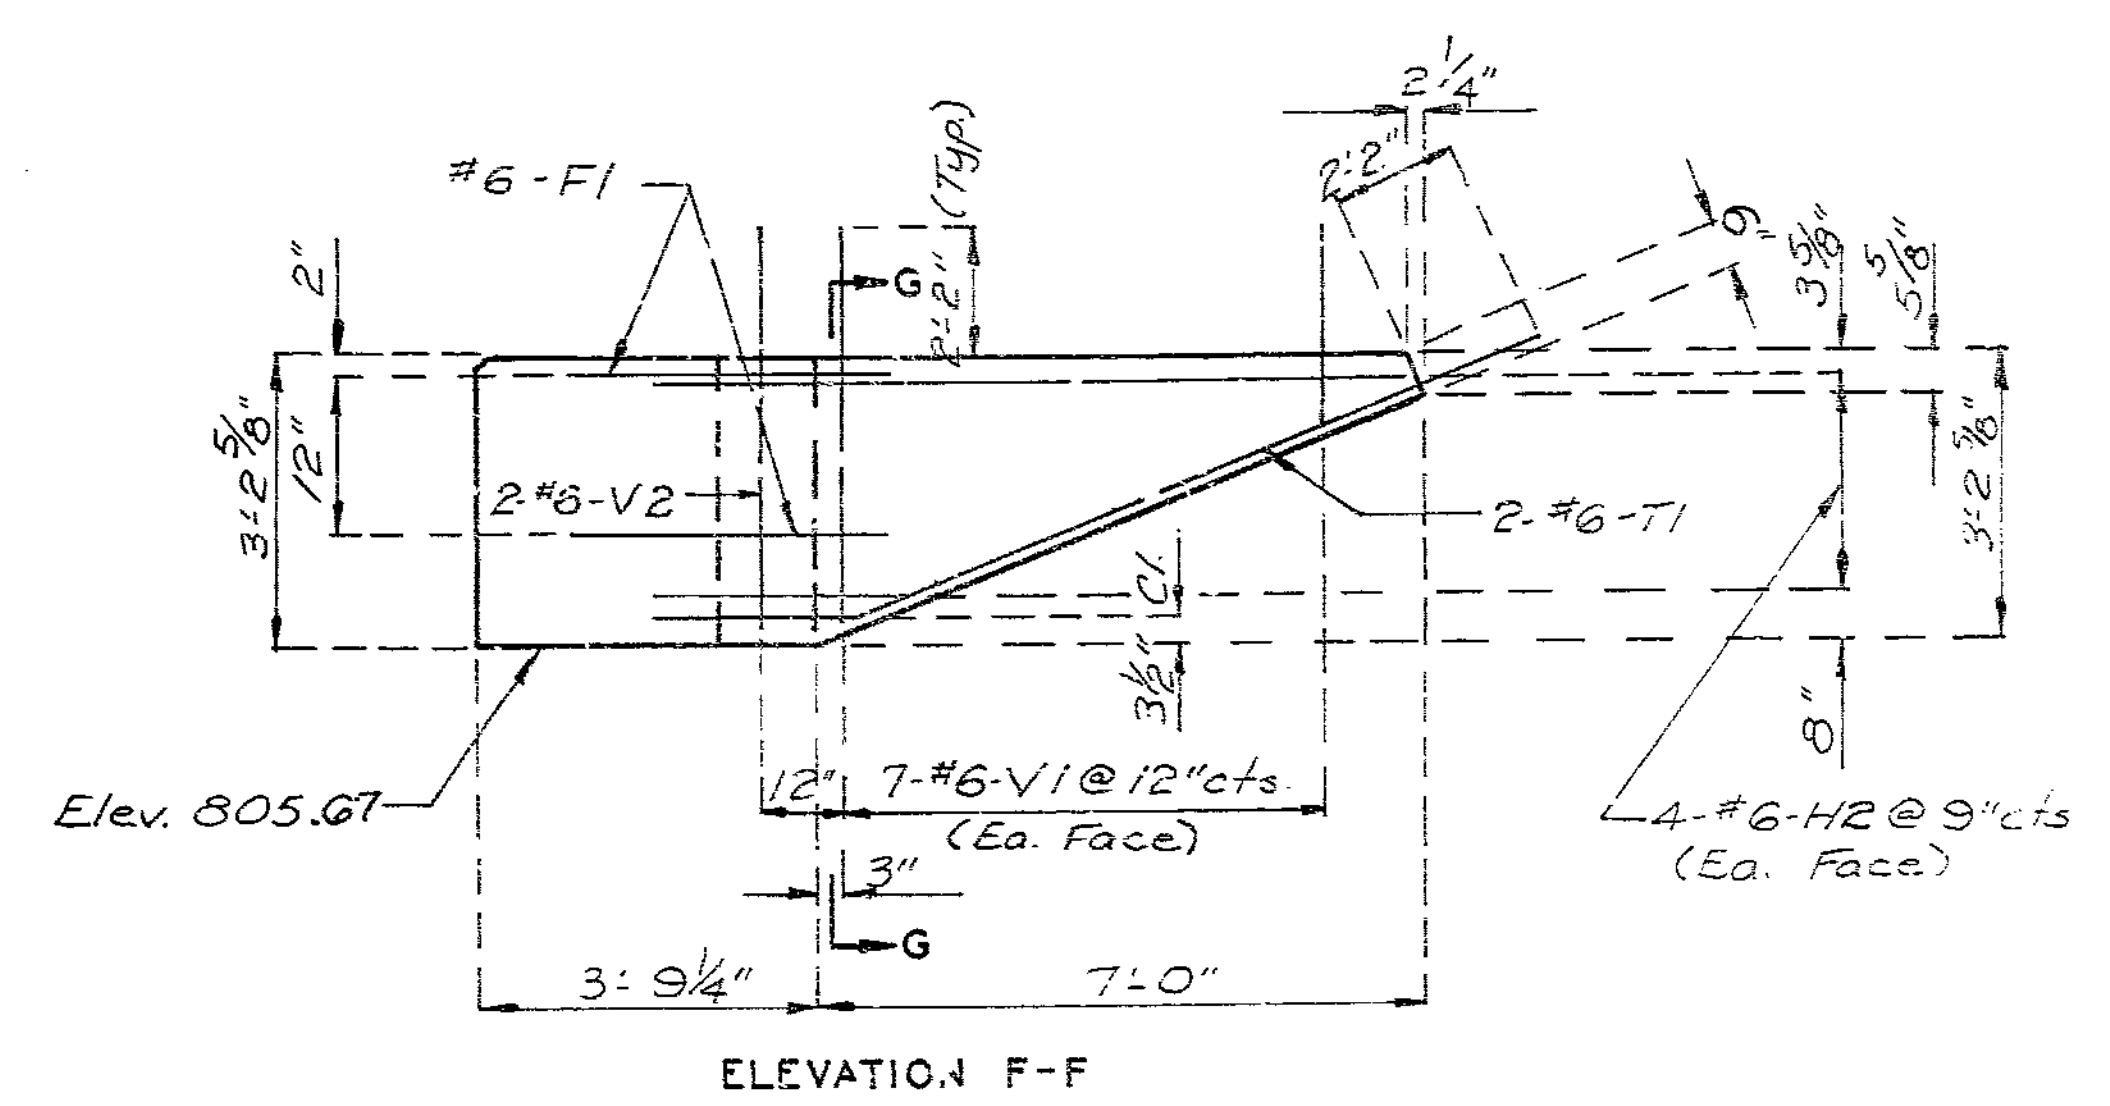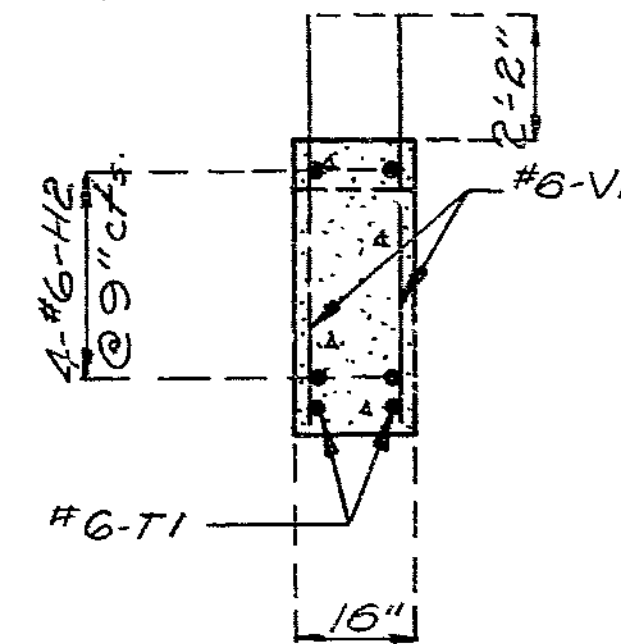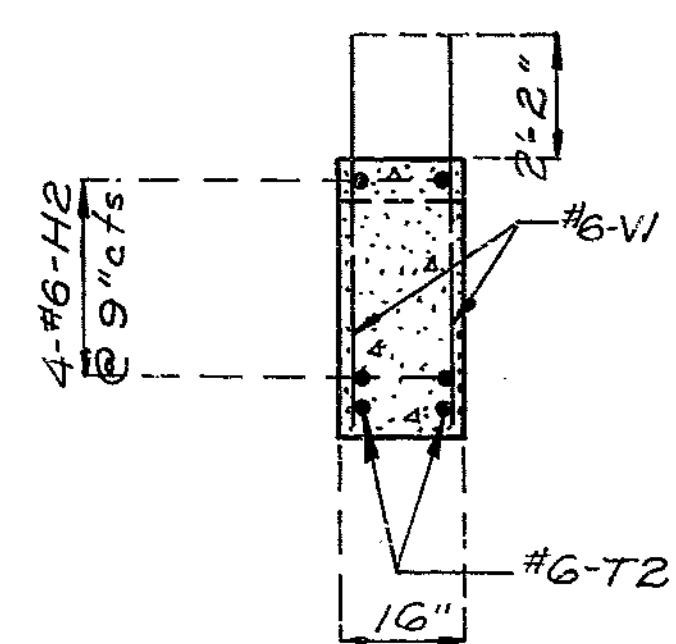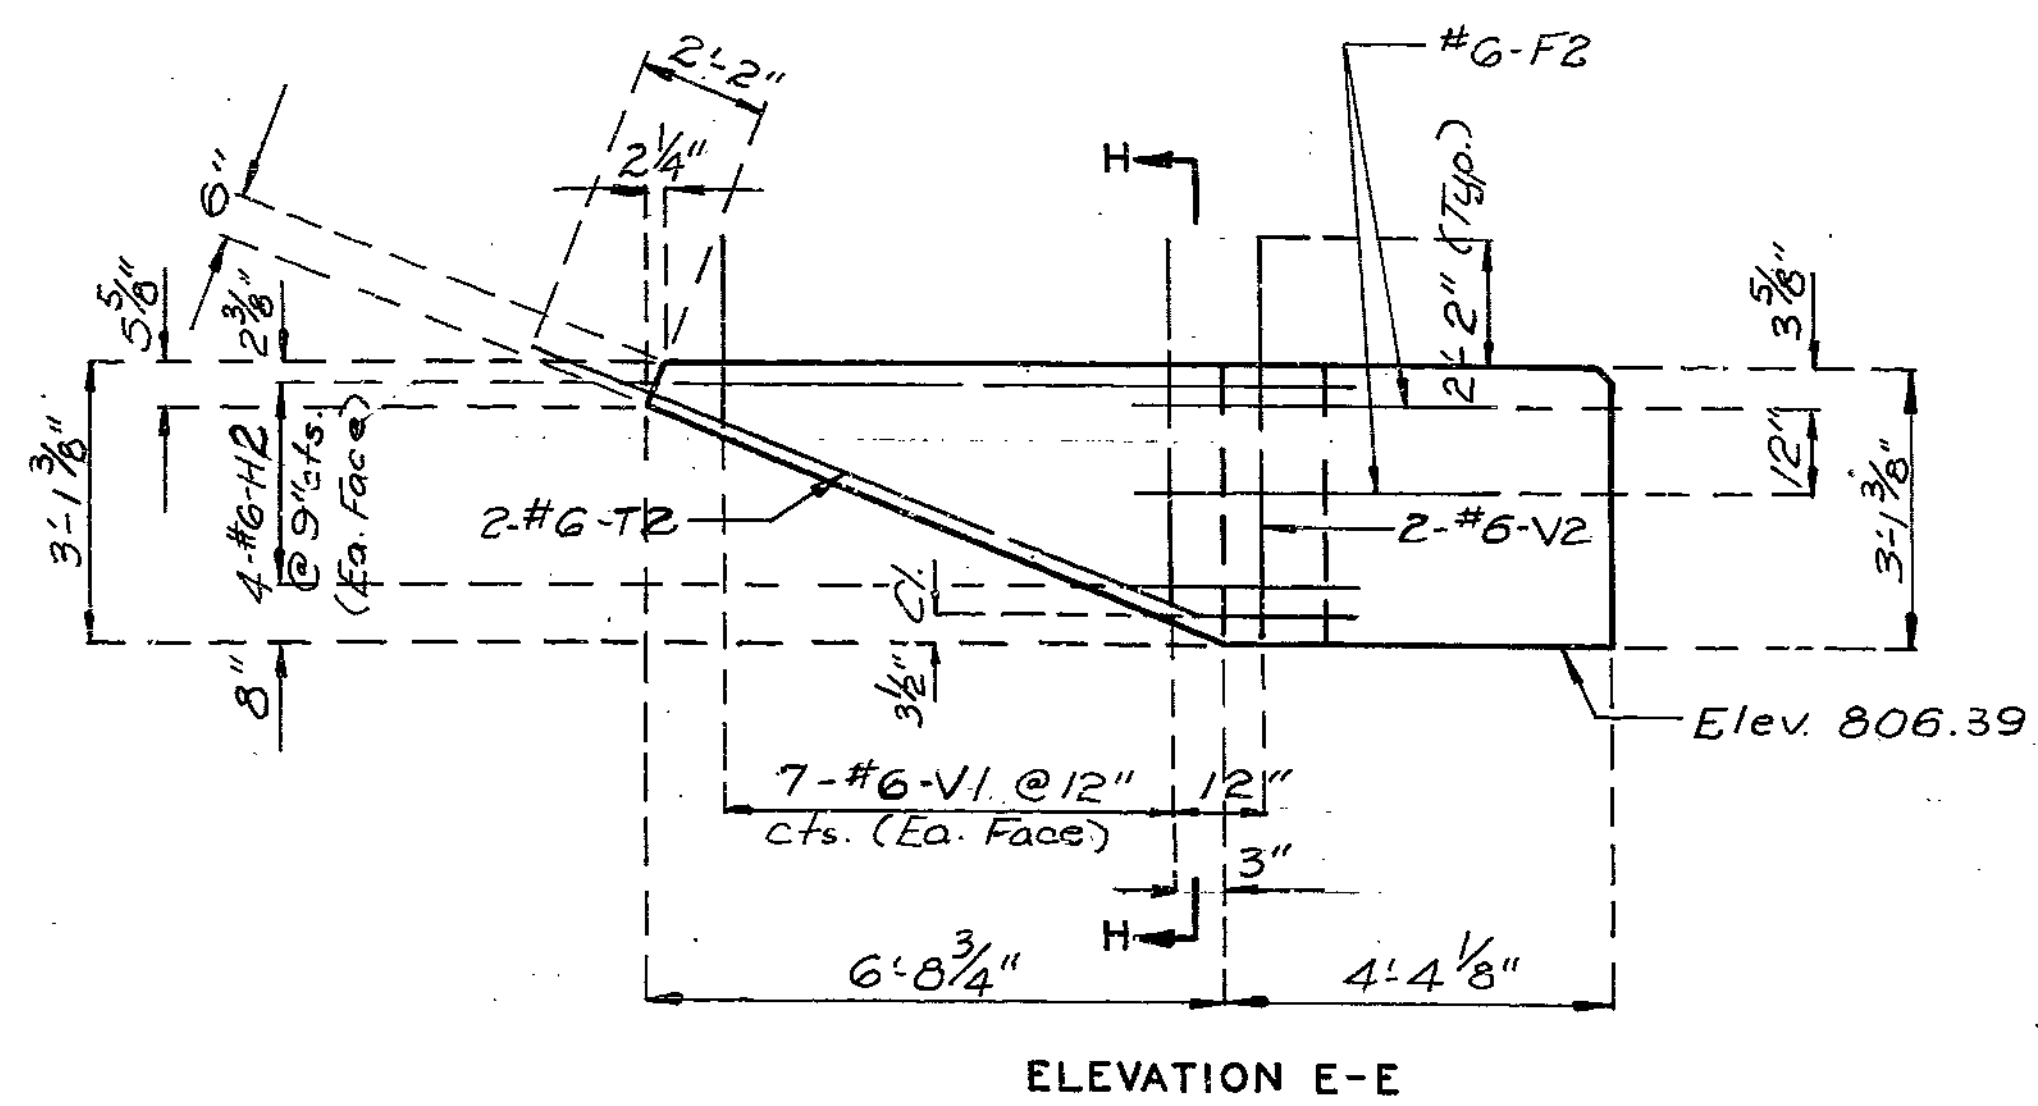

DETAILS OF END BENT NO. 1

Note: For location of Elev. E-E & F-F see sheet No. 14.

DETAILED Aug. 1988  
CHECKED Aug. 1988


Note: This drawing is not to scale. Follow dimensions.

Sheet No. 15 of 55

JACKSON COUNTY

A-2745

STATE	PROJ. NO.	SHEET NO.
MO.		71

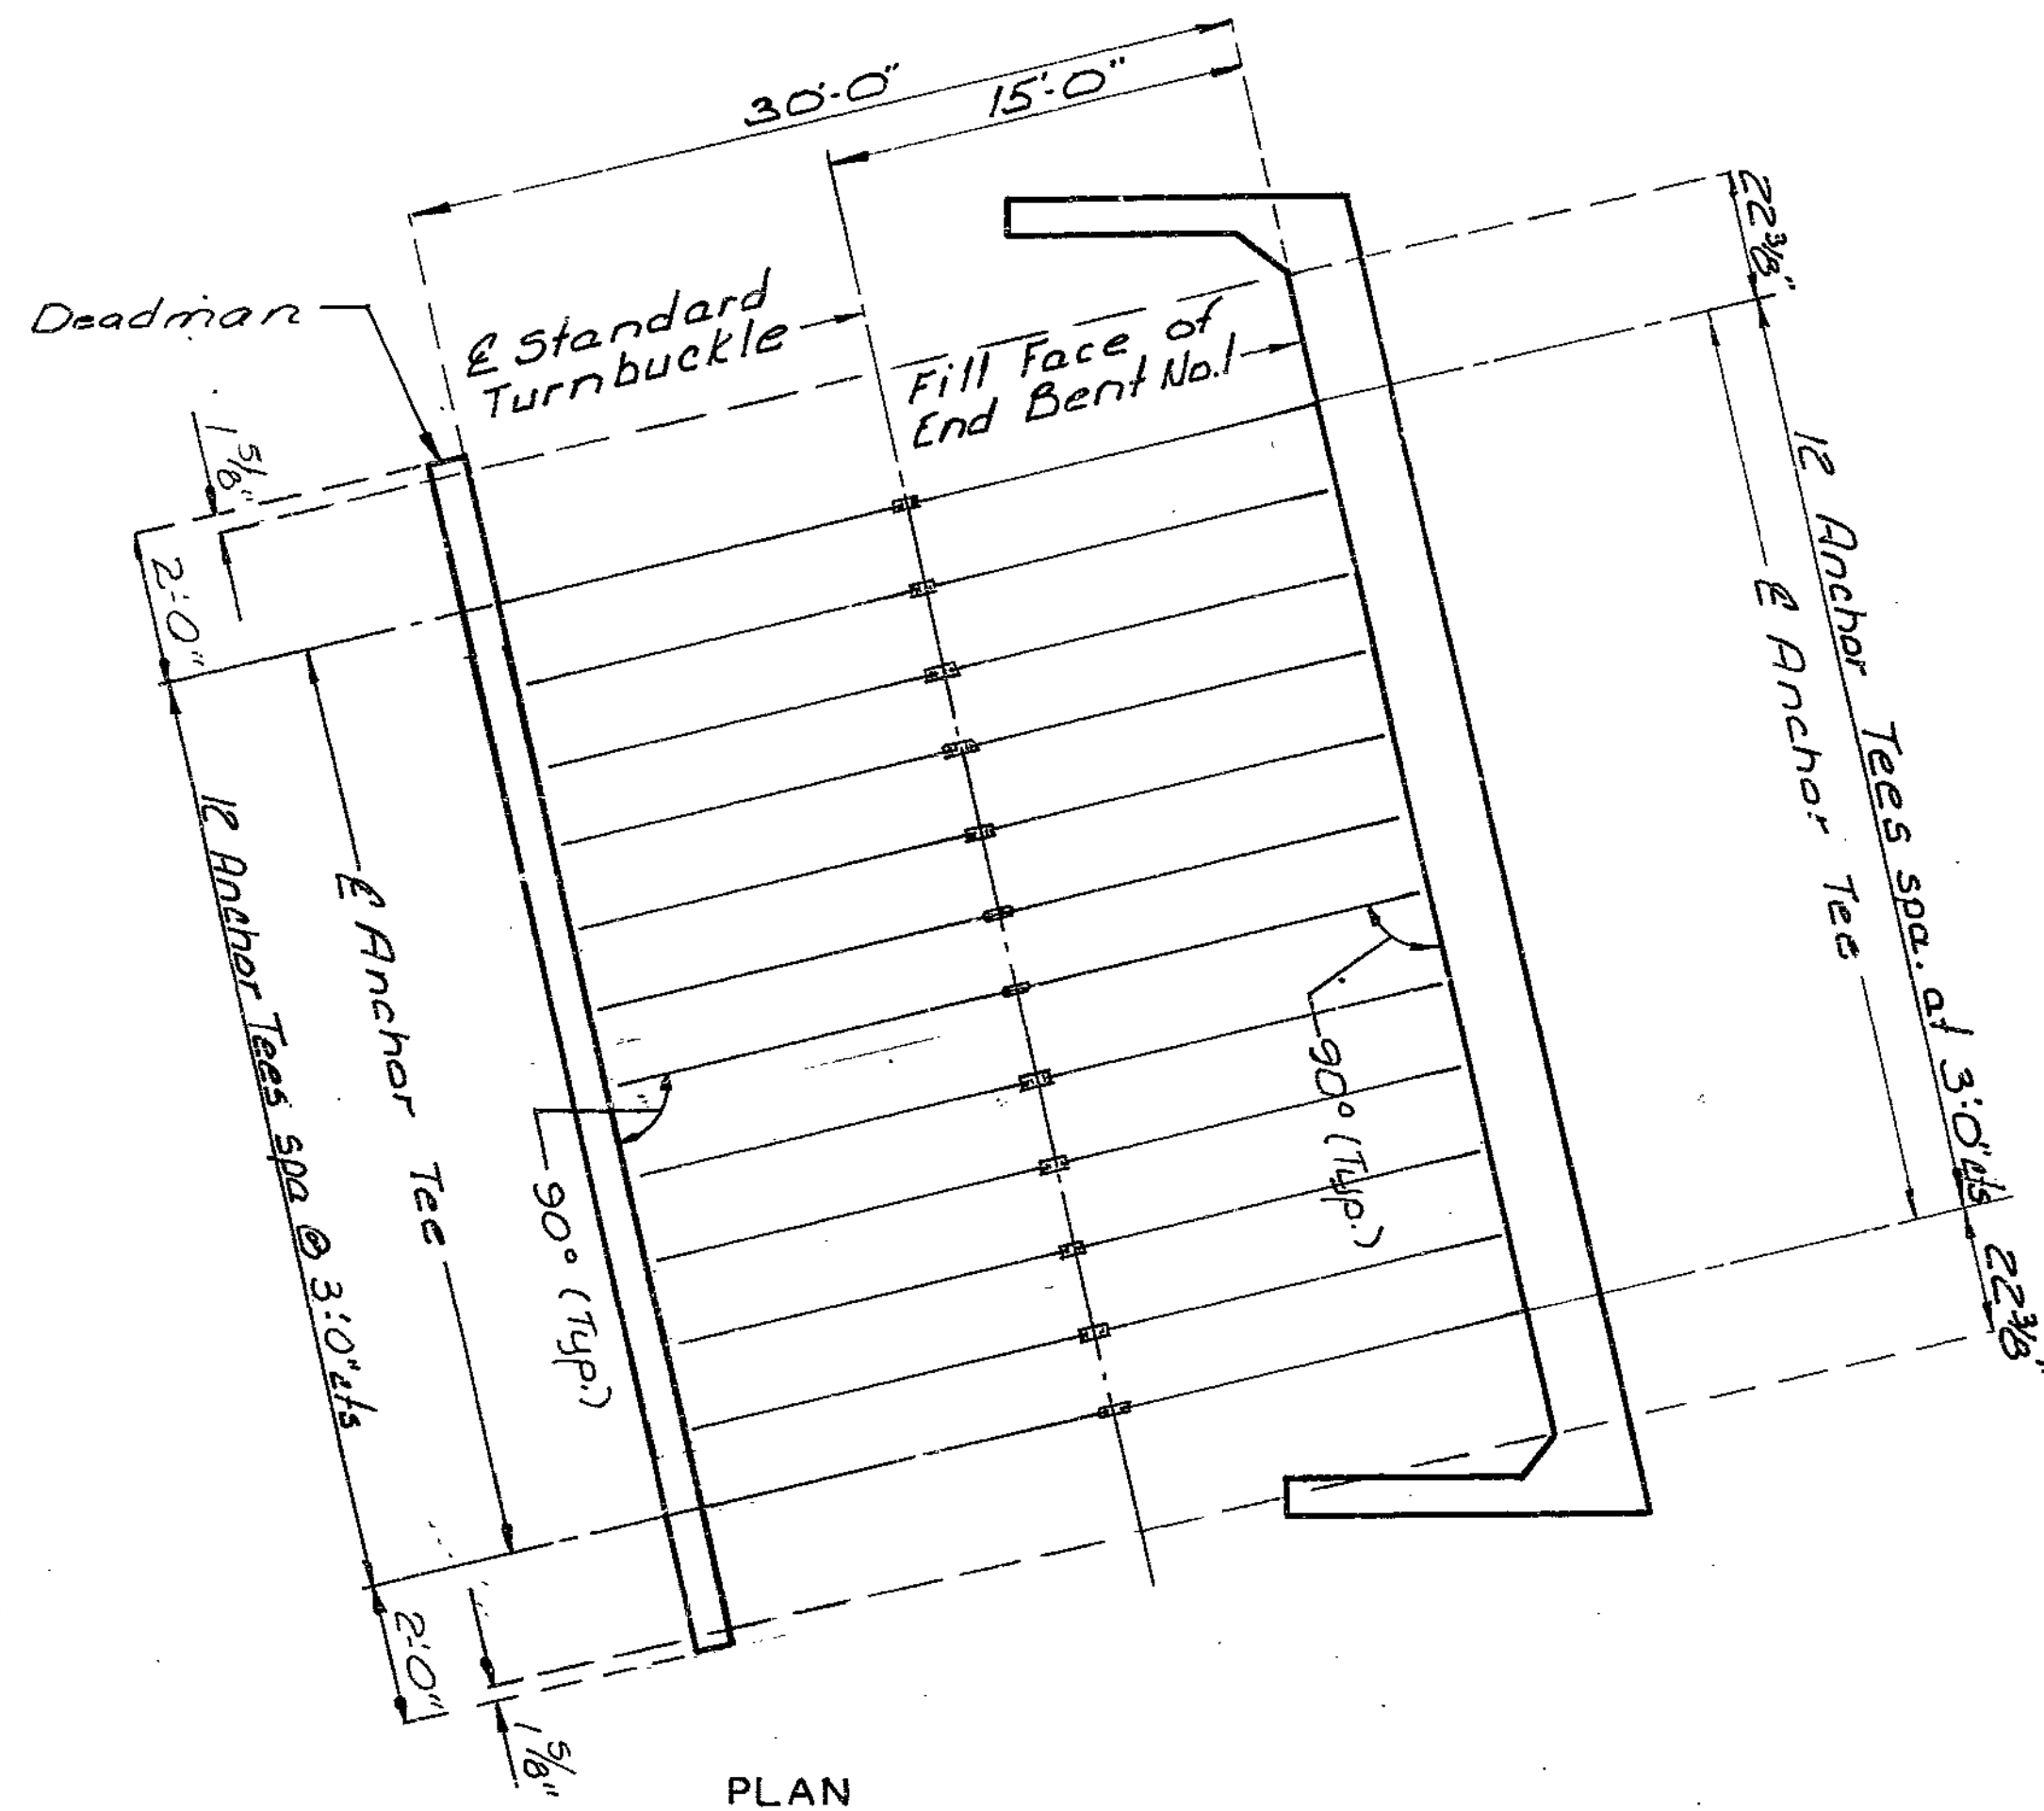


PLAN

NOTES:

CONSTRUCTION SEQUENCE:


- CONSTRUCT END BENT WITH ANCHOR TEES IN PLACE. MACHINE COMPACT FILL UP TO ELEVATION OF 7/8"Ø ROD AND TURNBUCKLE.
- CONSTRUCT DEADMAN WITH ANCHOR TEES IN PLACE. INSTALL 7/8"Ø ROD, CLEVIS AND TURNBUCKLE ASSEMBLY. TIGHTEN TURNBUCKLE UNTIL SNUG.
- HAND COMPACT FILL FOR 12" (MIN.) OVER 7/8"Ø ROD AND TURNBUCKLE.
- MACHINE COMPACT REMAINING FILL.

BILL OF REINFORCING STEEL FOR DEADMAN		
NUMBER	SIZE & MARK	LENGTH
8	#4-H3	36'-9"
148	#4-V3	21"

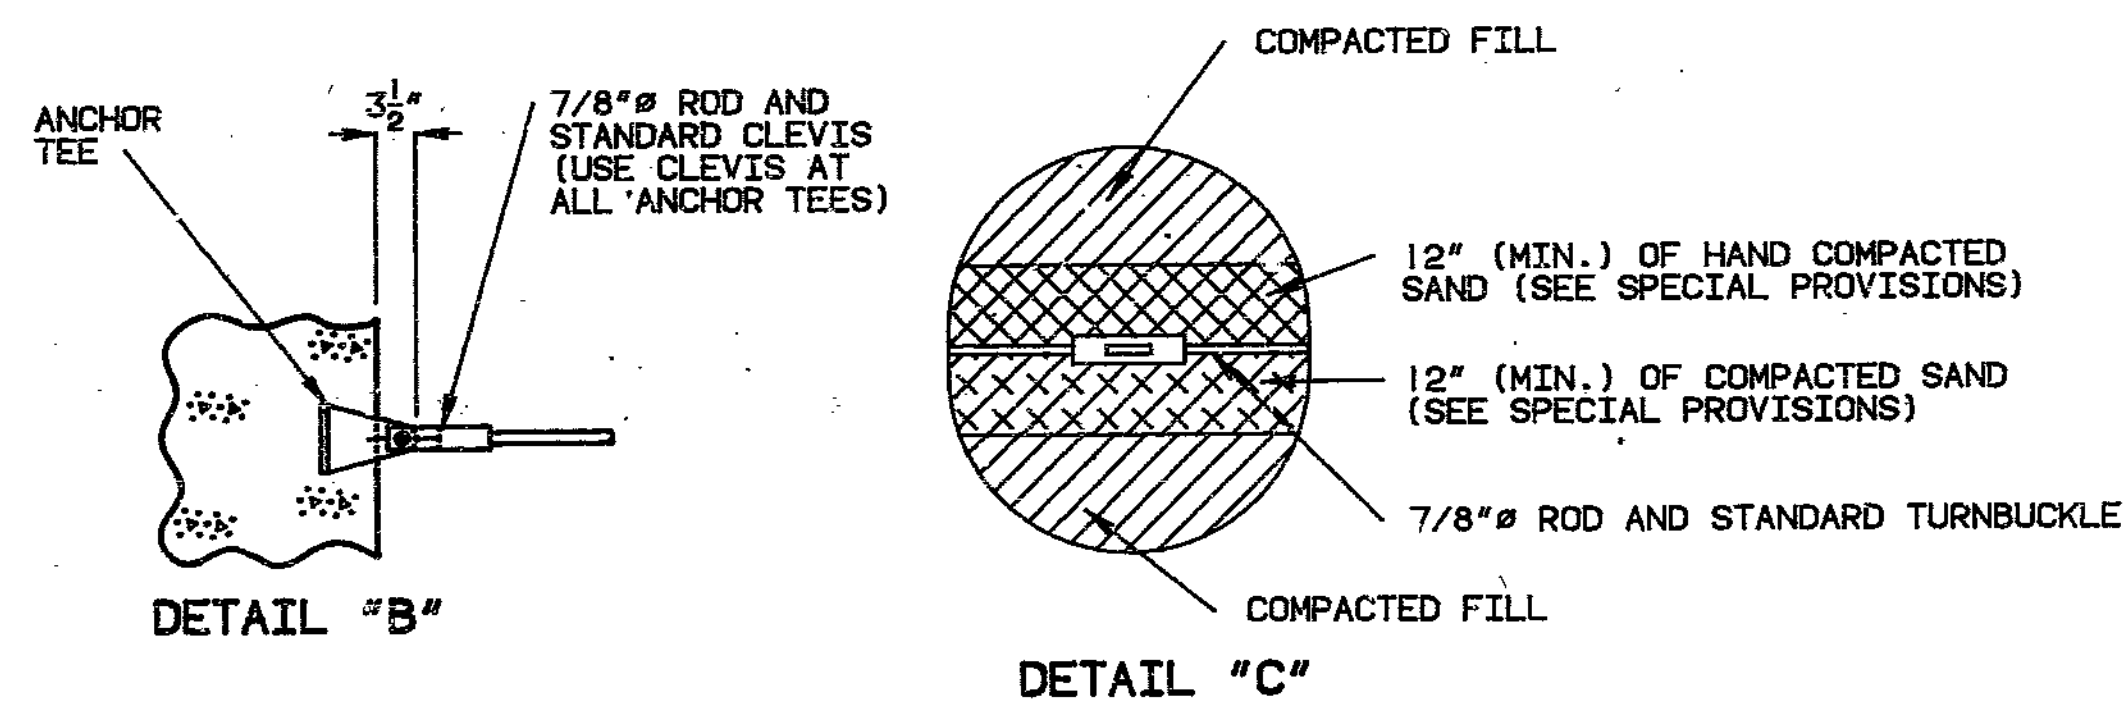


DETAIL "B"

DETAIL "C"

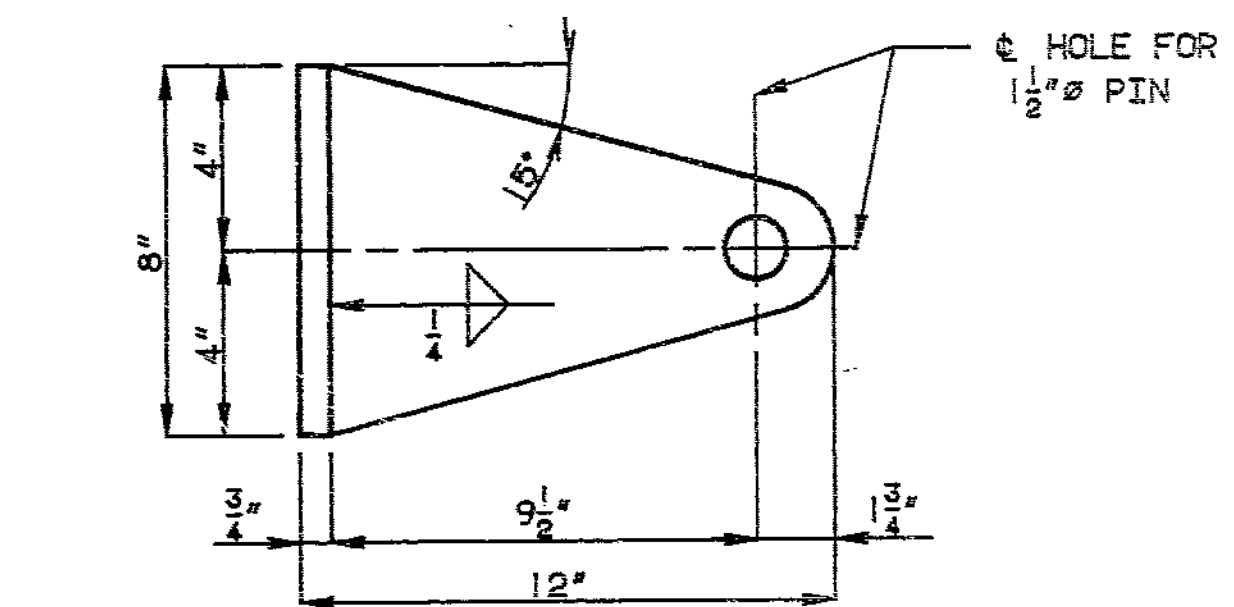


ELEVATION

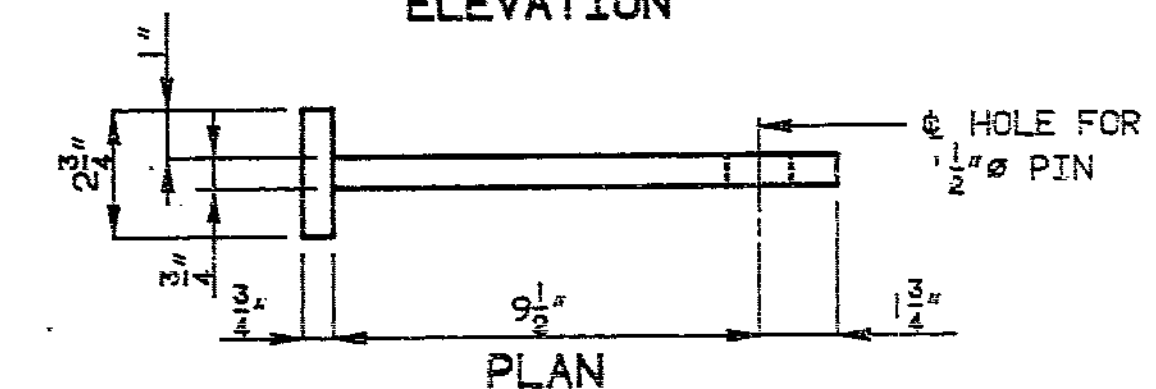


PLAN

DETAIL OF ANCHOR TEE

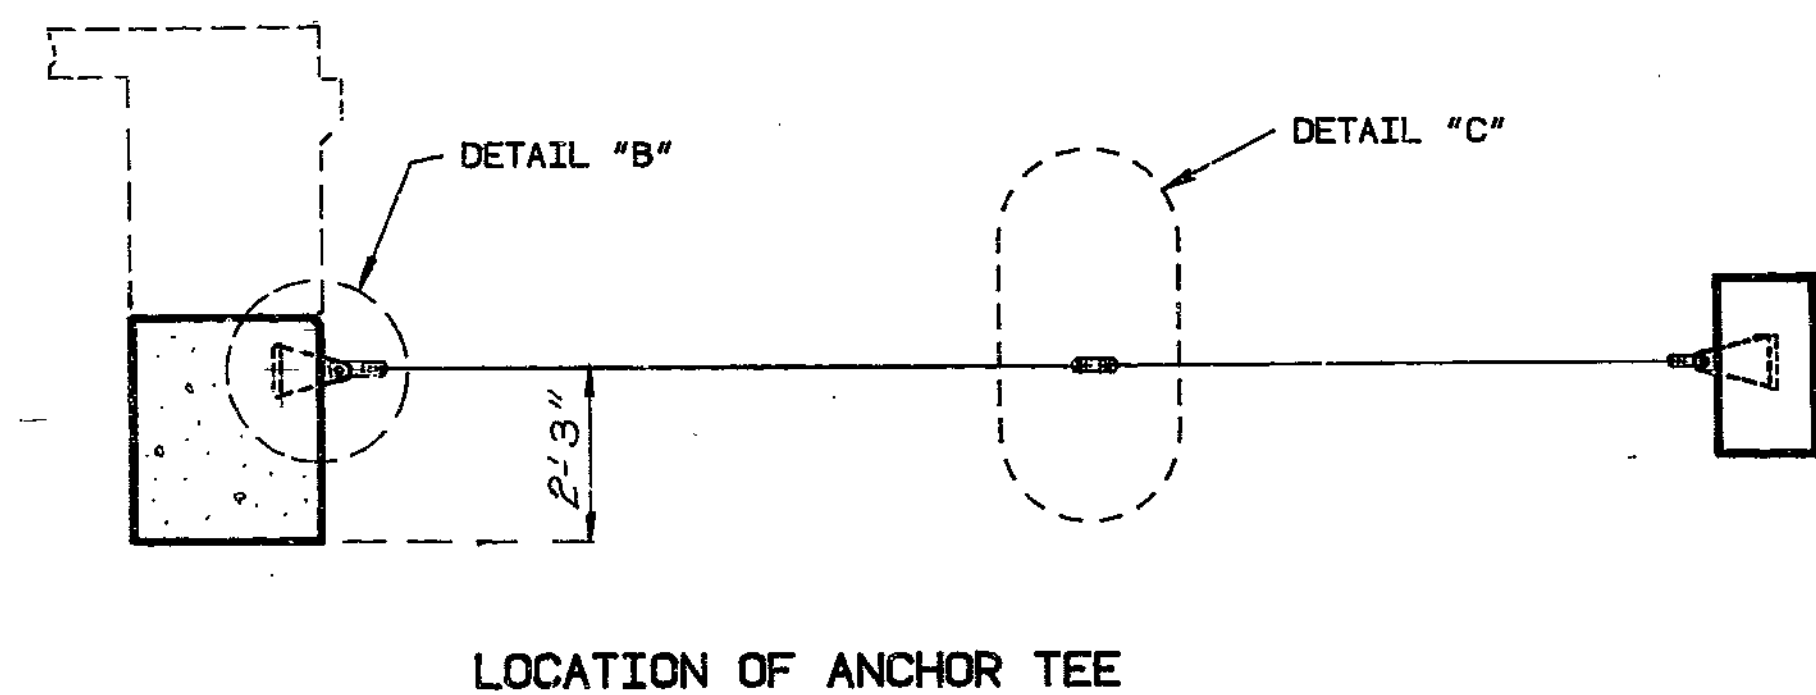

LOCATION OF ANCHOR TEE

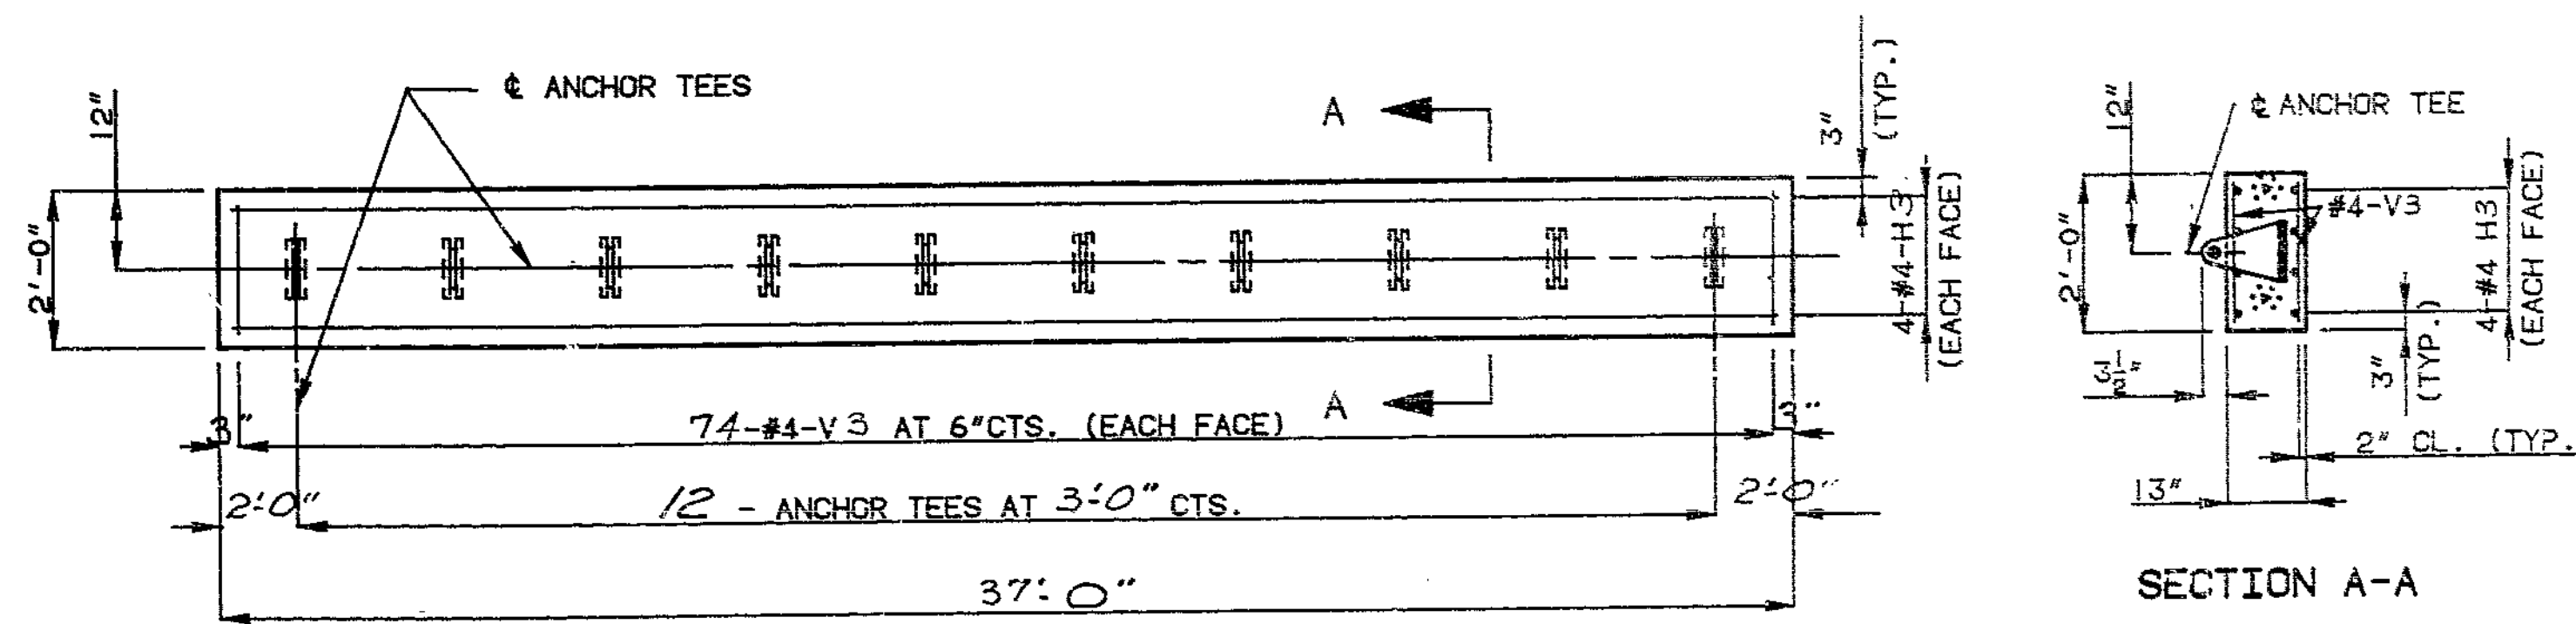

ELEVATION OF DEADMAN

SECTION A-A

DETAILS OF DEAD MAN ANCHORAGE SYSTEM AT BENT NO. 1

326

STD. D.M.A. REVISED JULY 1984  
 JULY 1984  
 REVISED JULY 1988

DETAILED AUG. 1988  
 CHECKED Aug. 1988

Note: This drawing is not to scale. Follow dimensions.

Sheet No. 16 of 25



JACKSON

COUNTY

A-2745




STATE	PROJ. NO.	SHEET NO.
MO.		72

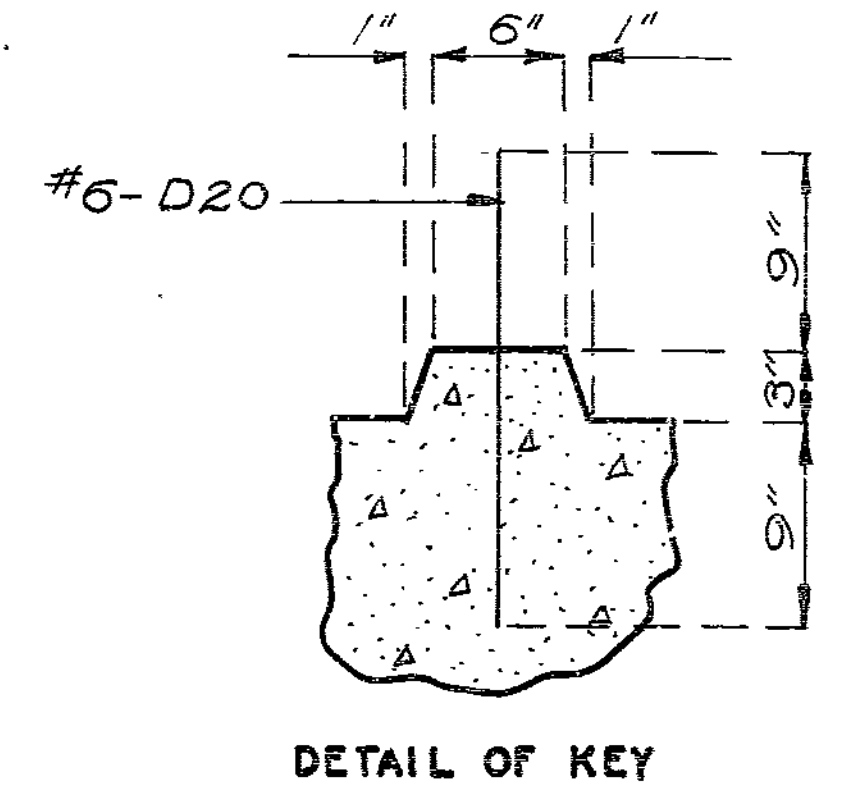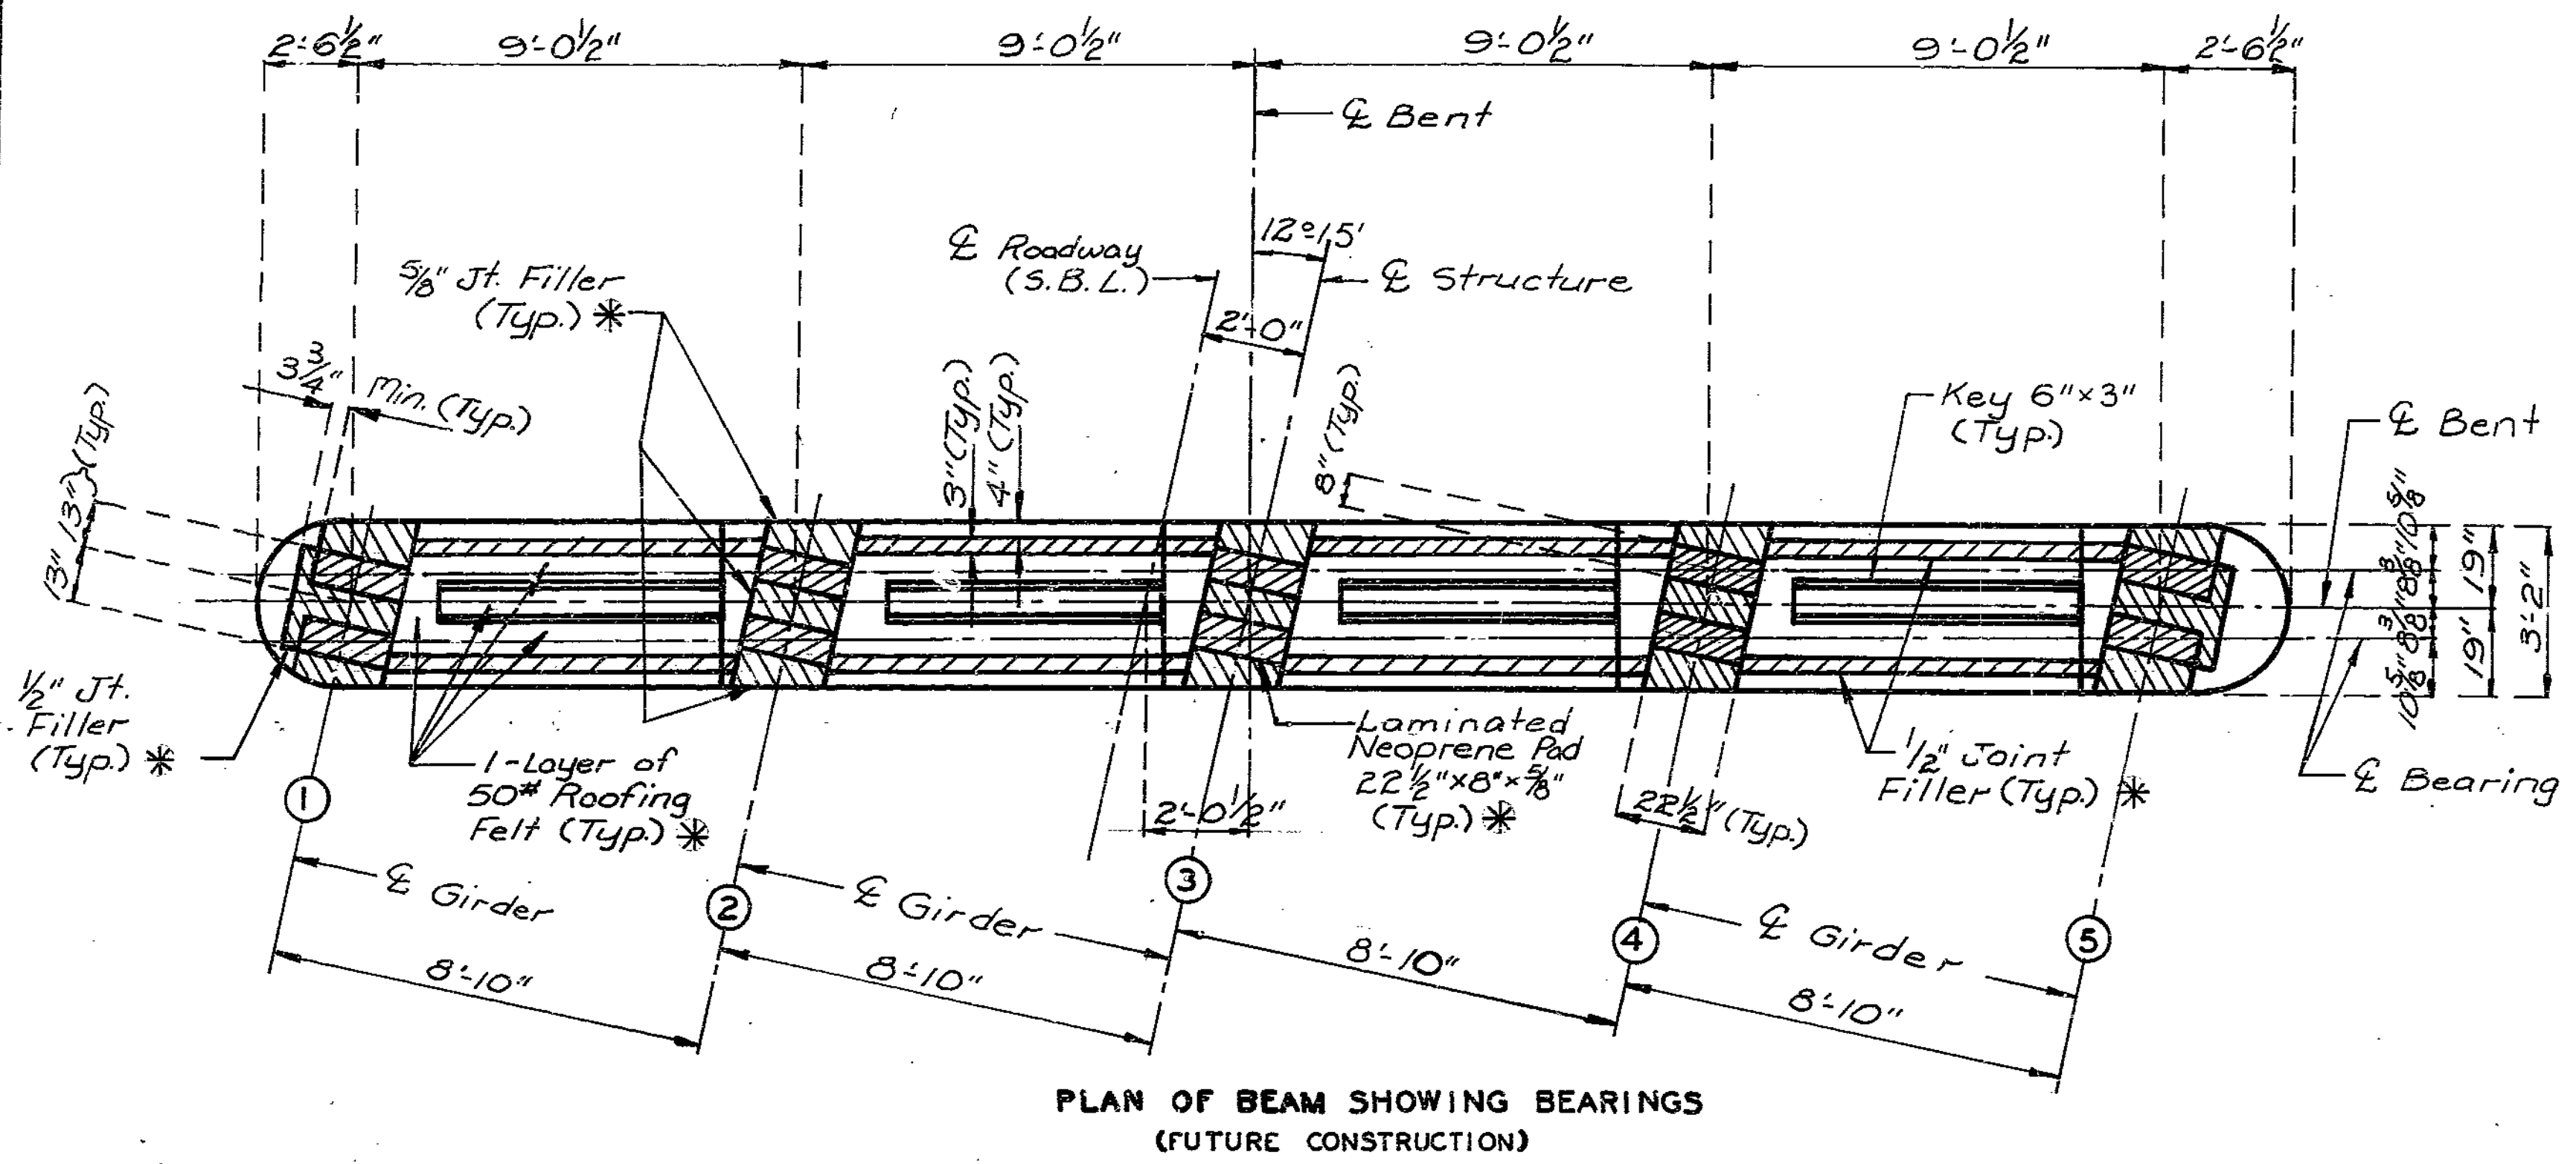


\* Jt. Filler, Bearings, & Roofing Felt are in Future Construction.

Note: For details of Int. Bents No. 2 & 3 not shown, see sheet No. 18.

HS 387

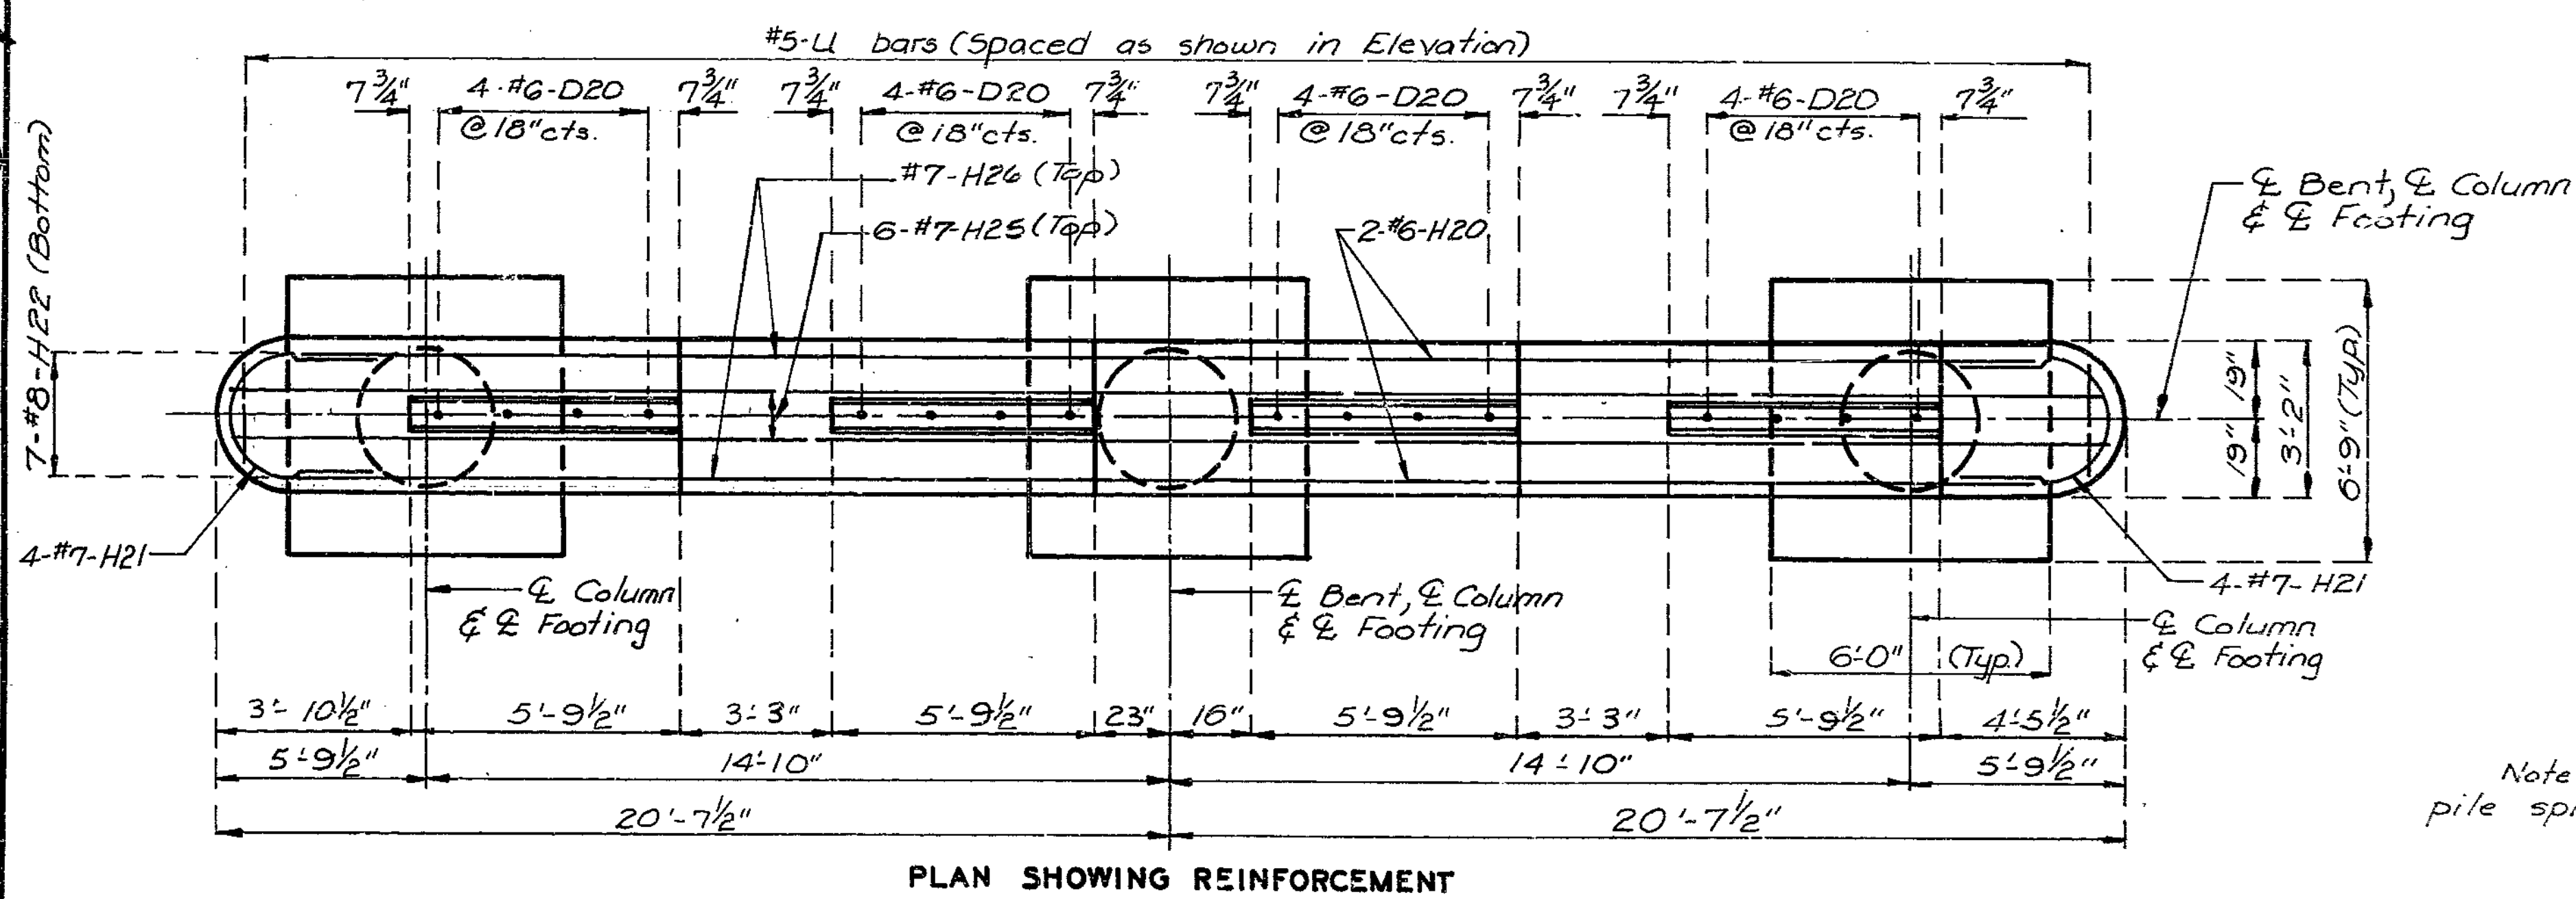

PLAN SHOWING REINFORCEMENT

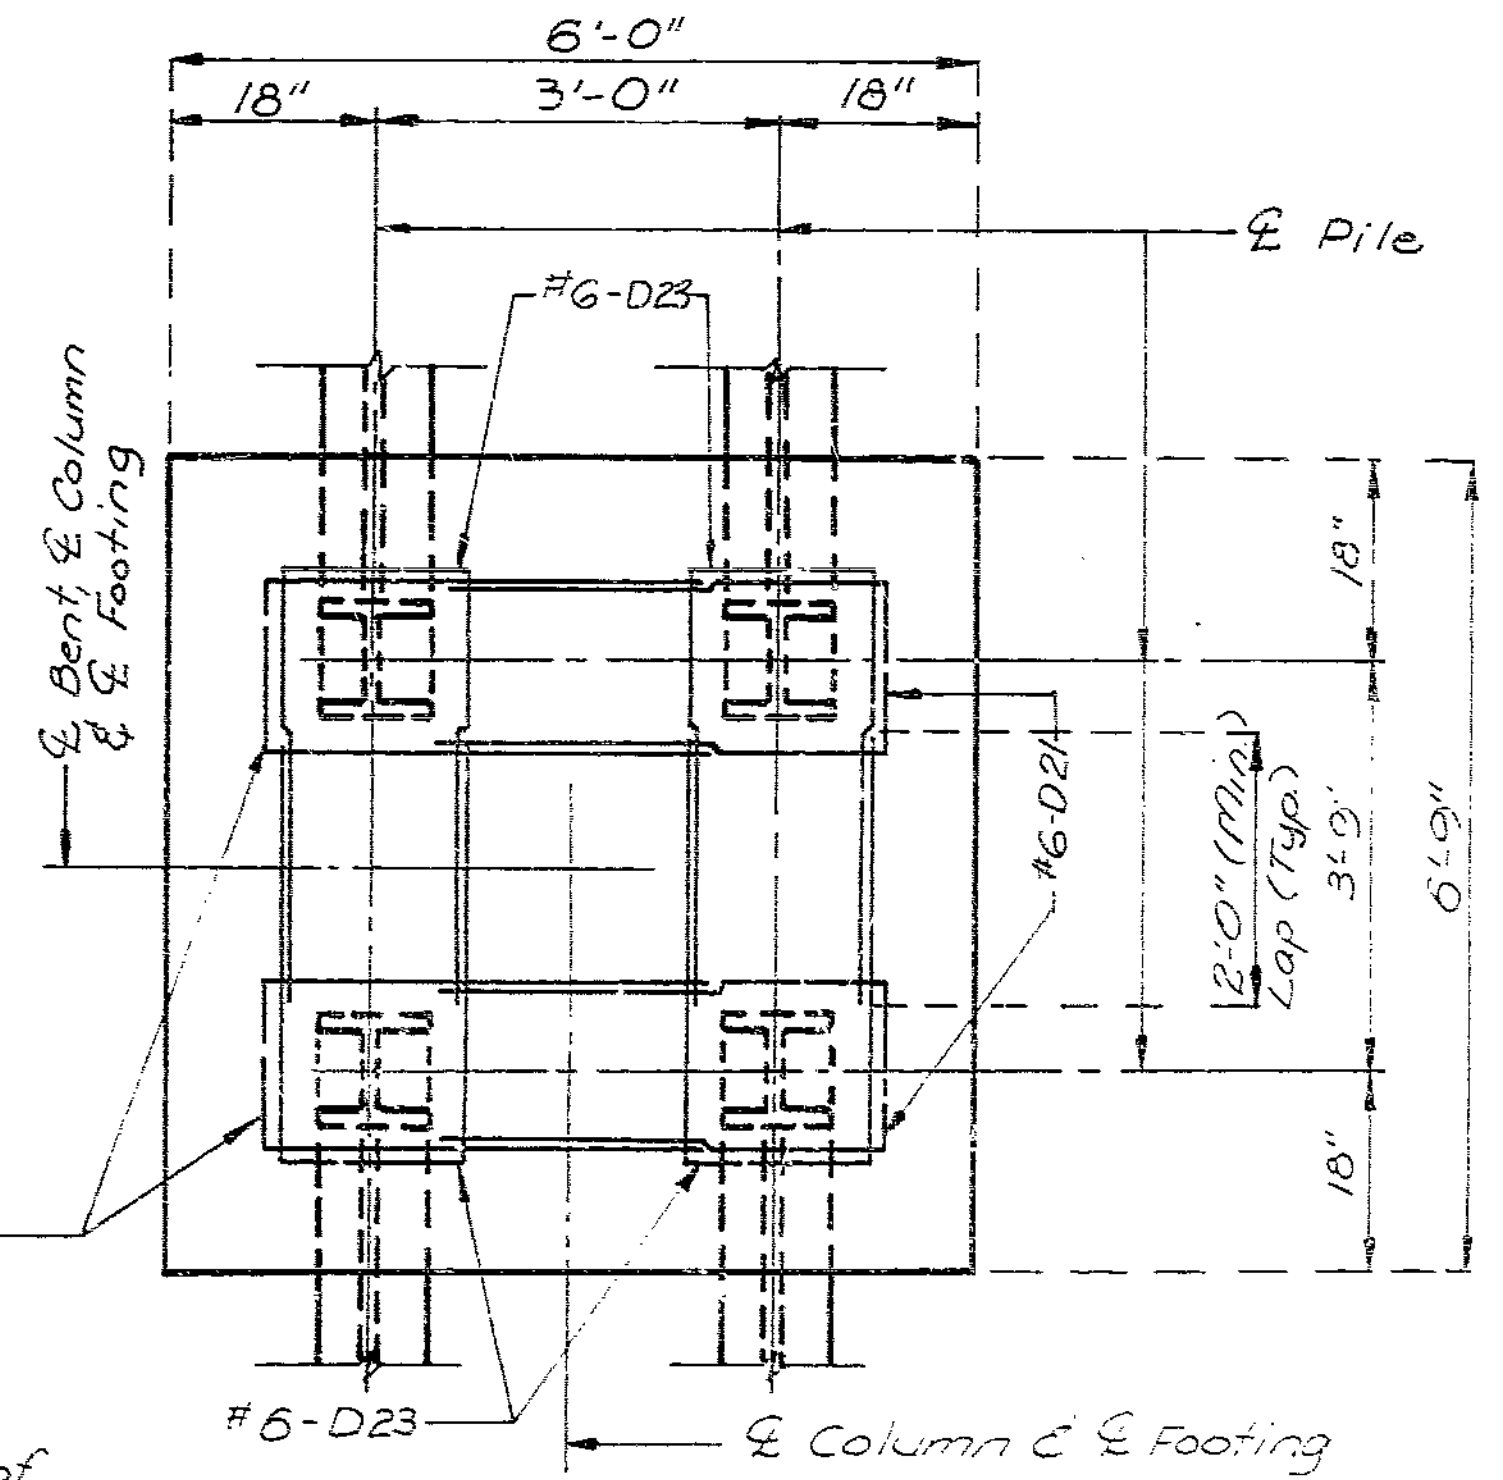

PLAN OF FOOTING SHOWING REINFORCEMENT

Note: For details of pile splice see sheet No. 9.

DETAILS OF INTERMEDIATE BENT NO. 2 & 3

DETAILED MARCH 1988  
CHECKED July 1988


Note: This drawing is not to scale. Follow dimensions.

Sheet No. 17 of 55

JACKSON COUNTY

A-2745

STATE	PROJ. NO.	SHEET NO.
MO.		73

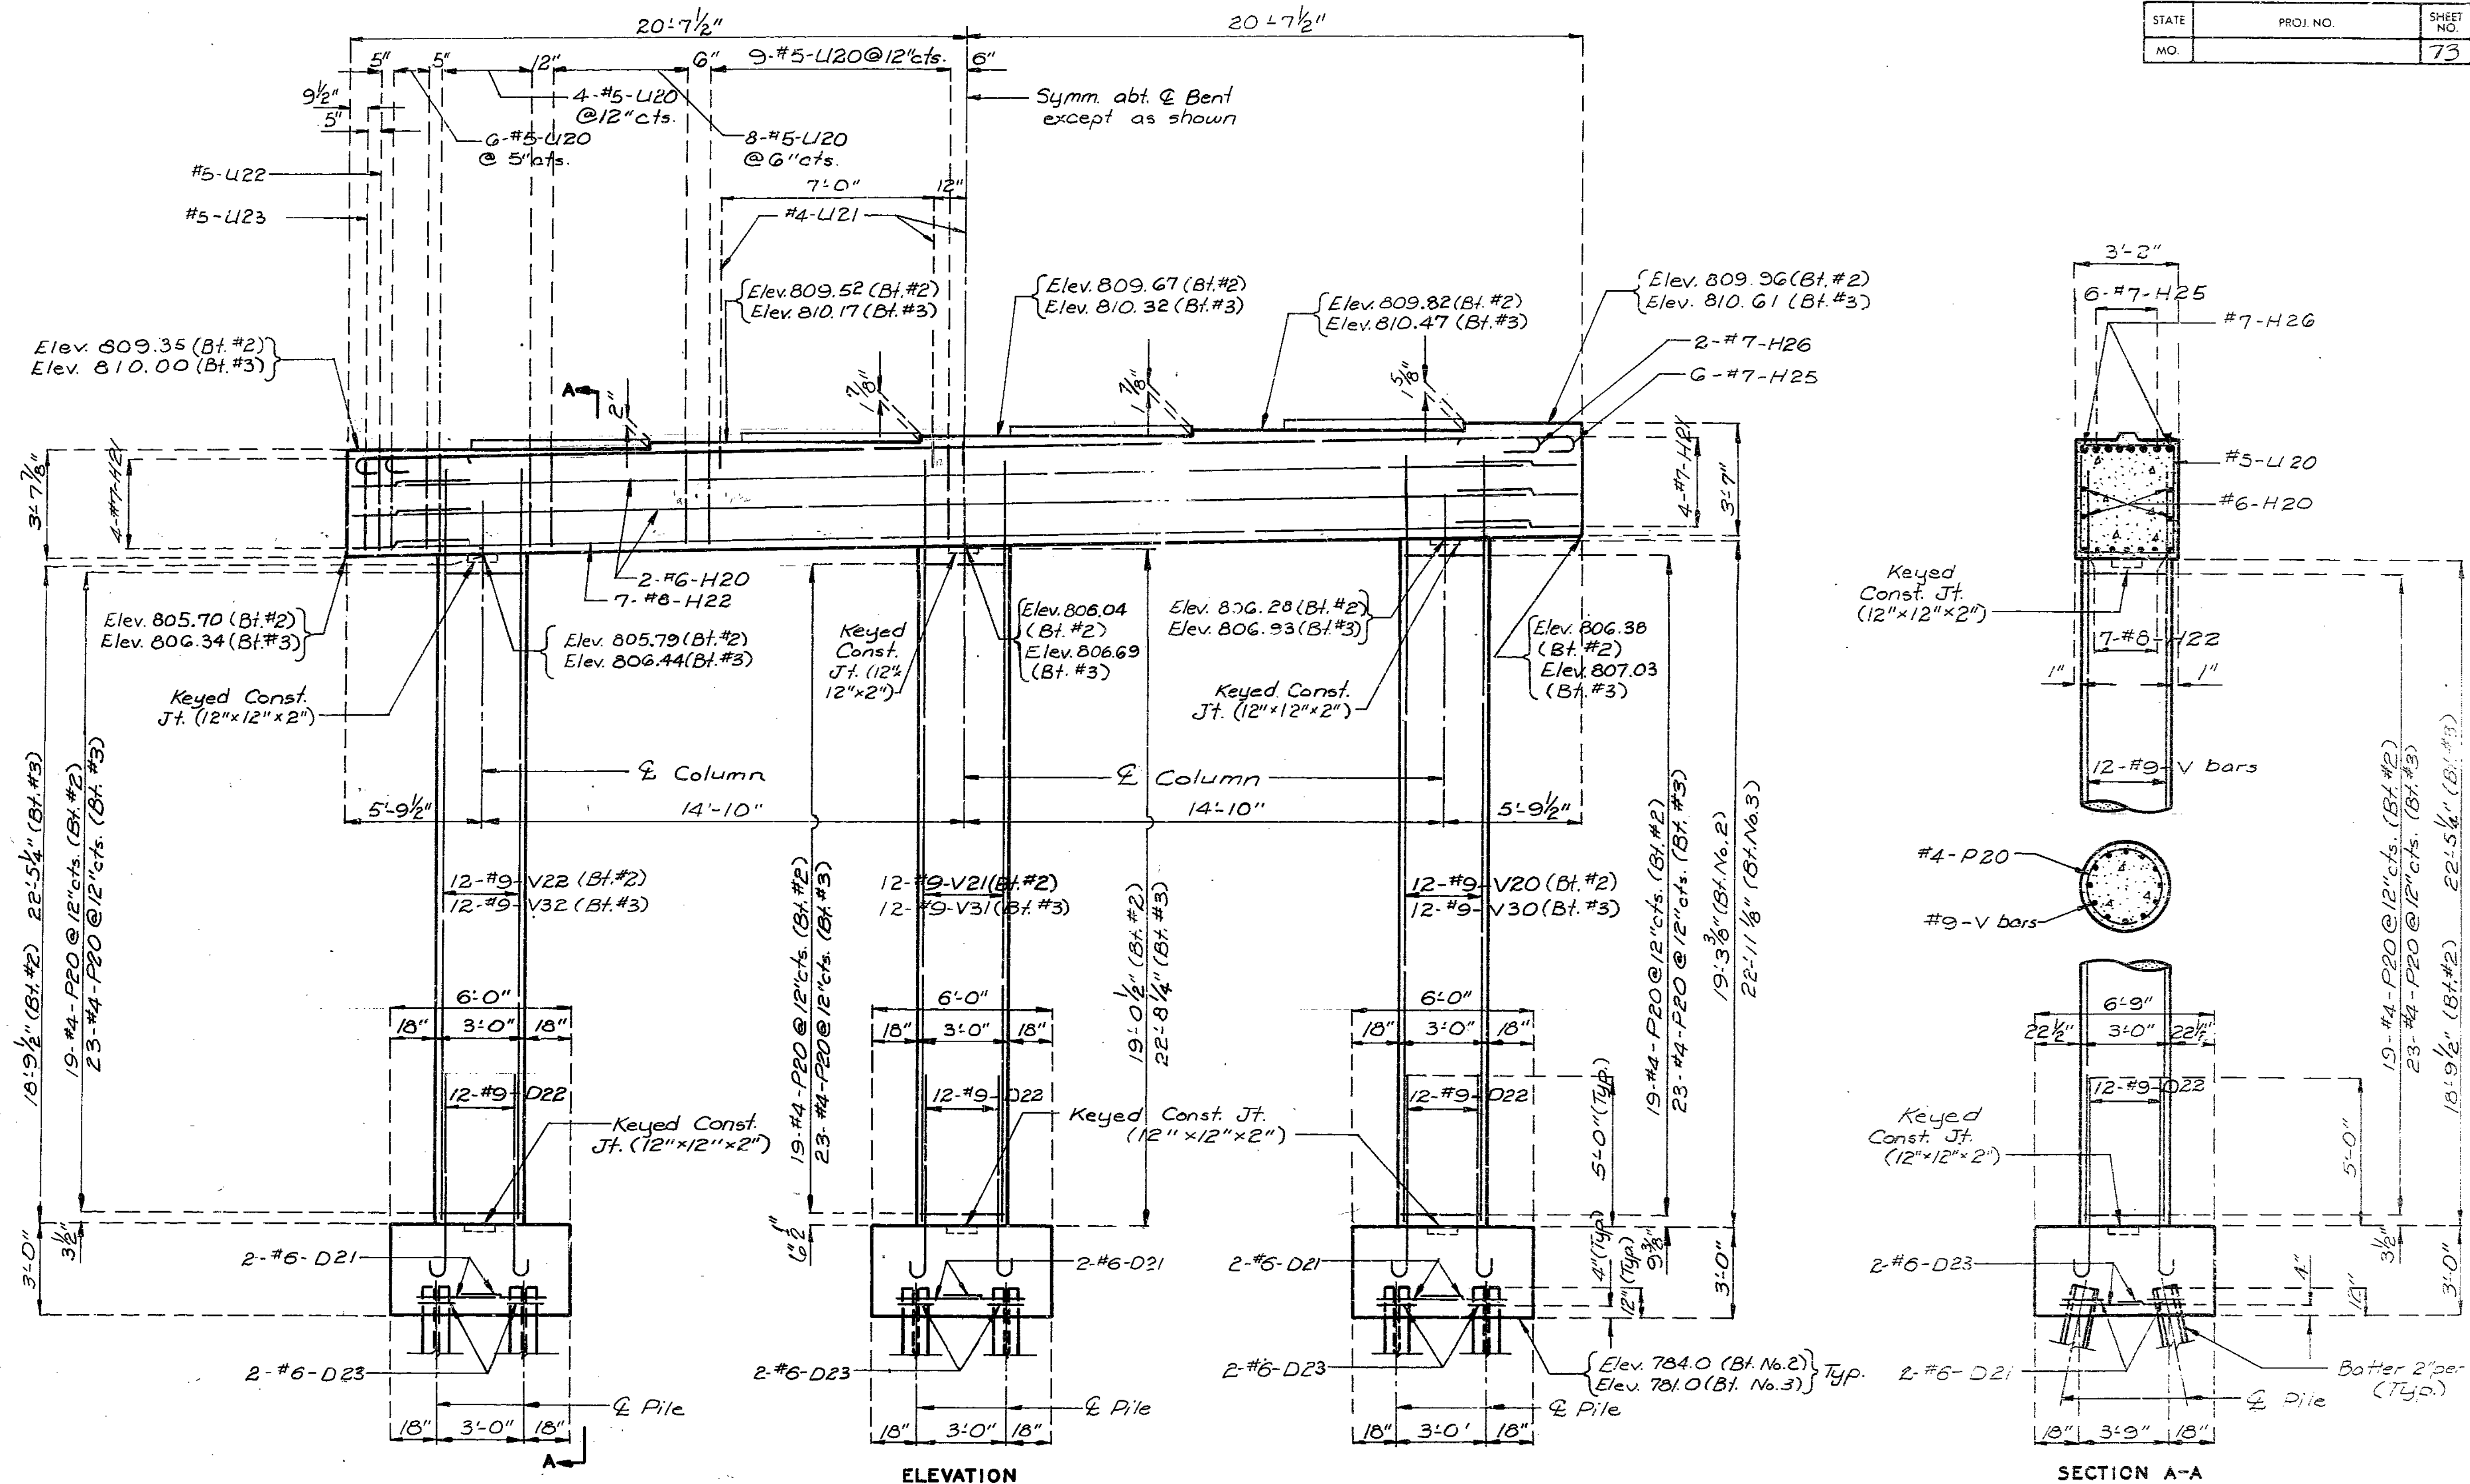

274 300

DETAILS OF INTERMEDIATE BENT NO. 2 & 3

Note: For details of Int. Bent No. 2 & 3 not shown, see sheet No. 7.

DETAILED MARCH 1988  
CHECKED July 1988

Note: This drawing is not to scale. Follow dimensions.

Sheet No. 15 of 55



JACKSON COUNTY

A-2745



STATE	PROJ. NO.	SHEET NO.
MO.		75

Note: For Details of Inter. Bent No. 1 No. 4 not shown see sheet No. 19

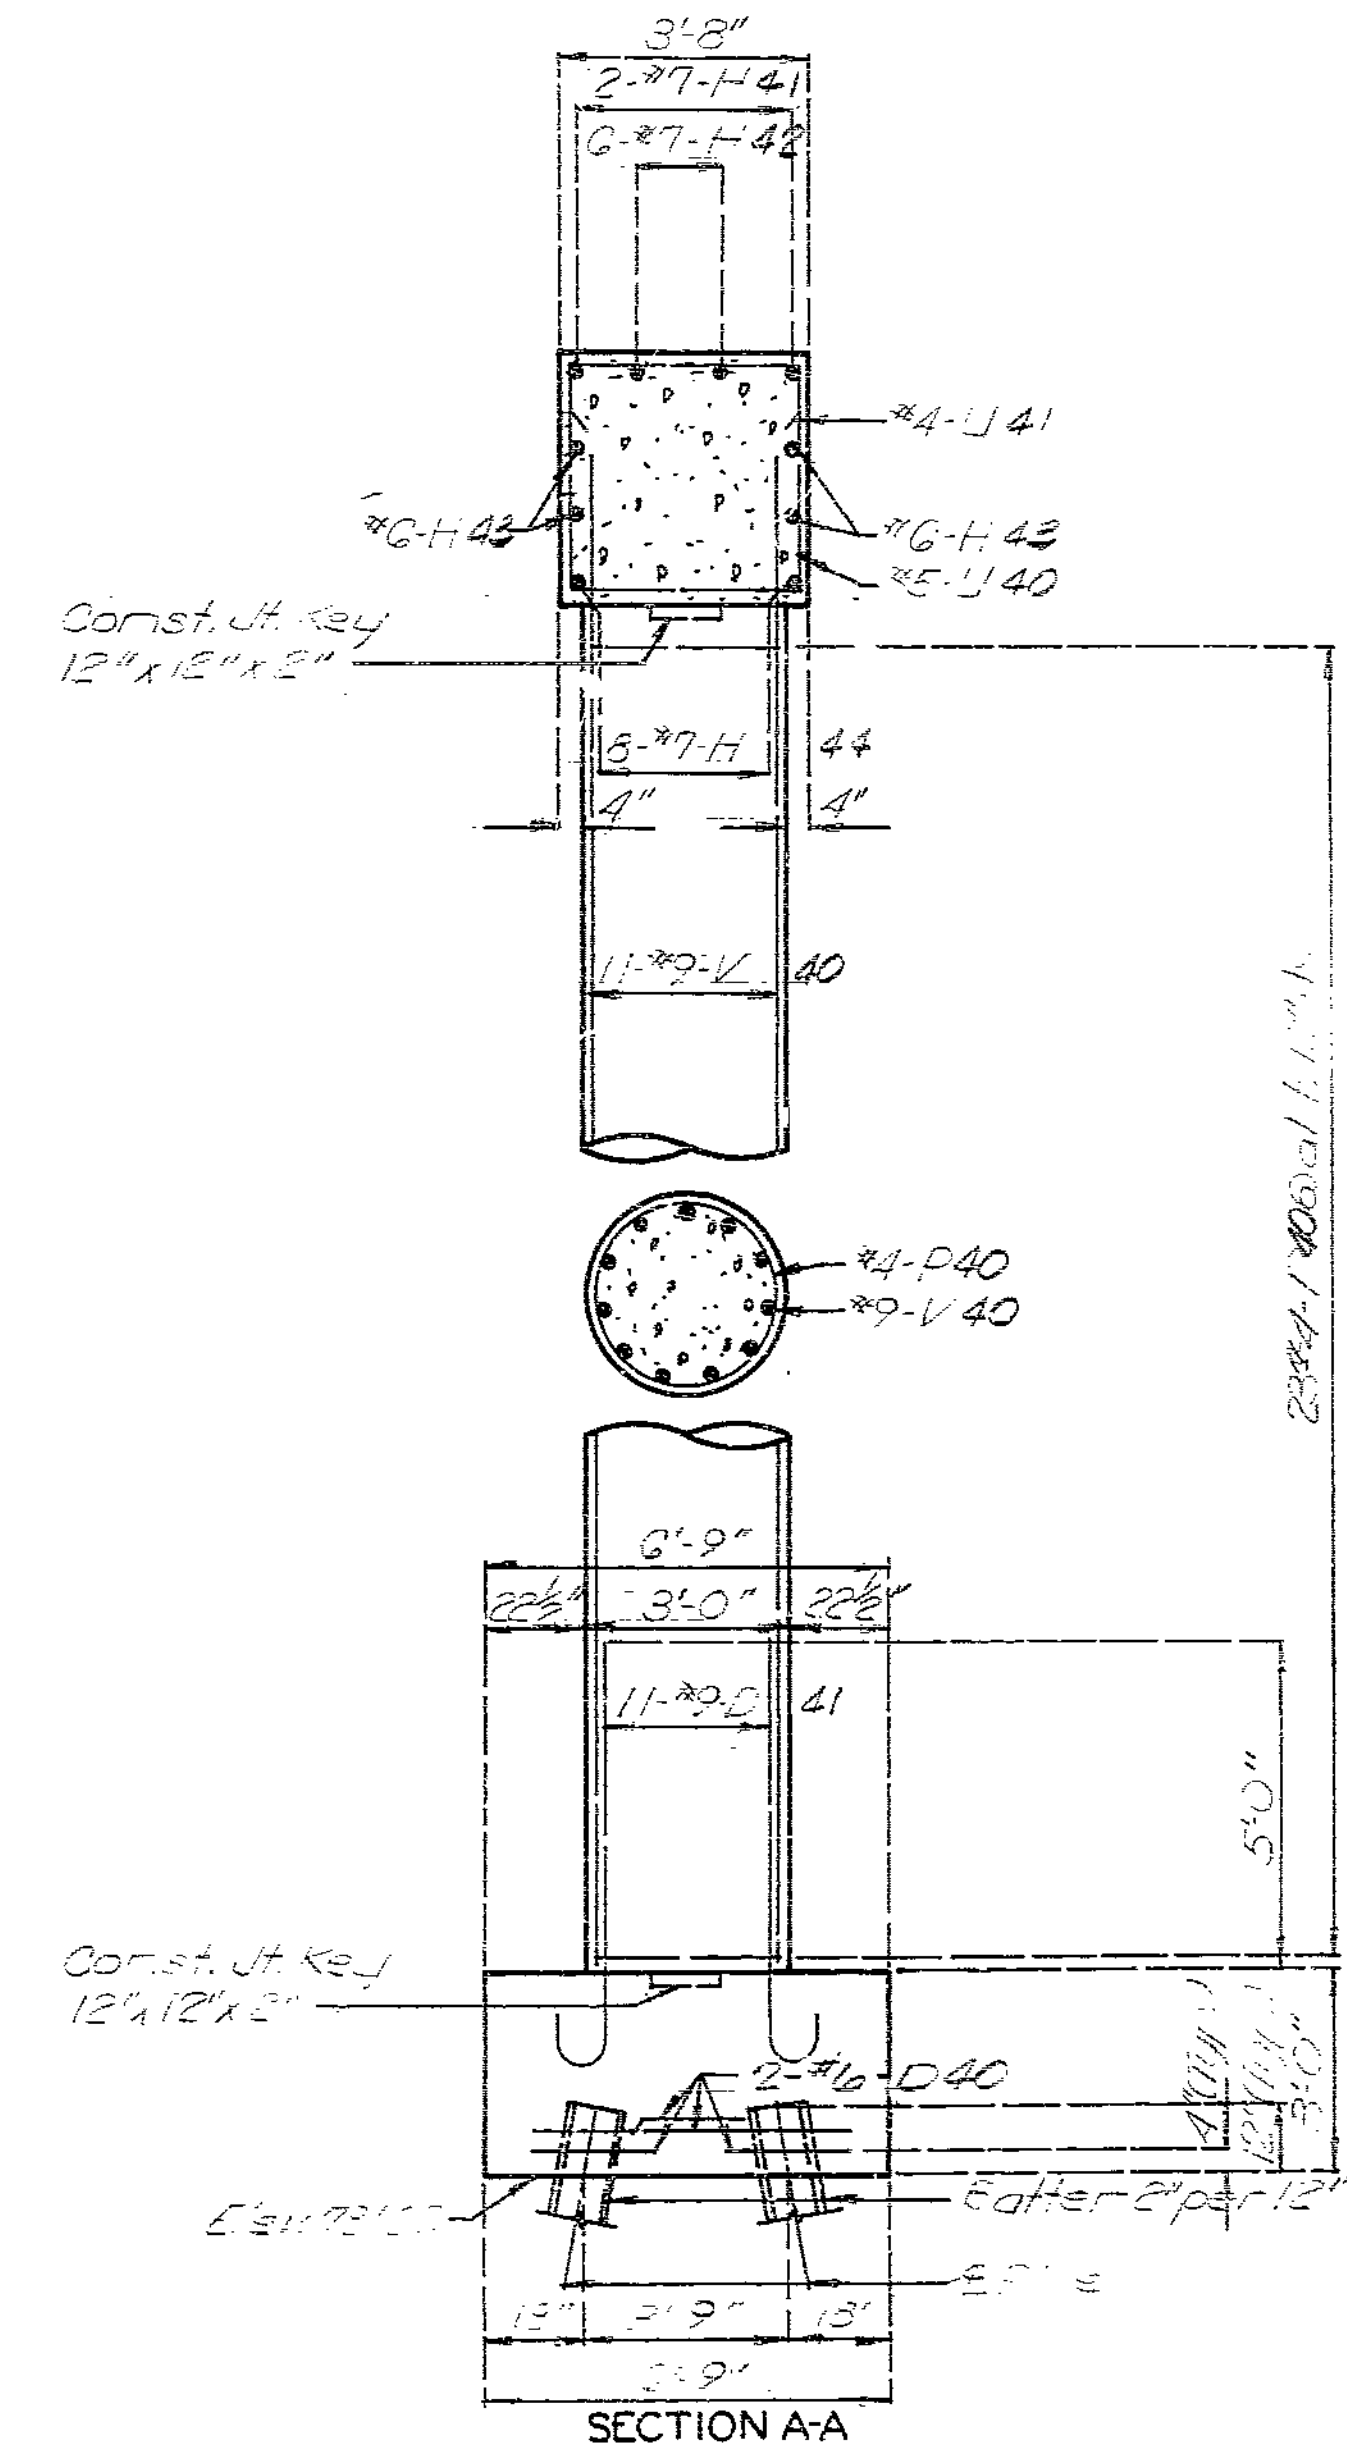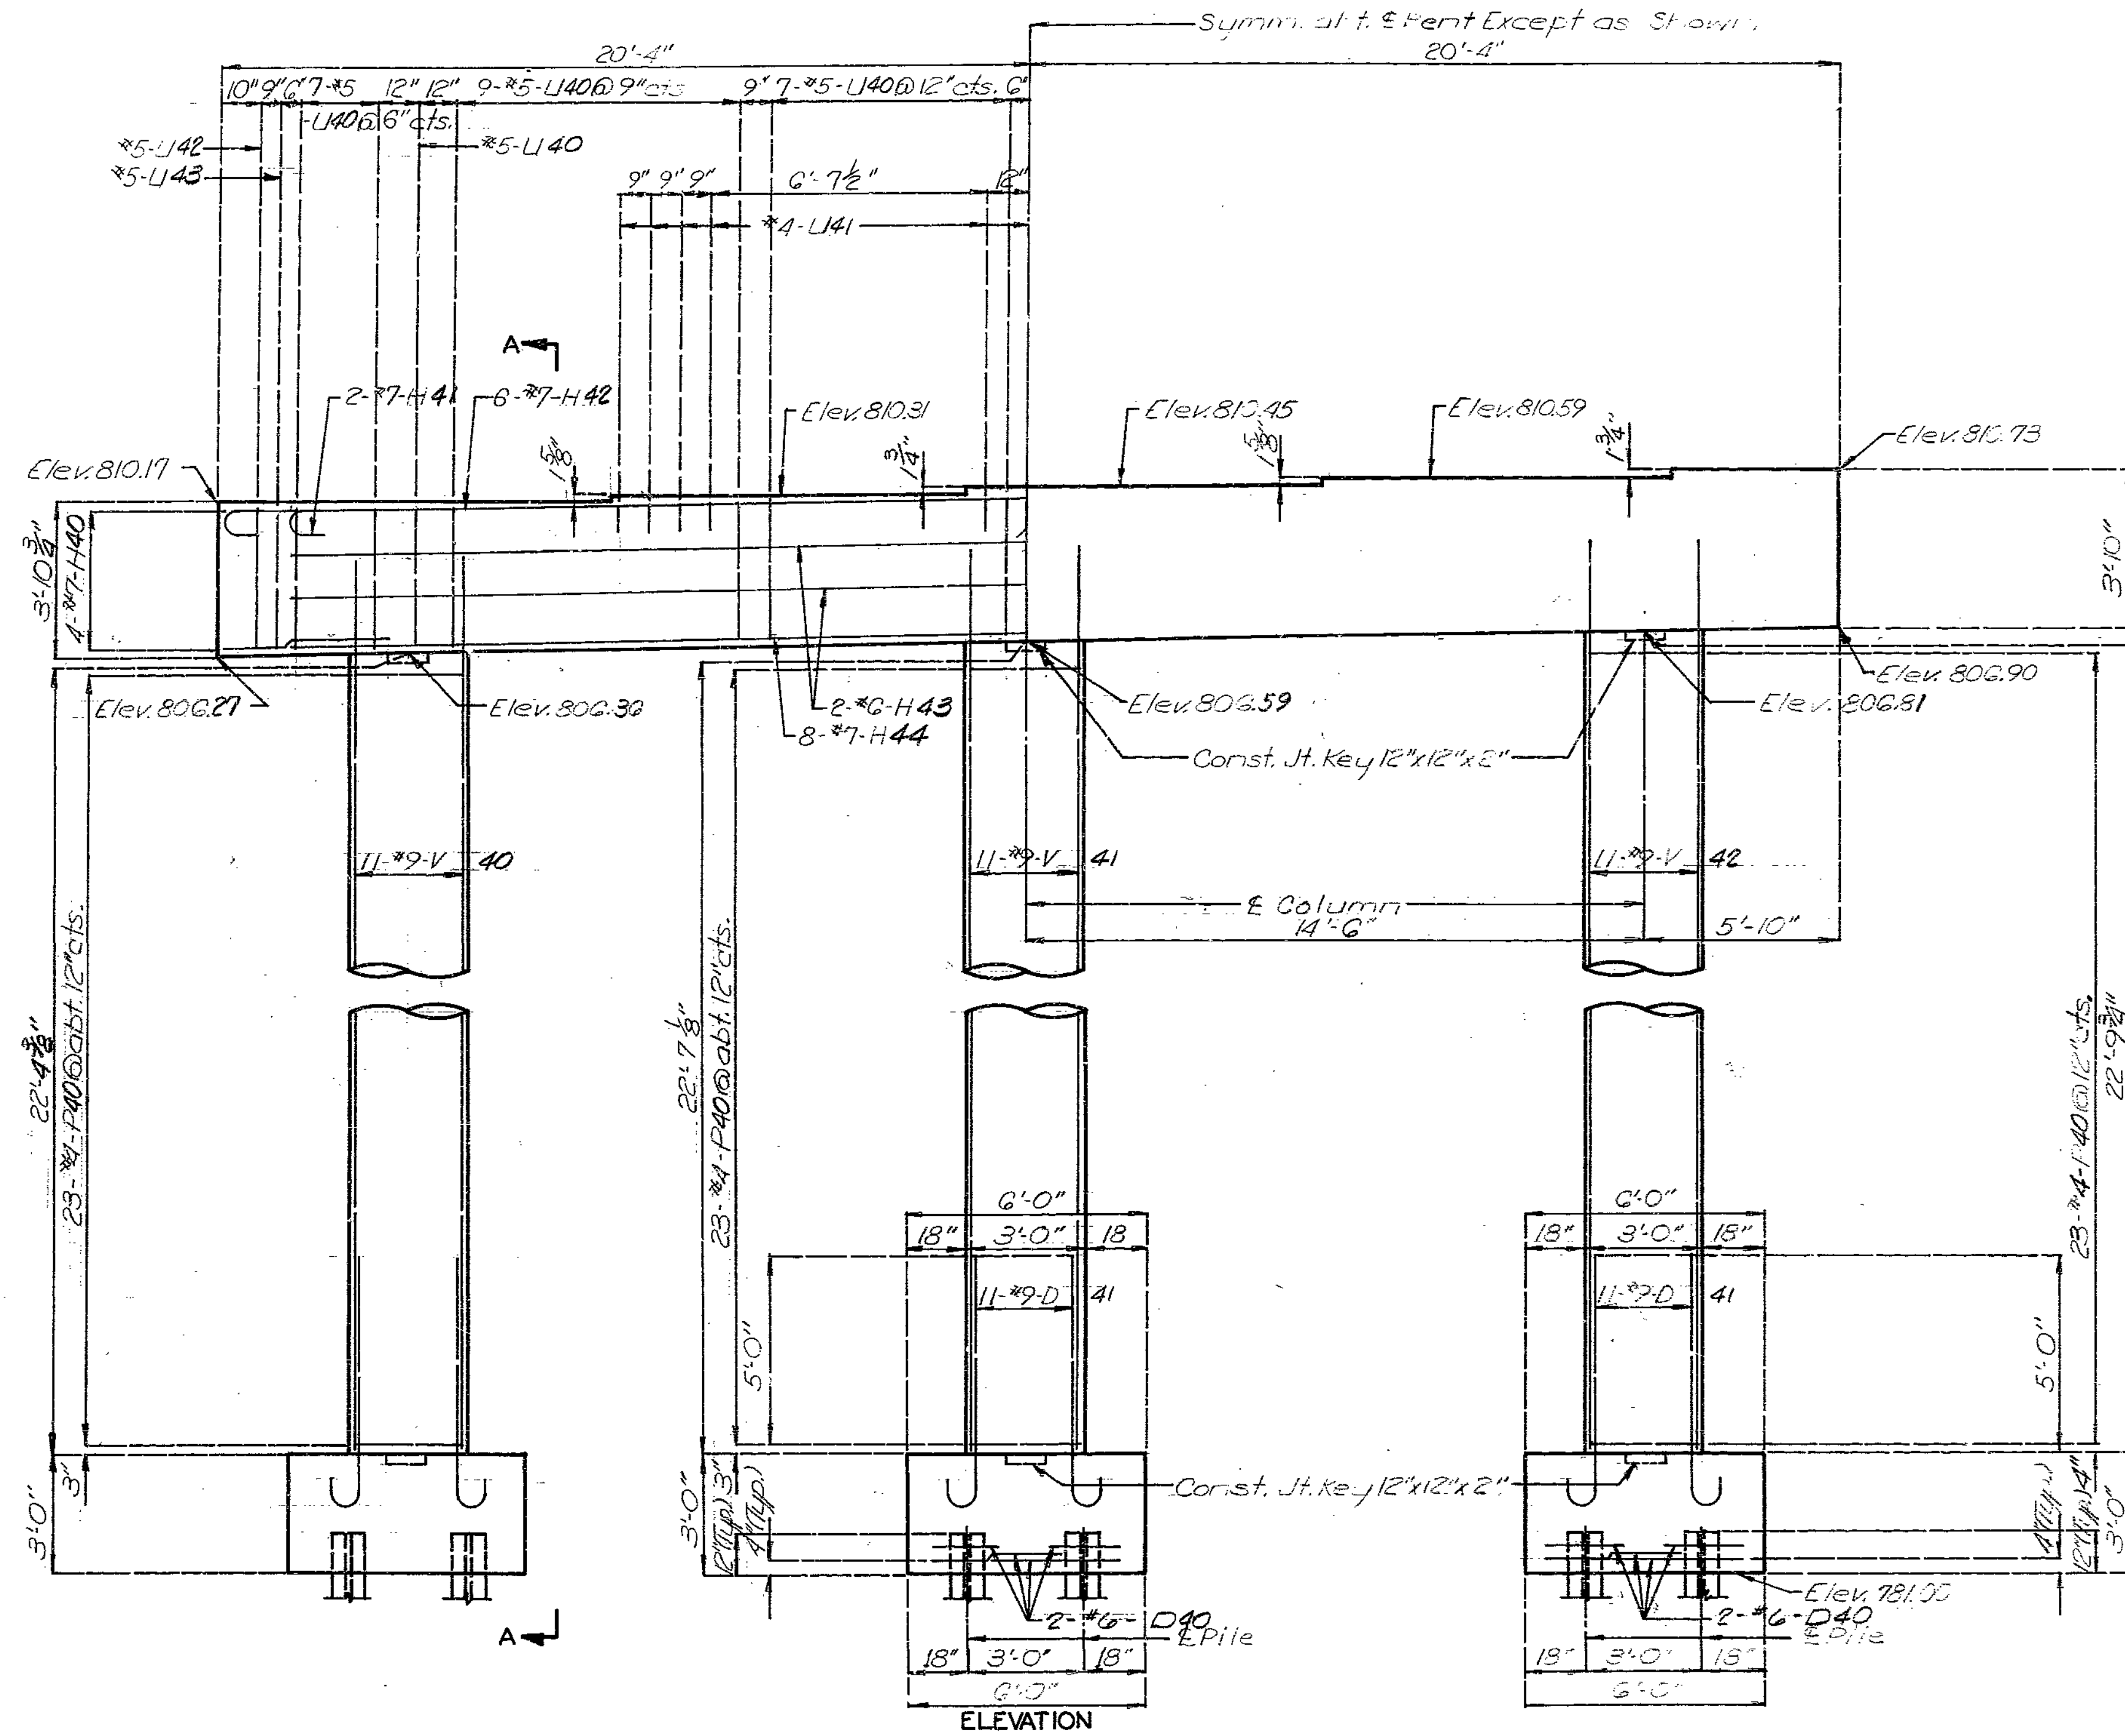

DETAILS OF INTERMEDIATE BENT NO. 4

8/6 330

DETAILED APR. 1988  
CHECKED AUG 1988

Note: This drawing is not to scale. Follow dimensions.

Sheet No. 22 of 55

JACKSON COUNTY



A-2745

STATE	PROJ. NO.	SHEET NO.
MO.		76



Note: For Details of Intermediate Bent No. 5 not shown see sheet No. 22.

\*Brgs., Jt. Filler, & Roofing Felt are in Future Construction.

Note: For Pile Splice Detail see sheet No. 9.

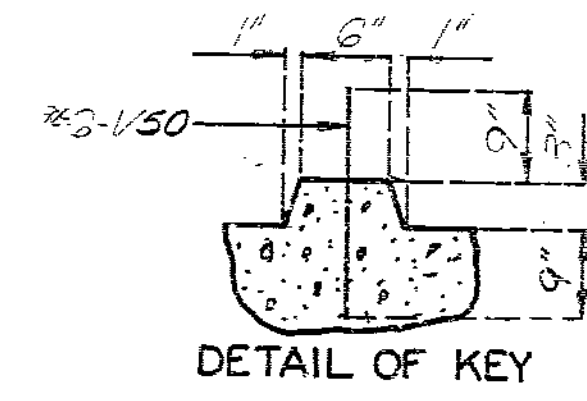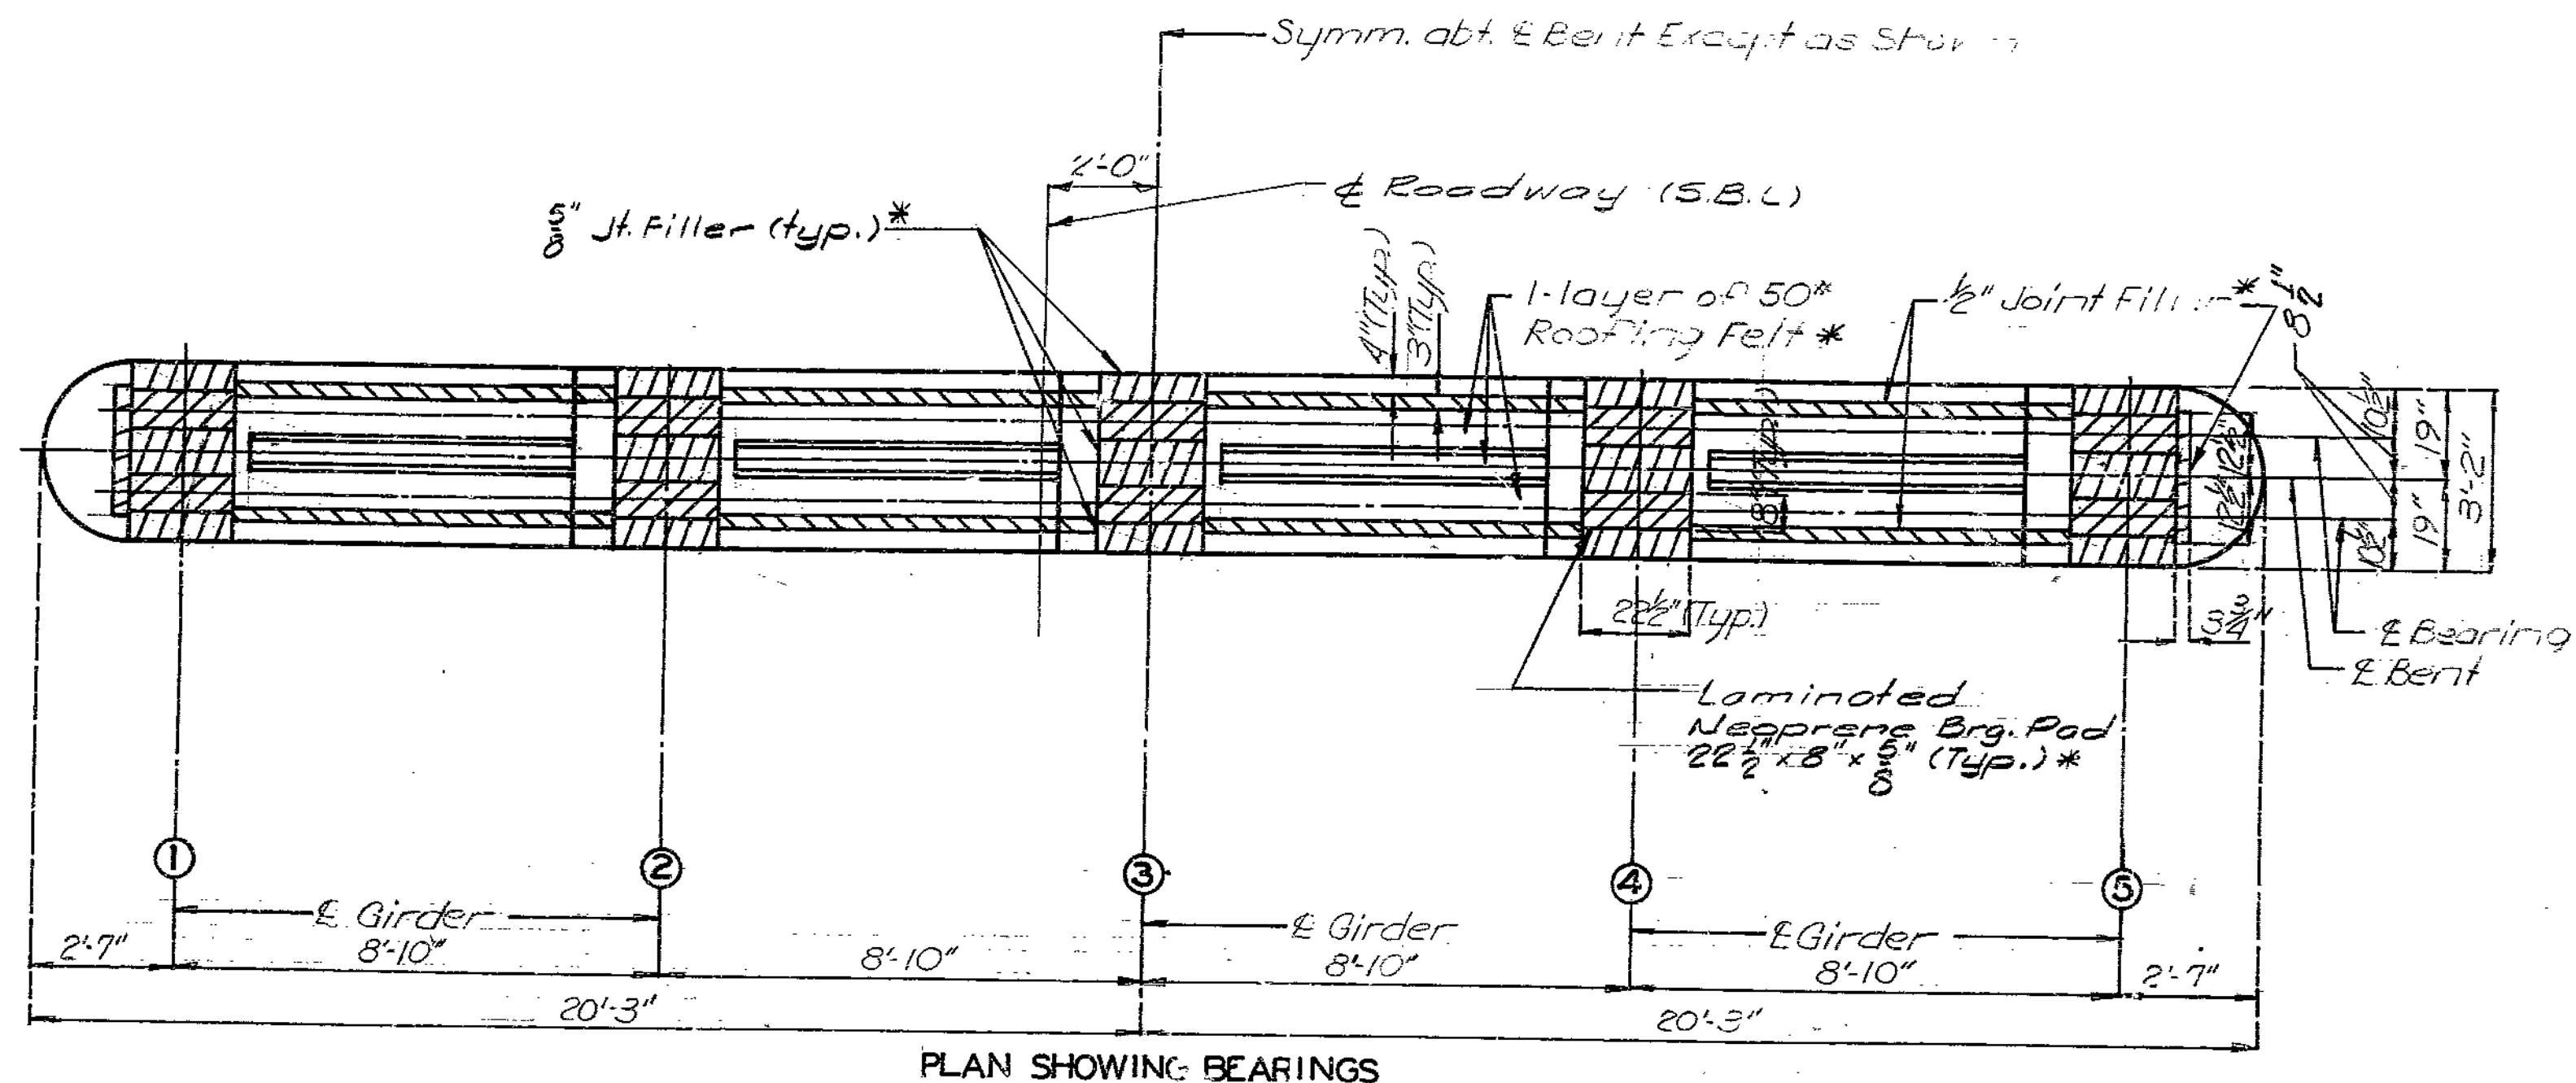

877331

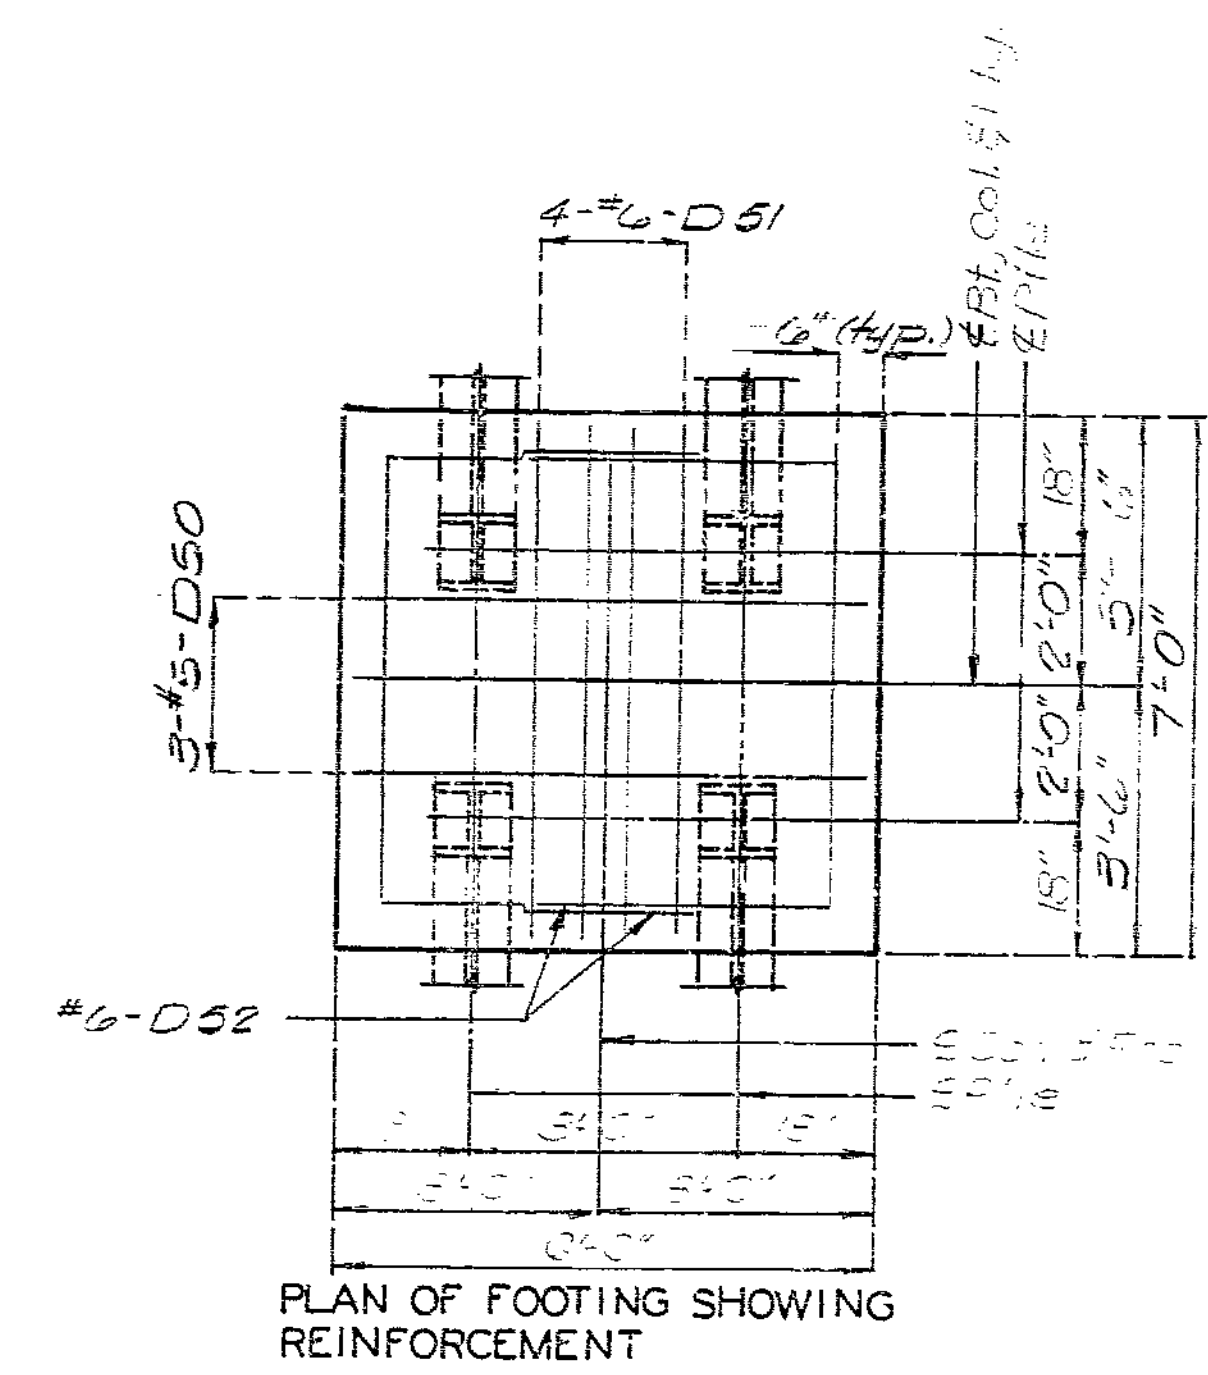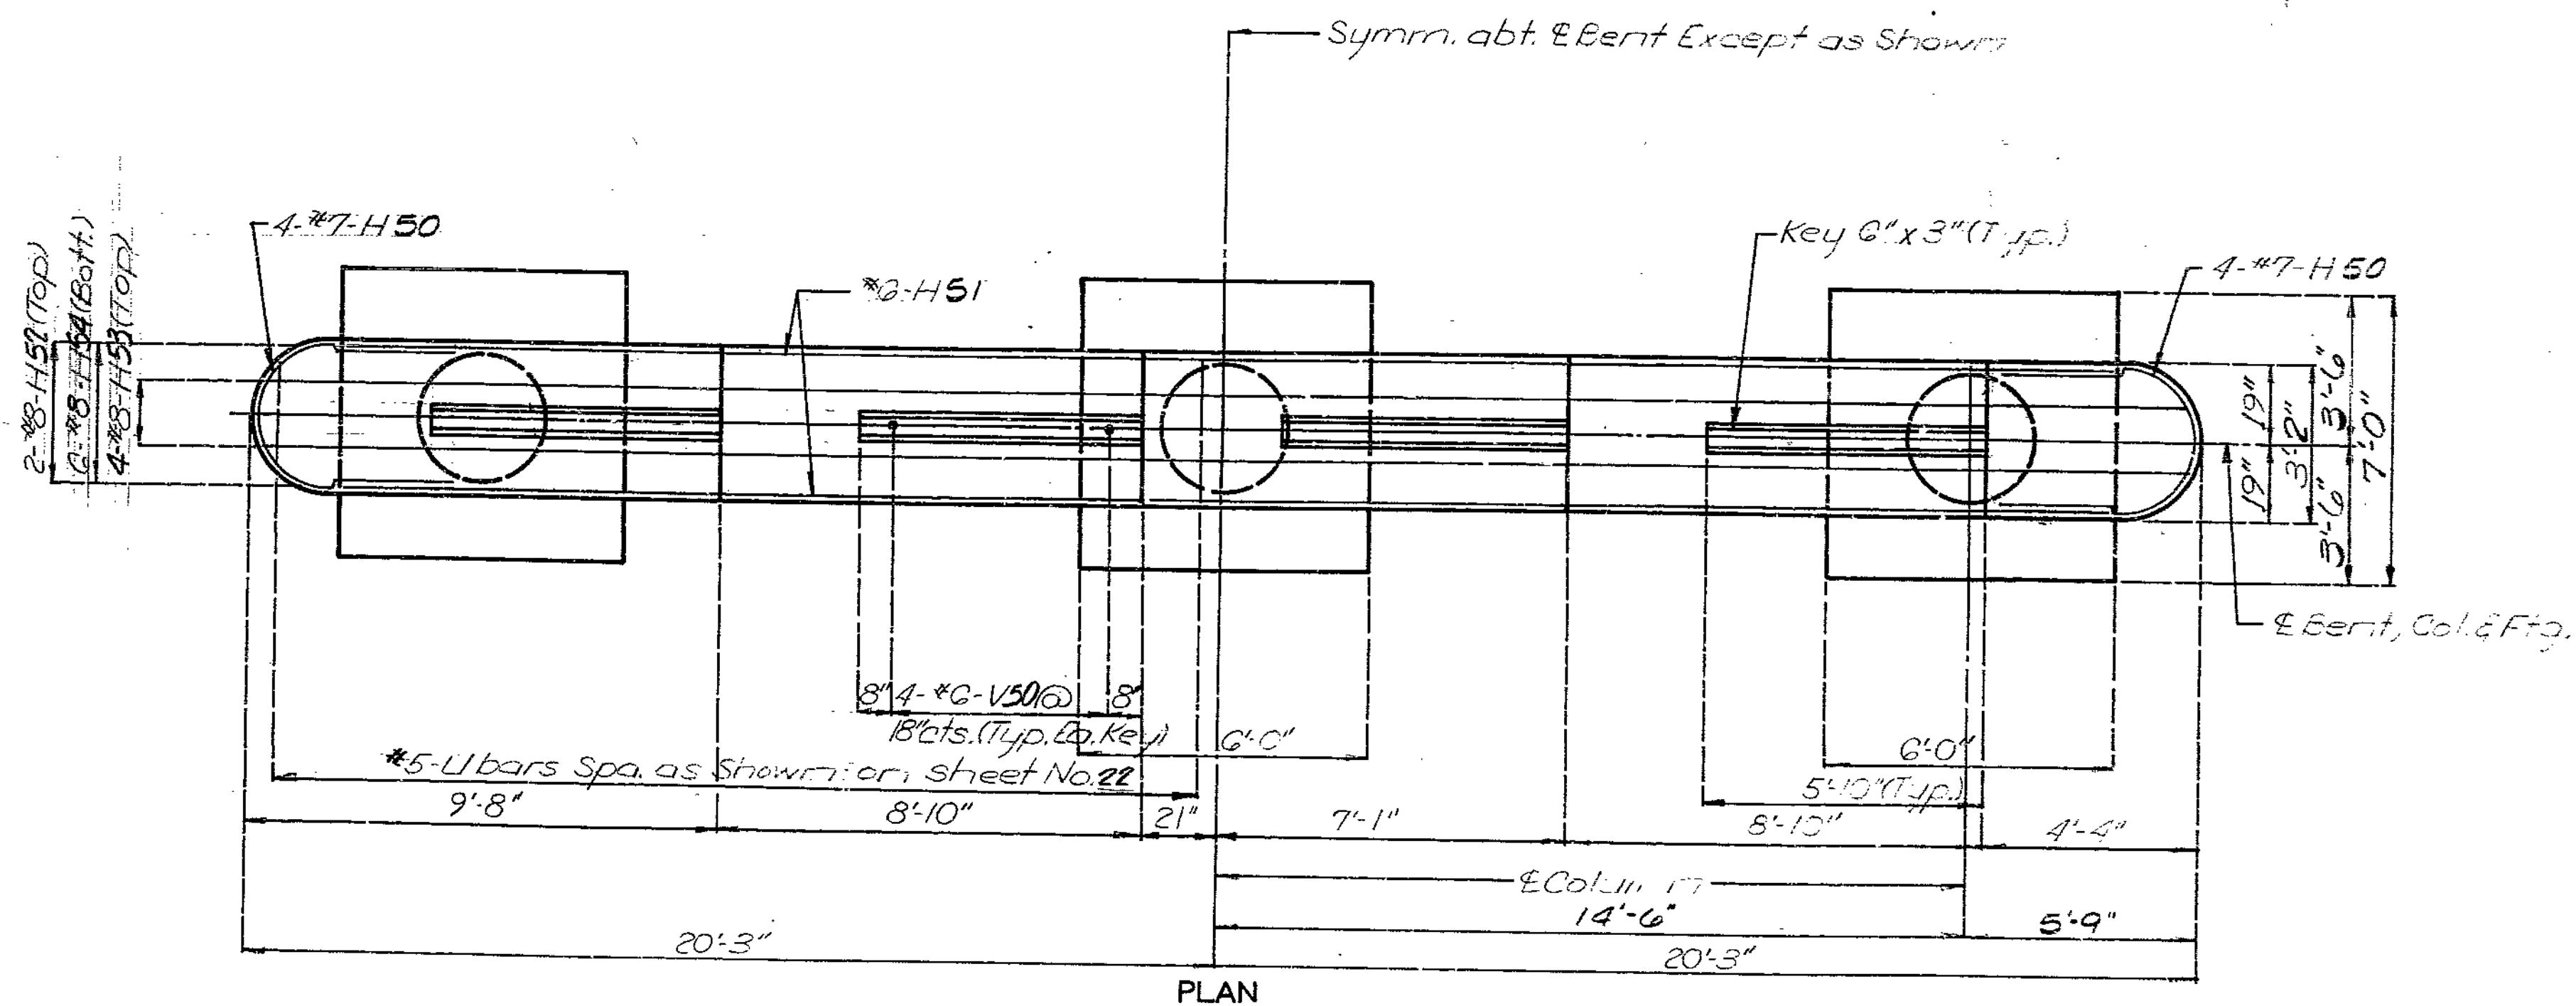

DETAILS OF INTERMEDIATE BENT NO. 5

DETAILED APR. 1988  
CHECKED ALIG 1988

Note: This drawing is not to scale. Follow dimensions.



Sheet No. 21 of 55.

JACKSON COUNTY

A-2745

STATE	PROJ. NO.	SHEET NO.
MO.		77

Note: For details of Intermediate Bent No. 5, see drawing A-27452-21

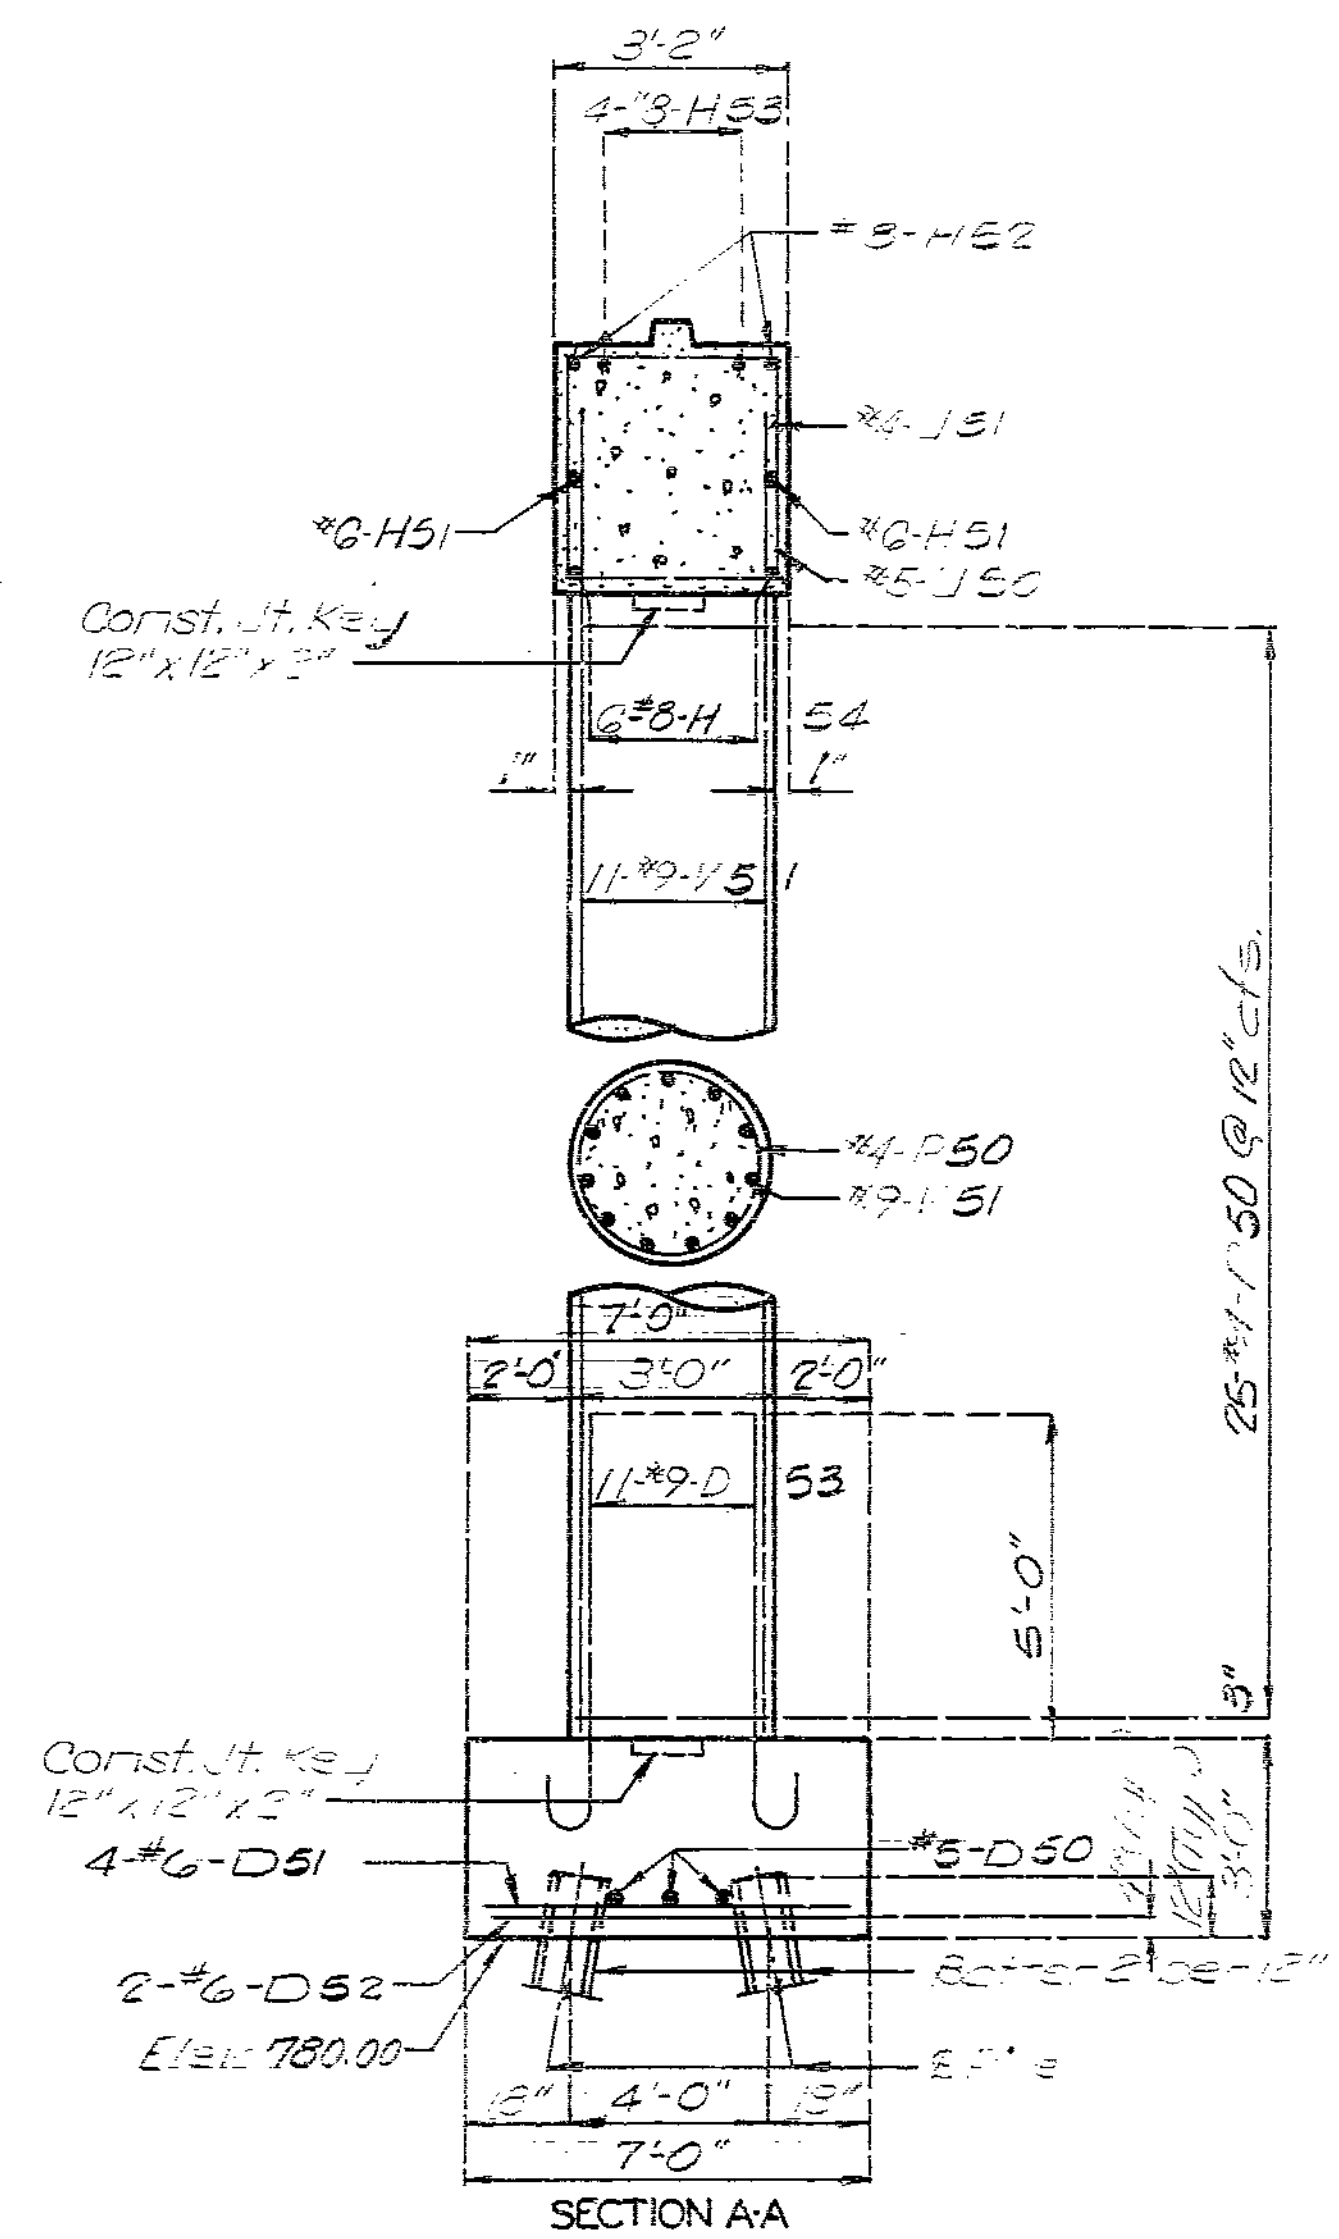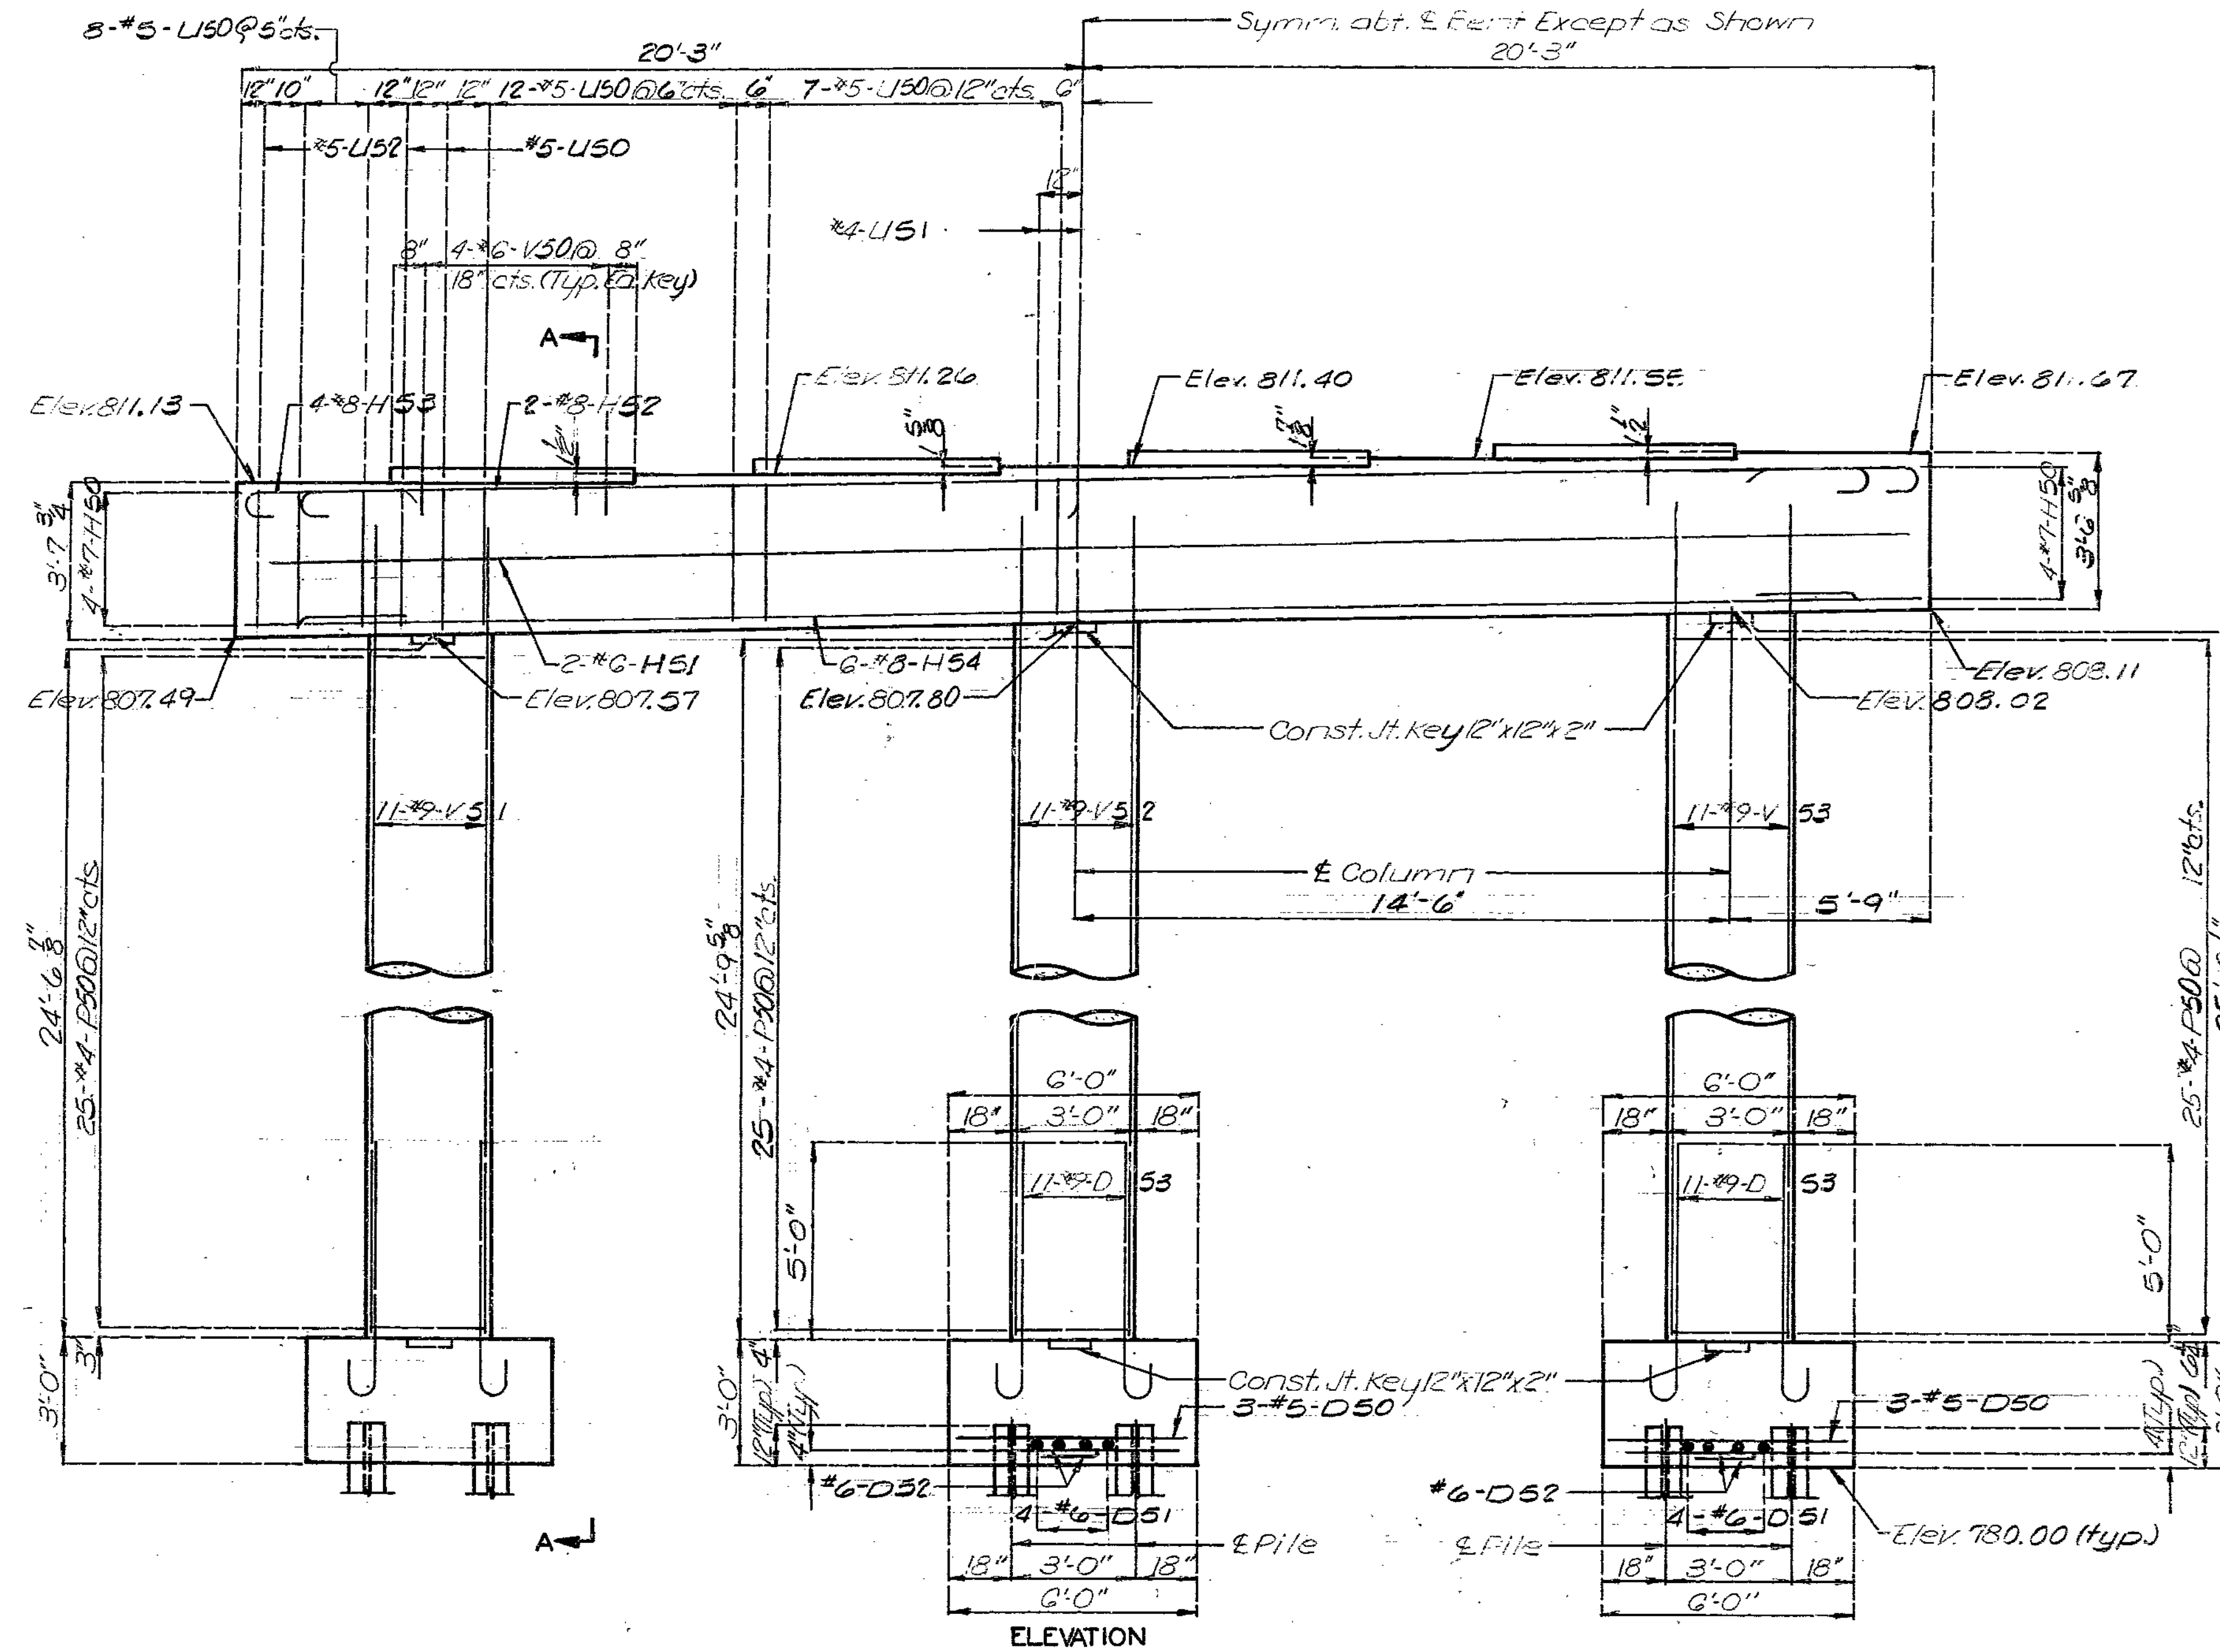

218 332

DETAILS OF INTERMEDIATE BENT NO. 5

DATE: DETAILED APR. 1988  
CHECKED AUG. 1988



Note: This drawing is not to scale. Follow dimensions.

Sheet No. 22 of 53

JACKSON COUNTY


A-2745

STATE	PROJ. NO.	SHEET NO.
MO.		73

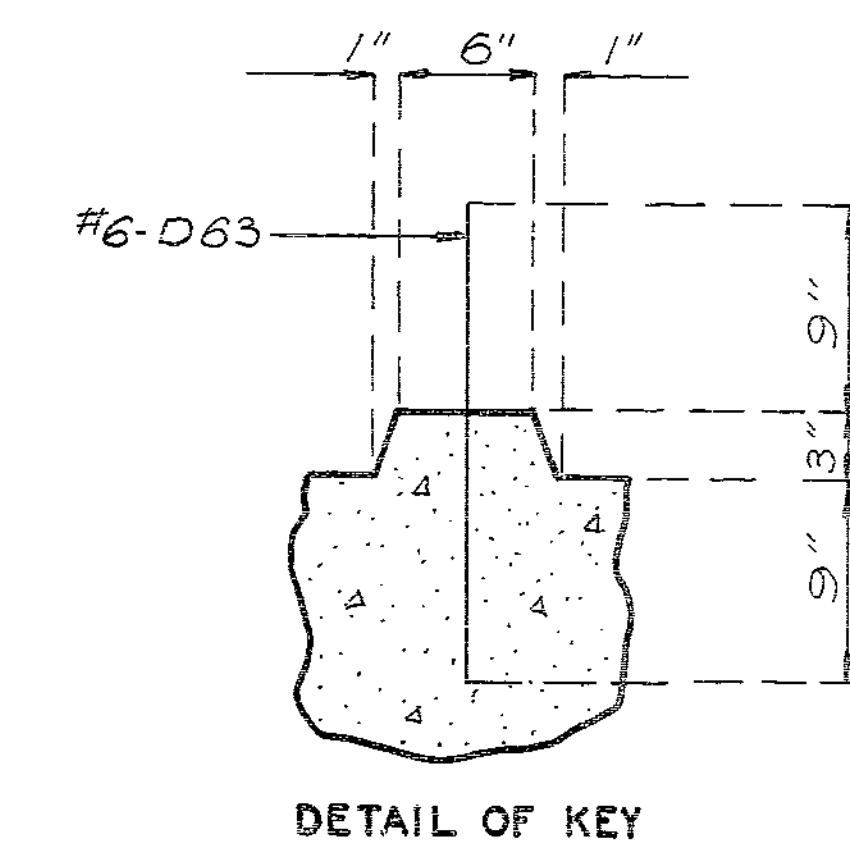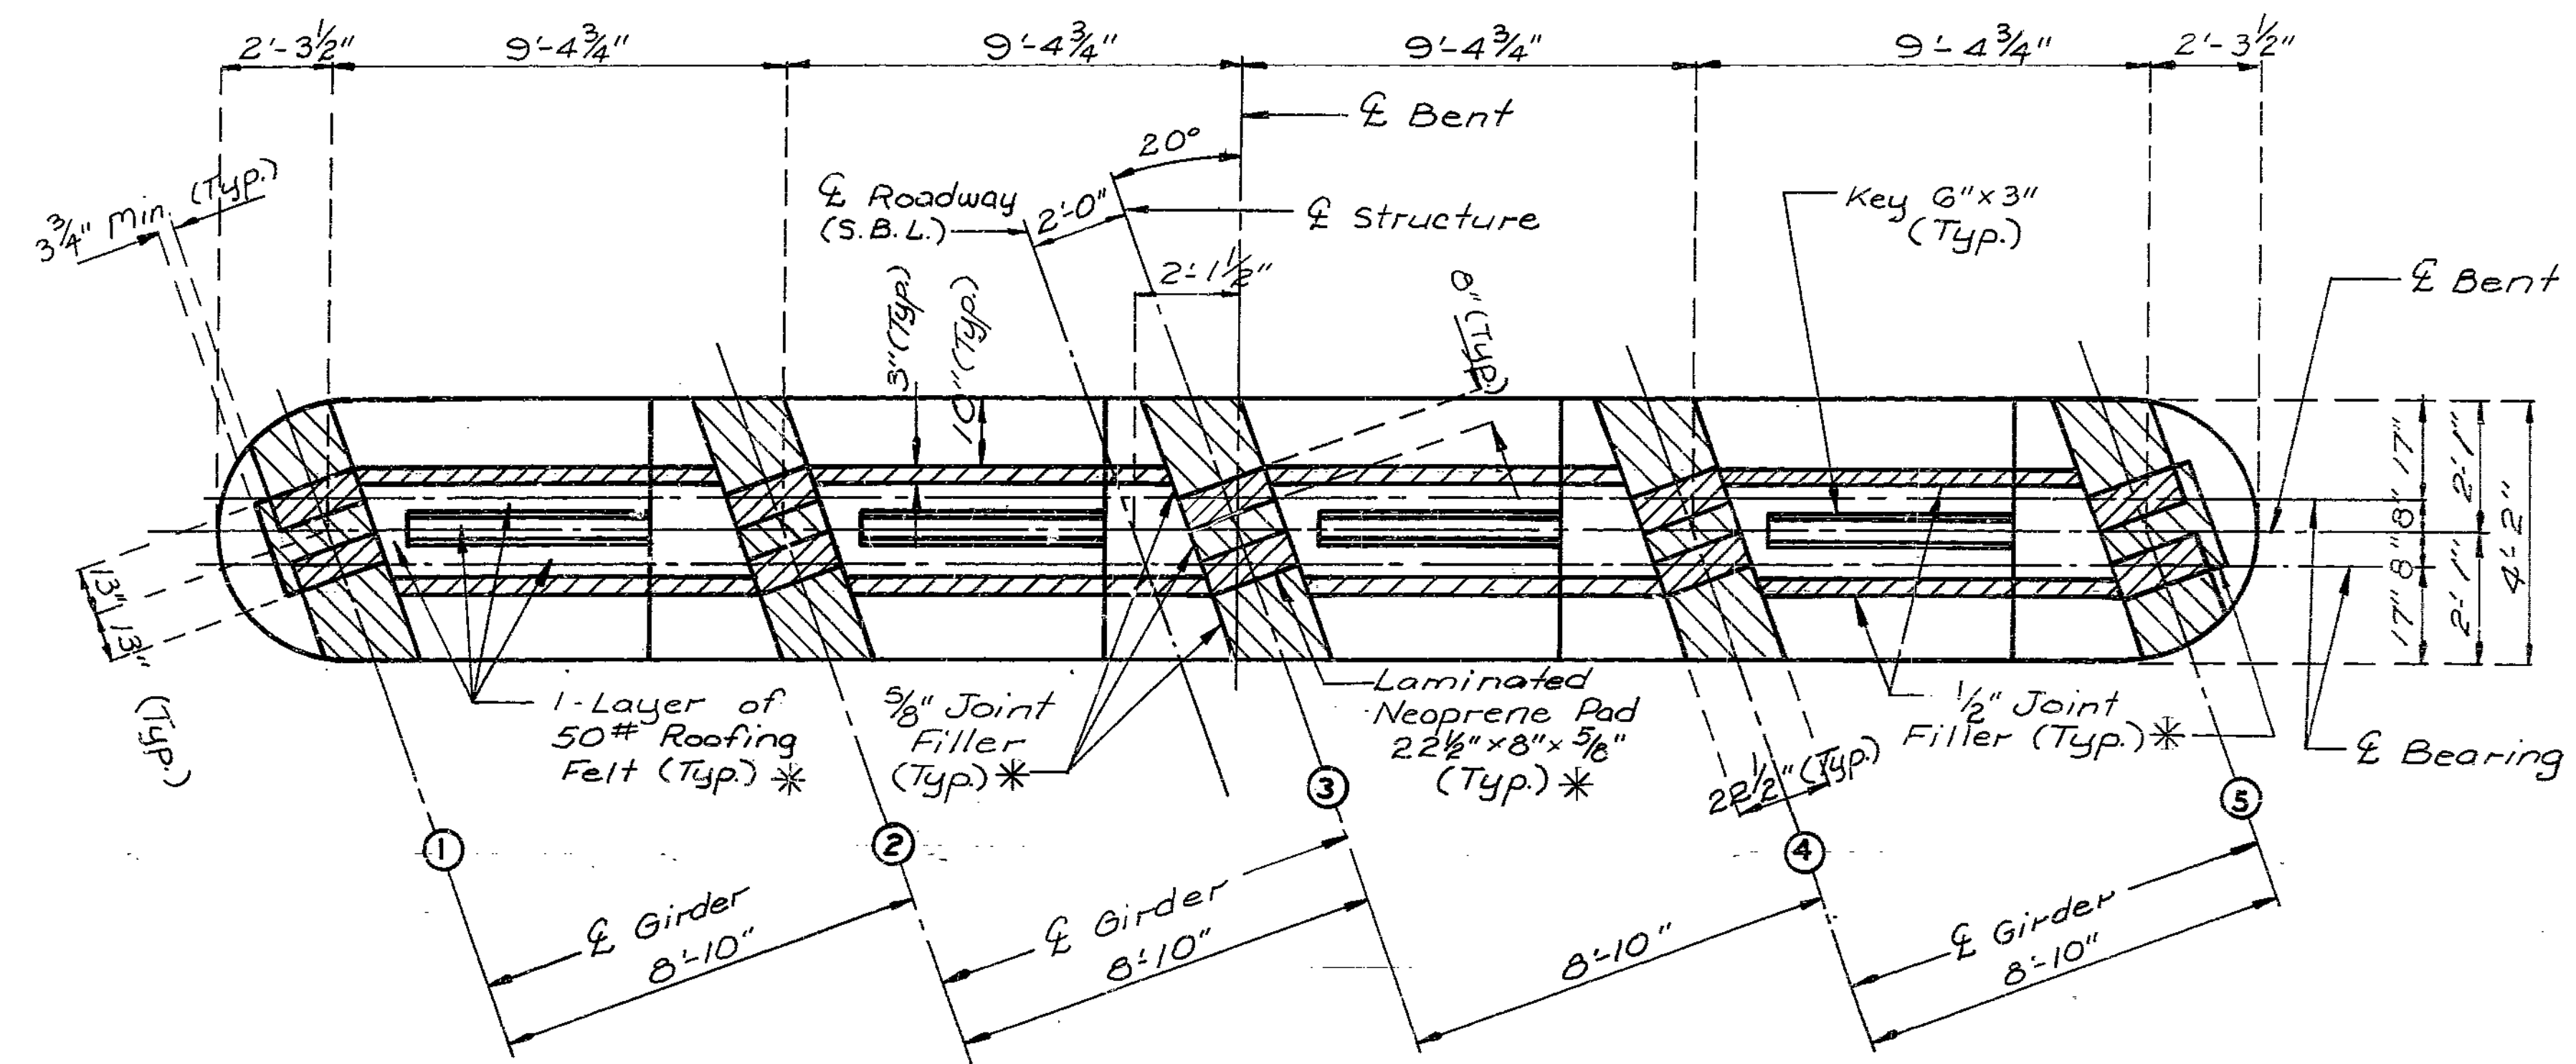


PLAN OF BEAM

\* Bearings, Jt. Filler & Roofing Felt are in future construction  
 Note: For details of Bt. No. 6 & 7 not shown see sheet No. 24.

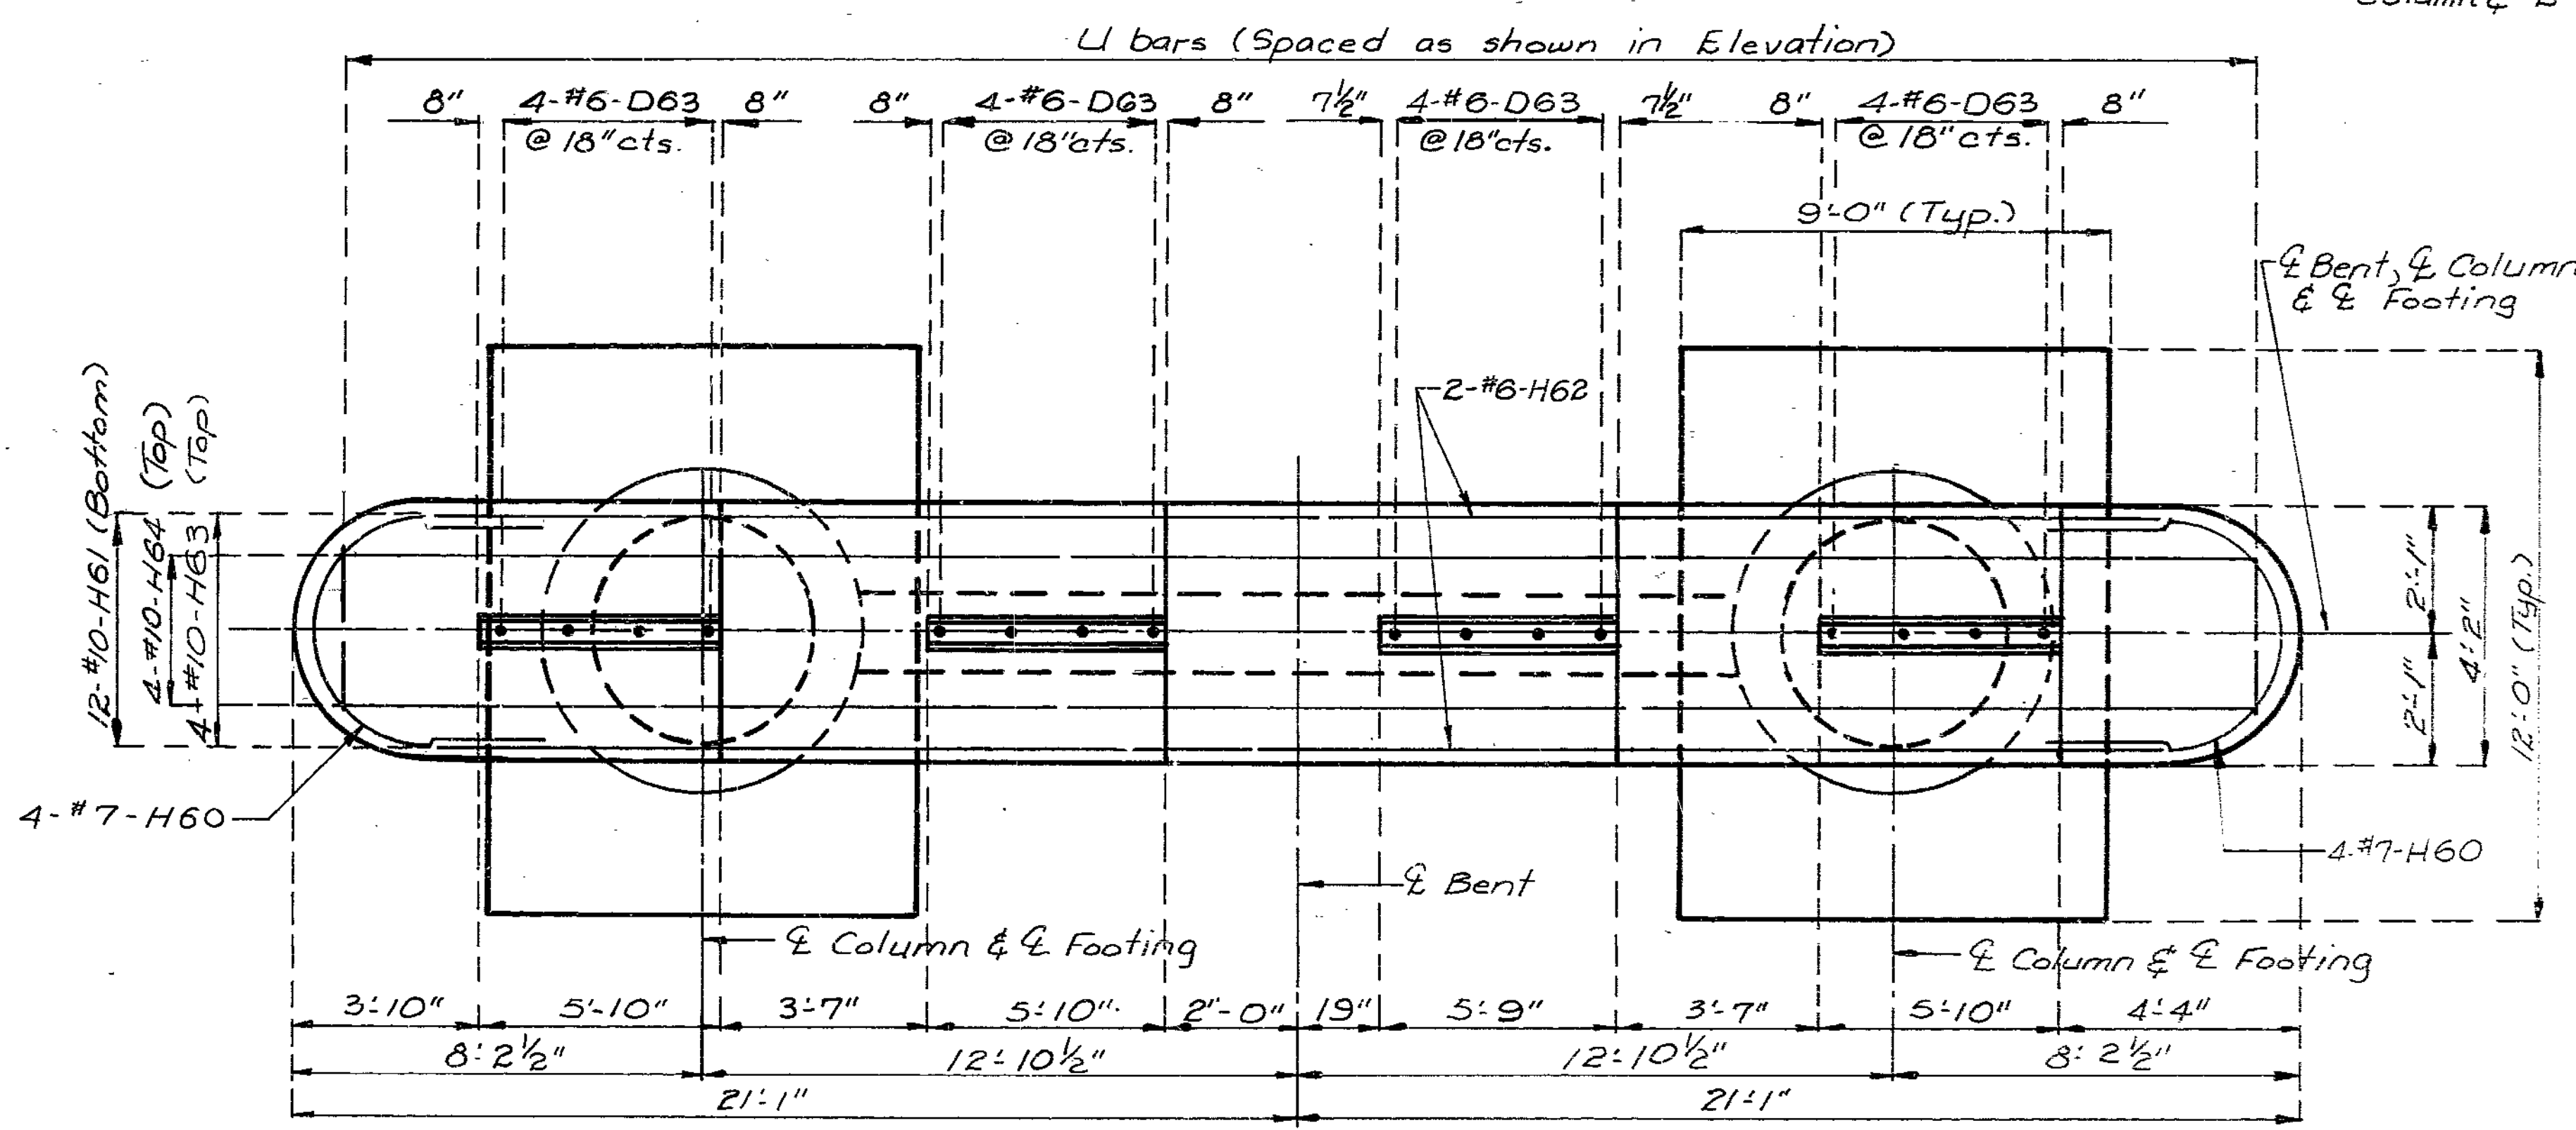

PLAN SHOWING REINFORCEMENT

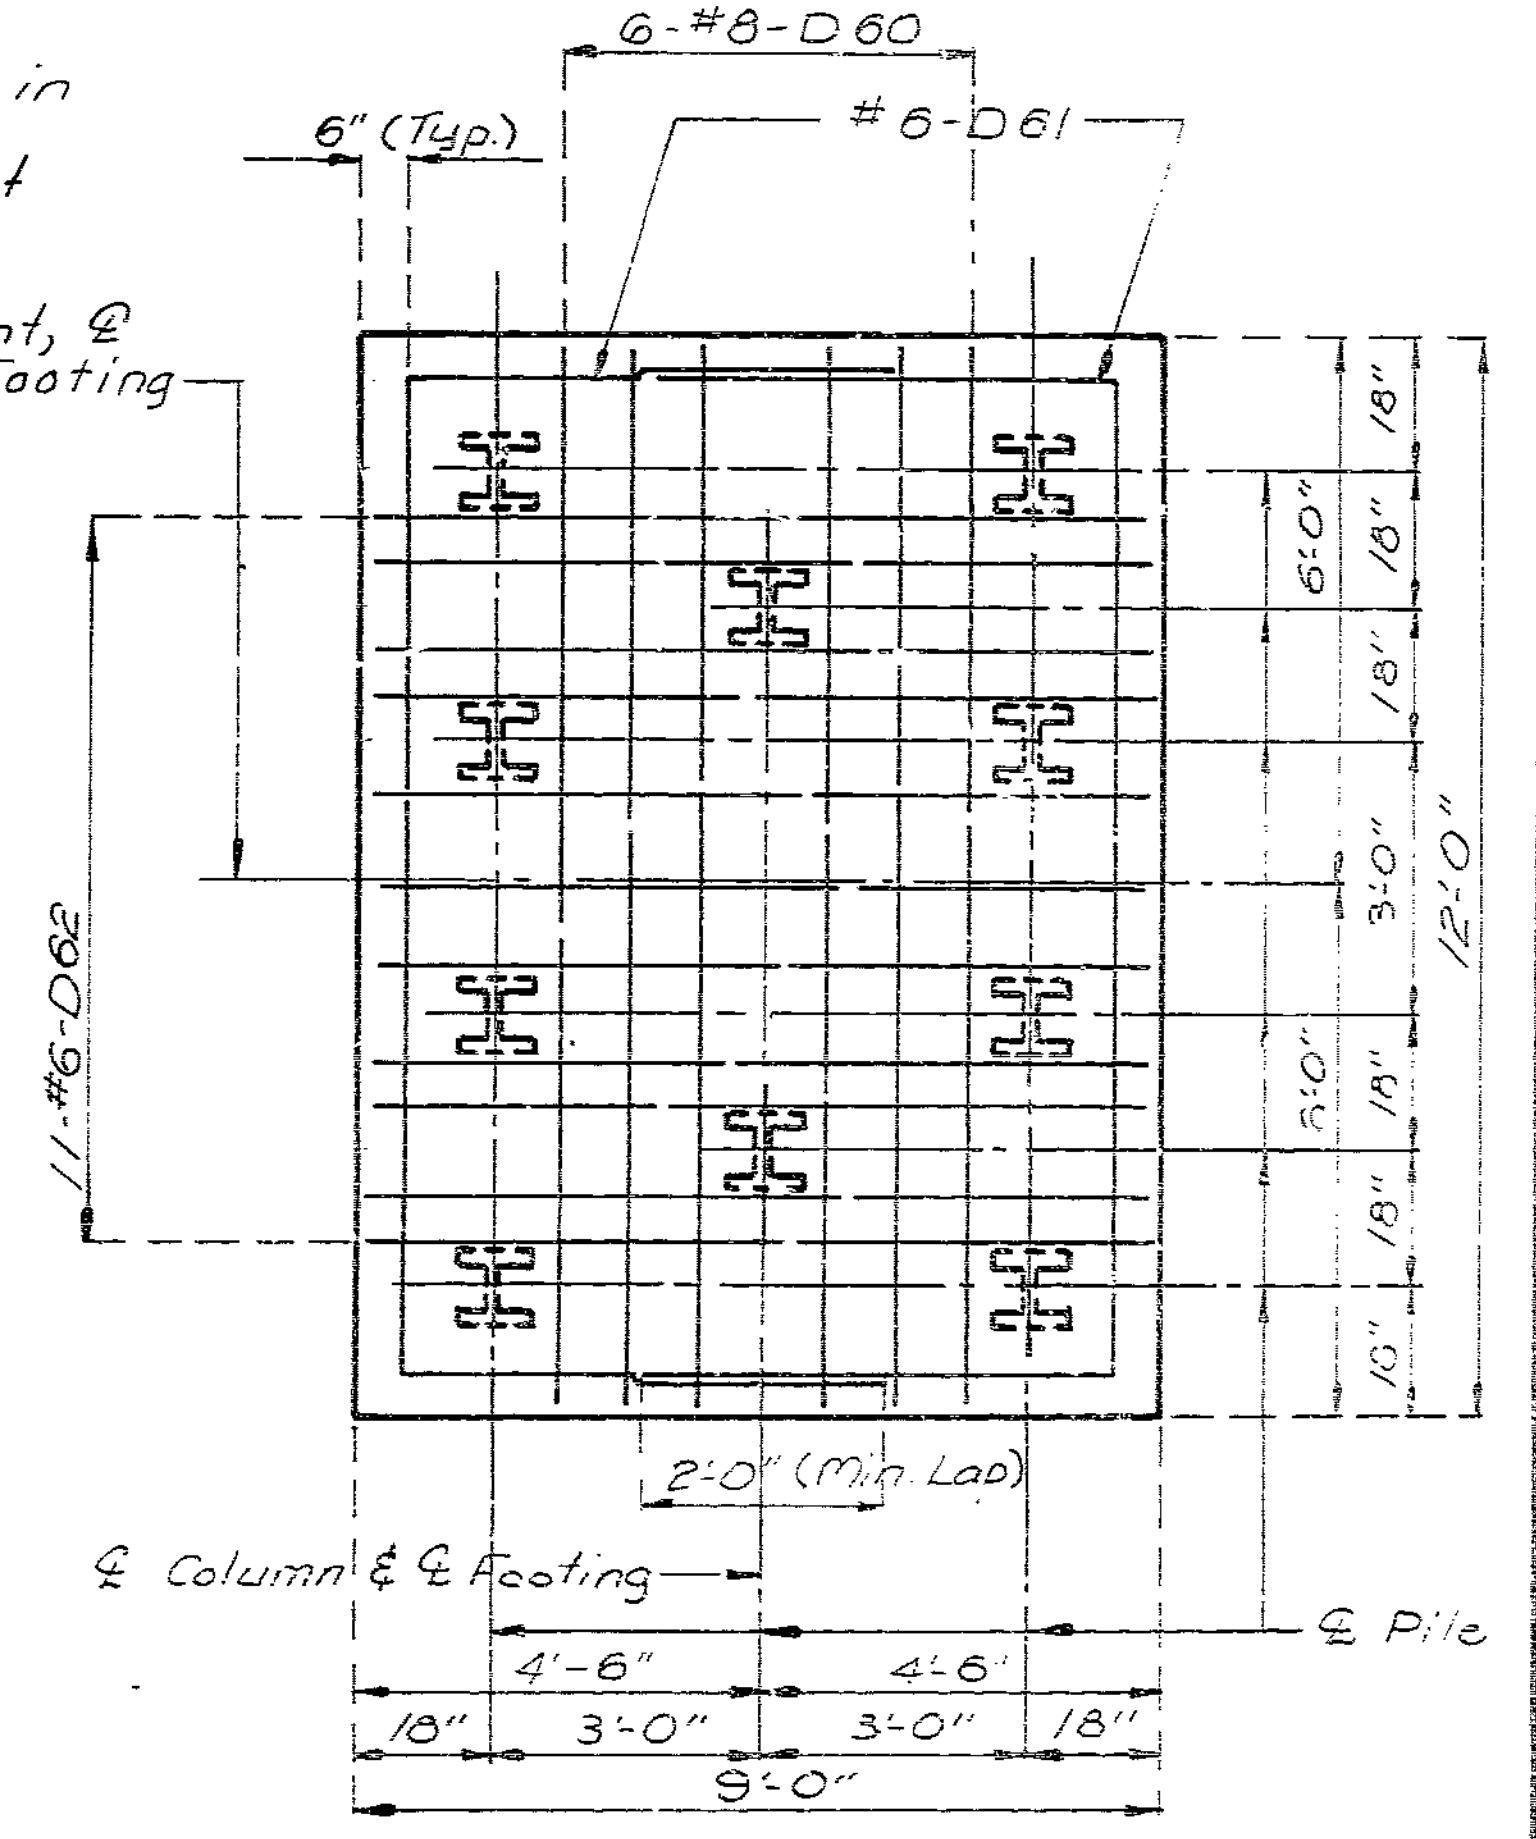

PLAN OF FOOTING SHOWING REINFORCEMENT

Note: For detail of pile splice see sheet No. 9.

DETAILS OF INTERMEDIATE BENT NO. 6 & 7

279 333

DETAILED APRIL 1988  
 CHECKED Aug. 1988

Note: This drawing is not to scale. Follow dimensions.

Sheet No. 23 of 36


JACKSON COUNTY

A-2745






STATE	PROJ. NO.	SHEET NO.
MO.		80

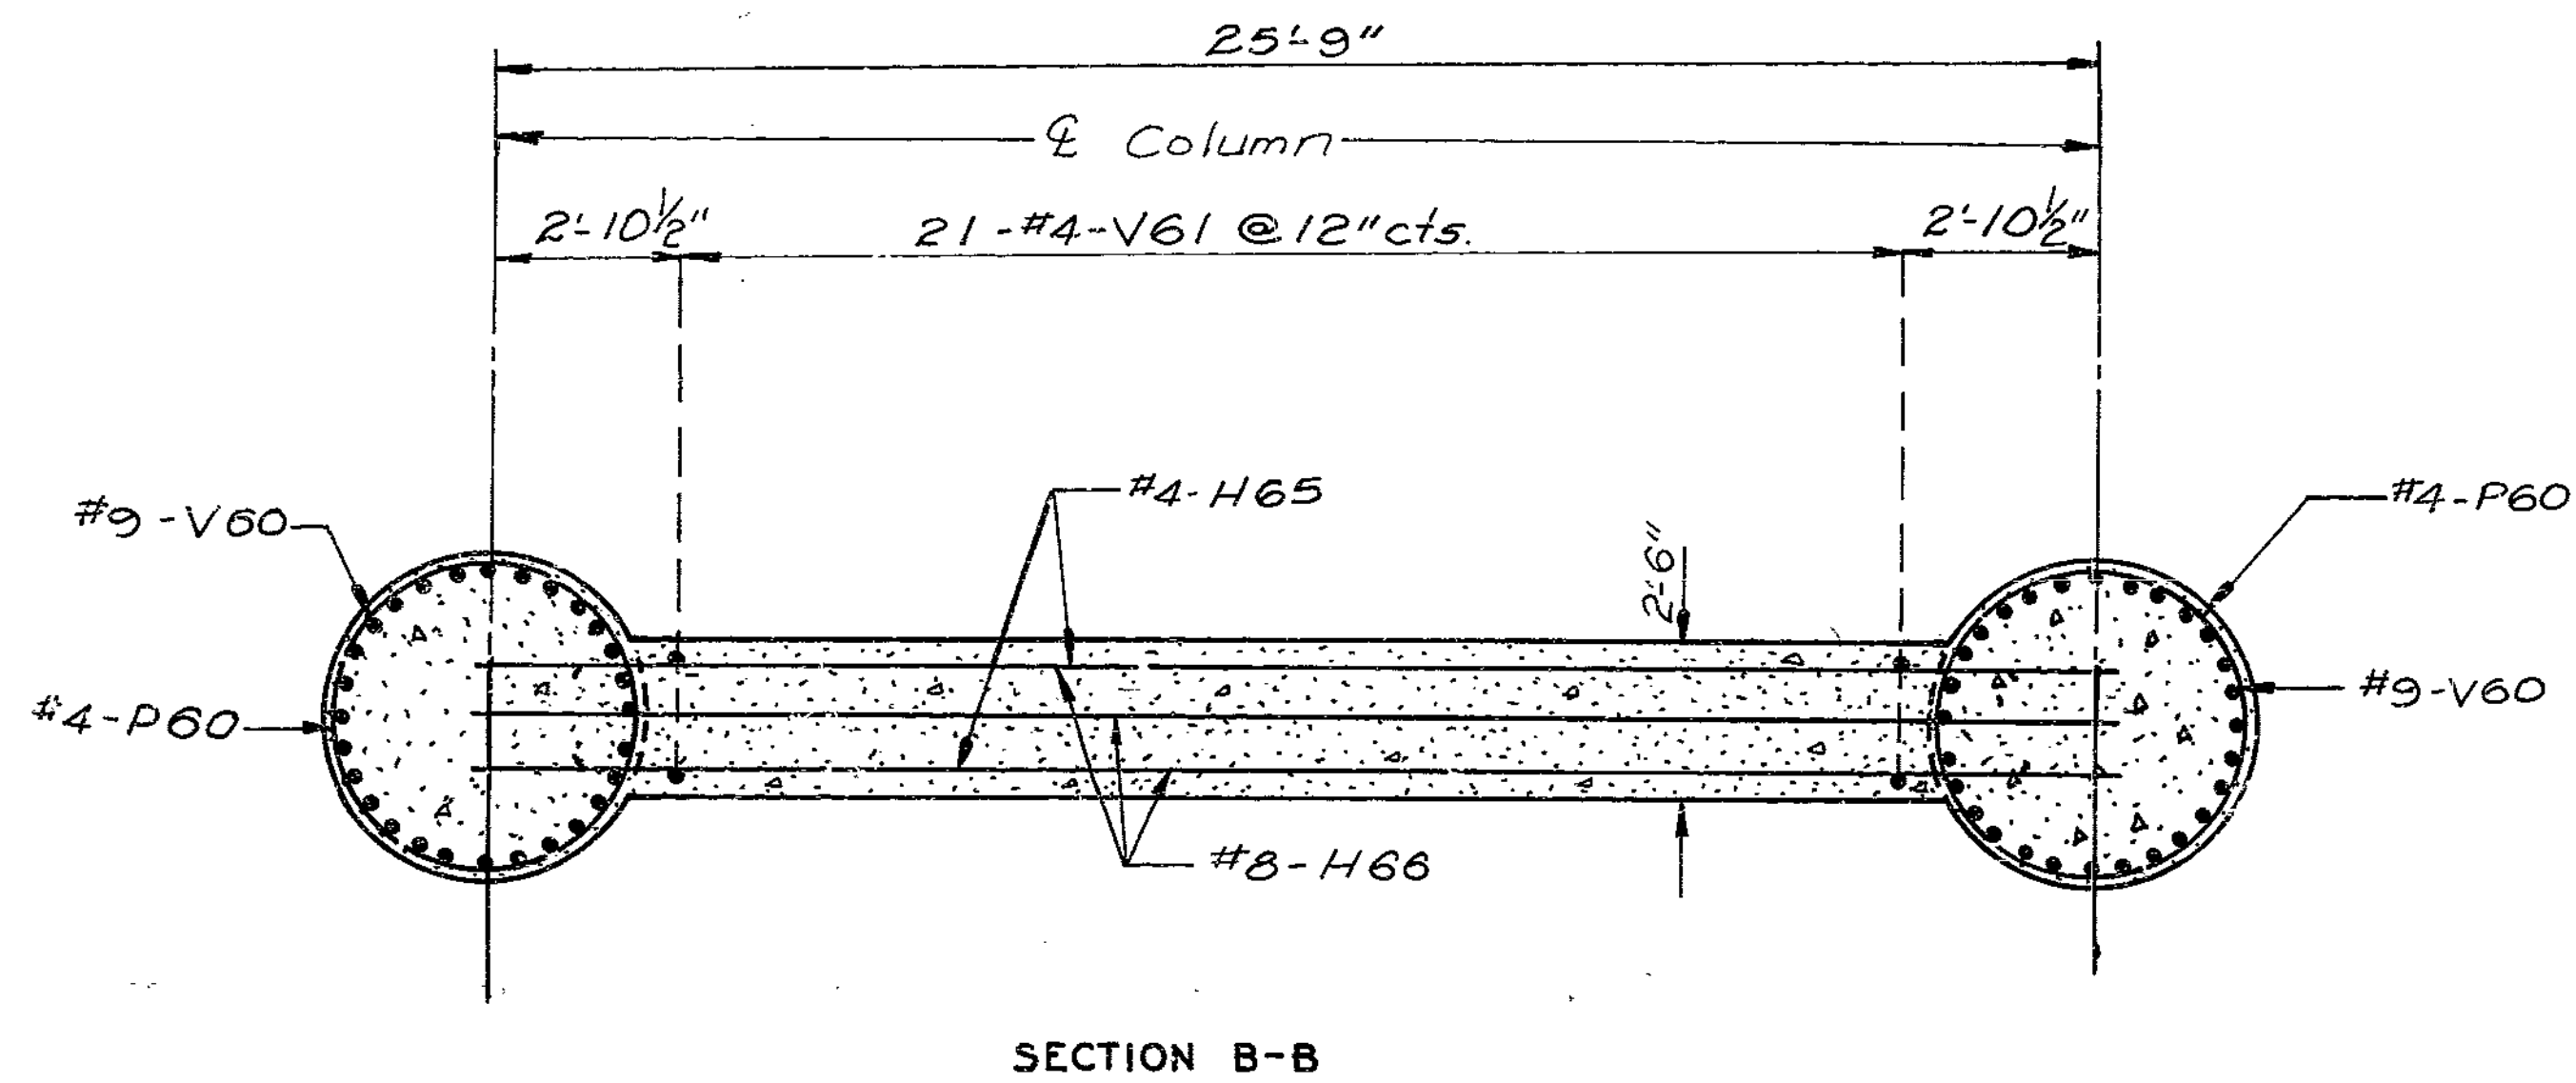


SECTION B-B

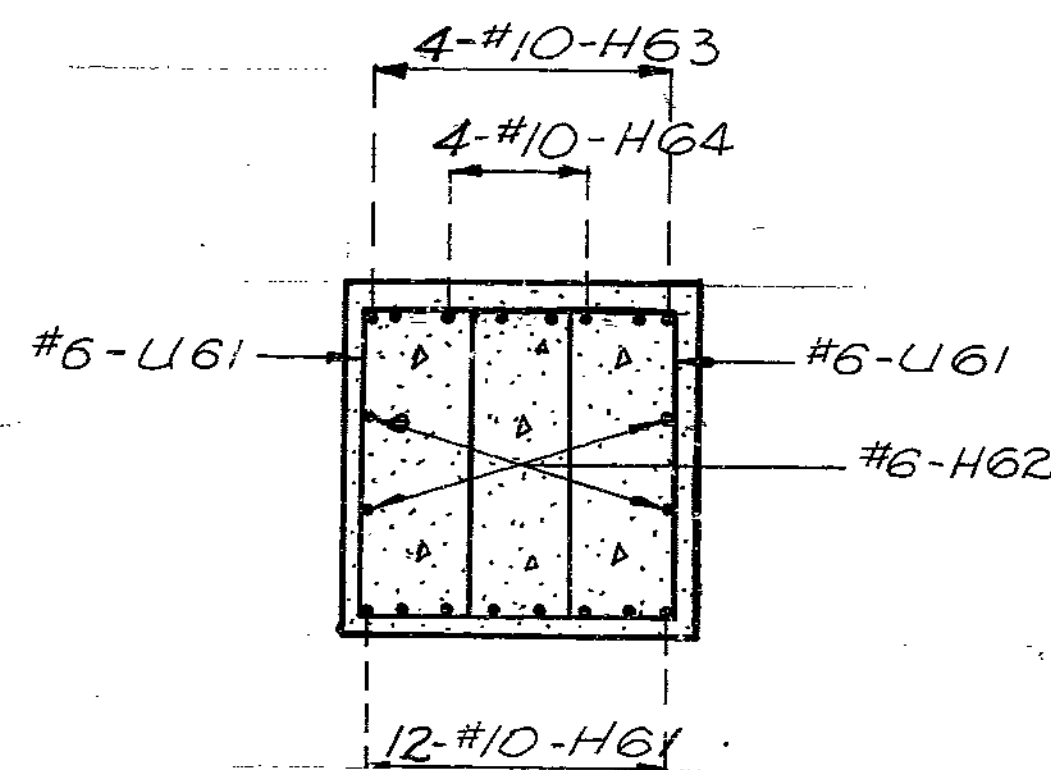

SECTION C-C

Note: For location of Section A-A, B-B & C-C see sheet No. 24.

Note: For detail of pile splice see sheet No. 9.

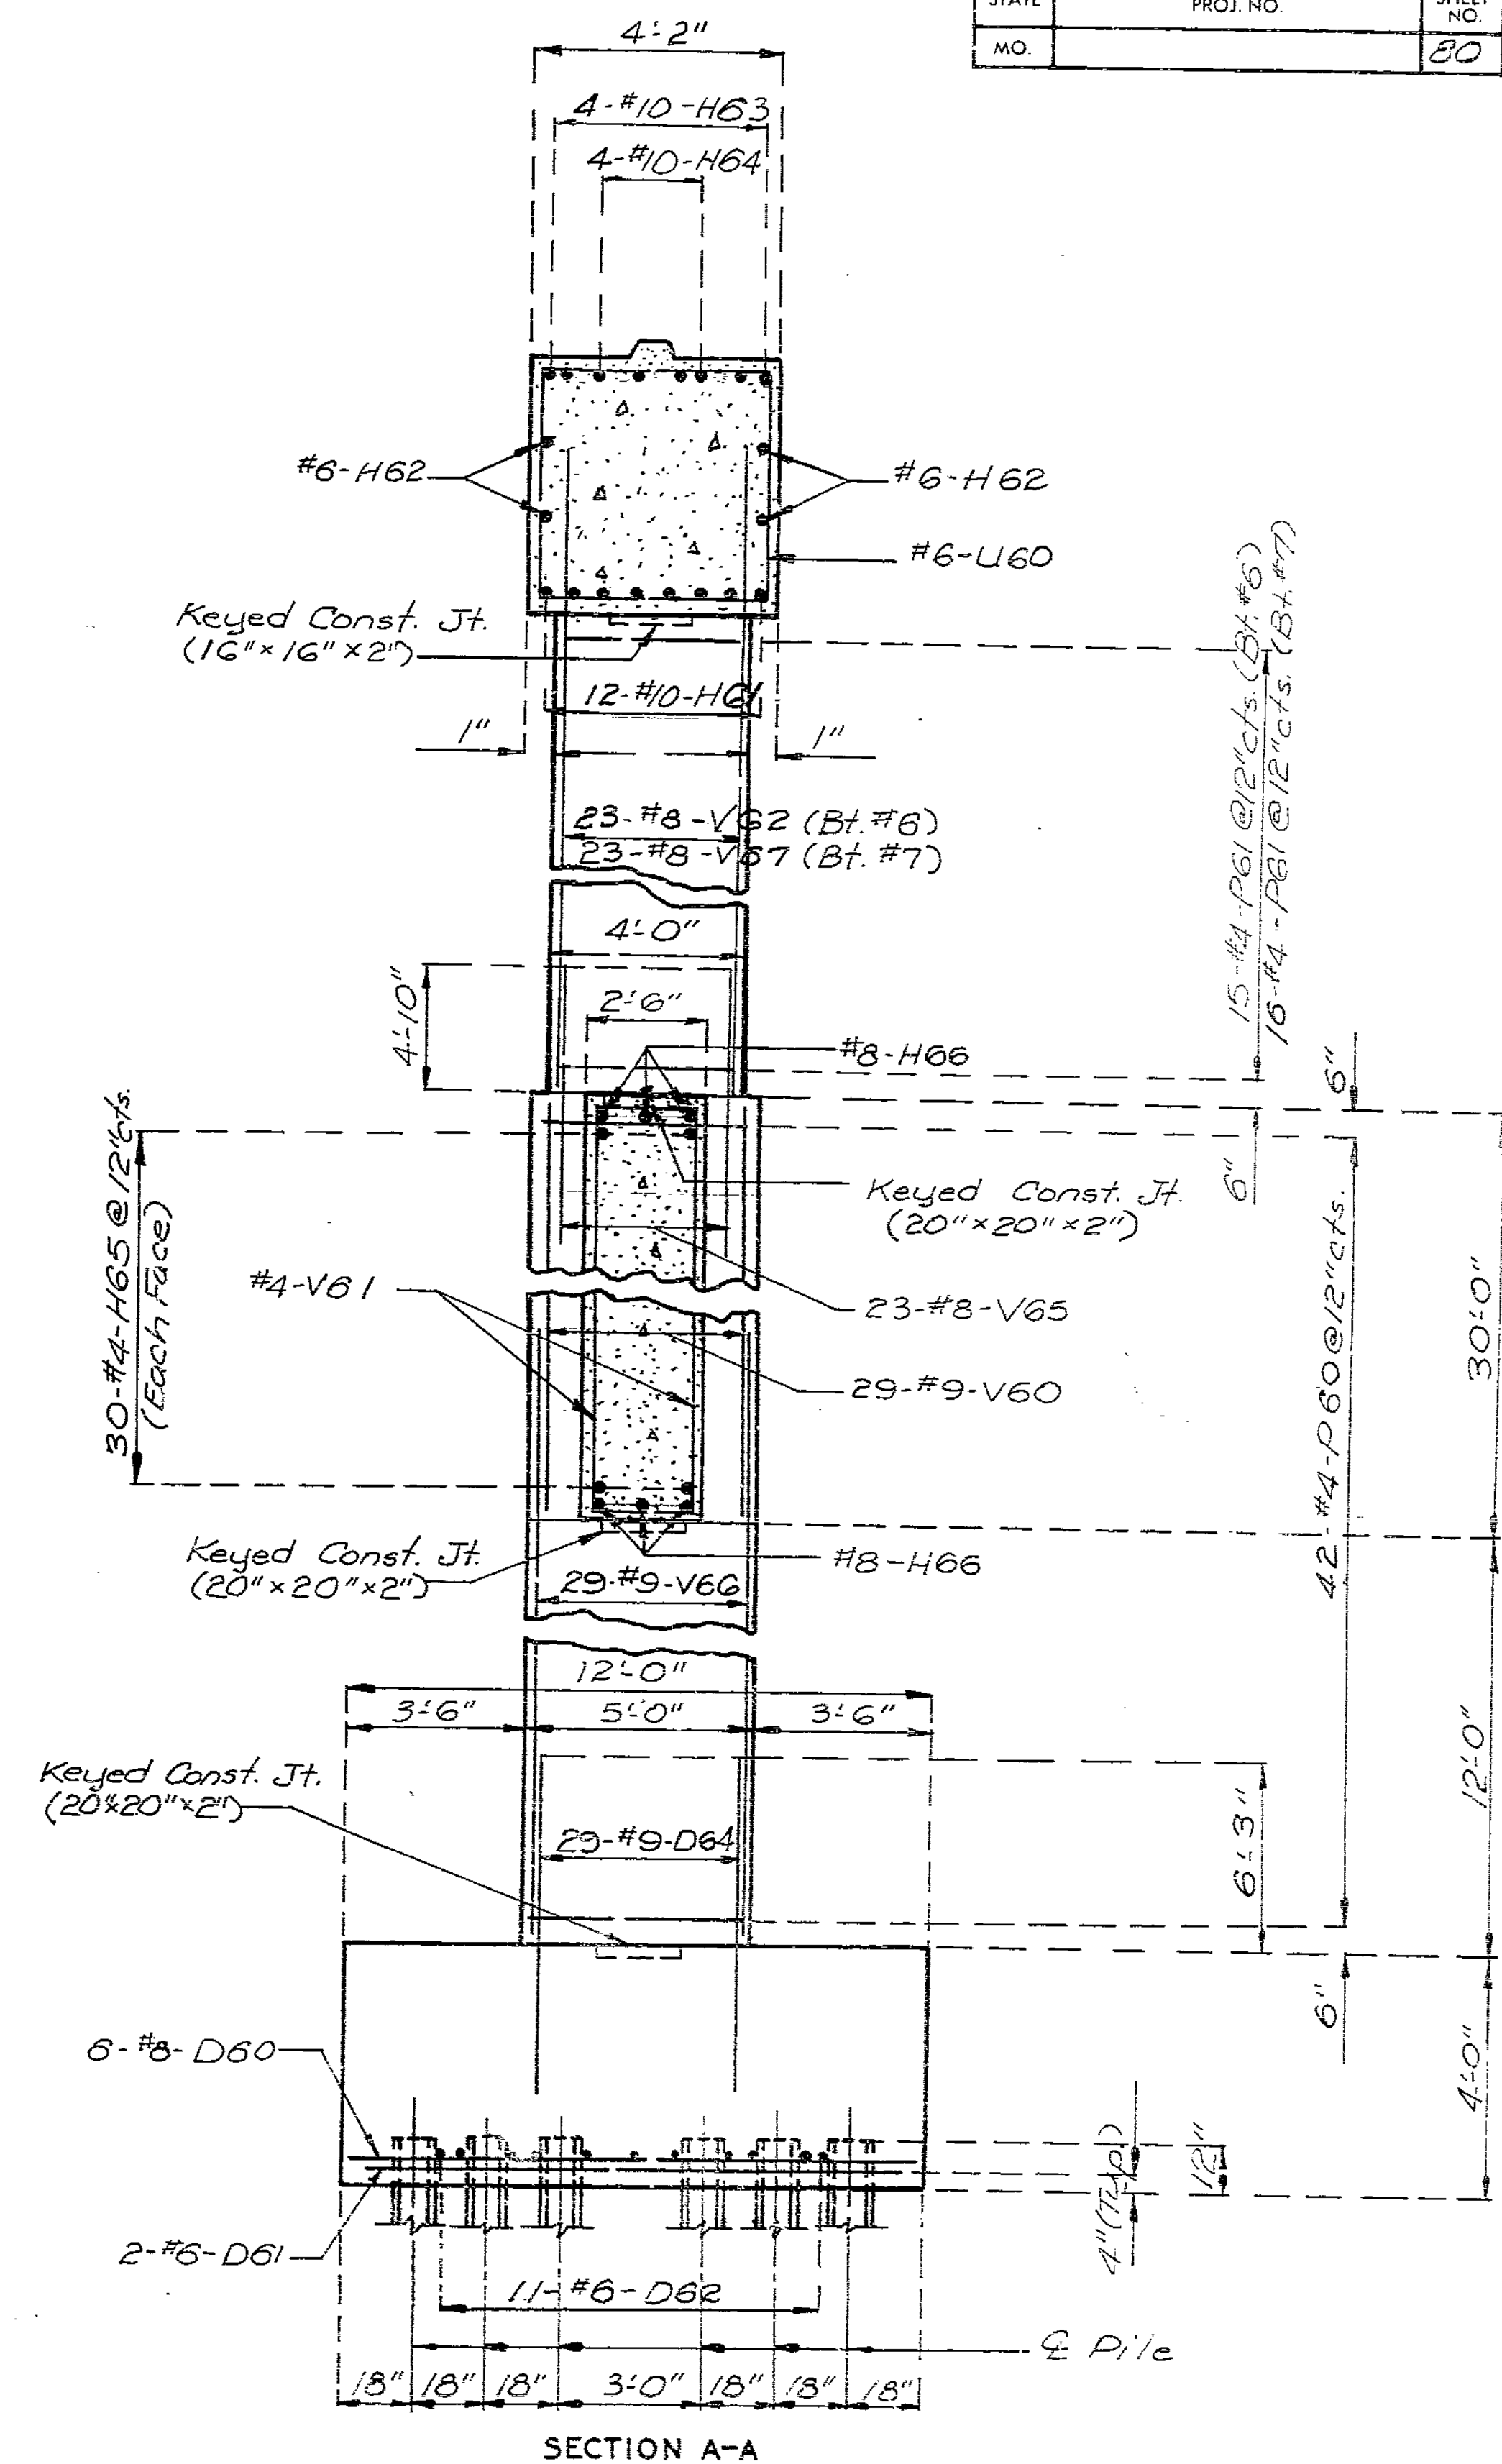

SECTION A-A

DETAILS OF INTERMEDIATE BENT NO. 6&7

88X 335

DATE: DETAILED MAY 1988  
CHECKED Aug. 1988

Note: This drawing is not to scale. Follow dimensions.

Sheet No. 25 of 55



JACKSON COUNTY

A-2745





STATE	PROJ. NO.	SHEET NO.
MO.		82

Note: For details of Bl. No 9 not shown see sheet No. 28.  
 For Details of Anchor Bolt Spirals see sheet No. 9.  
 \* Bearings and Anchor Bolts are included in Future construction.

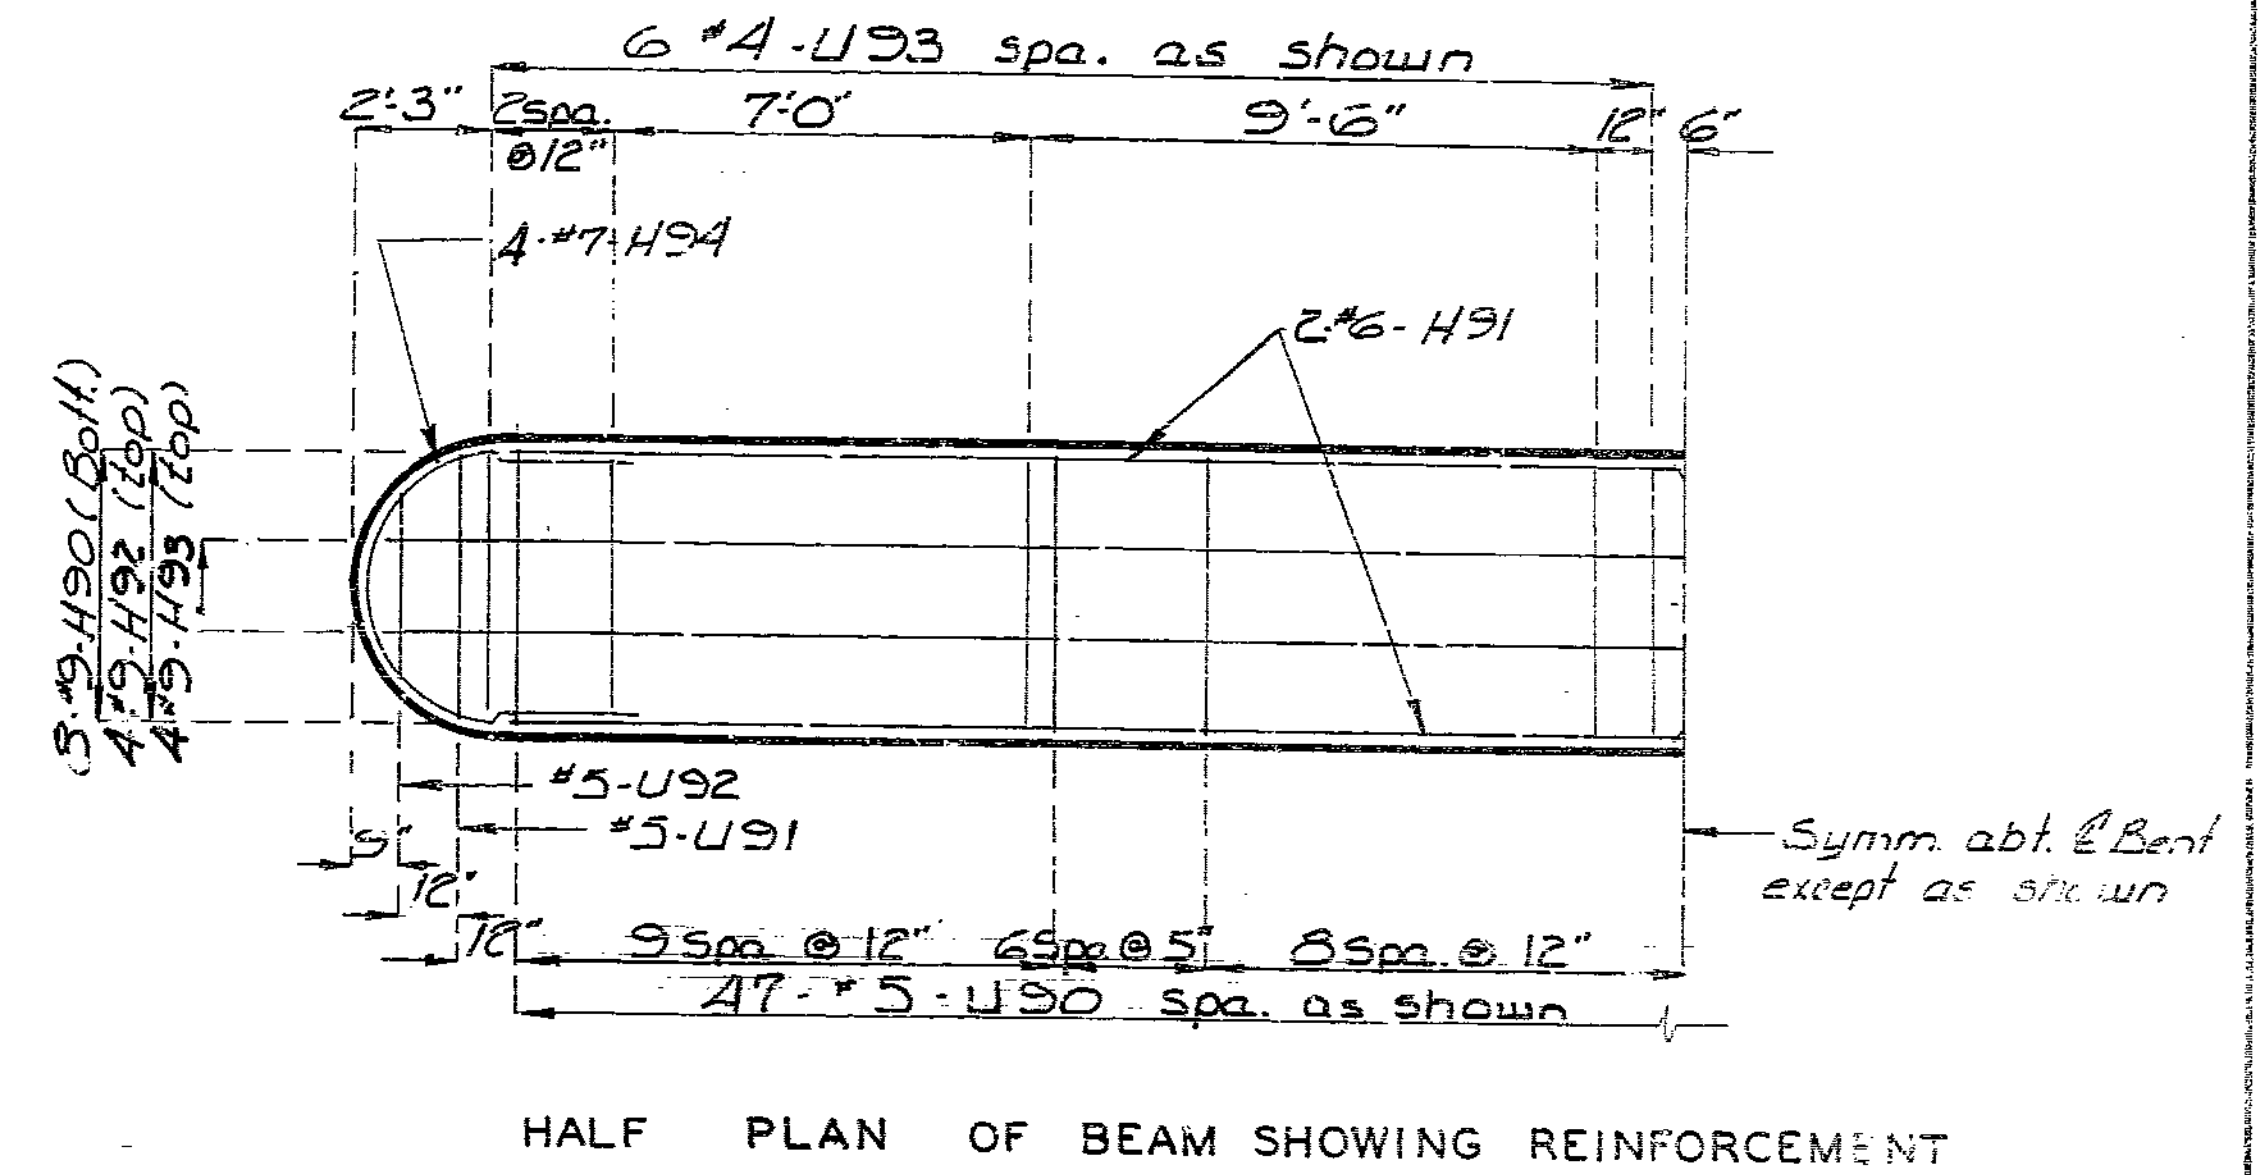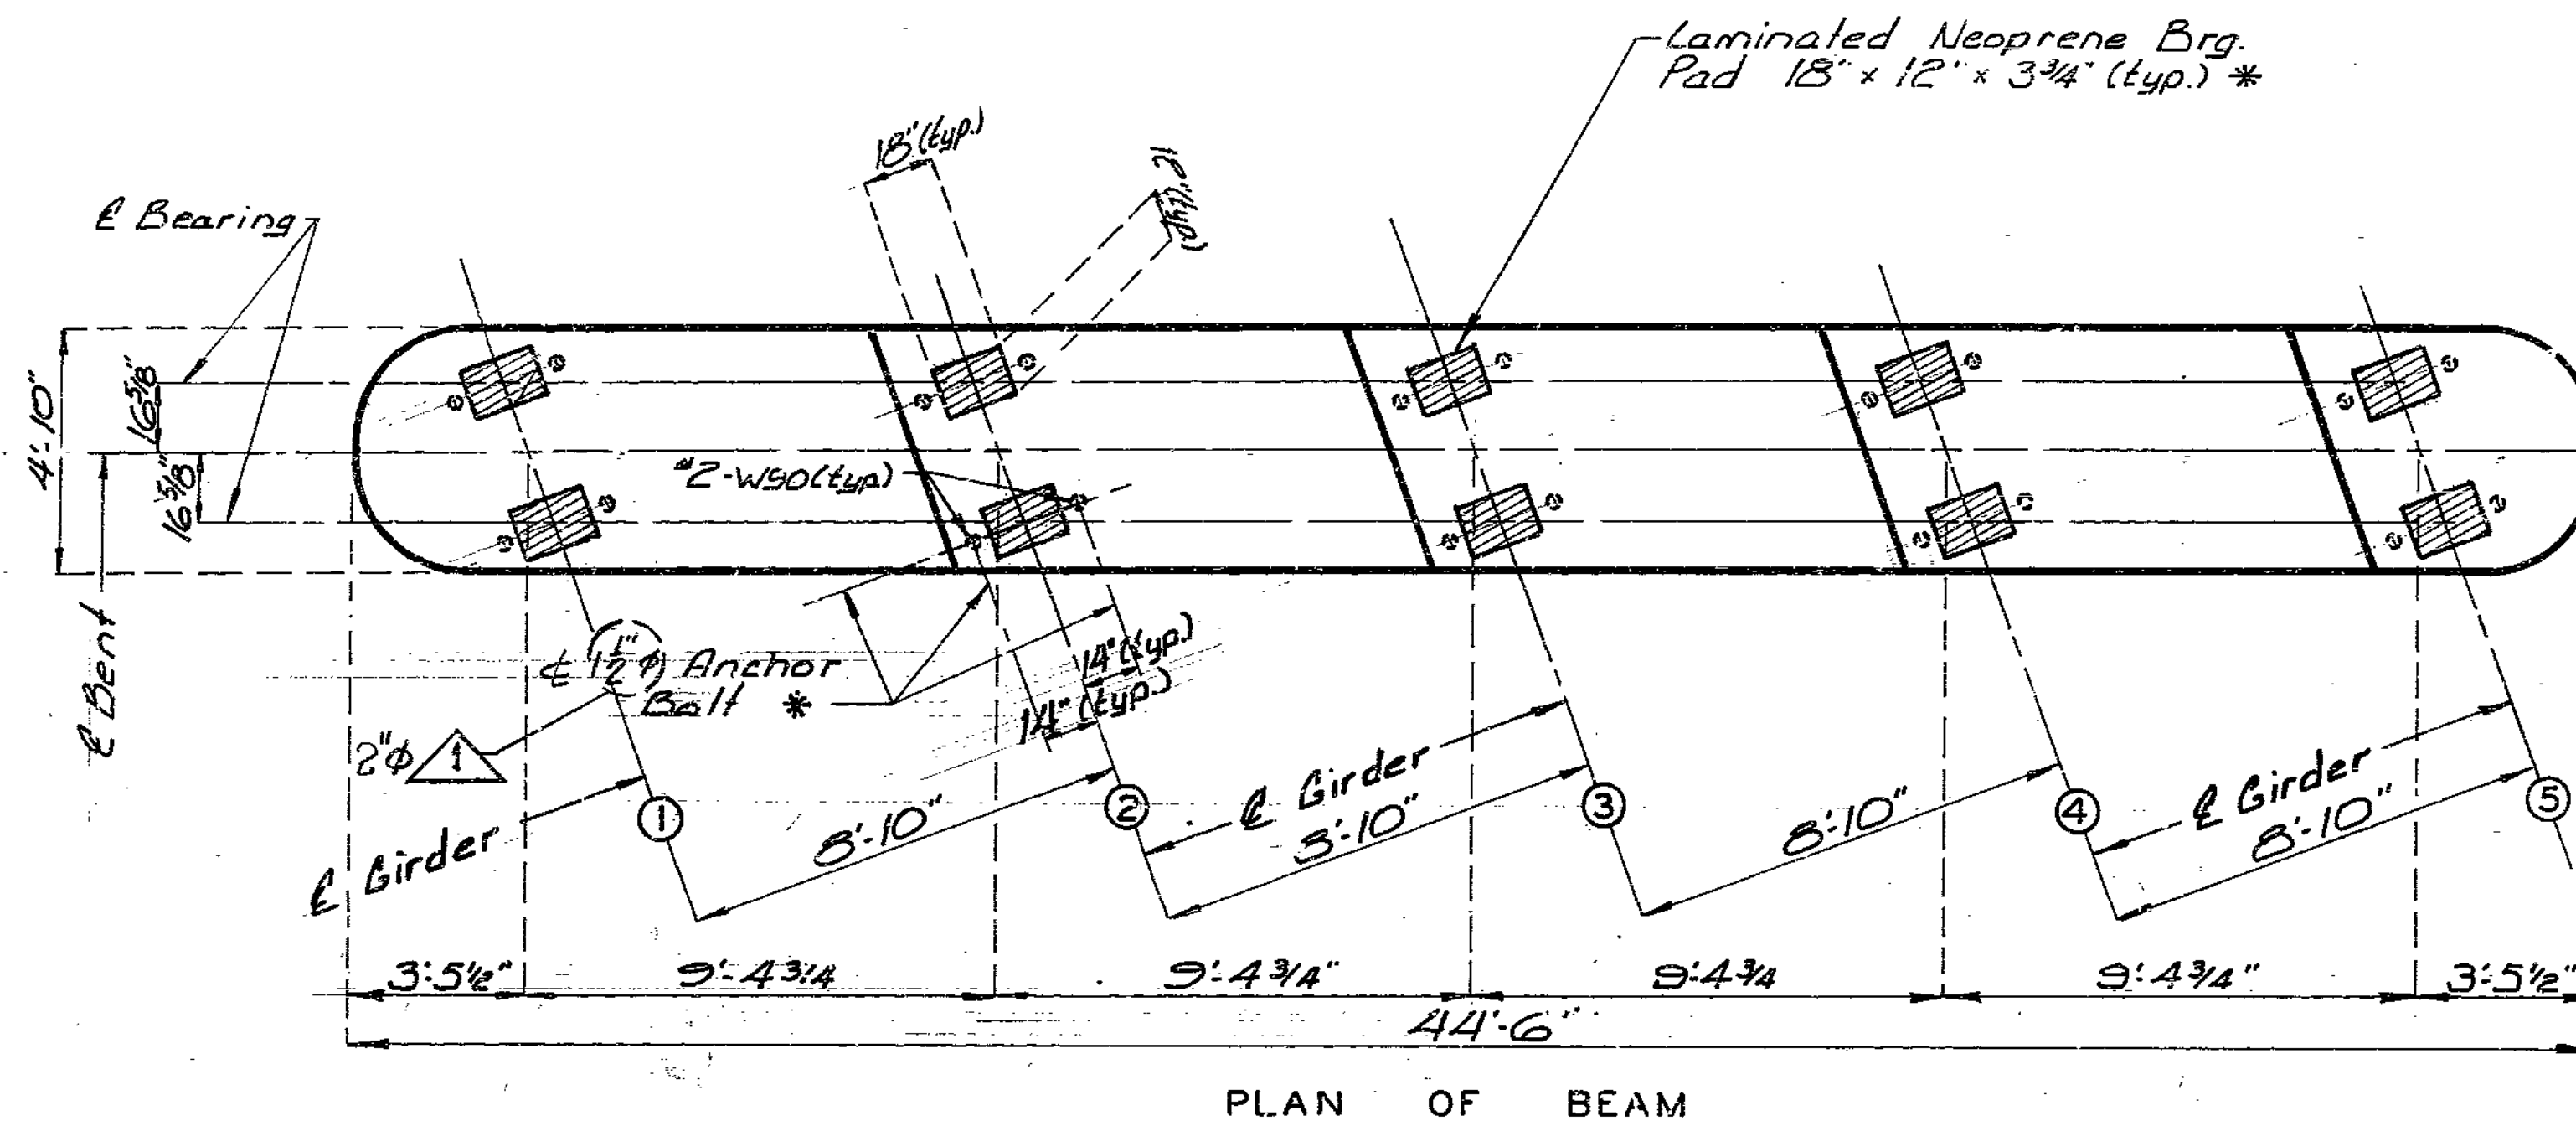

A23 337

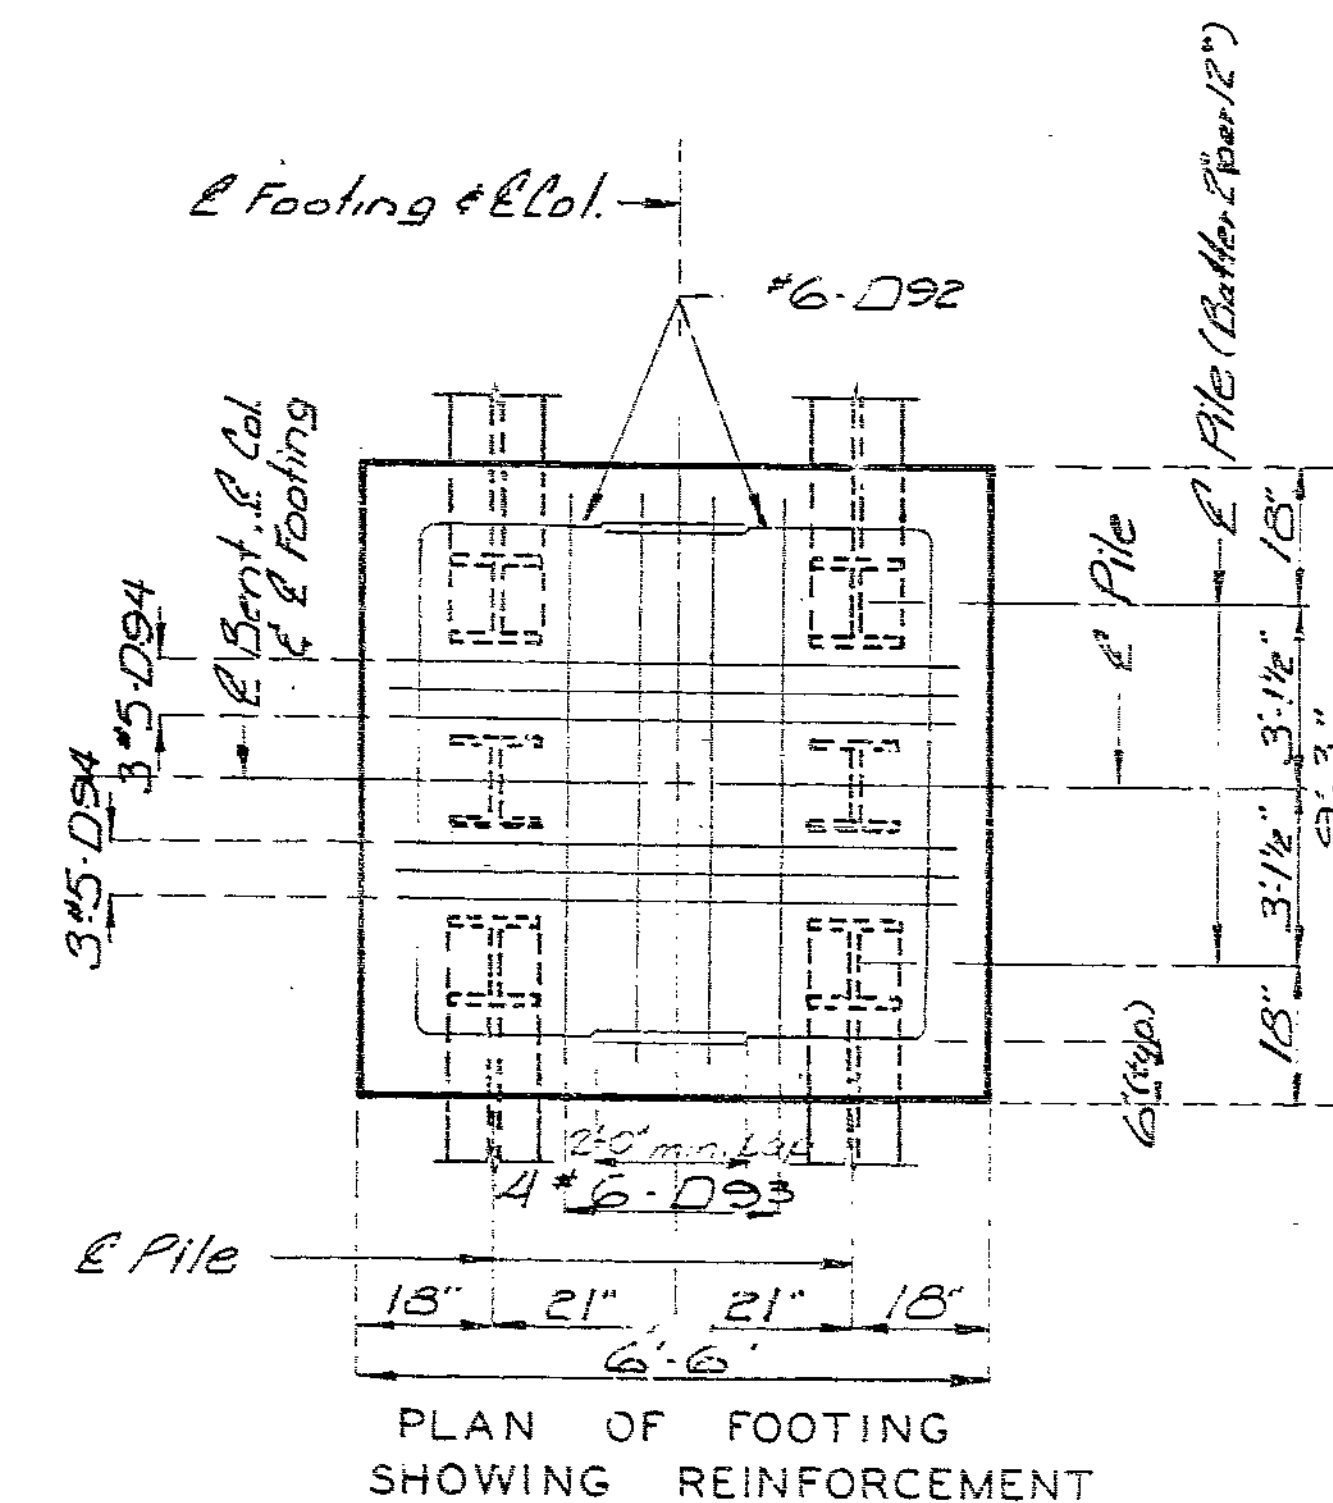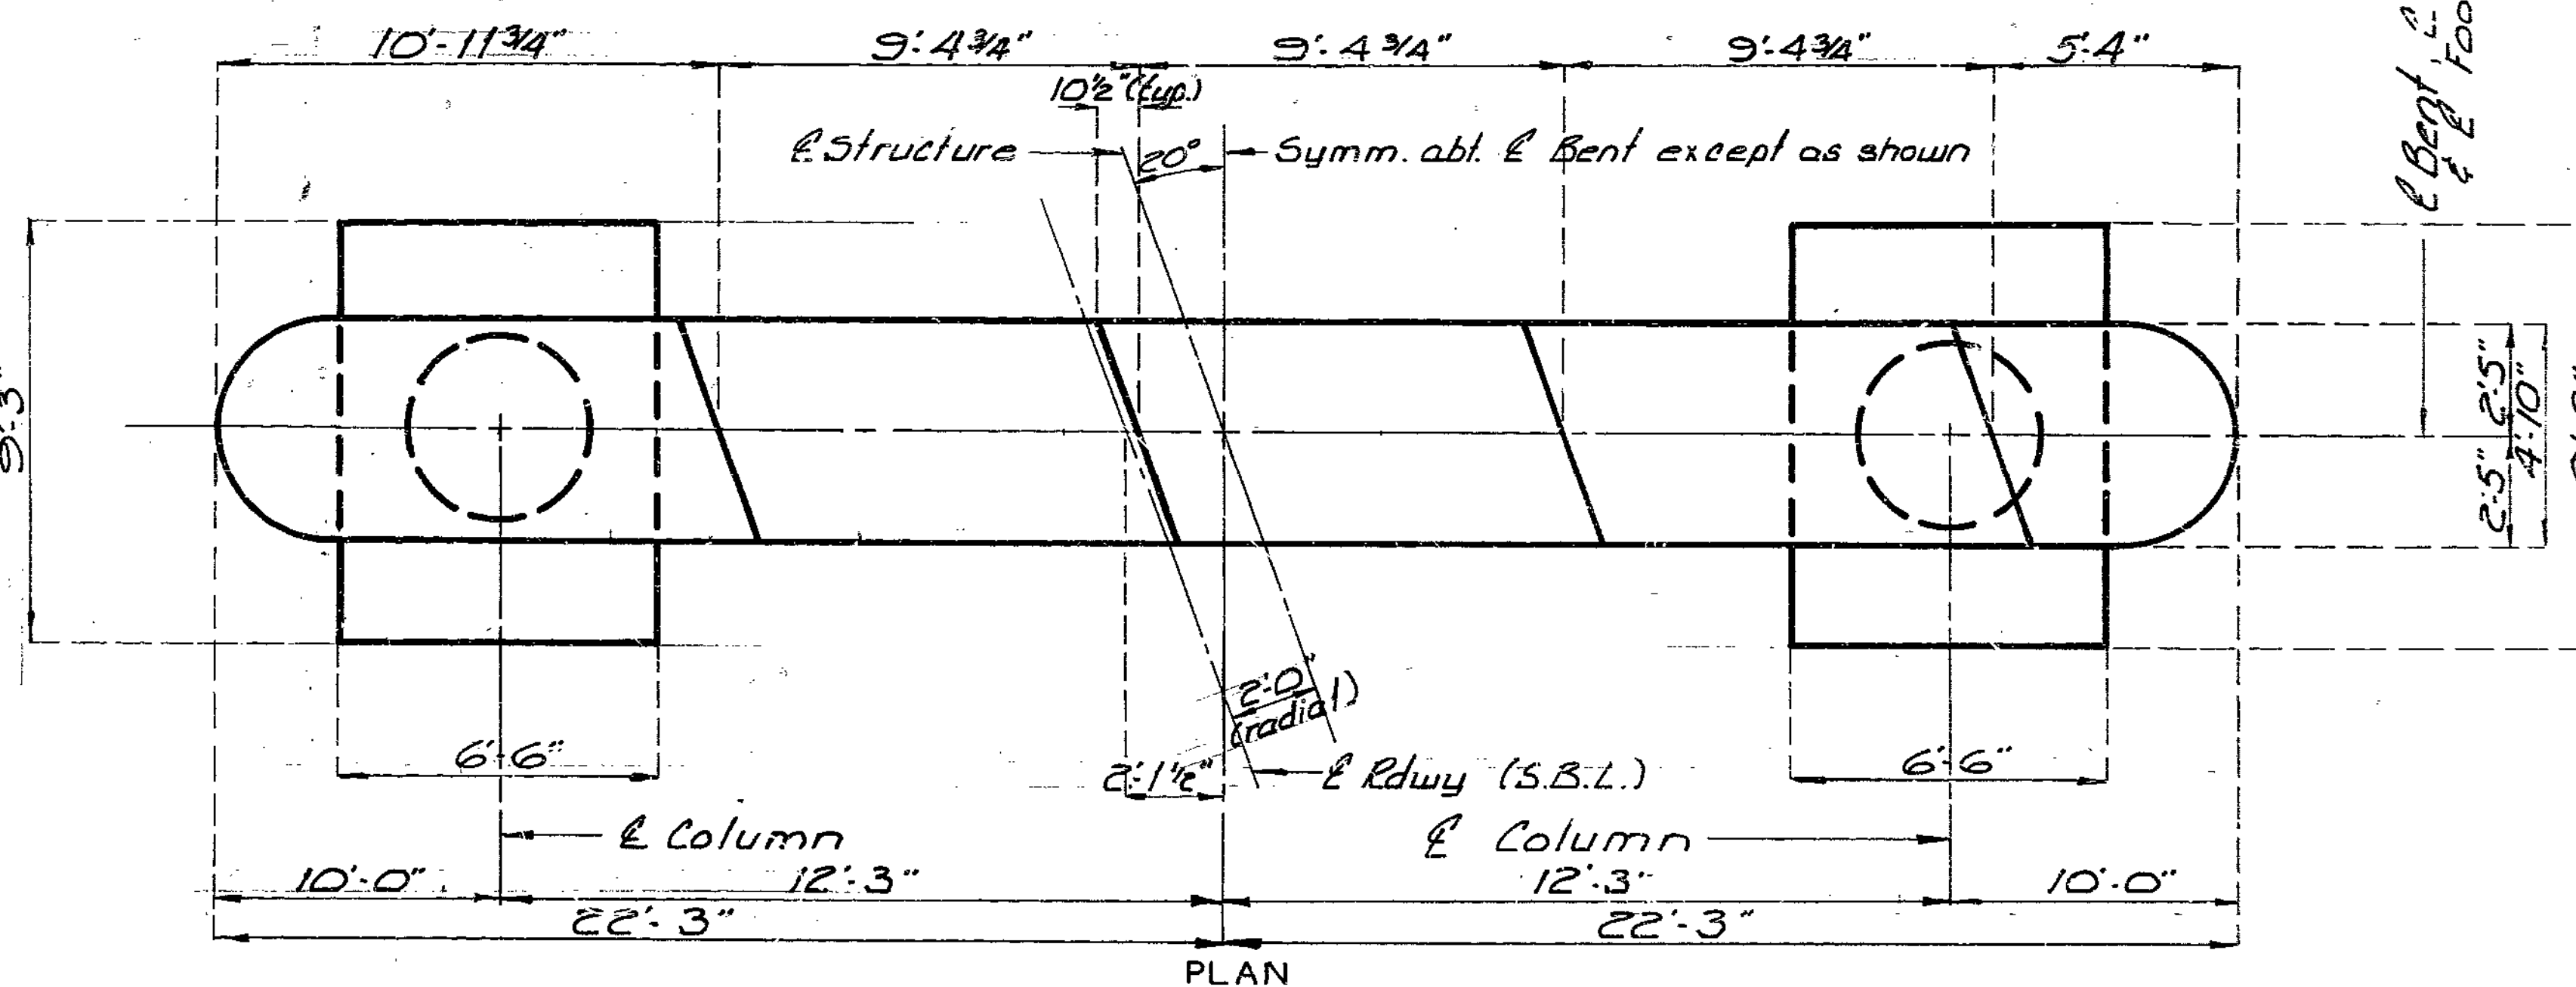

DETAILS OF INTERMEDIATE BENT NO. 9

DETAILED MAY 1988  
 CHECKED August 1988

Note: This drawing is not to scale. Follow dimensions.

Revised 3/8/89



Sheet No. 27 of 58

JACKSON

COUNTY

A-2745

STATE	PROJ. NO.	SHEET NO.
MO.		33

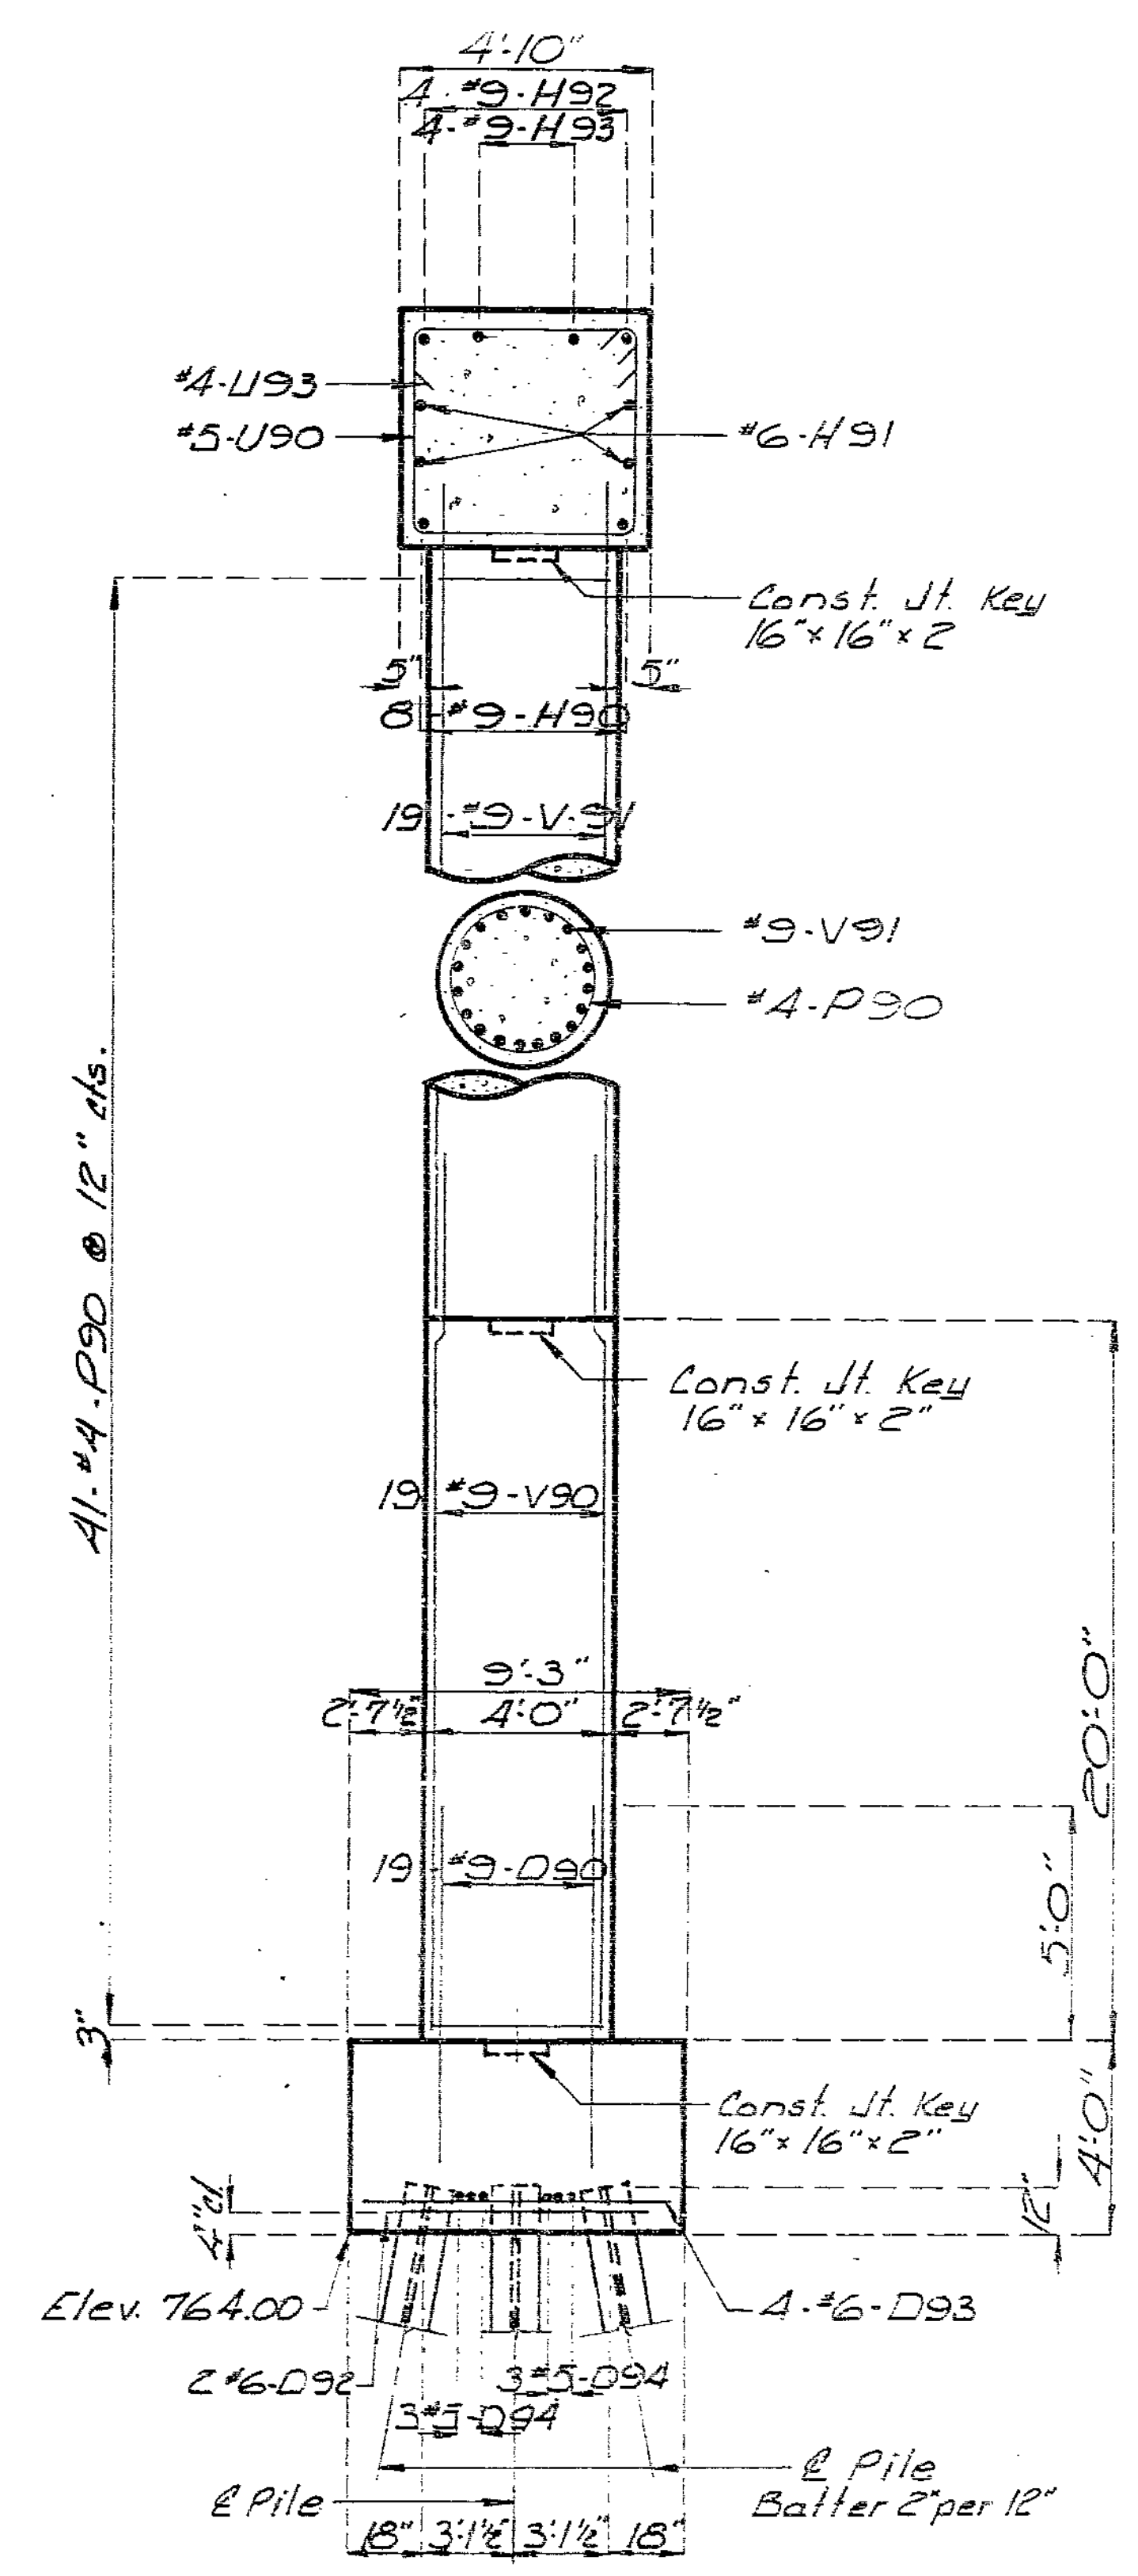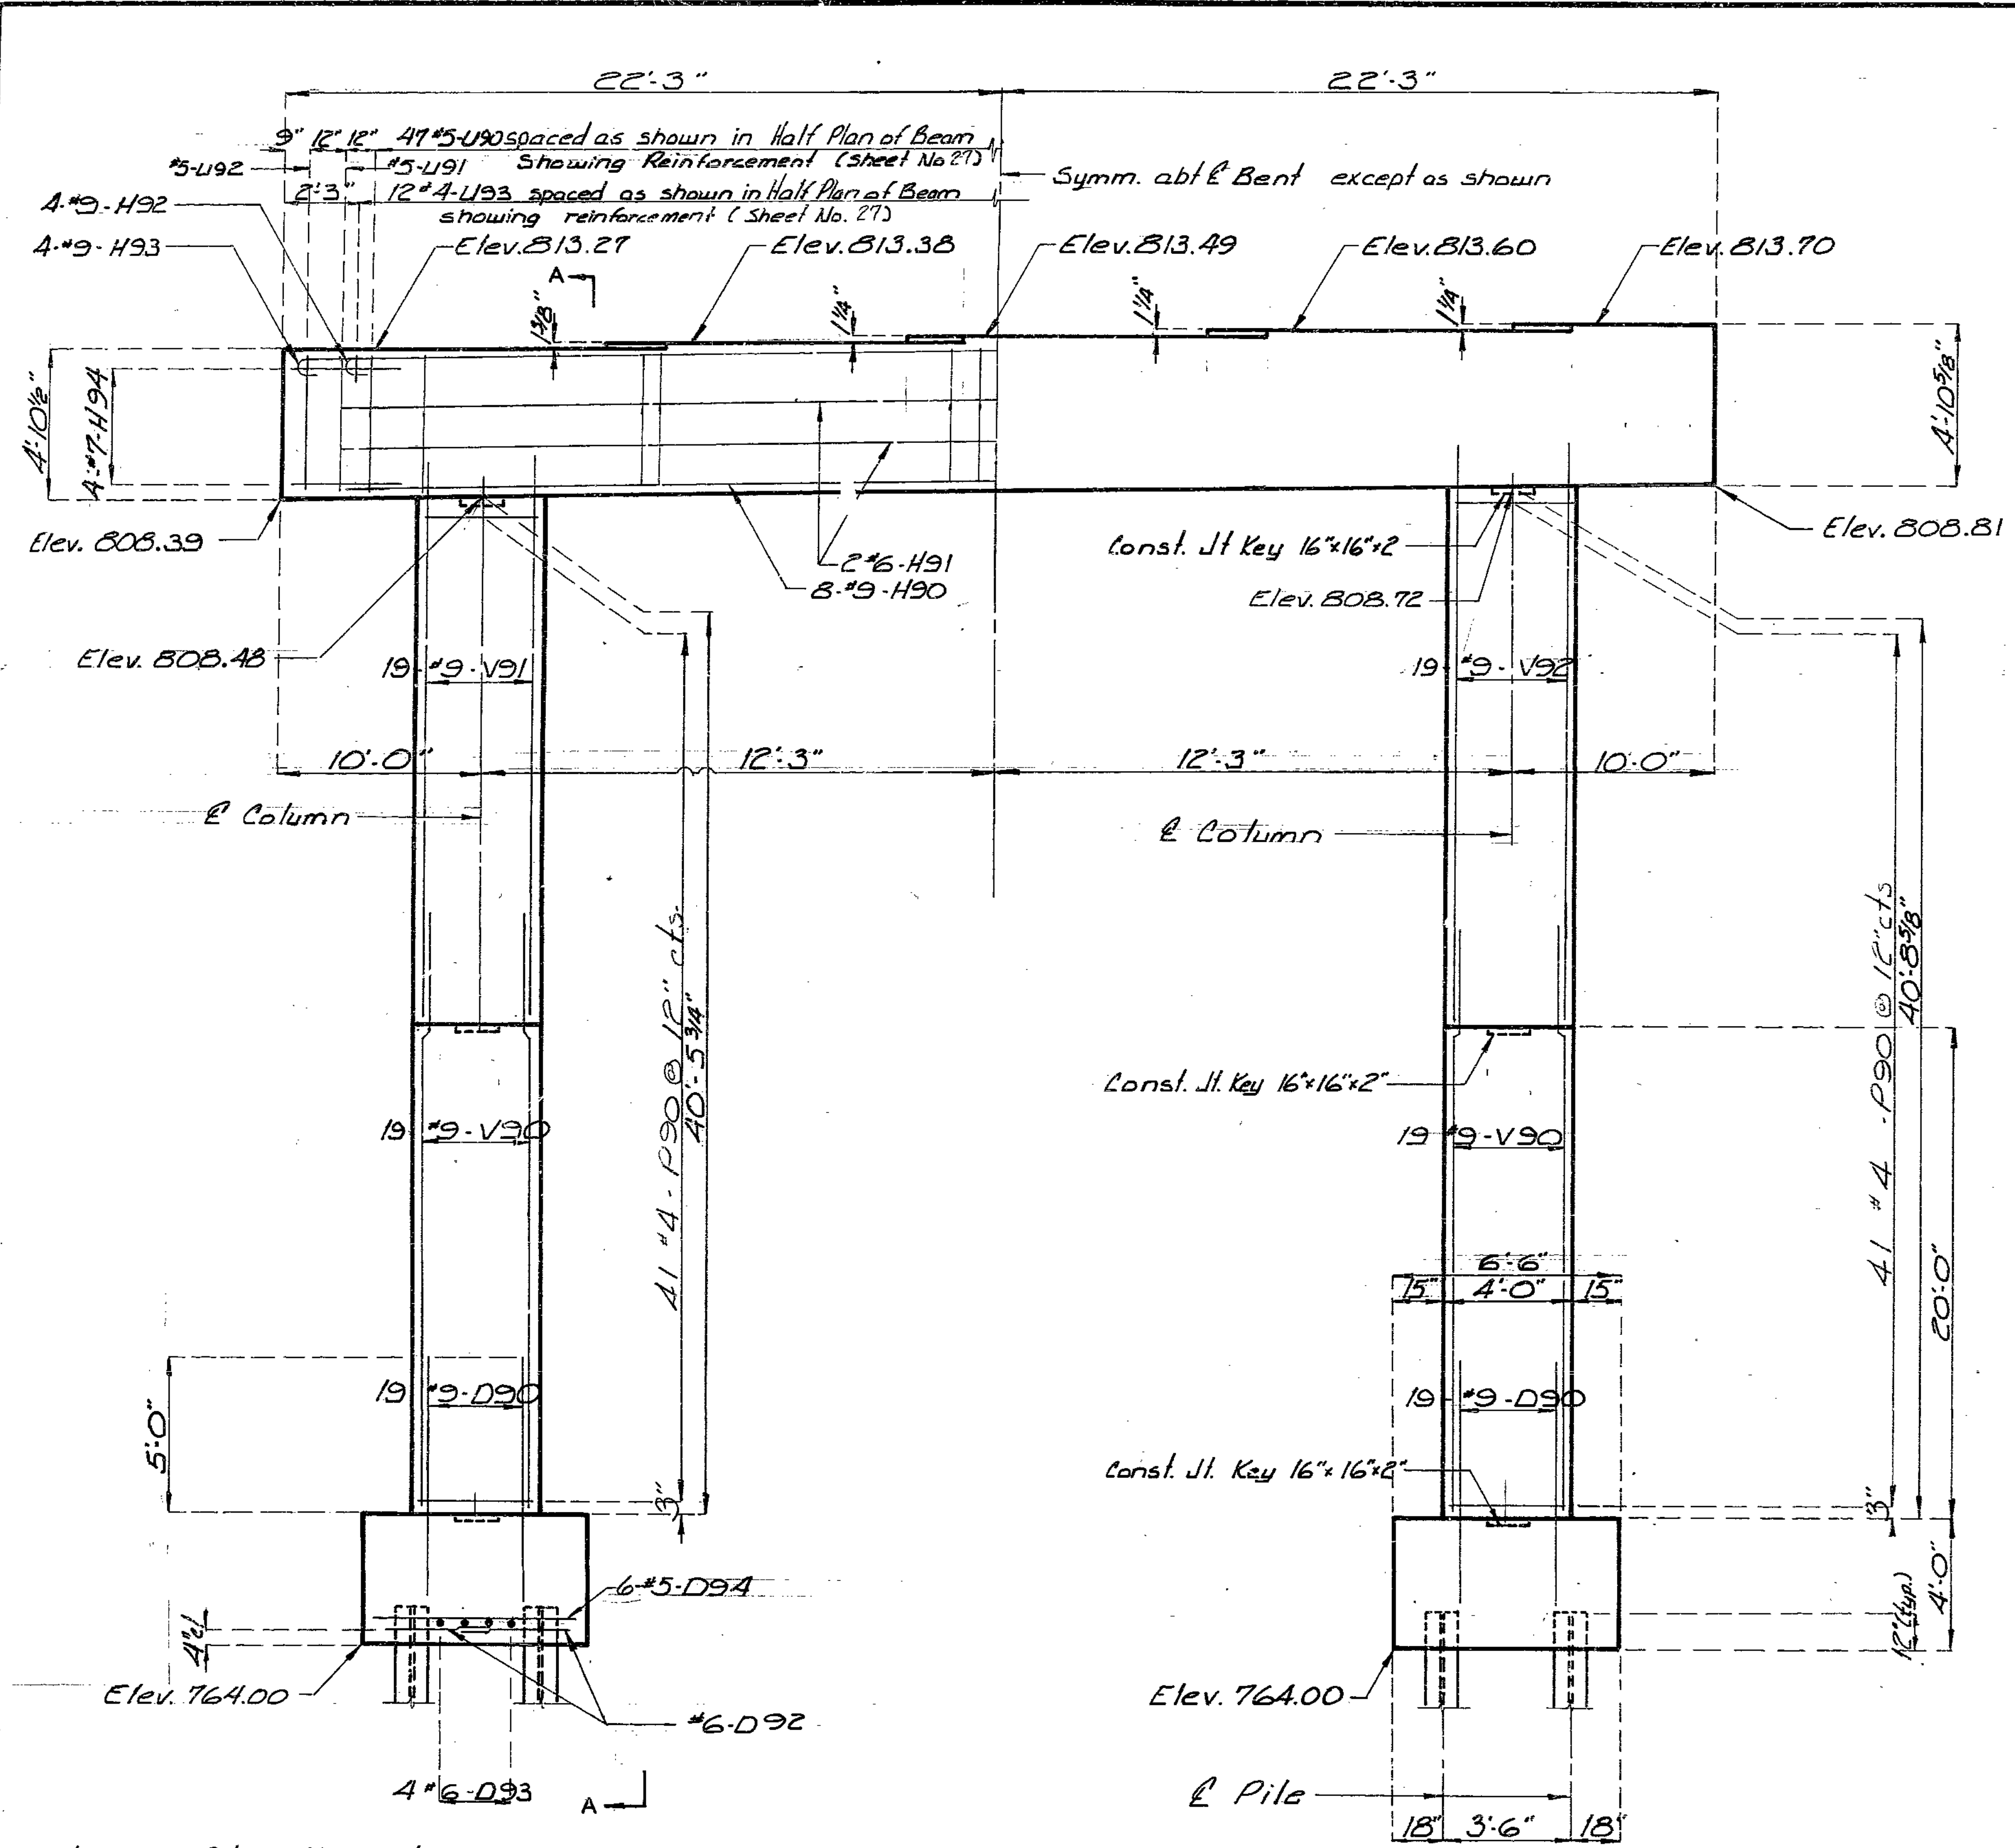

824 338

Note: For Pile Splice Detail see sheet No. 9  
For details of Int. Bent No. 9 not shown see sheet No. 27.

ELEVATION

SECTION A-A

DETAILS OF INTERMEDIATE BENT NO. 9

DATE: DETAILED MAY 1988  
CHECKED August 1988




Note: This drawing is not to scale. Follow dimensions.

Sheet No. 28 of 33

JACKSON COUNTY



A-2745

STATE	PROJ. NO.	SHEET NO.
MO.		84

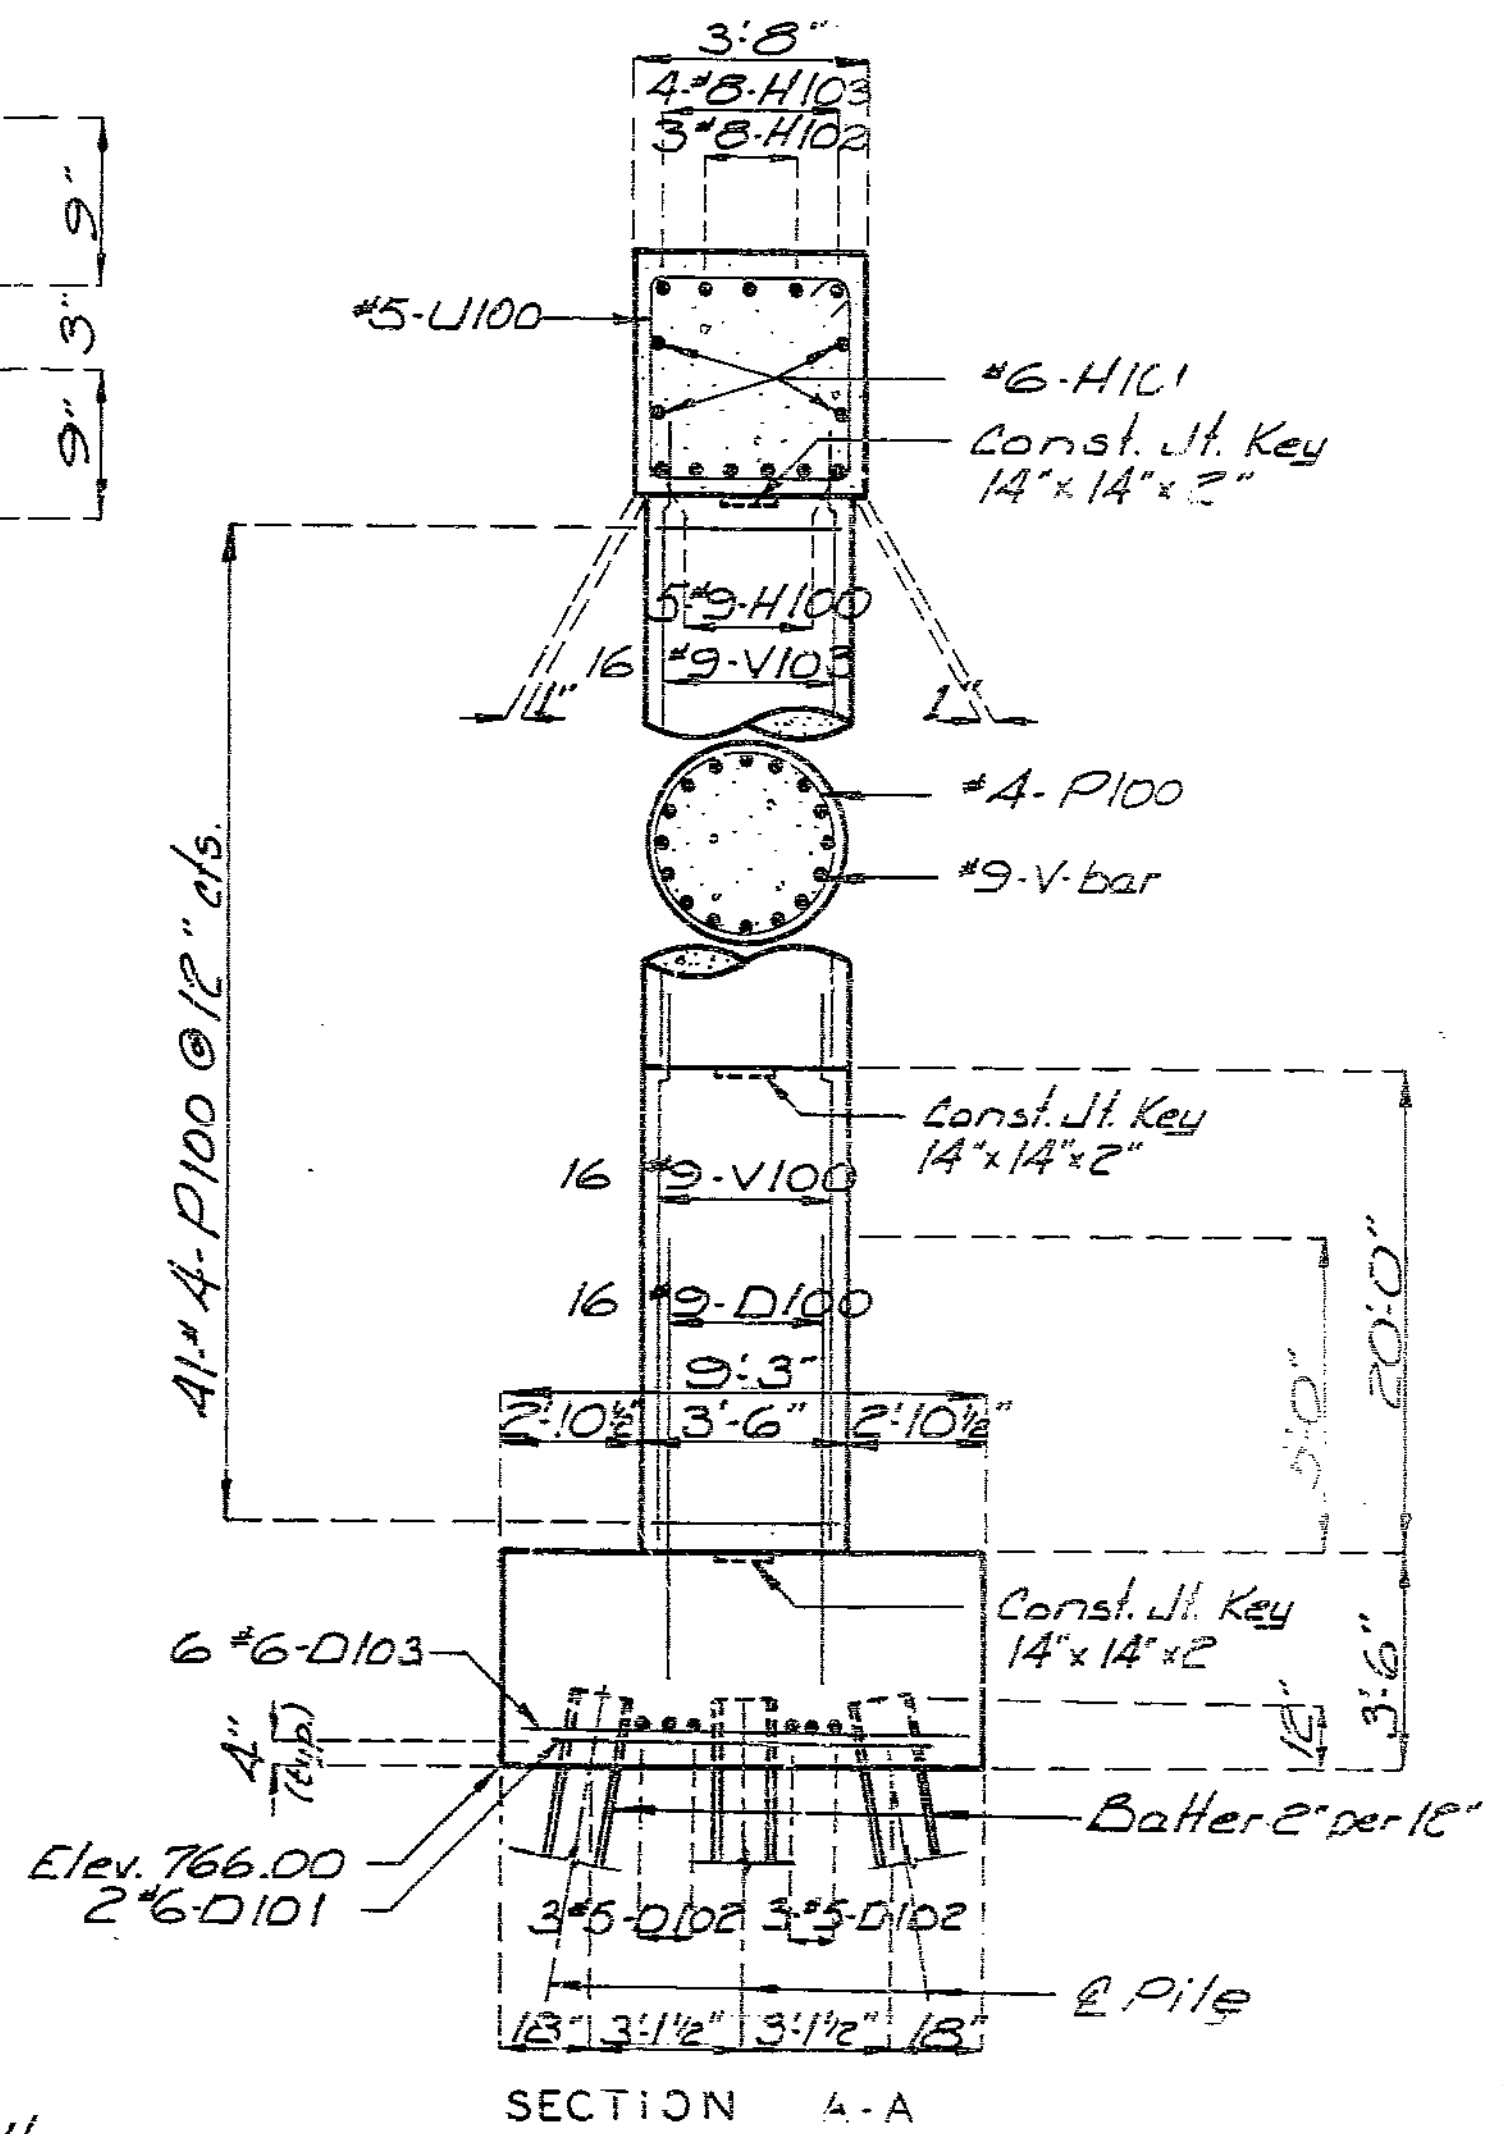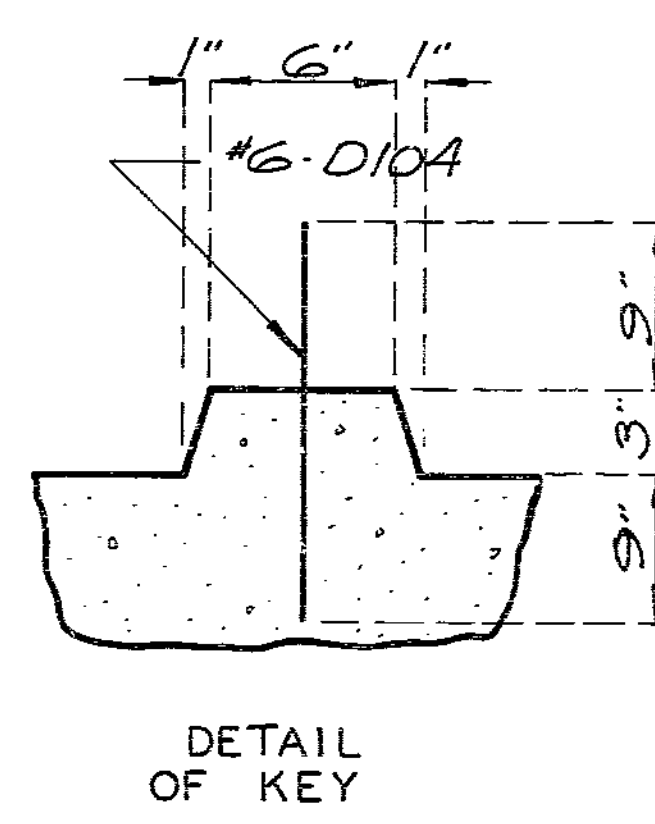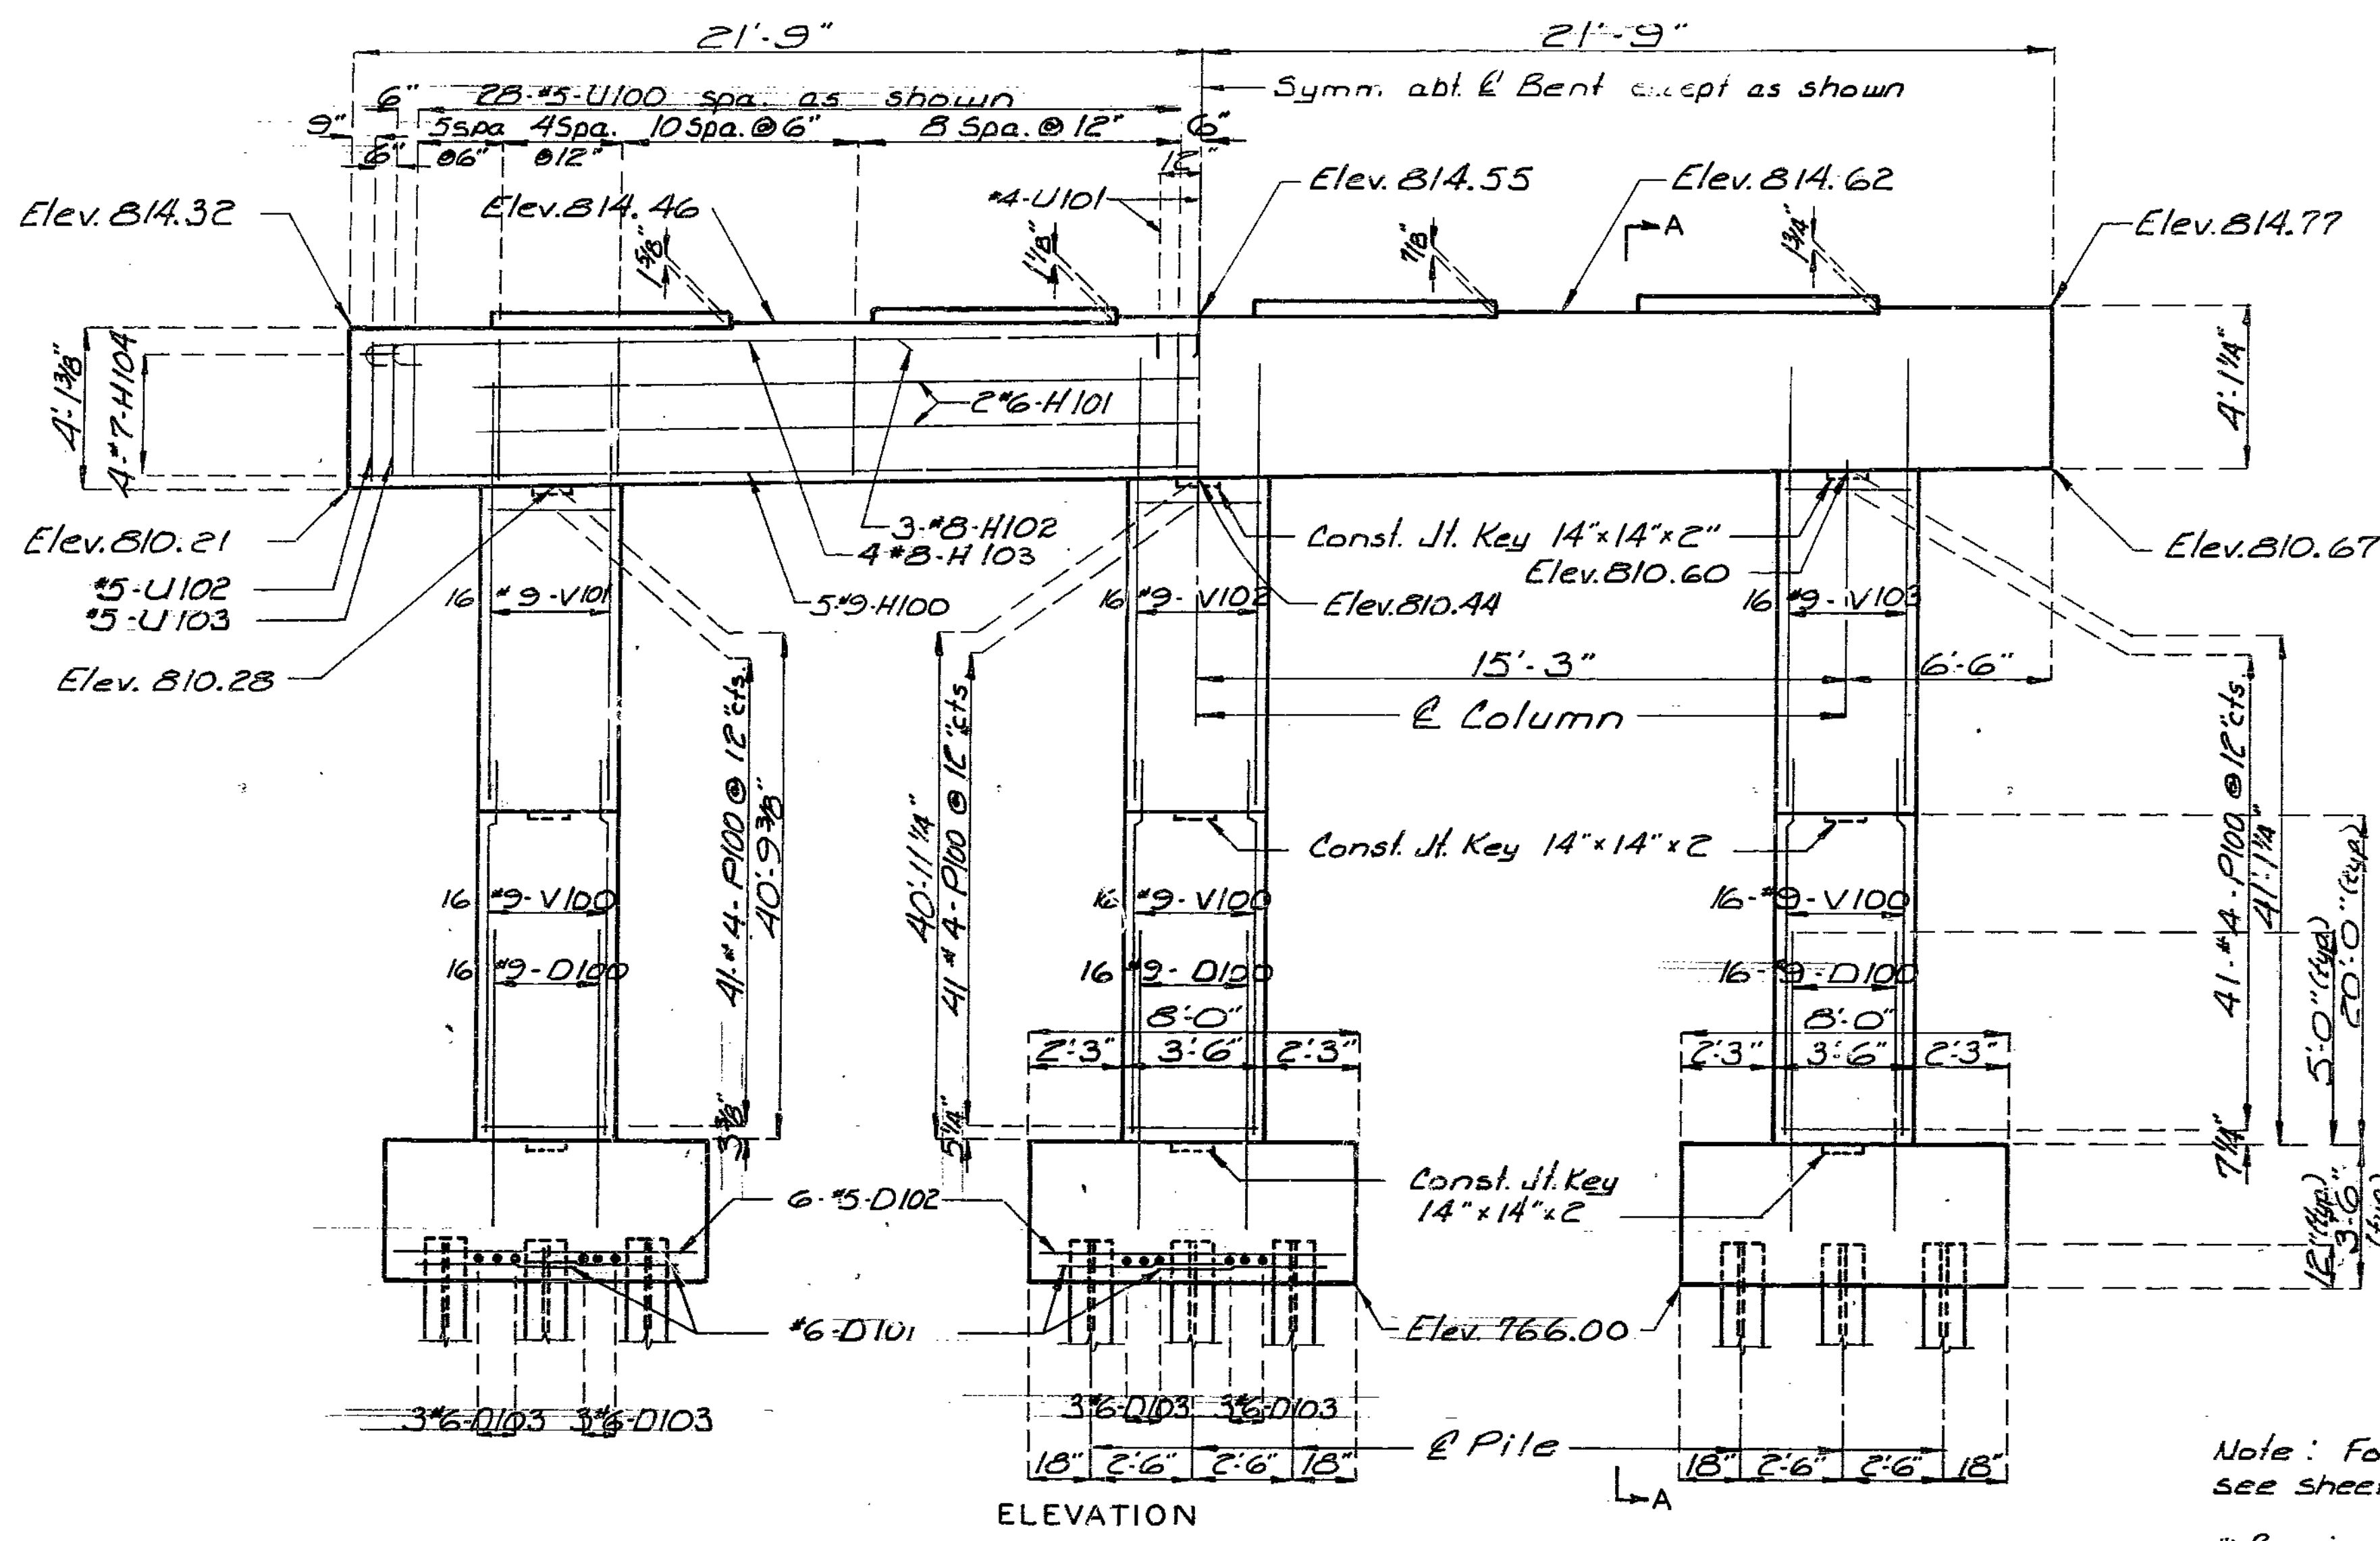

Note: For Pile Splice Detail see sheet No. 9.  
 \*Bearings, Jt. Filler & Roofing Felt are in Future Construction.

885 339

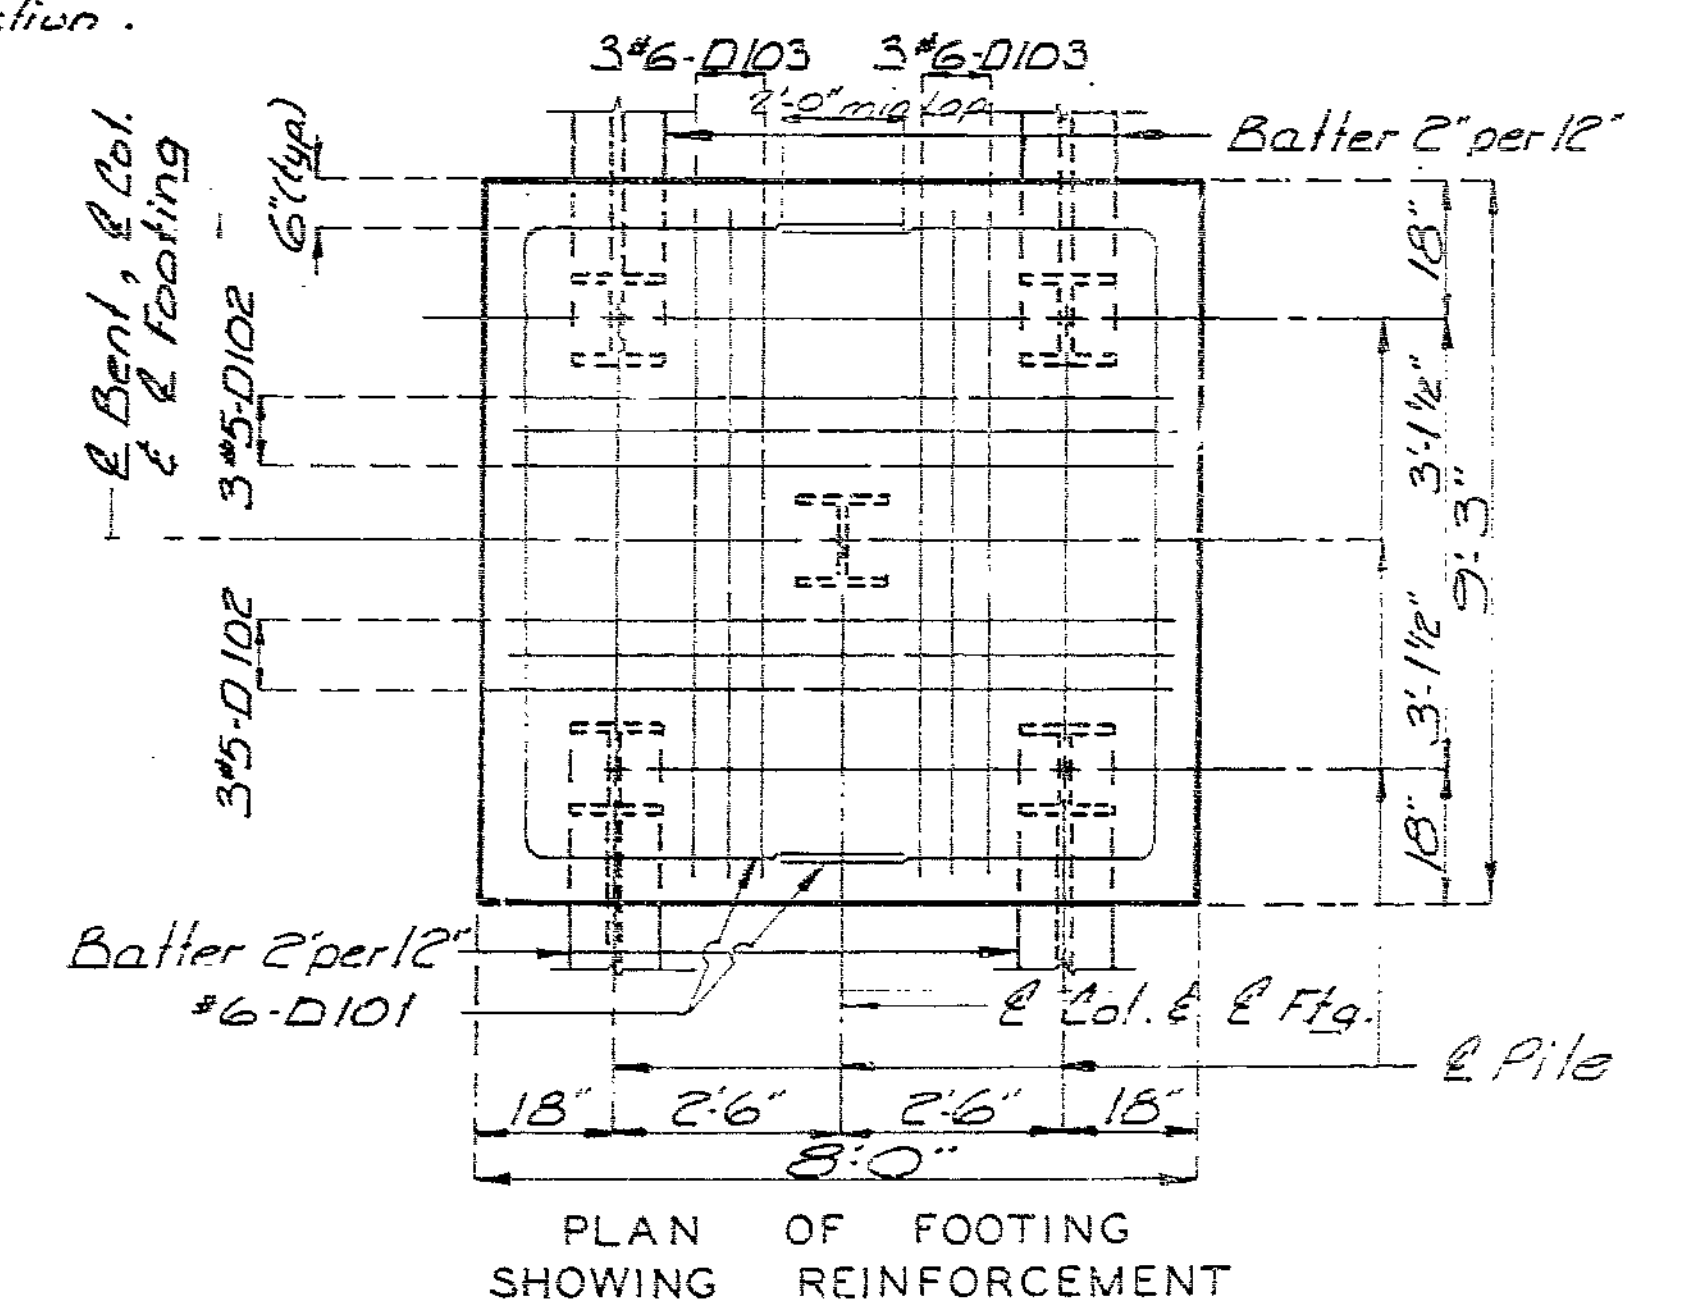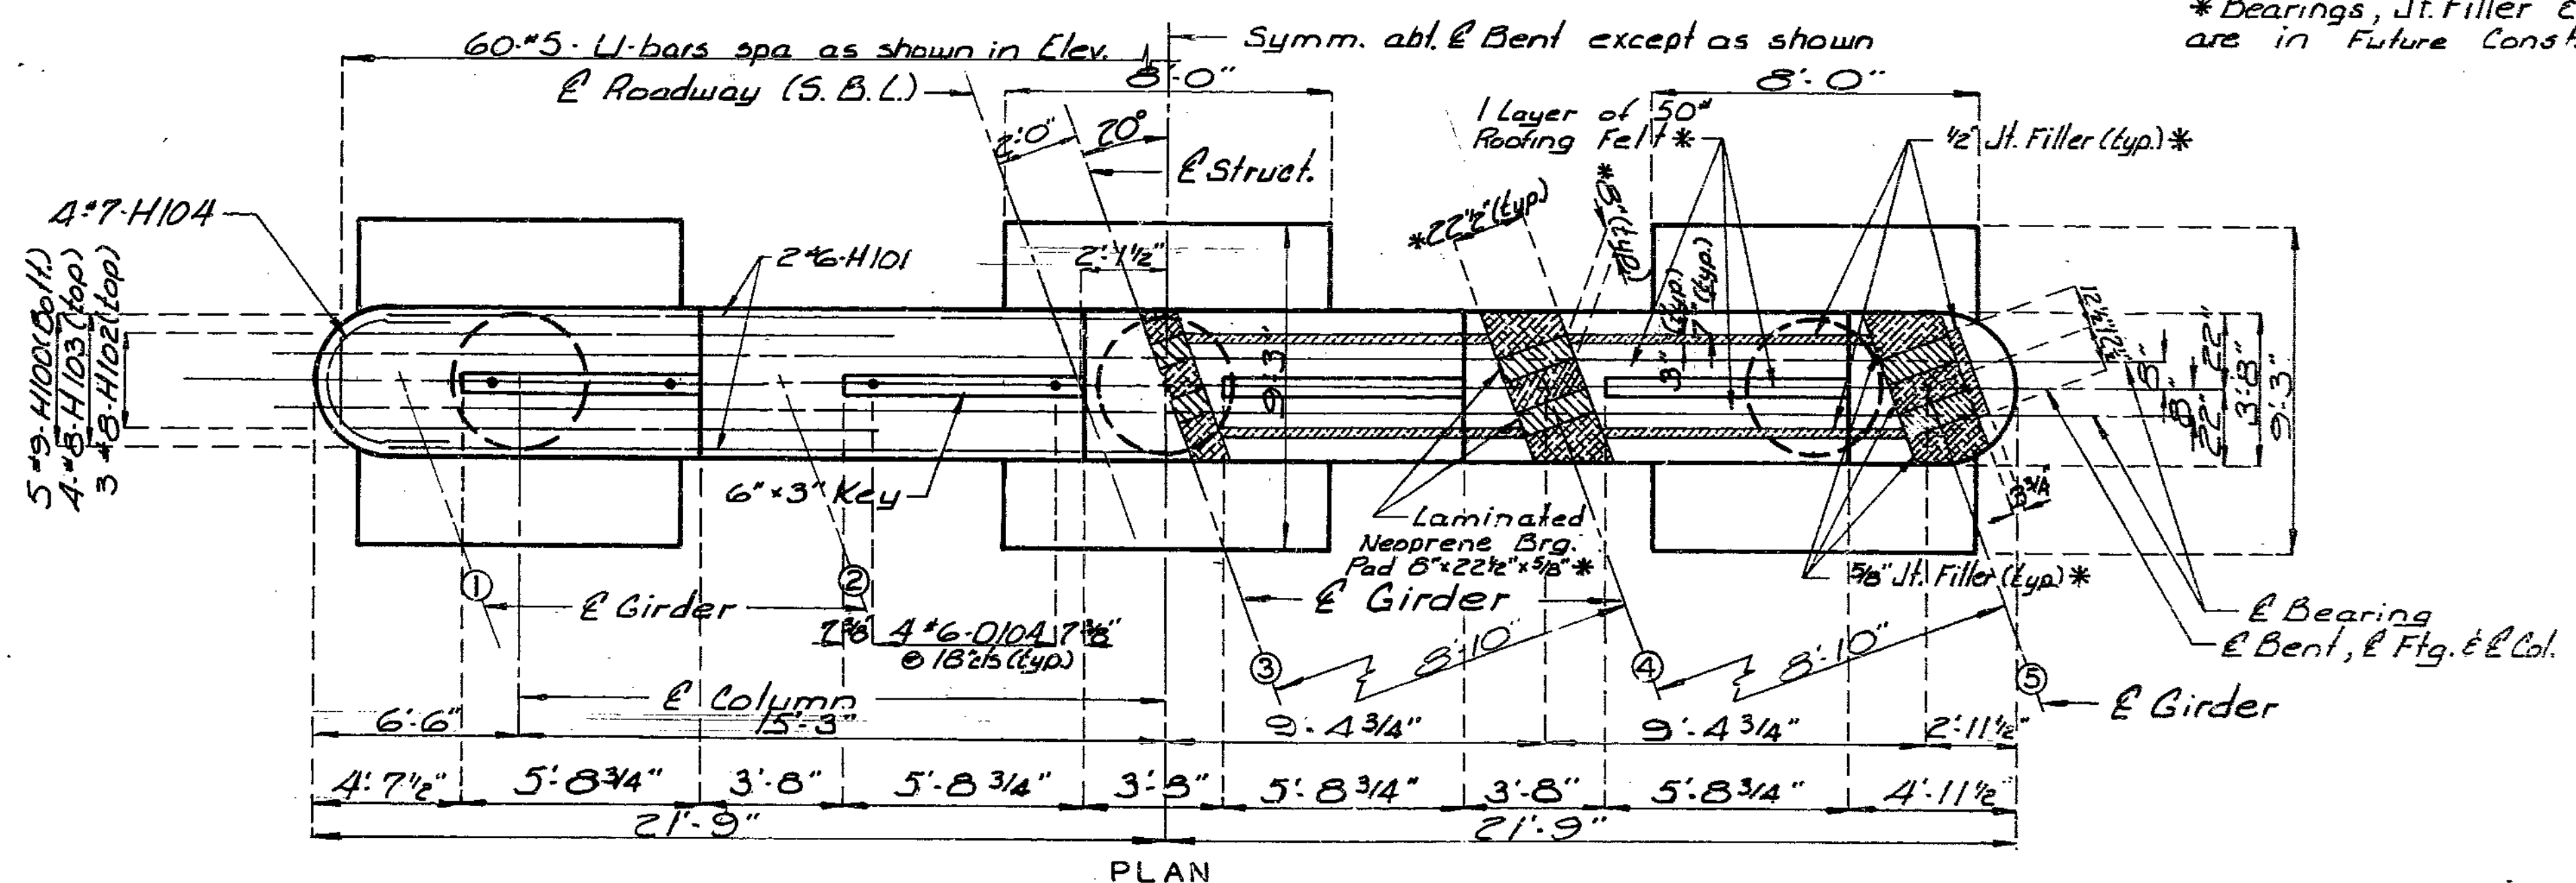

DETAILS OF INTERMEDIATE BENT NO. 10



DETAILED APRIL 1988  
 CHECKED August 1988

Note: This drawing is not to scale. Follow dimensions.


Sheet No. 24 of 55

STATE	PROJ. NO.	SHEET NO.
MO.		35

Note: For Details of Intermediate Bent No. 11 not shown, see sheet No. 31.  
 \*Brgs, Jt. Filler & Roofing Felt are in Future Construction.  
 For details of pile splice see sheet No. 9

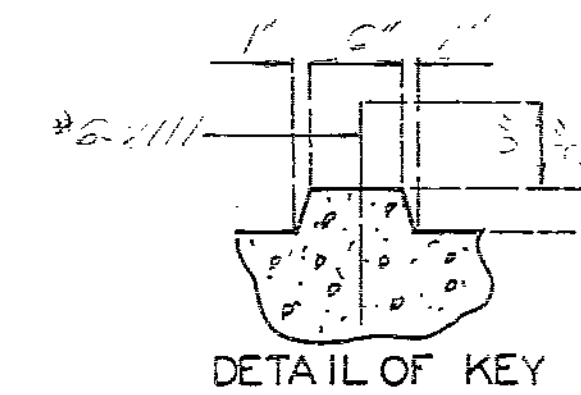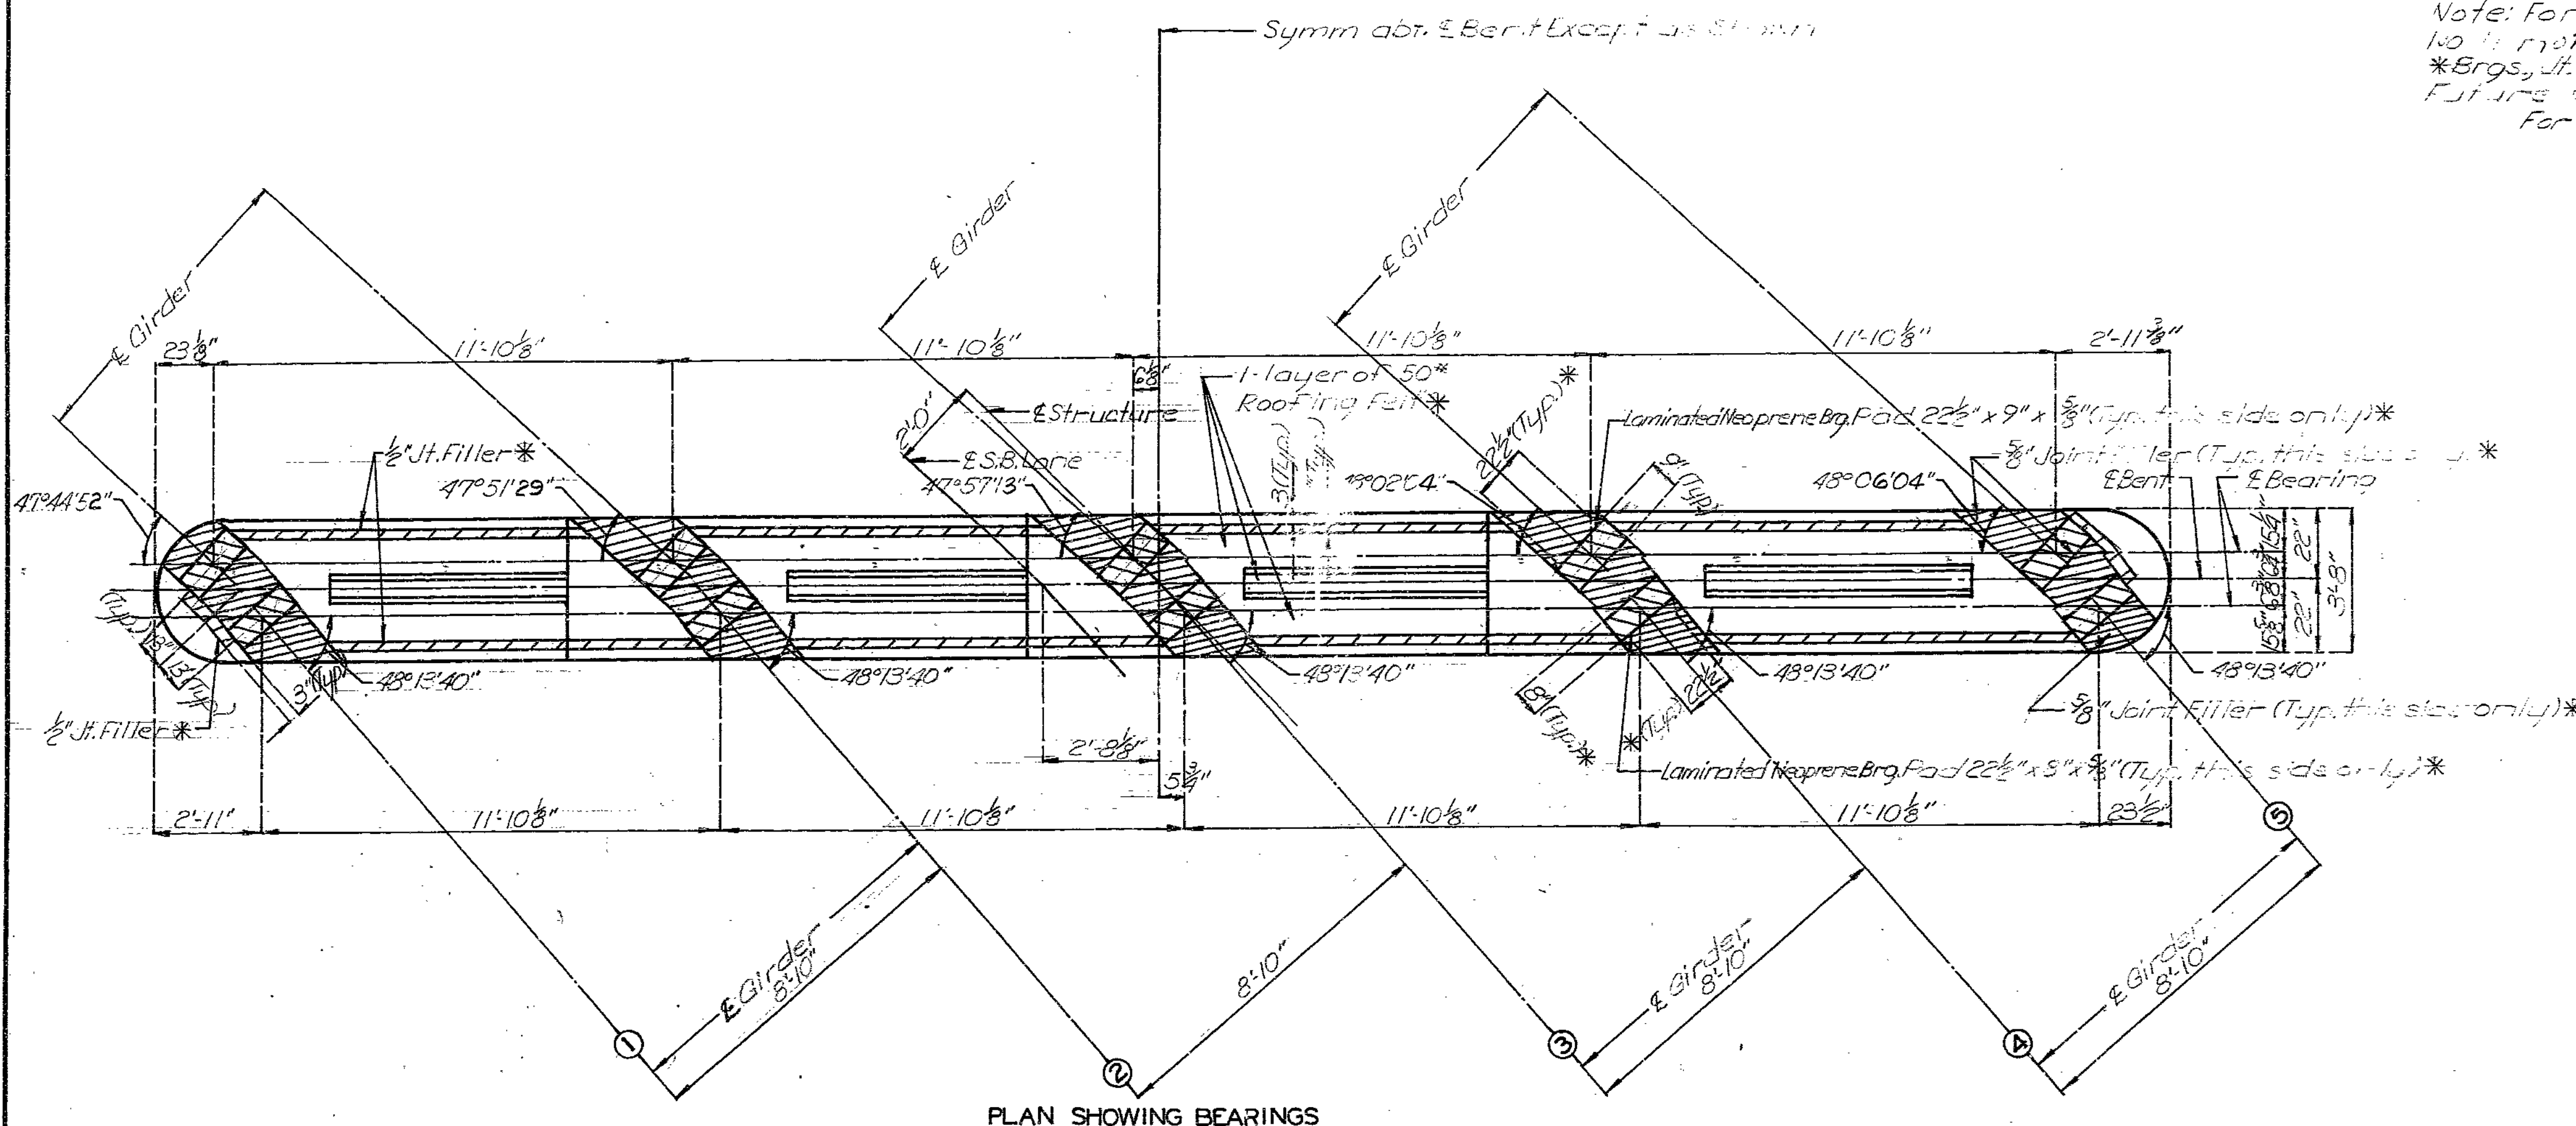


PLAN SHOWING BEARINGS

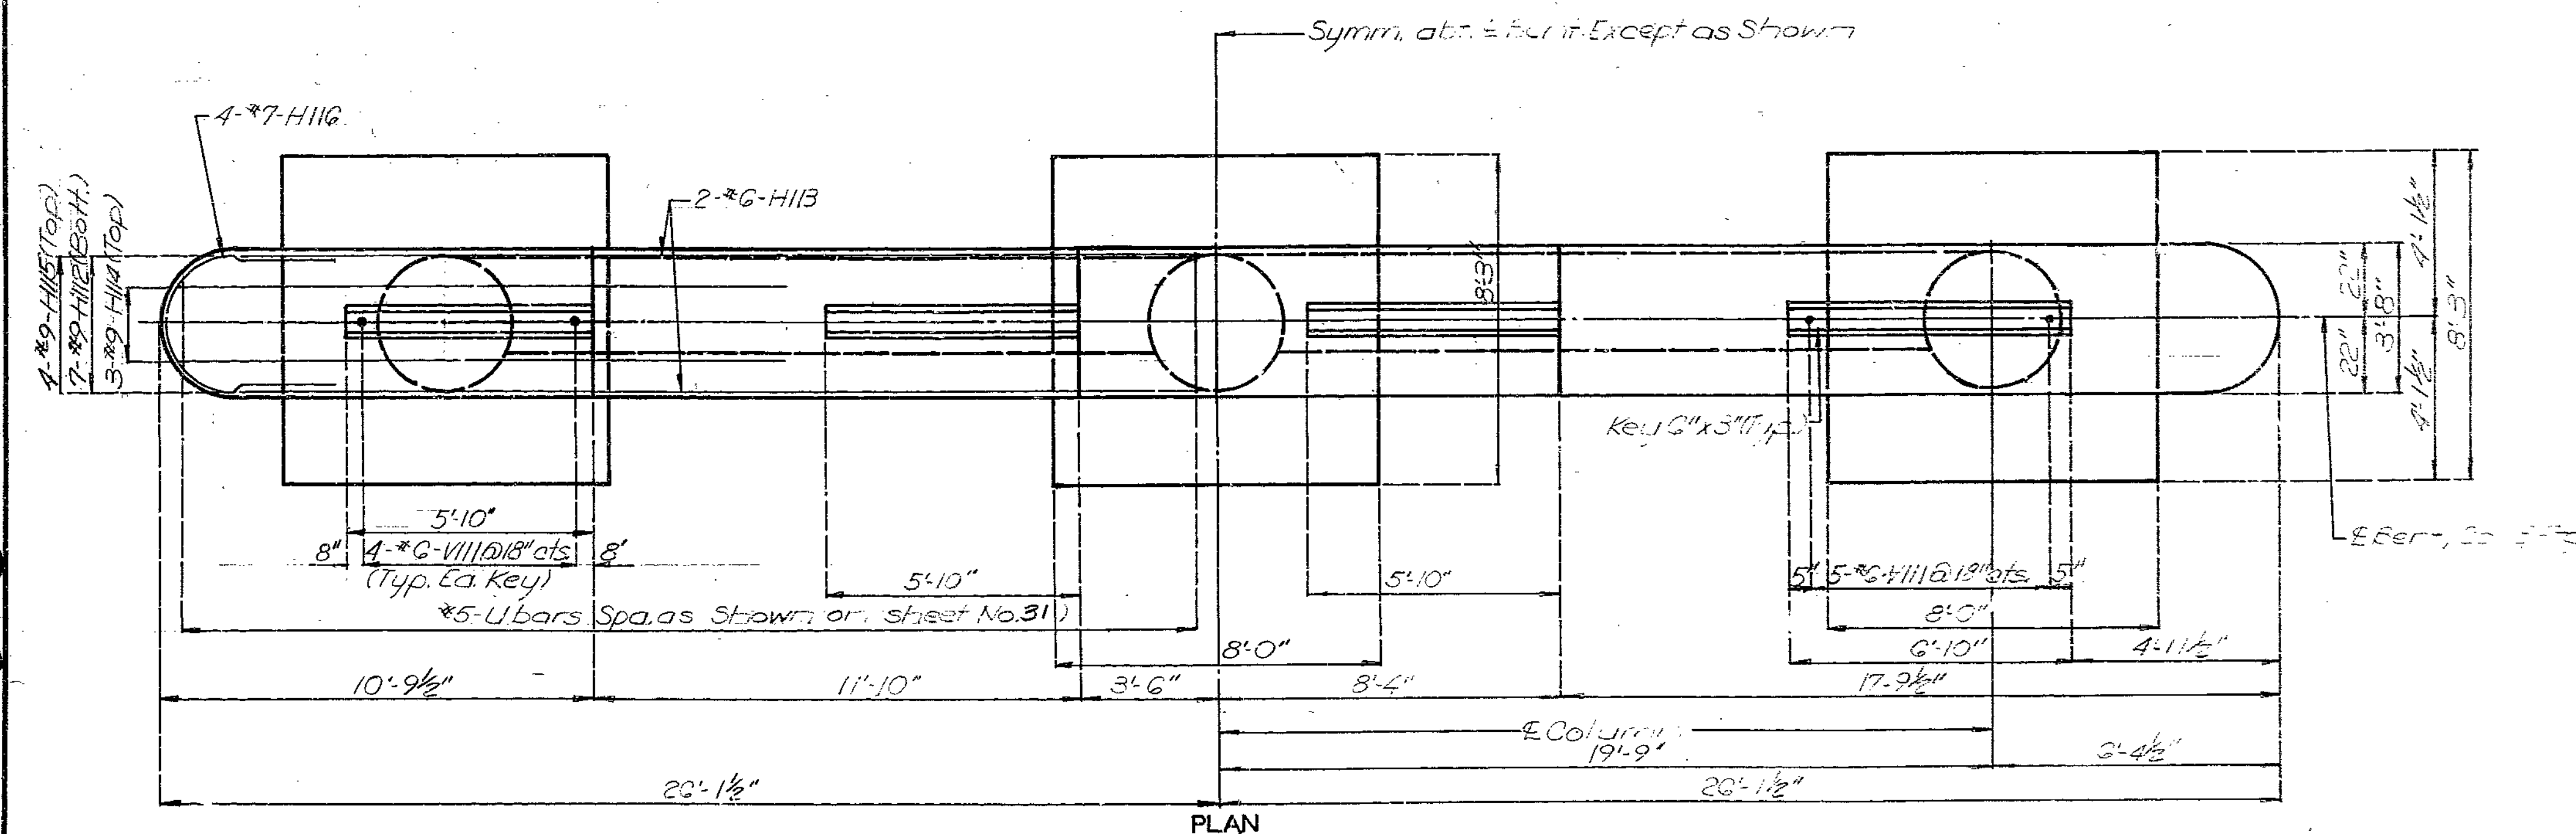

PLAN

DETAILS OF INTERMEDIATE BENT NO. 11

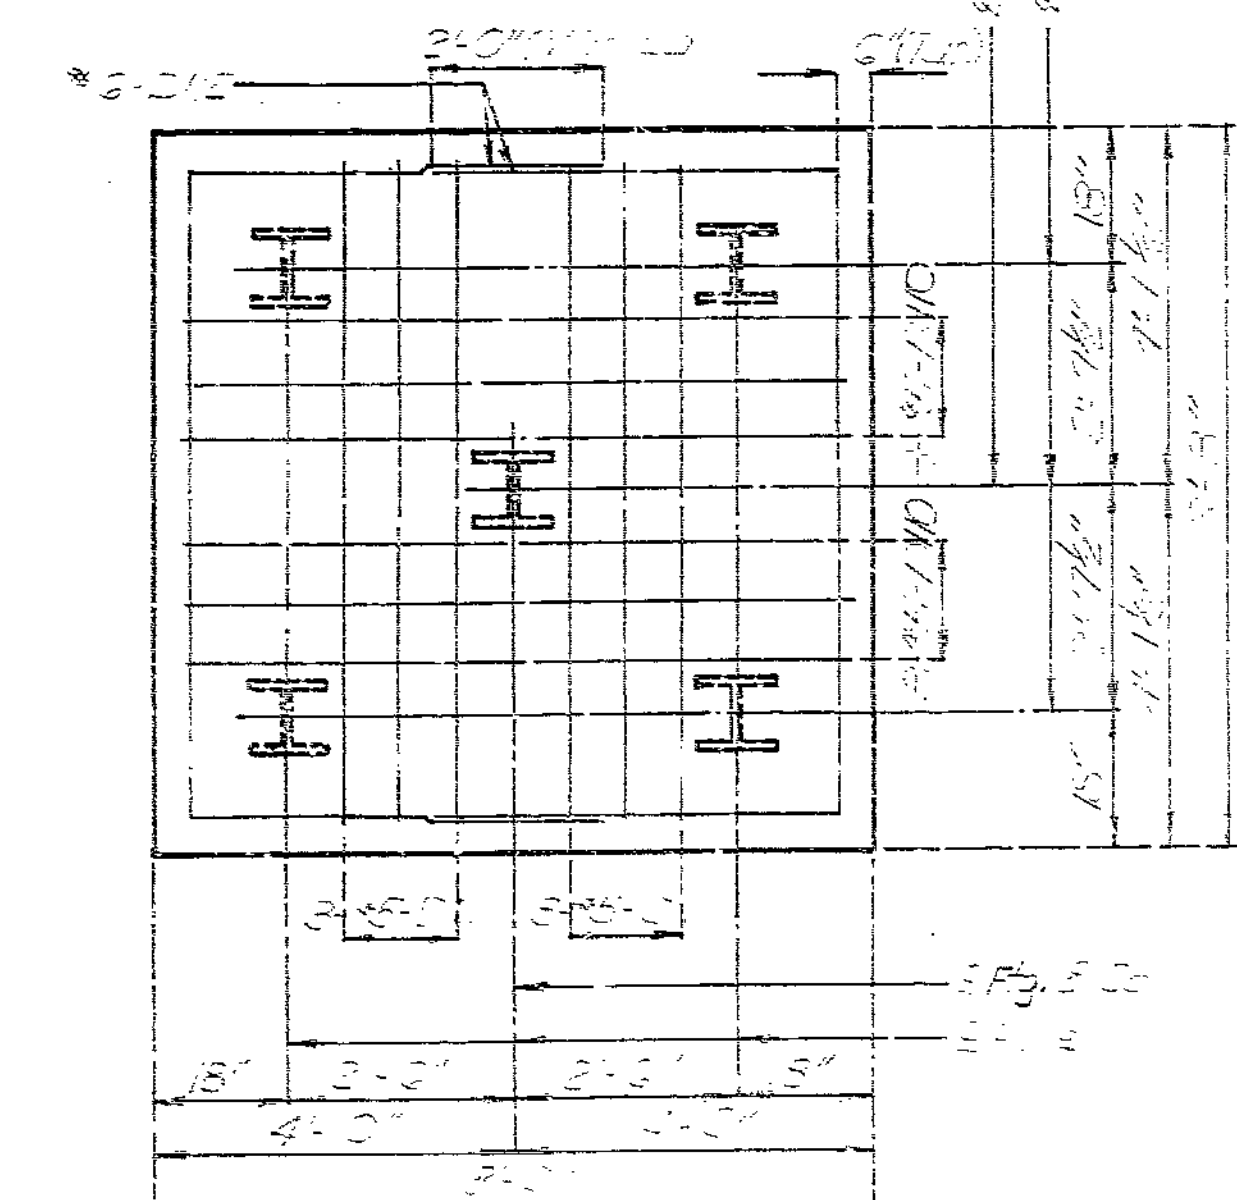

PLAN OF FOOTING SHOWING REINFORCEMENT

340

DETAILED MAY 1988  
 CHECKED Aug. 1988

Note: This drawing is not to scale. Follow dimensions.



Sheet No. 30 of 35

JACKSON COUNTY

A-2745

STATE	PROJ. NO.	SHEET NO.
MO.		36

Note: For details of Jt. Key & details of Pile Out, see sheet no. 30

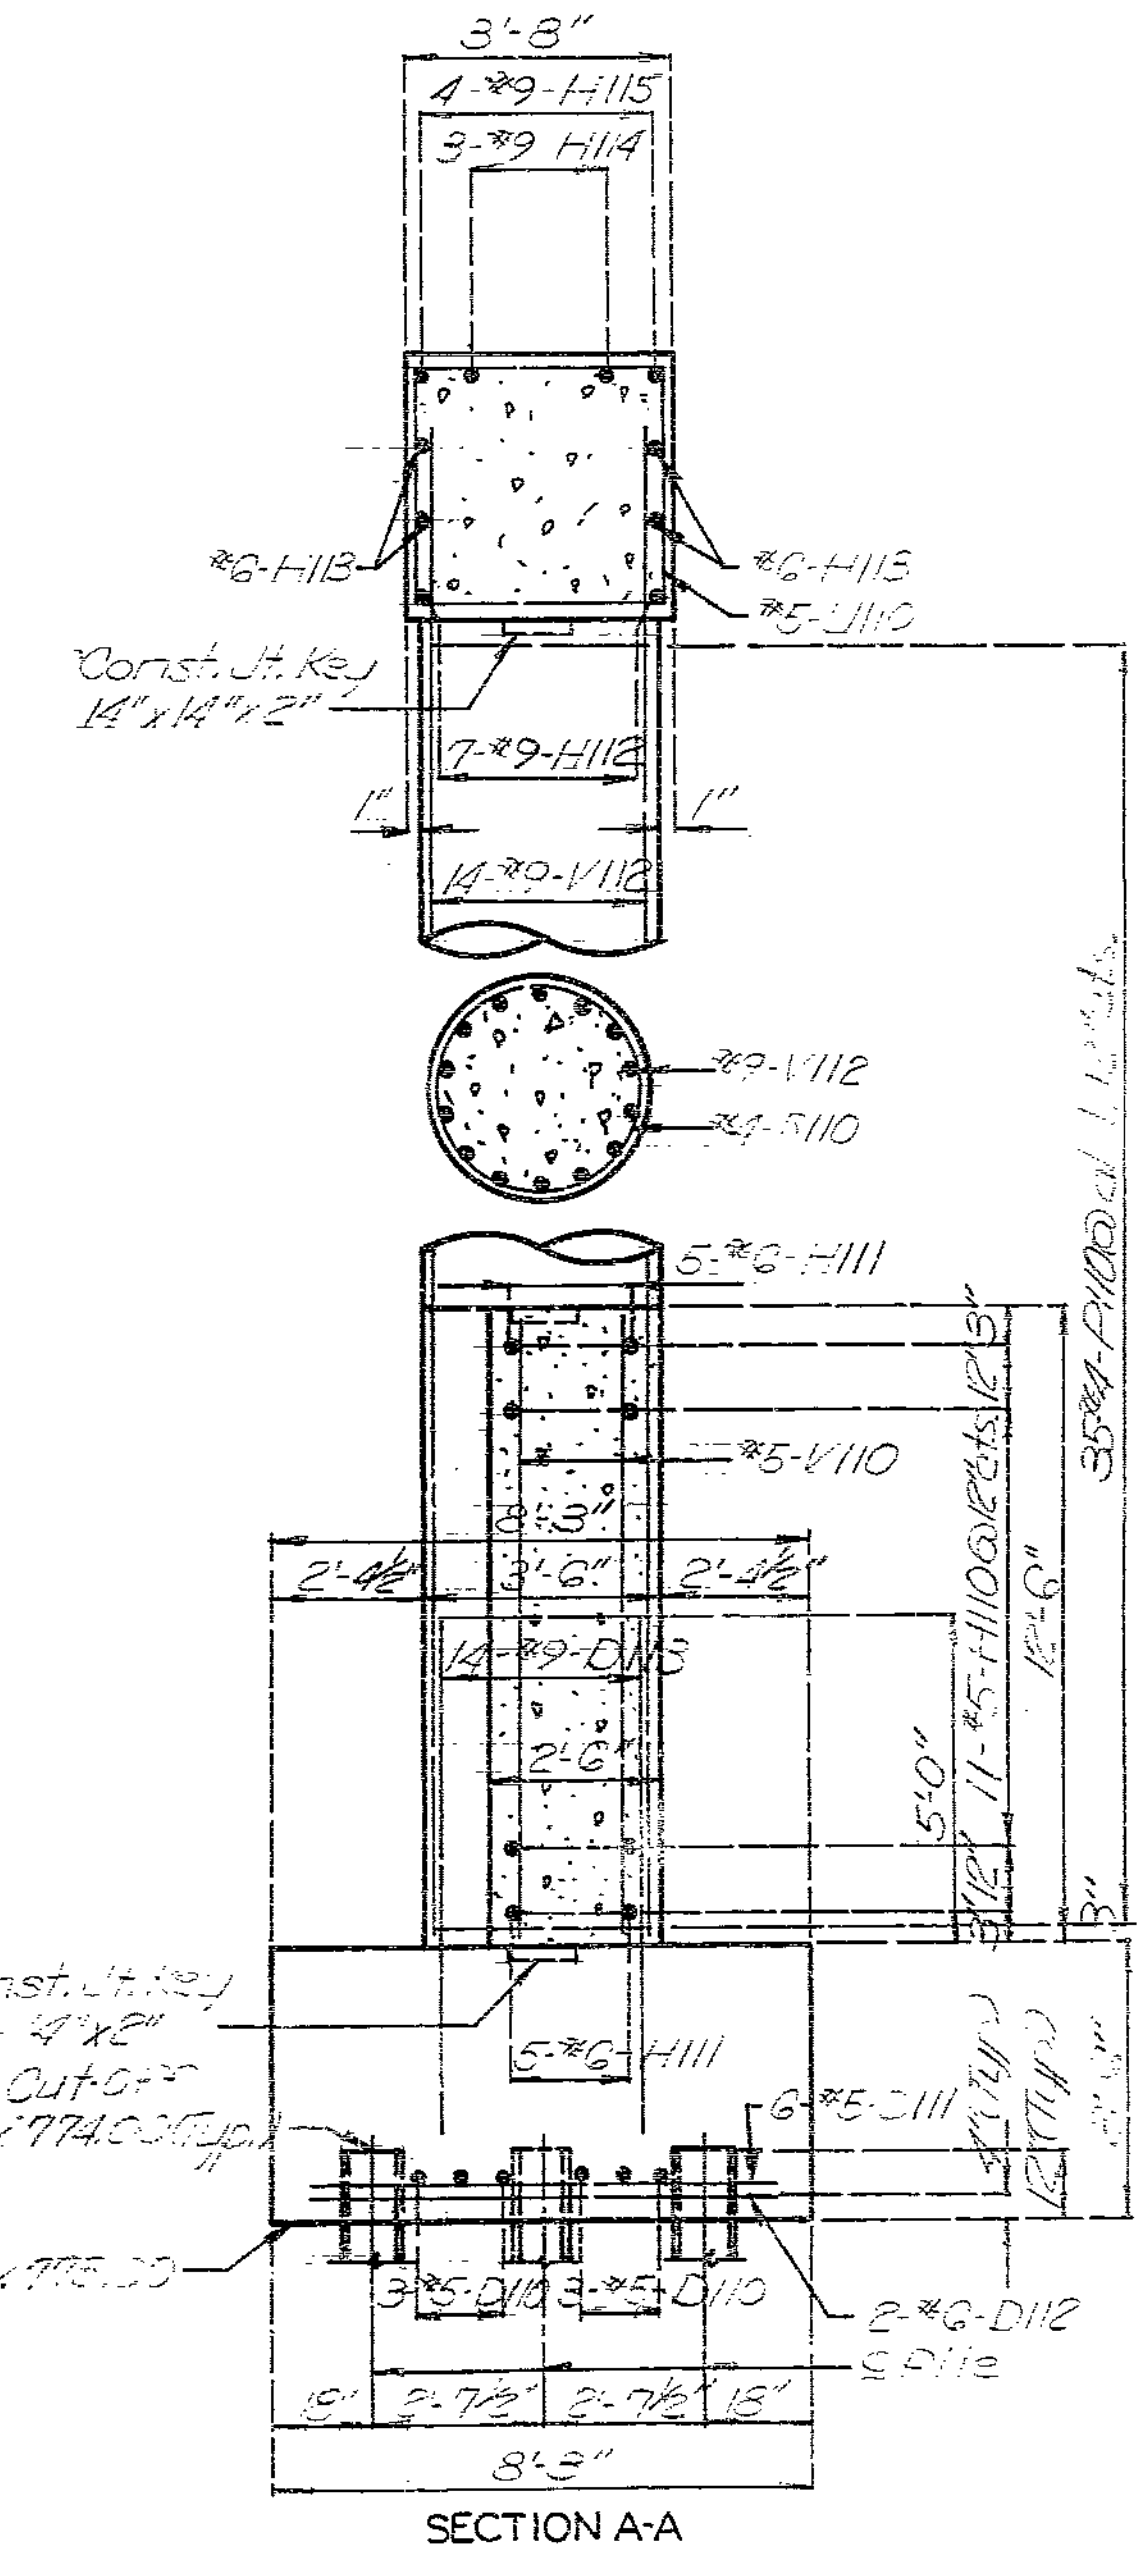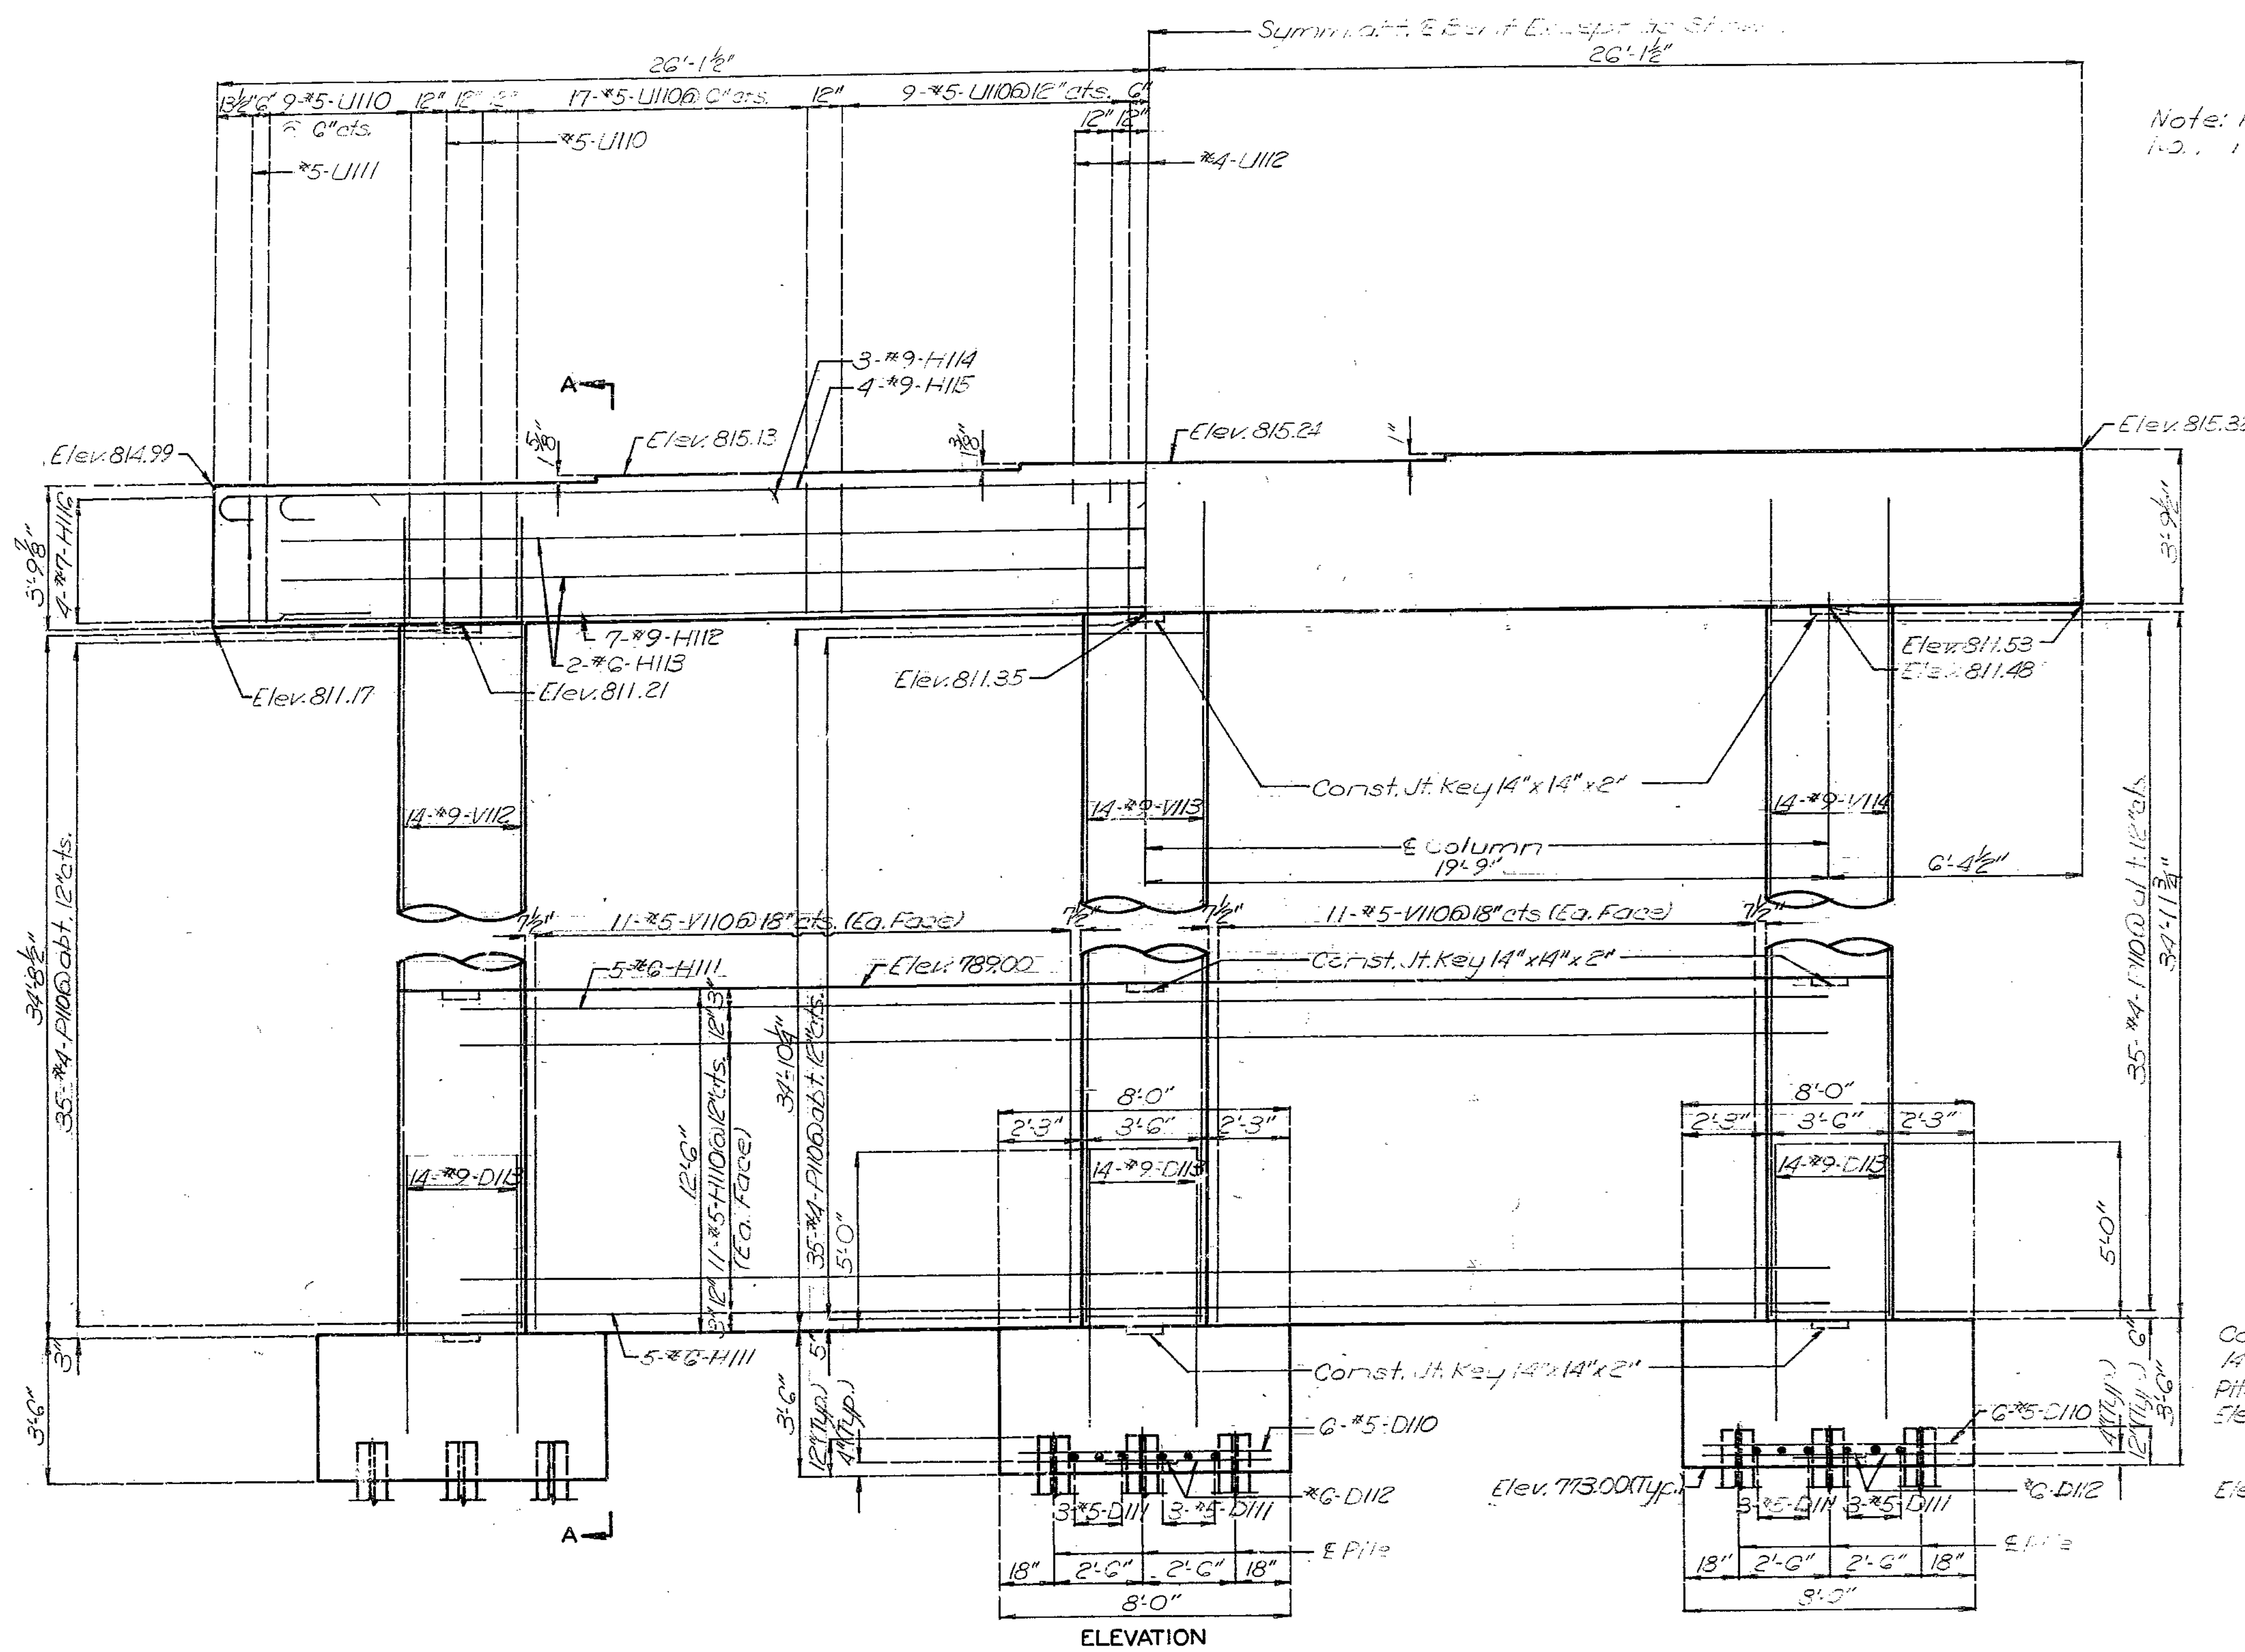

DETAILS OF INTERMEDIATE BENT NO. 11

287341

DETAILED MAY 1988  
CHECKED Aug 1988

Note: This drawing is not to scale. Follow dimensions.

Sheet No. 31 of 36


JACKSON COUNTY

A-2745





STATE	PROJ. NO.	SHEET NO.
MO.		83

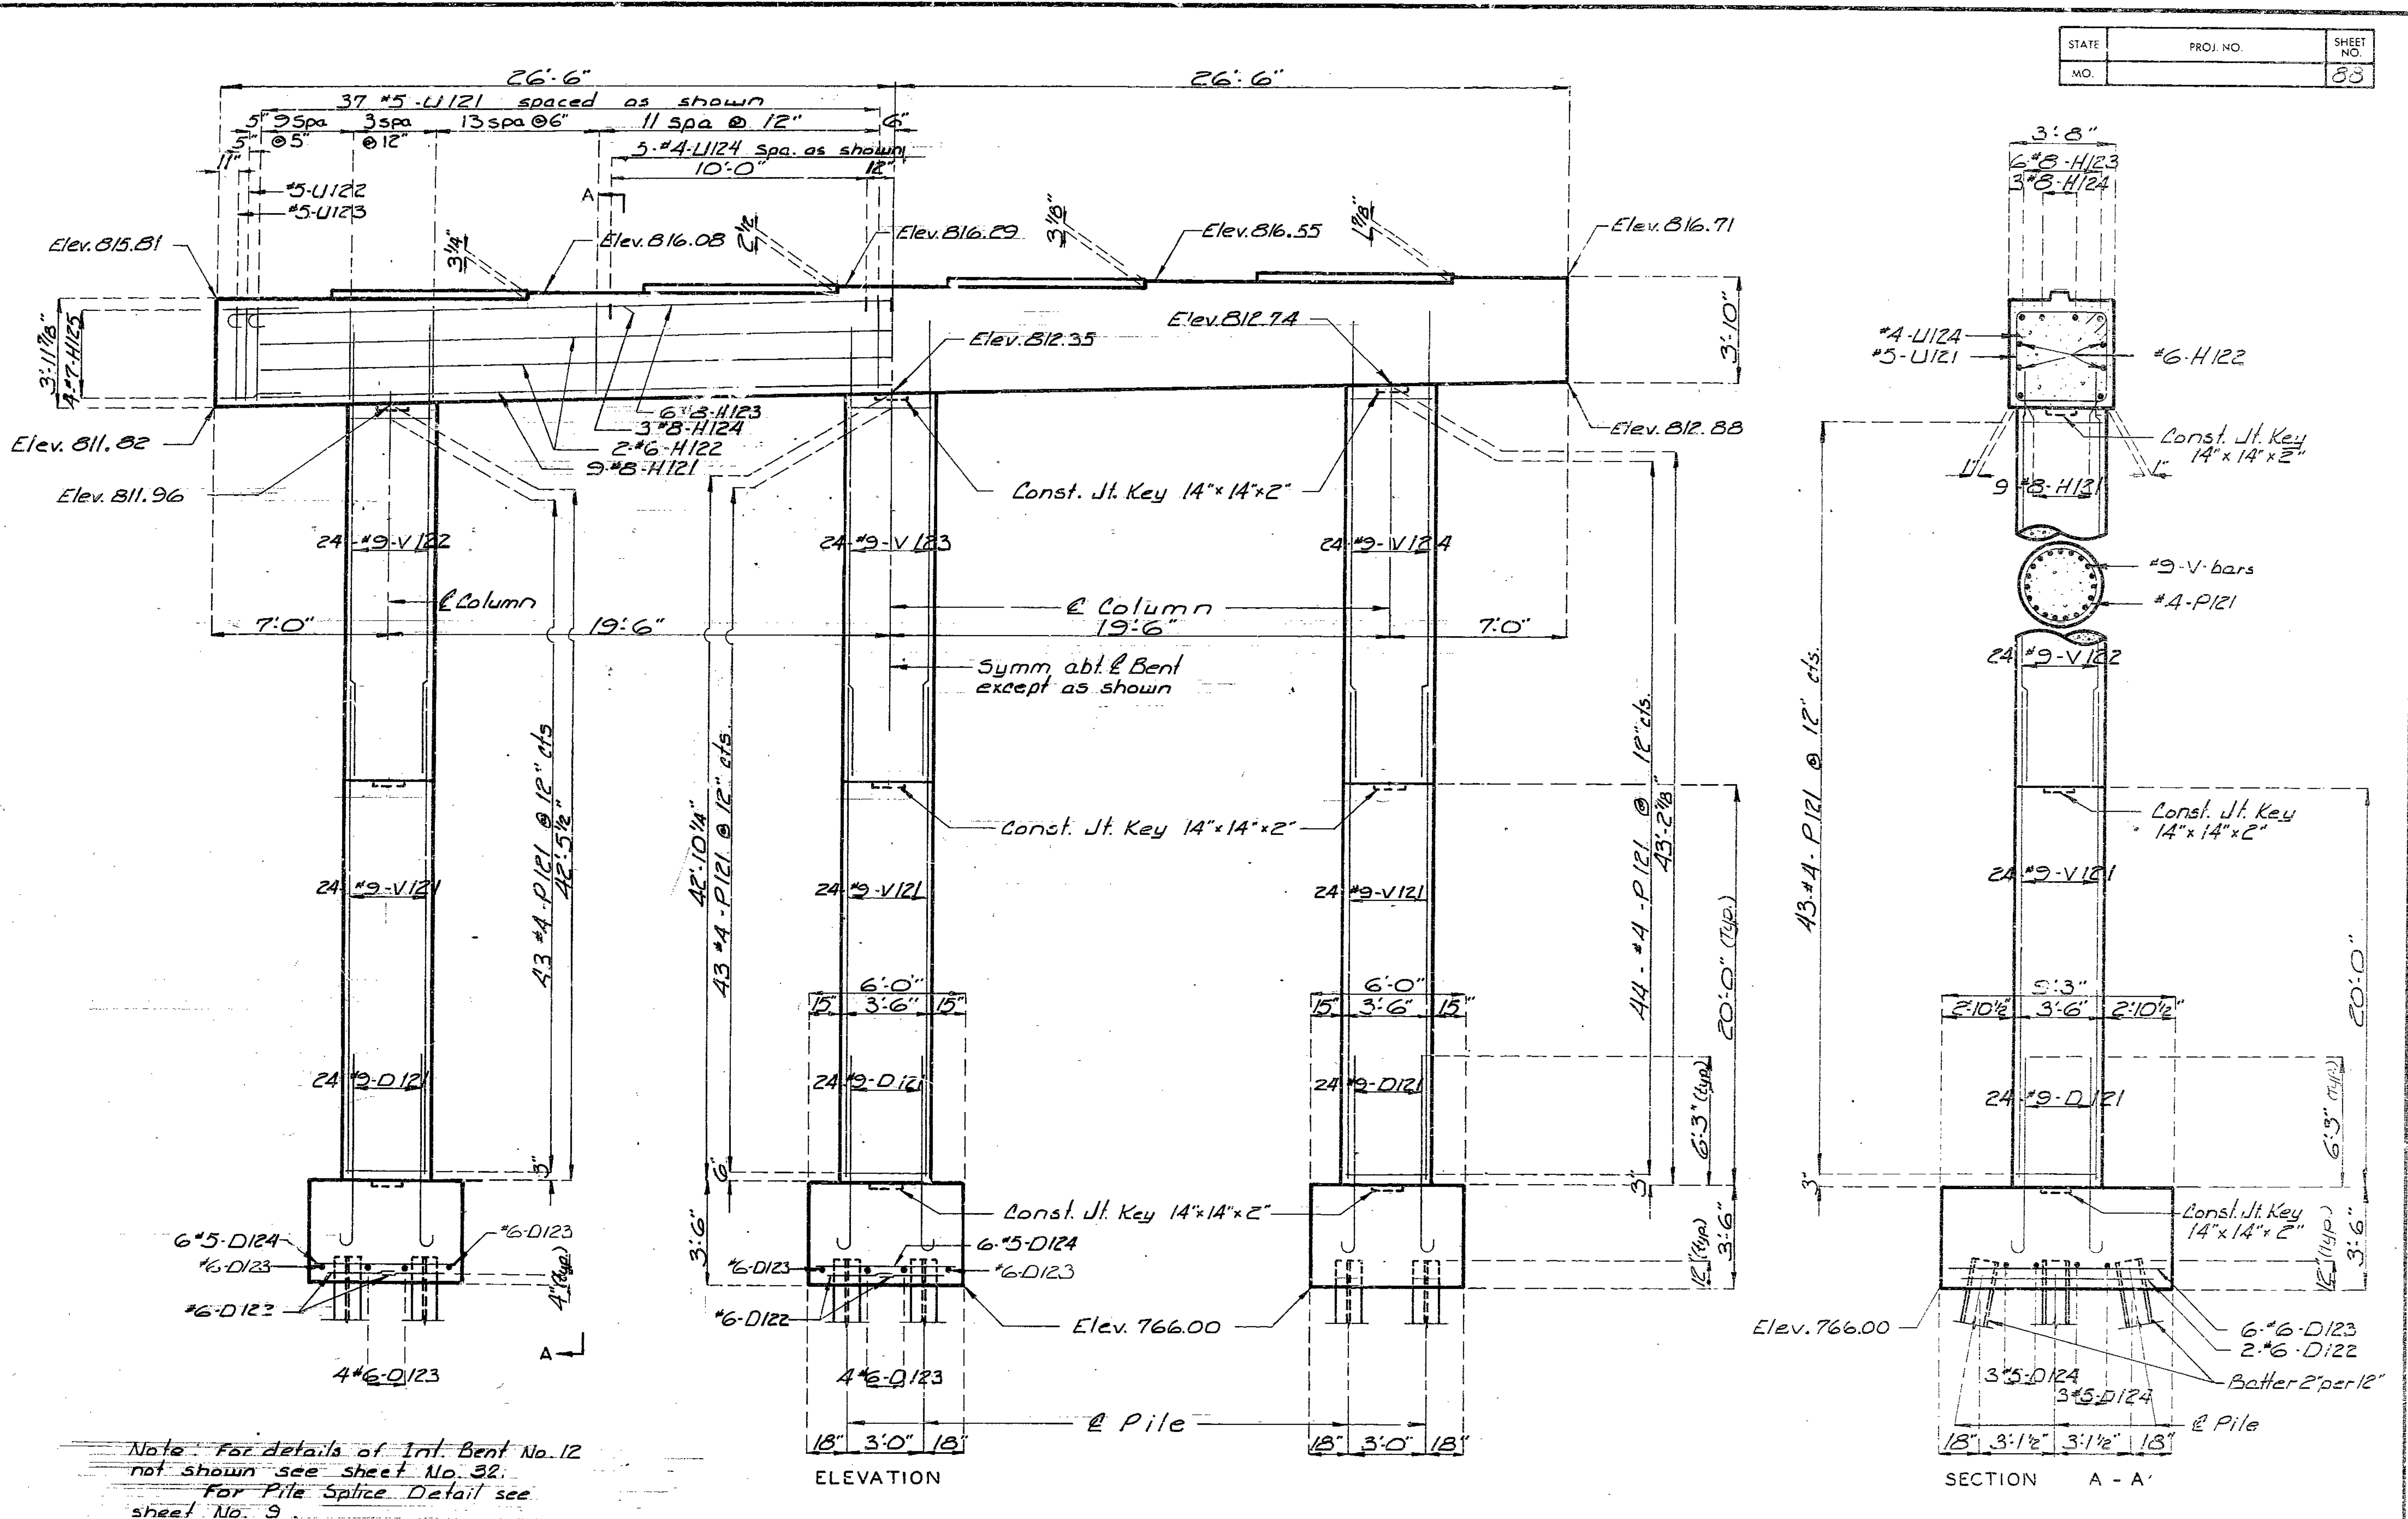

343


DETAILED MAY 1988  
CHECKED August 1988

DETAILS OF INTERMEDIATE BENT NO. 12

Note: This drawing is not to scale. Follow dimensions.


Sheet No. 33 of 53

STATE	PROJ. NO.	SHEET NO.
MO		39

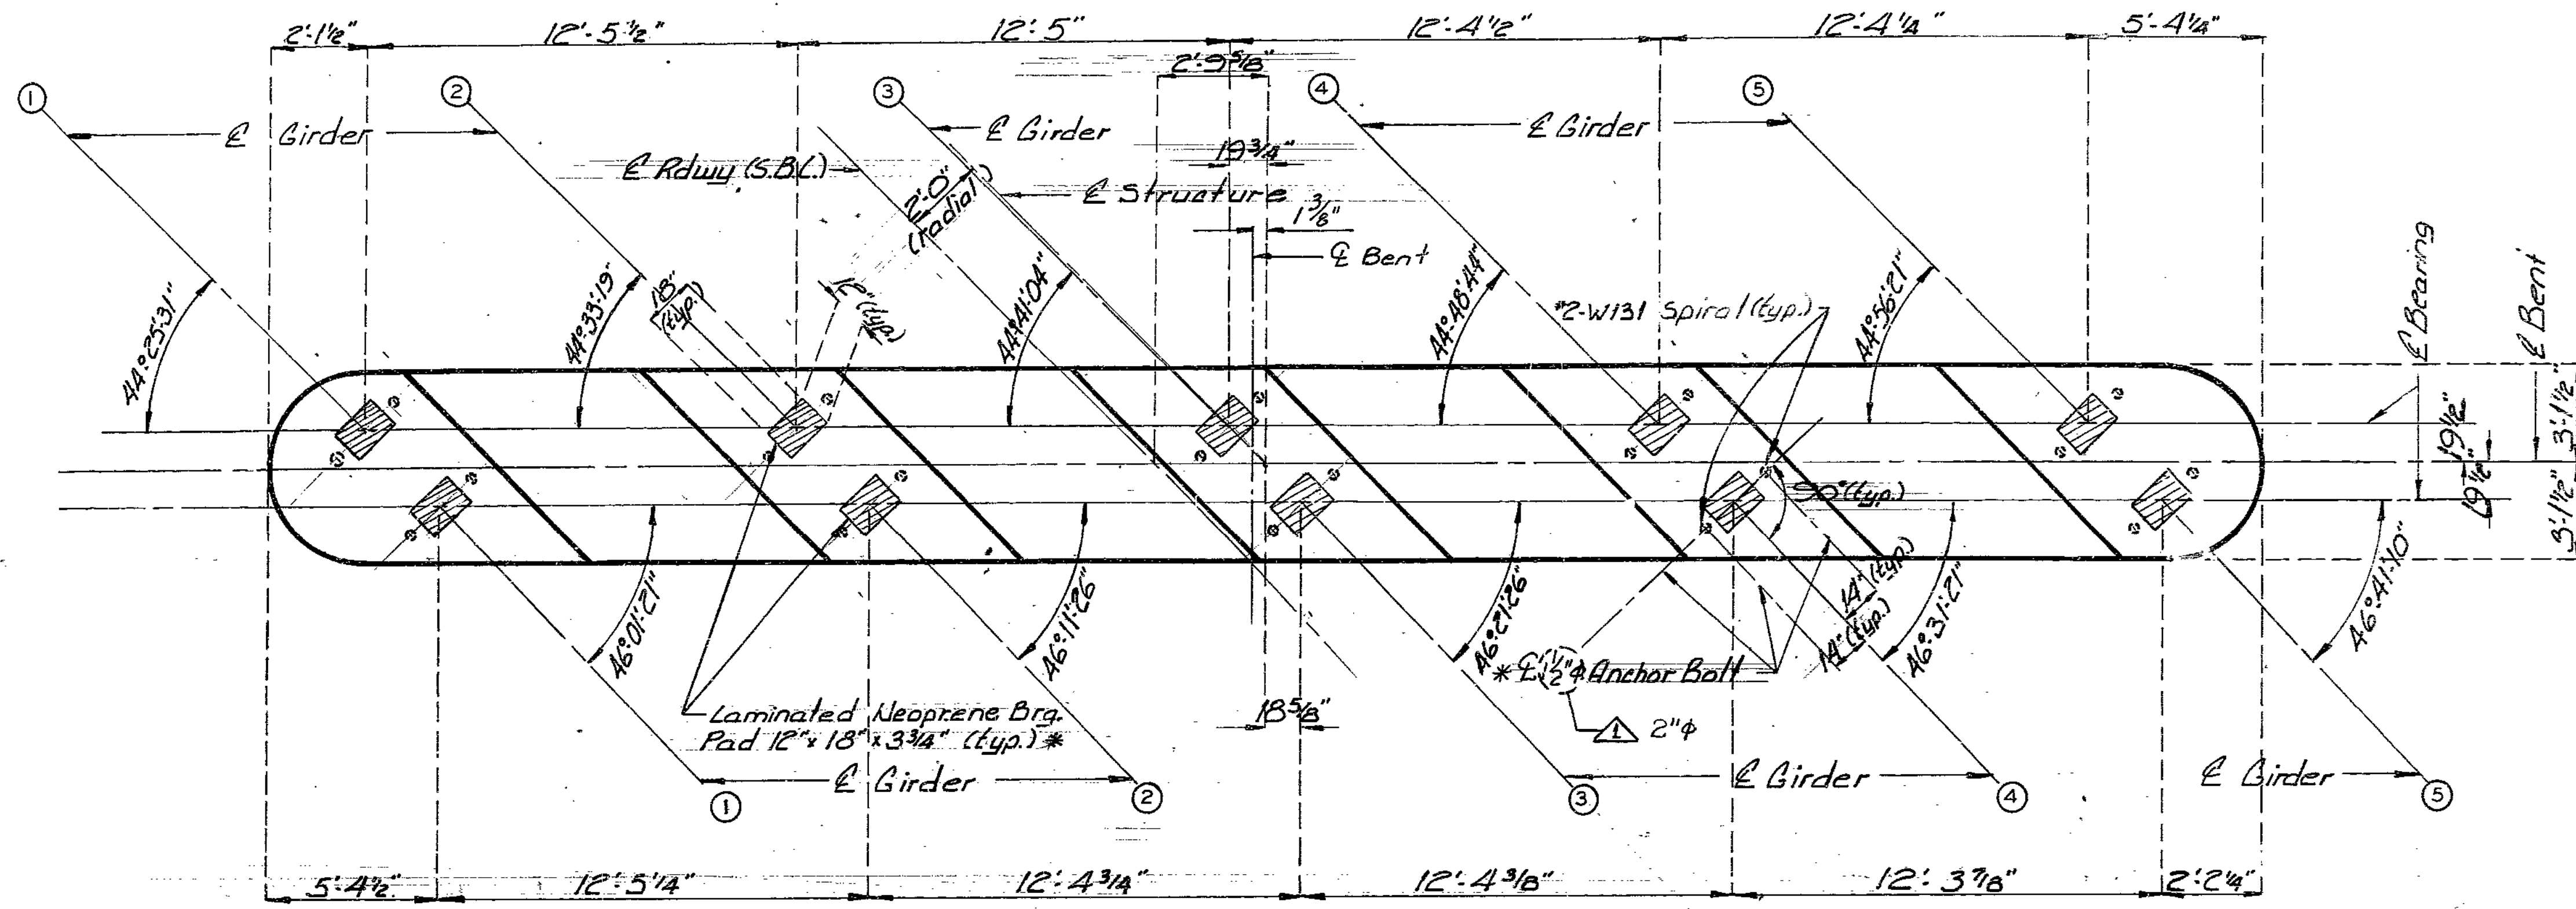

Note: For details of Bl. No.13 not shown see sheet No. 35.  
 For Details of Anchor Bolt Spiral see sheet No. 9.  
 \*Bearings and Anchor Bolts are included in Future Construction.

258 344

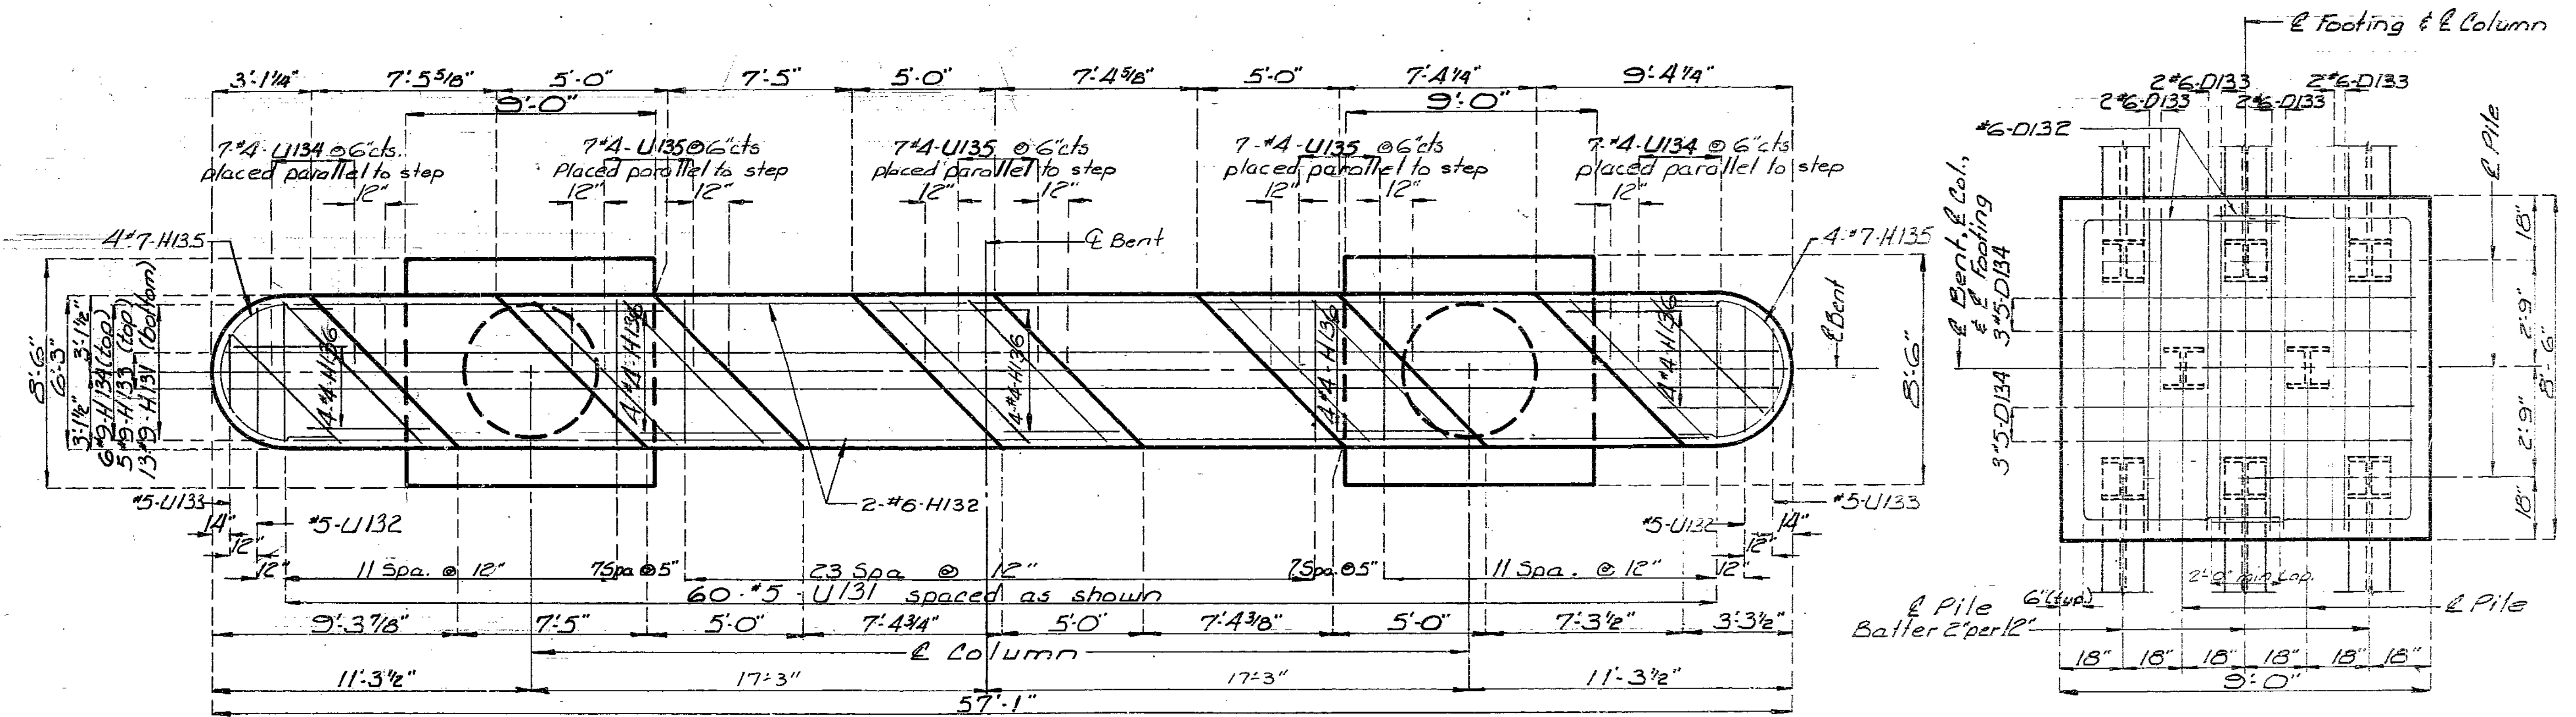

DETAILS OF INTERMEDIATE BENT NO. 13

DETAILED MAY 1988  
 CHECKED August 1988

Note: This drawing is not to scale. Follow dimensions.



Sheet No. 34 of 55

Revised 3/8/89 JACKSON

COUNTY

A-2745

STATE	PROJ. NO.	SHEET NO.
MO.		30

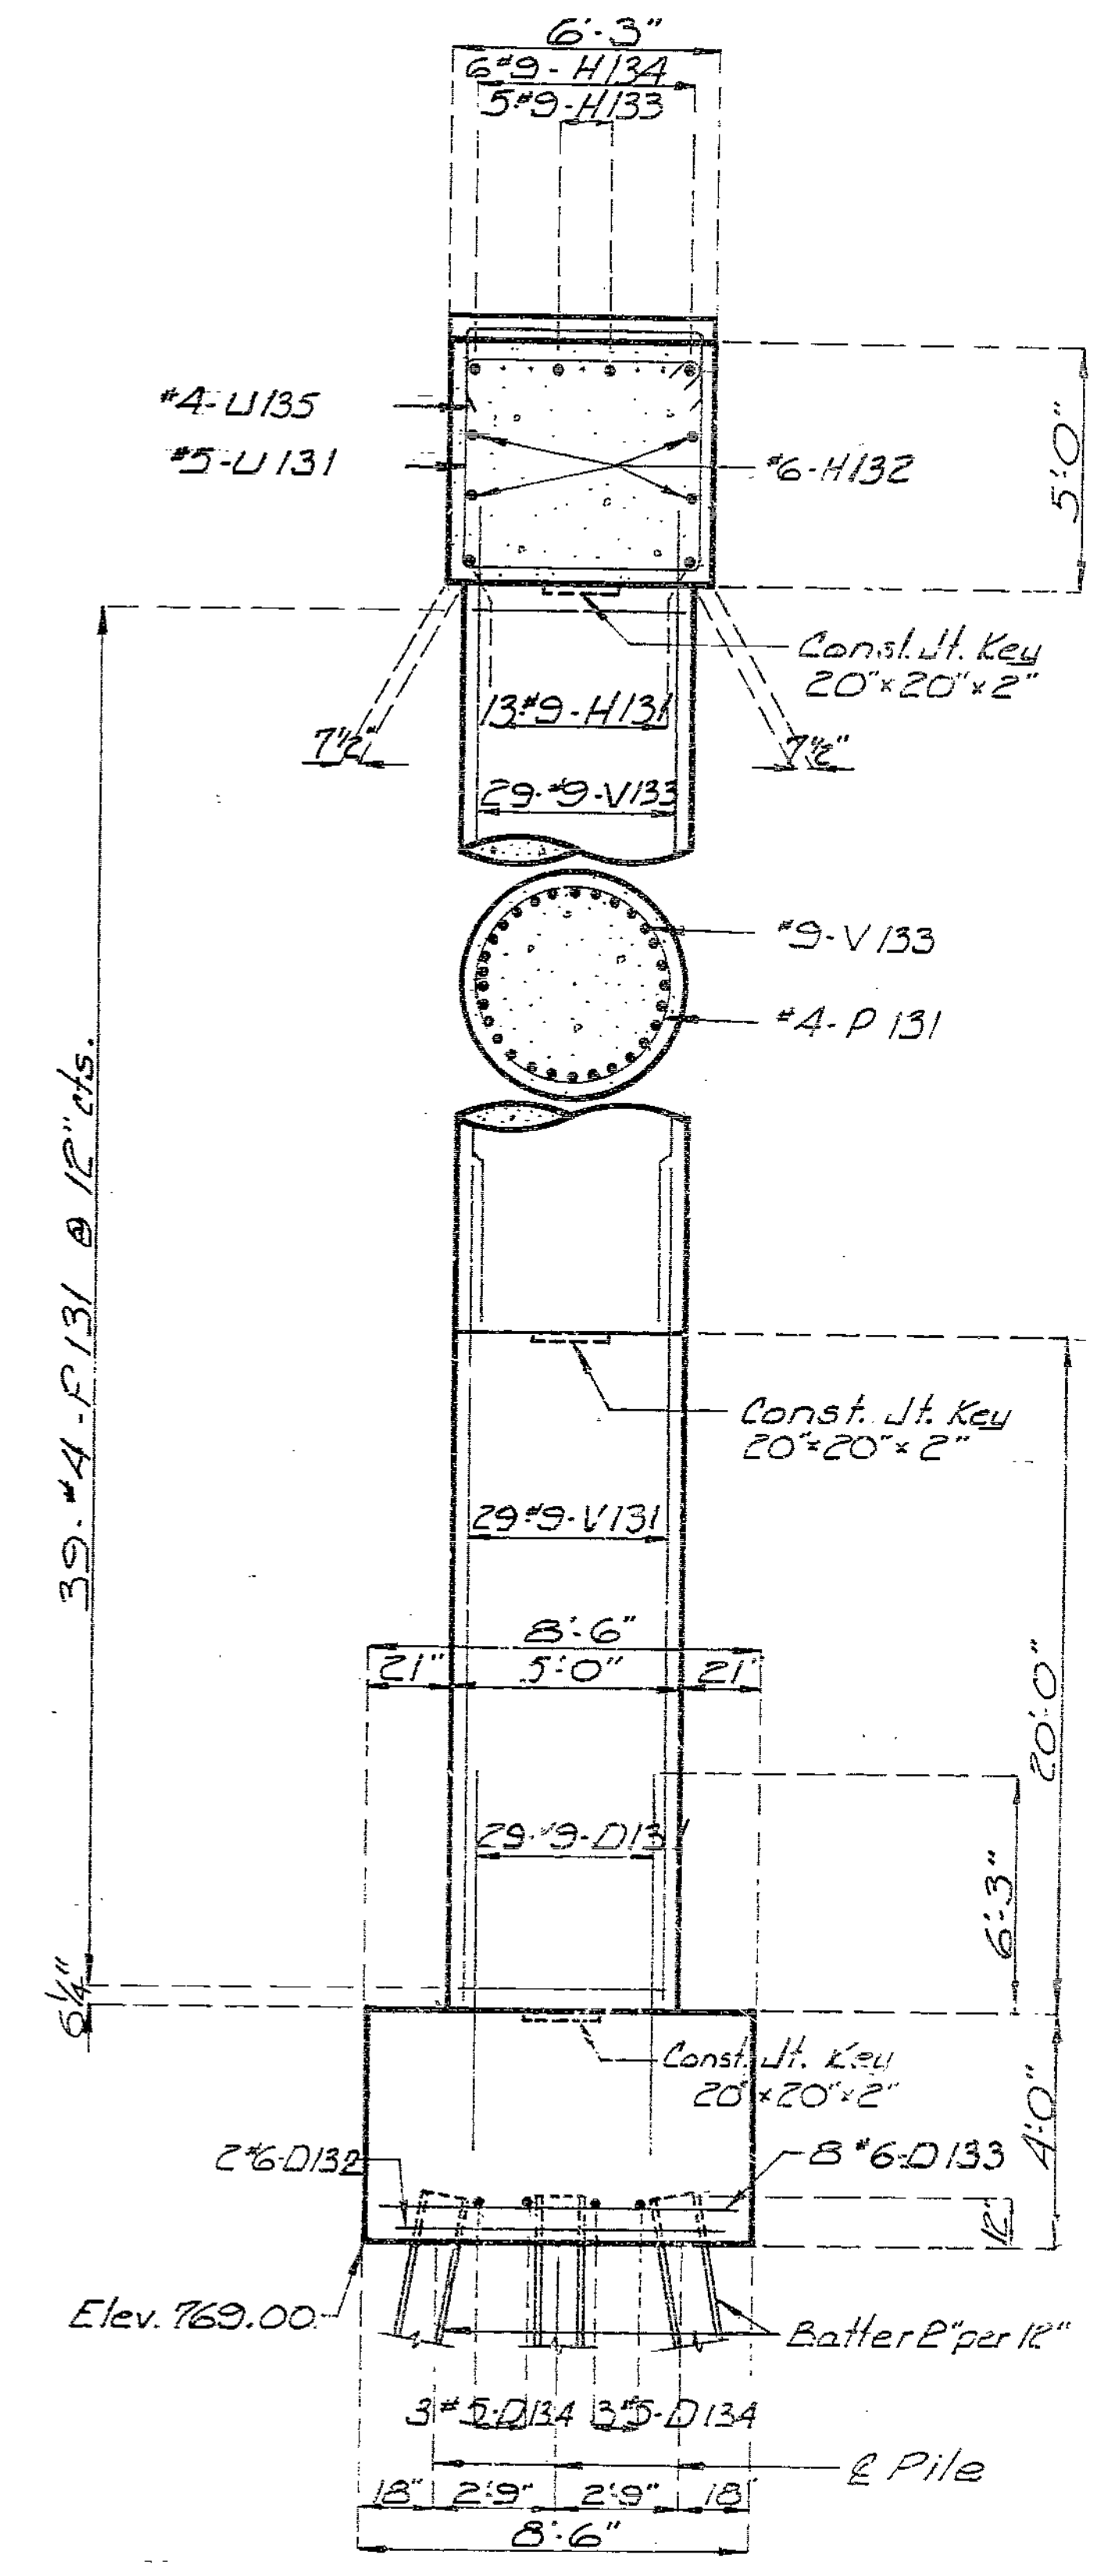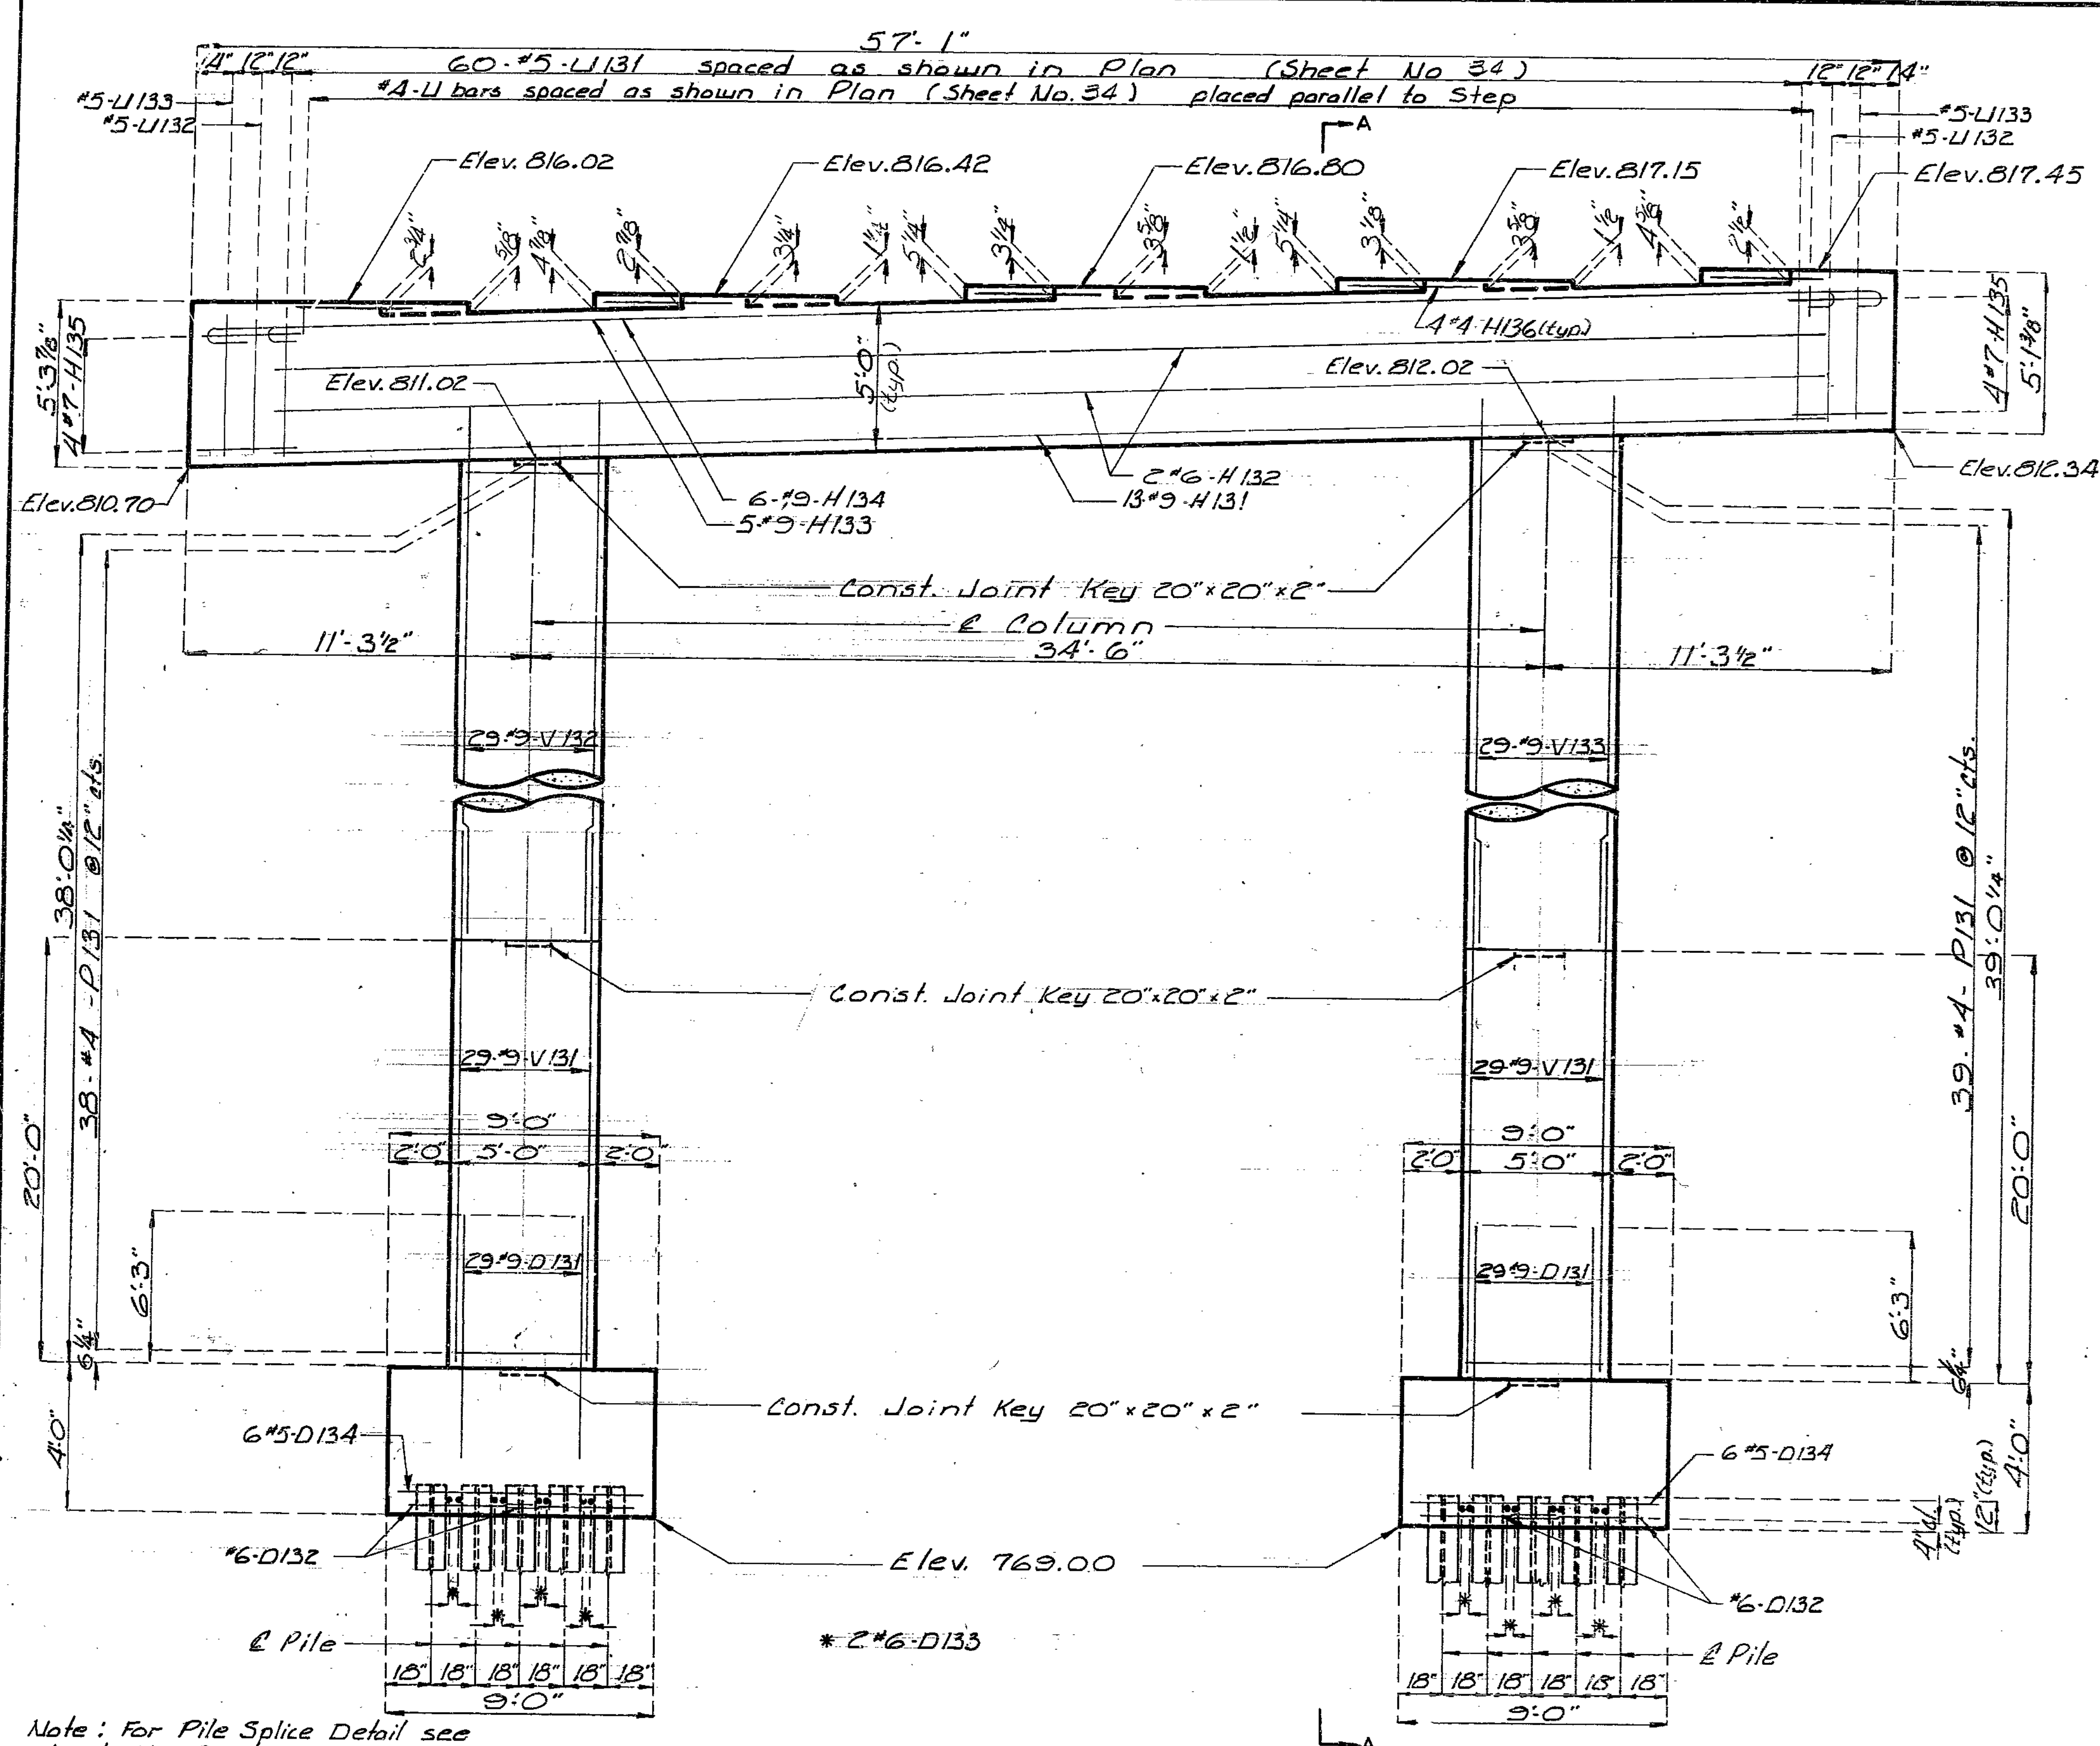

831 345

Note: For Pile Splice Detail see sheet No. 9.  
For details of Int. Bent No. 13 not shown see sheet No. 34.

ELEVATION  
DETAILS OF INTERMEDIATE BENT NO. 13


SECTION A-A

DETAILED MAY 1988  
CHECKED August 1988


Note: This drawing is not to scale. Follow dimensions.

Sheet No. 33 of 35


STATE	PROJ. NO.	SHEET NO.
MO.		31

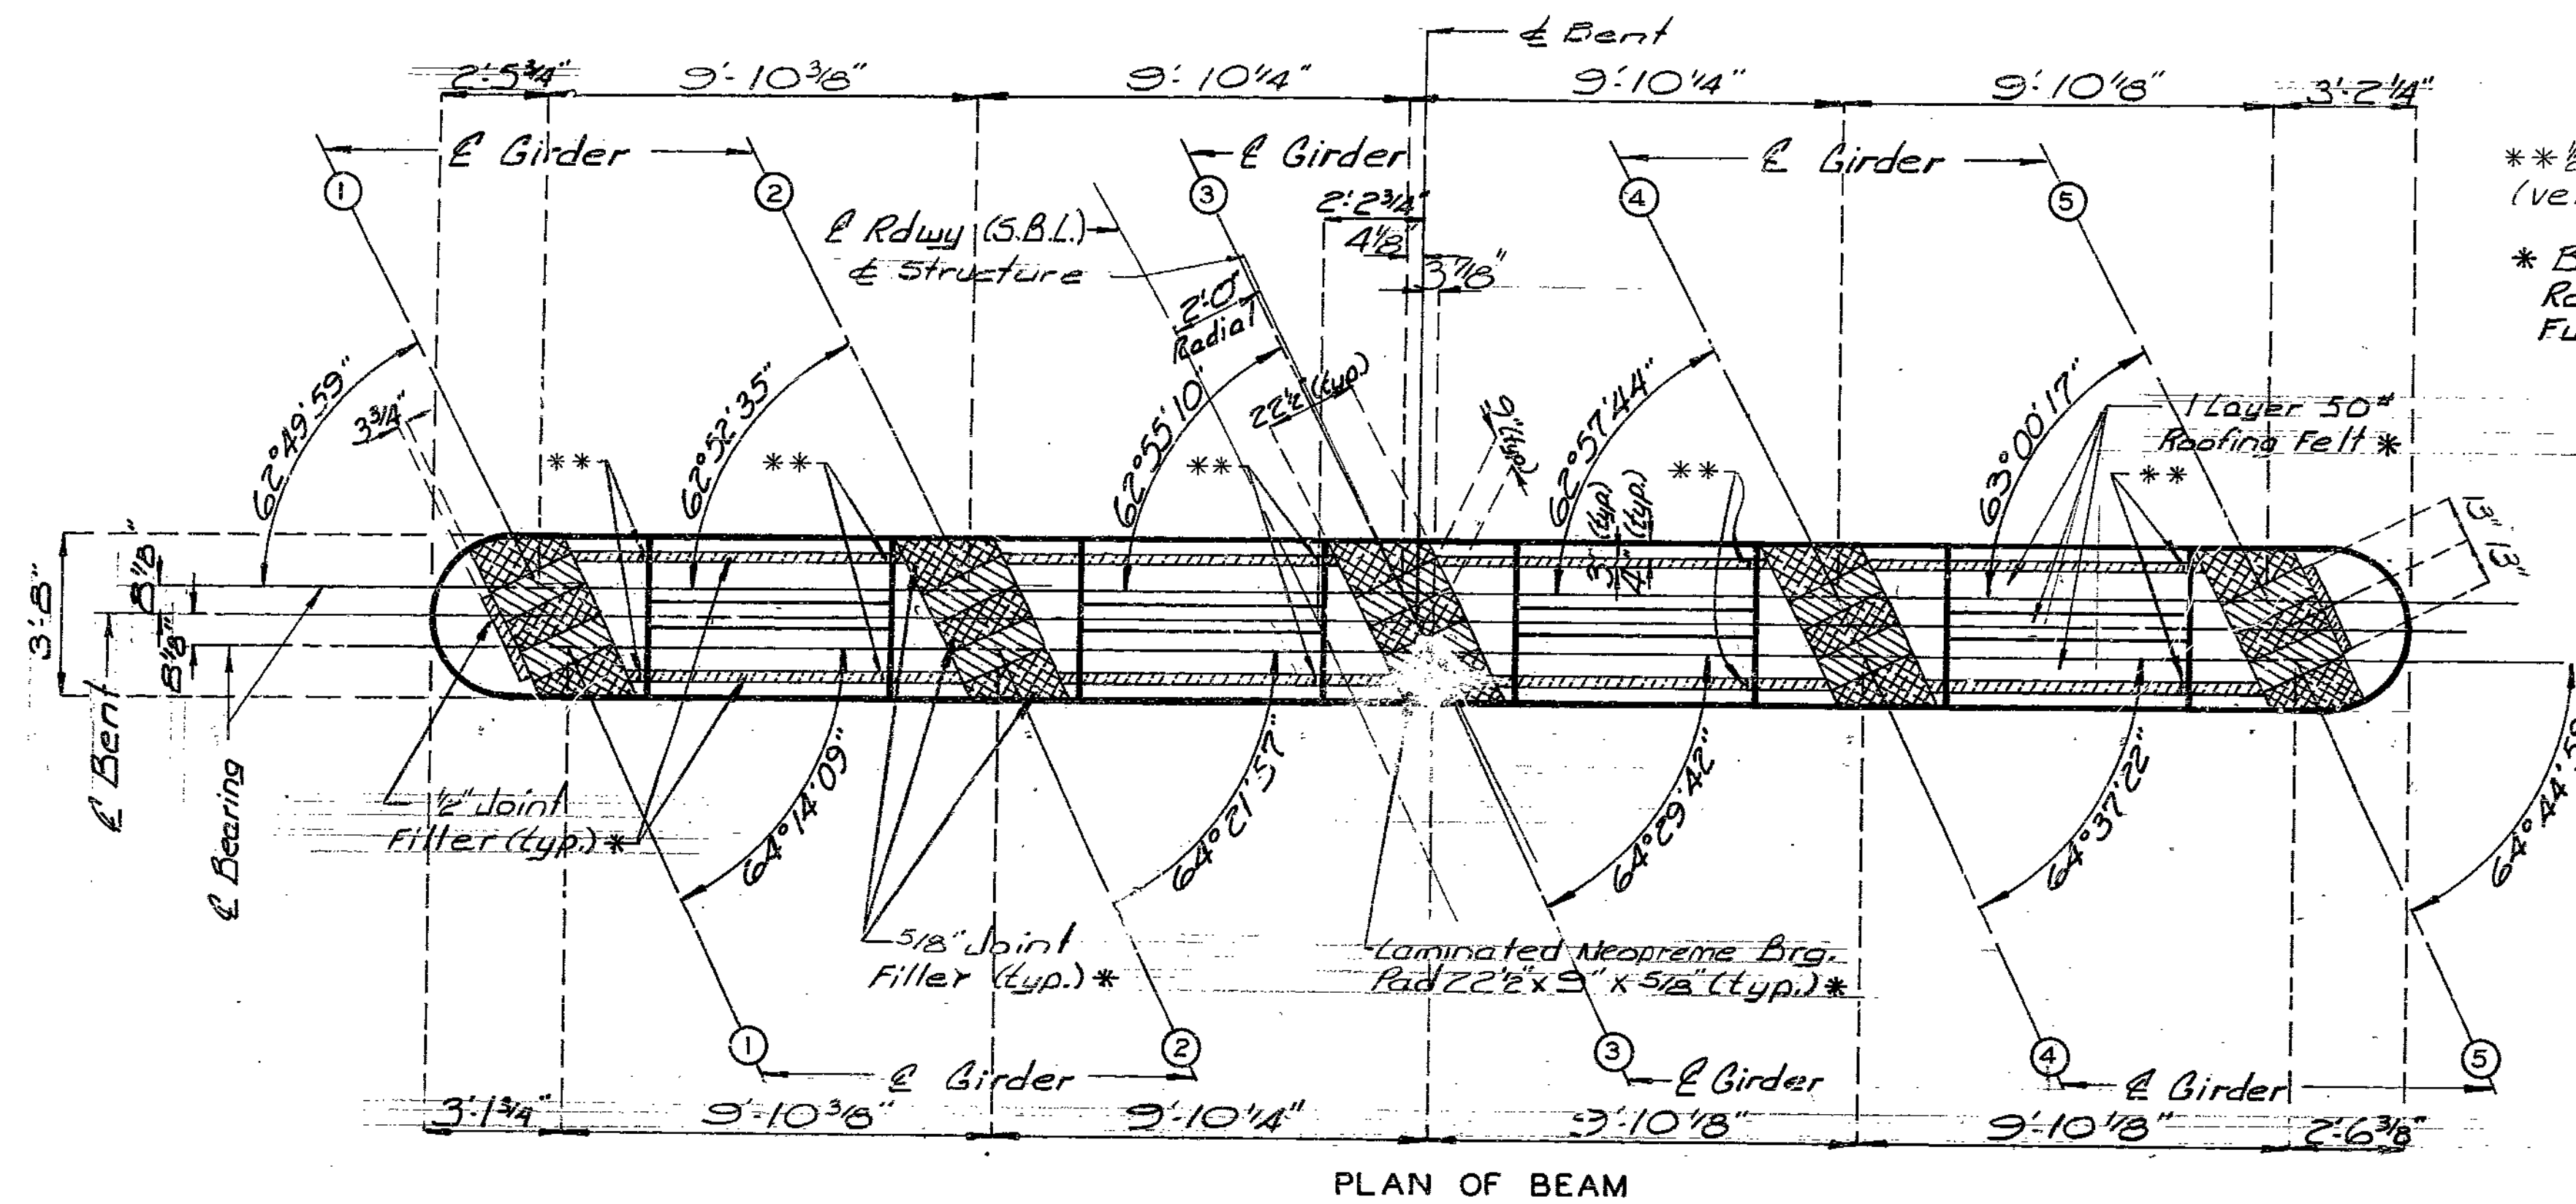

\*\* Joint Filler (vertical face) \*  
 \* Bearings, Jt. Filler, and Roofing Felt are in Future Construction.

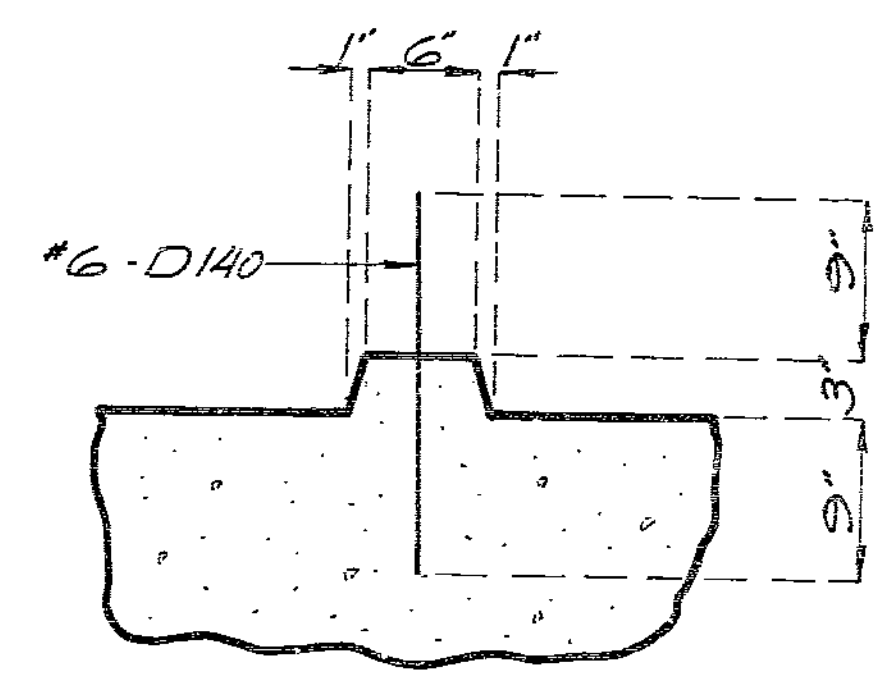


DETAIL OF KEY

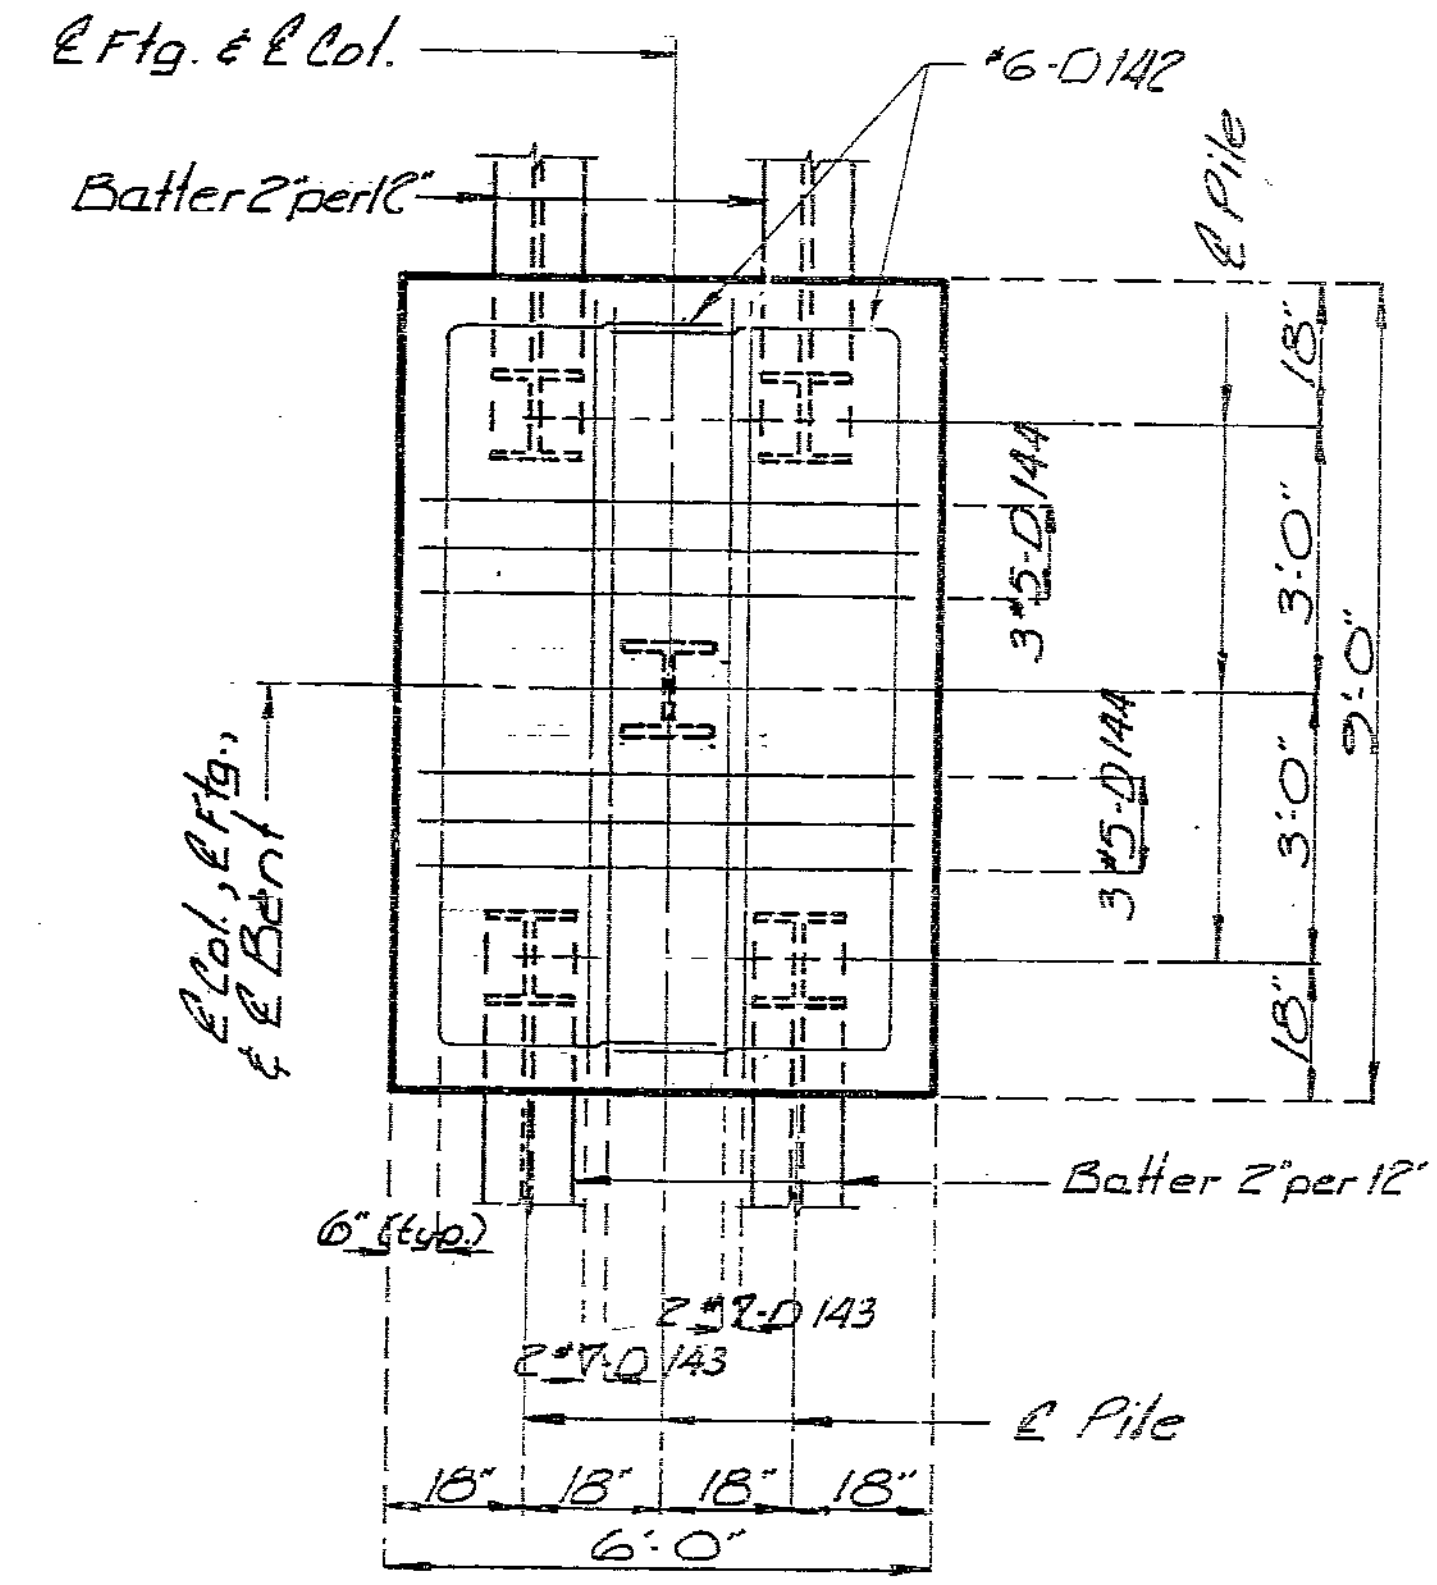

PLAN OF FOOTING

Note: For details of Bent No. 14 not shown see sheet No. 37.

237 346

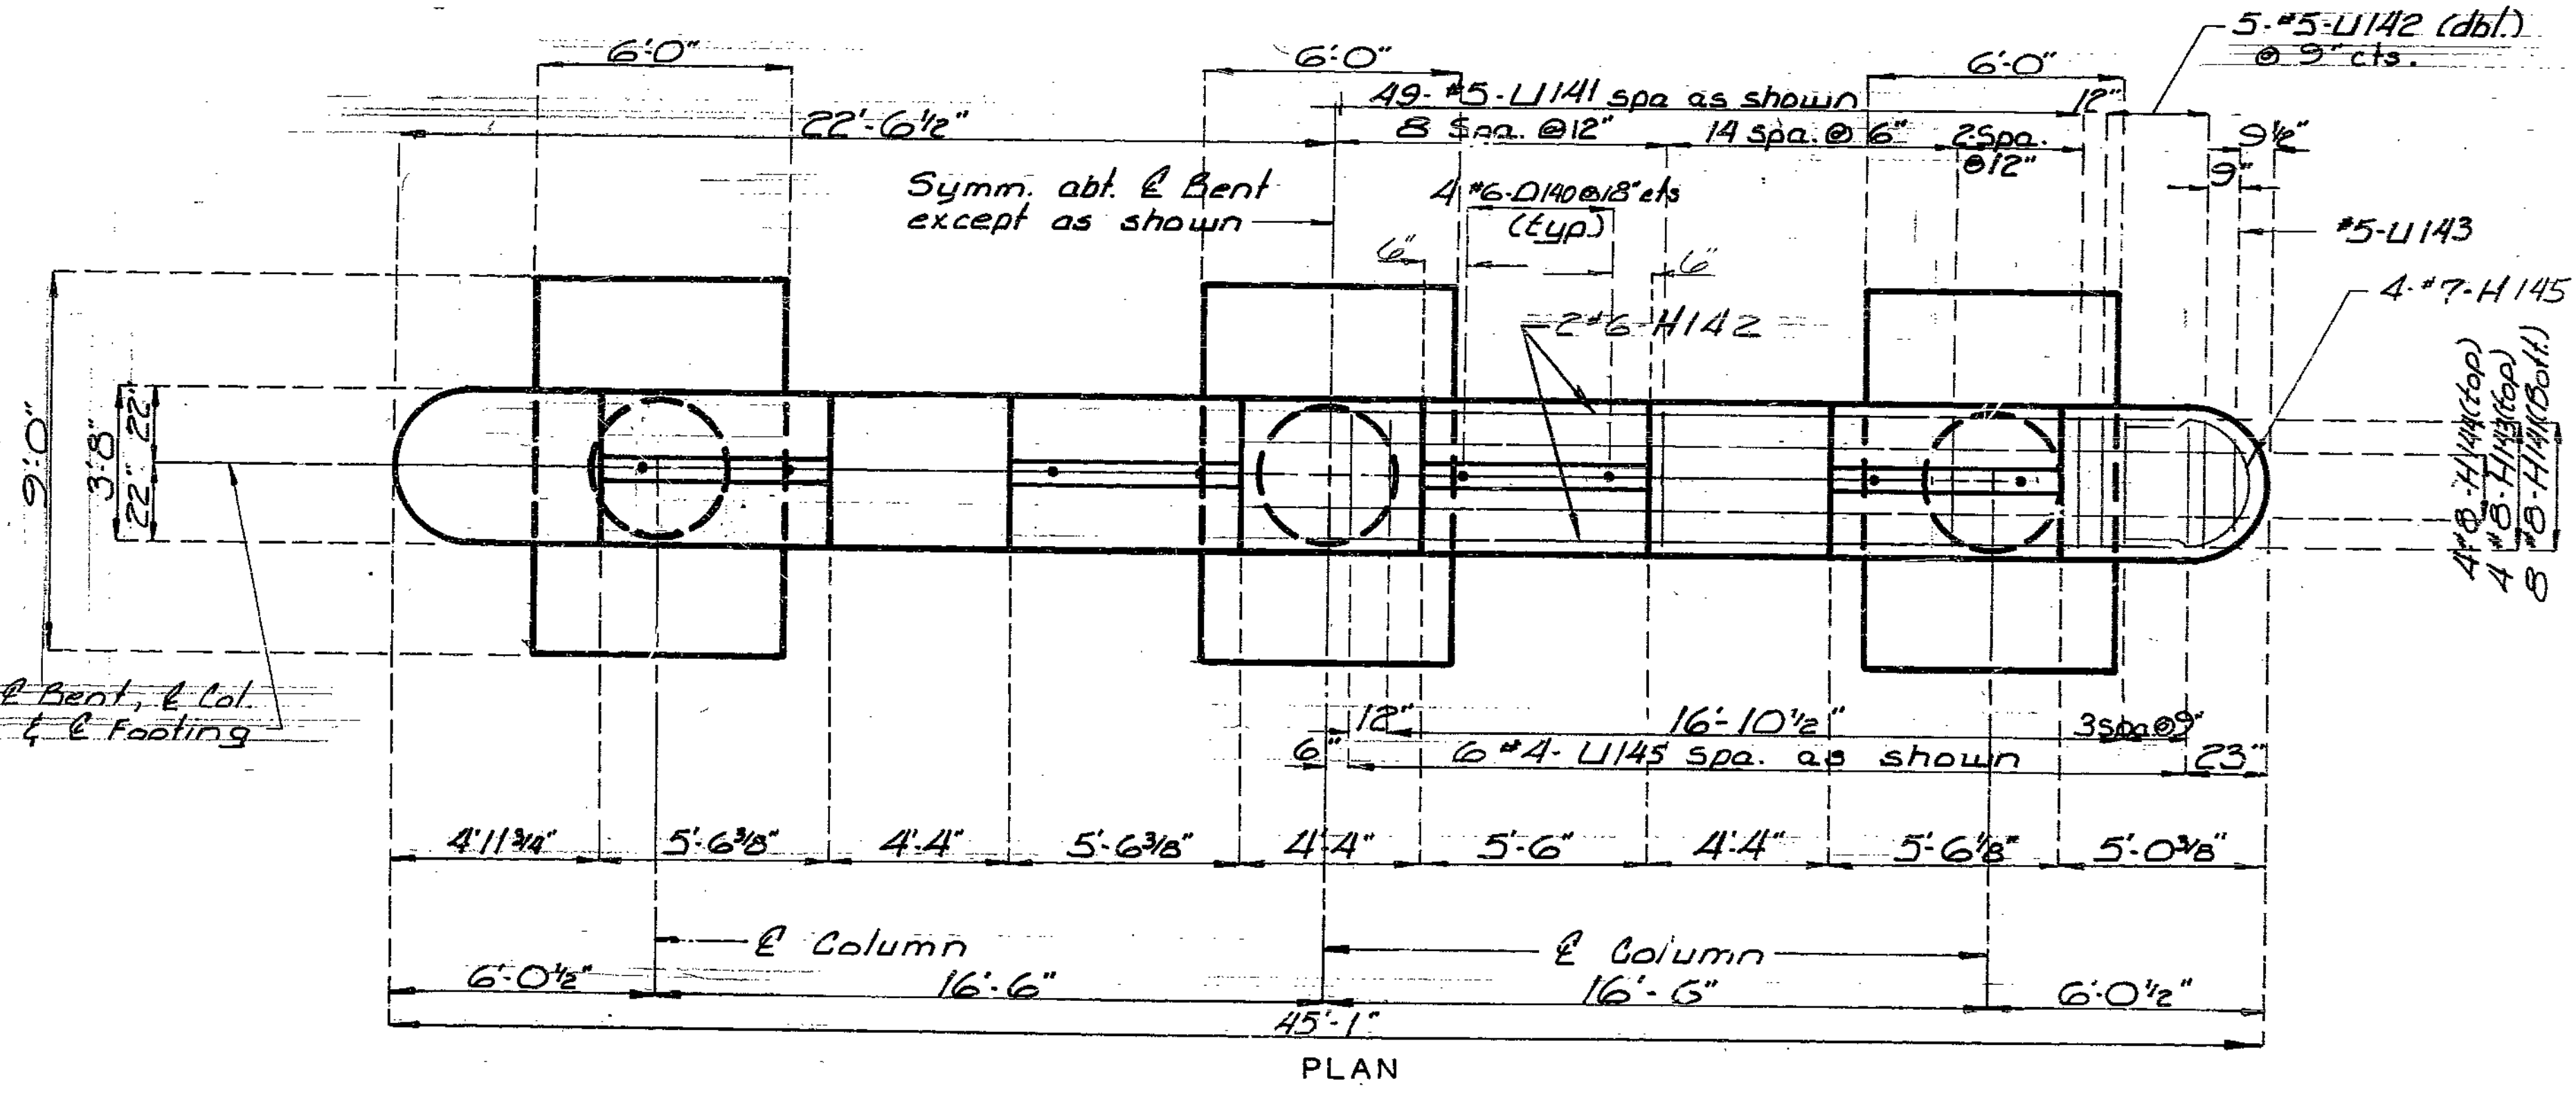

PLAN

DETAILS OF INTERMEDIATE BENT NO. 14

DETAILED JUNE 1988  
 CHECKED August 1988



Note: This drawing is not to scale. Follow dimensions.

Sheet No. 36 of 36

JACKSON COUNTY

A-2745

STATE	PROJ. NO.	SHEET NO.
MO.		32

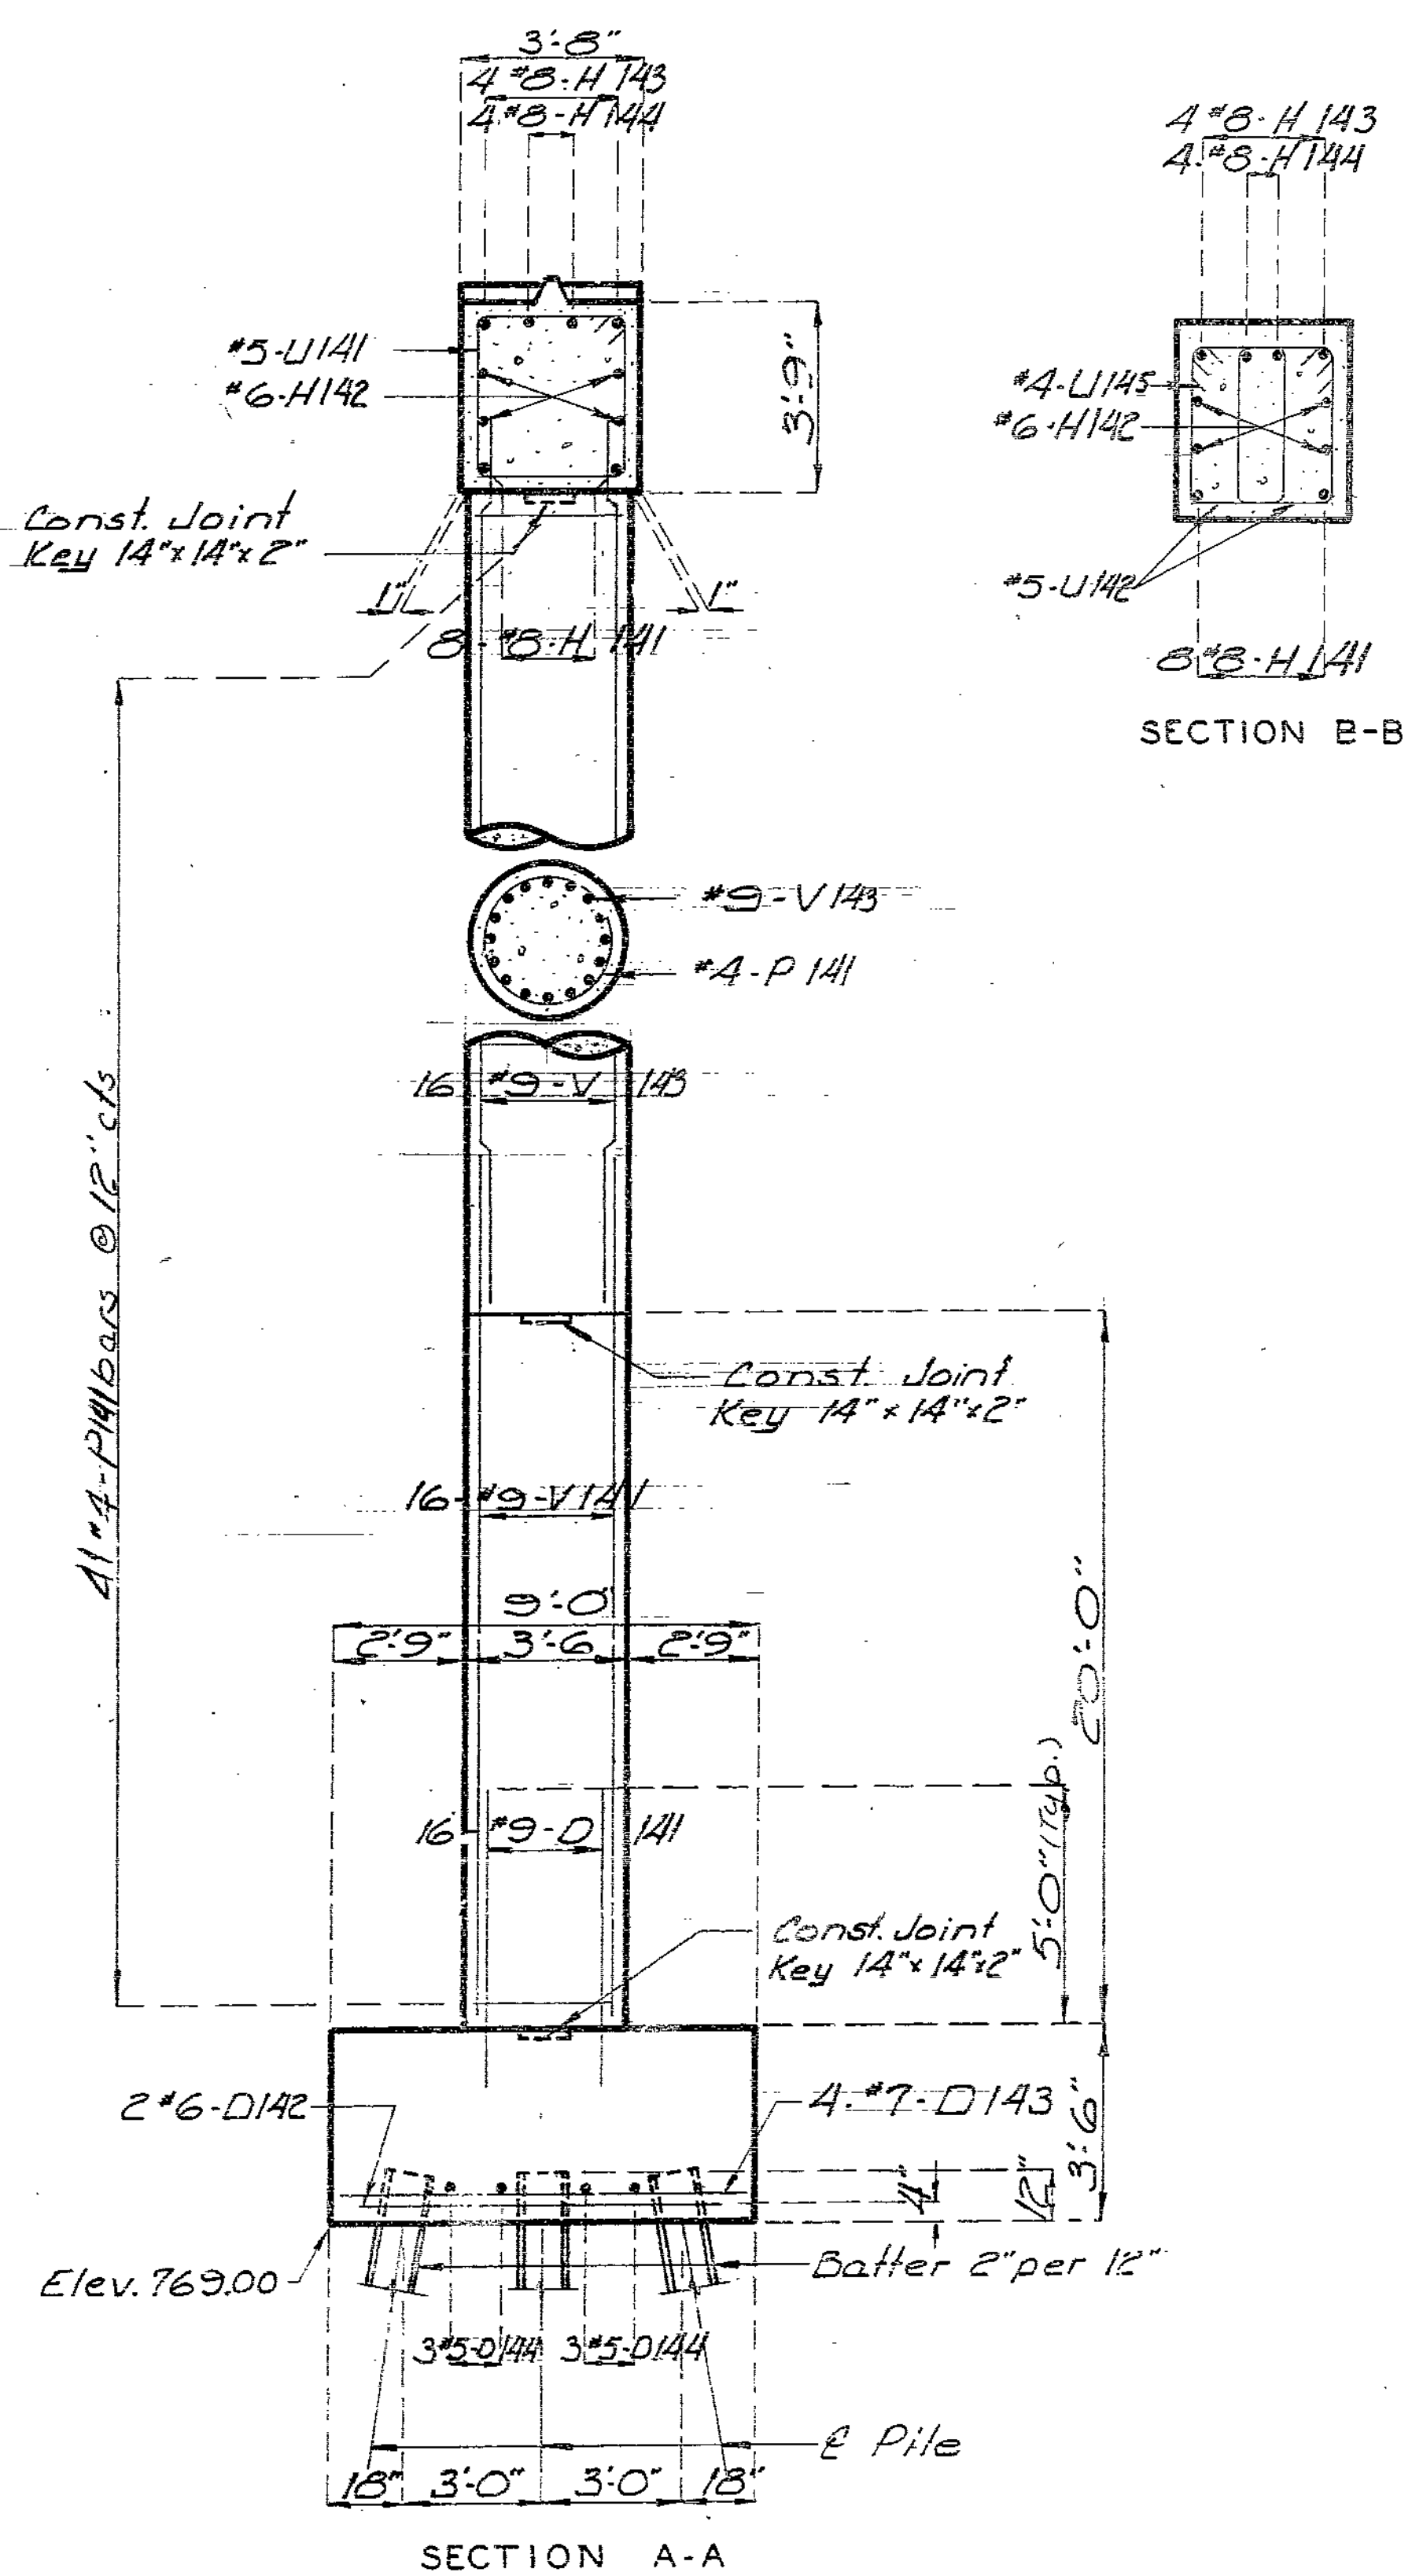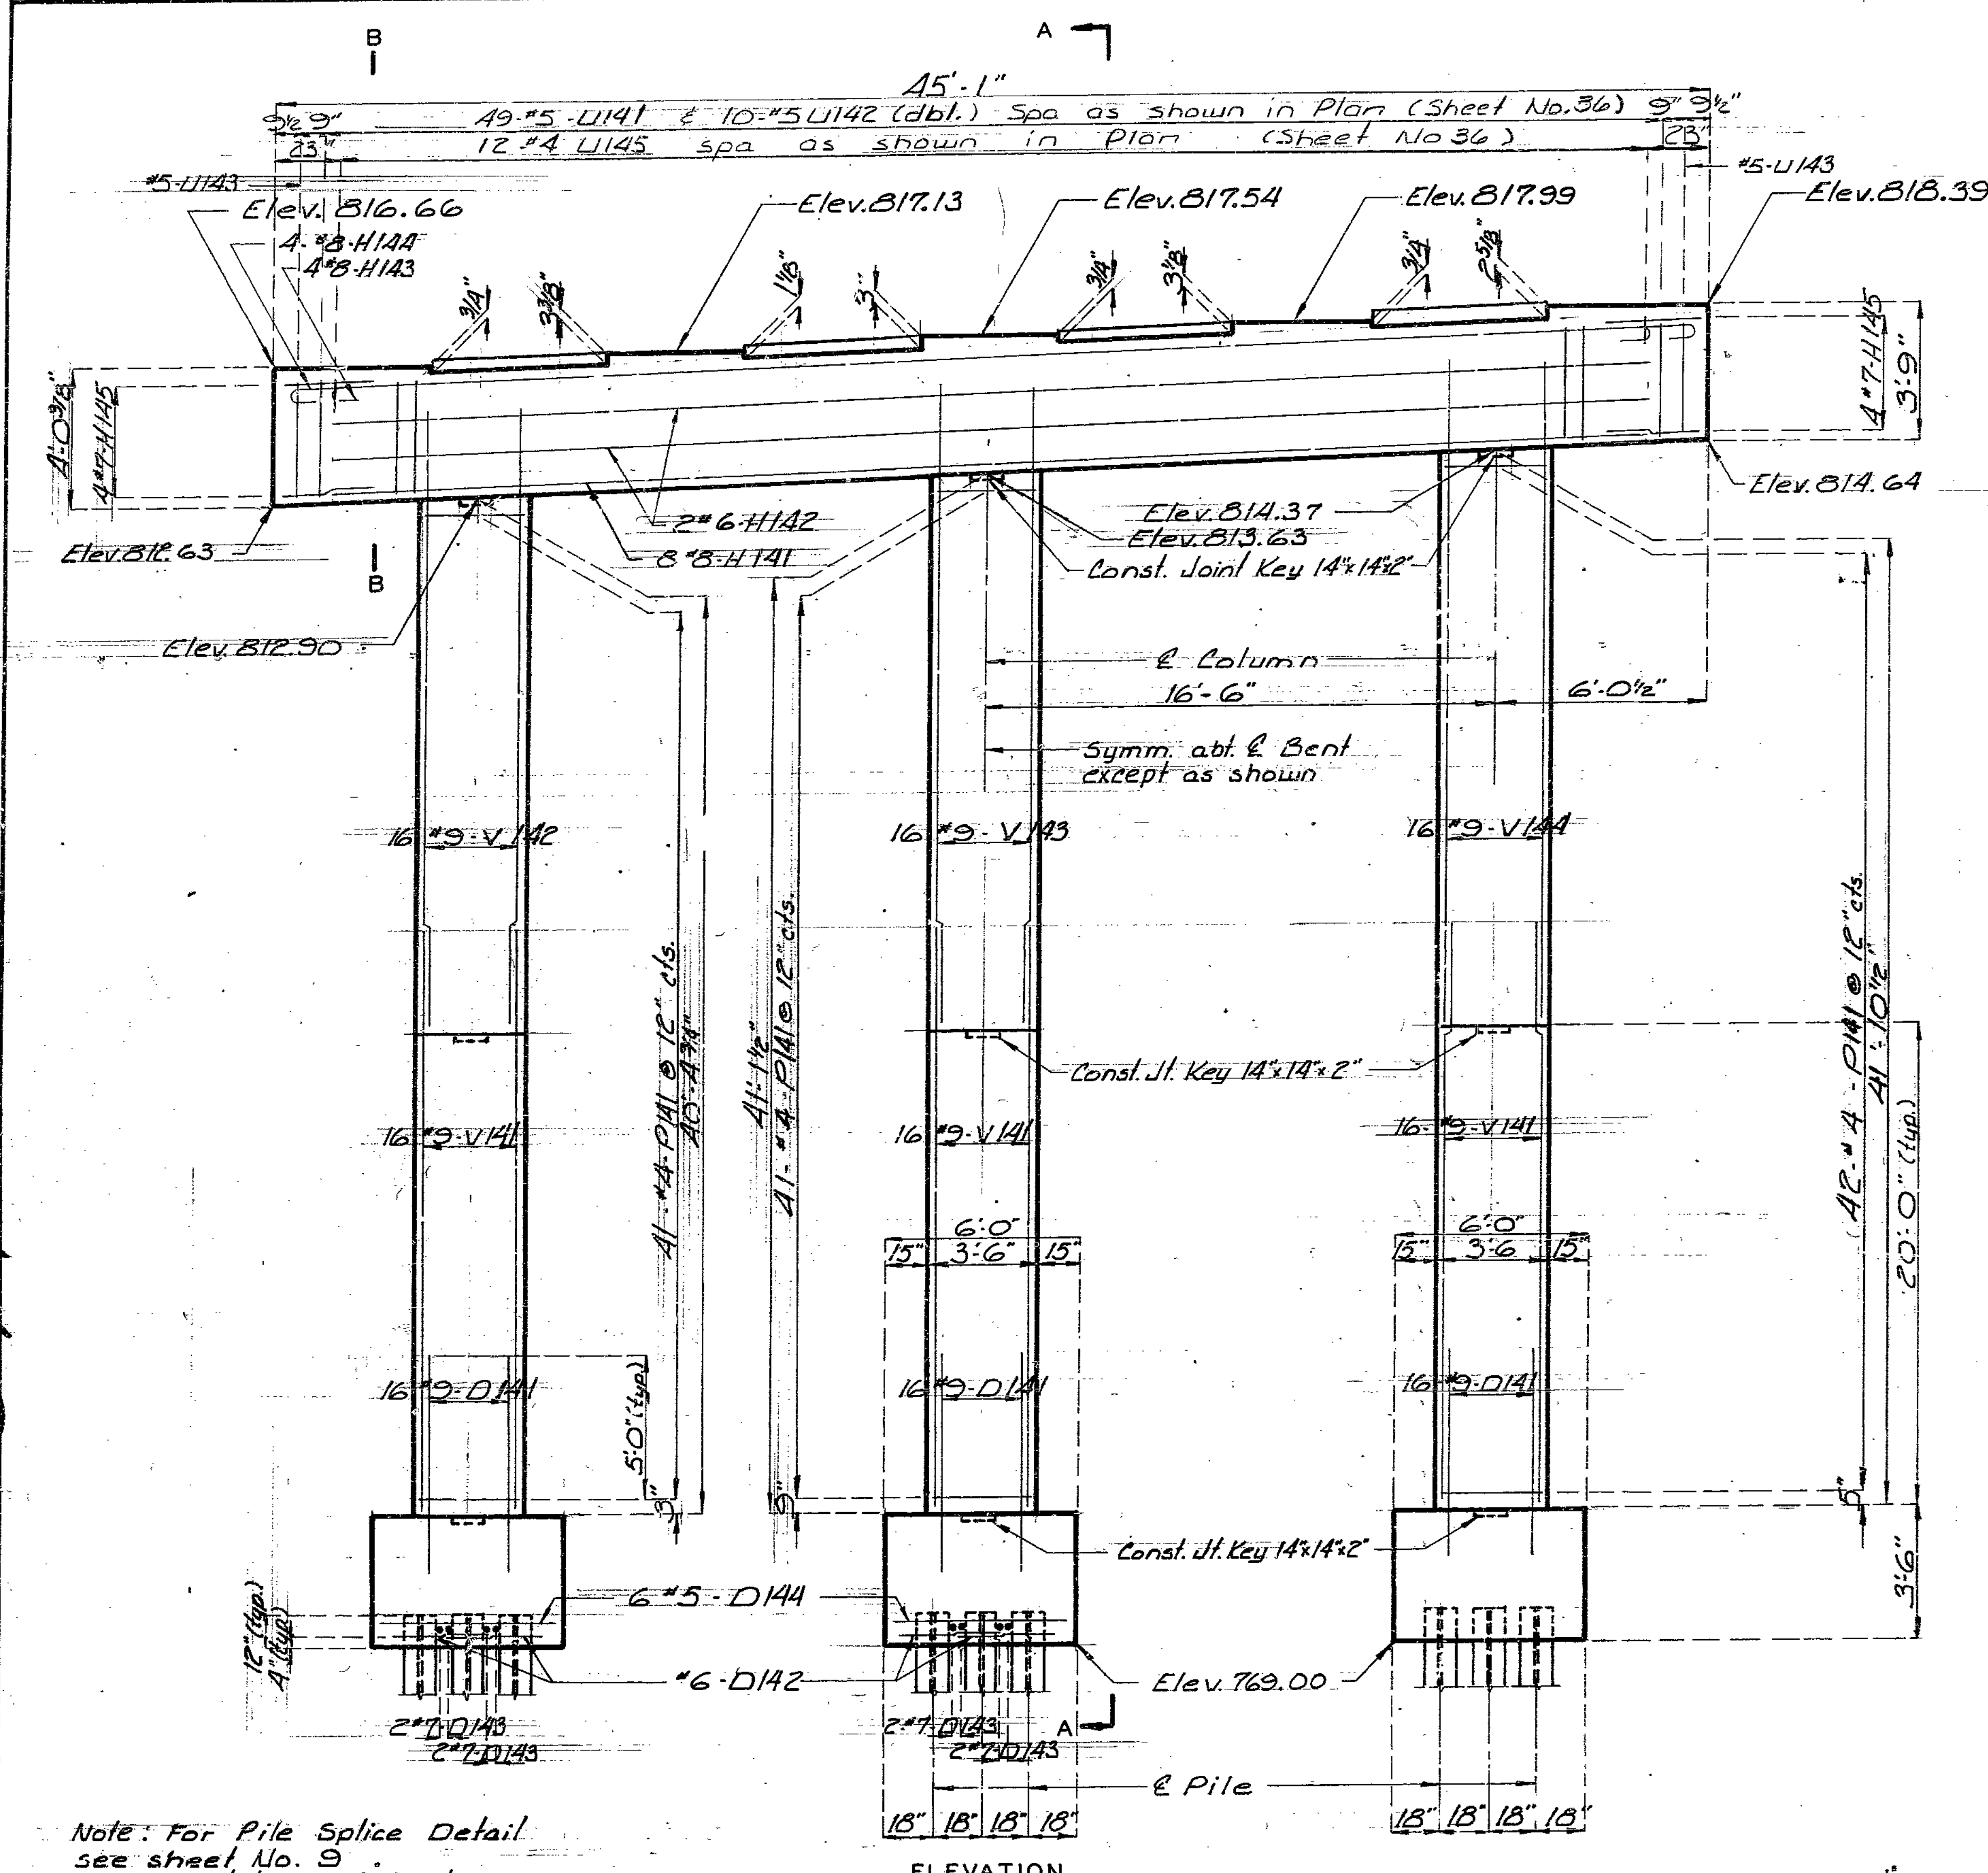

Note: For Pile Splice Detail see sheet No. 9  
 For details of Bent No. 14 not shown see sheet No. 36.

DETAILS OF INTERMEDIATE BENT NO. 14

833 347

DETAILED JUNE 1988  
 CHECKED August 1988

Note: This drawing is not to scale. Follow dimensions.


Sheet No. 37 of 55

JACKSON COUNTY

A-2745

STATE	PROJ. NO.	SHEET NO.
MO.		93

Note: For Details of Intermediate Bent No. 15 see sheet No. 39.


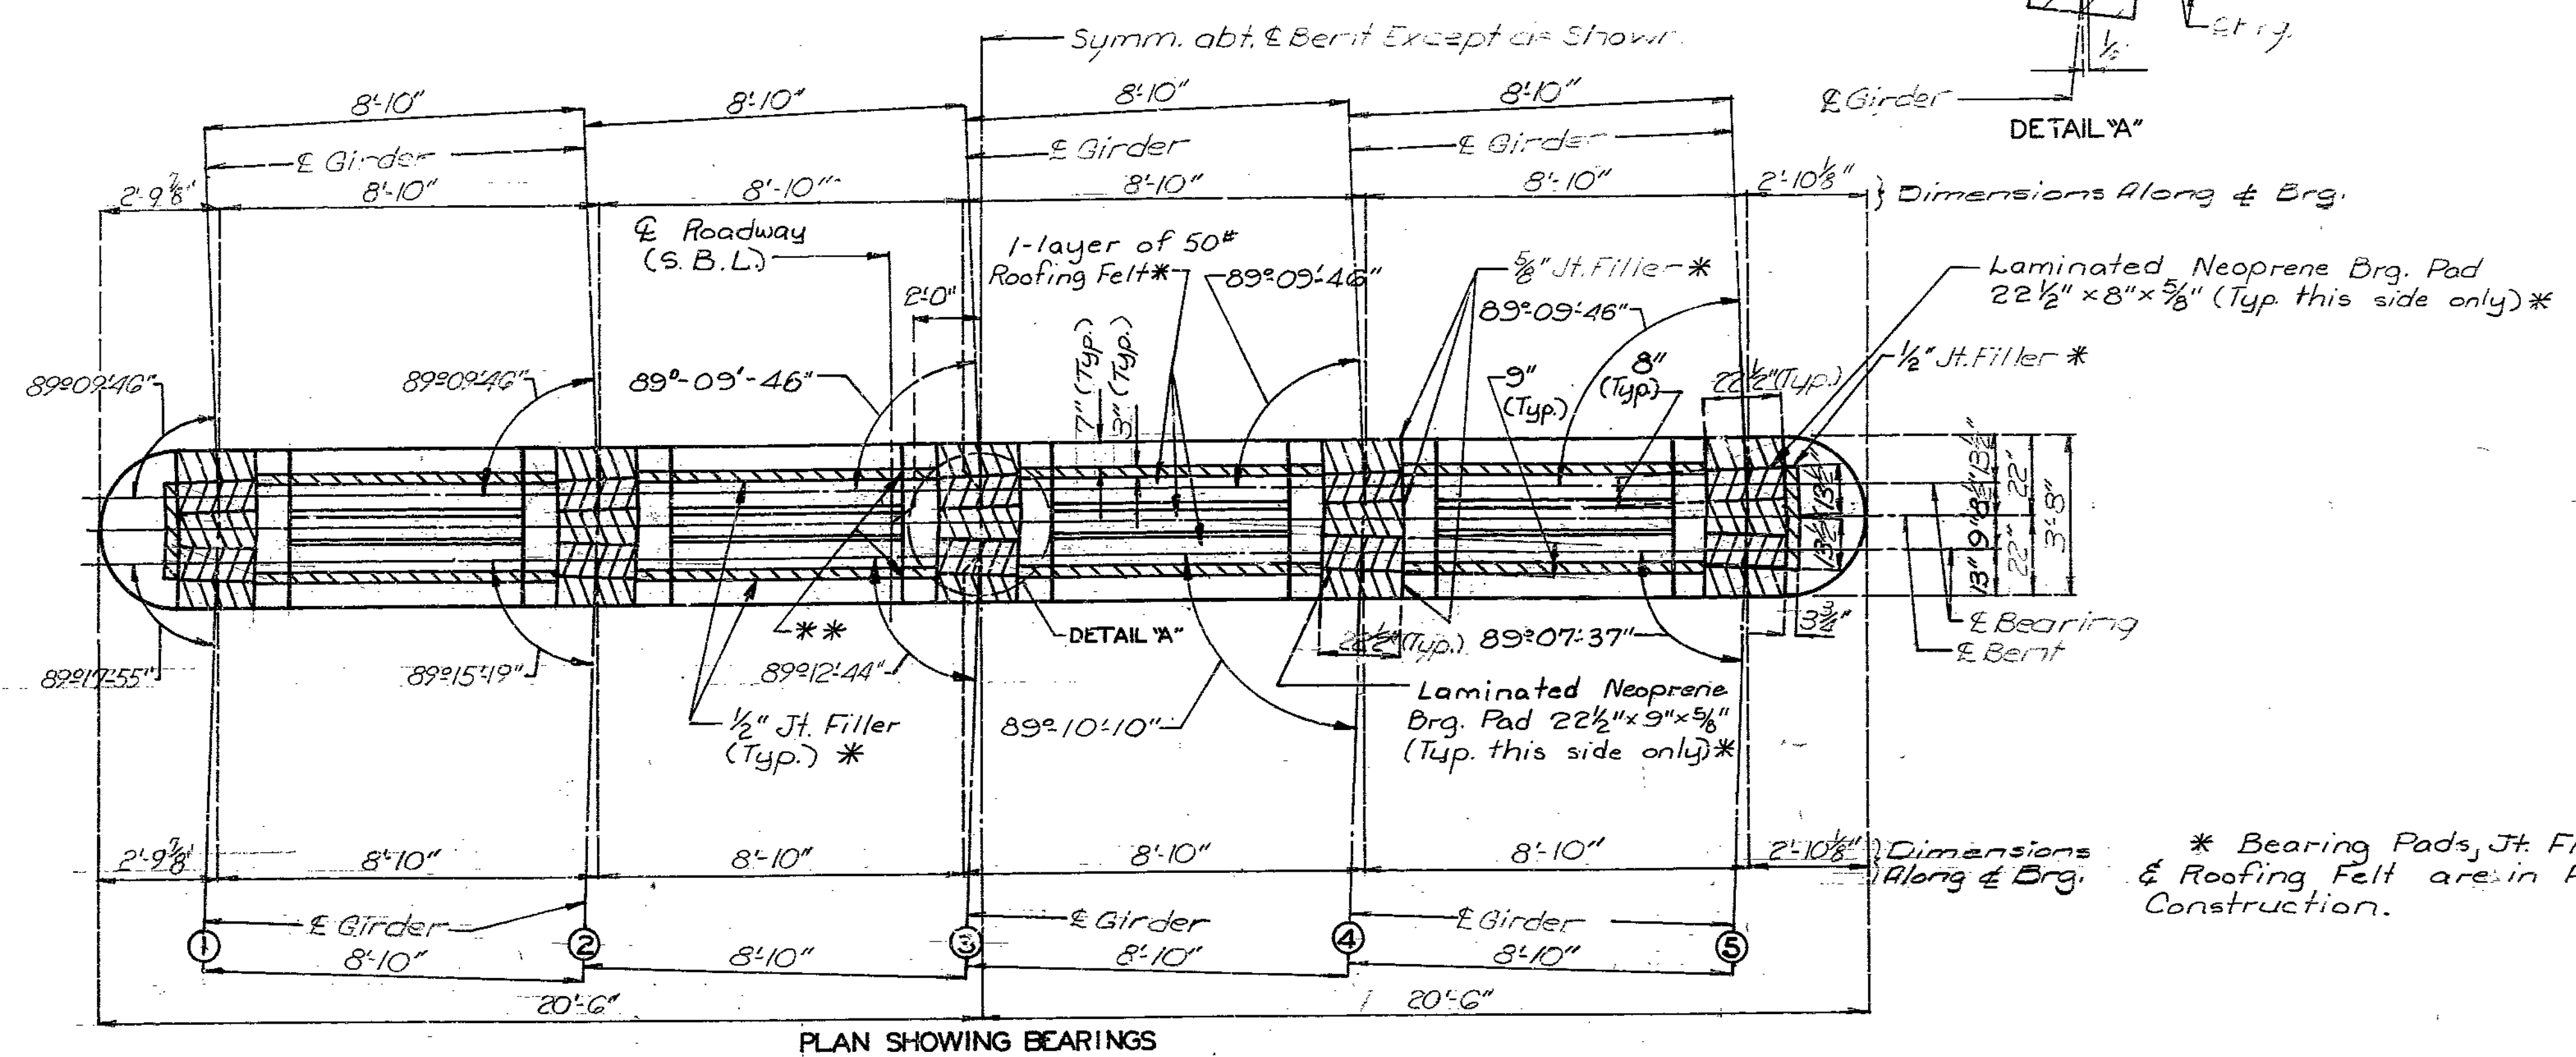


\* Bearing Pads, Jt. Filler & Roofing Felt are in Future Construction.

\*\* 1/2" Jt. Filler on vertical face of steps over 2" high (Typ.)\*

Note: For details of pile splice see sheet No. 9.

834 348

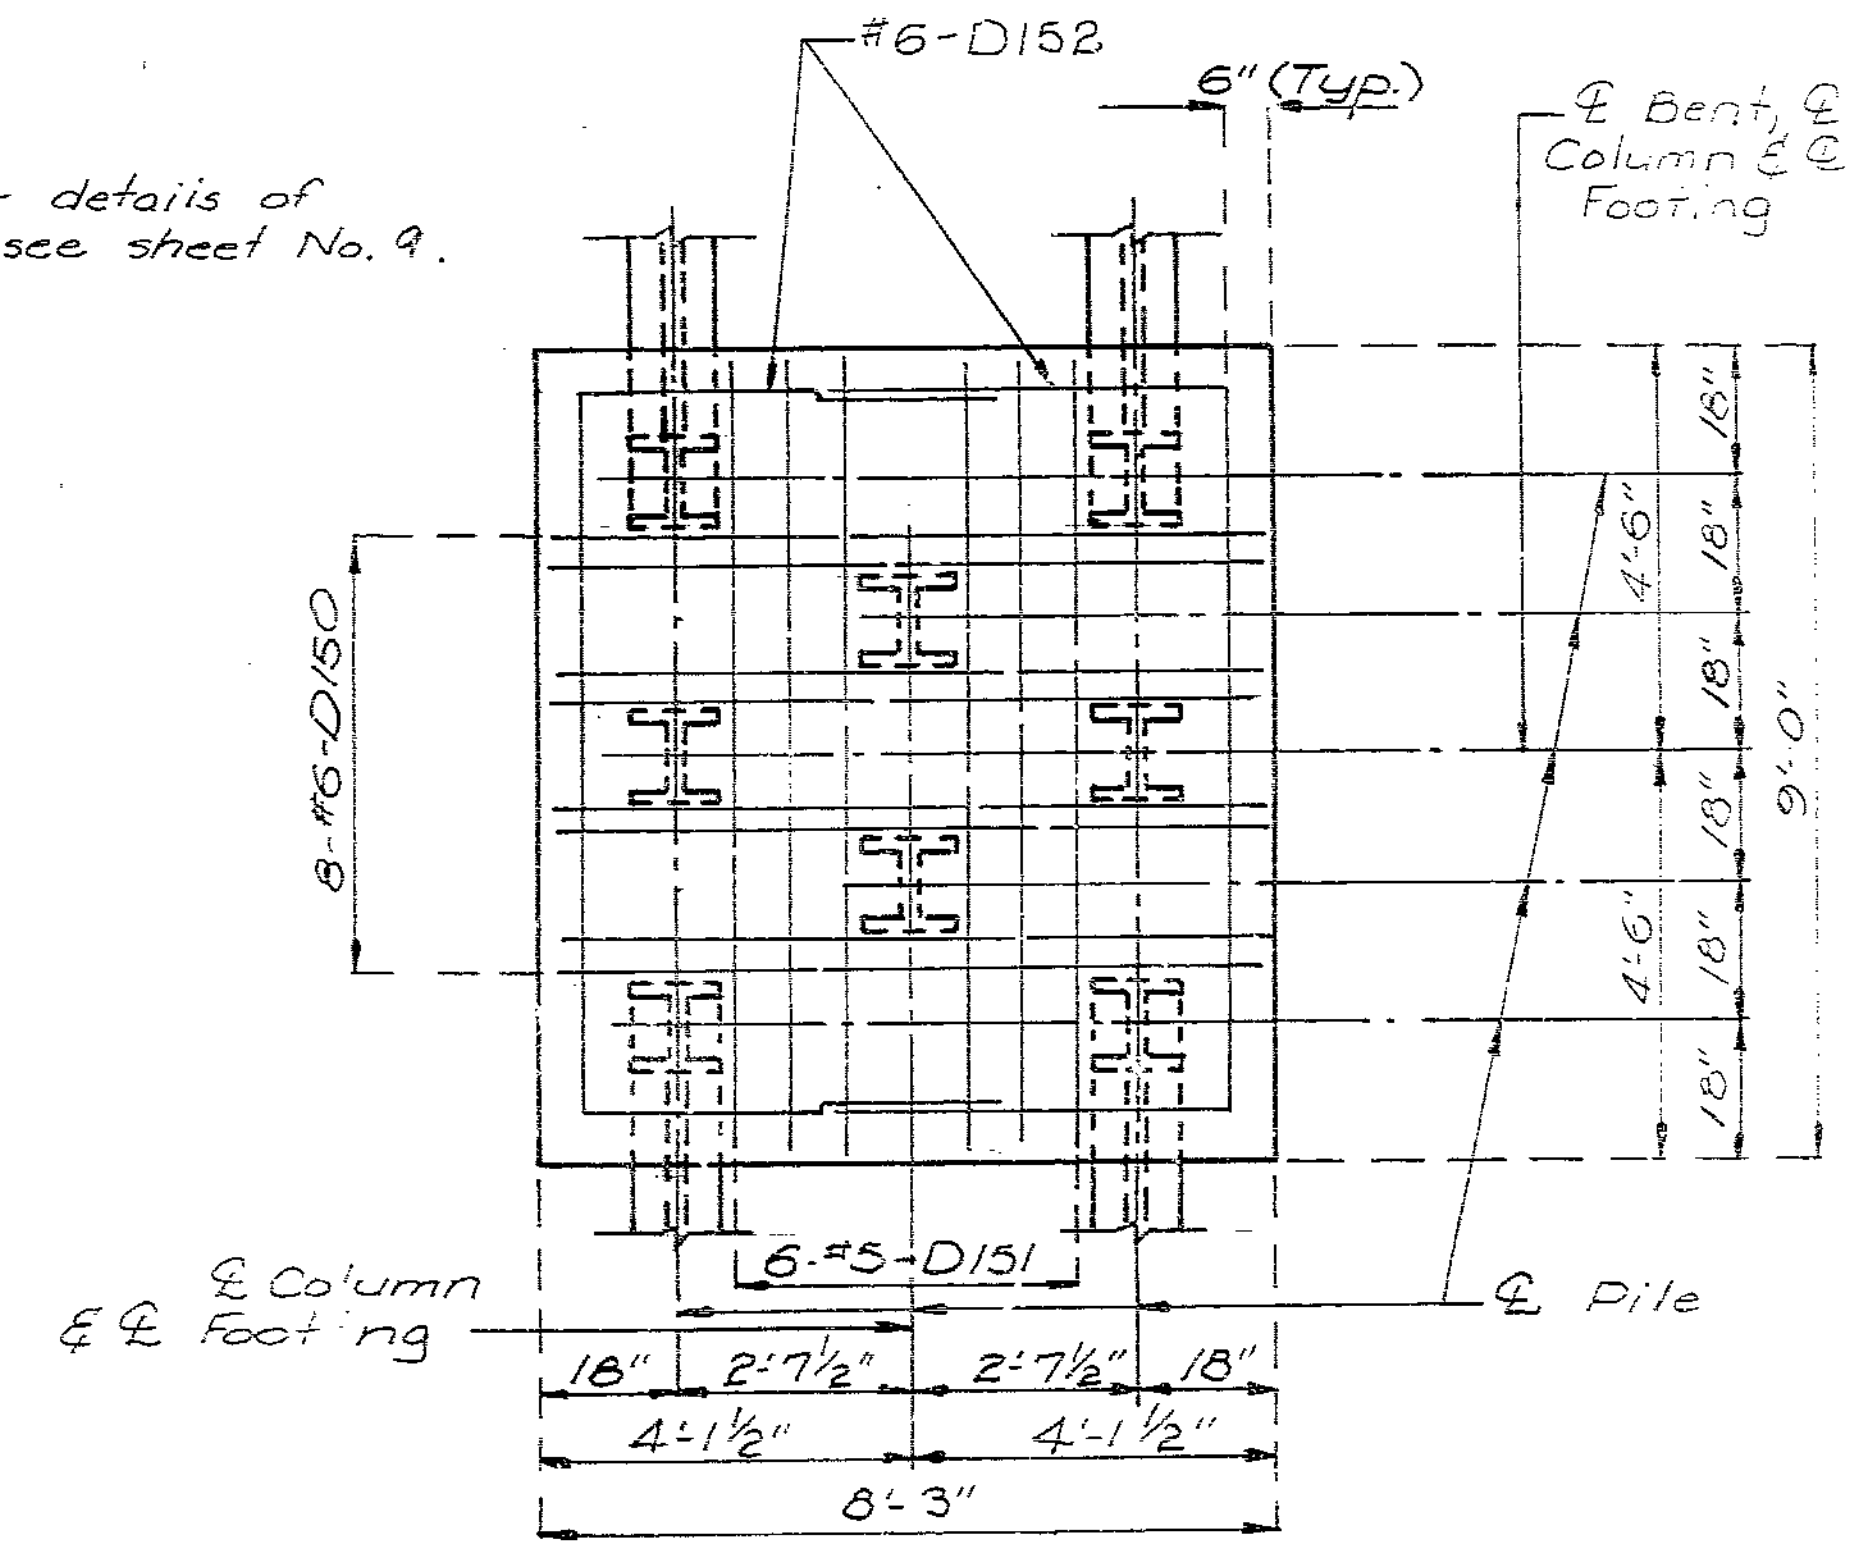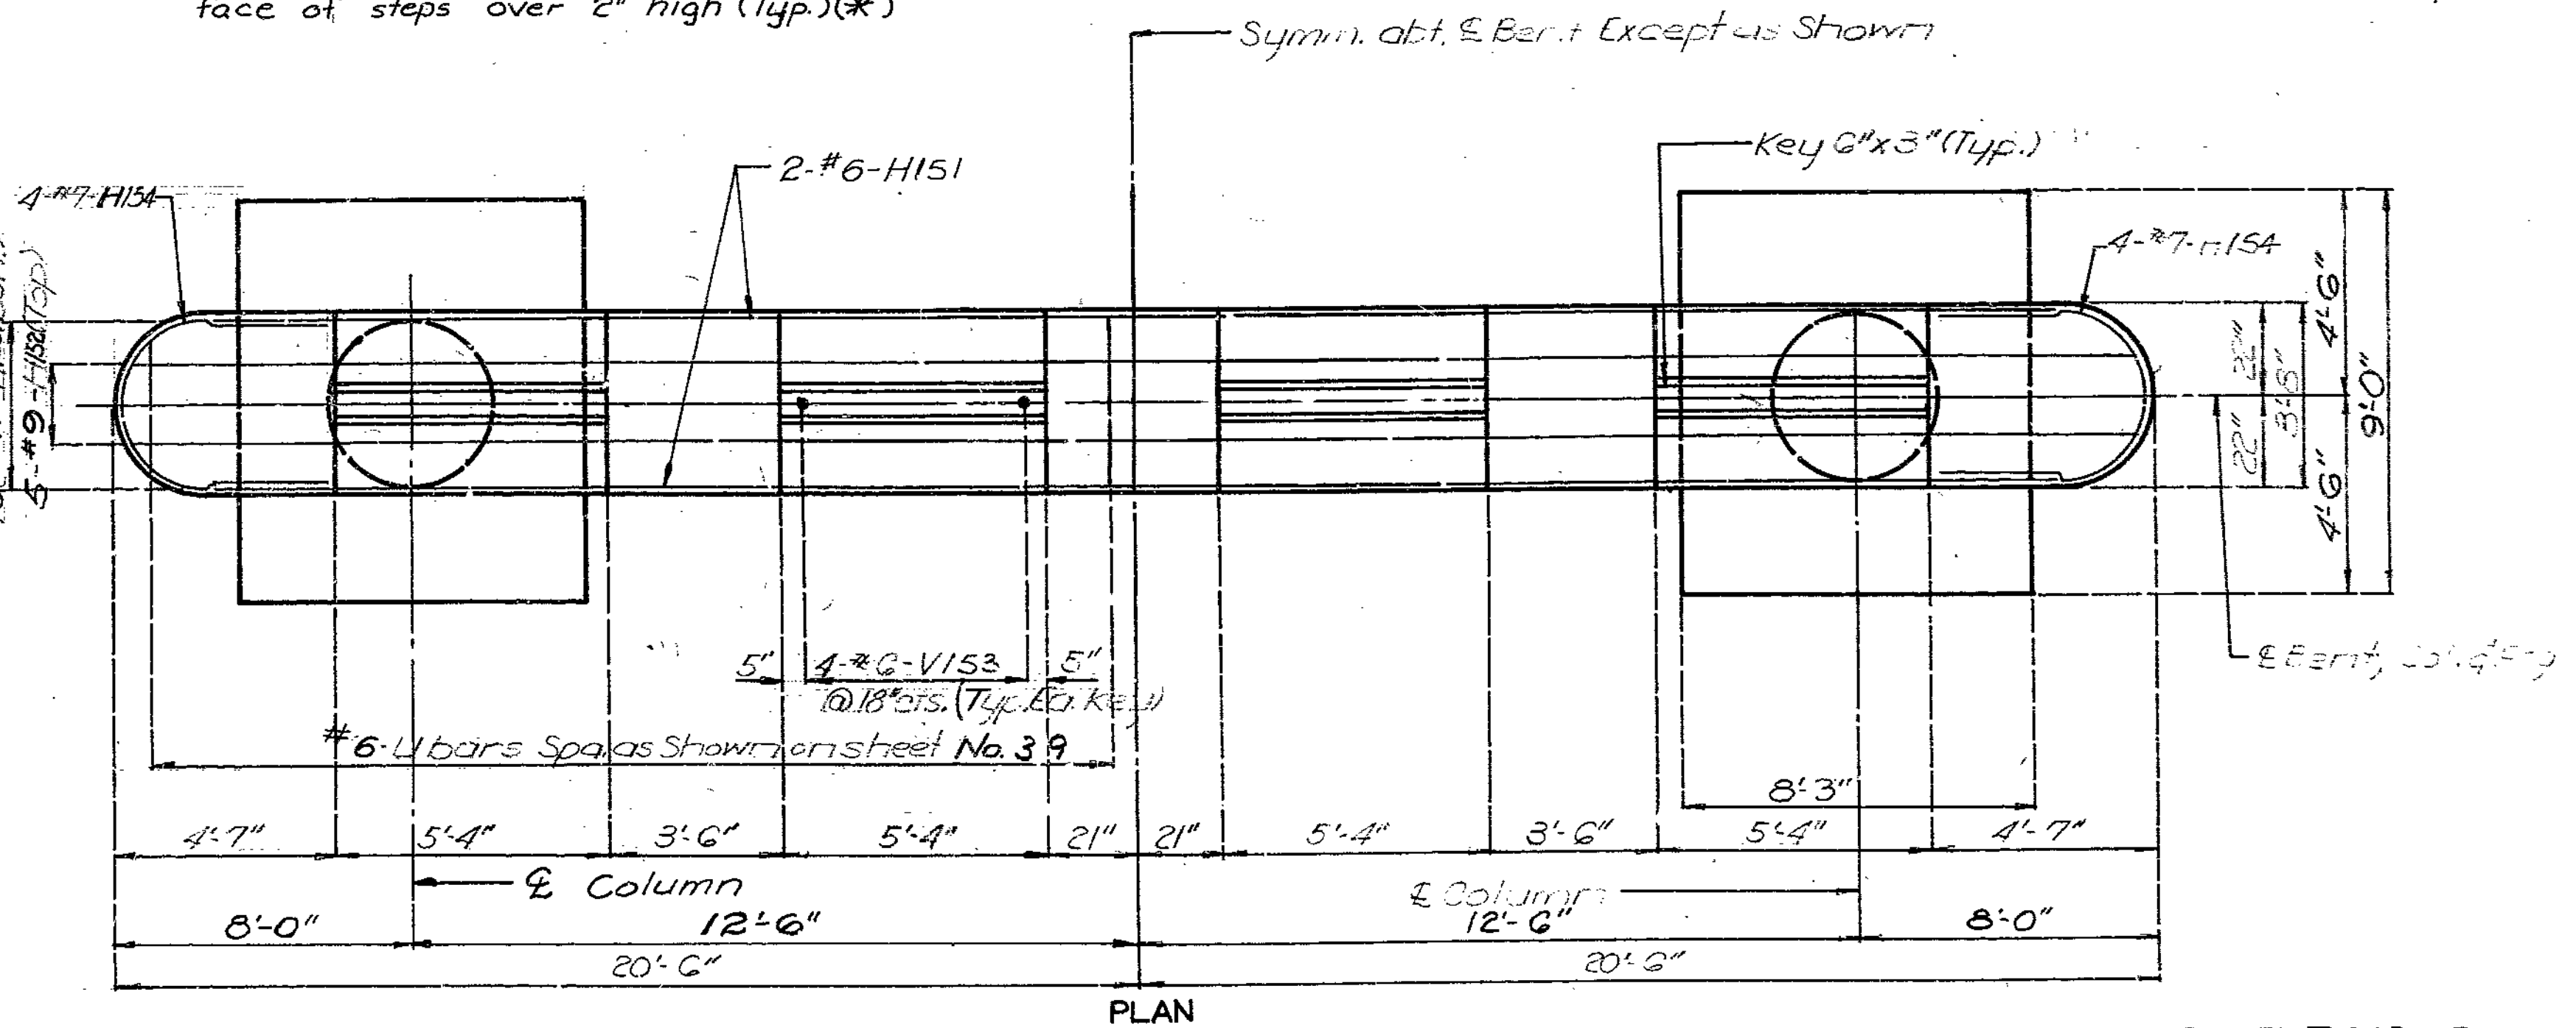


DETAILED MAY 1988  
CHECKED Aug. 1988

Note: This drawing is not to scale. Follow dimensions.

Sheet No. 38 of 55


STATE	PROJ. NO.	SHEET NO.
NO.		34

Note: For Details of Connections See 85

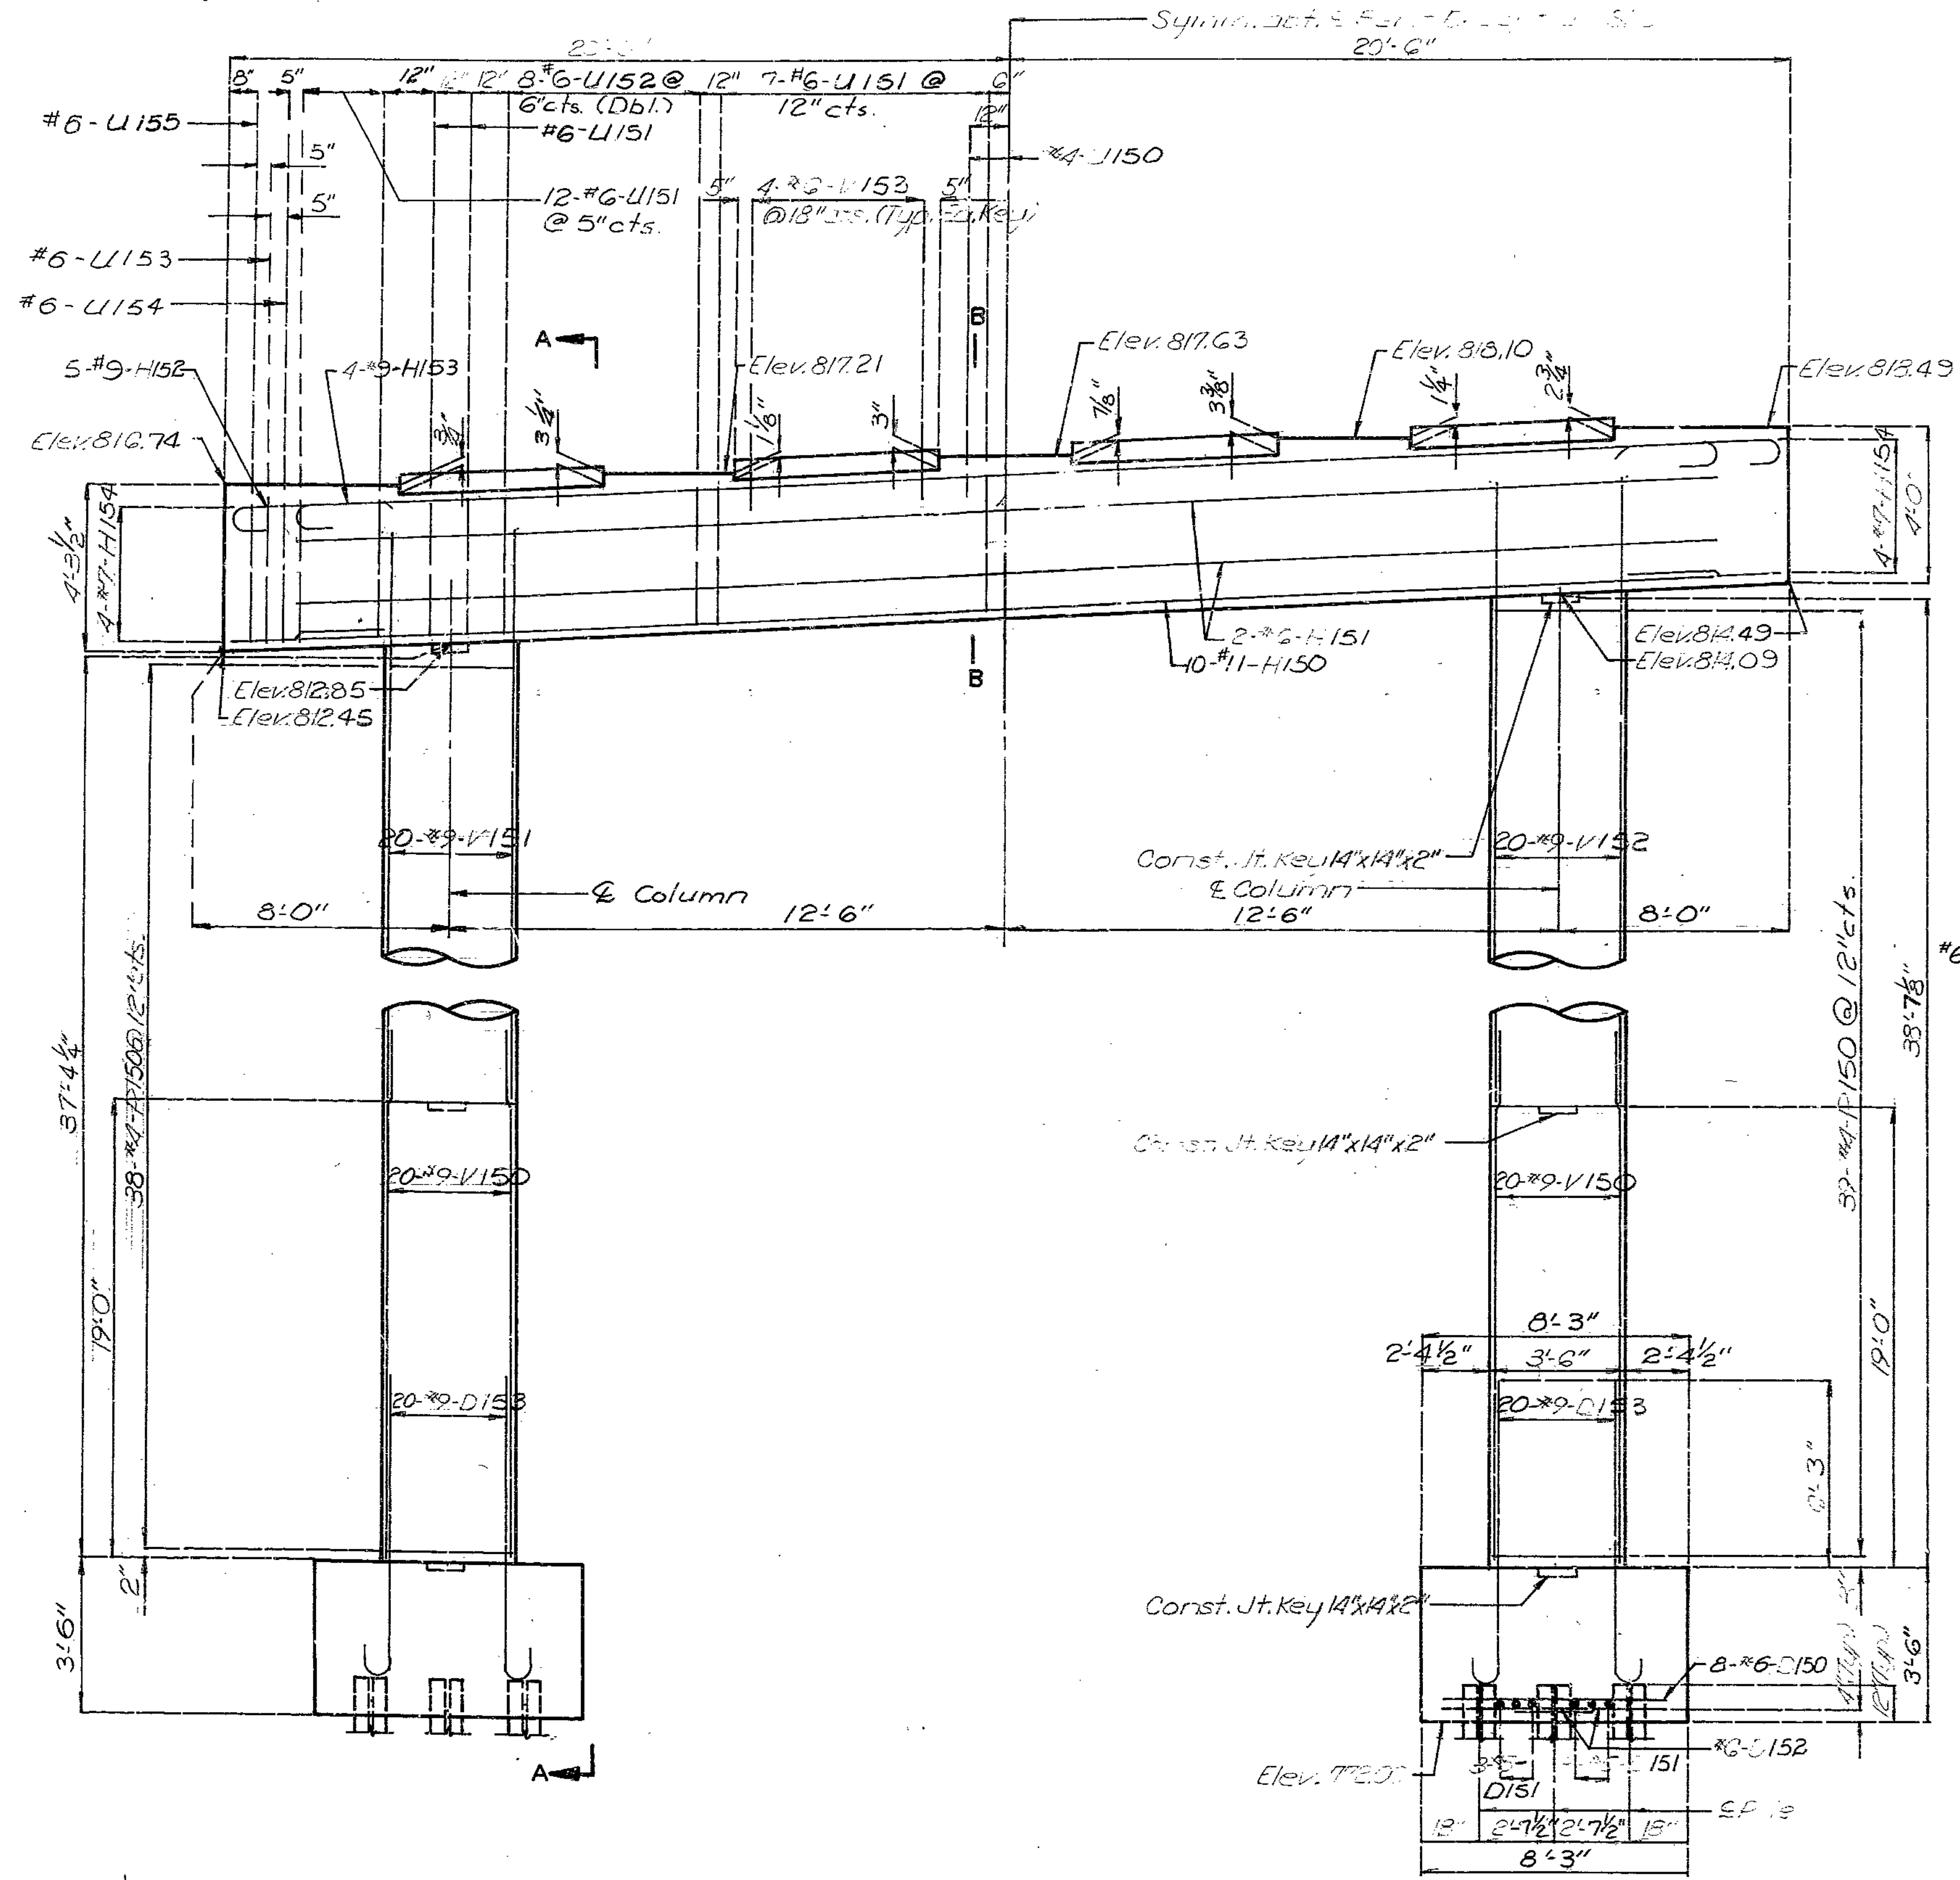

ELEVATION

DETAILS OF INTERMEDIATE BENT NO. 15

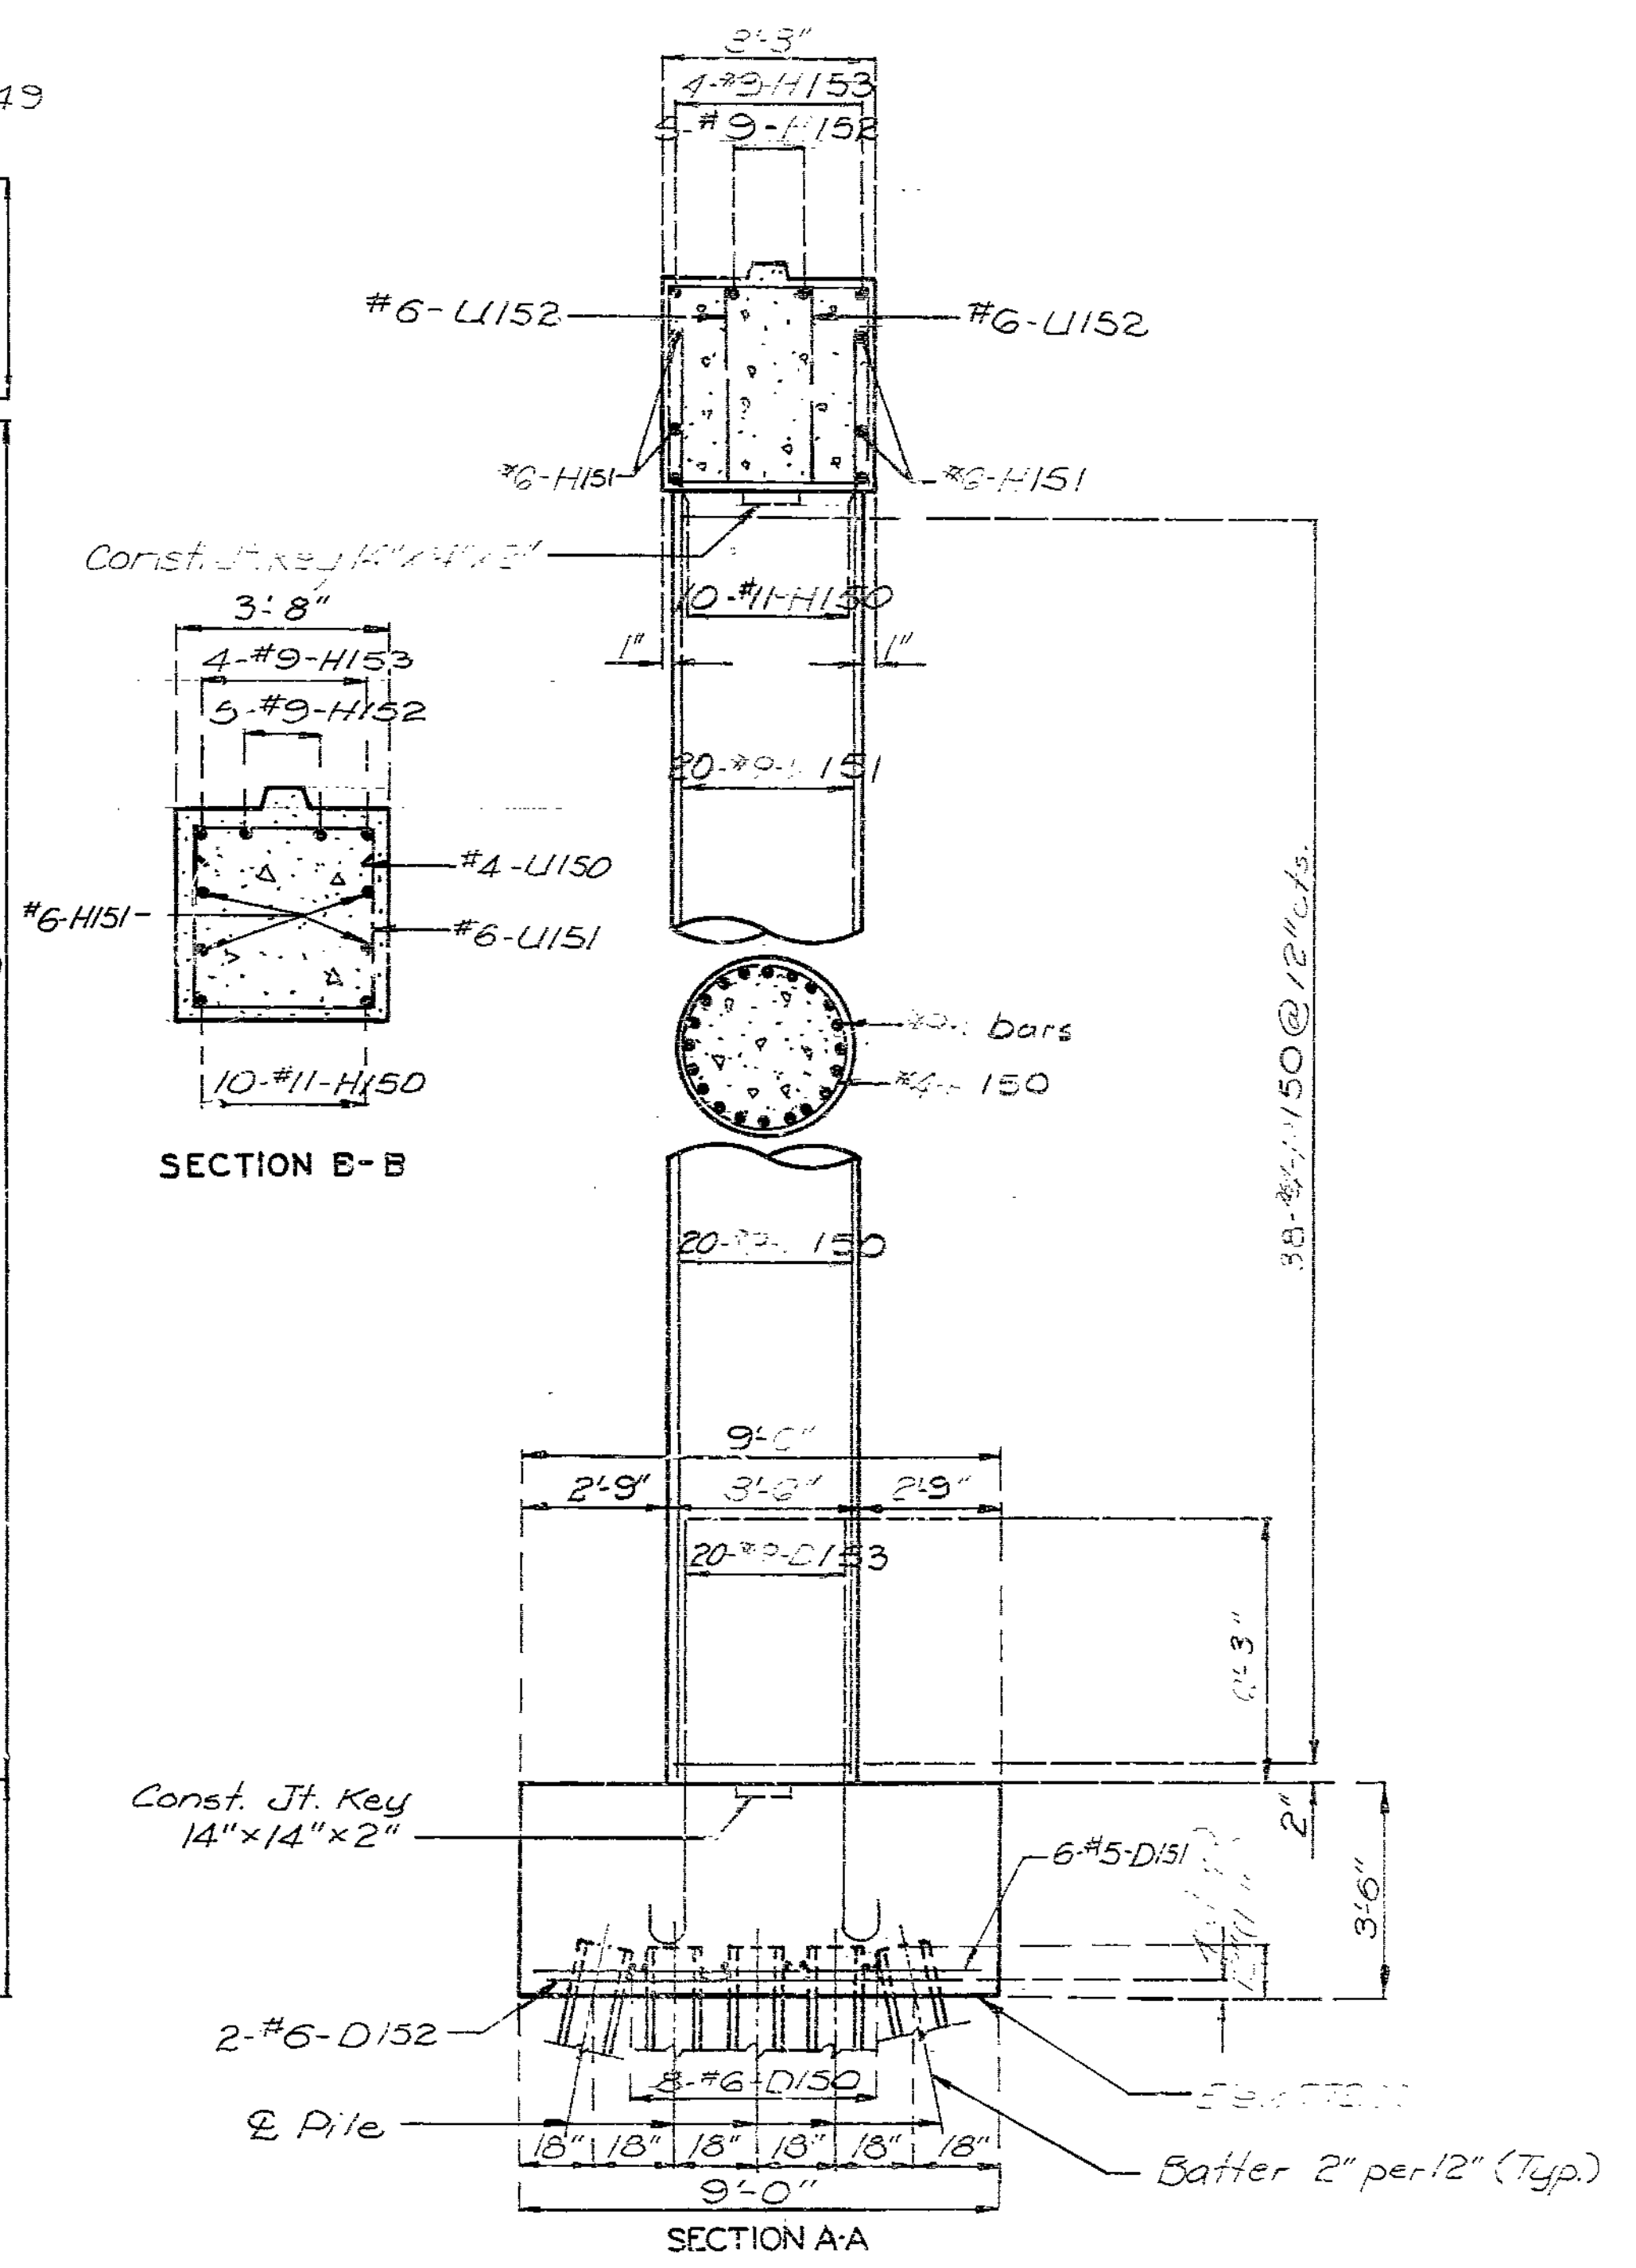

SECTION E-B

SECTION A-A

235 349

DETAILED MAY 1988  
CHECKED Aug. 1988

Note: This drawing is not to scale. Follow dimensions.




Sheet No. 39 of 55

JACKSON COUNTY

A-2745

STATE	PROJ. NO.	SHEET NO.
MO.		95


Note: For details of intermediate bent, see sheet No. 40.  
For detail of pile splice see sheet No. 9

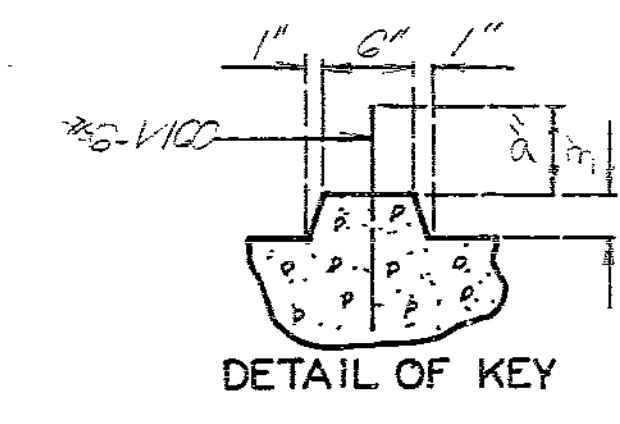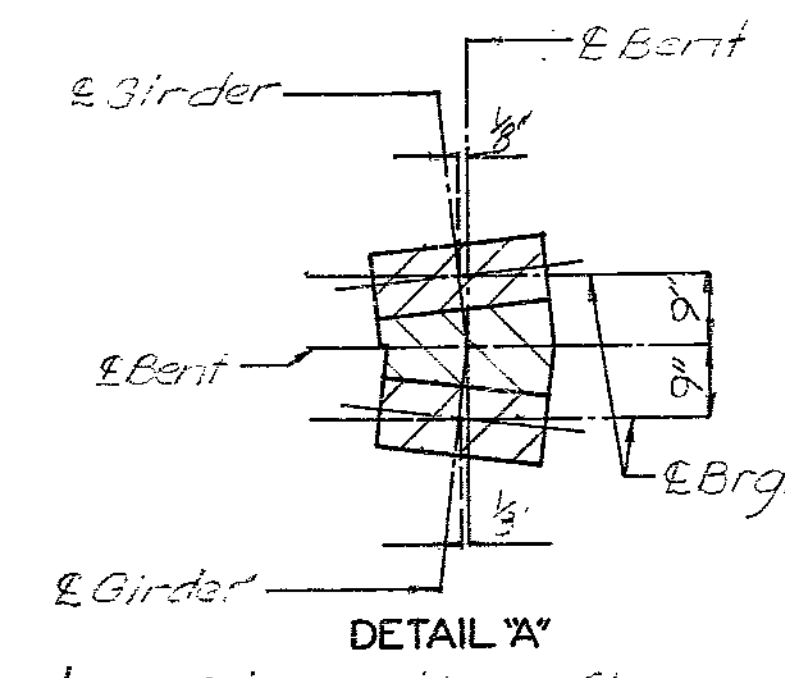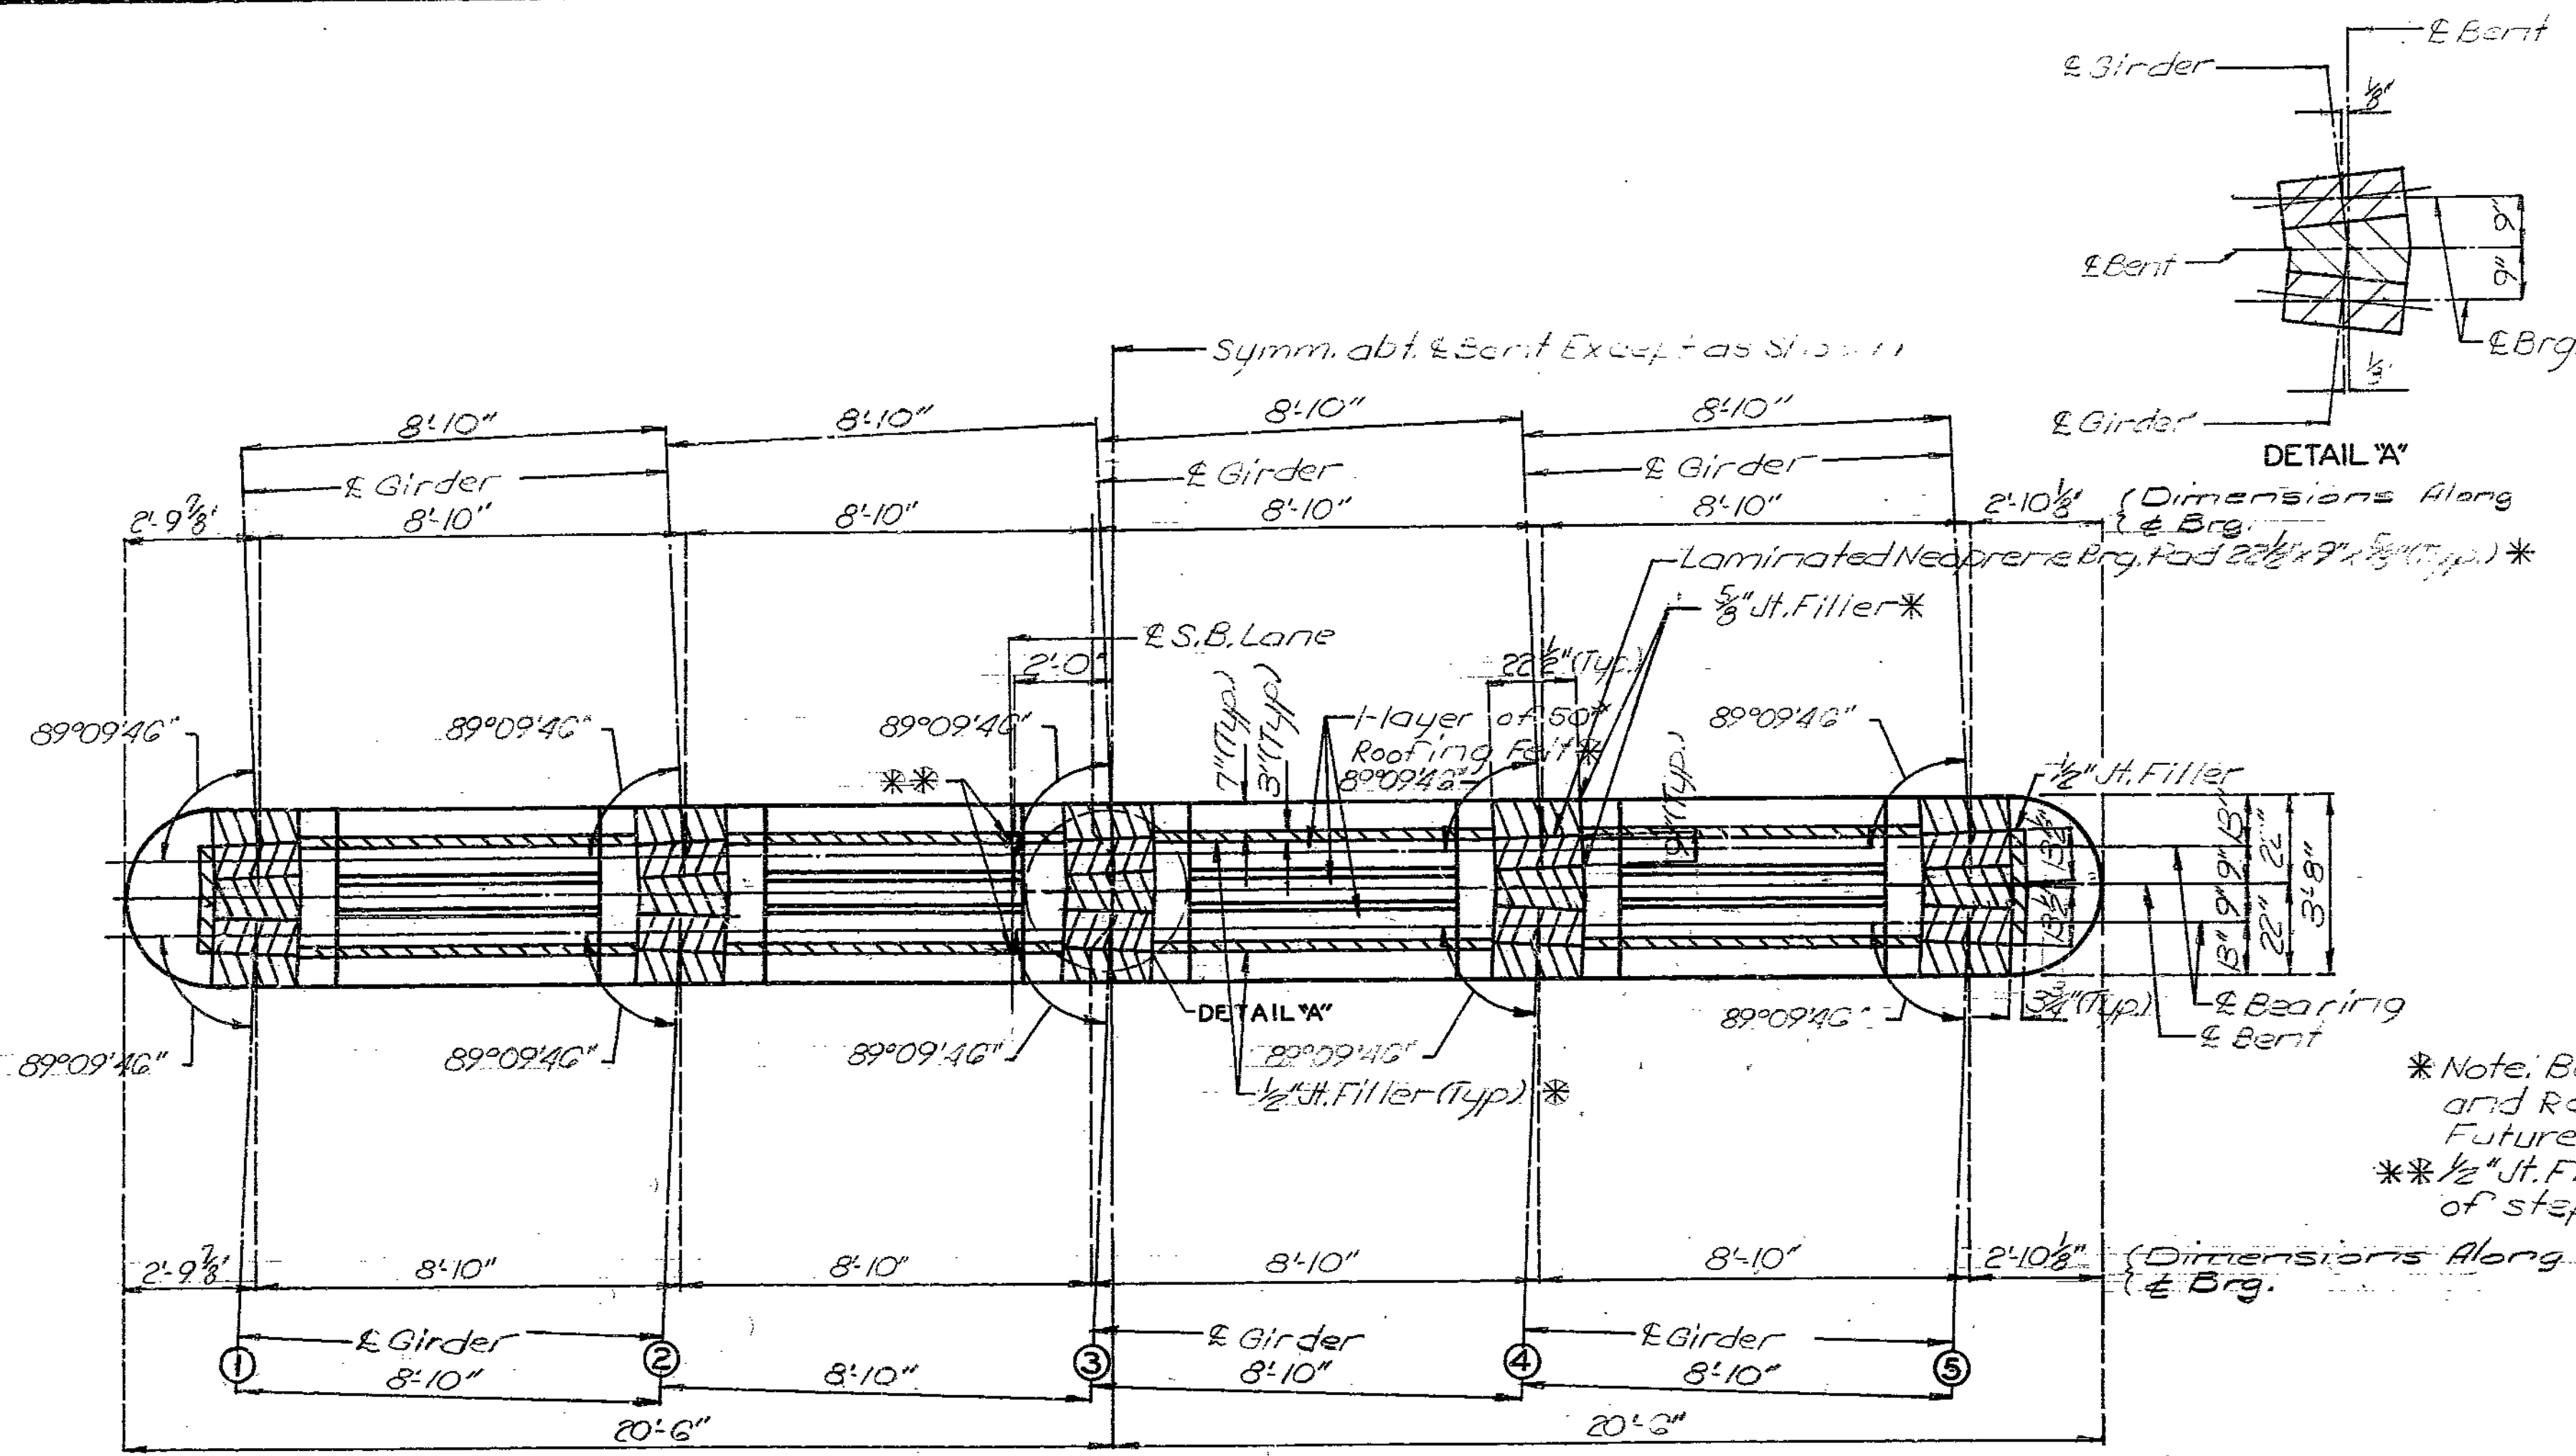

\* Note: Bearing Pads, Jt. Filler and Roofing Felt are in Future Const.  
\*\* 1/2" Jt. Filler on vertical face of steps over 2" high (Typ.) \*


PLAN SHOWING BEARINGS

836 350

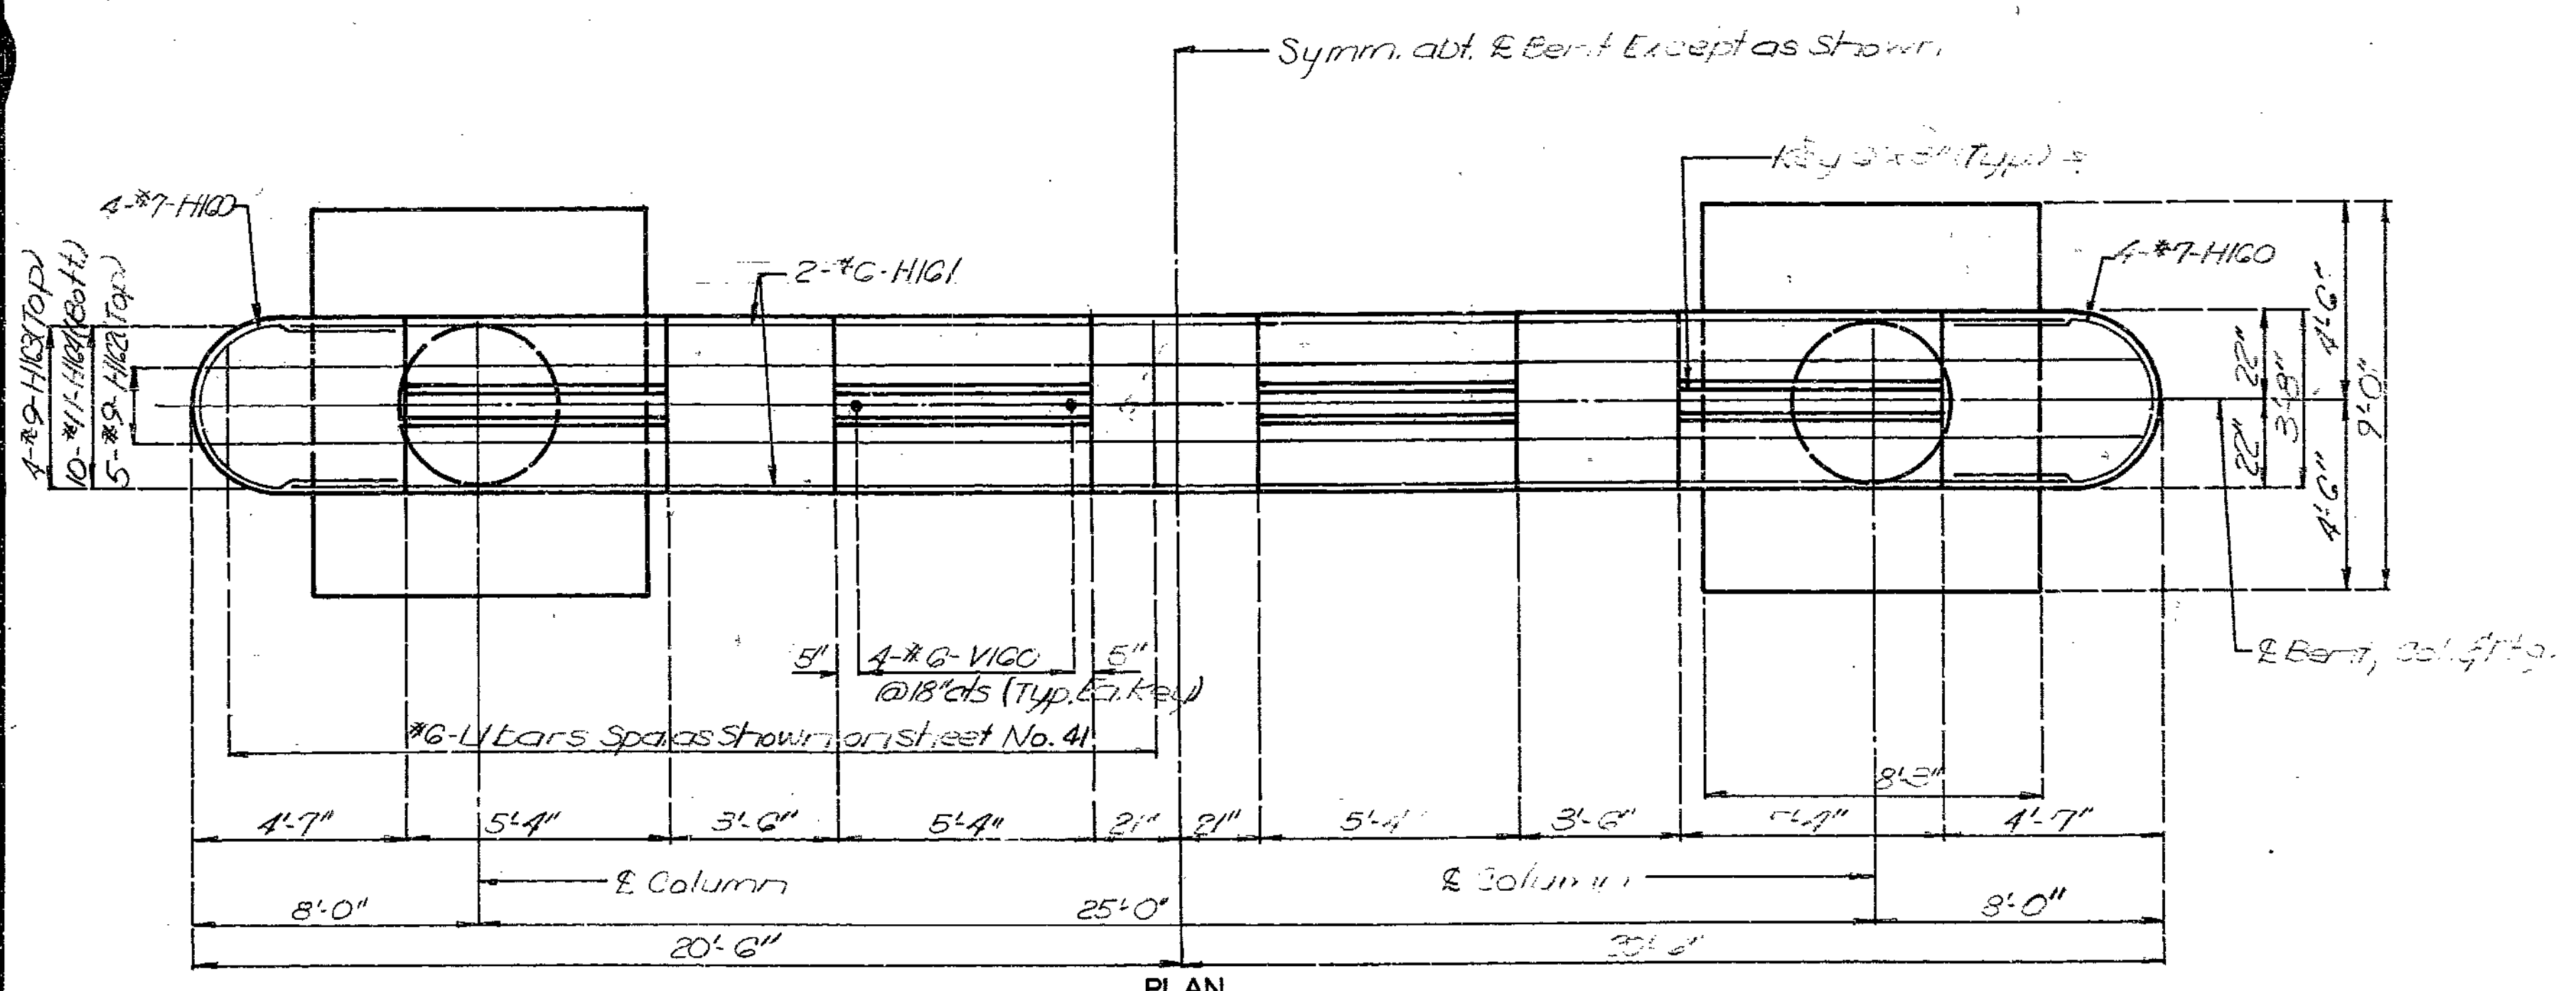

PLAN

DETAILS OF INTERMEDIATE BENT NO. 16

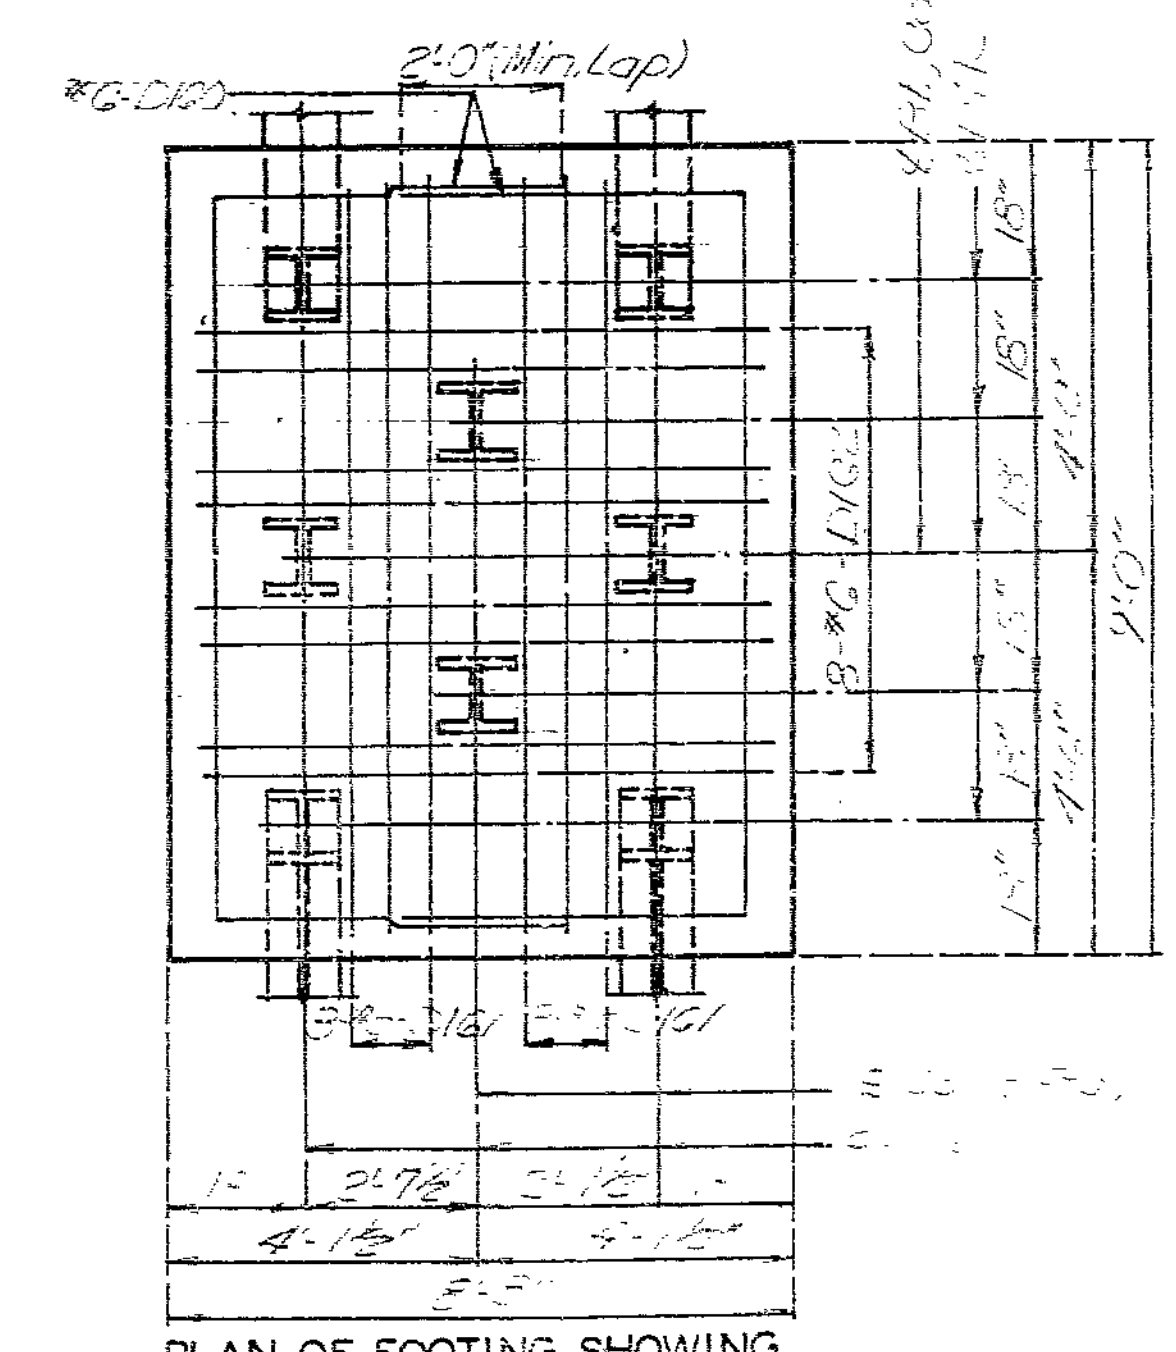

PLAN OF FOOTING SHOWING REINFORCEMENT

DETAILED AUG 19 88  
CHECKED AUG 19 88

Note: This drawing is not to scale. Follow dimensions.

Sheet No. 40 of 55


JACKSON COUNTY

A-2745




STATE	PROJ. NO.	SHEET NO.
MO.		96

Note: For details of column section, No. 16 refer to sheet No. 40.

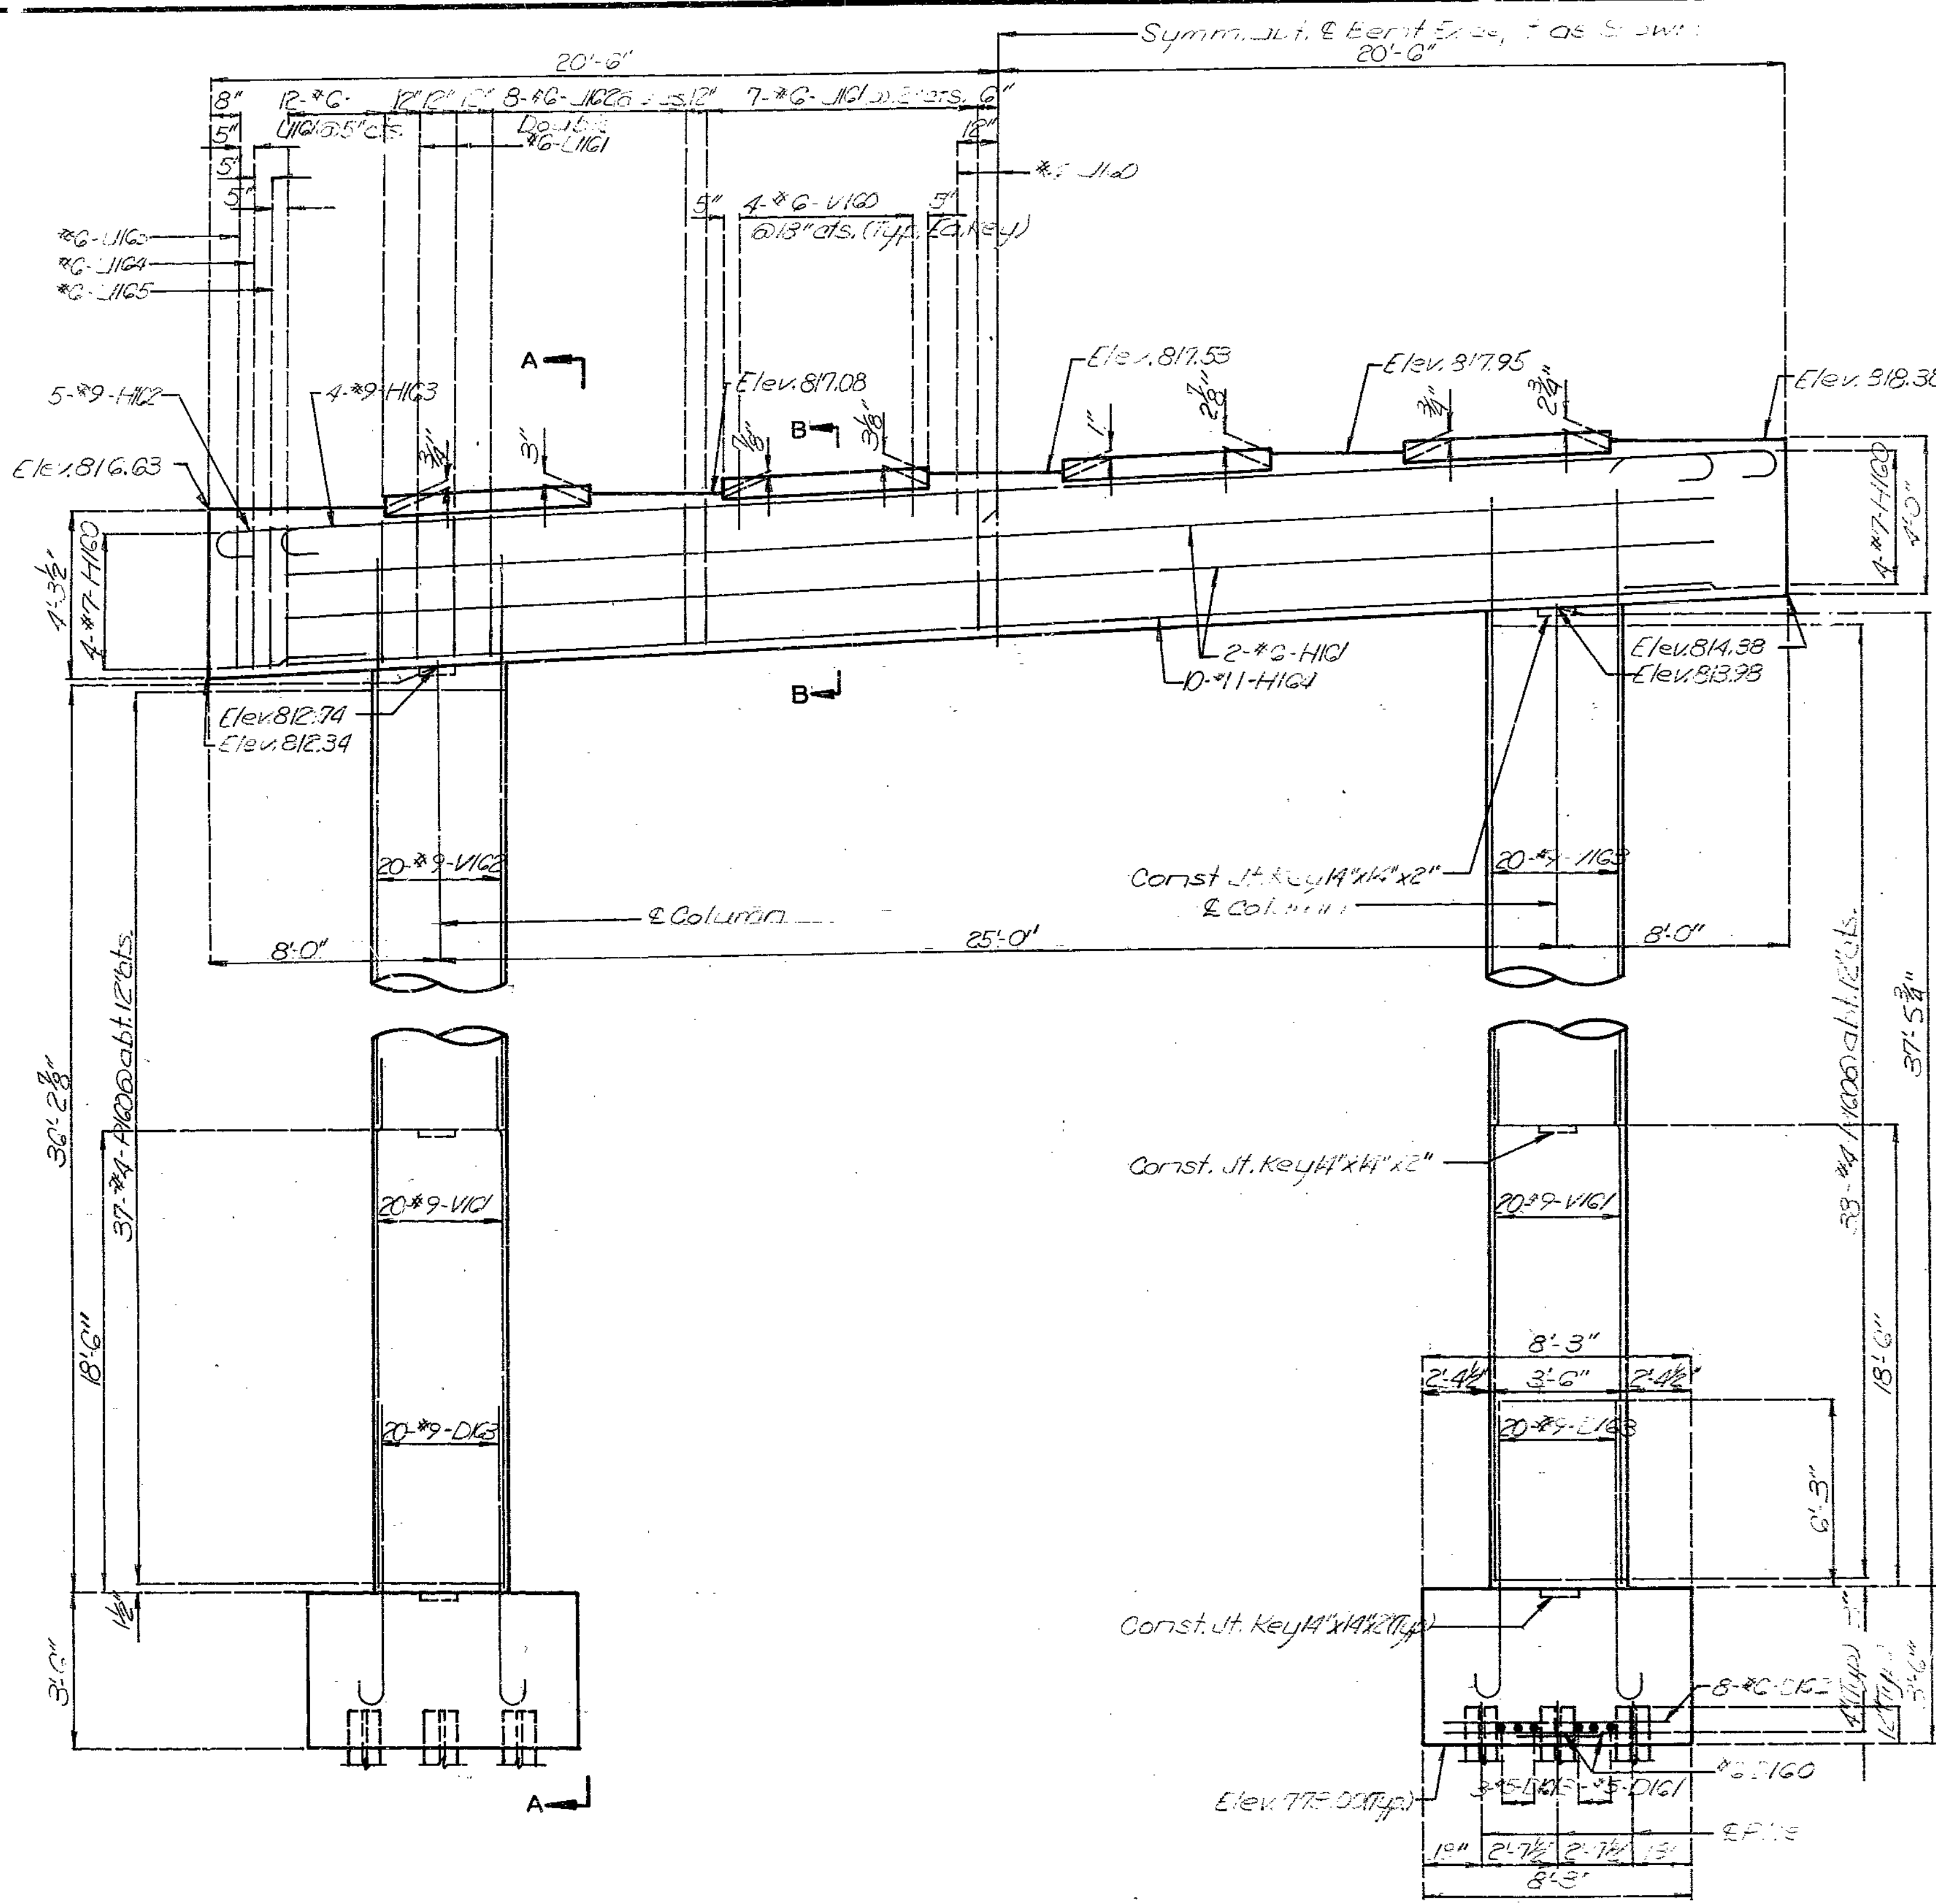

ELEVATION

DETAILS OF INTERMEDIATE BENT NO. 16

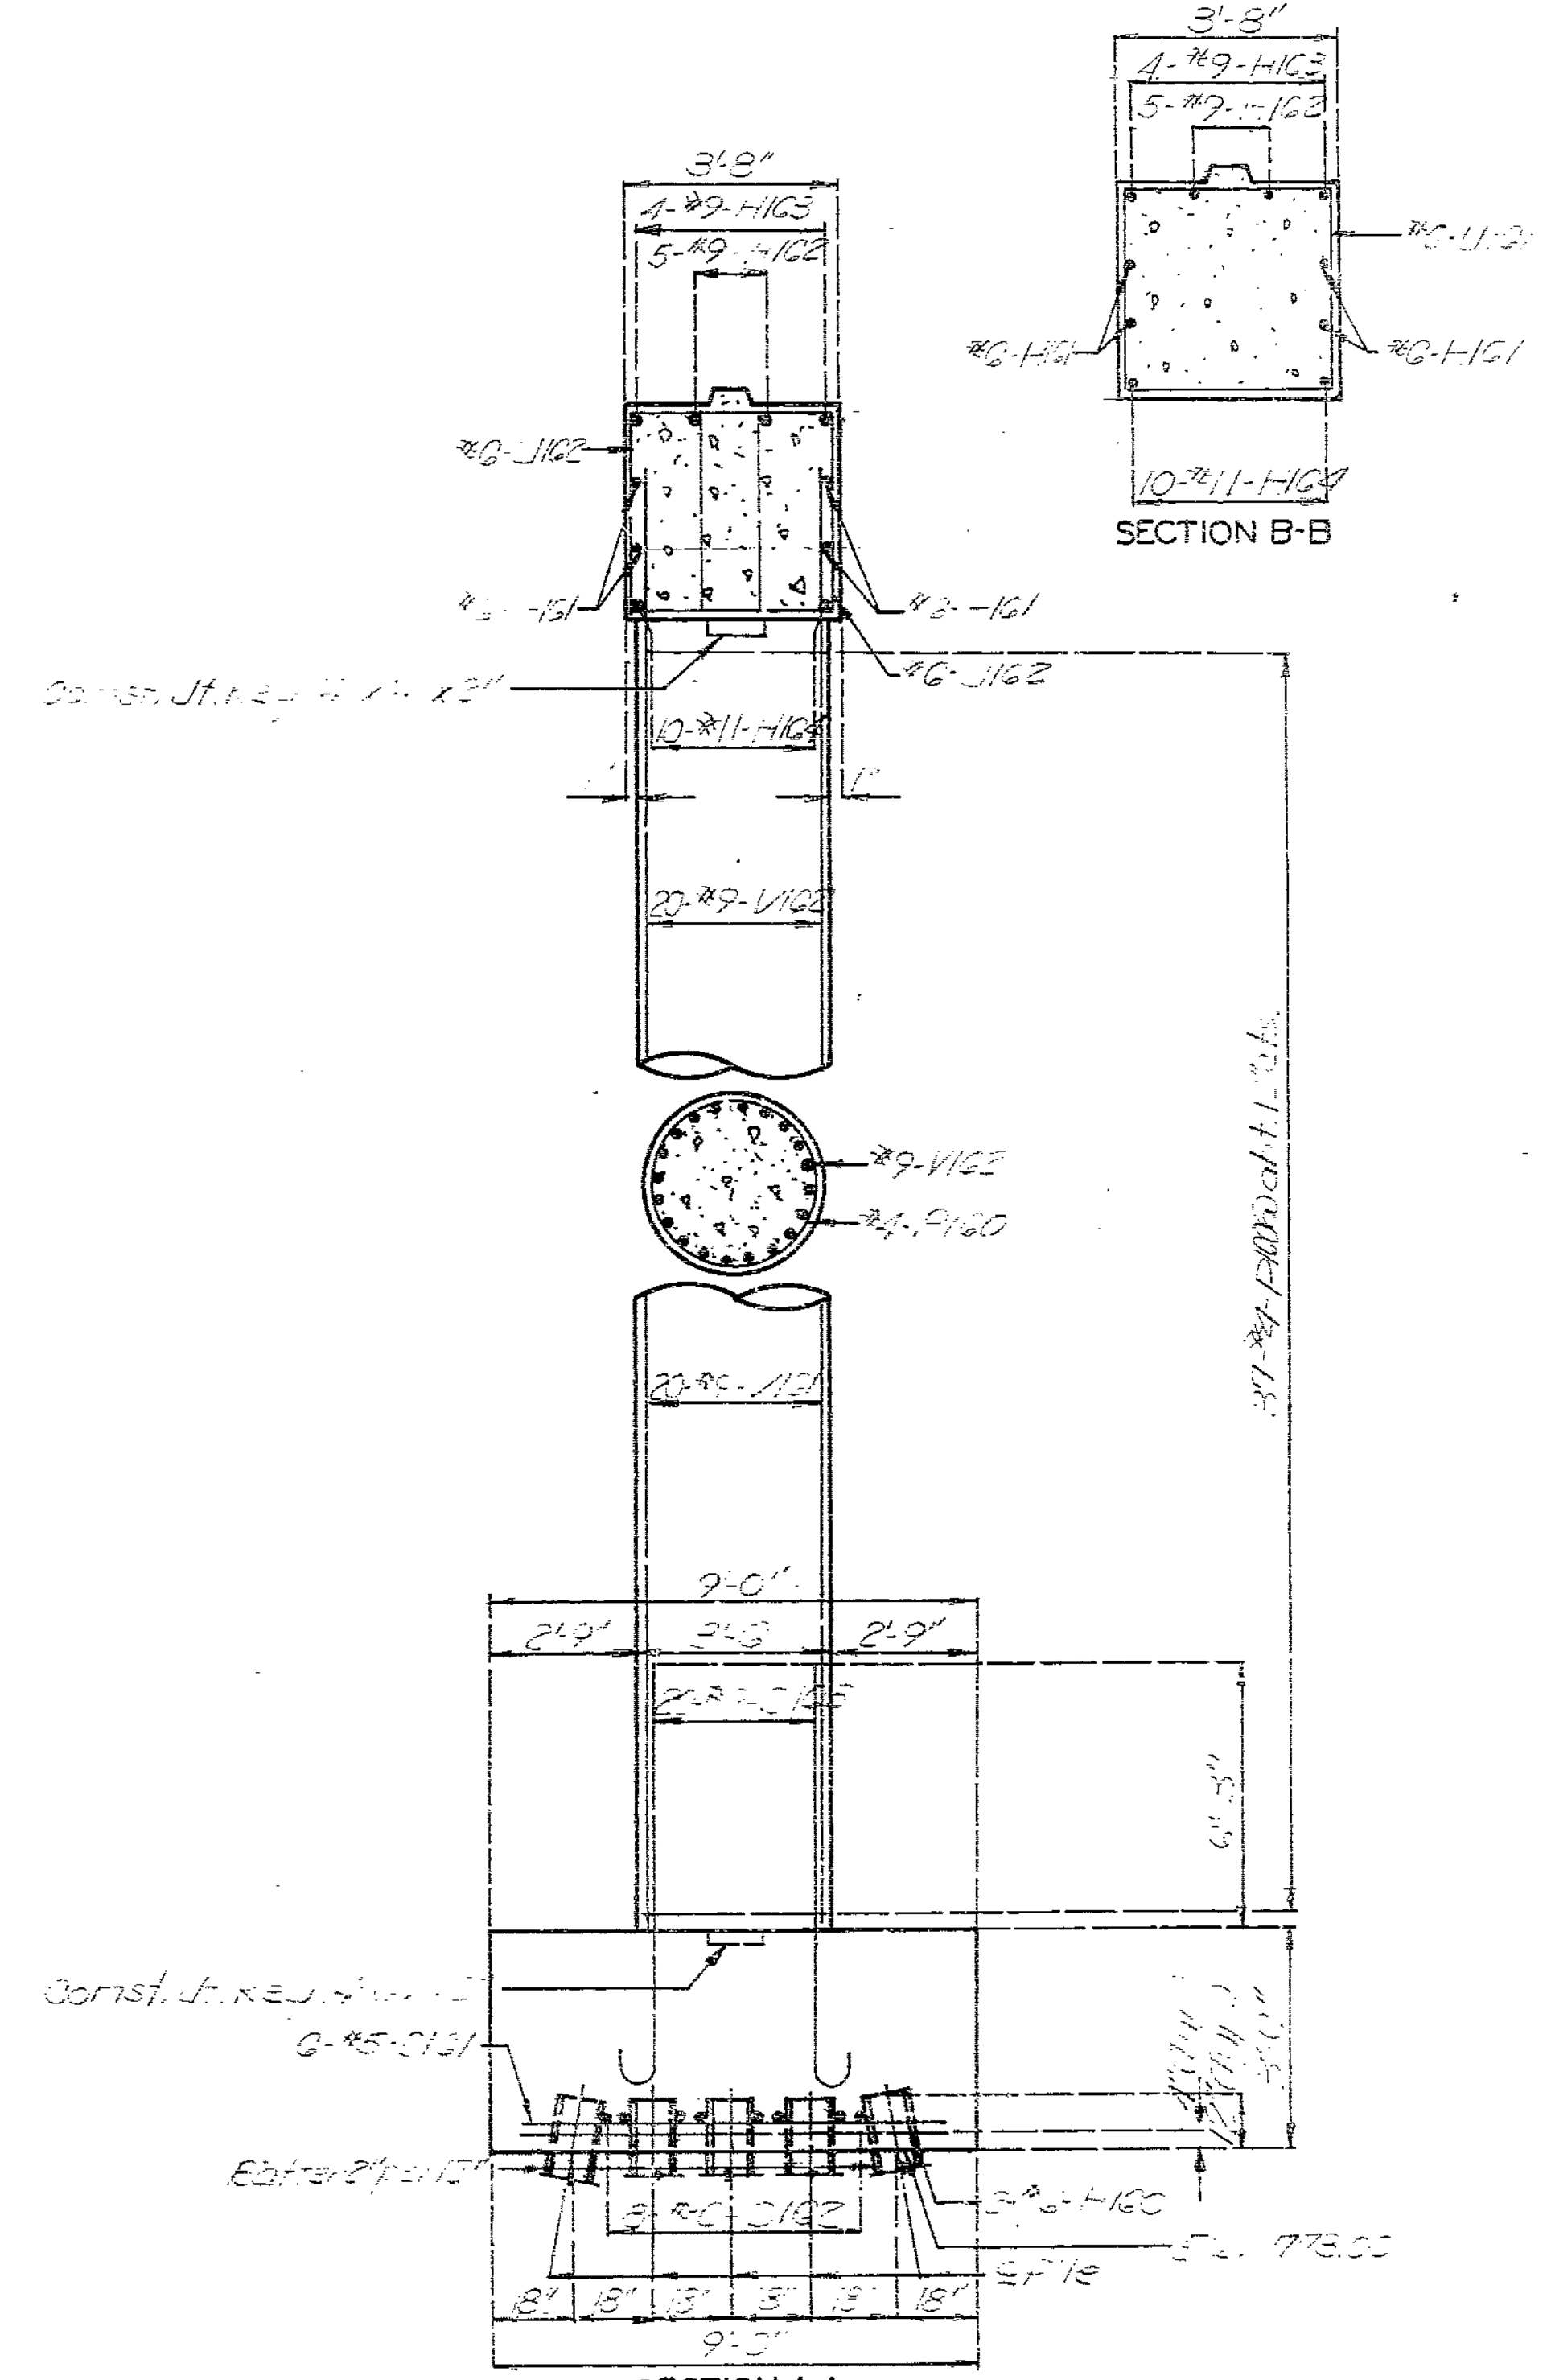

SECTION A-A

SECTION B-B

237 351

DETAILED MAY 1988  
 CHECKED AUG 19 88


Note: This drawing is not to scale. Follow dimensions.

Sheet No. 4 of 55

JACKSON COUNTY



A-2745

STATE	PROJ. NO.	SHEET NO.
MO.		57

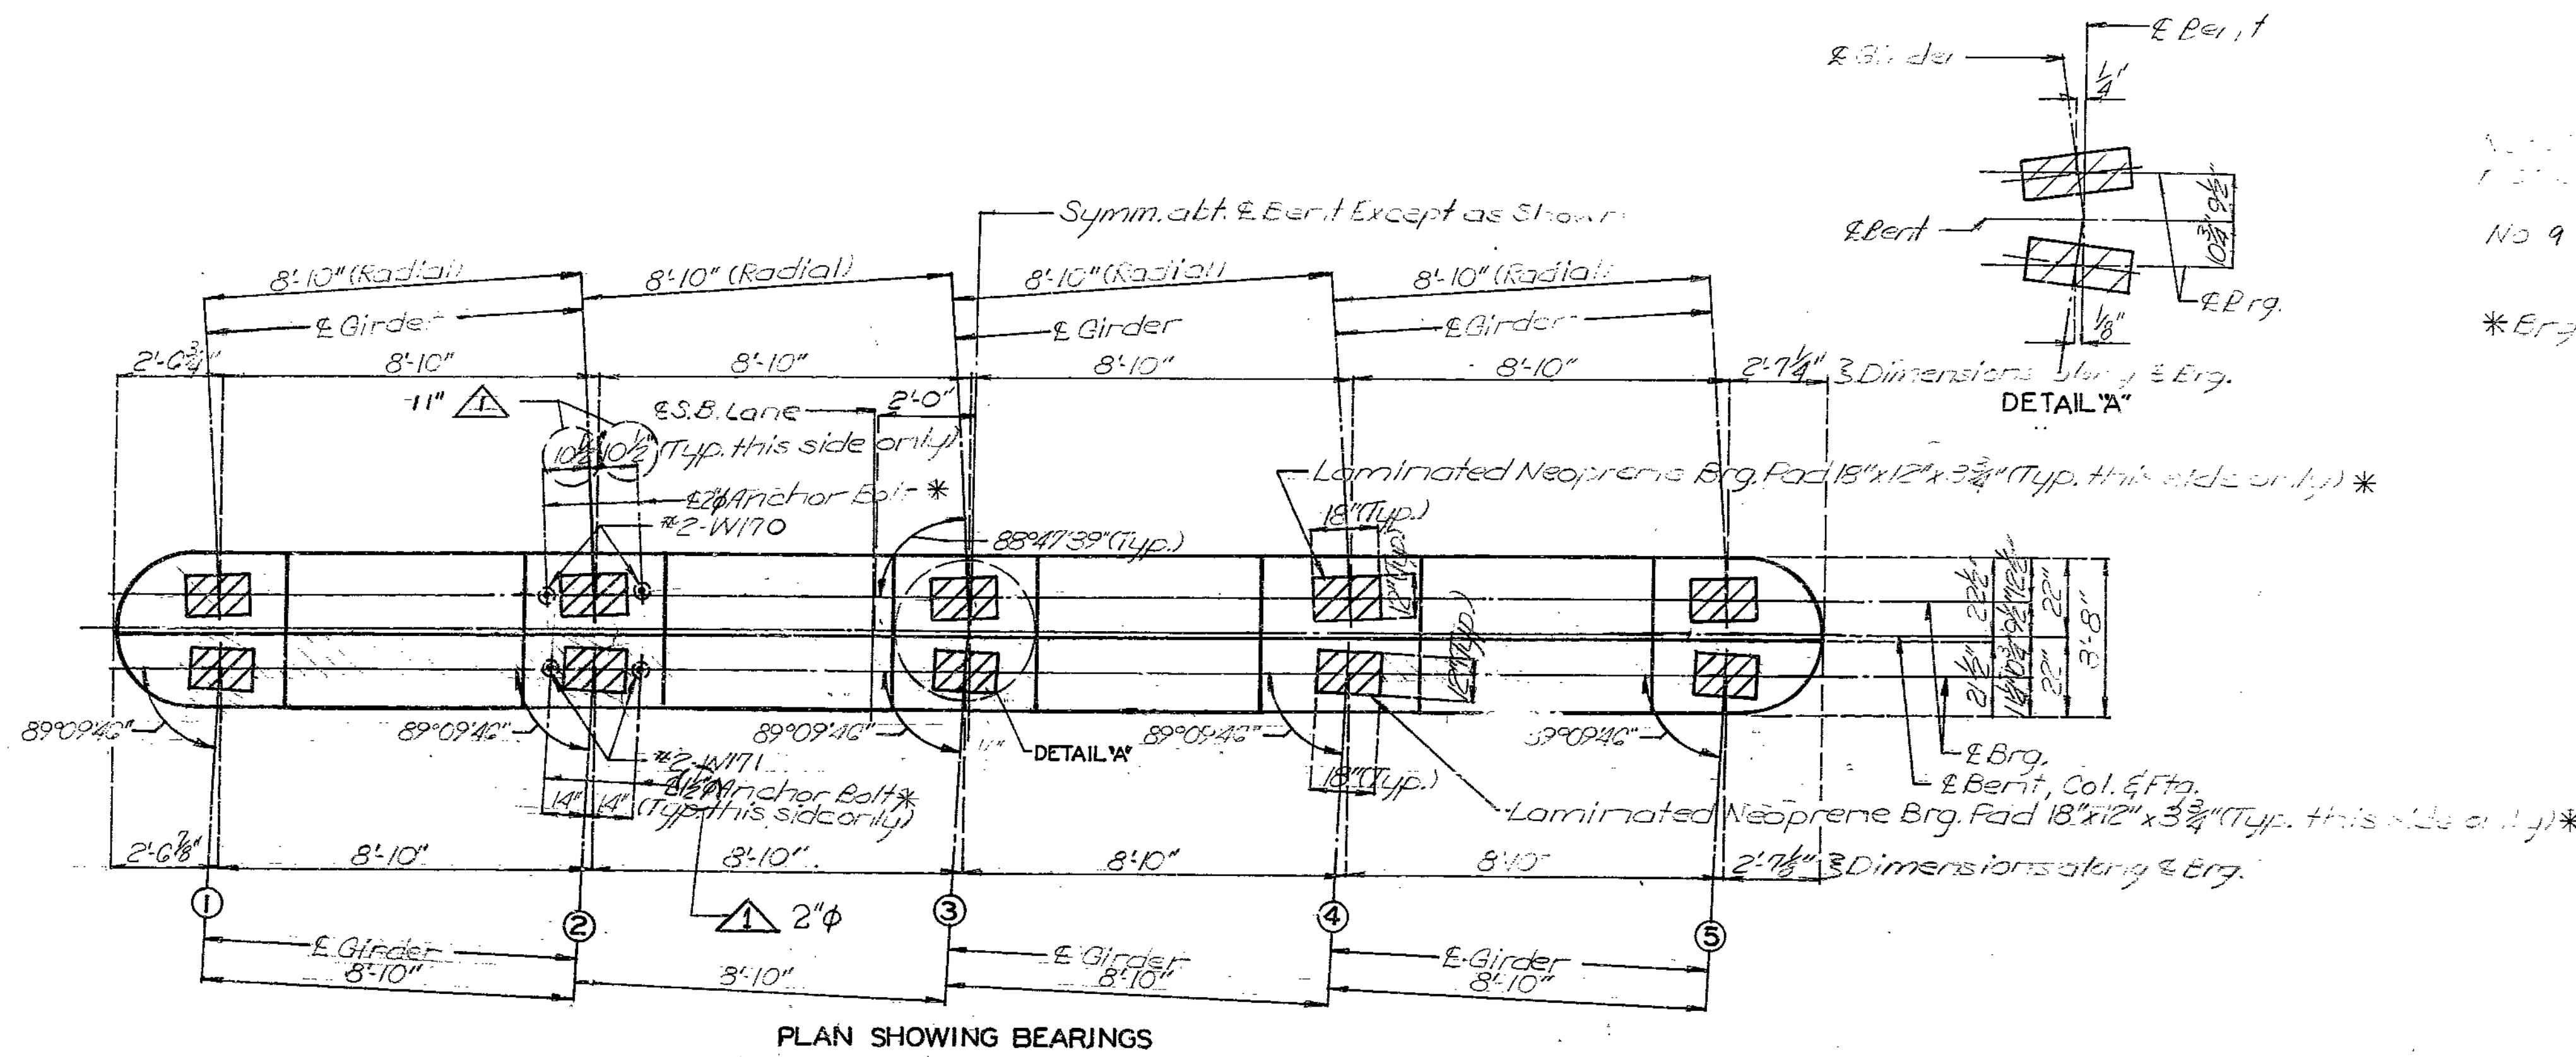

See Detail of Intermediate Bent No. 12 for details see sheet No. 43  
 For Anchor Bolt Spirals Detail No. 9  
 For File Splice detail see sheet No. 9  
 \* Ergs & Anchor Bolts are in future construction.

238 352

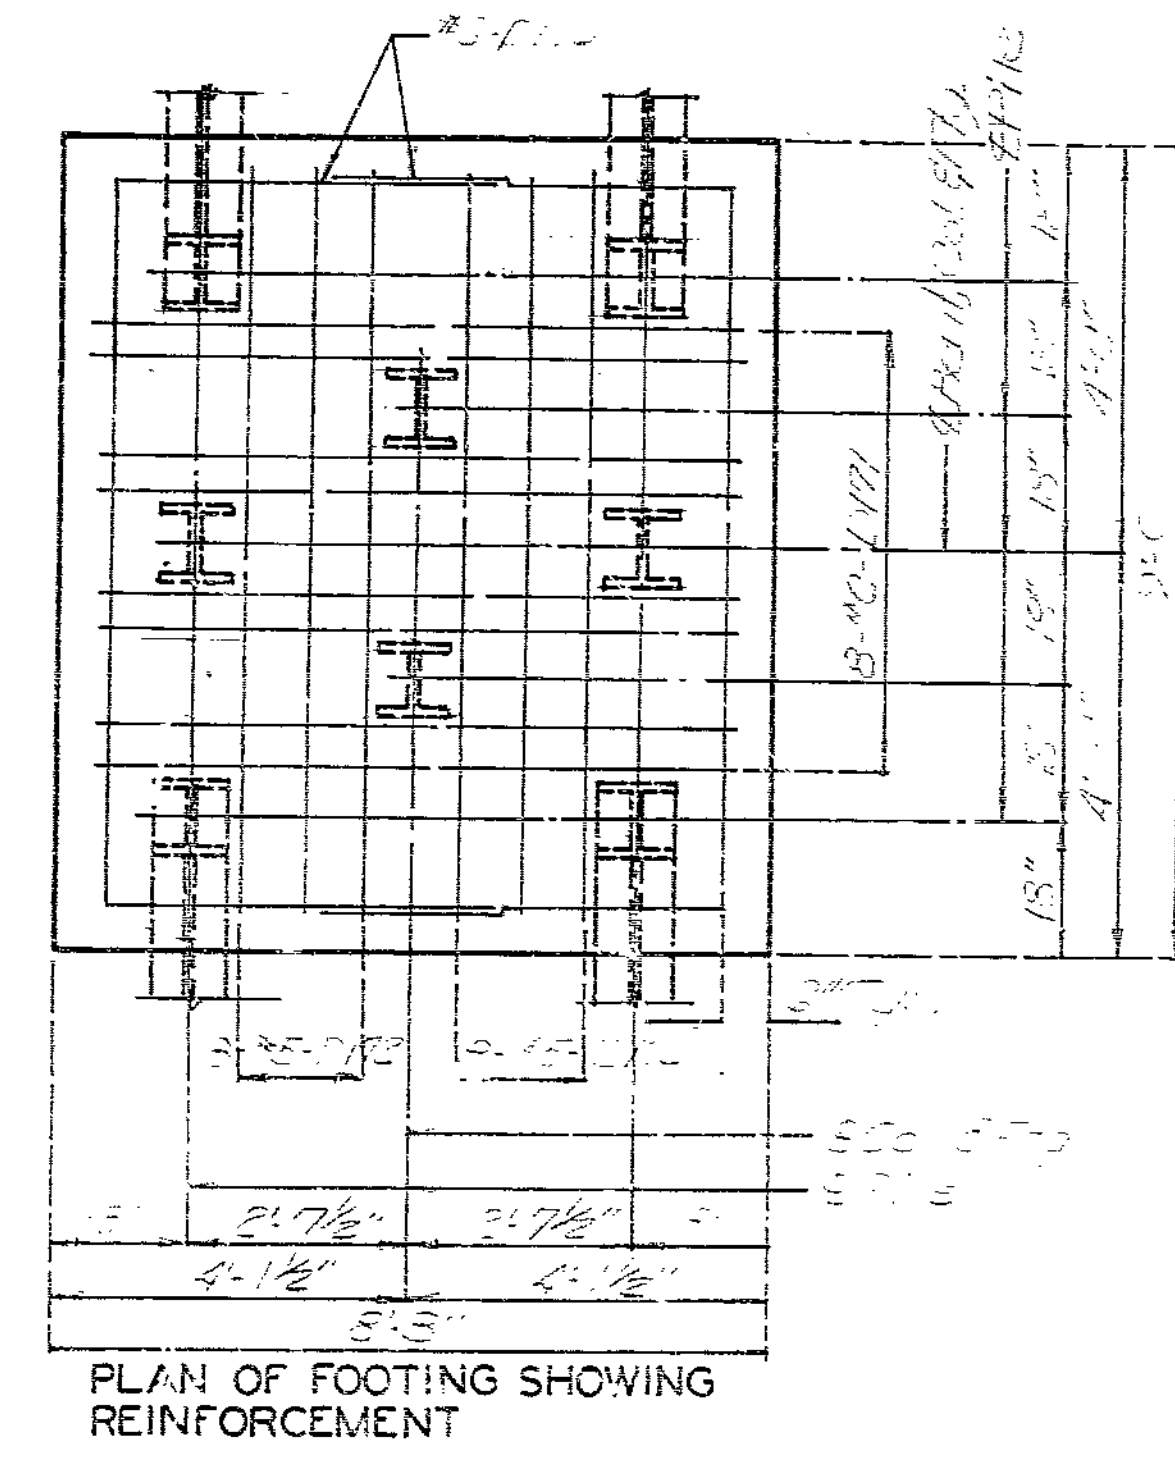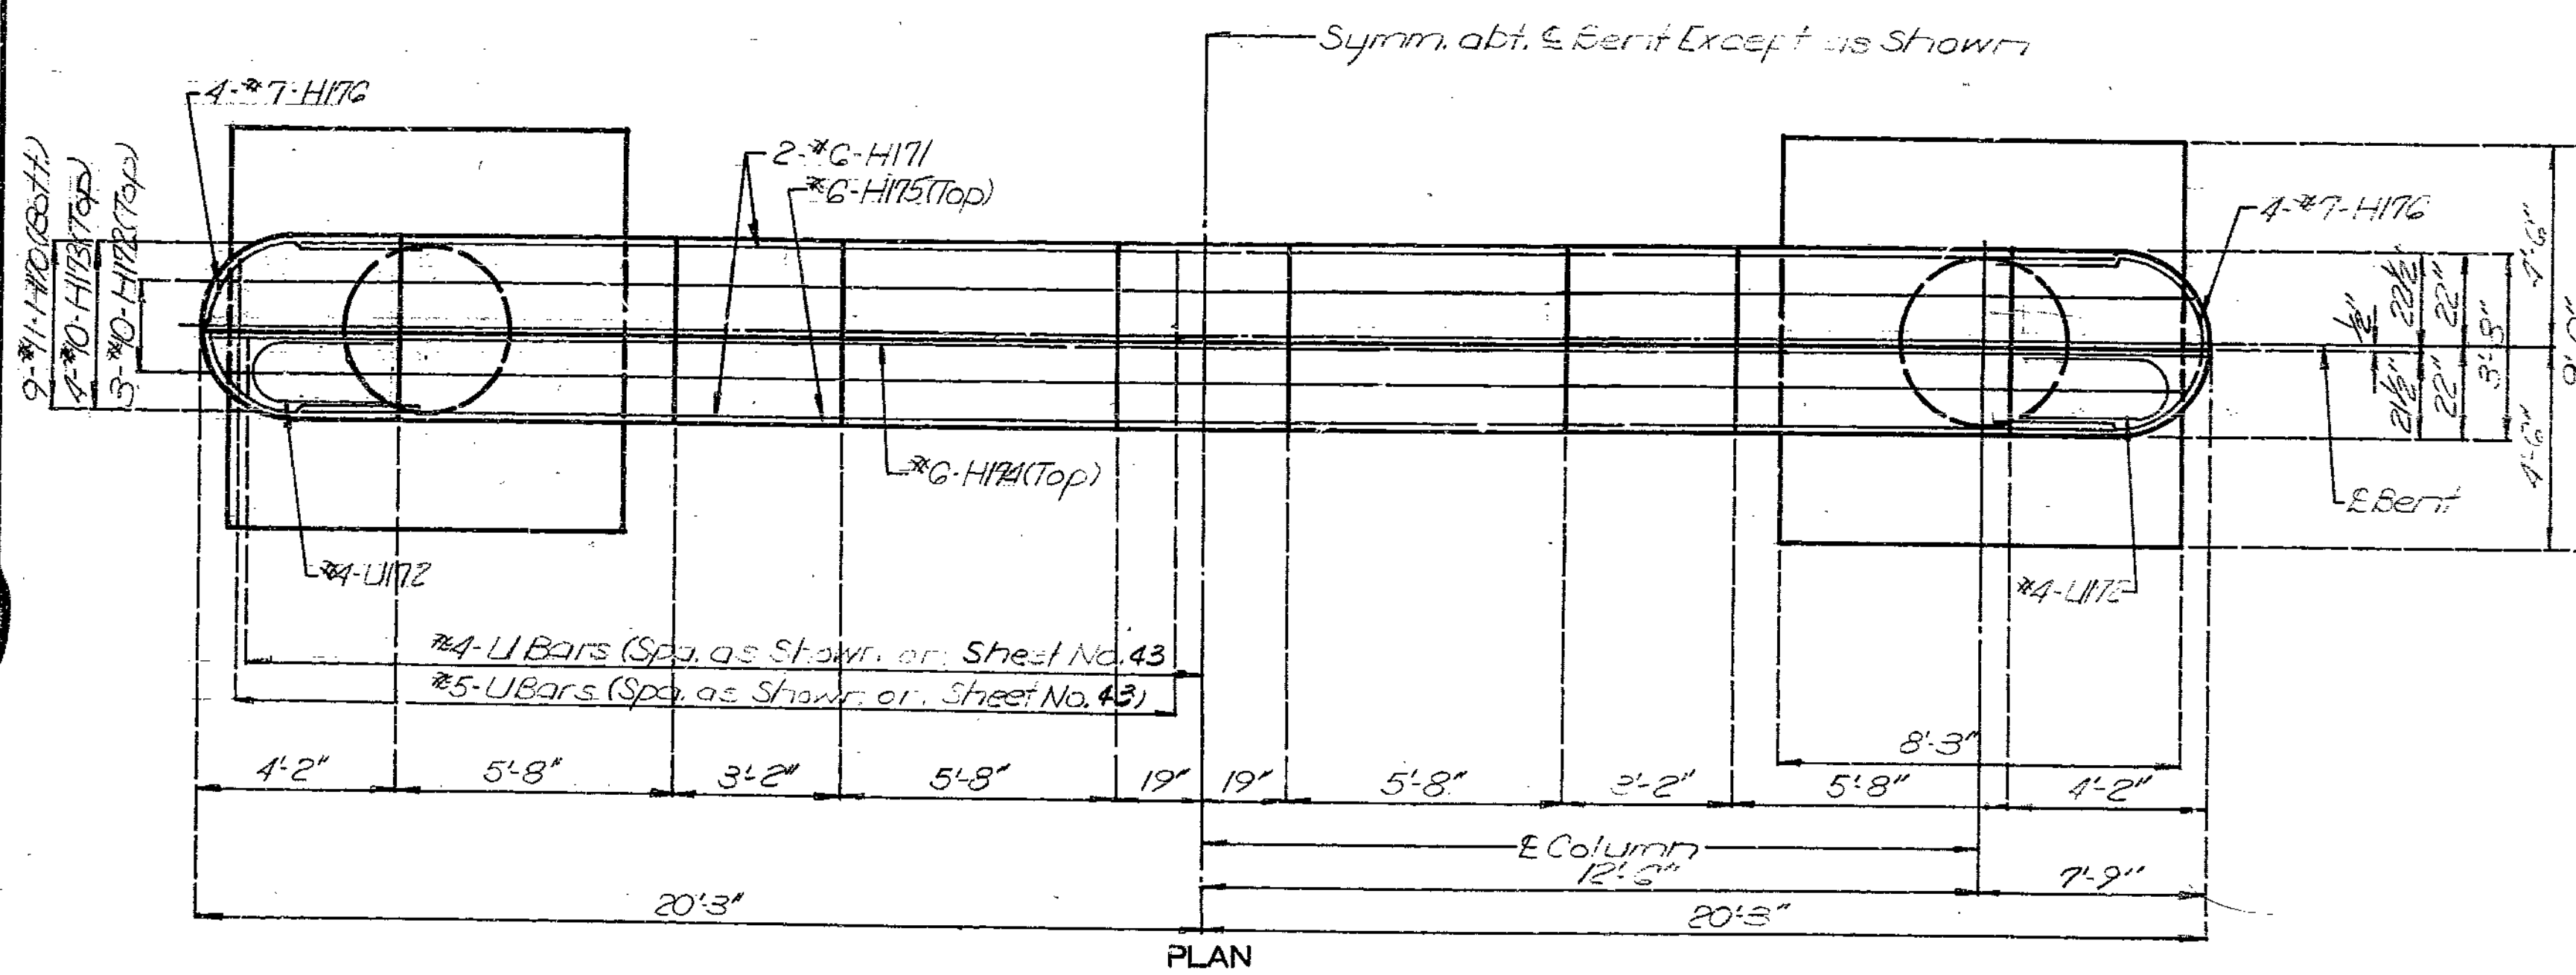

DETAILS OF INTERMEDIATE BENT NO.17

DETAILED JUN 1988  
 CHECKED AWB 1988

Note: This drawing is not to scale. Follow dimensions.

Revised 3/8/89

Sheet No. 42 of 53

JACKSON COUNTY

A-2745





STATE	PROJ. NO.	SHEET NO.
MO.		56

Note: For details of Intermediate Bent No. 18 not shown, see sheet No. 45  
 For details of girder to spiral see sheet No. 9

Note: For details of pile splice see sheet No. 9

\* Ergs. & Anchor bolts are in future construction.

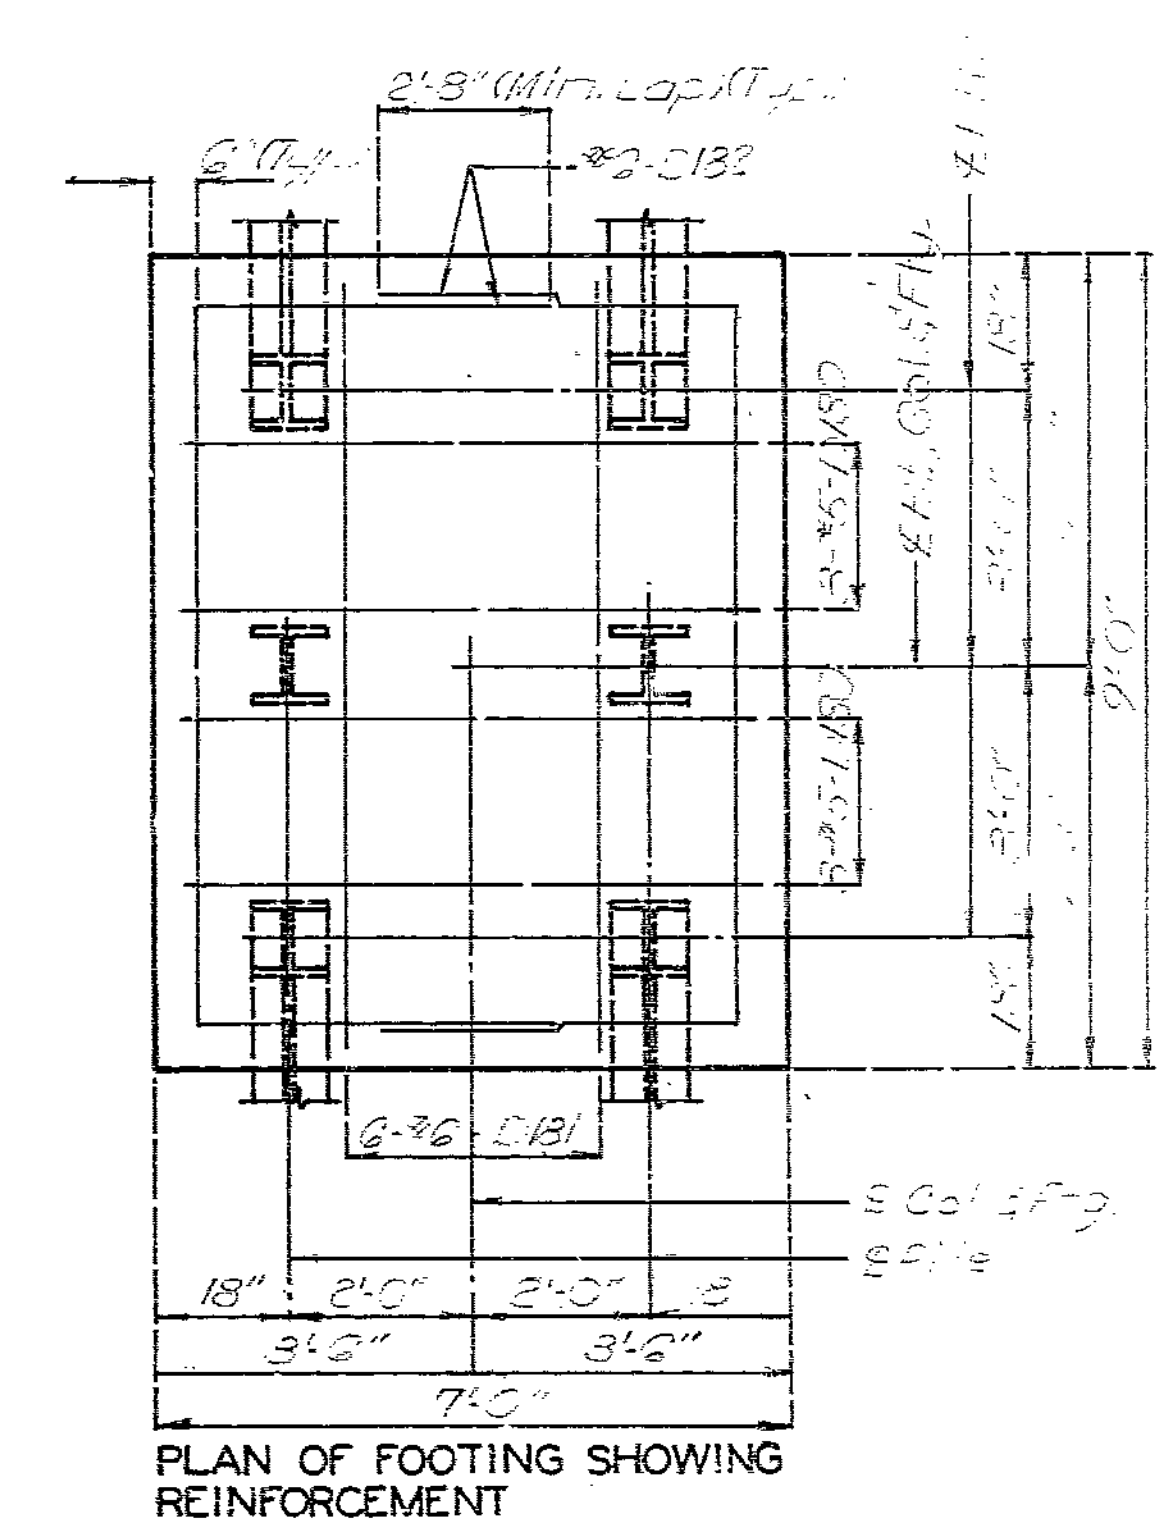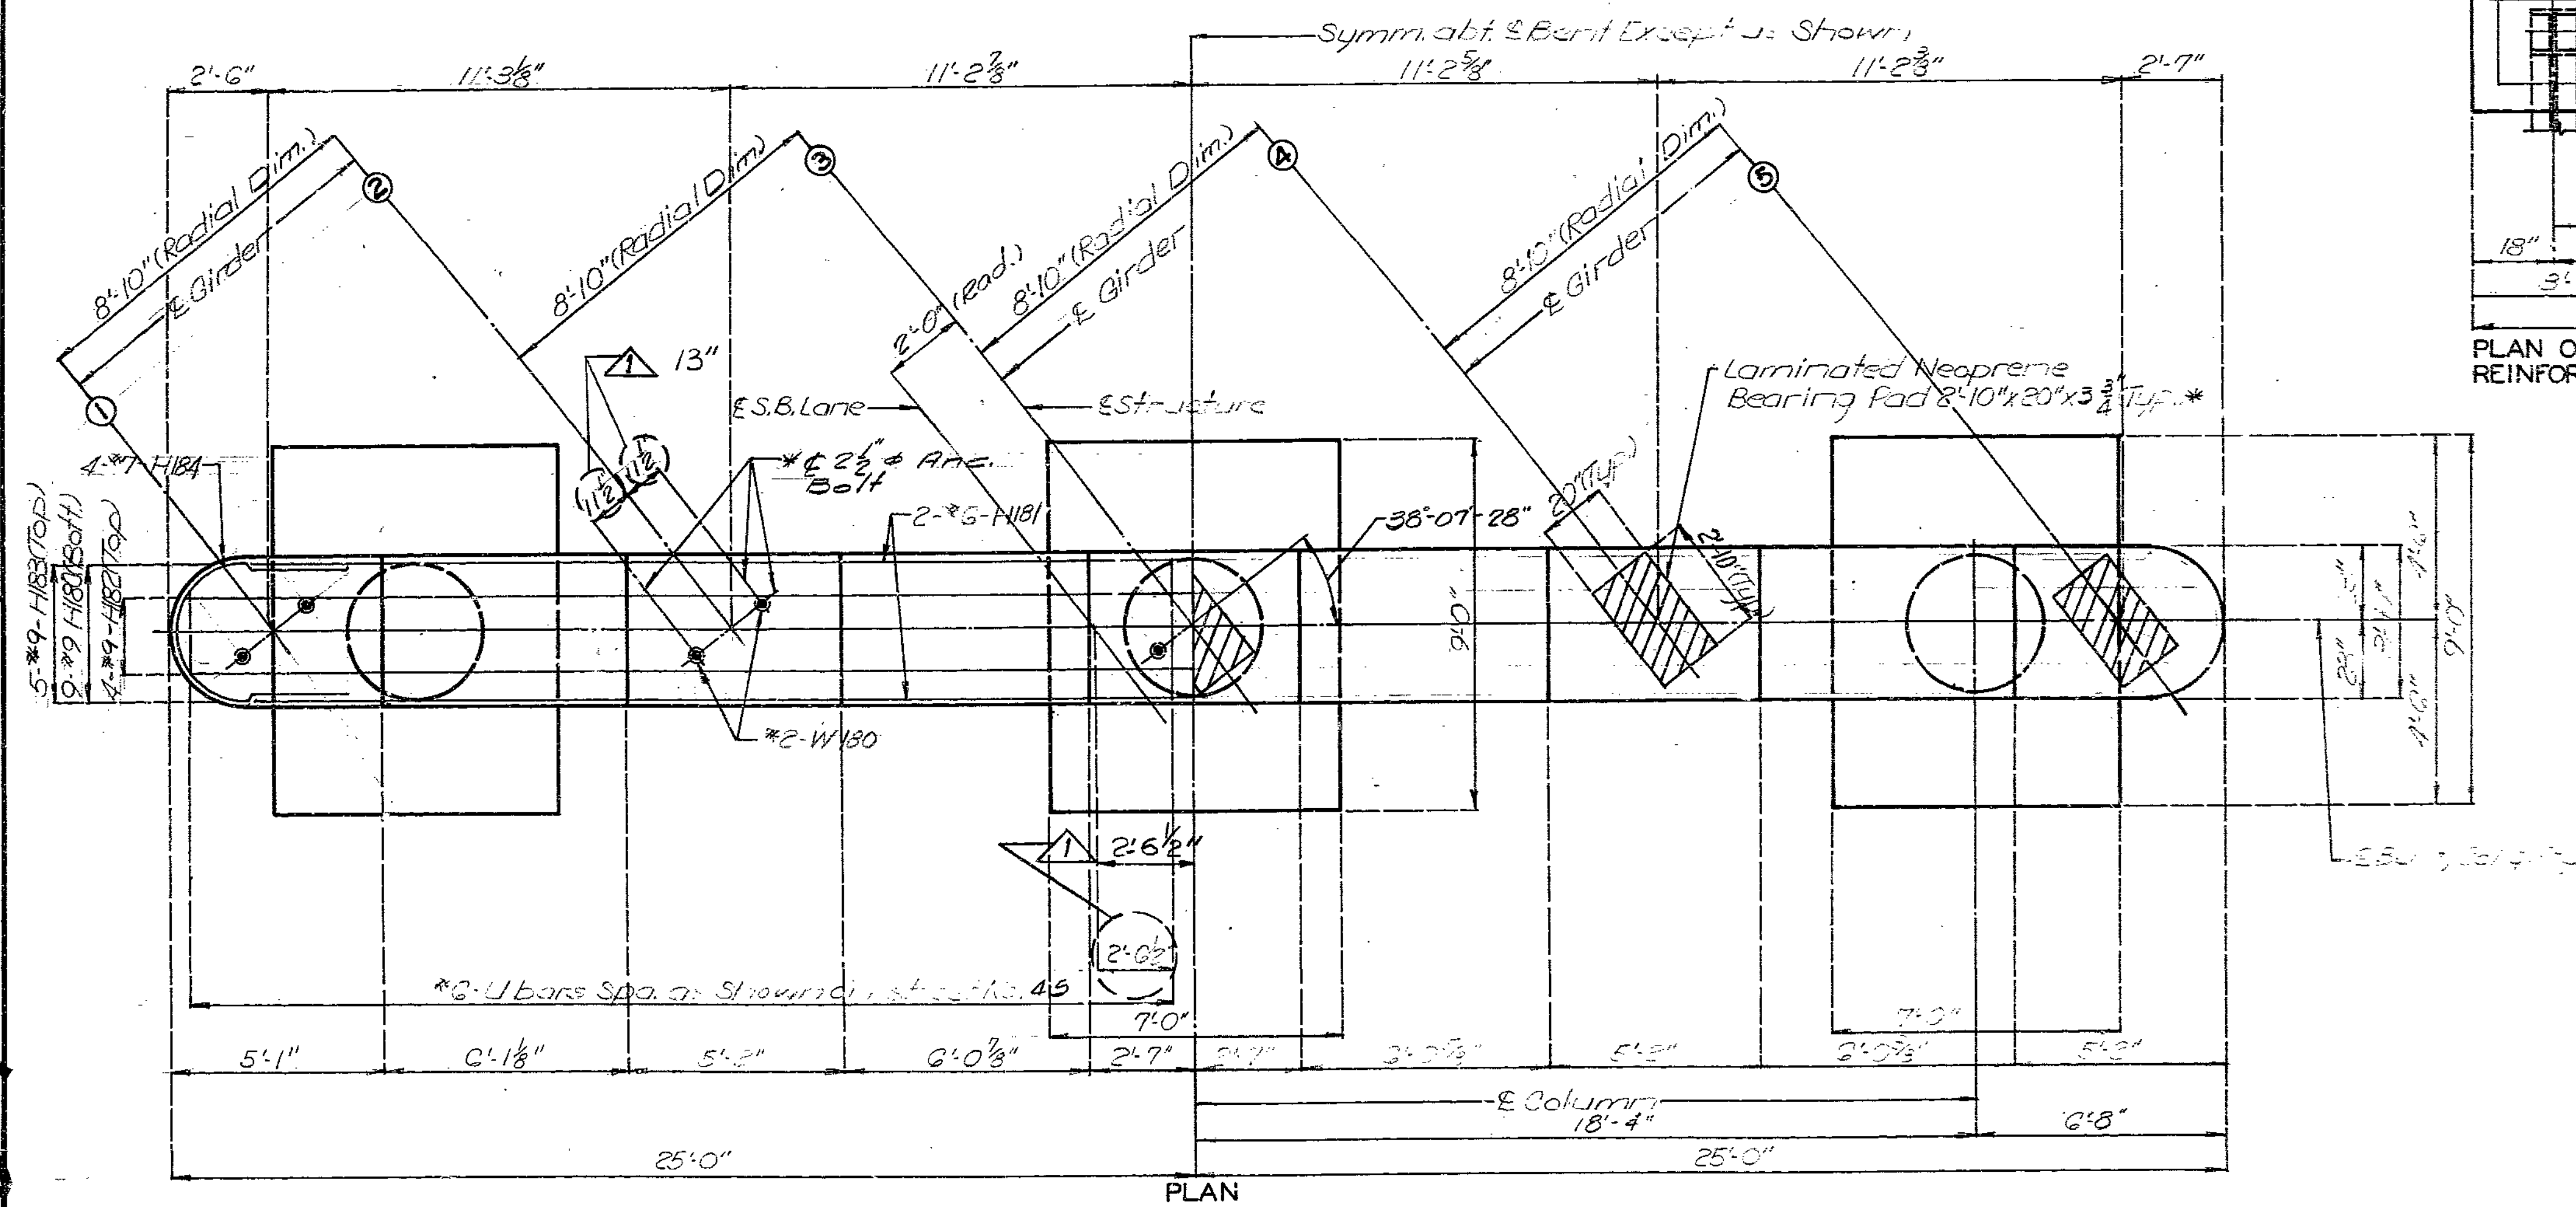

DETAILS OF INTERMEDIATE BENT NO. 18

248 354

DETAILED JUNE 1988  
 CHECKED Aug 1988

Note: This drawing is not to scale. Follow dimensions.

Revised 3/8/89



Sheet No. 22 of 55

JACKSON COUNTY

A-2745

STATE	PROJ. NO.	SHEET NO.
MO.		100

Note: For details of Intermediate Bent No. 18, see sheet 44.

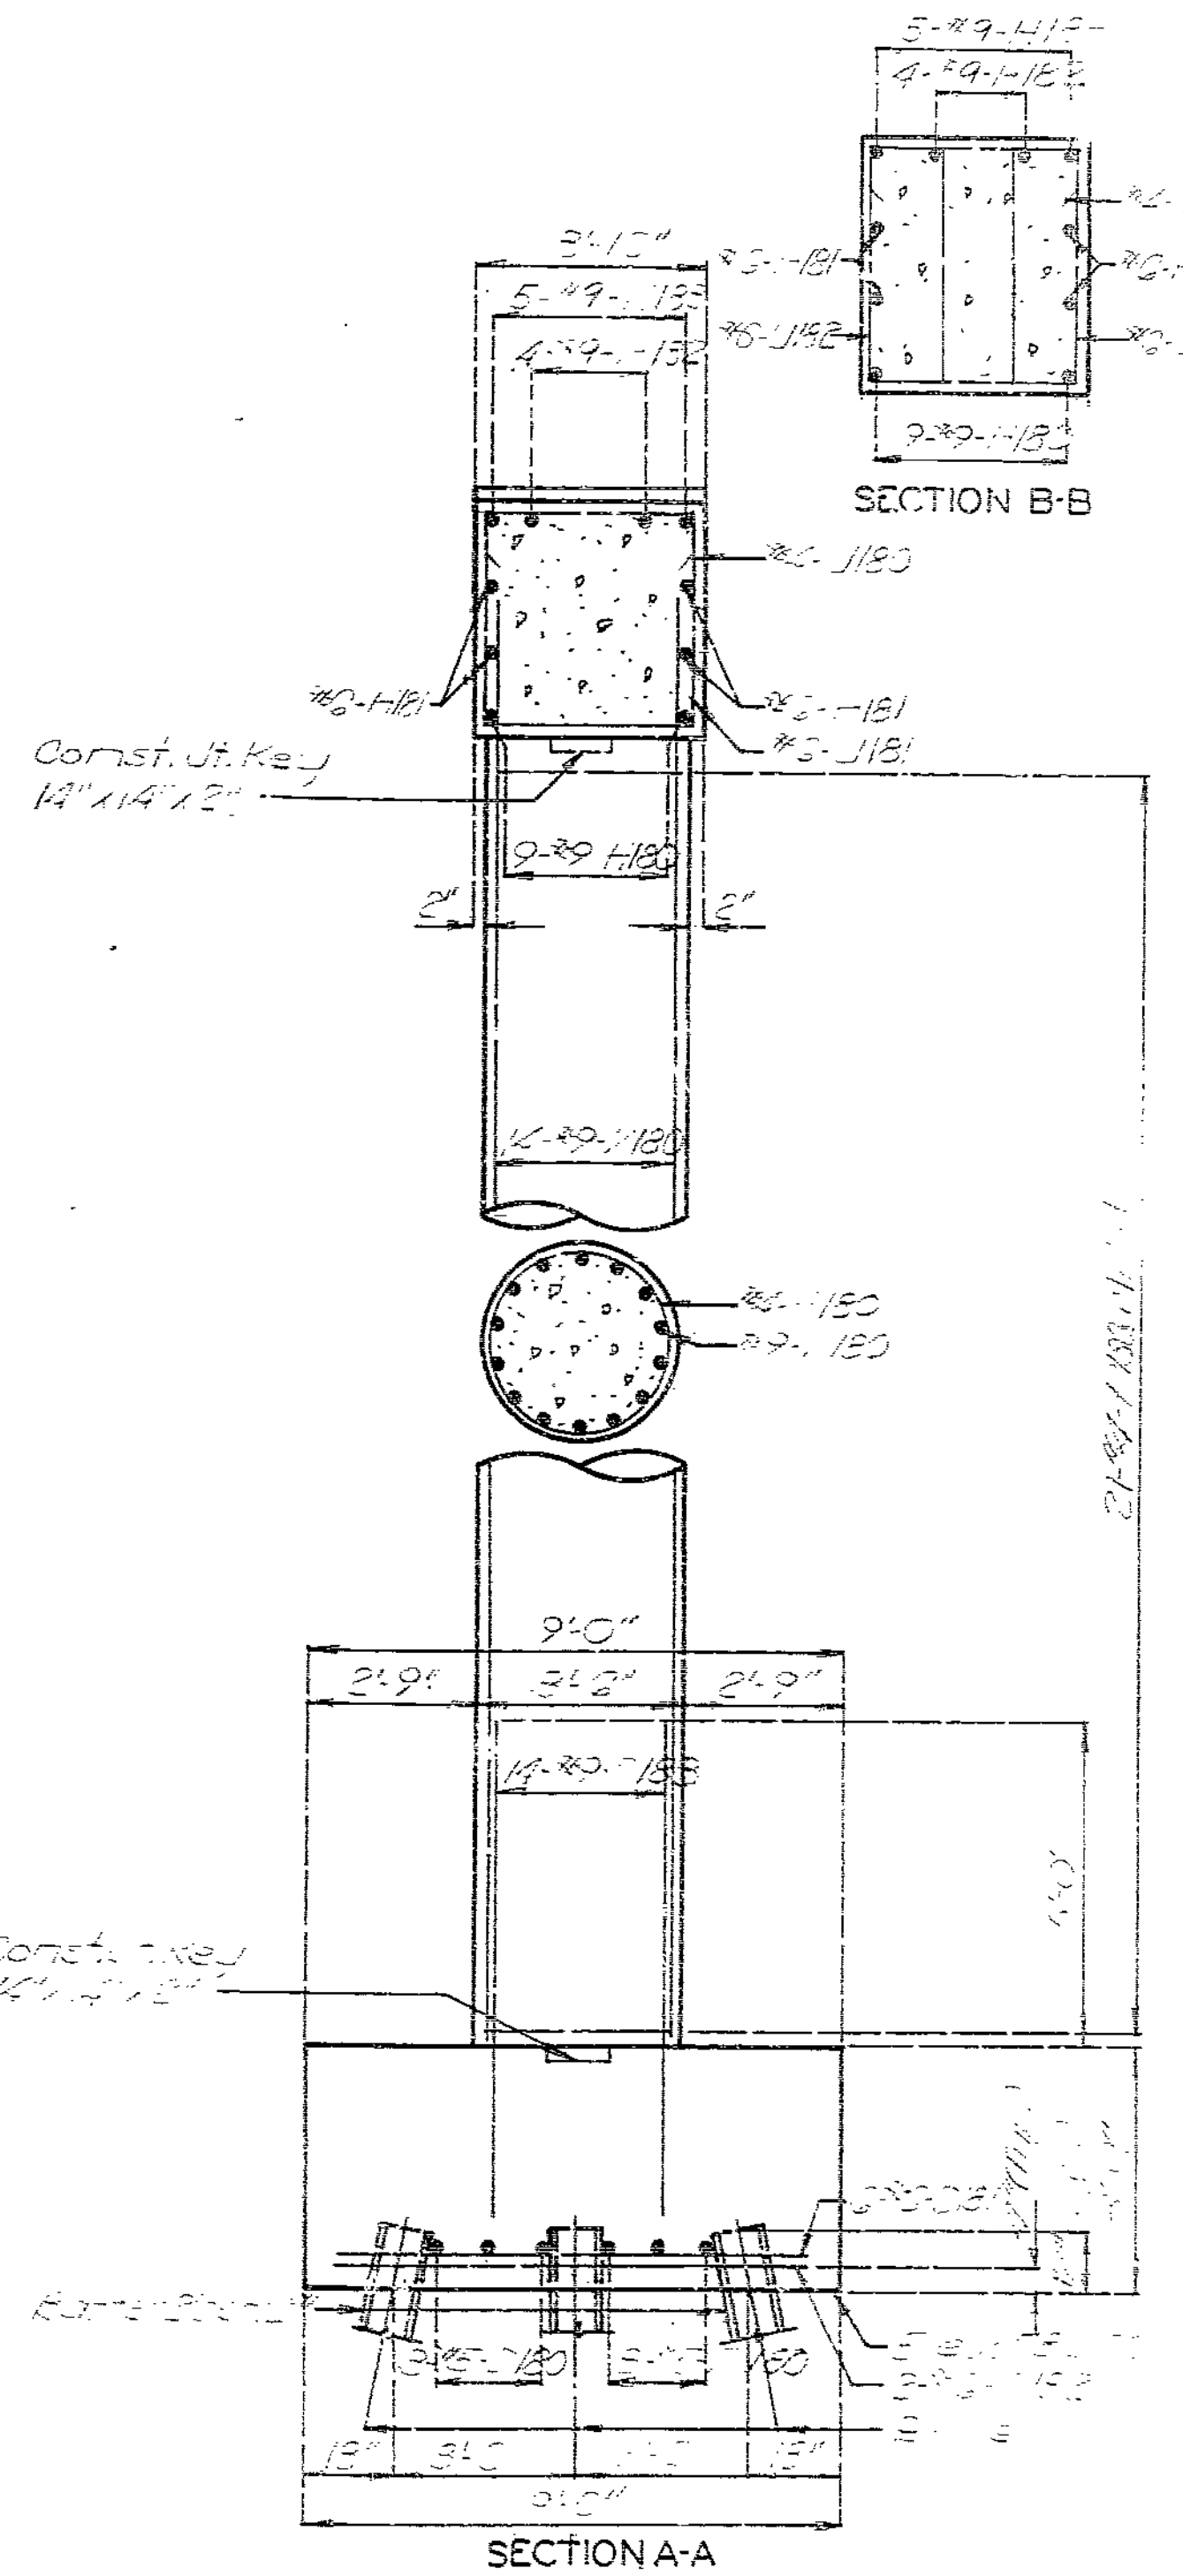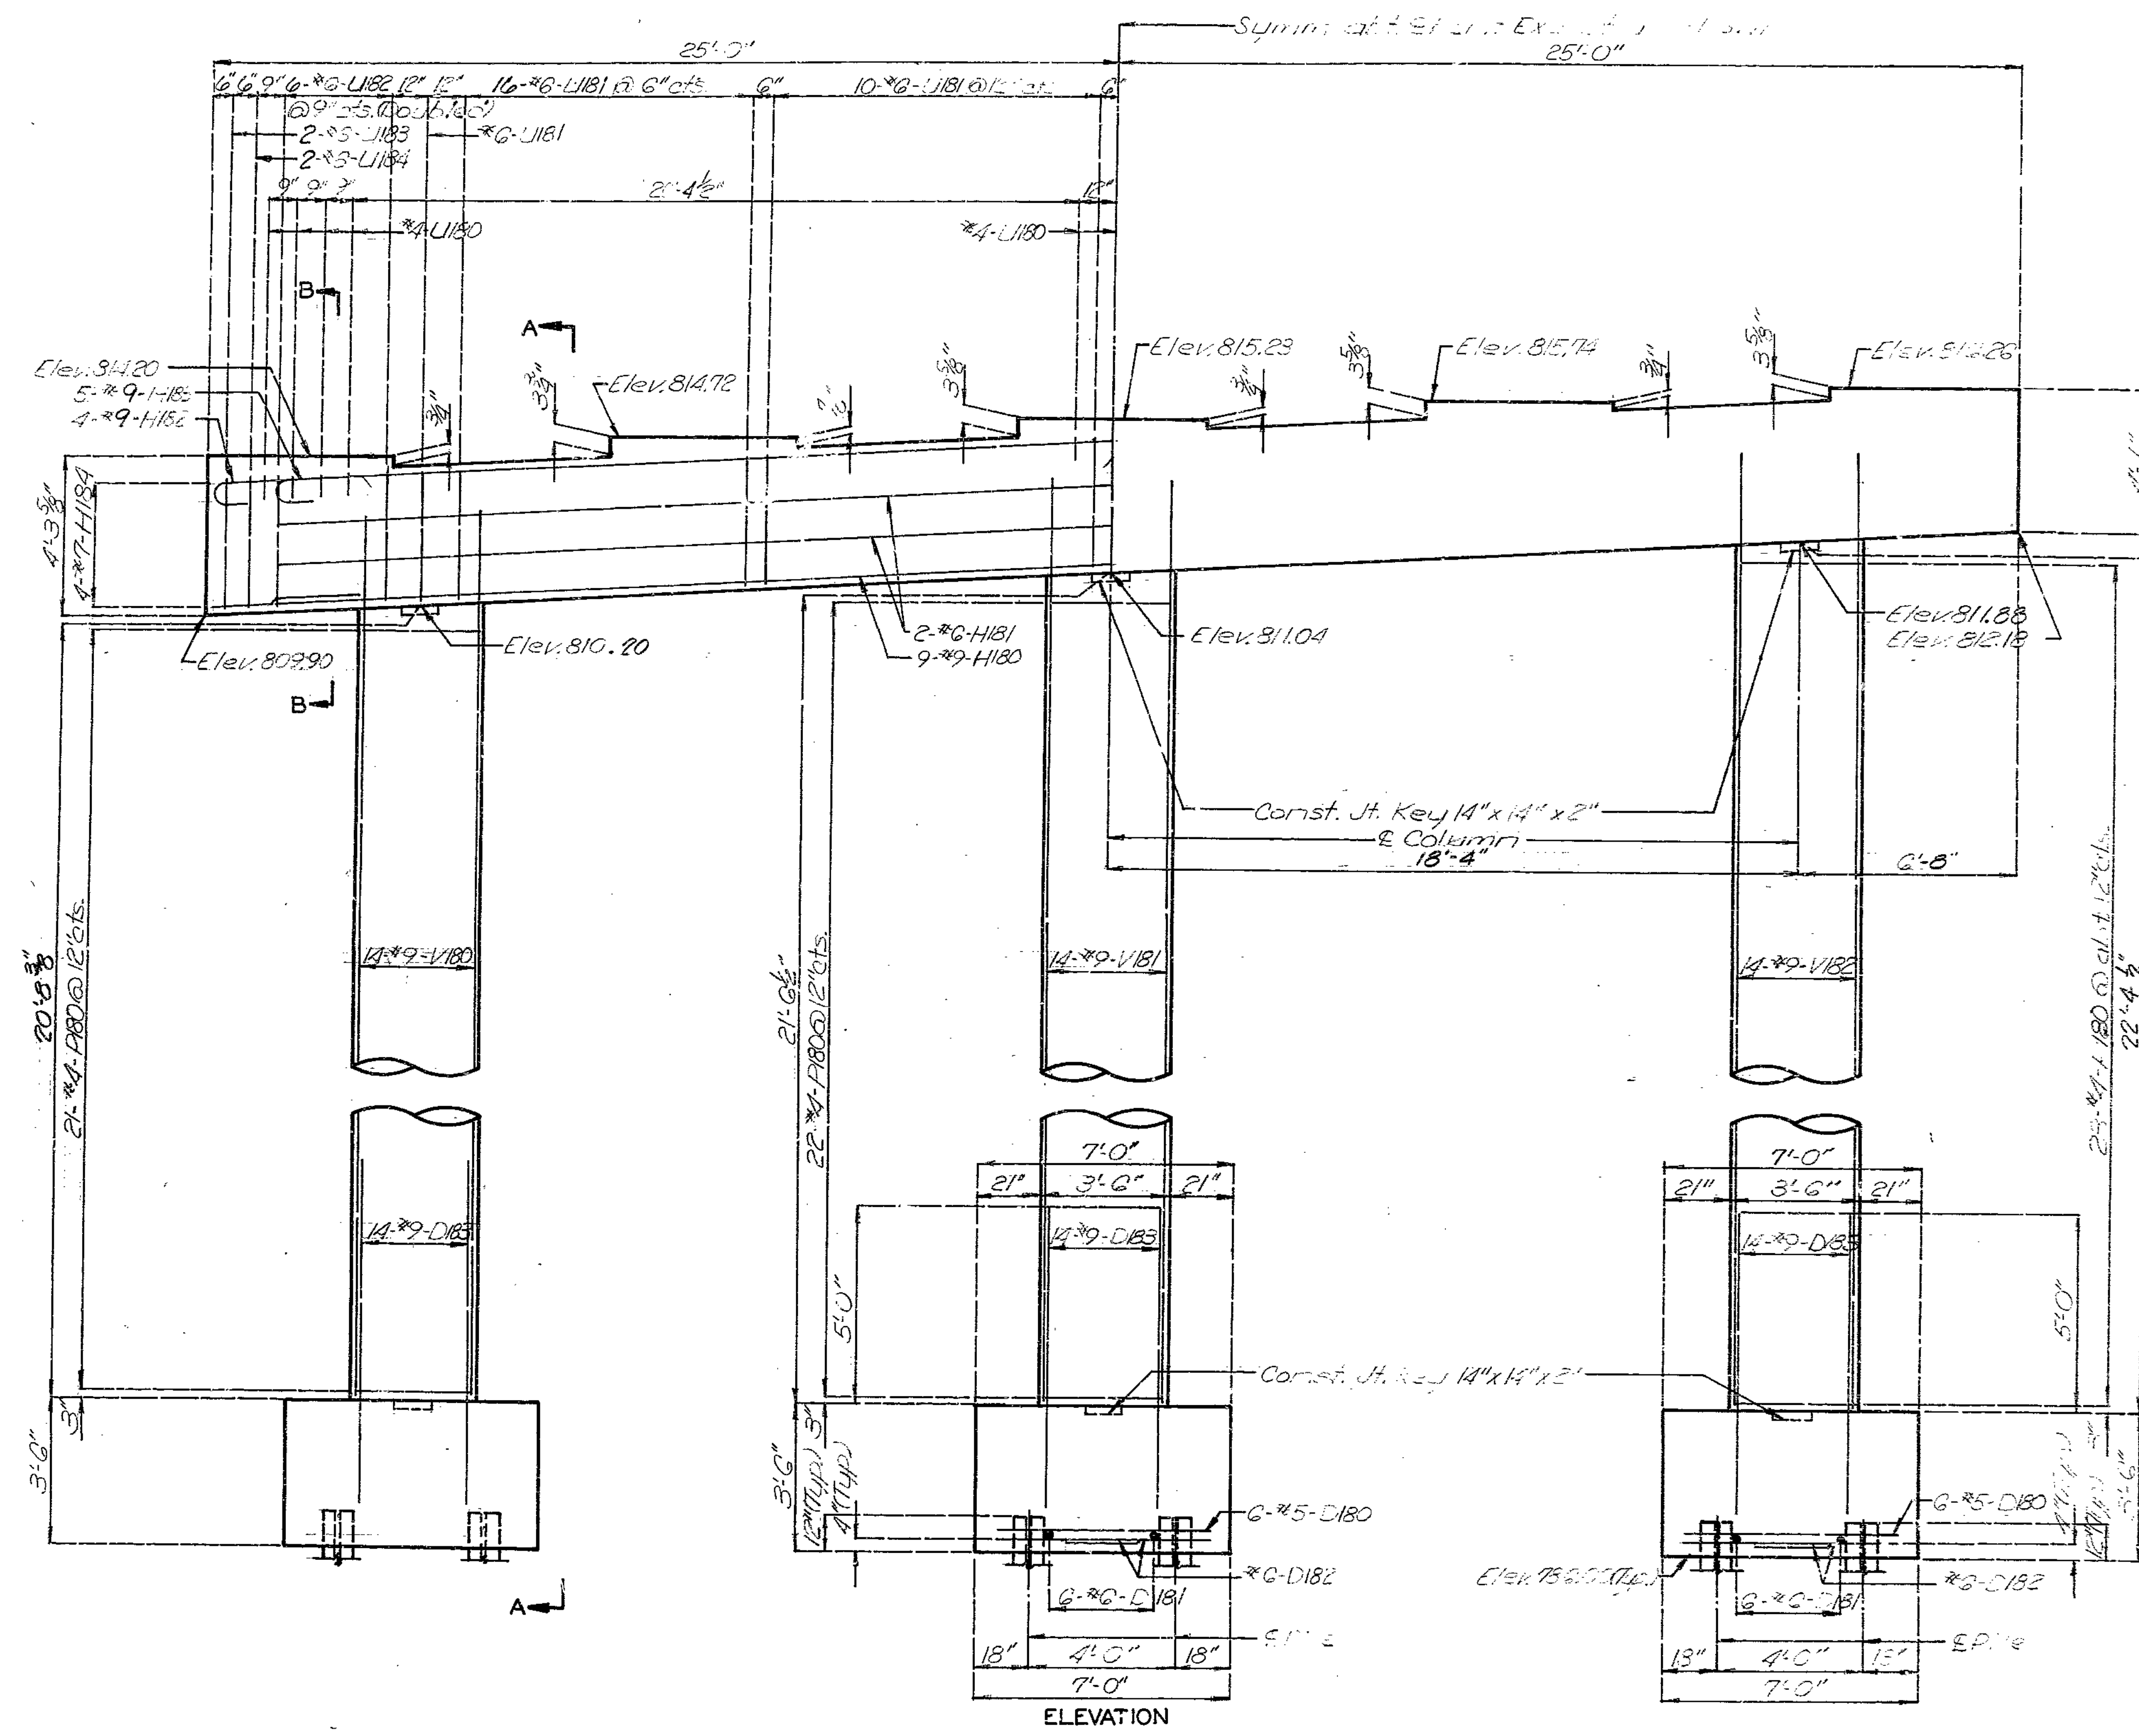

DETAILS OF INTERMEDIATE BENT NO. 18

244 355

DETAILED JUNE 1988  
CHECKED AUG 1988


Note: This drawing is not to scale. Follow dimensions.

Sheet No. 45 of 55

JACKSON COUNTY

A-2745

STATE	PROJ. NO.	SHEET NO.
MO		101

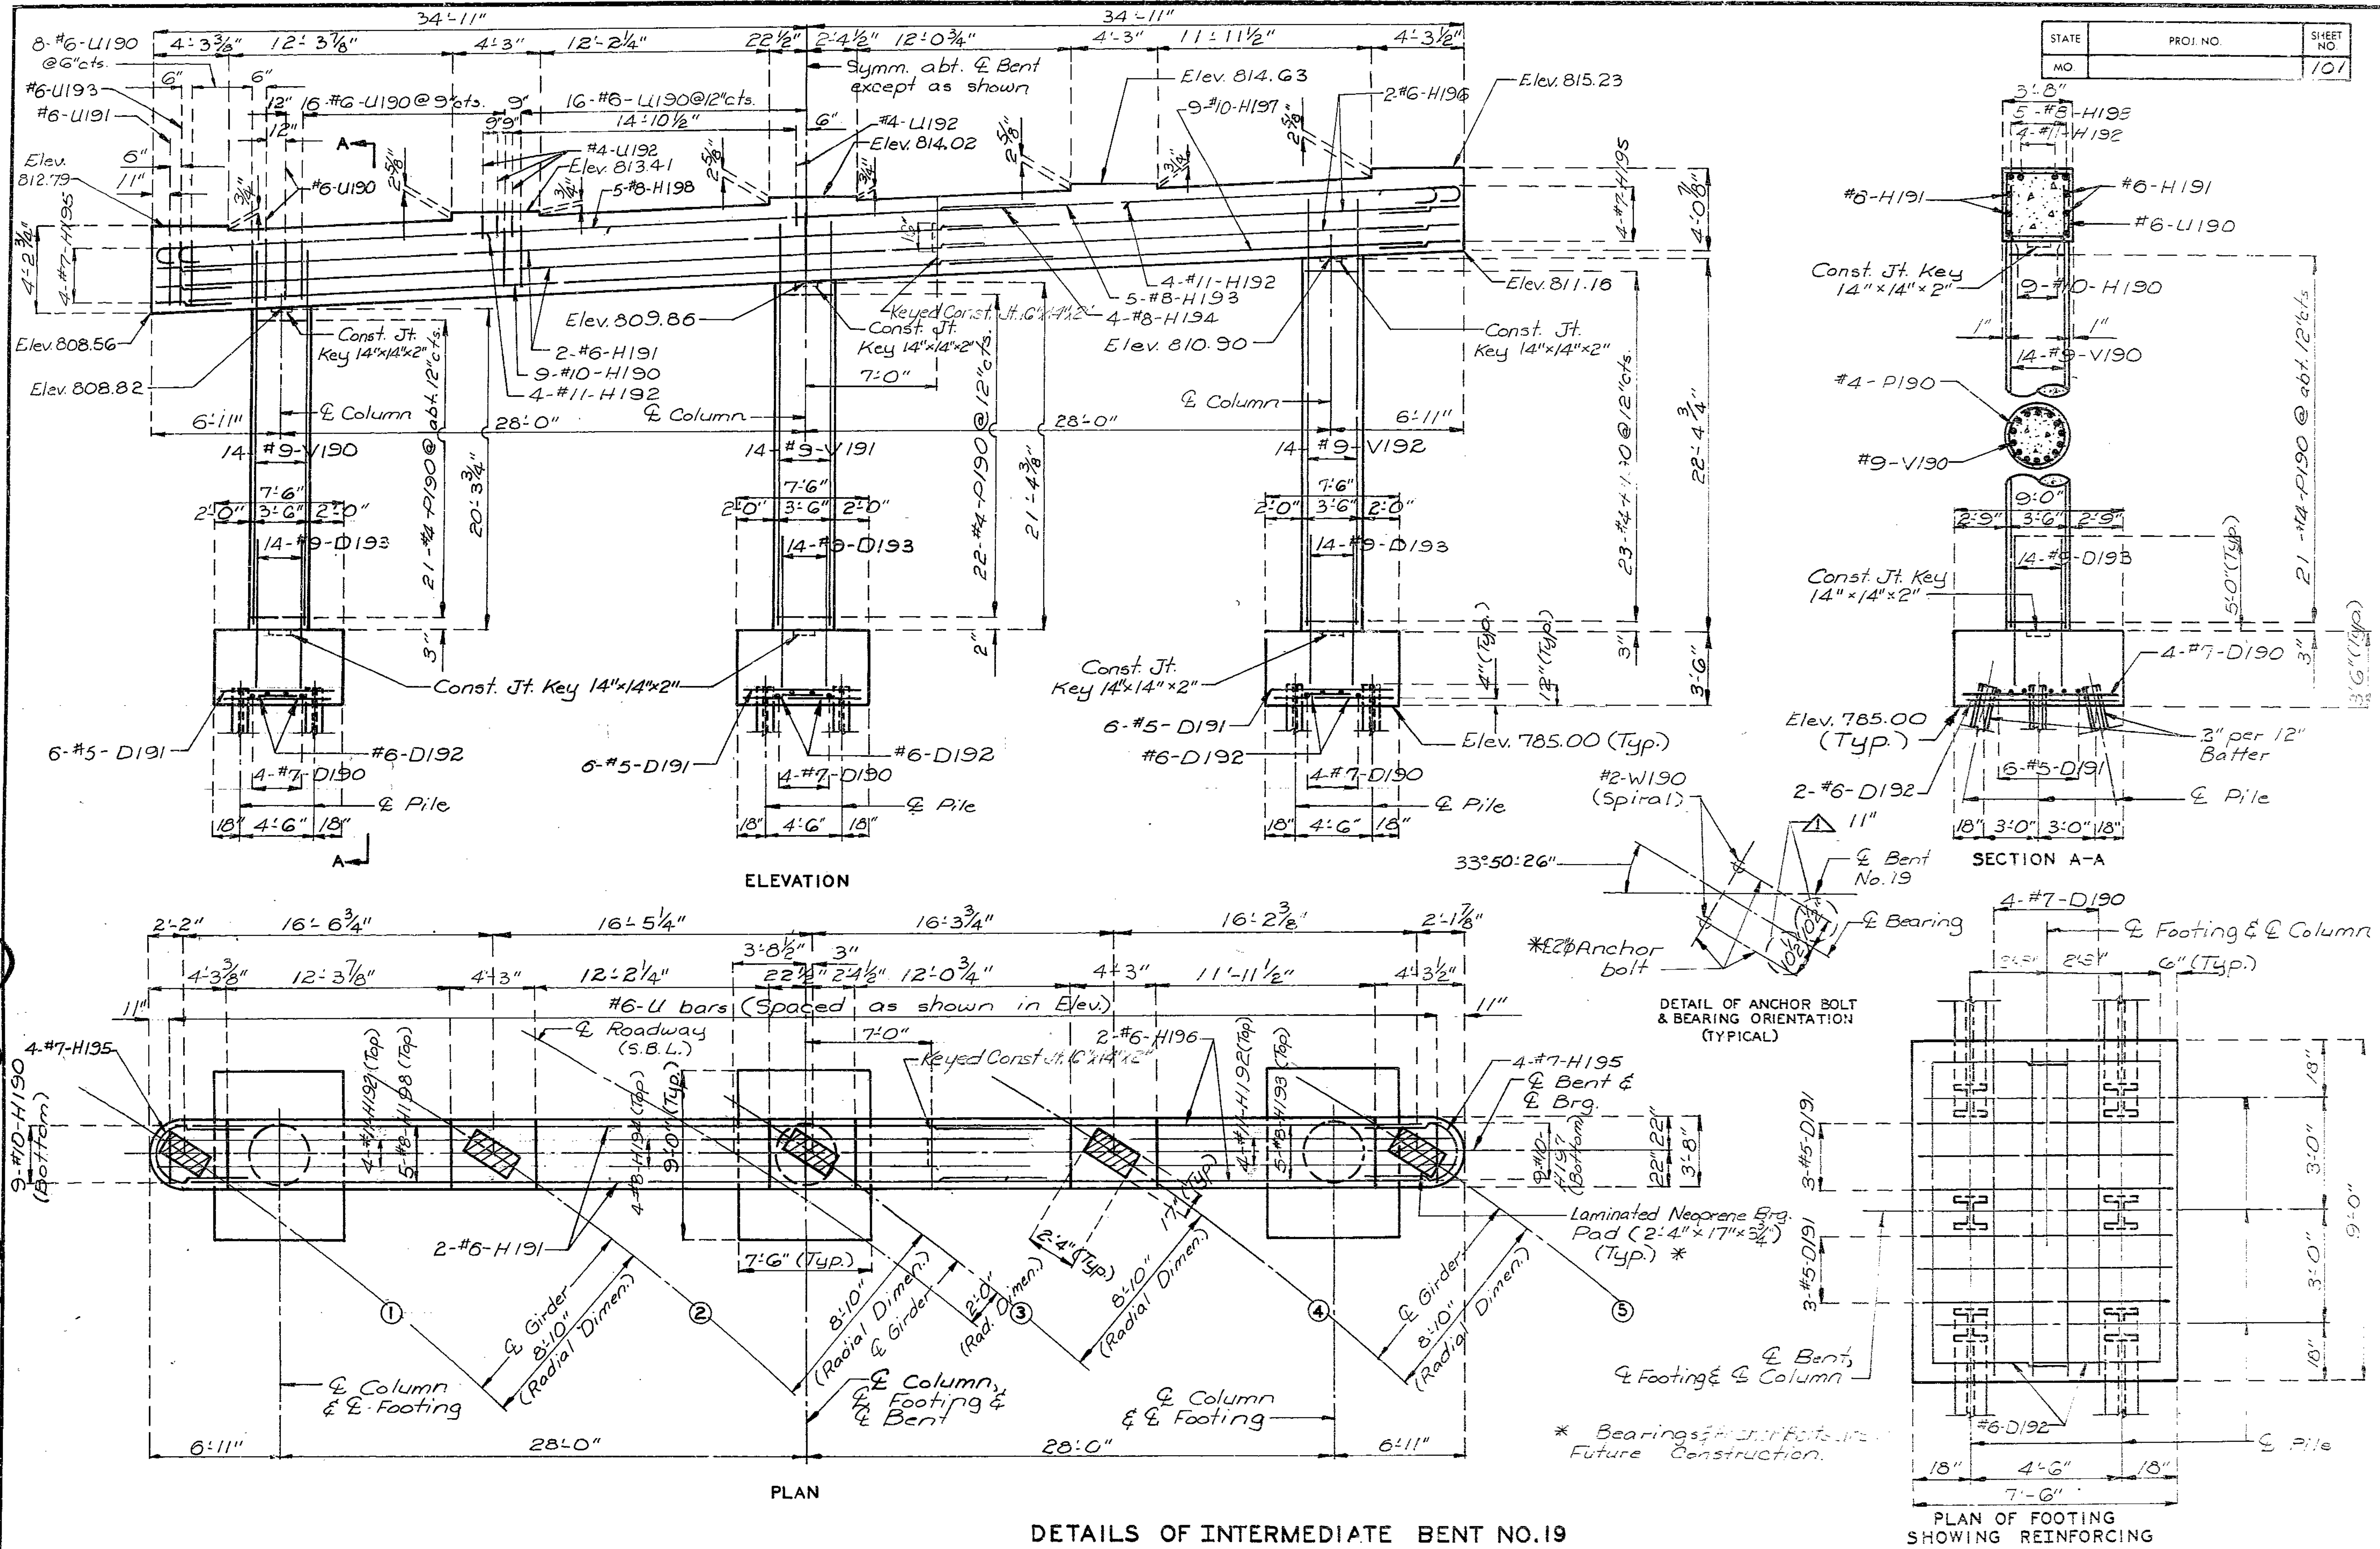

212 356

DATE: DETAILED June 1980  
CHECKED AUG. 19 88

Note: This drawing is not to scale. Follow dimensions.


Sheet No. 46 of 55

Revised 3/3/89 JACKSON

COUNTY

A-2745

STATE	PROJ. NO.	SHEET NO.
MO.		102

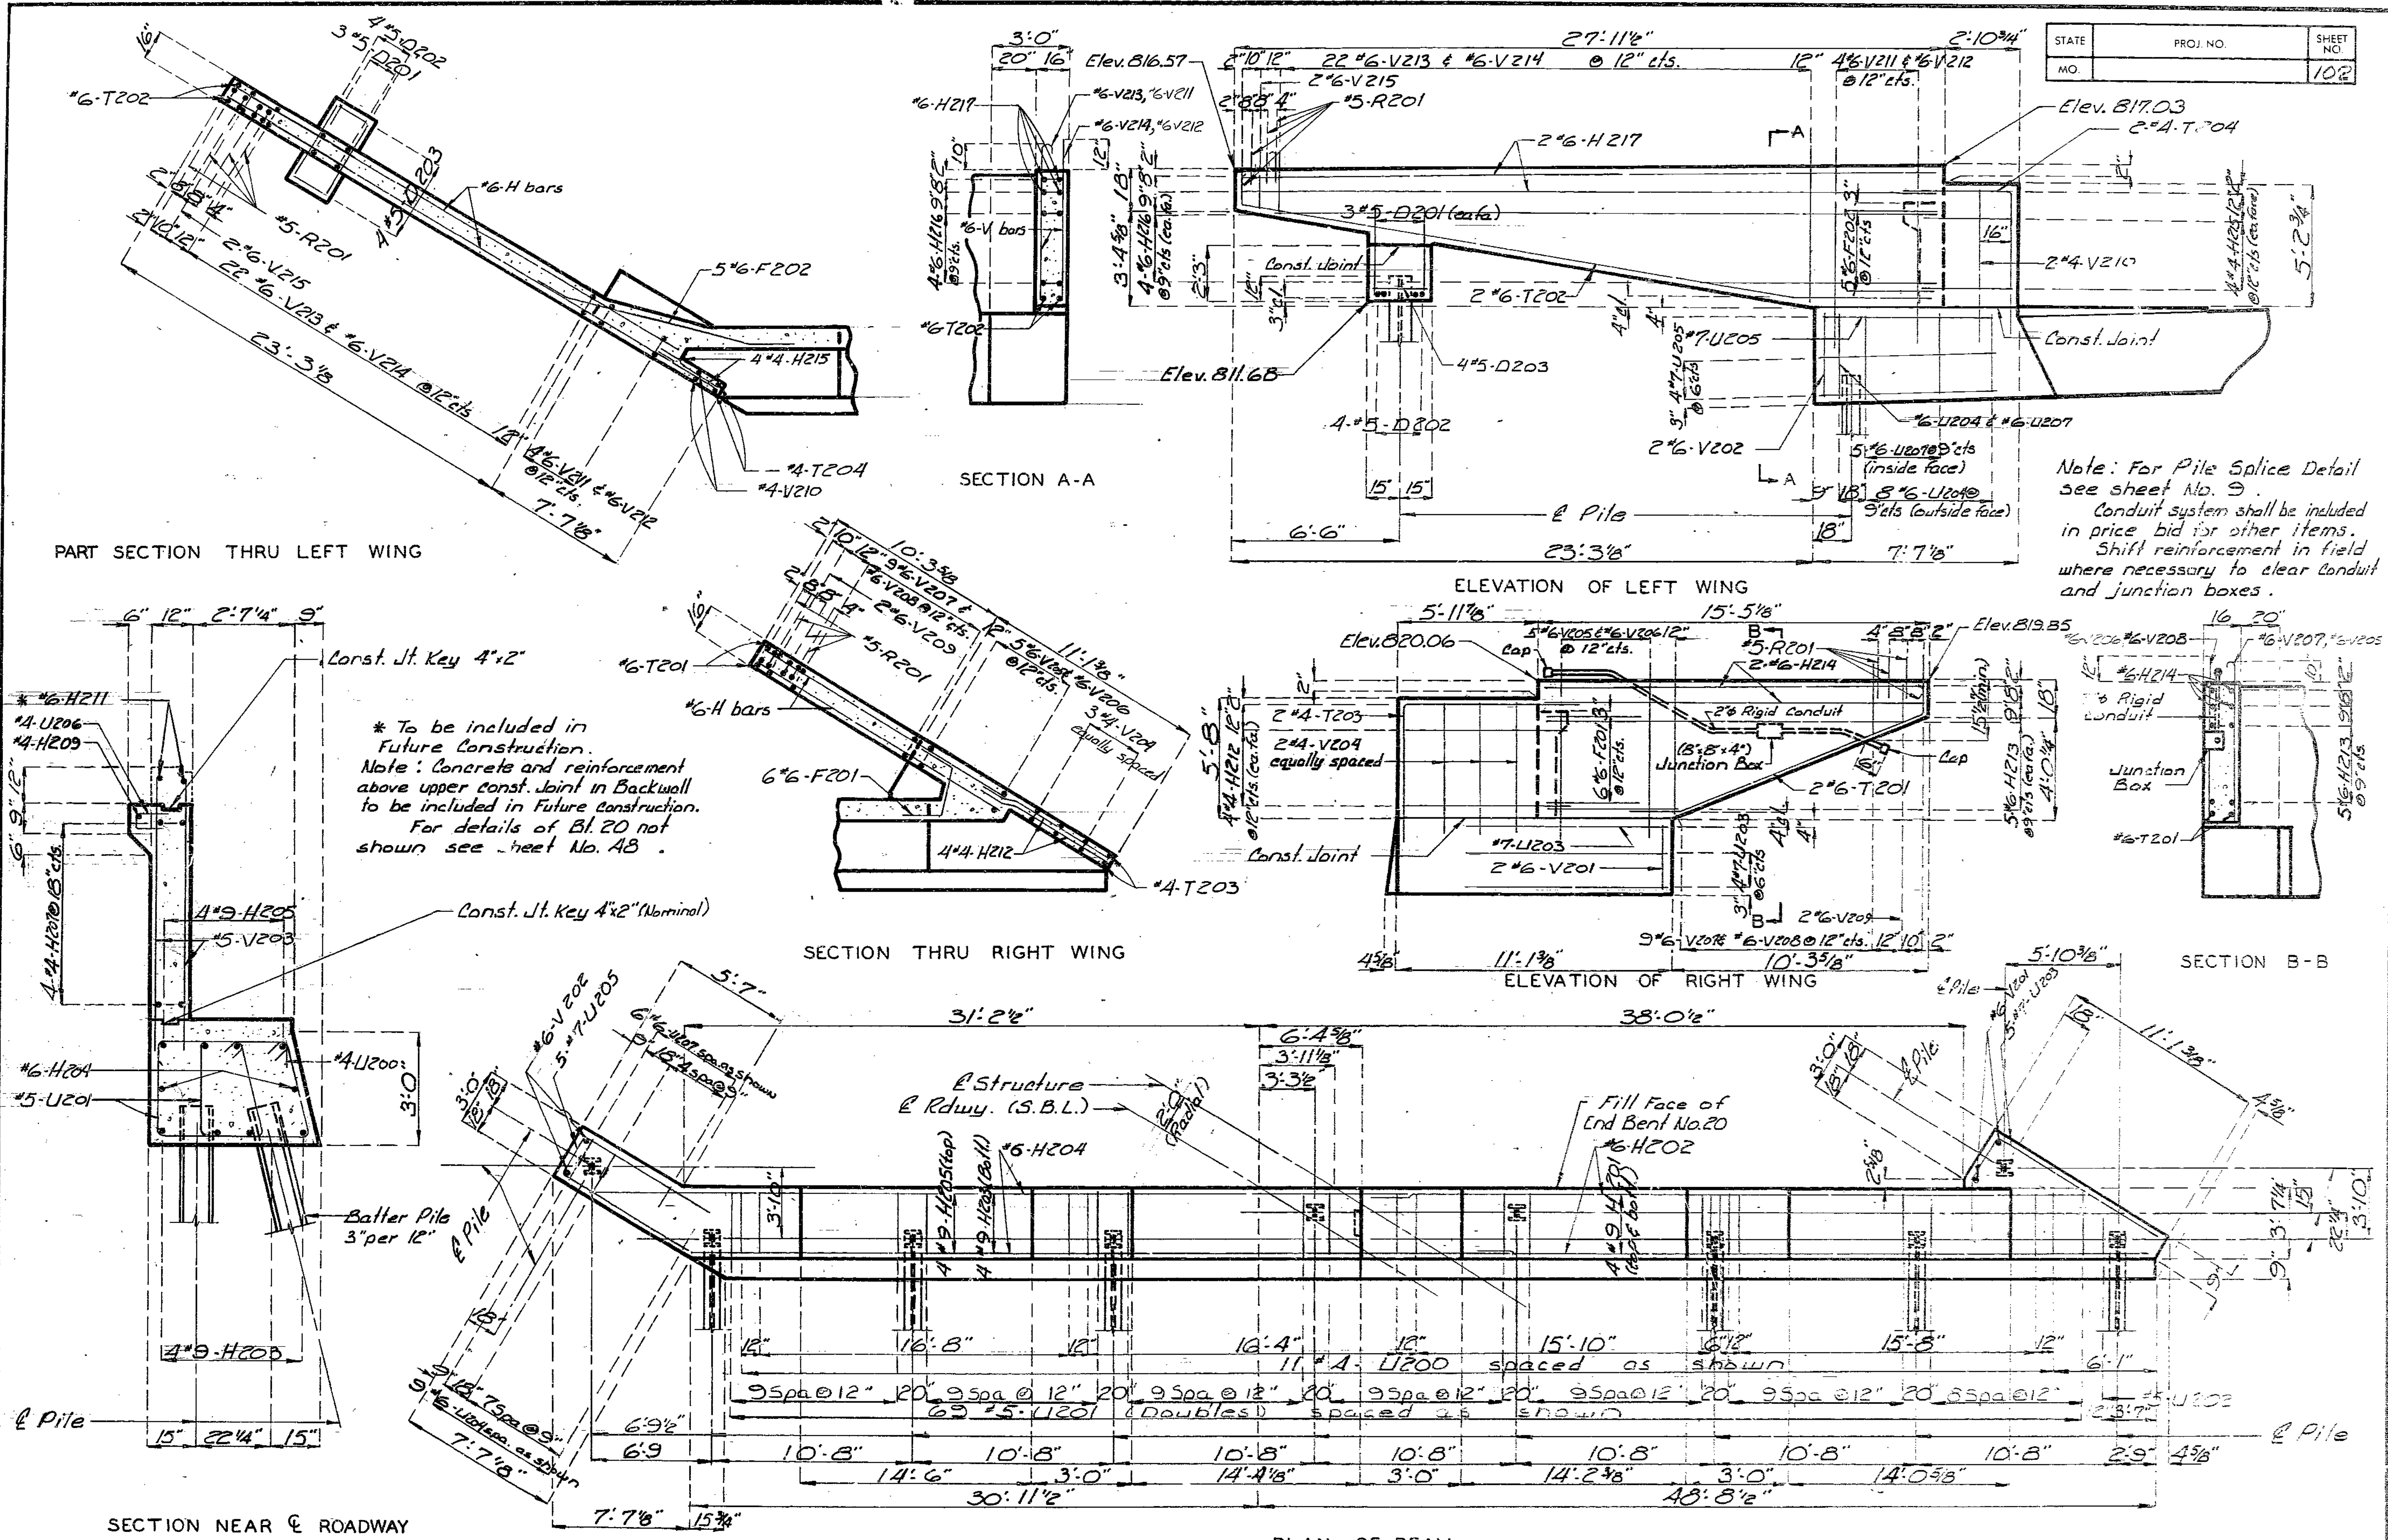

Note: For Pile Splice Detail see sheet No. 9.  
 Conduit system shall be included in price bid for other items.  
 Shift reinforcement in field where necessary to clear conduit and junction boxes.

\* To be included in Future Construction.  
 Note: Concrete and reinforcement above upper const. joint in Backwall to be included in Future construction.  
 For details of Bl. 20 not shown see sheet No. 48.

242 357

DETAILED JUNE 1988  
 CHECKED August 1988

Note: This drawing is not to scale. Follow dimensions.

PLAN OF BEAM  
 DETAILS OF END BENT NO. 20

Sheet No. 47 of 55


JACKSON COUNTY

A-2745

PILE NO.	PILE CUT-OFF ELEV.
A	Elev. 812.63
B	Elev. 812.68
C	Elev. 809.58
D	Elev. 809.84
E	Elev. 810.25
F	Elev. 810.66
G	Elev. 811.07
H	Elev. 811.47
I	Elev. 811.88
J	Elev. 812.29
K	Elev. 812.70
L	Elev. 812.48


STATE	PRO. NO.	SHEET NO.
MO.		103

\* #6-H210, #6-H211, Brgs. & Anchor Bolts are in Future Construction.

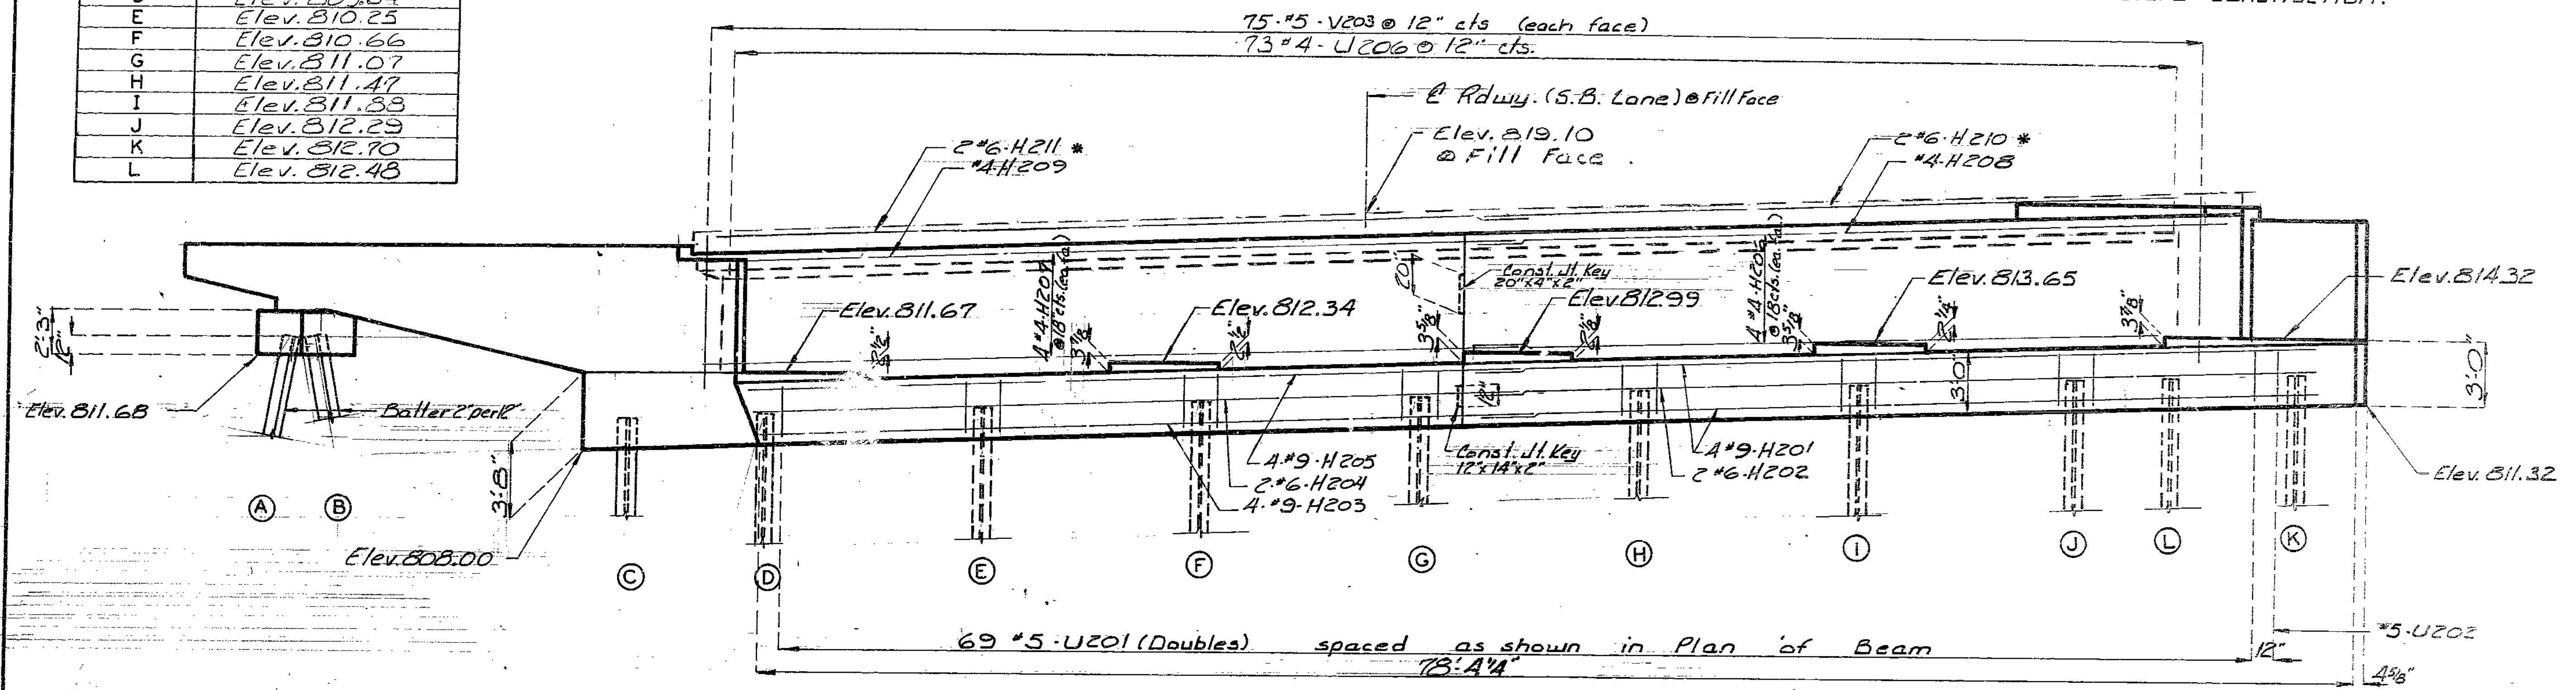

ELEVATION

244 358

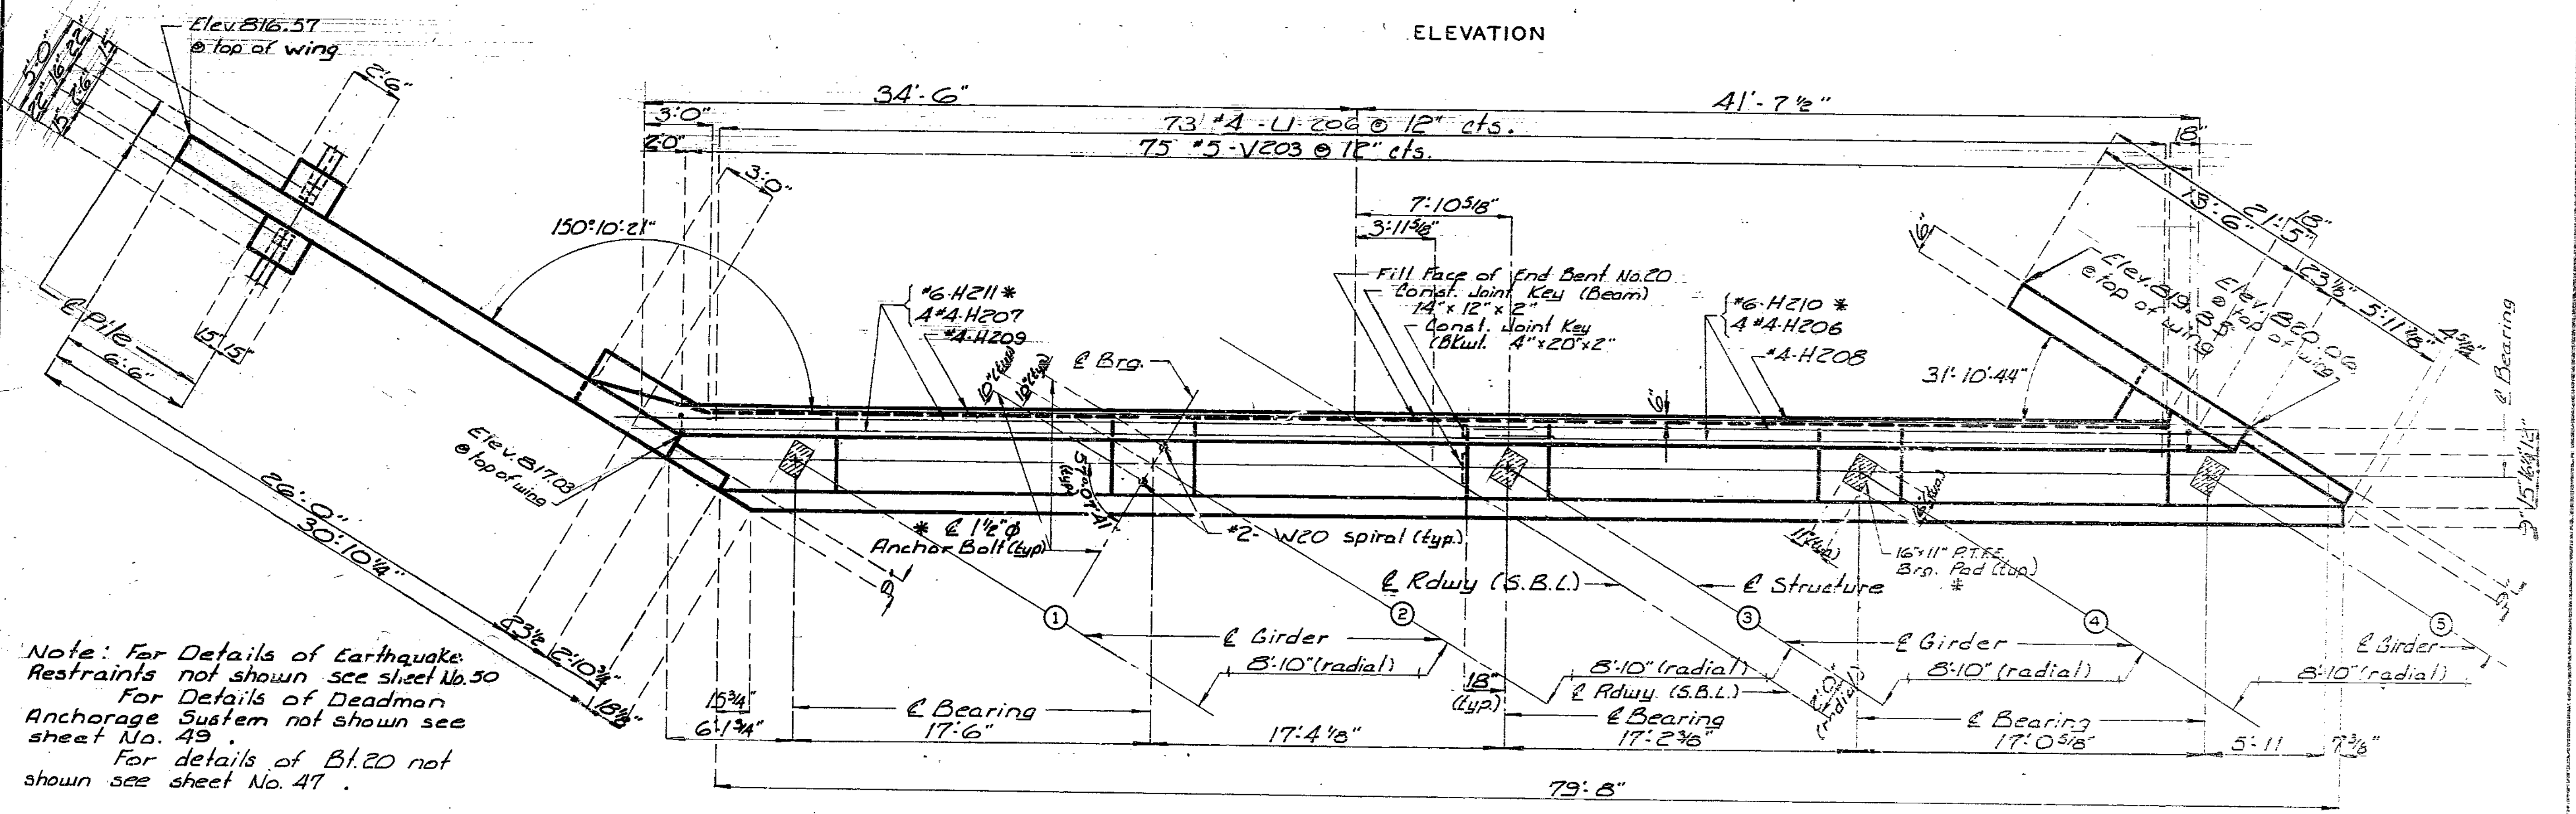

PLAN

Note: For Details of Earthquake Restraints not shown see sheet No. 50  
 For Details of Deadman Anchorage System not shown see sheet No. 49  
 For details of Bl. 20 not shown see sheet No. 47.

DETAILED JUNE 1988  
 CHECKED August 1988

Note: This drawing is not to scale. Follow dimensions.

DETAILS OF END BENT NO. 20

Sheet No. 48 of 55


JACKSON COUNTY

A-2745



60 scale


STATE	PROJ NO	SHEET NO
MO		104

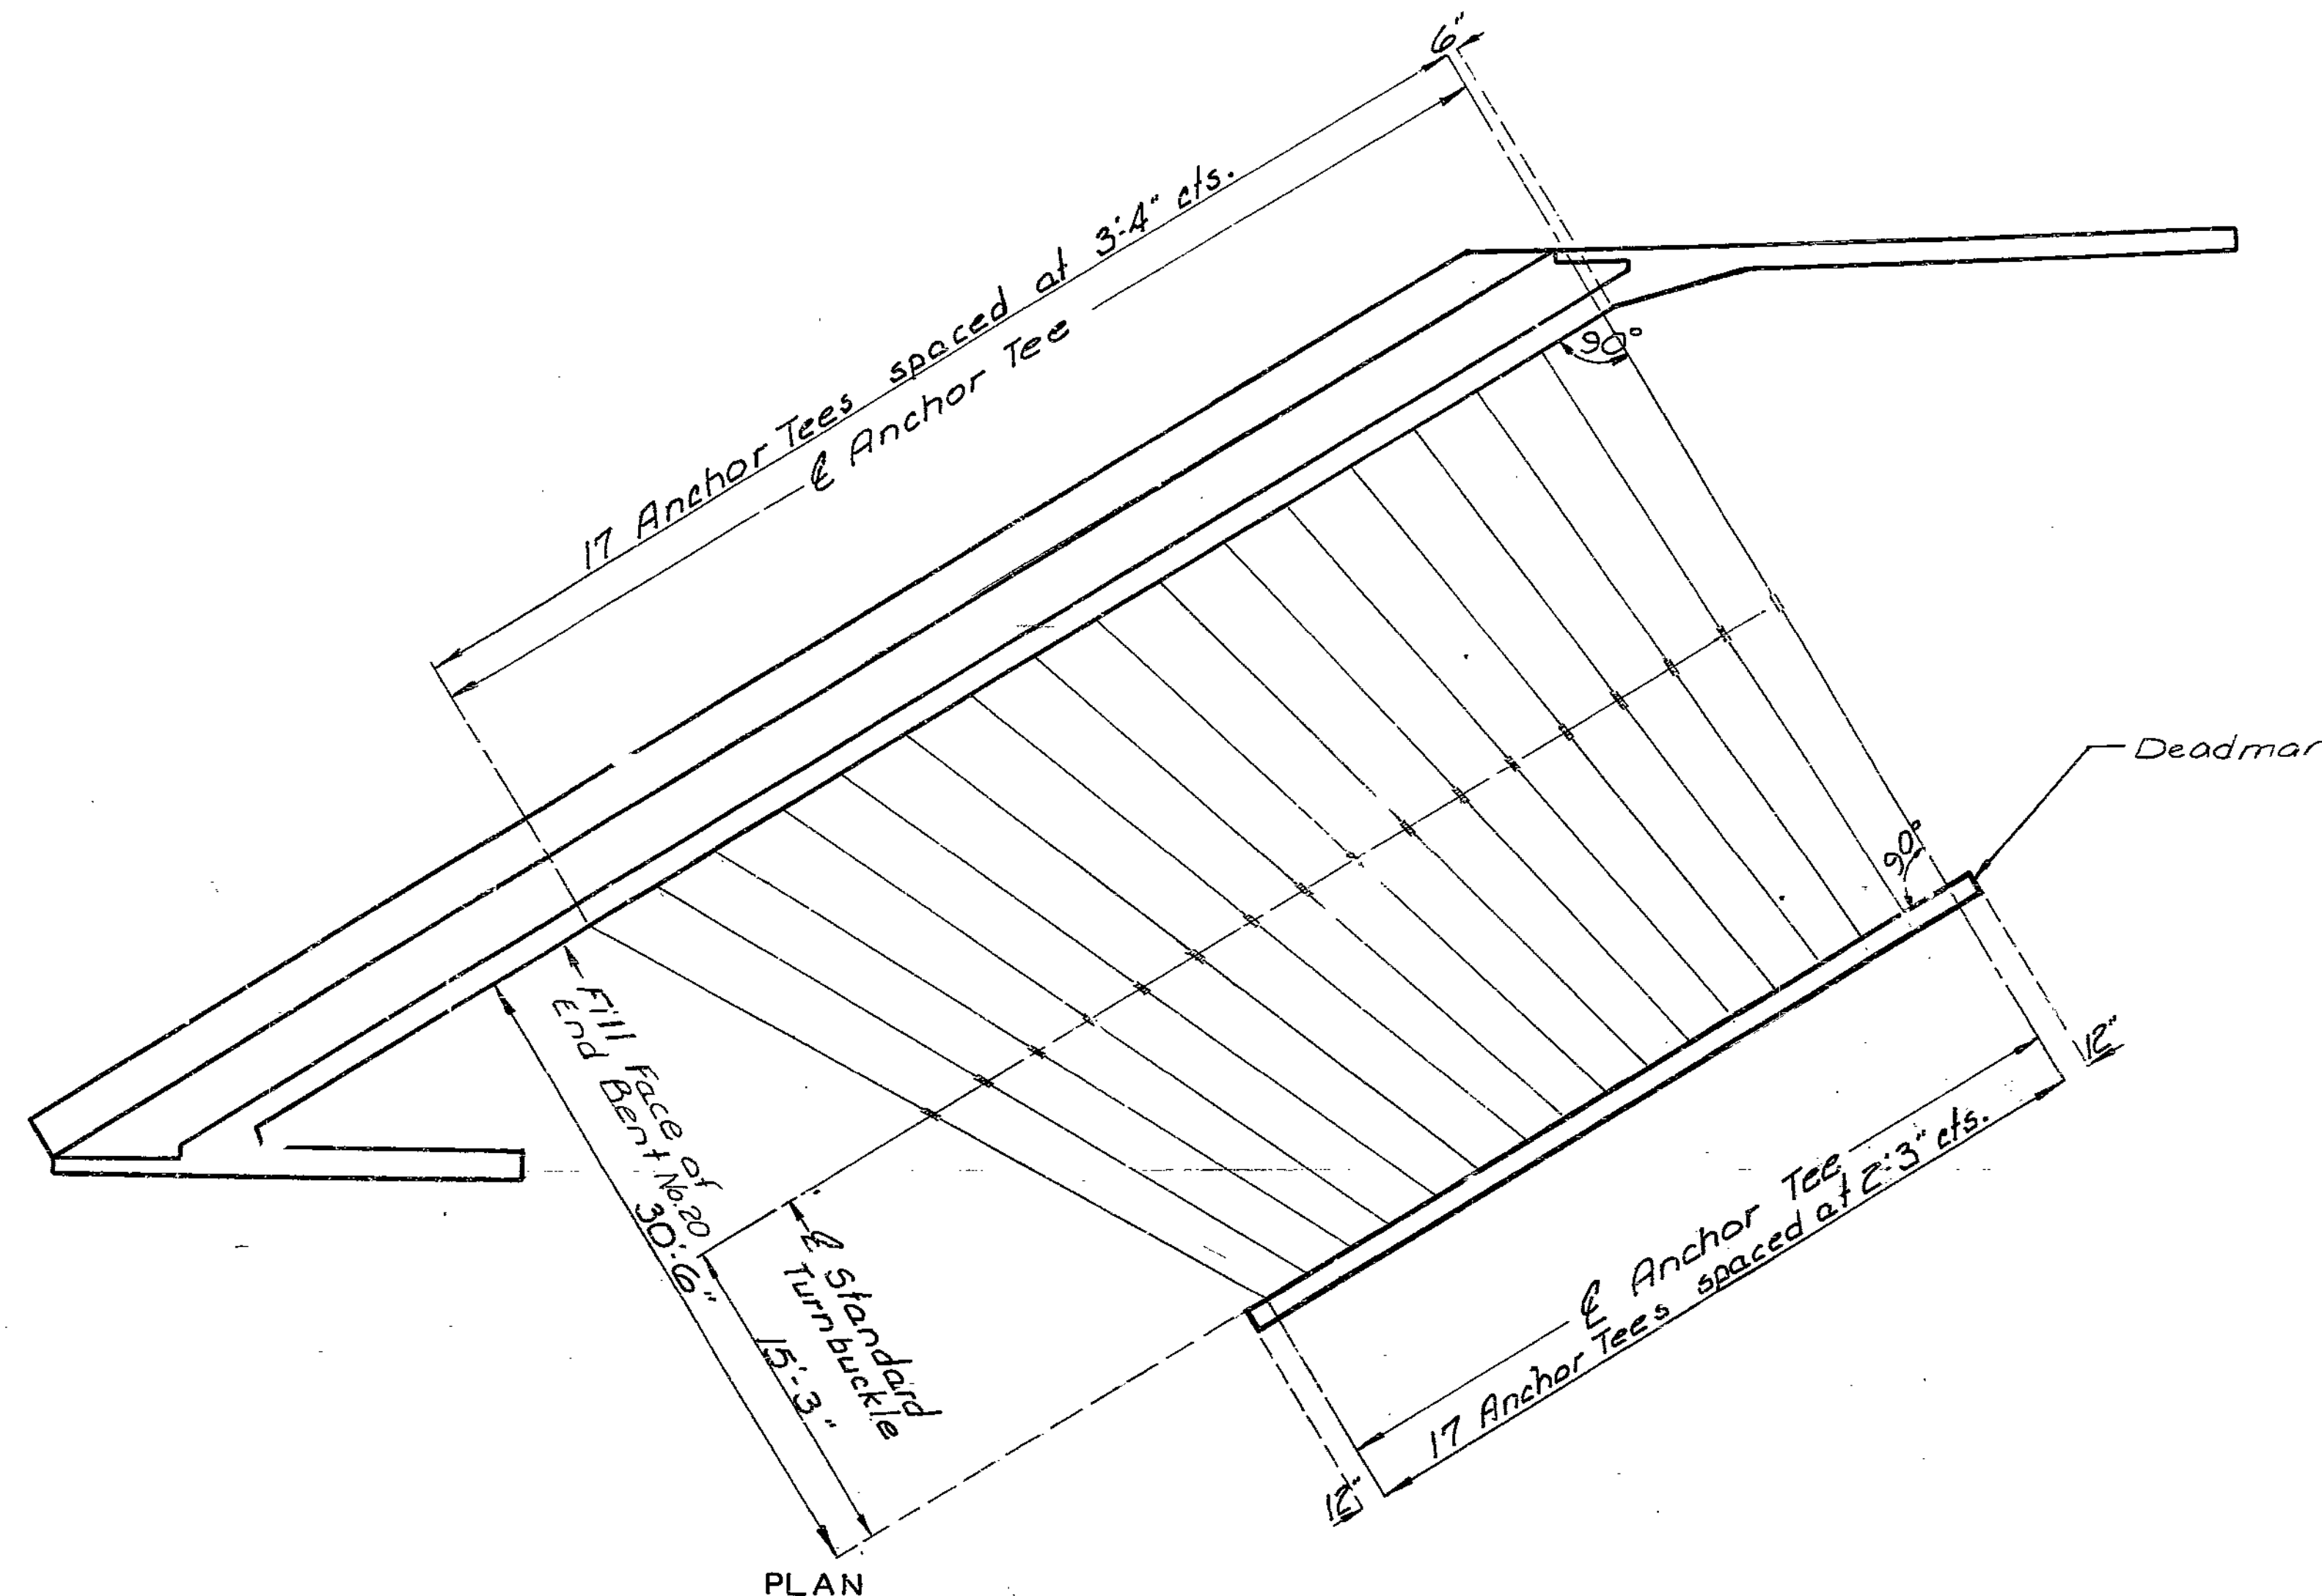



NOTES:

**CONSTRUCTION SEQUENCE:**  
 Construct End Bent with Anchor Tees in place.  
 Machine compact fill up to elevation of 1"  $\phi$  Rod and Turnbuckle.  
 Construct Dead Man with Anchor Tees in place.  
 Install 1"  $\phi$  Rod, Clevis and Turnbuckle assembly.  
 Tighten Turnbuckle until snug.  
 Hand compact fill for 12" (min.) over 1"  $\phi$  Rod and Turnbuckle.  
 Machine compact remaining fill.


BILL OF REINFORCING STEEL EACH DEAD MAN		
NUMBER	SIZE & MARK	LENGTH
8	#4-H4	37'-9"
152	#4-V4	21"

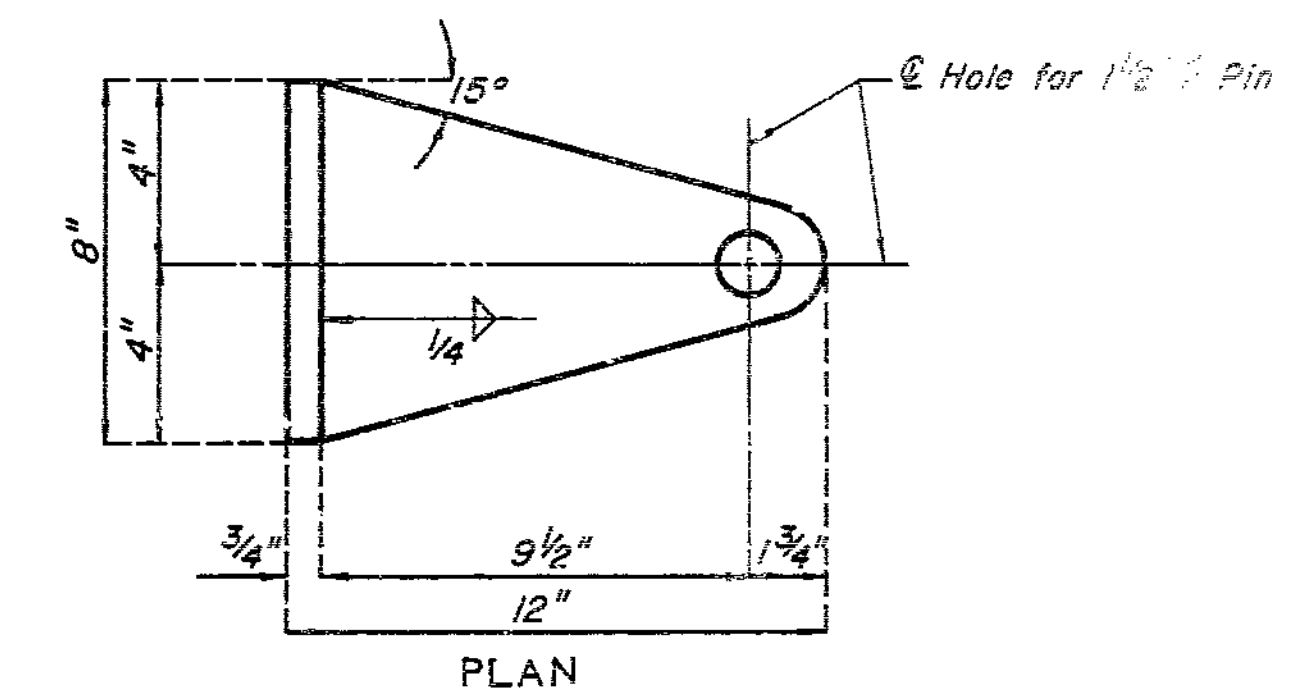


ELEVATION  
DETAIL OF ANCHOR TEE

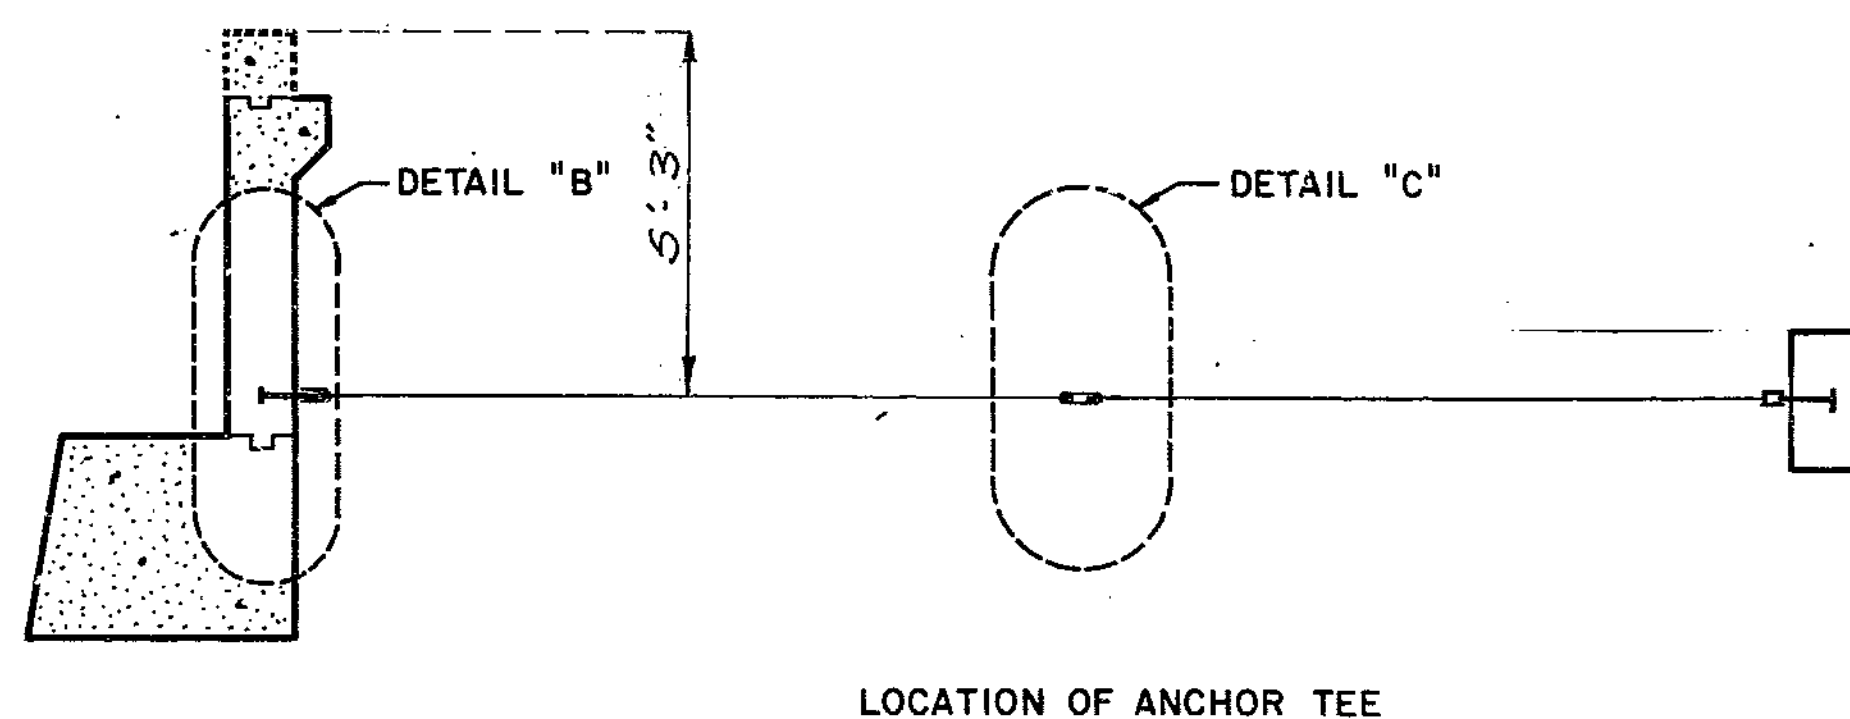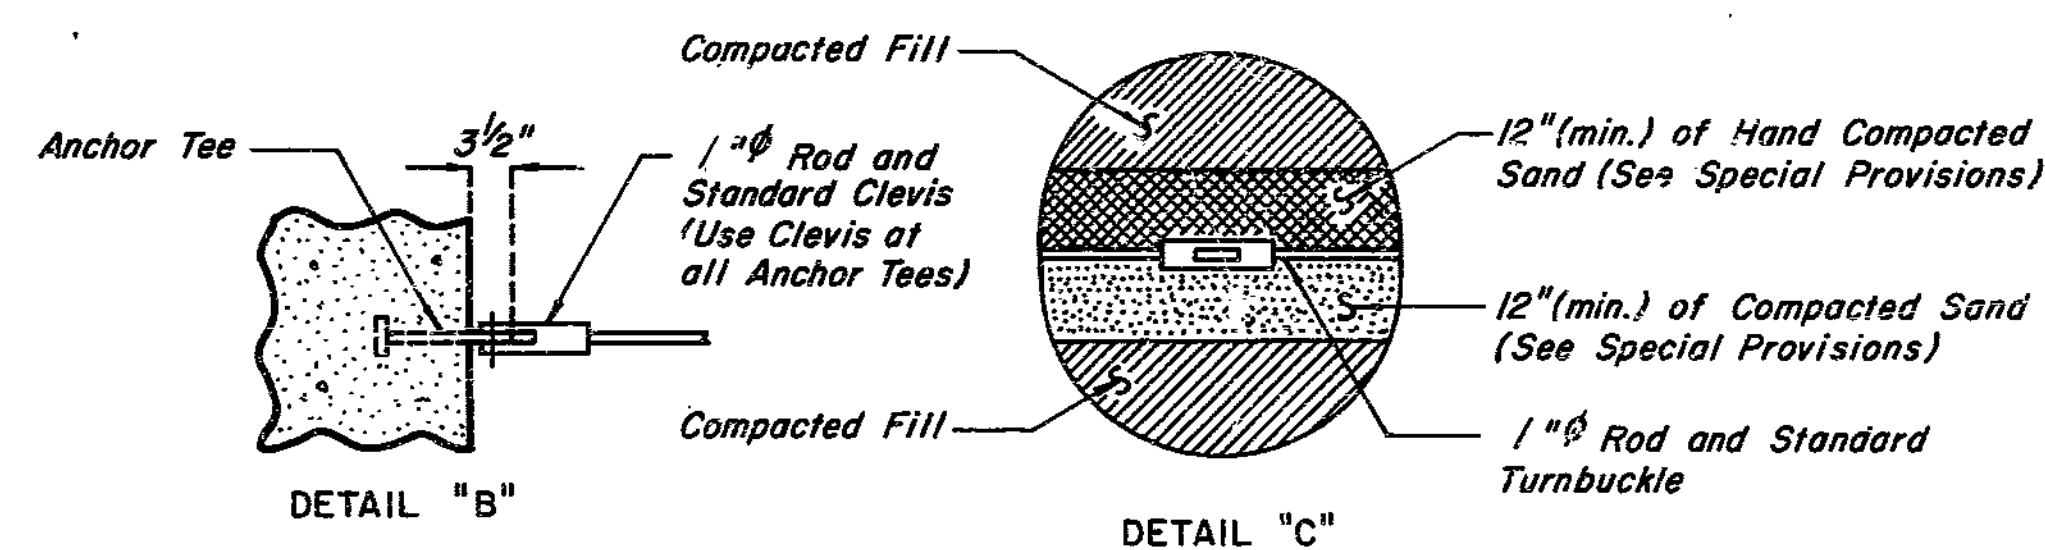

LOCATION OF ANCHOR TEE

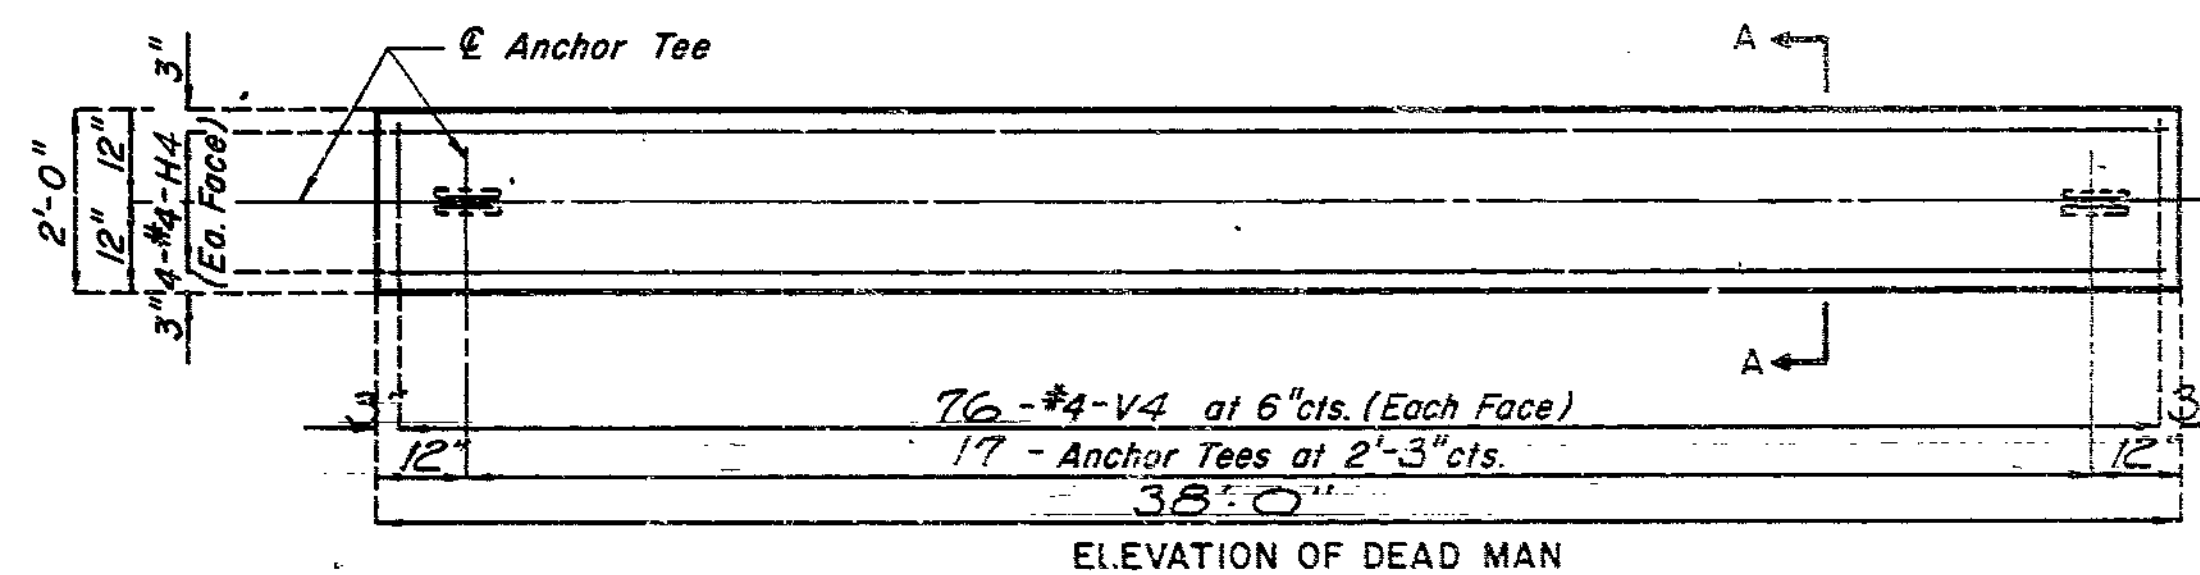

ELEVATION OF DEAD MAN

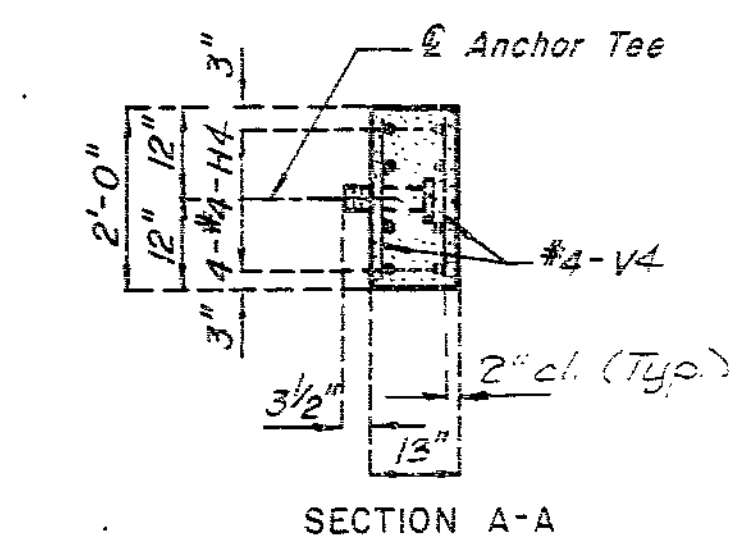

SECTION A-A

DETAILS OF DEAD MAN ANCHORAGE SYSTEM AT BENT NO. 20

Note: This drawing is not to scale. Follow dimensions.

Sheet No. 49 of 55


JACKSON COUNTY

A-2745

245 359


STD. D.M.A. REVISED  
 JULY 1984  
 DETAILED JUNE 1988  
 CHECKED Aug. 1983

STATE	PROJ. NO.	SHEET NO.
MO.		105

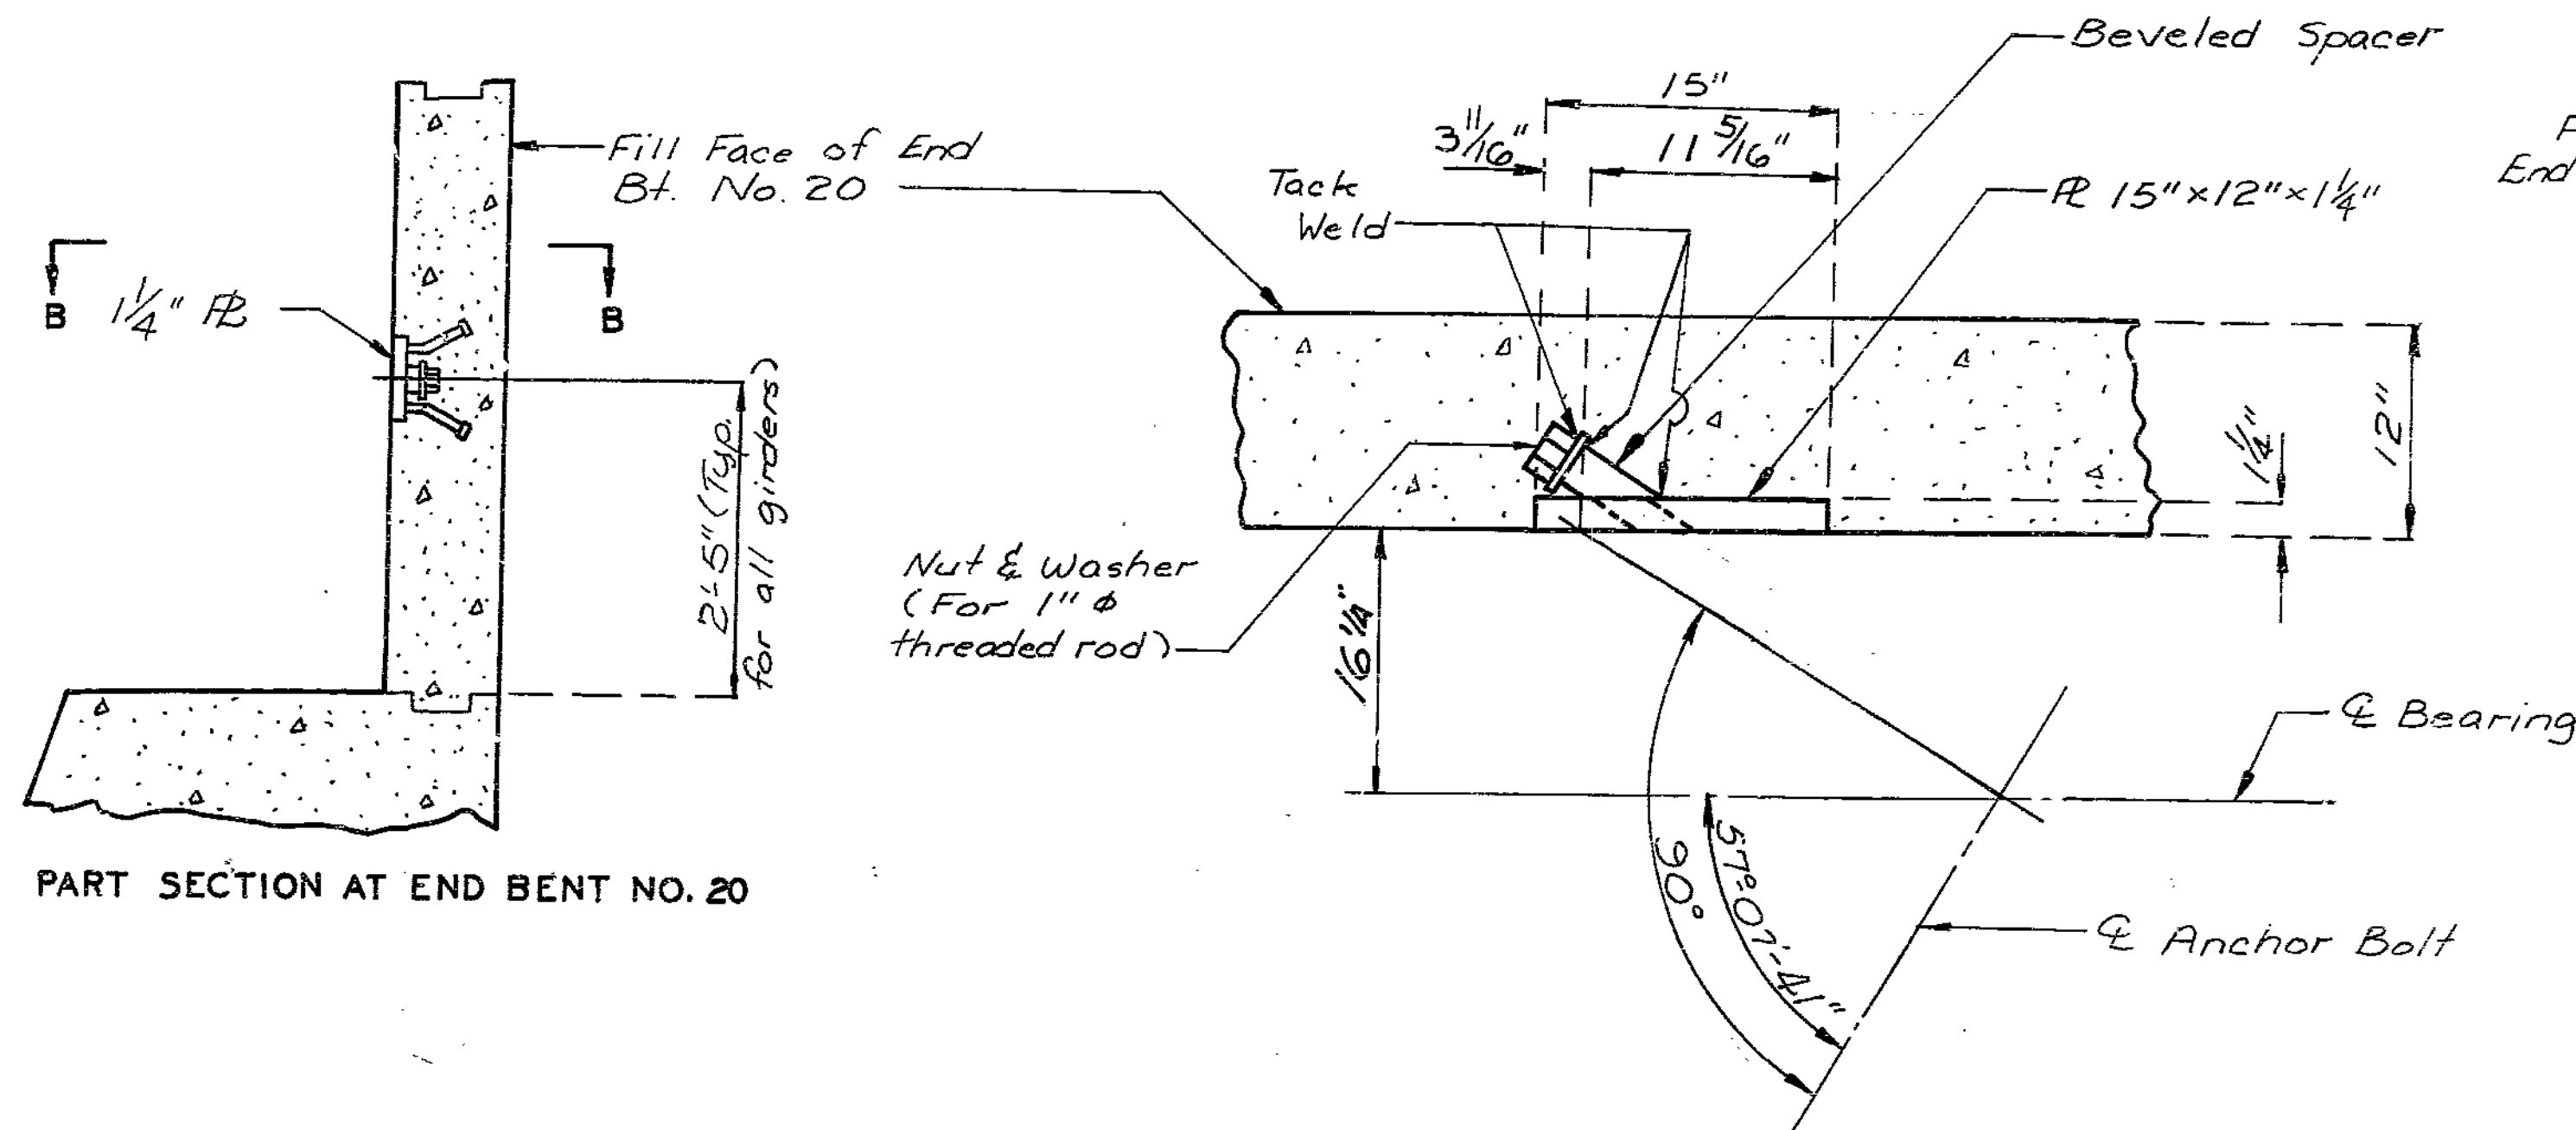


PART SECTION AT END BENT NO. 20


SECTION B-B (GDRS. NO. 1 & 5)

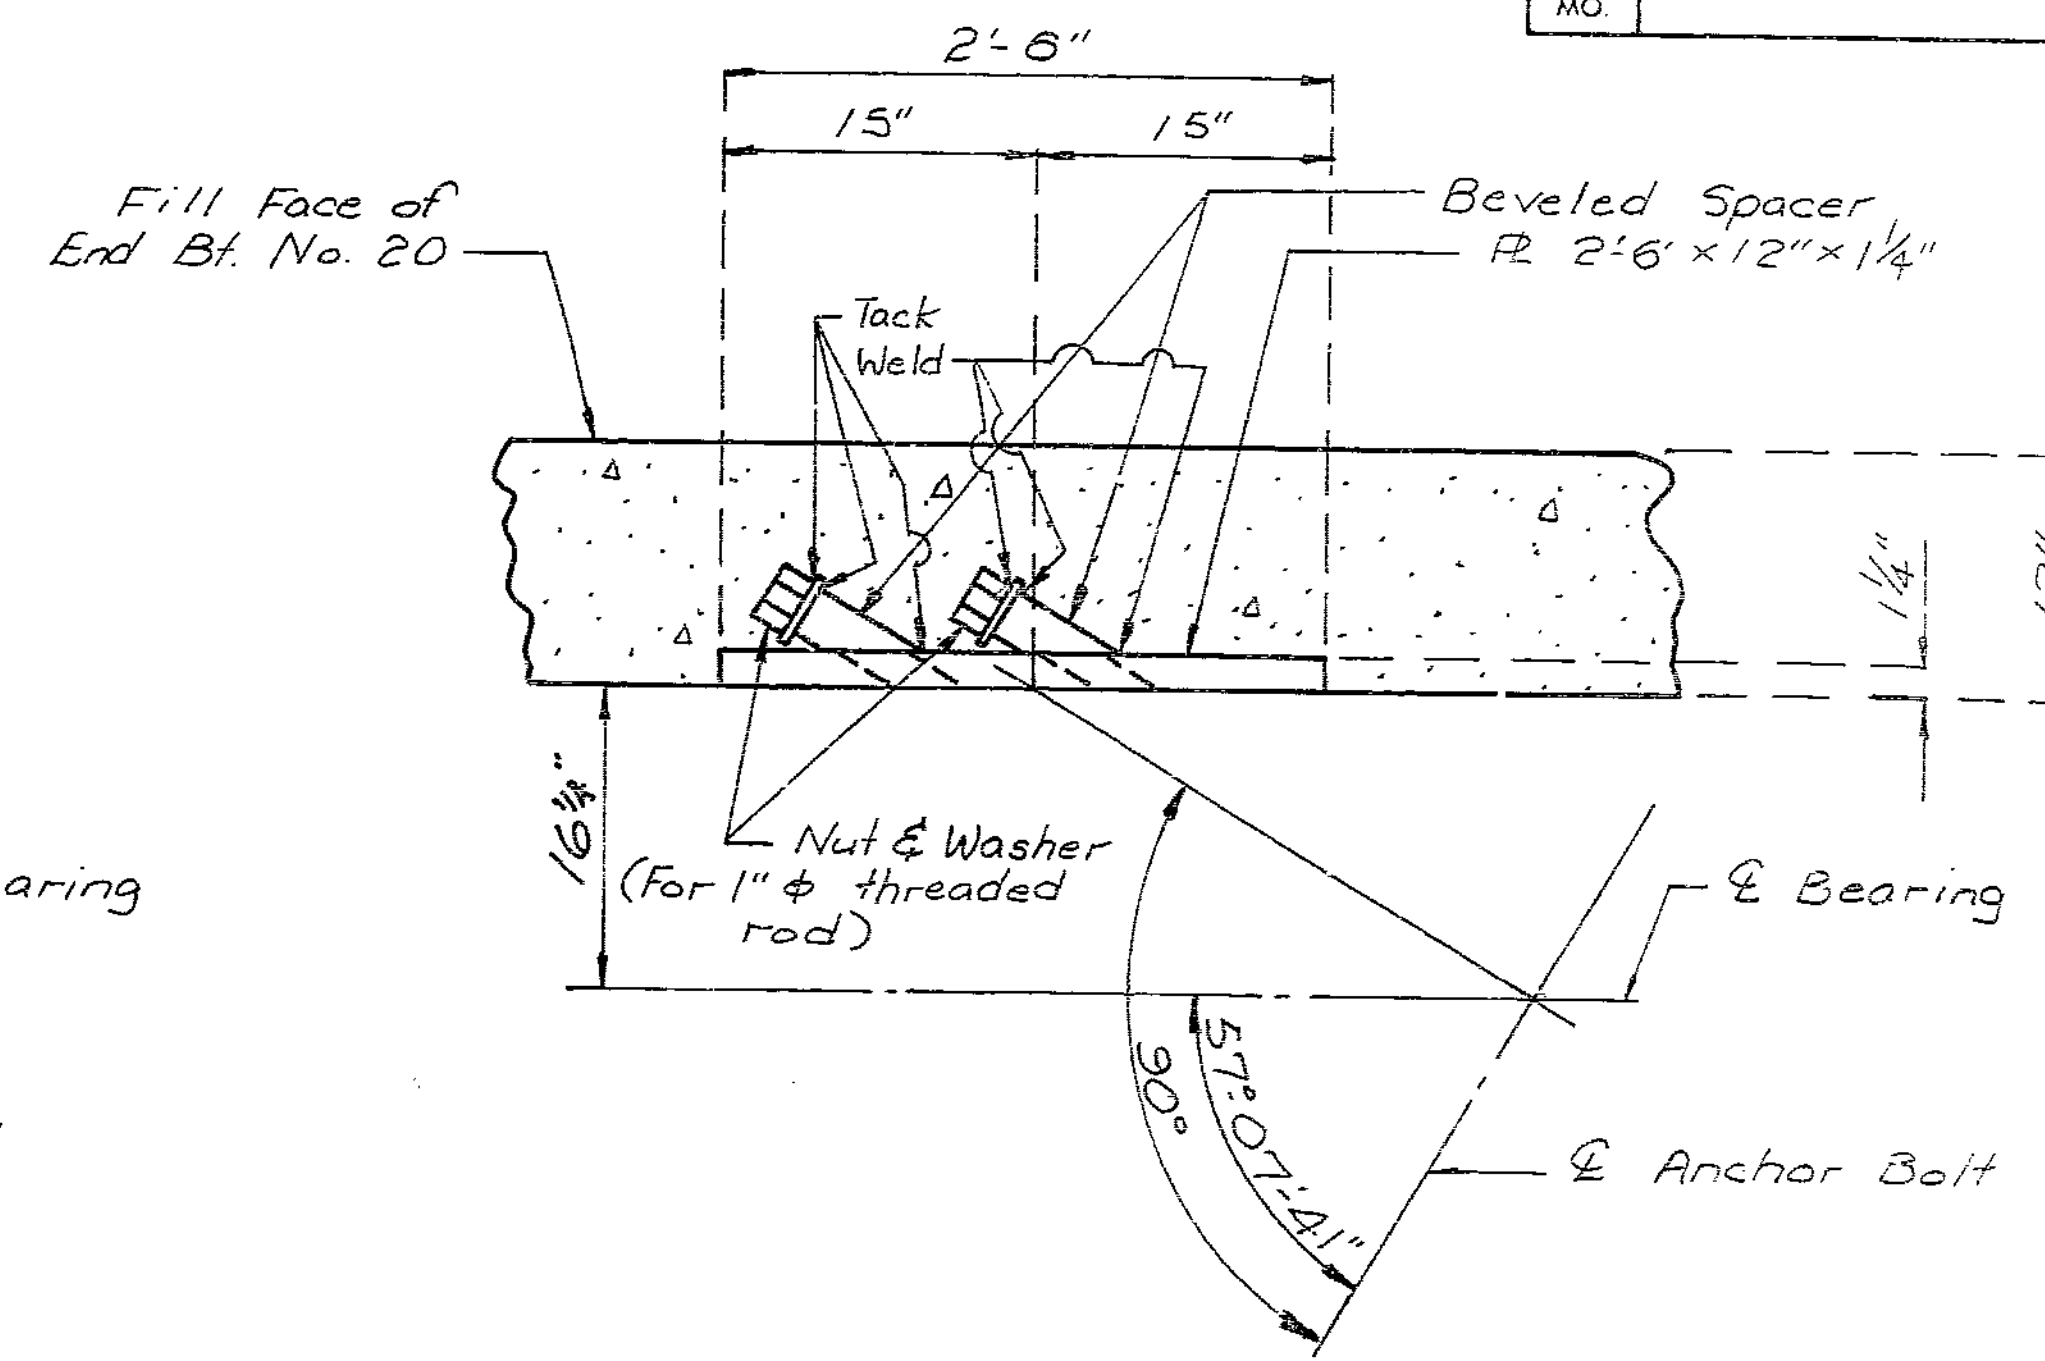


SECTION B-B (GDRS. NO. 2, 3 & 4)

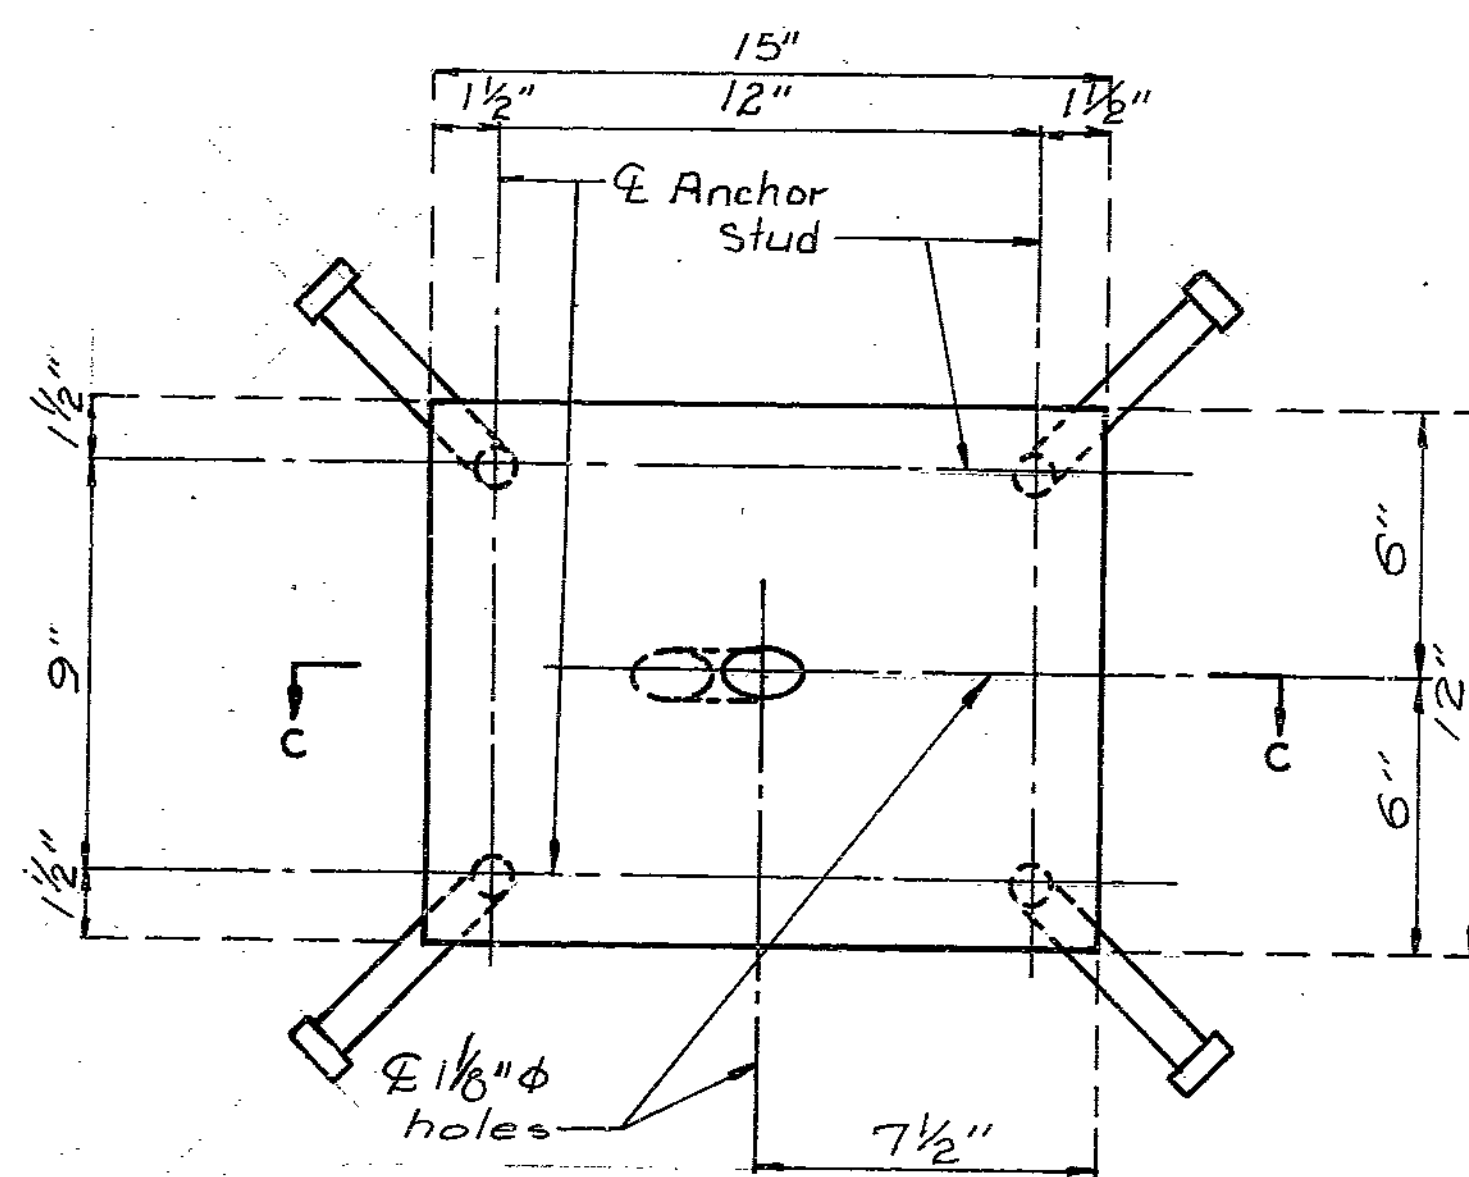


PLAN OF ANCHOR PLATE

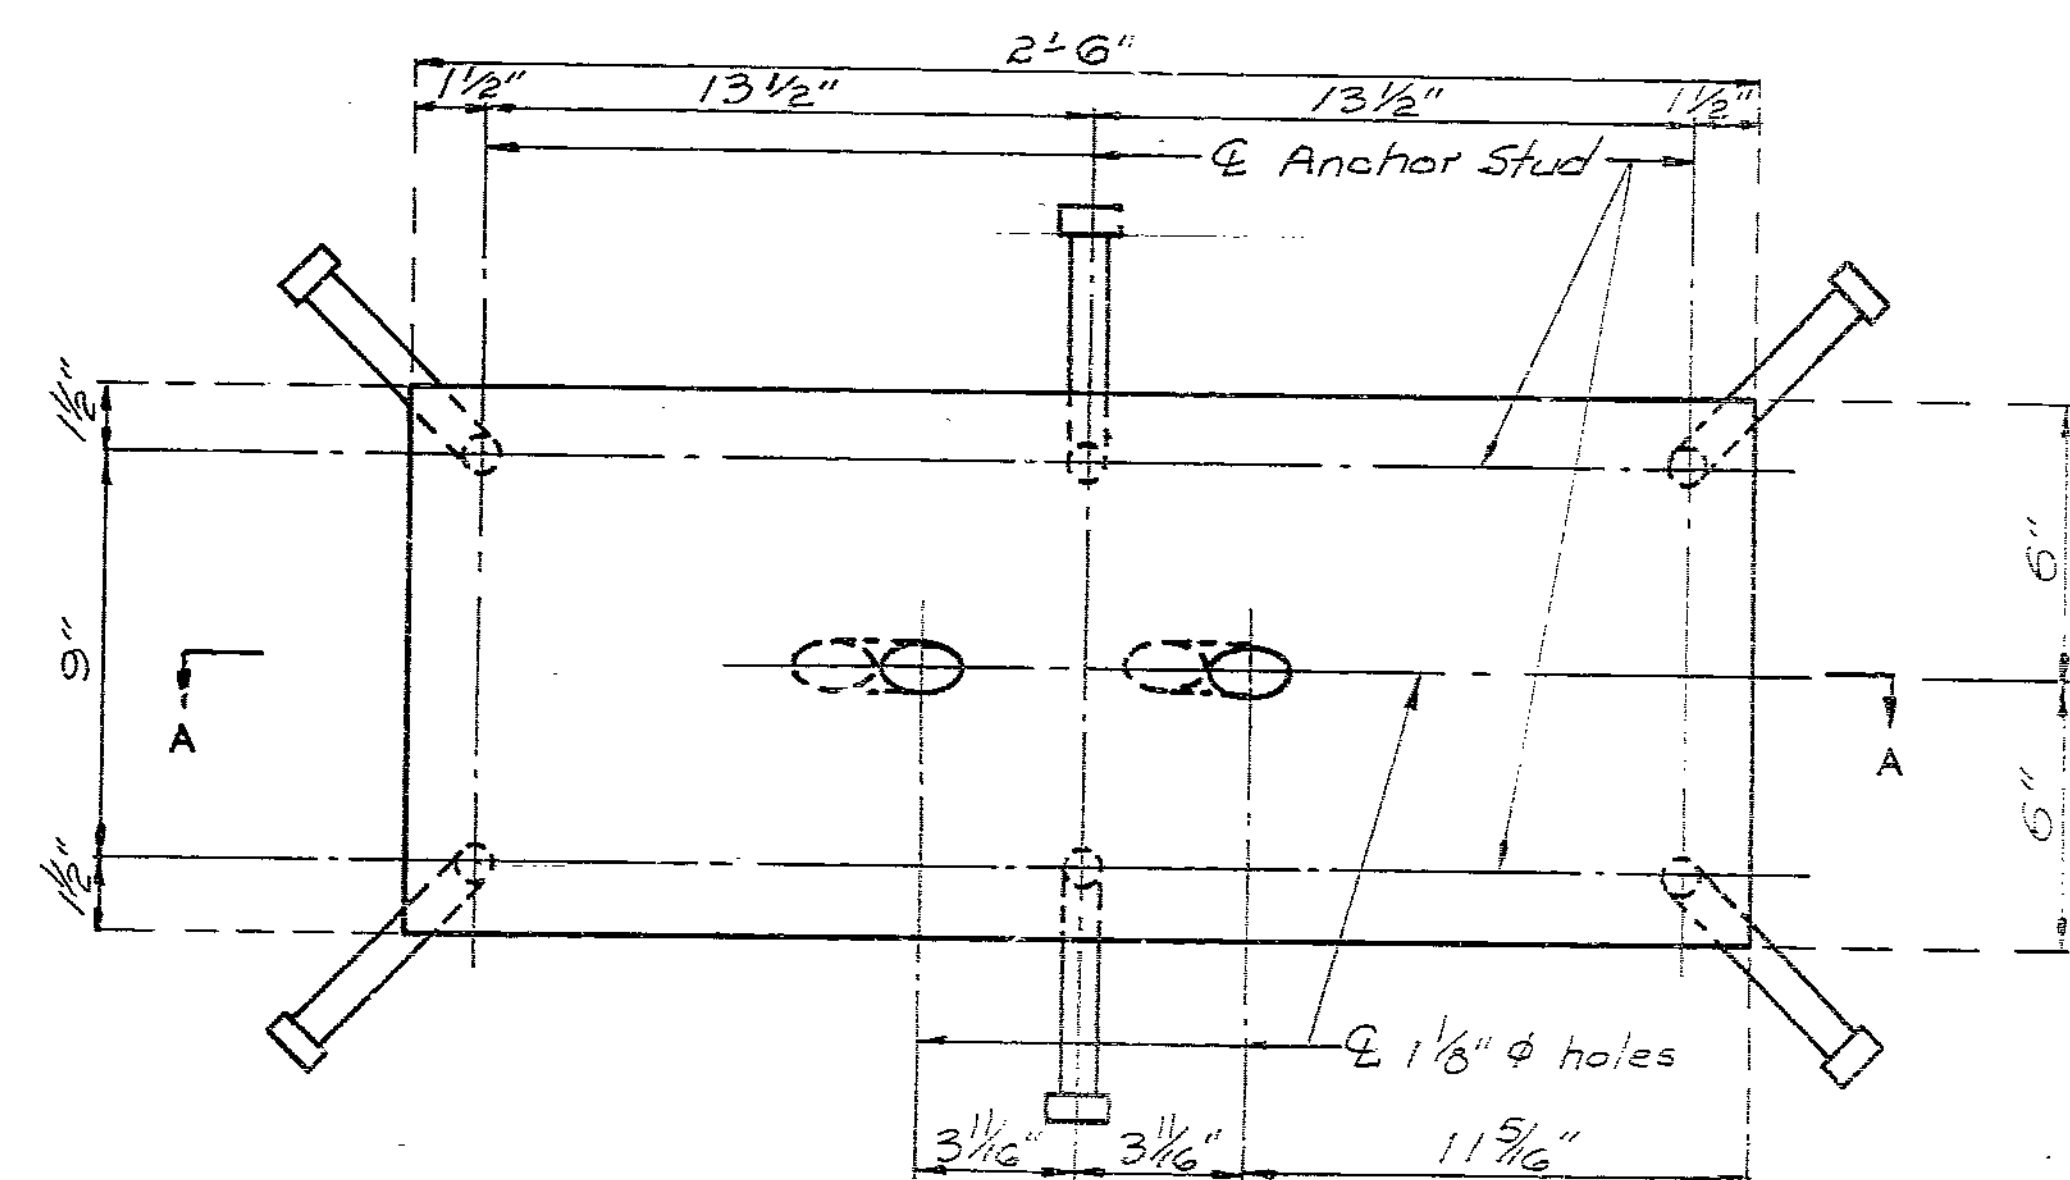

PLAN OF ANCHOR PLATE

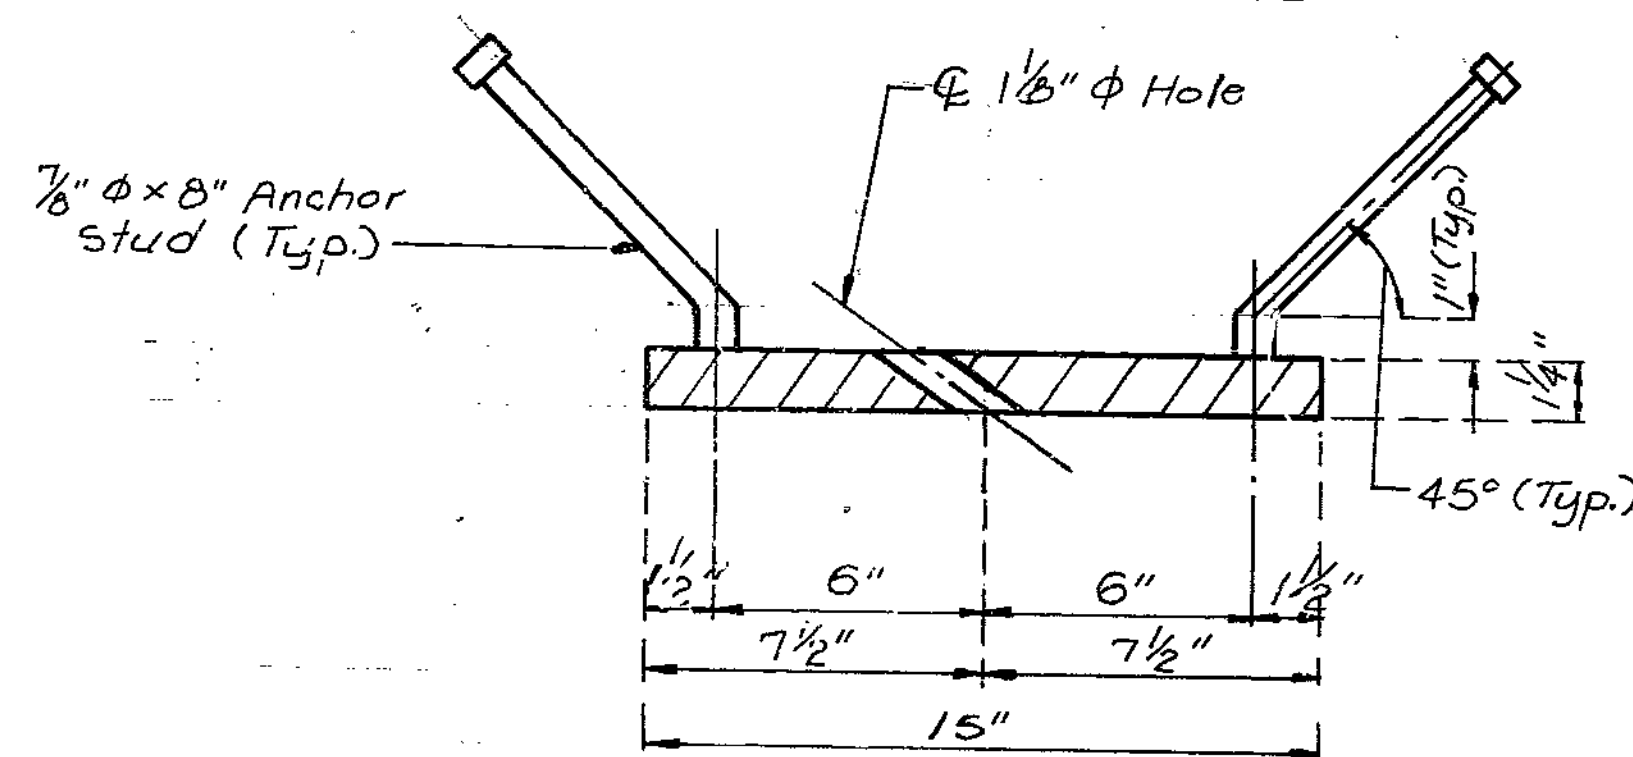

SECTION C-C

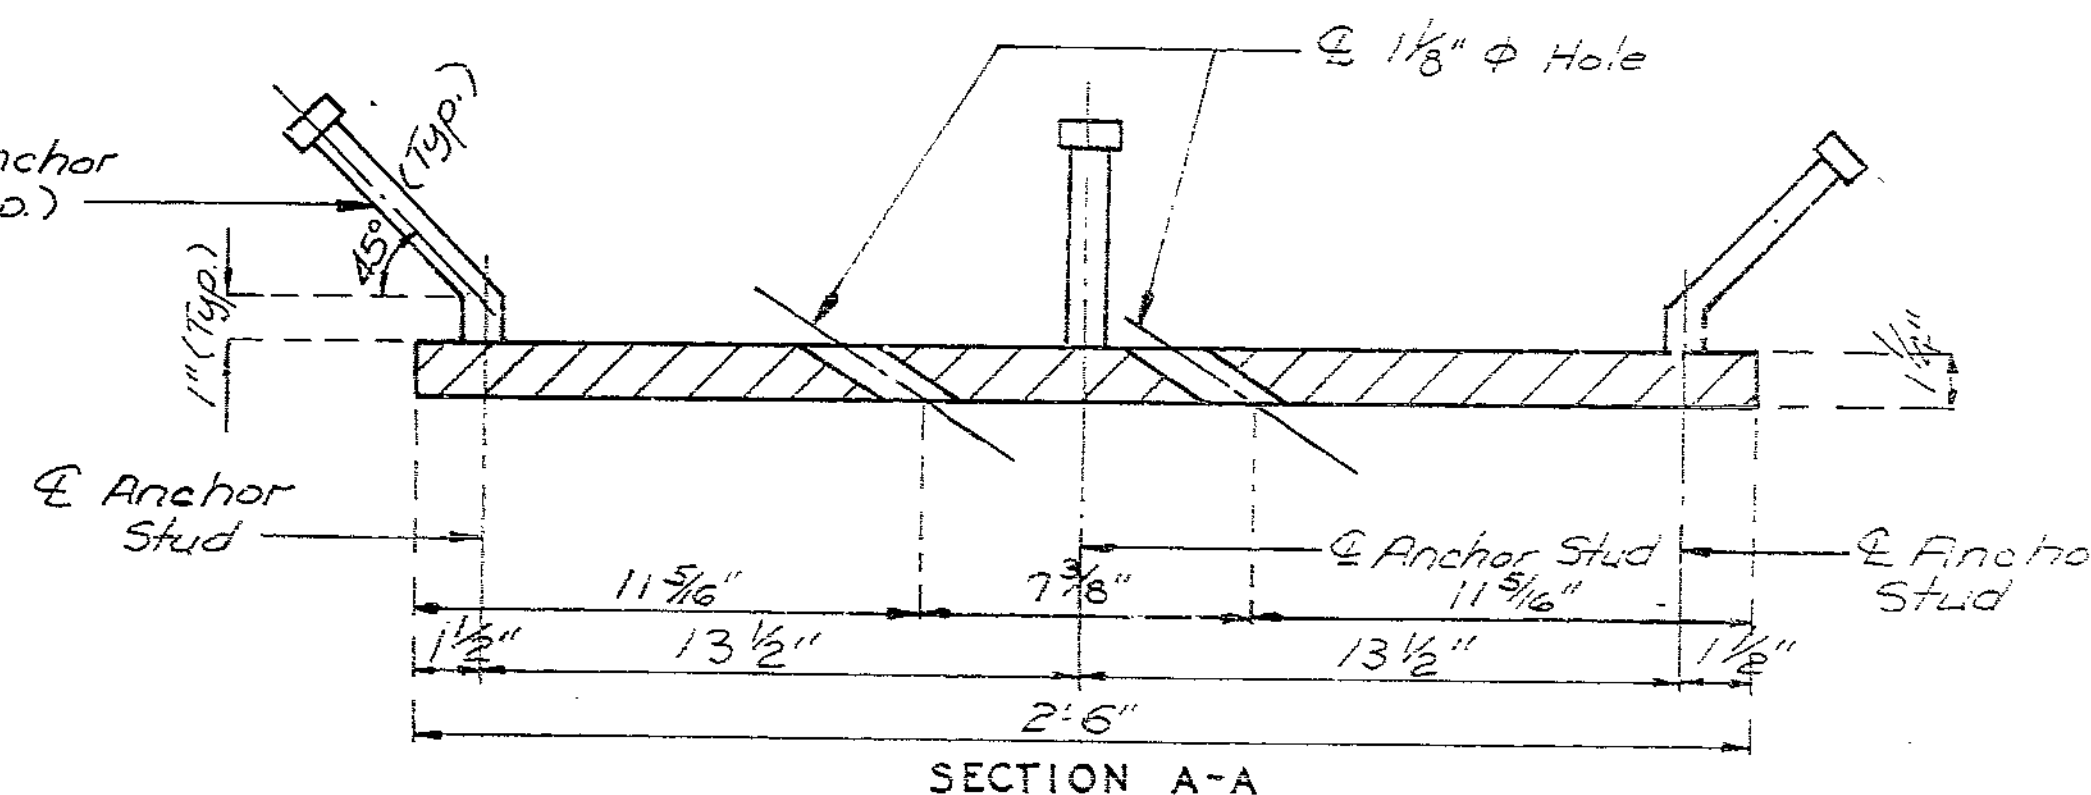

SECTION A-A

Notes:

- All plates shall be A36 steel.
- All nuts & washers shall be A-307 steel.
- Anchor studs shall be in accordance with Sec. 1037.
- Restrainer on girder No. 155 to be located on inside face of girder.
- Cost of furnishing and installing Earthquake Restraints is included in price bid for concrete.
- A temporary threaded plug shall be inserted into each embedded hex nut in the backwall before concrete is poured. Plugs shall extend 1/8" into backwall concrete. This temporary plug shall remain in place until installation of threaded rods by future contract.
- The earthquake restraint assemblies 7/8" x 8" Anchor Stud (Typ) shall be galvanized after fabrication in accordance with ASTM A123. The threads shall be protected during galvanizing.

DETAILS OF EARTHQUAKE RESTRAINTS AT BT. NO. 20

Note: This drawing is not to scale. Follow dimensions.

Sheet No. 50 of 55


JACKSON COUNTY

A-2745

846 360  
 DETAILED Aug. 1988  
 CHECKED Aug. 1988


COMPLETE BILL OF REINFORCING STEEL																								
NO. REQD.	MARK NO.	LOCATION	EPOXY	SHAPE NO.	STIRRUP	SUBSTR.	VARIES	DIMENSIONS										NOMINAL LENGTH	ACTUAL LENGTH	WEIGHT				
								B		C		D		E		F					H		K	
								FT.	IN.	FT.	IN.	FT.	IN.	FT.	IN.	FT.	IN.				FT.	IN.	FT.	IN.
END BENT NO. 1																								
2	6F1			23	X			14.000	4 11.875	14.000	8.750	10.875	8.750	10.875	7 4 7 3	22								
2	6F2			23	X			14.000	4 0.750	14.000	10.875	8.750	10.875	8.750	6 5 6 4	19								
10	6H1	BEAM		20	X			42 2.000							42 2 42 2	639								
16	6H2	WING		20	X	V	4	4 4.000							4 4 4 4									
INCR = 23.000 IN																								
								10 1.000							10 1 10 1	173								
2	6T1	WING		23	X			9 3.750	3 5.000				3 5.000	8 8.000	12 9 12 9	38								
2	6T2	WING		23	X			9 0.625	3 5.000				3 5.000	8 5.000	12 6 12 5	37								
30	5U1	BEAM		10	S	X		4 8.000	2 3.625						11 8 11 5	357								
12	4U2	BEAM		13	S	X		2 3.625	2 9.000	2 3.625	2 9.000				10 10 10 7	85								
13	4U3	BEAM		10	S	X		2 9.000	2 3.625						7 10 7 8	67								
28	6V1	WING		20	X	V	4	5 2.000							5 2 5 2									
INCR = 4.625 IN																								
				20	X			2 10.000							2 10 2 10	168								
4	6V2	WING		20	X			5 3.000							5 3 5 3	32								
INT. BENT NO. 2																								
16	6D20	BEAM		20	X			21.000							21 21	42								
12	6D21	FOOTING		10	X			3 3.000	16.000						7 10 7 6	139								
36	9D22	FOOTING & COLUMN		17	X			6 5.000							7 8 7 8	938								
12	6D23	FOOTING		10	X			3 8.000	16.000						8 8 8 4	150								
4	6H20	BEAM		20	X			38 10.000							38 10 38 10	233								
8	7H21	BEAM		7	X			4 0.000	2 9.750						9 6 9 6	159								
7	8H22	BEAM		20	X			38 10.000							38 10 38 10	726								
6	7H25	BEAM		18	X			40 2.000							41 10 41 10	513								
2	7H26	BEAM		18	X			38 10.000							40 6 40 6	166								
57	4P20	COLUMNS		16	X			2 9.000							9 6 9 6	362								
54	5U20	BEAM		13	S	X		2 11.000	3 3.000	2 11.000	3 3.000				13 3 12 11	727								
5	4U21	BEAM		10	S	X		6.000	2 11.000						3 11 3 9	12								
2	5U22	BEAM		13	S	X		2 10.000	3 3.000	2 10.000	3 3.000				13 1 12 9	27								
2	5U23	BEAM		13	S	X		2 5.000	3 3.000	2 5.000	3 3.000				12 3 11 11	25								
12	9V20	COLUMN		20	X			22 2.000							22 2 22 2	904								
12	9V21	COLUMN		20	X			21 11.000							21 11 21 11	894								
12	9V22	COLUMN		20	X			21 8.000							21 8 21 8	884								
INT. BENT NO. 3																								
16	6D20	BEAM		20	X			21.000							21 21	42								
12	6D21	FOOTING		10	X			3 3.000	16.000						7 10 7 6	139								
36	9D22	FOOTING & COLUMN		17	X			6 5.000							7 8 7 8	938								
12	6D23	FOOTING		10	X			3 8.000	16.000						8 8 8 4	150								
4	6H20	BEAM		20	X			38 10.000							38 10 38 10	233								
8	7H21	BEAM		7	X			4 0.000	2 9.750						9 6 9 6	159								
7	8H22	BEAM		20	X			38 10.000							38 10 38 10	726								
6	7H25	BEAM		18	X			40 2.000							41 10 41 10	513								
2	7H26	BEAM		18	X			38 10.000							40 6 40 6	166								

COMPLETE BILL OF REINFORCING STEEL																								
NO. REQD.	MARK NO.	LOCATION	EPOXY	SHAPE NO.	STIRRUP	SUBSTR.	VARIES	DIMENSIONS										NOMINAL LENGTH	ACTUAL LENGTH	WEIGHT				
								B		C		D		E		F					H		K	
								FT.	IN.	FT.	IN.	FT.	IN.	FT.	IN.	FT.	IN.				FT.	IN.	FT.	IN.
69	6P20	COLUMNS		16	X			2 9.000								9 6 9 6	438							
54	5U20	BEAM		13	S	X		2 11.000	3 3.000	2 11.000	3 3.000				13 3 12 11	727								
5	4U21	BEAM		10	S	X		6.000	2 11.000						3 11 3 9	12								
2	5U22	BEAM		13	S	X		2 10.000	3 3.000	2 10.000	3 3.000				13 1 12 9	27								
2	5U23	BEAM		13	S	X		2 5.000	3 3.000	2 5.000	3 3.000				12 3 11 11	25								
12	9V30	COLUMN		20	X			25 10.000							25 10 25 10	1056								
12	9V31	COLUMN		20	X			25 7.000							25 7 25 7	1044								
12	9V32	COLUMN		20	X			25 4.000							25 4 25 4	1034								
BENT NO. 4																								
24	6D4C	FOOTING		10	X			3 7.000	16.000						8 6 6 2	294								
33	9D4I	FTG. AND COL.		17	X			6 5.000							7 8 7 8	860								
8	7H40	BEAM		16	X			4 3.000	3 3.750						14 10 14 10	243								
2	7H41	BEAM		18	X			37 8.000							39 4 39 4	161								
6	7H42	BEAM		18	X			39 4.000							41 0 41 0	503								
4	6H43	BEAM		20	X			37 8.000							37 8 37 8	226								
8	7H44	BEAM		20	X			37 8.000							37 8 37 8	616								
69	4P40	COLUMN		16	X			2 9.000							9 6 9 6	438								
48	5U40	BEAM		13	S	X		3 5.000	3 6.000	3 5.000	3 6.000				14 9 14 9	722								
11	4U41	BEAM		10	S	X		6.000	3 5.000						4 5 4 3	31								
2	5U42	BEAM		13	S	X		2 9.000	3 6.000	2 9.000	3 6.000				13 5 13 1	27								
2	5U43	BEAM		13	S	X		3 4.500	3 6.000	3 4.500	3 6.000				14 8 14 4	30								
11	9V40	COLUMN		20	X			25 5.000							25 5 25 5	951								
11	9V41	COLUMN		20	X			25 7.000							25 7 25 7	957								
11	9V42	COLUMN		20	X			25 10.000							25 10 25 10	966								
20	2H41	BEAM		22	X			15.000	9.125						23 0 23 0	76								
BENT NO. 5																								
9	5D50	FOOTING		20	X			5 9.000							5 9 5 9	54								
12	6D51	FOOTING		20	X			6 9.000							6 9 6 9	122								
6	6D52	FOOTING		10	X			3 6.000	6 0.000						13 0 12 6	114								
33	9D53	FTG. AND COL.		17	X			6 5.000							7 8 7 8	860								
8	7H50	BEAM		7	X			4 0.000	2 9.750						9 6 9 6	159								
2	6H51	BEAM		20	X			38 0.000							30 0 38 0	114								
2	8H52	BEAM		18	X			38 0.000							39 10 39 10	213								
4	8H53	BEAM		18	X			39 9.000							41 7 41 7	344								
6	8H54	BEAM		20	X			38 0.000							38 0 38 0	609								
73	4P50	COLUMN		16	X			2 9.000							9 6 9 6	476								
58	5U50	BEAM		13	S	X		2 11.000	3 2.000	2 11.000	3 2.000				13 1 12 9	771								
3	4U51	BEAM		10	S	X		6.000	2 11.000						3 11 3 9	8								
2	5U52	BEAM		13	S	X		2 8.000	3 2.000	2 8.000	3 2.000				12 7 12 3	26								
16	6V50	BEAM		20	X			21.000							21 21	42								

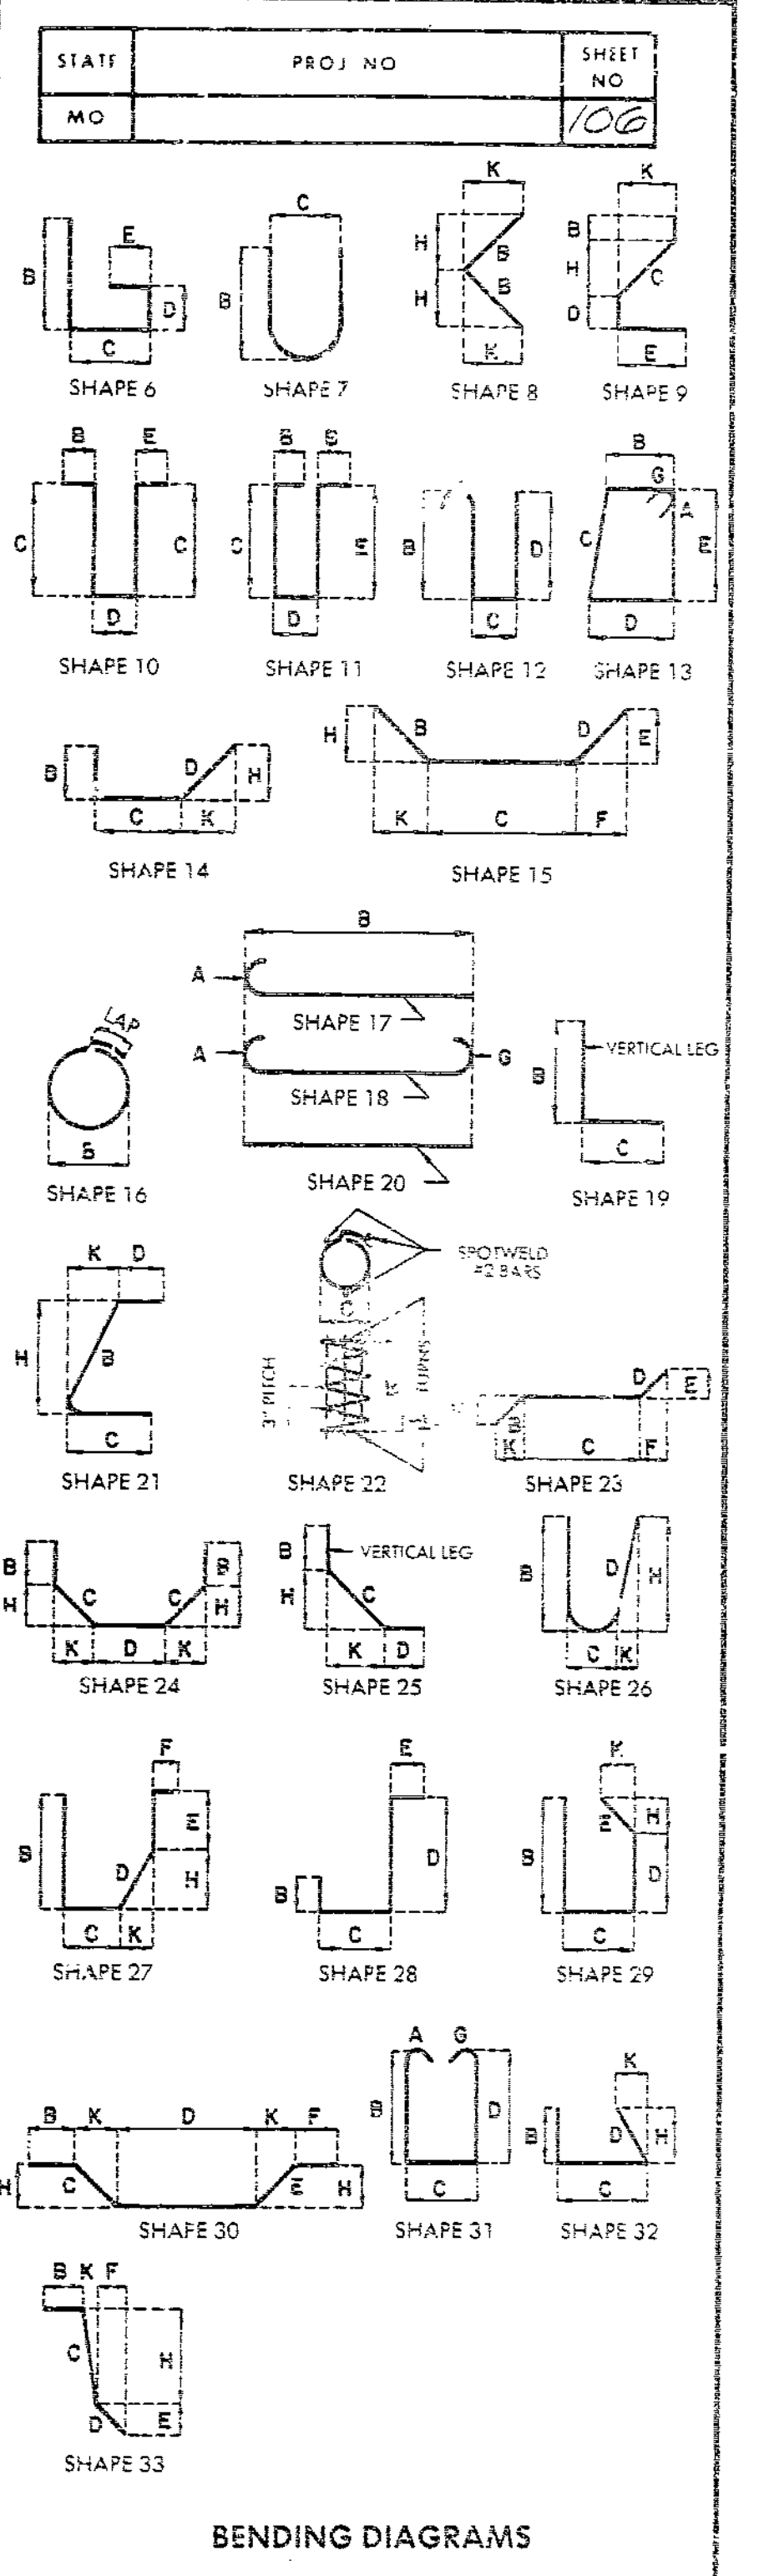


COMPLETE BILL OF REINFORCING STEEL																					
NO. REQD.	MARK NO.	LOCATION	EPOXY	SHAPE NO.	STIRRUP	SUBSTR.	VARIES	NO. EACH	DIMENSIONS								NOMINAL LENGTH	ACTUAL LENGTH	WEIGHT		
									B	C	D	E	F	H	K						
									FT.	IN.	FT.	IN.	FT.	IN.	FT.	IN.				FT.	IN.
11	9V51	COLUMN		20	X				27	6.000						27	6	27	6	1029	
11	9V52	COLUMN		20	X				27	9.000						27	9	27	9	1638	
11	9V53	COLUMN		20	X				27	11.000						27	11	27	11	1044	
INT. BENT NO. 6																					
12	8D60	FOOTING		20	X				11	9.000						11	9	11	9	376	
4	4D61	FOOTING		10	S	X				5	0.000	11	6.000			21	6	21	2	127	
22	6D62	FOOTING		20	X				8	9.000						8	9	8	9	289	
16	6D63	BEAM		20	X					21.000						21	21			42	
58	9D64	FOOTING		20	X				9	11.000						9	11	9	11	1956	
INT. BENT NO. 8																					
8	7H60	BEAM		7	X				4	5.500	3	9.500				11	0	11	0	180	
12	10H61	BEAM		20	X				38	6.000						38	6	38	6	1988	
4	6H62	BEAM		20	X				38	6.000						38	6	38	6	231	
4	10H63	BEAM		18	X				41	4.41	4	7.11				41	4	41	4	711	
4	10H64	BEAM		18	X				41	5.000						41	3	44	3	762	
60	4H65	TIE BEAM		20	X				22	9.000						22	9	22	9	912	
6	8H66	TIE BEAM		20	X				25	5.000						25	5	25	5	407	
INT. BENT NO. 7																					
38	4P60	COLUMN		16	X				4	9.000						15	9	15	9	884	
30	4P61	COLUMN		16	X				3	9.000						12	8	12	8	254	
INT. BENT NO. 9																					
12	8D60	FOOTING		20	X				11	9.000						11	9	11	9	376	
4	4D61	FOOTING		10	S	X				5	0.000	11	6.000			21	6	21	2	127	
22	6D62	FOOTING		20	X				8	9.000						8	9	8	9	289	
16	6D63	BEAM		20	X					21.000						21	21			42	
58	9D64	FOOTING		20	X				9	11.000						9	11	9	11	1956	
8	7H60	BEAM		7	X				4	5.500	3	9.500				11	0	11	0	180	
12	10H61	BEAM		20	X				38	6.000						38	6	38	6	1988	
4	6H62	BEAM		20	X				38	6.000						38	6	38	6	231	
4	10H63	BEAM		18	X				41	4.41	4	7.11				41	4	41	4	711	
4	10H64	BEAM		18	X				41	5.000						44	3	44	3	762	
60	4H65	TIE BEAM		20	X				22	9.000						22	9	22	9	912	
6	8H66	TIE BEAM		20	X				25	5.000						25	5	25	5	407	
84	4P60	COLUMN		16	X				4	9.000						15	9	15	9	884	
32	4P61	COLUMN		16	X				3	9.000						12	8	12	8	271	
38	4P60	COLUMN		16	X				4	9.000						15	9	15	9	884	
32	4P61	COLUMN		16	X				3	9.000						12	8	12	8	271	

COMPLETE BILL OF REINFORCING STEEL																					
NO. REQD.	MARK NO.	LOCATION	EPOXY	SHAPE NO.	STIRRUP	SUBSTR.	VARIES	NO. EACH	DIMENSIONS								NOMINAL LENGTH	ACTUAL LENGTH	WEIGHT		
									B	C	D	E	F	H	K						
									FT.	IN.	FT.	IN.	FT.	IN.	FT.	IN.				FT.	IN.
36	6U61	BEAM		13	S	X			2	7.000	3	9.000	2	7.000	3	9.000	14	0	13	6	730
2	6U62	BEAM		13	S	X			3	9.000	3	9.000	3	9.000	3	9.000	16	4	15	10	48
2	6U63	BEAM		13	S	X			2	6.000	3	9.000	2	6.000	3	9.000	13	10	13	4	40
3	4U64	BEAM		10	S	X				6.000	3	11.000				4	11	4	9	10	
2	6U65	BEAM		13	S	X			3	4.000	3	9.000	3	4.000	3	9.000	15	6	15	0	45
INT. BENT NO. 8																					
58	9V60	COLUMN		20	X				29	9.000						29	9	29	9	5867	
42	4V61	TIE BEAM		10	S	X				20.000	29	9.000				33	1	32	11	924	
23	8V64	COLUMN		20	X				18	6.000						18	6	18	6	1136	
46	8V65	COLUMN		20	X				9	8.000						9	8	9	8	1187	
58	9V66	COLUMN		20	X				18	3.000						18	3	18	3	3599	
23	8V67	COLUMN		20	X				18	2.000						18	2	18	2	1116	
INT. BENT NO. 9																					
48	9D80	COLUMN & FOOTING		20	X				8	0.000						8	0	8	0	1306	
6	6D81	FOOTINGS		10	S	X				4	10.000	8	3.000			17	11	17	7	158	
18	5D82	FOOTINGS		20	X				7	9.000						7	9	7	9	145	
18	6D83	FOOTINGS		20	X				9	0.000						9	0	9	0	243	
16	6D84	BEAM		20	X					21.000						21	21			42	
5	9H80	BEAM		20	X				40	8.000						40	8	40	8	491	
4	4H81	BEAM		20	X				40	8.000						40	8	40	8	244	
6	8H82	BEAM		17	X				13	8.000						14	7	14	7	234	
4	8H83	BEAM		18	X				40	8.000						42	6	42	6	454	
8	7H84	BEAM		7	X				4	3.000	3	3.750				10	3	10	3	168	
126	4P80	COLUMNS		16	X				3	3.000						11	1	11	1	933	
56	5U80	BEAM		13	S	X			3	5.000	3	9.000	3	5.000	3	9.000	15	3	14	11	471
3	4U81	BEAM		10	S	X				6.000	3	5.000				4	5	4	5	9	
2	5U82	BEAM		13	S	X			2	7.750	3	9.000	2	7.750	3	9.000	13	9	13	5	28
2	5U83	BEAM		13	S	X			3	2.500	3	9.000	3	2.500	3	9.000	14	10	14	6	30
48	9V80	COLUMN		20	X				25	0.000						25	0	25	0	4080	
16	9V81	COLUMN		20	X				24	5.000						24	5	24	5	1328	
16	9V82	COLUMN		20	X				24	7.000						24	7	24	7	1337	
16	9V83	COLUMN		20	X				24	9.000						24	9	24	9	1346	
INT. BENT NO. 9																					
38	9D90	COLUMN & FOOTING		20	X				8	0.000						8	0	8	0	1034	
4	6D92	FOOTING		10	S	X				3	9.000	8	3.000			15	9	15	5	93	
8	6D93	FOOTING		20	X				8	3.000						8	3	8	3	99	
12	5D94	FOOTING		20	X				6	3.000						6	3	6	3	78	
8	9H90	BEAM		20	X				40	6.000						40	6	40	6	1102	
4	6H91	BEAM		20	X				40	6.000						40	6	40	6	243	
4	9H92	BEAM		18	X				40	6.000						43	0	43	0	585	
4	9H93	BEAM		18	X				42	10.000						45	4	45	4	617	
8	7H94	BEAM		7	X				4	11.000	4	5.750				12	3	12	3	200	
82	4P90	COLUMNS		16	X				3	9.000						12	8	12	8	394	
47	5U90	BEAM		13	S	X			4	7.000	4	7.000	4	7.000	4	7.000	19	3	18	11	929
2	5U91	BEAM		13	S	X			4	4.000	4	7.000	4	4.000	4	7.000	18	9	18	5	38
2	5U92	BEAM		13	S	X			3	1.000	4	7.000	3	1.000	4	7.000	16	3	15	11	33


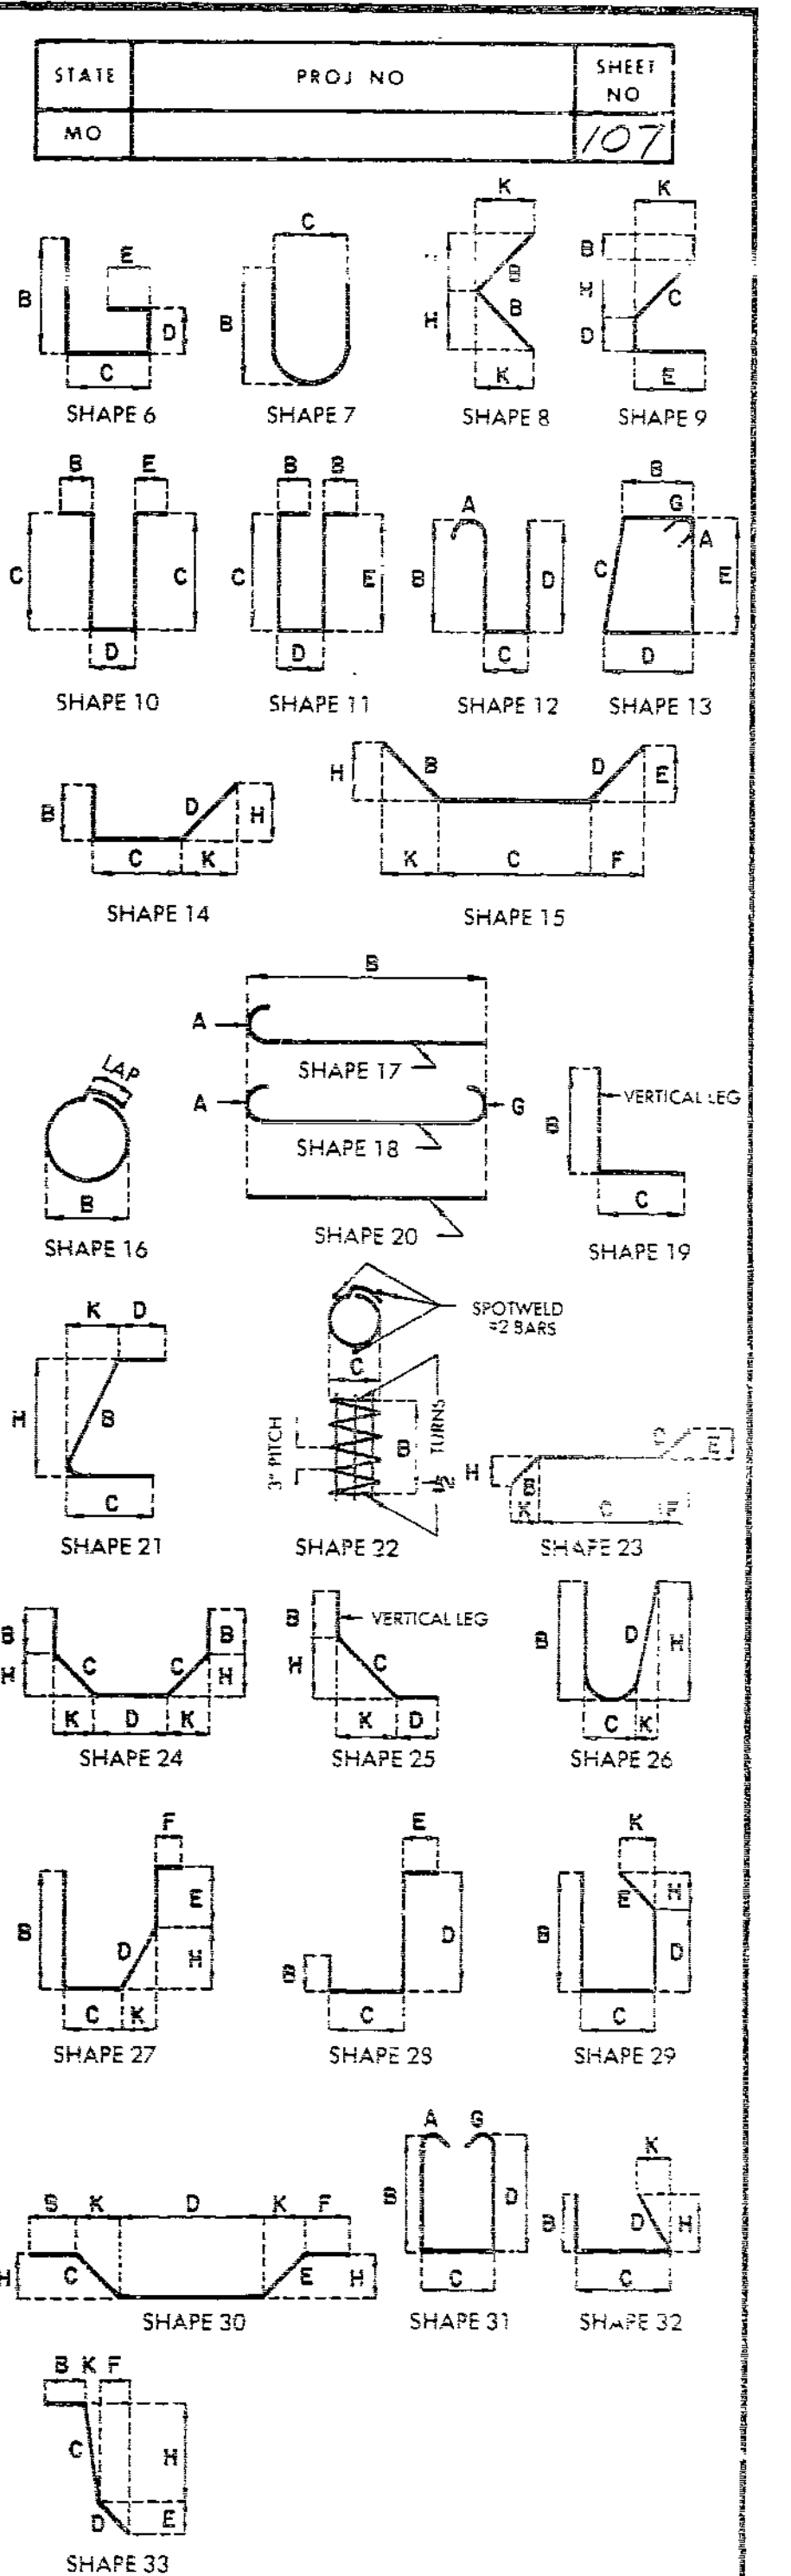


BENDING DIAGRAMS

362  
368

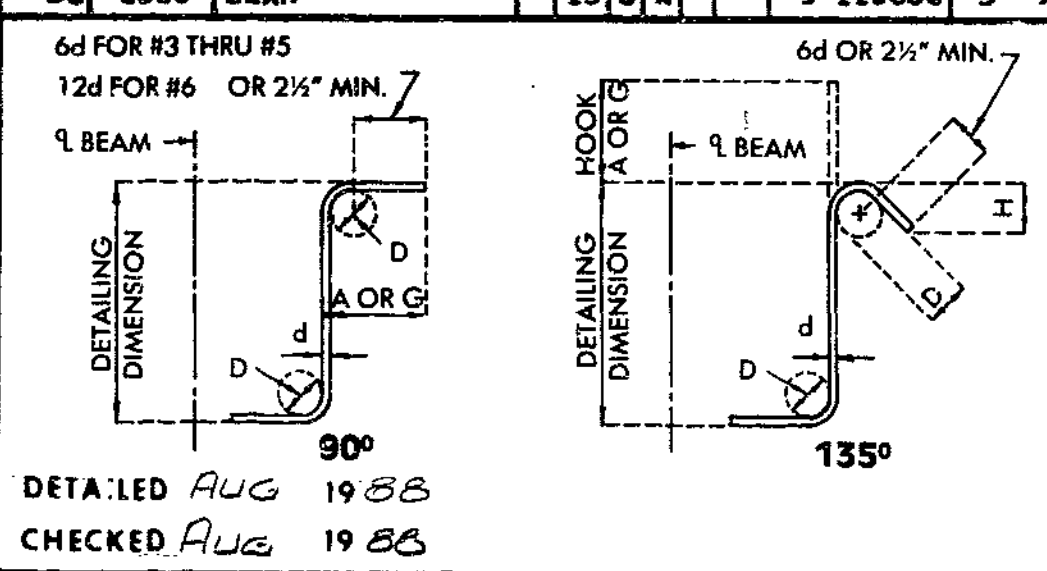

STIRRUP HOOK DIMENSIONS				
GRADES 40-50-60 KSI				
BAR SIZE	D (IN.)	90° HOOK		135° HOOK
		A O R G	A O R G	APPROX. H
#3	1 1/4"	4"	4"	2 1/2"
#4	2"	4 1/2"	4 1/2"	3"
#5	2 1/2"	6"	5 1/2"	3 3/4"
#6	4 1/2"	12"	7 1/2"	4 1/2"

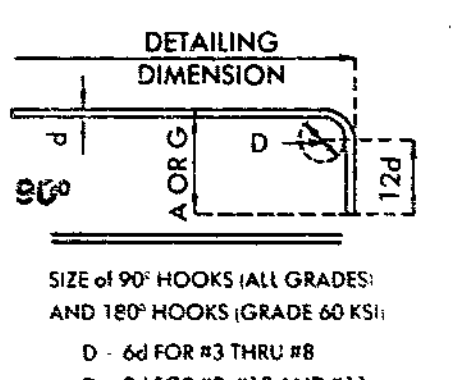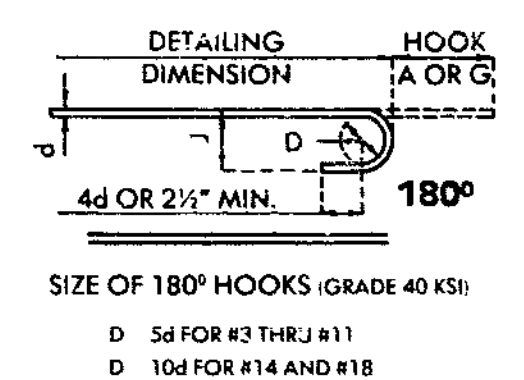

NOTE: UNLESS OTHERWISE NOTED DIAMETER "D" IS THE SAME FOR ALL BENDS AND HOOKS ON A BAR.  
 Note: This drawing is not to scale. Follow dimensions.


BAR SIZE	D (IN.)	END HOOK DIMENSIONS			
		180° HOOKS		90° HOOKS	
		ALL GRADES			
		A	O	R	G
#3	2 1/4"	5"	3"	6"	6"
#4	3"	6"	4"	8"	8"



COMPLETE BILL OF REINFORCING STEEL																								
NO. REQ.	MARK NO.	LOCATION	EPOXY	SHAPE NO.	STIRRUP	SUBSTR.	VARIES	DIMENSIONS										NOMINAL LENGTH	ACTUAL LENGTH	WEIGHT				
								B		C		D		E		F					H		K	
								FT.	IN.	FT.	IN.	FT.	IN.	FT.	IN.	FT.	IN.				FT.	IN.	FT.	IN.
INT. BT. NO. 14																								
16	6D140	BEAM		20	X			21	0	0							21	21	42					
48	9D141	COLUMNS		20	X			8	0	0							8	0	1306					
6	6D142	FOOTINGS		10	X			3	6	0	8	0	0				15	0	132					
12	7D143	FOOTINGS		20	X			8	9	0							8	9	219					
18	9D144	FOOTINGS		20	X			5	9	0							5	9	108					
8	8H141	BEAM		20	X			42	3	0							42	3	902					
4	6H142	BEAM		20	X			42	3	0							42	3	254					
4	8H143	BEAM		18	X			44	1	44							44	1	471					
4	8H144	BEAM		18	X			44	3	0							44	3	494					
8	7H145	BEAM		7	X			4	4	0	3	3	750				10	5	170					
124	4P141	COLUMNS		16	X			3	3	0							11	1	918					
49	5U141	BEAM		13	S	X		3	5	0	3	6	0	3	5	0	14	9	737					
20	5U142	BEAM		13	S	X		2	3	0	2	3	0	2	3	0	12	5	252					
2	5U143	BEAM		13	S	X		2	8	0	3	6	0	2	8	0	13	3	27					
12	4U145	BEAM		10	S	X			6	0	3	5	0				4	5	34					
48	9V141	COLUMNS		20	X			25	0	0							25	0	4080					
16	9V142	COLUMNS		20	X			23	4	23	4						23	4	1269					
16	9V143	COLUMNS		20	X			24	1	0							24	1	1310					
16	9V144	COLUMNS		20	X			25	10	0							25	10	1409					
INT. BT. NO. 15																								
16	6D150	FOOTINGS		20	X			8	0	0							8	0	192					
12	5D151	FOOTINGS		20	X			8	9	0							8	9	110					
8	6D152	FOOTINGS		10	X			4	8	0	8	0	0				17	4	102					
40	9D153	FOOTING & COL.		17	X			8	1	0							9	4	269					
10	11H150	BEAM		20	X			38	2	0							38	2	2028					
4	6H151	BEAM		20	X			38	2	38	2						38	2	229					
9	9H152	BEAM		18	X			40	3	0							40	3	727					
4	9H153	BEAM		18	X			38	2	0							40	8	553					
8	7H154	BEAM		7	X			4	4	0	3	3	500				10	5	170					
77	4P150	COLUMNS		16	X			3	3	0							11	1	570					
3	4U150	BEAM		10	S	X			6	0	3	5	0				4	5	9					
42	6U151	BEAM		13	S	X		3	5	0	3	5	0	3	9	0	13	8	957					
32	6U152	BEAM		13	S	X		2	3	0	3	9	0	2	3	0	13	4	617					
2	6U153	BEAM		13	S	X		3	0	875	3	9	0	3	0	875	3	9	0					
2	6U154	BEAM		13	S	X		3	4	250	3	9	0	3	4	250	3	9	0					
2	6U155	BEAM		13	S	X		2	6	0	3	9	0	2	6	0	3	9	0					
40	9V150	COLUMNS		20	X			25	3	500							25	3	3434					
20	9V151	COLUMN		20	X			22	0	0							22	0	1496					
20	9V152	COLUMN		20	X			23	3	0							23	3	1581					
16	6V153	BEAM		20	X			21	0								21	0	42					
INT BENT NO. 16																								
4	6D160	FOOTING		10	X			4	0	0	8	0	0				16	0	94					
12	5D161	FOOTING		20	X			8	9	0							8	9	110					
16	6D162	FOOTING		20	X			6	9	0							6	9	162					
40	9D163	FOOTING & COL.		17	X			8	1	0							9	4	1269					
8	7H160	BEAM		7	X			4	4	0	3	3	500				10	5	170					

COMPLETE BILL OF REINFORCING STEEL																								
NO. REQ.	MARK NO.	LOCATION	EPOXY	SHAPE NO.	STIRRUP	SUBSTR.	VARIES	DIMENSIONS										NOMINAL LENGTH	ACTUAL LENGTH	WEIGHT				
								B		C		D		E		F					H		K	
								FT.	IN.	FT.	IN.	FT.	IN.	FT.	IN.	FT.	IN.				FT.	IN.	FT.	IN.
4	6H161	BEAM		20	X			38	0	0							38	0	728					
5	9H162	BEAM		18	X			40	3	0							40	3	727					
4	9H163	BEAM		18	X			38	0	0							40	6	551					
10	11H164	BEAM		20	X			38	0	0							38	0	2019					
65	4P160	COLUMN		16	X			3	3	0							11	1	481					
3	4U160	BEAM		10	S	X			6	0	3	5	0				4	5	9					
42	6U161	BEAM		13	S	X		3	5	0	3	9	0	3	9	0	15	8	957					
32	6U162	BEAM		13	S	X		2	3	0	3	9	0	2	3	0	13	4	617					
2	6U163	BEAM		13	S	X		3	4	250	3	9	0	3	4	250	3	9	0					
2	6U164	BEAM		13	S	X		3	0	875	3	9	0	3	0	875	3	9	0					
2	6U165	BEAM		13	S	X		2	6	0	3	9	0	2	6	0	3	9	0					
16	6V160	BEAM		20	X			21	0								21	0	42					
40	9V161	COLUMN		20	X			24	9	0							24	9	3366					
20	9V162	COLUMN		20	X			21	5	0							21	5	1456					
20	9V163	COLUMN		20	X			22	2	0							22	2	1507					
INT. BENT NO. 17																								
4	6D170	FOOTING		10	X			4	7	500	8	0	0				17	3	102					
16	6D171	FOOTING		20	X			8	0	0							8	0	192					
12	5D172	FOOTING		20	X			8	9	0							8	9	110					
38	9D173	FTG. AND COLUMN		20	X			8	0	0							8	0	1034					
9	11H170	BEAM		20	X			37	6	0							37	6	1793					
4	6H171	BEAM		20	X			37	6	0							37	6	225					
3	10H172	BEAM		18	X			39	6	0							42	4	546					
4	10H173	BEAM		18	X			37	6	0							40	4	694					
1	6H174	BEAM		20	X			39	6	0							39	6	59					
1	6H175	BEAM		20	X			37	6	0							37	6	56					
8	7H176	BEAM		7	X			4	4	0	3	3	500				10	5	170					
72	4P170	COLUMN		16	X			3	3	0							11	1	533					
21	6U170	BEAM		13	S	X		3	5	0	3	9	0	3	5	0	15	8	478					
44	6U171	BEAM		13	S	X		2	3	0	3	9	0	2	3	0	13	4	848					
2	4U172	BEAM		7	X			3	8	0	18	0					8	1	11					
2	6U173	BEAM		13	S	X		3	2	500	3	9	0	3	2	500	3	9	0					
2	6U174	BEAM		13	S	X		2	4	0	3	9	0	2	4	0	13	6	39					
2	4U175	BEAM		10	S	X			12	0	17	250					3	5	4					
13	4U176	BEAM		10	S	X			6	0	3	5	0				4	5	37					
37	4U177	BEAM		10	S	X			12	0	18	500					3	7	84					
10	4U178	BEAM		10	S	X			6	0	18	500					2	7	16					

STATE	PROJ NO	SHEET NO
MO		110

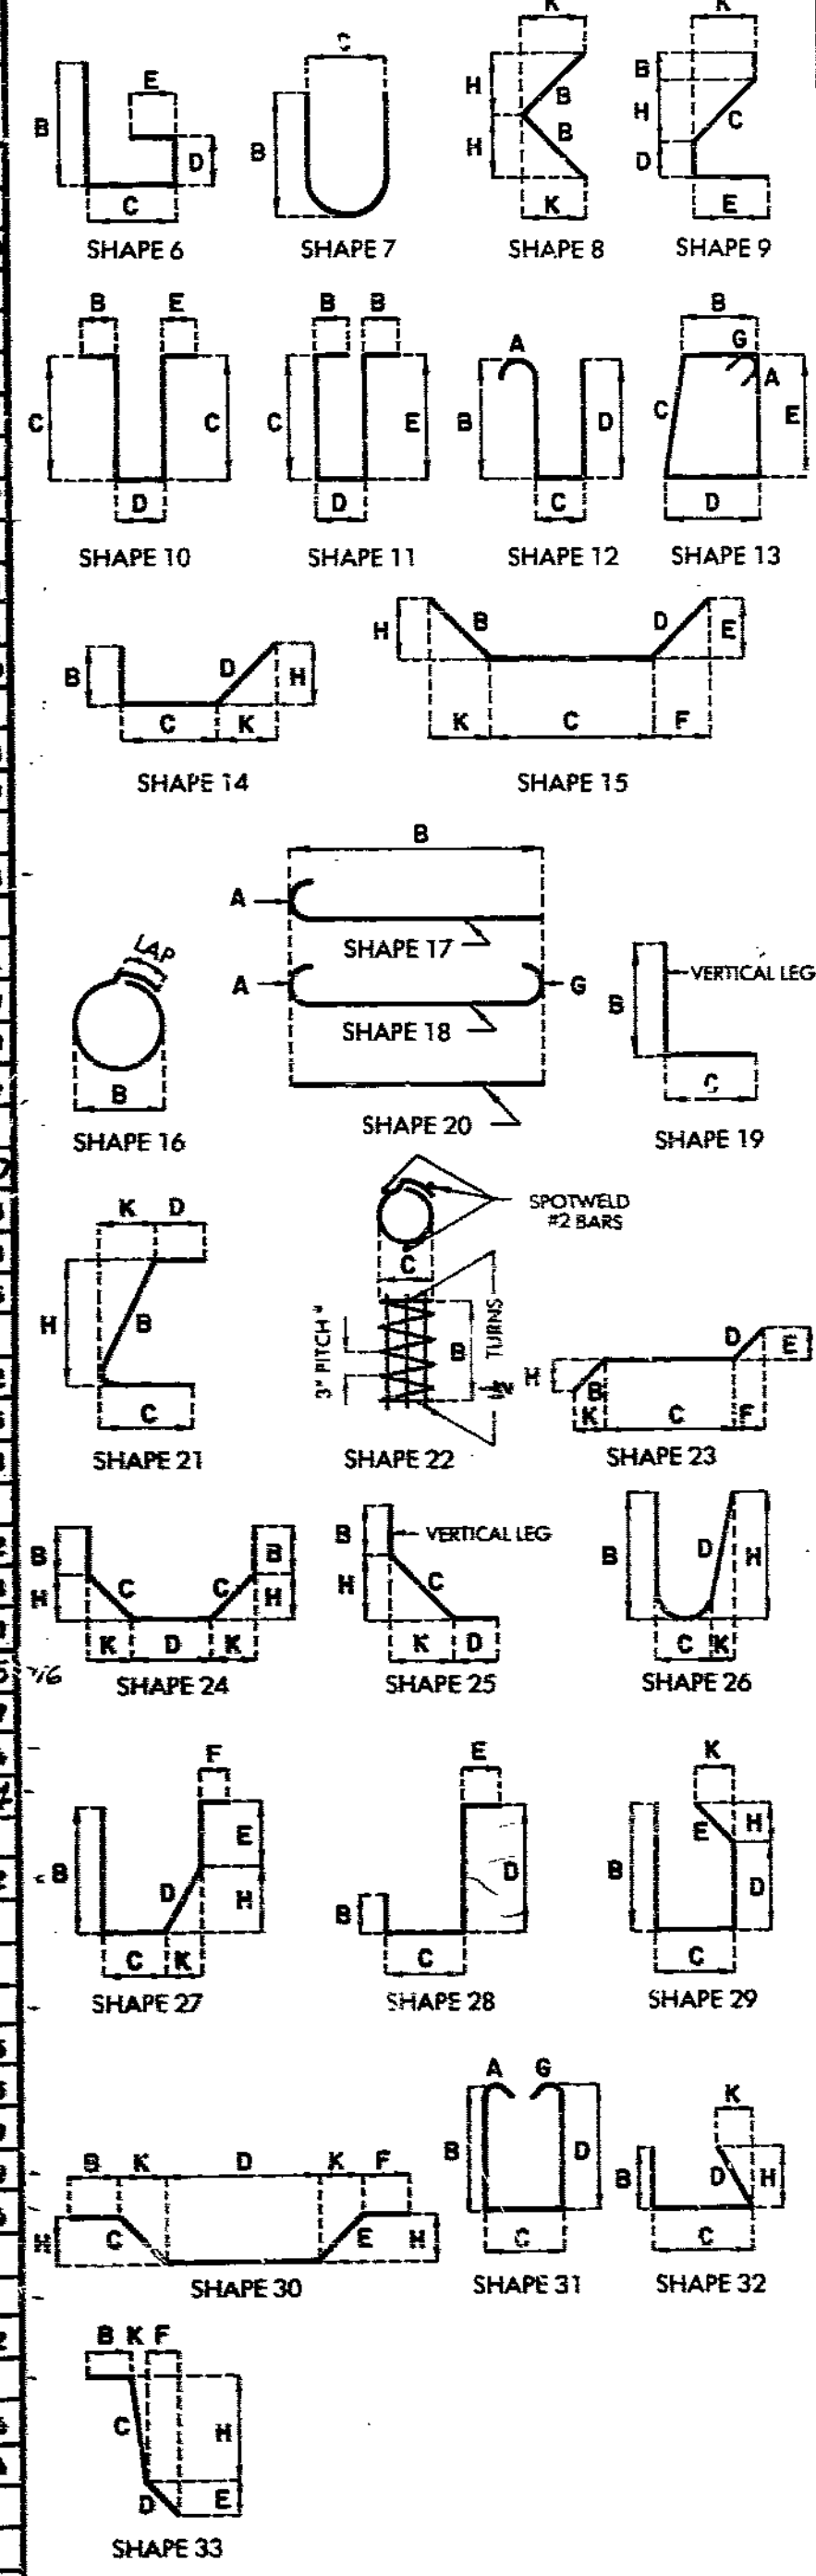


BENDING DIAGRAMS

**NOTES:**  
 ALL STANDARD HOOKS AND BENDS OTHER THAN 180 DEG. TO BE BENT WITH SAME PROCEDURE AS FOR 90 DEG. STD. HOOKS.  
 HOOKS AND BENDS SHALL BE IN ACCORDANCE WITH THE PROCEDURES AS SHOWN ON THIS SHEET.  
 E - EPOXY COATED REINFORCEMENT.  
 S - STIRRUP  
 X - BAR IS INCLUDED IN SUBSTRUCTURE QUANTITIES.  
 V - BAR DIMENSIONS VARY IN EQUAL INCREMENTS BETWEEN DIMENSIONS SHOWN ON THIS LINE AND THE FOLLOWING LINE.  
 NO. EA. - NUMBER OF BARS OF EACH LENGTH.  
 NOMINAL LENGTHS - ARE BASED ON OUT TO OUT DIMENSIONS SHOWN IN BENDING DIAGRAMS AND ARE LISTED FOR FABRICATORS USE. (NEAREST INCH)  
 ACTUAL LENGTHS - ARE MEASURED ALONG CENTERLINE BAR TO THE NEAREST INCH.  
 PAYWEIGHTS ARE BASED ON ACTUAL LENGTHS.


NO. REQ.	MARK NO.	LOCATION	EPOXY	SHAPE NO.	STIRRUP	SUBSTR.	VARIES	DIMENSIONS												NOMINAL LENGTH	ACTUAL LENGTH	WEIGHT		
								B		C		D		E		F		H					K	
								FT.	IN.	FT.	IN.	FT.	IN.	FT.	IN.	FT.	IN.	FT.	IN.				FT.	IN.
4	9H182	BEAM		18	X			48	0	0	0							48	0	48	0	693		
5	9H183	BEAM		18	X			47	0	0	0							48	0	48	0	144		
8	7H204	BEAM		7	X			4	5	0	0	3	5	0	0			50	8	50	8	689		
66	47170	COLUMNS		16	X			3	3	0	0							37	1	37	1	198		
11	4U181	BEAM		10	S	X				8	0	0	3	7	0	0			45	8	45	8	244	
54	6U161	BEAM		13	S	X				3	7	0	0	3	9	0	0			37	1	37	1	25
26	6U182	BEAM		13	S	X				2	5	0	0	3	9	0	0			45	8	45	8	31
4	6U183	BEAM		13	S	X				2	2	3	75	3	9	0	0			6	11	6	11	37
4	6U184	BEAM		13	S	X				3	1	0	0	3	9	0	0			14	9	14	9	200
14	9V180	COLUMN		20	X					23	7	23	7							15	2	15	2	91
14	9V181	COLUMN		20	X					24	5	24	5							3	10	3	10	20
14	9V182	COLUMN		20	X					25	3	25	3							26	0	26	0	248
10	2W180	A & B WELLS		22	X					2	1	0	0	9	125					7	0	7	0	248
INT. BENT NO-19																								
12	7D190	FOOTINGS		20	X					8	9	8	9							27	9	27	9	167
18	5D191	FOOTINGS		20	X					7	3	7	3							2	1	2	1	38
6	6D192	FOOTINGS		18	X					4	3	4	3							33	2	33	2	55
62	9D193	COLUMNS		20	X					7	11	7	11							33	2	33	2	55
9	10H190	BEAM		20	X					48	3	48	3							16	0	16	0	842
4	6H201	BEAM		20	X					43	6	43	6							10	8	10	8	842
8	11H192	BEAM		18	X					19	1	19	1							11	1	11	1	489
5	6H193	BEAM		17	X					26	5	26	5							16	6	16	6	146
4	9H194	BEAM		20	X					21	6	21	6							7	11	7	11	1130
4	9H195	BEAM		20	X					43	6	43	6							2	2	2	2	1869
4	9H196	BEAM		20	X					19	1	19	1							2	2	2	2	1869
4	9H197	BEAM		20	X					26	5	26	5							2	2	2	2	1869
4	9H198	BEAM		20	X					21	6	21	6							2	2	2	2	1869
4	9H199	BEAM		20	X					26	5	26	5							2	2	2	2	1869
5	9H194	BEAM		17	X					47	0	47	0							10	9	10	9	169
66	47170	COLUMNS		16	X					11	1	11	1							4	7	4	7	32
83	7AU191	BEAM		13	S	X				3	9	0	0	3	9	0	0			16	0	16	0	1259
2	11S1	BEAM		13	S	X				2	10	0	0	3	9	0	0			13	8	13	8	42
2	9U192	BEAM		13	S	X				4	5	4	5							4	5	4	5	23
2	9U193	BEAM		13	S	X				3	3	0	0	3	3	0	0			15	4	14	10	49
14	9V190	COLUMN		20	X					23	3	23	3							23	3	23	3	1107
14	9V191	COLUMN		20	X					24	3	24	3							24	3	24	3	1154
14	9V192	COLUMN		20	X					25	3	25	3							25	3	25	3	1202
10	2W190	A & B WELLS		22	X					26	1	26	1							26	1	26	1	45
END BENT NO 20																								
6	5D201	FOOTING		20	X					3	8	3	8							3	8	3	8	23
4	5D202	FOOTING		20	X					4	9	4	9							4	9	4	9	20
4	5D203	FOOTING		20	X					2	3	2	3							2	3	2	3	9
4	6E201	WING		15	S	X				14	125	2	9	500	14	125	13	500	4	0	0	0	45	
5	6E202	WING		15	S	X				14	250	12	2	0	0	3	750	13	750	3	750	13	750	109
8	9H201	BEAM		20	X					37	1	37	1							37	1	37	1	1009
2	6H202	BEAM		20	X					37	1	37	1							37	1	37	1	131

Note: 2 additional #5-2006 & #5-2003 have been added to bar list for testing purposes.

857 365  
 857 365

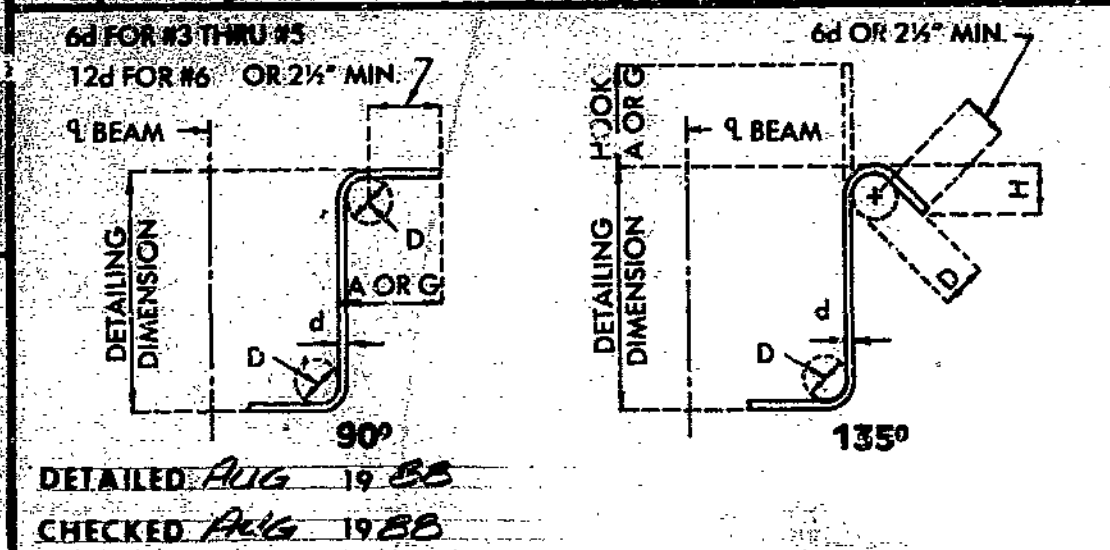

BAR SIZE	D (IN.)	90° HOOK		135° HOOK		APPROX. H
		A O R G	HOOK	A O R G	HOOK	
#3	1 1/8"	4"	4"	4"	4"	2 1/2"
#4	2"	4 1/2"	4 1/2"	4 1/2"	4 1/2"	3"
#5	2 1/2"	6"	6"	5 1/2"	5 1/2"	3 1/2"
#6	4 1/4"	12"	12"	7 1/2"	7 1/2"	4 1/4"

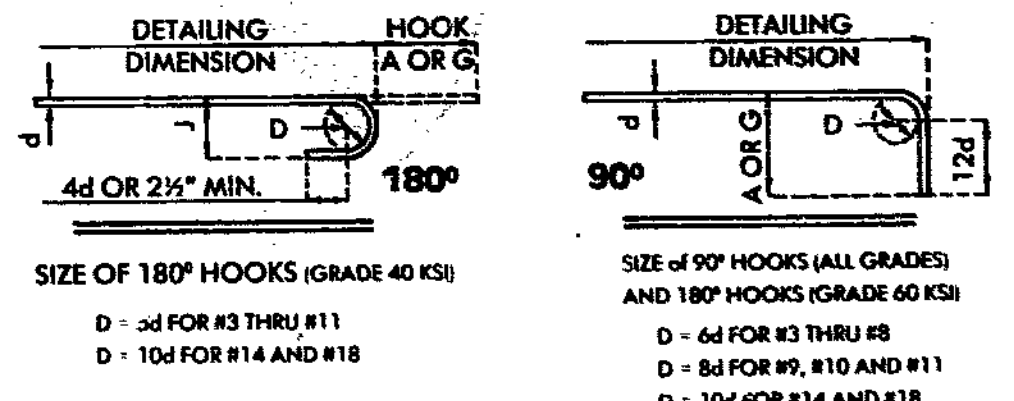

BAR SIZE	D (IN.)	180° HOOKS ALL GRADES		90° HOOKS ALL GRADES	
		A O R G	J	A O R G	J
#3	2 1/4"	5"	3"	6"	6"
#4	3"	6"	4"	8"	8"
#5	3 3/4"	7"	5"	10"	10"
#6	4 1/4"	8"	6"	12"	12"
#7	5 1/4"	10"	7"	14"	14"
#8	6"	11"	8"	16"	16"
#9	9 1/4"	15"	11 1/2"	19"	19"
#10	10 1/4"	17"	13 1/2"	22"	22"
#11	12"	19"	14 1/2"	24"	24"
#14	18 1/4"	23"	21 1/2"	27"	27"

STD. 90.8  
 MAY 1974  
 REVISED  
 JUN 1986  
 CHECKED: *AKG* 1985

NOTE: UNLESS OTHERWISE NOTED DIAMETER "D" IS THE SAME FOR ALL BENDS AND HOOKS ON A BAR.  
 Note: This drawing is not to scale. Follow dimensions.


COMPLETE BILL OF REINFORCING STEEL																								
NO. REQ.	MARK NO.	LOCATION	EPOXY	SHAPE NO.	STIRRUP	S	X	DIMENSIONS								NOMINAL LENGTH	ACTUAL LENGTH	WEIGHT						
								B		C		D		E					F		H		K	
								FT.	IN.	FT.	IN.	FT.	IN.	FT.	IN.				FT.	IN.	FT.	IN.	FT.	IN.
4	9H182	BEAM		18	X			46	0.000							51 0	51 0	696						
5	9H183	BEAM		18	X			47	0.000							49 6	49 6	862						
8	7H184	BEAM		7	X			4	5.000	3	5.000					10 3	10 8	174						
66	4P190	COLUMNS		16	X			3	3.000							11 1	11 1	489						
11	6U180	BEAM		10	X				6.000	3	7.000					4 7	4 5	32						
54	6U191	BEAM		13	X			3	7.000	3	9.000	3	7.000	3	9.000	16 0	15 6	1252						
26	6U182	BEAM		13	X			2	5.000	3	9.000	2	5.000	3	9.000	13 8	13 2	678						
4	6U183	BEAM		13	X			2	2.375	3	9.000	2	2.375	3	9.000	13 2	12 9	77						
4	6U184	BEAM		13	X			3	1.000	3	9.000	3	1.000	3	9.000	15 0	14 6	87						
14	9V160	COLUMN		20	X			23	7.000							23 7	23 7	1123						
14	9V181	COLUMN		20	X			24	5.000							24 5	24 5	1162						
16	9V182	COLUMN		20	X			25	3.000							25 3	25 3	1202						
10	2W180	A.B. WELLS		22	X			2	1.000	9	1.25					33 2	33 2	55						
INT. BENT NO. 19																								
12	7D190	FOOTINGS		20	X			8	9.000							8 9	8 9	219						
18	5D191	FOOTINGS		20	X			7	3.000							7 3	7 3	136						
6	6D192	FOOTINGS		16	X				3.000	8	0.000					16 6	16 2	146						
42	9D193	COLUMNS		20	X			7	11.000							7 11	7 11	1130						
9	10H190	BEAM		20	X			48	3.000							48 3	48 3	1869						
4	6H191	BEAM		20	X			43	6.000							43 6	43 6	261						
8	11H192	BEAM		17	X			17	6.000							19 1	19 1	811						
5	8H193	BEAM		17	X			26	5.000							26 5	26 5	355						
4	8H194	BEAM		20	X			21	6.000							21 6	21 6	290						
8	7H195	BEAM		7	X			4	3.000	3	3.000					10 3	10 3	168						
4	6H196	BEAM		20	X			26	5.000							26 5	26 5	159						
9	10H197	BEAM		20	X			26	5.000							26 5	26 5	1023						
5	8H198	BEAM		17	X			47	0.000							47 11	47 11	640						
66	4P190	COLUMNS		16	X			3	3.000							11 1	11 1	489						
83	4U190	BEAM		13	X			3	5.000	3	9.000	3	5.000	3	9.000	15 8	15 2	1891						
2	11U191	BEAM		13	X			2	10.000	3	9.000	2	10.000	3	9.000	14 6	14 8	42						
8	4U192	BEAM		19	X			6	0.000	3	5.000					4 5	4 3	23						
2	6U193	BEAM		13	X			3	3.000	3	9.000	3	3.000	3	9.000	15 4	14 10	49						
14	9V190	COLUMN		20	X			23	3.000							23 3	23 3	1107						
14	9V191	COLUMN		20	X			24	3.000							24 3	24 3	1154						
14	9V192	COLUMN		20	X			25	3.000							25 3	25 3	1202						
10	2W190	A.B. WELLS		22	X			18	0.000	9	1.25					26 1	26 1	45						
END BENT NO. 20																								
6	5D201	FOOTING		20	X			3	0.000							3 8	3 8	23						
4	5D202	FOOTING		20	X			4	9.000							4 9	4 9	20						
4	5D203	FOOTING		20	X			2	3.000							2 3	2 3	9						
4	6F201	WING		15	X			14	1.25	2	9.500	14	1.25	13	5.00	4	0.00	13	5.00	4	0.00	45		
5	6F202	WING		15	X			14	2.50	12	2.00	14	2.50	3	7.50	13	7.50	13	7.50	14	7	109		
8	9H201	BEAM		20	X			37	1.000							37 1	37 1	1009						
2	6H202	BEAM		20	X			37	1.000							37 1	37 1	111						

COMPLETE BILL OF REINFORCING STEEL																									
NO. REQ.	MARK NO.	LOCATION	EPOXY	SHAPE NO.	STIRRUP	S	X	V	DIMENSIONS								NOMINAL LENGTH	ACTUAL LENGTH	WEIGHT						
									B		C		D		E					F		H		K	
									FT.	IN.	FT.	IN.	FT.	IN.	FT.	IN.				FT.	IN.	FT.	IN.	FT.	IN.
4	9H203	BEAM		20	X				48	0.000						48 0	48 0	529							
2	6H204	BEAM		20	X				48	0.000						48 0	48 0	133							
4	9H205	BEAM		20	X				50	8.000						50 8	50 8	623							
8	4H206	BACKWALL		20	X				37	1.000						37 1	37 1	87							
8	4H207	BACKWALL		20	X				45	8.000						45 8	45 8	211							
1	4H208	BACKWALL		20	X				37	1.000						37 1	37 1	87							
1	4H209	BACKWALL		20	X				45	8.000						45 8	45 8	57							
8	4H212	WING		20	X				6	11.000						6 11	6 11	90							
12	6H213	WING		20	X	V			2	14	9.000					2 14	2 14	8							
INCR = 17.625 IN																									
4	6H214	WING		20	X				15	2.000						15 2	15 2	7							
8	4H215	WING		20	X				3	10.000						3 10	3 10	20							
10	6H216	WING		20	X	V			2	26	0.000					2 26	2 26	0							
INCR = 57.000 IN																									
4	6H217	WING		20	X				27	9.000						27 9	27 9	197							
8	5R201	WING		10	S	X			2	1.000	6	0.000				4 2	4 2	29							
2	6T201	WING		25	S	X			16	0.000	10	3.000	2	0.000		3 9	3 9	91							
2	6T202	WING		25	S	X			15	0.000	22	2.625	3	0.000		2 1.500	22	0.000	26	8	25	4	73		
2	4T203	WING		19	S	X			7	1.000	7	5.000				14 8	14 5	5	19						
2	4T204	WING		19	S	X			6	8.000	4	4.000				11 0	10 11	23							
11	4U209	BEAM		10	S	X				6.000	3	3.000				4 3	4 1	30							
138	5U201	BEAM		13	S	X			2	2.000	2	9.500	2	8.000	2	9.000	11 9	11 0	1288						
1	5U202	BEAM		13	S	X			2	9.000	2	10.250	3	6.000	2	9.000	12 9	12 8	12						
5	7U203	BEAM		14	S	X			6	8.500	2	9.000	2	0.125		12.000	21.000	11 5	11 5	112					
9	6U204	BEAM		10	S	X	V	1	2	0.000	3	3.000				7 2	6 11	9							
INCR = 0.375 IN																									
5	7U205	BEAM		10	S	X			7	4.000	2	9.000				3 0	2 10	179							
73	4U206	BEAM		19	S	X				15.000	6	0.000				7 3	6 11	138							
6	6U207	BEAM		10	S	X	V	1	2	0.000	3	3.000				7 2	6 9	9							
INCR = 0.375 IN																									
2	6V201	BEAM		20	X				2	9.000						2 9	2 9	9							
2	6V202	BEAM		20	X				3	4.000						3 4	3 4	10							
152	5V203	BEAM		20	X				7	8.000						7 8	7 5	222							
6	4V204	BEAM		20	X				6	8.000						6 8	6 6	27							
5	6V205	WING		17	X				7	10.000						7 10	7 6	69							
7	6V206	WING		17	X				8	0.000						8 0	8 0	24							
9	6V207	WING		17	X	V	1		6	2.000						6 10	6 10	22							
INCR = 4.625 IN																									
9	6V208	WING		17	X	V	1		6	6.000						6 6	6 4	19							
INCR = 4.625 IN																									
2	6V209	WING		20	X				21	0.00															



MISSOURI HIGHWAY AND TRANSPORTATION COMMISSION

STATE	SECTION	DATE
MO	22	88
NO. 22	22	88

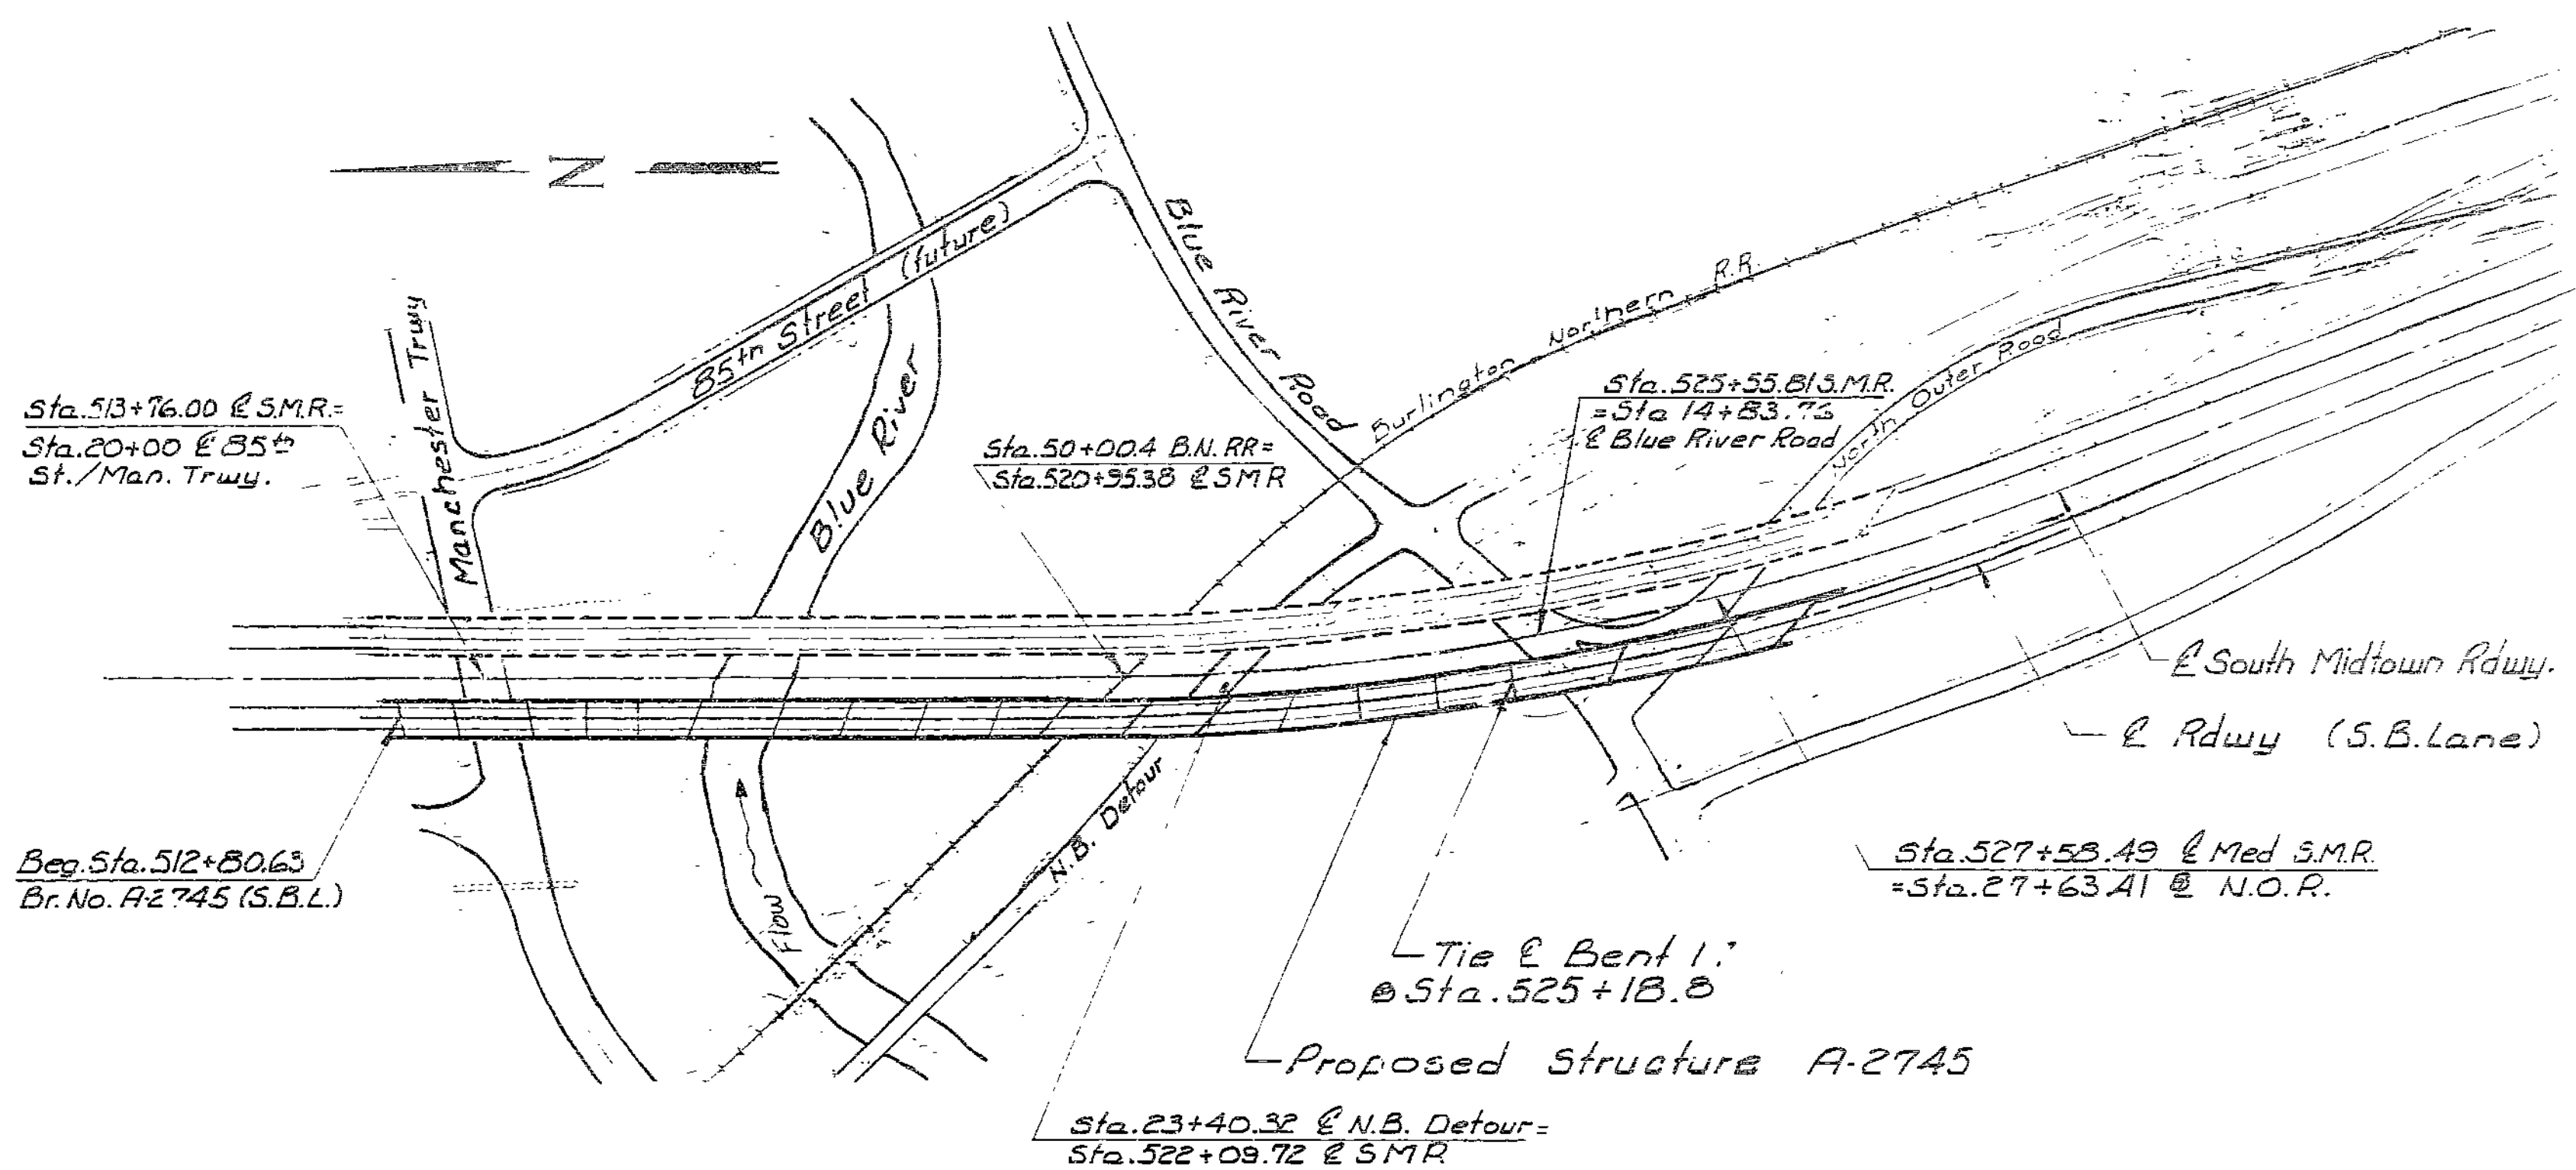

LOCATION SKETCH

BRIDGE NO. A-2745  
OVER  
MANCHESTER TRAFFICWAY, BLUE RIVER,  
BURLINGTON NORTHERN RR,  
N.B. DETOUR, BLUE RIVER ROAD  
& NORTH OUTER ROAD

SUBSTRUCTURE CONTRACT

1. INDEX OF DRAWINGS
2. PART PLAN & ELEVATION
3. PART PLAN & ELEVATION
4. PART PLAN & ELEVATION
5. PART PLAN & ELEVATION
6. PART PLAN & ELEVATION
7. PART PLAN & ELEVATION
8. PART PLAN & ELEVATION
9. GENERAL NOTES, QUANTITIES & PILE DATA
10. BORINGS
11. BORINGS
12. SUBSTRUCTURE LAYOUT
13. SUBSTRUCTURE LAYOUT
14. END BENT NO. 1
15. END BENT NO. 1
16. DEADMAN ANCHORAGE SYSTEM AT BT. 1
17. INT. BENT NO. 2 & NO. 3
18. INT. BENT NO. 2 & NO. 3
19. INT. BENT NO. 4
20. INT. BENT NO. 4
21. INT. BENT NO. 5

INDEX OF DRAWINGS

- |                             |  |
|-----------------------------|--|
| 22. INT. BENT NO. 5         | 42. INT. BENT NO. 17                   |
| 23. INT. BENT NO. 6 & NO. 7 | 43. INT. BENT NO. 17                   |
| 24. INT. BENT NO. 6 & NO. 7 | 44. INT. BENT NO. 18                   |
| 25. INT. BENT NO. 6 & NO. 7 | 45. INT. BENT NO. 18                   |
| 26. INT. BENT NO. 8         | 46. INT. BENT NO. 19                   |
| 27. INT. BENT NO. 9         | 47. END BENT NO. 20                    |
| 28. INT. BENT NO. 9         | 48. END BENT NO. 20                    |
| 29. INT. BENT NO. 10        | 49. DEADMAN ANCHORAGE SYSTEM AT BT. 20 |
| 30. INT. BENT NO. 11        | 50. EARTHQUAKE RESTRAINTS AT BT. 20    |
| 31. INT. BENT NO. 11        | 51. BAR LIST                           |
| 32. INT. BENT NO. 12        | 52. BAR LIST                           |
| 33. INT. BENT NO. 12        | 53. BAR LIST                           |
| 34. INT. BENT NO. 13        | 54. BAR LIST                           |
| 35. INT. BENT NO. 13        | 55. BAR LIST                           |
| 36. INT. BENT NO. 14        |  |
| 37. INT. BENT NO. 14        |  |
| 38. INT. BENT NO. 15        |  |
| 39. INT. BENT NO. 15        |  |
| 40. INT. BENT NO. 16        |  |
| 41. INT. BENT NO. 16        |  |

Note: For Hydrologic Data, Tables see sheet no. 6  
For Curve Data see sheet no. 10

BRIDGE NO. A-2745  
SIGNALS, SIGNS AND MARKERS  
CHECKED BY THE DISTRICT

STATE ROAD BOUNTY AND TAX COLLECTOR  
ST. LOUIS, MISSOURI  
PROJECT NO. 27452-100  
JOB NO. 27452-100

JACKSON COUNTY

DESIGNED Mar. 1988  
DETAILED July 1988  
CHECKED August 1988

Note: This drawing is not to scale. Follow dimensions


DATE: 8/22/88

A27452-100-366

MISSOURI HIGHWAY AND TRANSPORTATION COMMISSION

STATE	PROJECT	SHEET NO.
MO	06-008-1300	16
SEC/SUR	22 TWP 43	RGE 33

Job No. 4-U-7-20

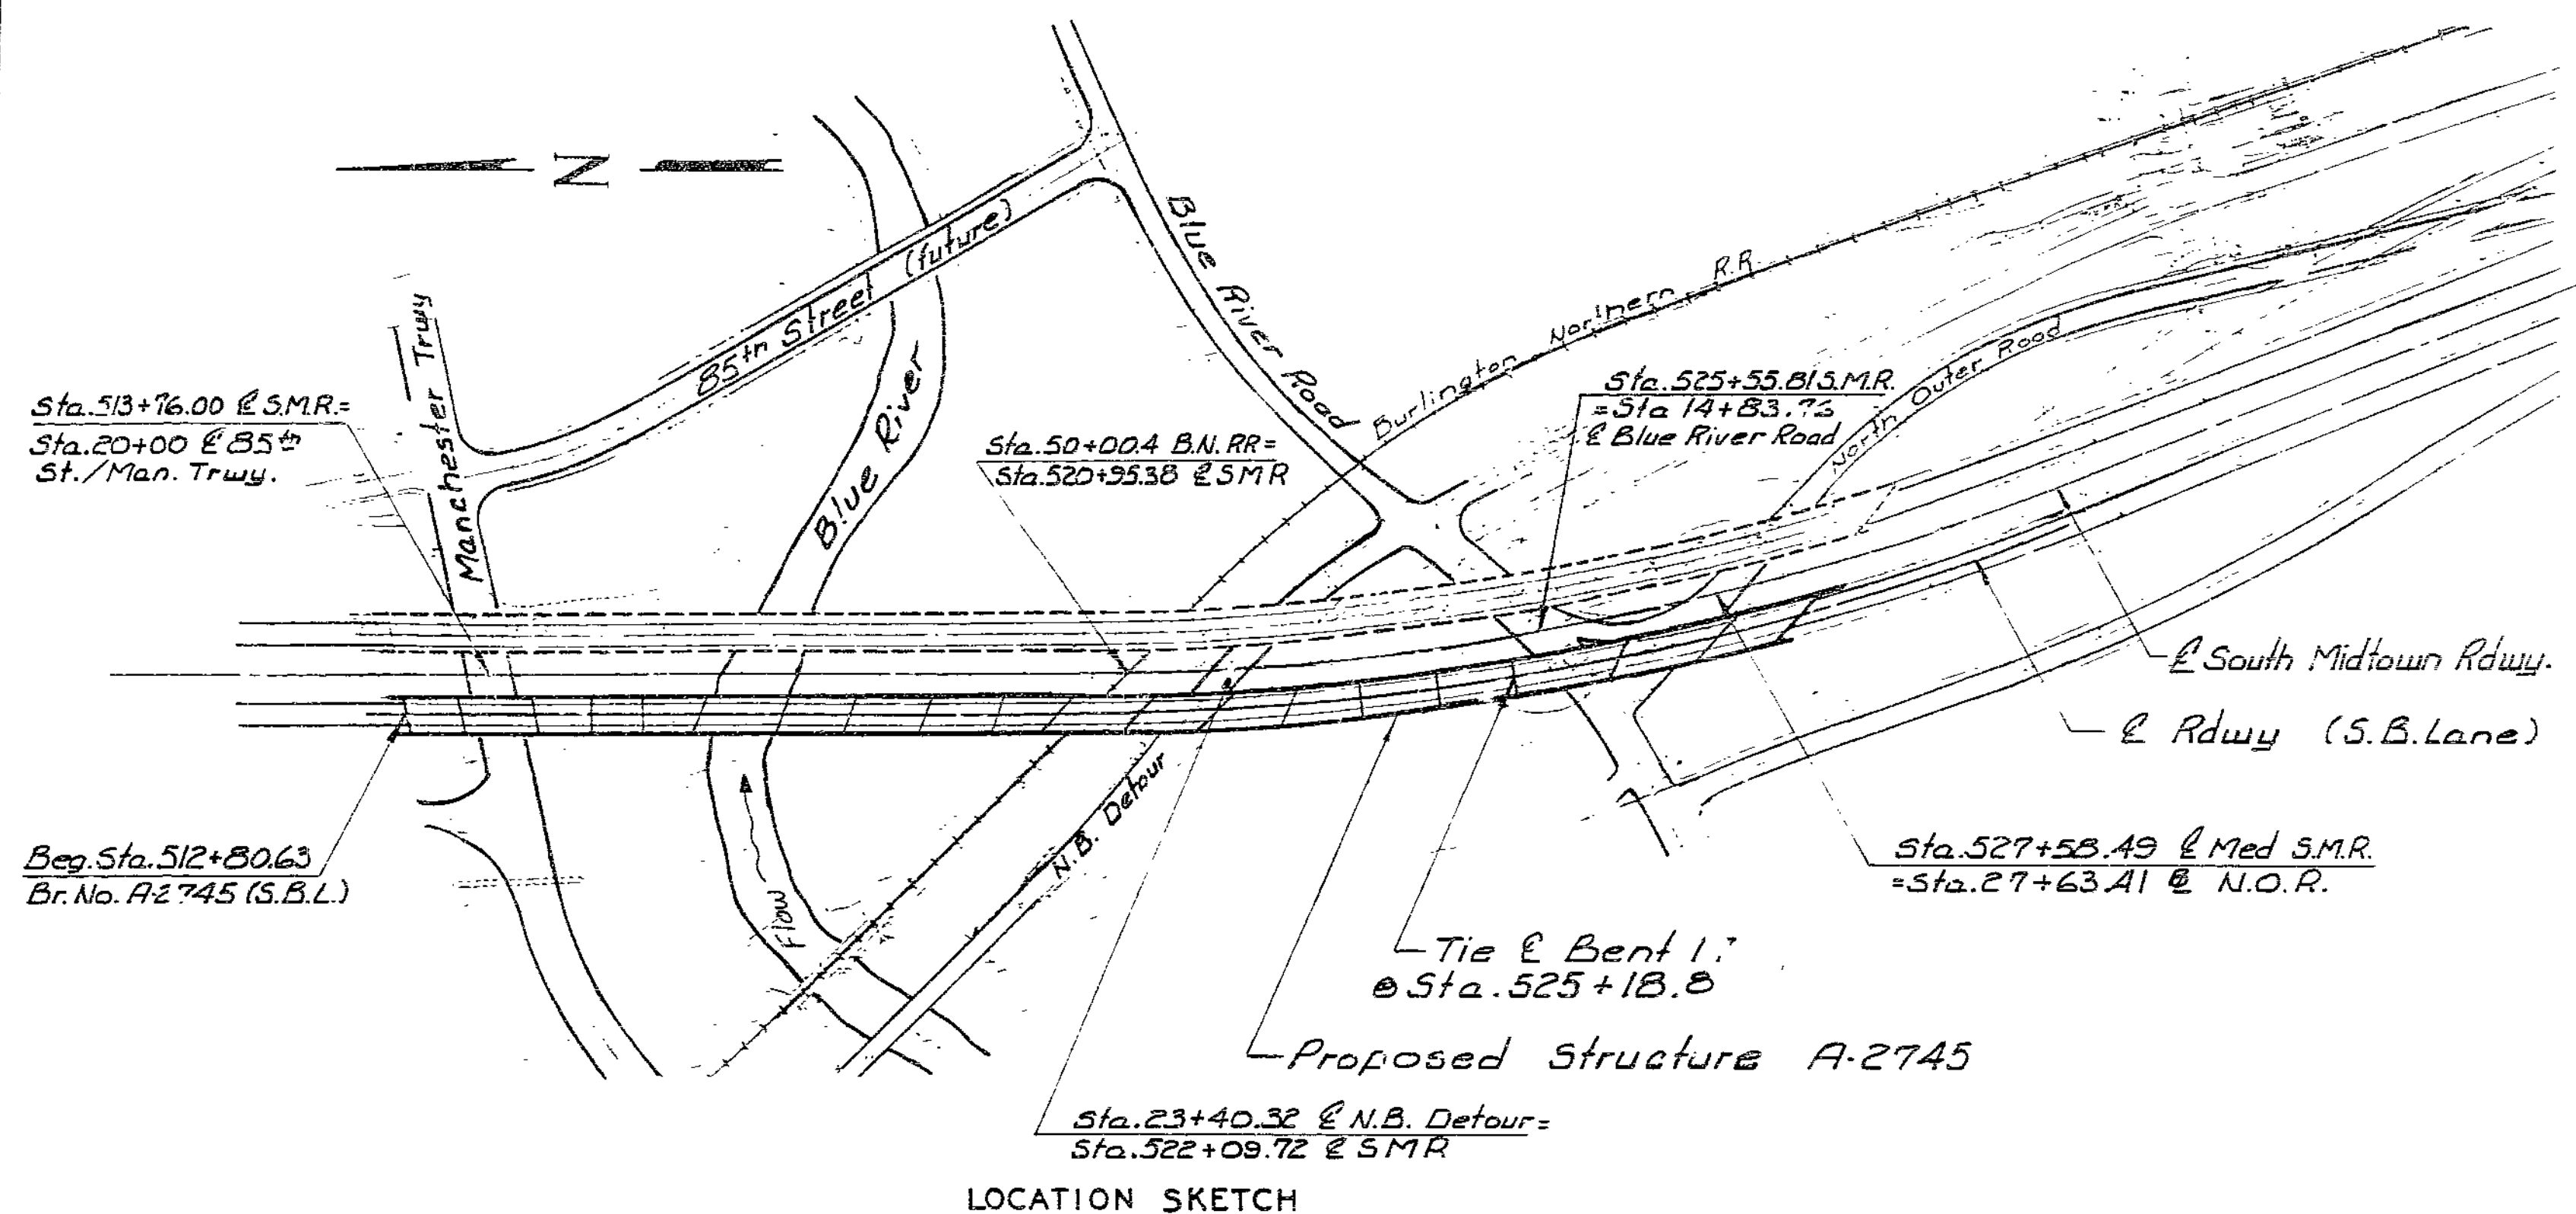

LOCATION SKETCH

BRIDGE NO. A-2745  
OVER

MANCHESTER TRAFFICWAY, BLUE RIVER,  
BURLINGTON NORTHERN RR,  
N.B. DETOUR, BLUE RIVER ROAD  
& NORTH OUTER ROAD

SUBSTRUCTURE CONTRACT

197 366

1. INDEX OF DRAWINGS
2. PART PLAN & ELEVATION
3. PART PLAN & ELEVATION
4. PART PLAN & ELEVATION
5. PART PLAN & ELEVATION
6. PART PLAN & ELEVATION
7. PART PLAN & ELEVATION
8. PART PLAN & ELEVATION
9. GENERAL NOTES, QUANTITIES & PILE DATA
10. BORINGS
11. BORINGS
12. SUBSTRUCTURE LAYOUT
13. SUBSTRUCTURE LAYOUT
14. END BENT NO. 1
15. END BENT NO. 1
16. DEADMAN ANCHORAGE SYSTEM AT BT. 1
17. INT. BENT NO. 2 & NO. 3
18. INT. BENT NO. 2 & NO. 3
19. INT. BENT NO. 4
20. INT. BENT NO. 4
21. INT. BENT NO. 5

INDEX OF DRAWINGS

22. INT. BENT NO. 5
23. INT. BENT NO. 6 & NO. 7
24. INT. BENT NO. 6 & NO. 7
25. INT. BENT NO. 6 & NO. 7
26. INT. BENT NO. 8
27. INT. BENT NO. 9
28. INT. BENT NO. 9
29. INT. BENT NO. 10
30. INT. BENT NO. 11
31. INT. BENT NO. 11
32. INT. BENT NO. 12
33. INT. BENT NO. 12
34. INT. BENT NO. 13
35. INT. BENT NO. 13
36. INT. BENT NO. 14
37. INT. BENT NO. 14
38. INT. BENT NO. 15
39. INT. BENT NO. 15
40. INT. BENT NO. 16
41. INT. BENT NO. 16
42. INT. BENT NO. 17
43. INT. BENT NO. 17
44. INT. BENT NO. 18
45. INT. BENT NO. 18
46. INT. BENT NO. 19
47. END BENT NO. 20
48. END BENT NO. 20
49. DEADMAN ANCHORAGE SYSTEM AT BT. 20
50. EARTHQUAKE RESTRAINTS AT BT. 20
51. BAR LIST
52. BAR LIST
53. BAR LIST
54. BAR LIST
55. BAR LIST

Note: For Hydrologic Data Table see sheet No. 8.  
For Curve Data see sheet No. 13.

B.M. TBM elevation 750.65 S.W. cor.  
signal base at S.W. cor. 87th St. and  
Hickman Mills Dr.

STATE ROAD: "SOUTH MIDTOWN ROADWAY"  
IN KANSAS CITY  
PROJECT NO. 06-008-1300 STA 512+80.63  
JOB NO. 4-U-7-20 RTE. 7, S.B.L.

JACKSON COUNTY

DATE 7/12/88


DESIGNED Mar. 1988  
DETAILED July 1988  
CHECKED August 1988

Note: This drawing is not to scale. Follow dimensions.

Sheet No. 1 of 55

MISSOURI HIGHWAY AND TRANSPORTATION COMMISSION

STATE	PROJ. NO.	SHEET NO.
MO	DE-008 (808)	116
SEC./SUR.	TWP	RGE.
22	4B	3B

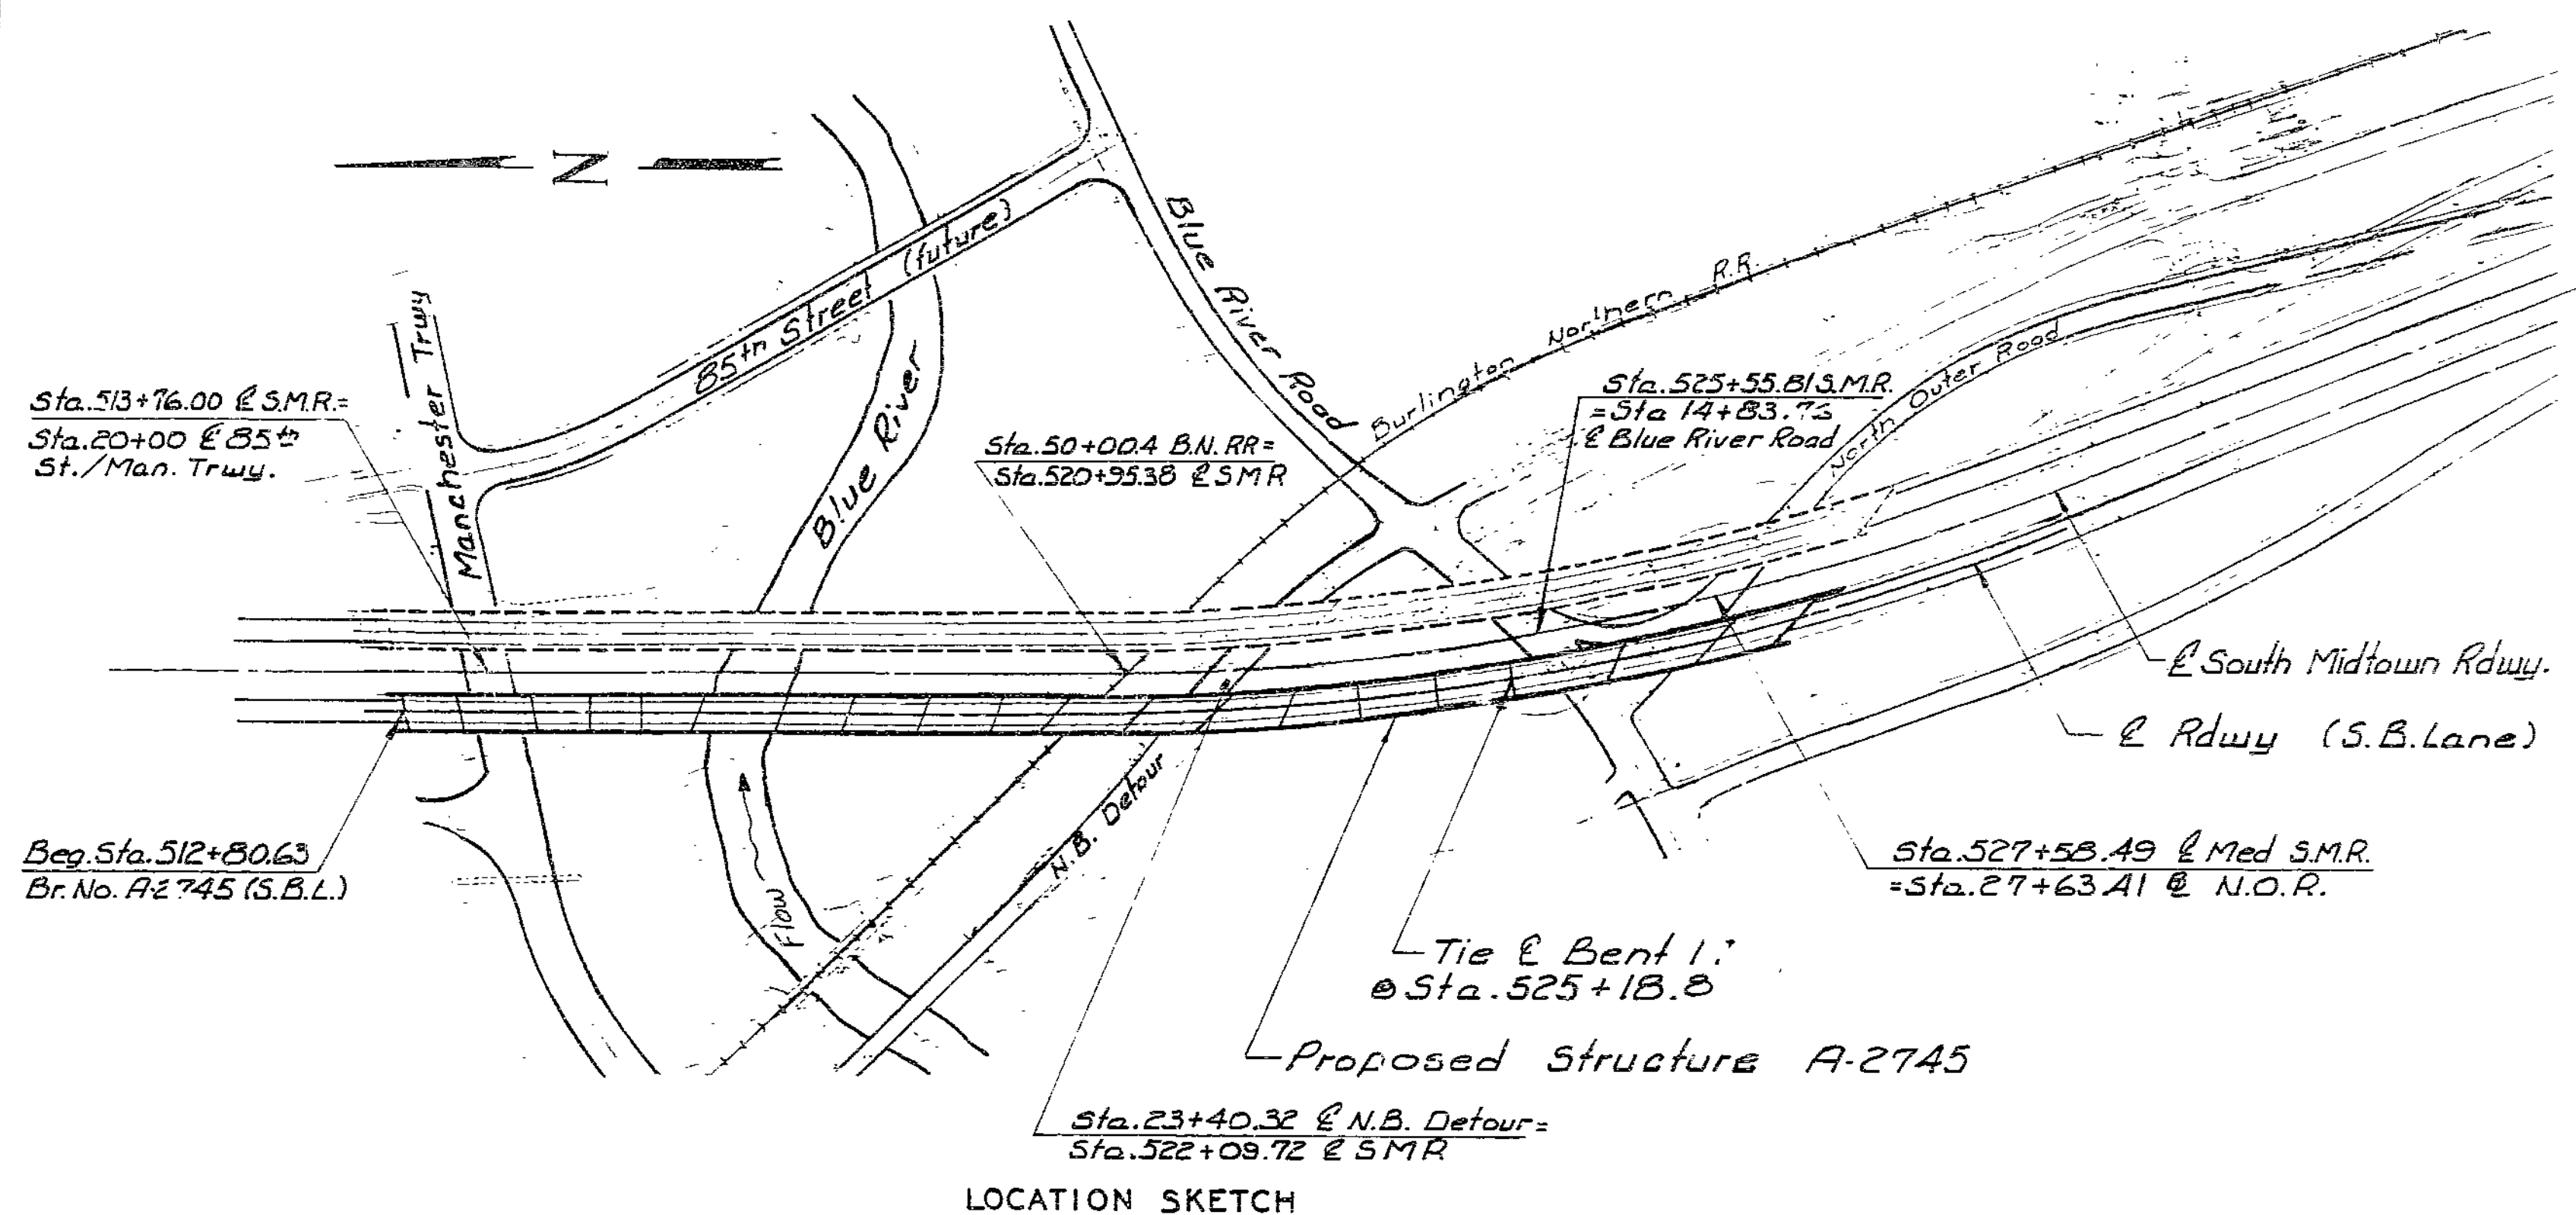

BRIDGE NO. A-2745  
OVER

MANCHESTER TRAFFICWAY, BLUE RIVER,  
BURLINGTON NORTHERN RR,  
N.B. DETOUR, BLUE RIVER ROAD  
& NORTH OUTER ROAD

SUBSTRUCTURE CONTRACT

LOCATION SKETCH

1. INDEX OF DRAWINGS
2. PART PLAN & ELEVATION
3. PART PLAN & ELEVATION
4. PART PLAN & ELEVATION
5. PART PLAN & ELEVATION
6. PART PLAN & ELEVATION
7. PART PLAN & ELEVATION
8. PART PLAN & ELEVATION
9. GENERAL NOTES, QUANTITIES & PILE DATA
10. BORINGS
11. BORINGS
12. SUBSTRUCTURE LAYOUT
13. SUBSTRUCTURE LAYOUT
14. END BENT NO. 1
15. END BENT NO. 1
16. DEADMAN ANCHORAGE SYSTEM AT BT. 1
17. INT. BENT NO. 2 & NO. 3
18. INT. BENT NO. 2 & NO. 3
19. INT. BENT NO. 4
20. INT. BENT NO. 4
21. INT. BENT NO. 5

INDEX OF DRAWINGS

22. INT. BENT NO. 5
23. INT. BENT NO. 6 & NO. 7
24. INT. BENT NO. 6 & NO. 7
25. INT. BENT NO. 6 & NO. 7
26. INT. BENT NO. 8
27. INT. BENT NO. 9
28. INT. BENT NO. 9
29. INT. BENT NO. 10
30. INT. BENT NO. 11
31. INT. BENT NO. 11
32. INT. BENT NO. 12
33. INT. BENT NO. 12
34. INT. BENT NO. 13
35. INT. BENT NO. 13
36. INT. BENT NO. 14
37. INT. BENT NO. 14
38. INT. BENT NO. 15
39. INT. BENT NO. 15
40. INT. BENT NO. 16
41. INT. BENT NO. 16
42. INT. BENT NO. 17
43. INT. BENT NO. 17
44. INT. BENT NO. 18
45. INT. BENT NO. 18
46. INT. BENT NO. 19
47. END BENT NO. 20
48. END BENT NO. 20
49. DEADMAN ANCHORAGE SYSTEM AT BT. 20
50. EARTHQUAKE RESTRAINTS AT BT. 20
51. BAR LIST
52. BAR LIST
53. BAR LIST
54. BAR LIST
55. BAR LIST

Note: For Hydrologic Data Table see sheet No. 9.  
For Curve Data see sheet No. 13.

B.M. 75M. Elevation 780.65 S.W. cor.  
signal base at S.W. cor. 87th St. and  
Hickman Mills Dr.

STATE ROAD: "SOUTH MIDTOWN ROADWAY"  
IN KANSAS CITY  
PROJECT NO. DE-008 (808) STA. 512+80.83  
JOB NO. 4-U-71-20 RTE. 71 S.B.L.

JACKSON COUNTY

DATE 7/12/88

DESIGNED	DATE
DETAILED	DATE
CHECKED	DATE

DESIGNED Mar. 1988  
DETAILED July 1988  
CHECKED August 1988

Note: This drawing is not to scale. Follow dimensions


Sheet No. A0155

A27 366

Note: Roadway fill shall be completed to the roadway section and up to the elevation of the bottom of the concrete beam within the limits of the structure and Formwork shall be 25' in back of the fill face of the bridge before piles are driven for any bents falling within the embankment section.

STATE	PROJ NO	SHEET NO
MO	04-0051 (205)	17
Sub No 4-1-91-EE		

(64'-82'-65')(65'-65'-82'-82'-82')(82'-67'-90'-90')(79'-79'-85'-85') PRESTRESSED CONCRETE I-GIRDER SPANS  
(123'-123'-93') CONT. COMP. R. GIRDER SPANS

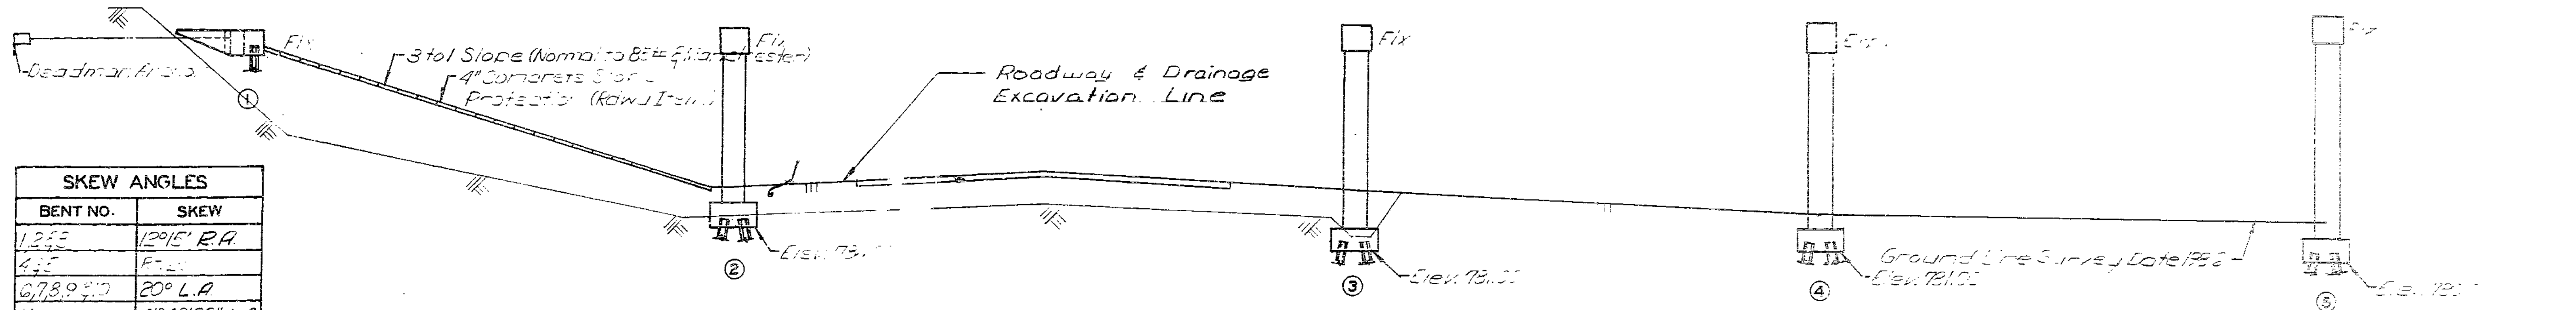


PART GENERAL ELEVATION

SKEW ANGLES	
BENT NO.	SKEW
1,2,3,5	12°15' R.A.
4,5	R.A.
6,7,8,9,10	20° L.A.
11	41°40'20" L.A.
12	42°47'35" L.A.
13	44°34'05" L.A.
14	22°13' L.A.
15,16,17	R.A.
18	30°00' L.A.
19	57°25'00" L.A.
20	50°17'55" L.A.

To Radial Line

Note: Skew angles are measured at & S.E.L.

798 367

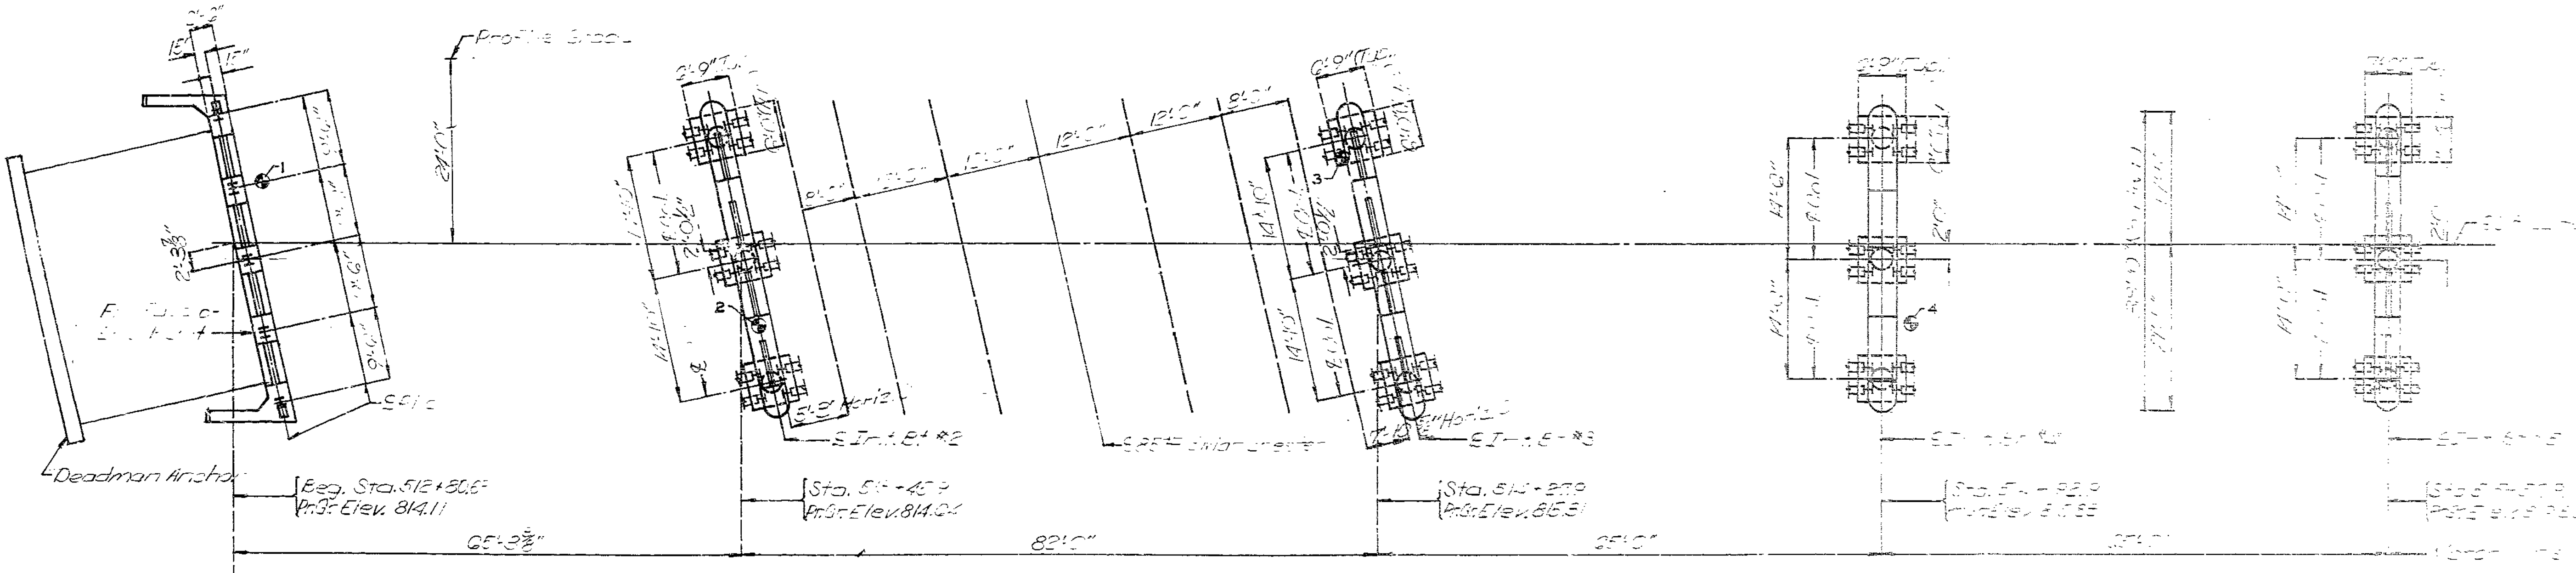

PART PLAN

Note: For boring data see sheet No. 10 & 11.  
⊙ Indicates location of boring

DETAILED JULY 1988  
CHECKED AUG 1988



Note: This drawing is not to scale. Follow dimensions.

Sheet No. 2/10/88

JACKSON COUNTY

4-2-10

STATE	PROJ. NO.	SHEET NO.
MO	DE-60-31-220	18

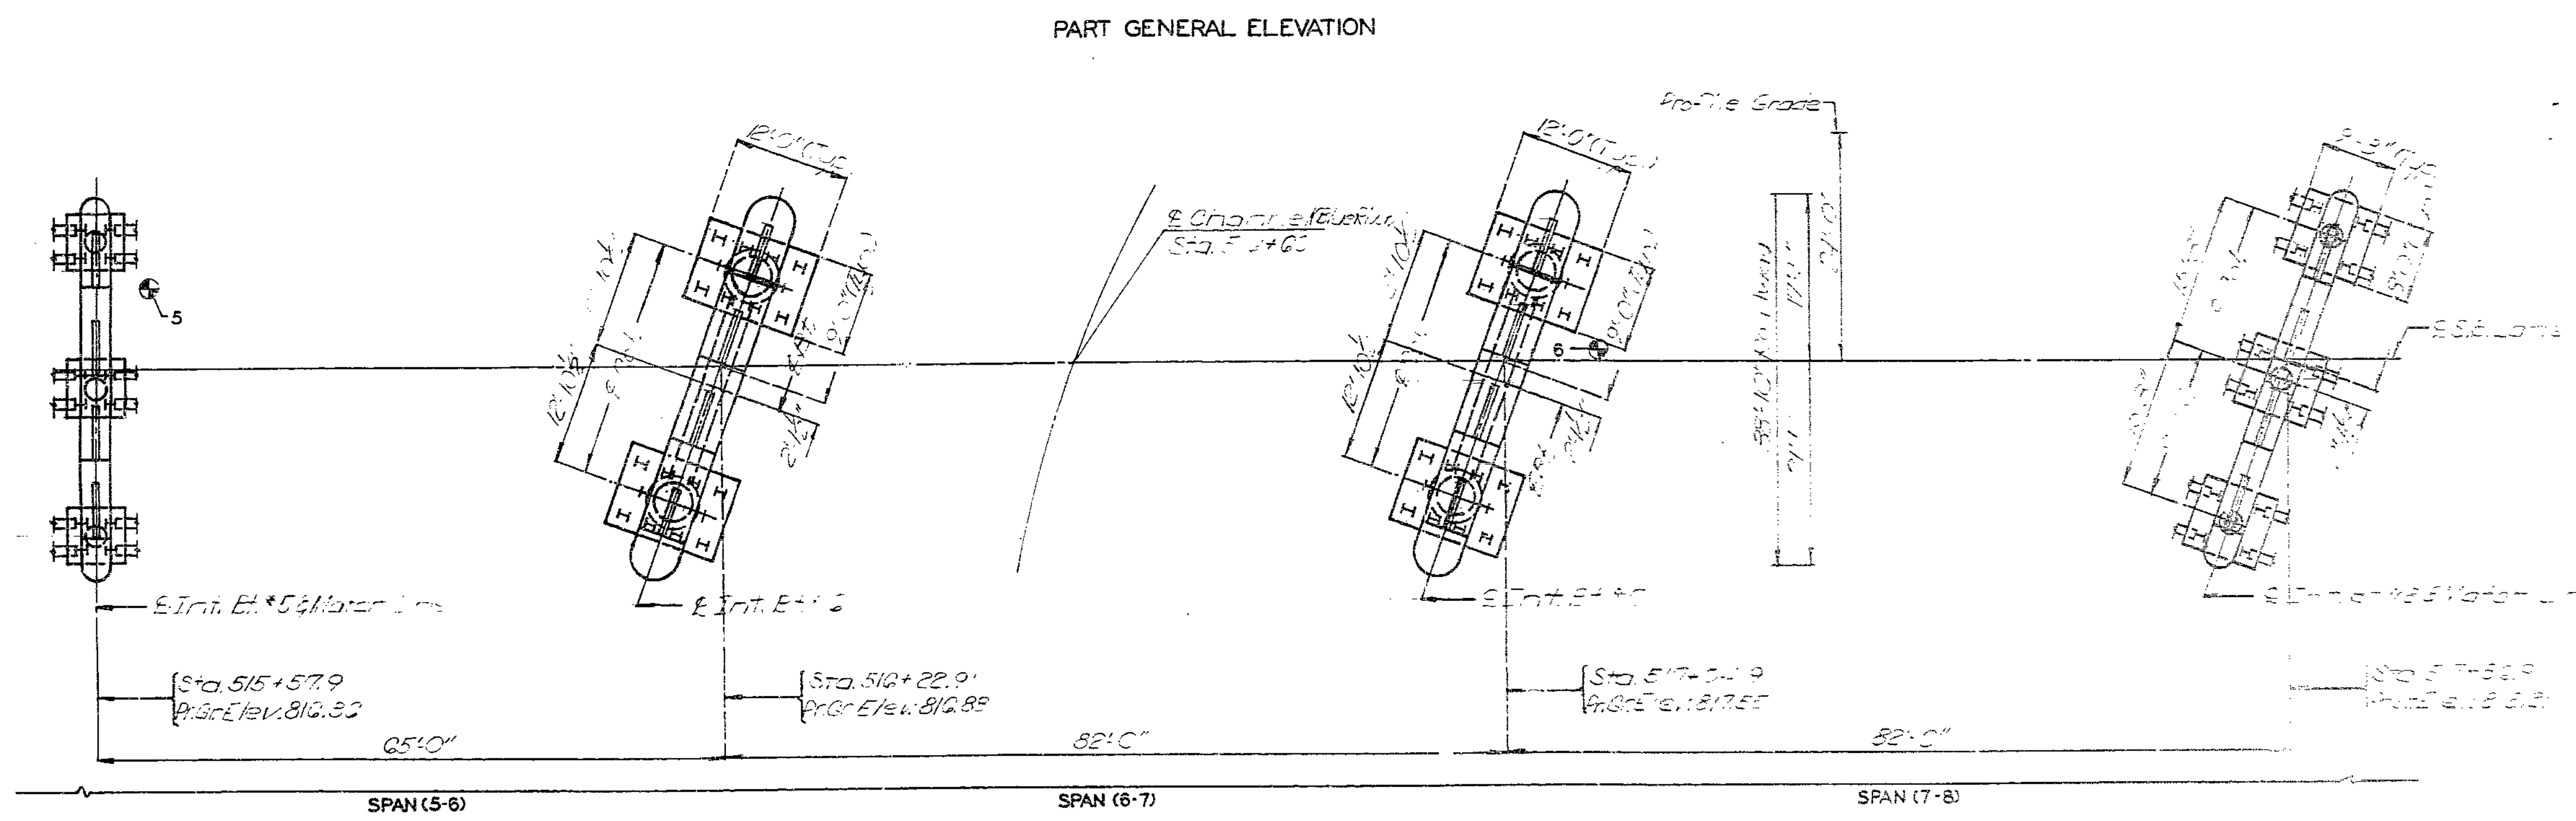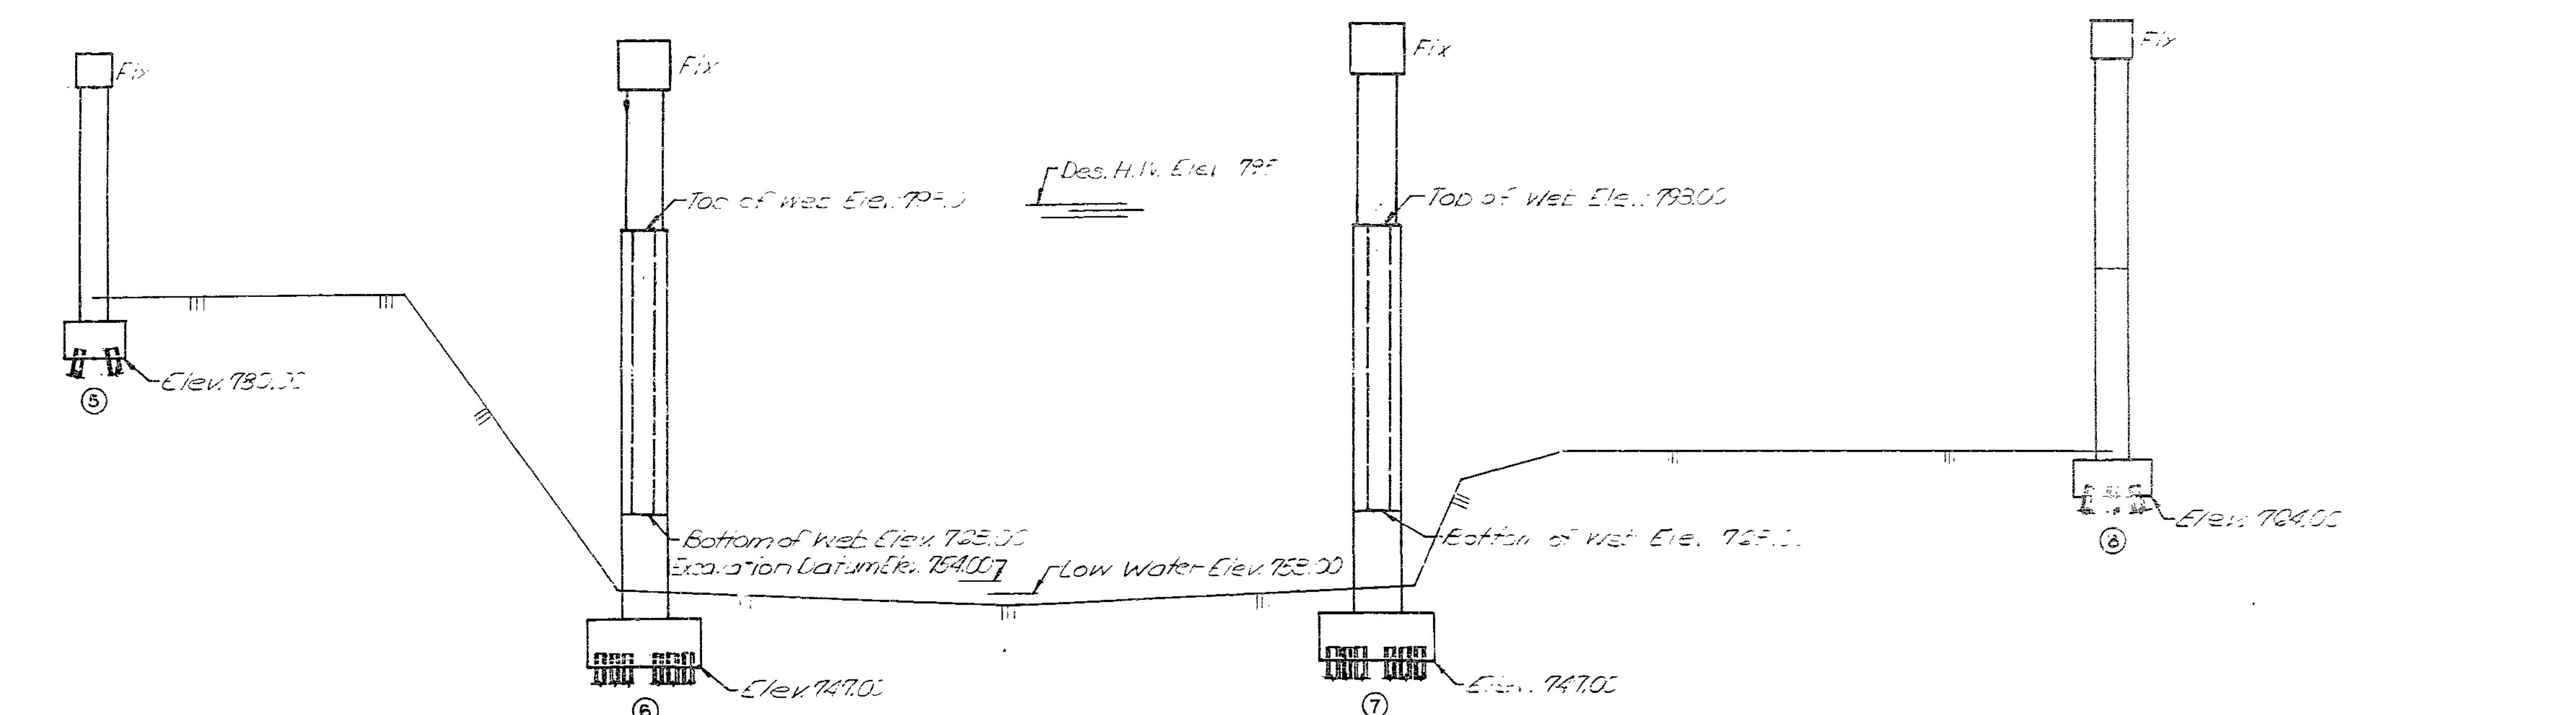

Note: For boring data see sheets 10 & 11.  
 \* indicates location of boring.

799 368

DETAILED JULY 1988  
 CHECKED Aug. 1983

Note: This drawing is not to scale. Follow dimensions.


SPAN 81'0" x 82'0"

JACKSON COUNTY


1983

STATE	PROJ NO	SHEET NO
MO	DE-0051 (303)	19

Set No 4-U-11-217

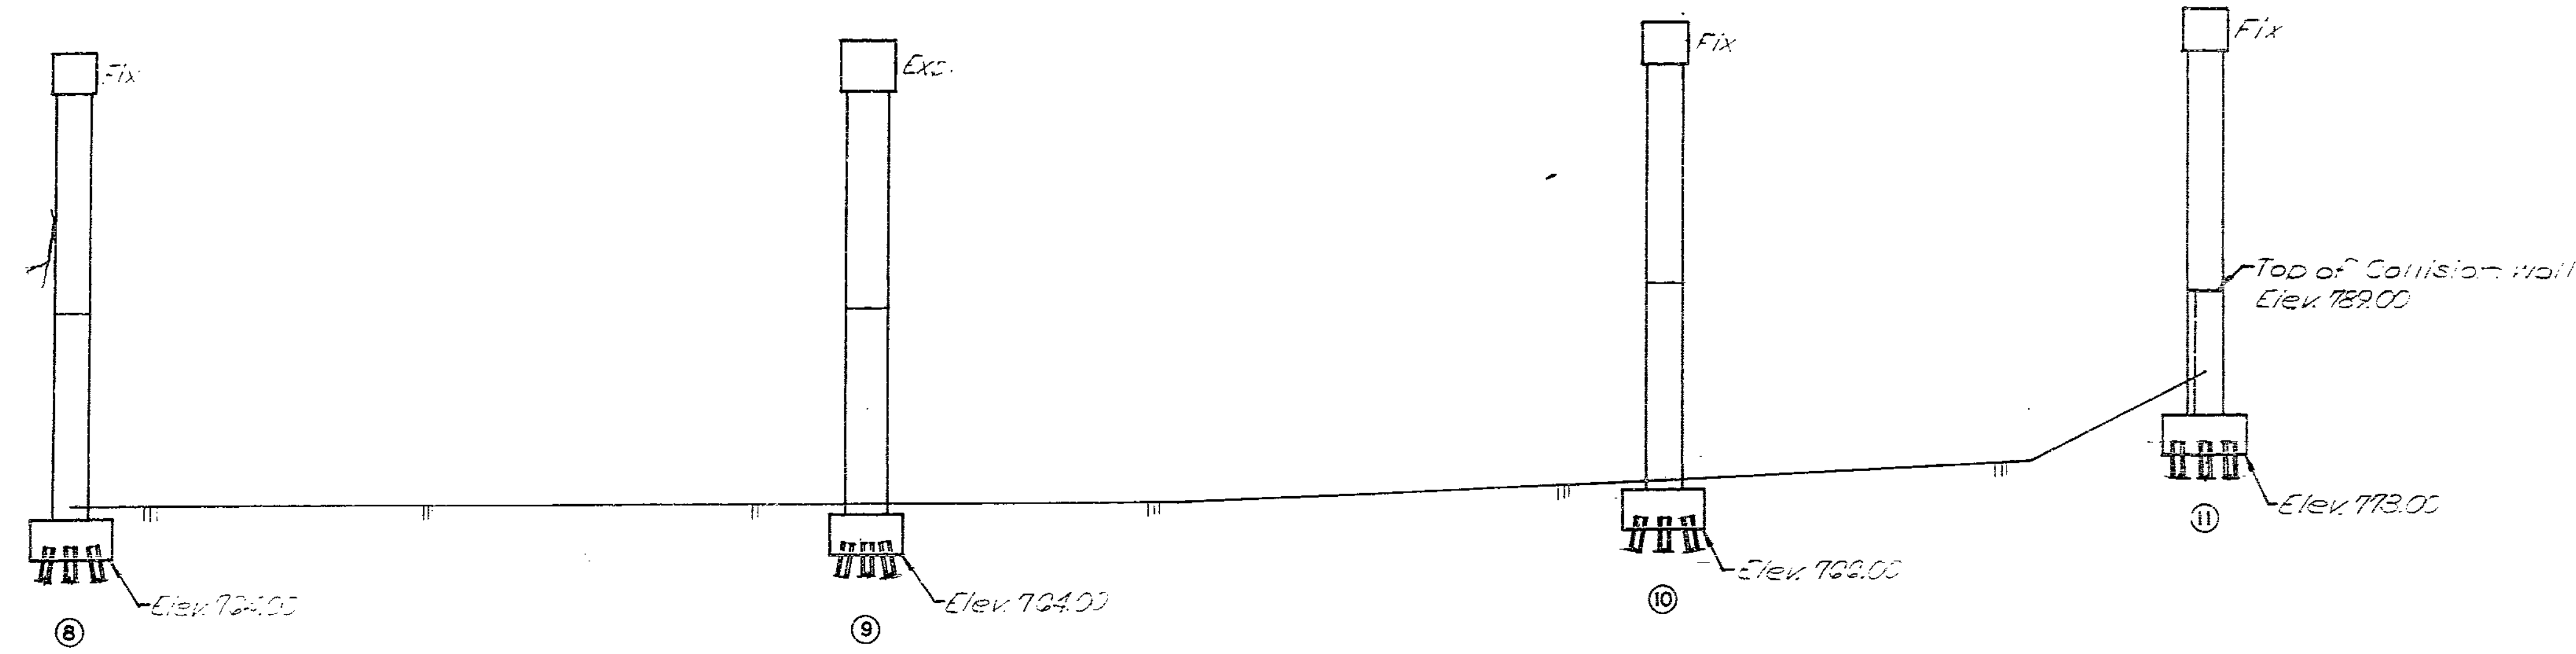

PART GENERAL ELEVATION

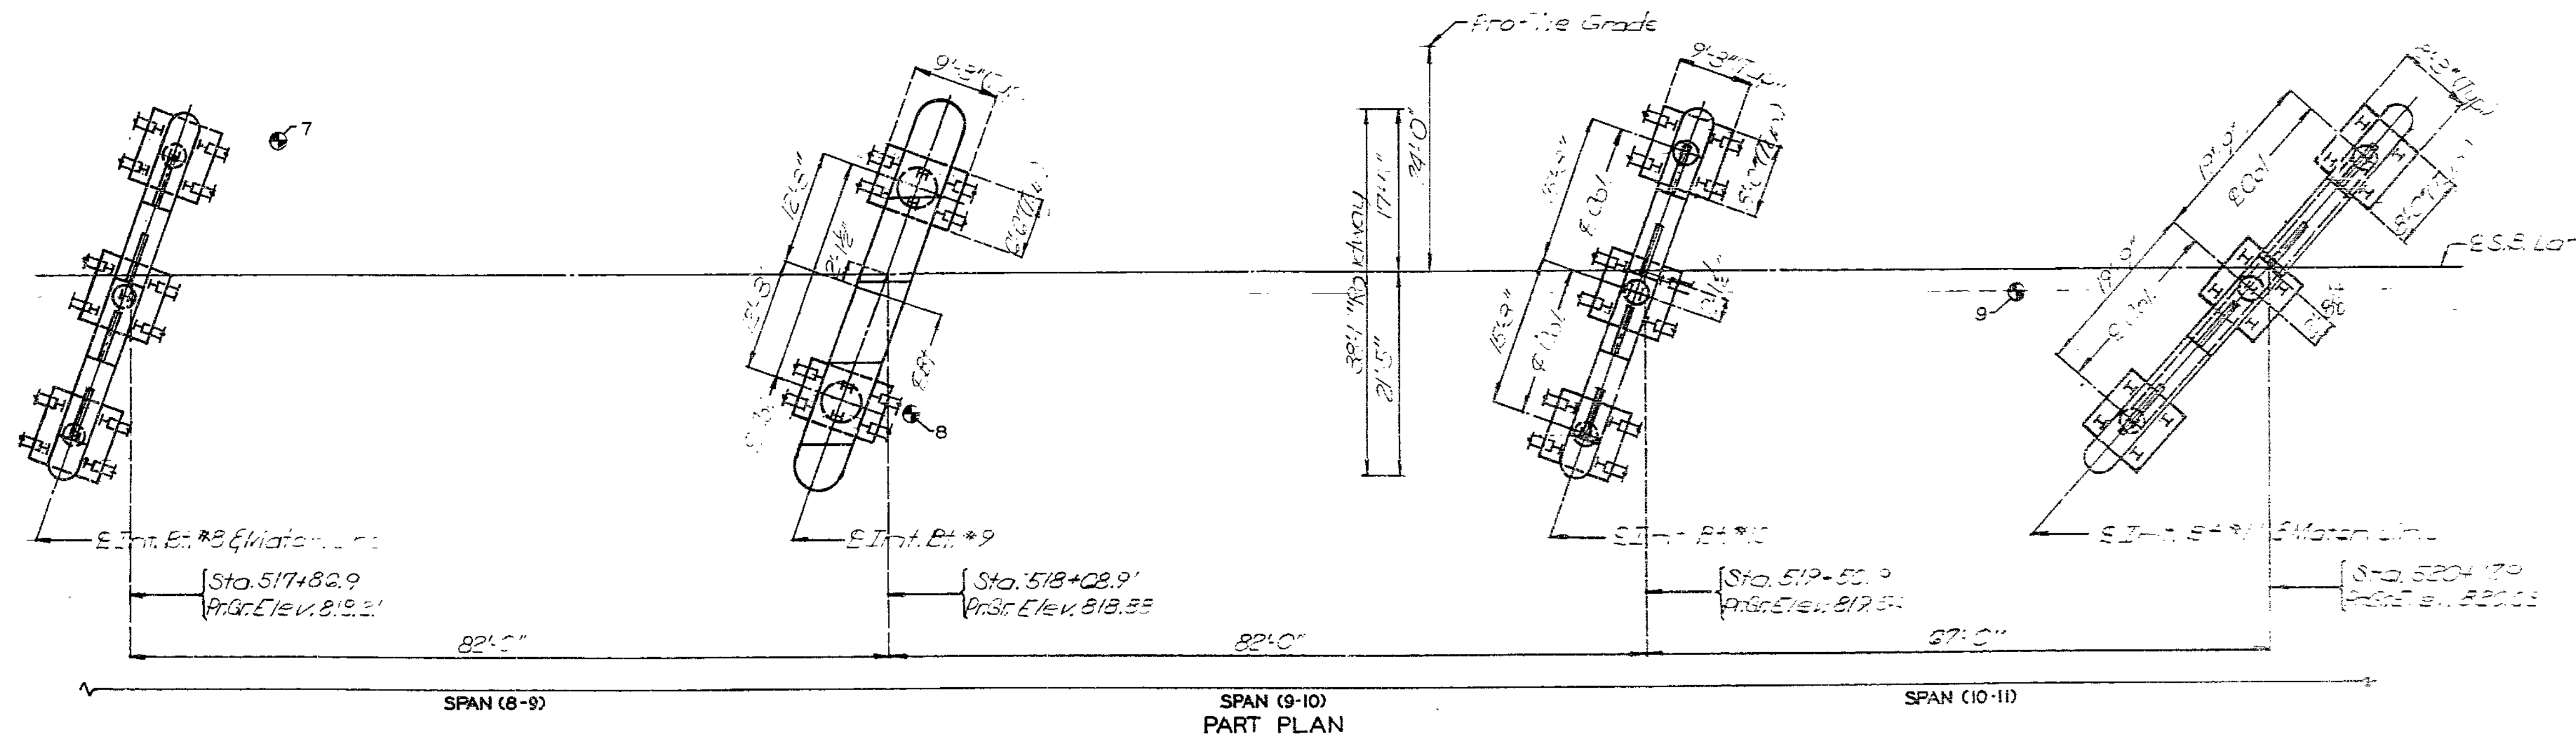

Note: For Boring Data see sheet No 10 & 11.  
 ● Indicates location of borings.

200 369

DETAILED JULY 1988  
 CHECKED Aug. 1988



Note: This drawing is not to scale. Follow dimensions.

Sheet No 4 of 33

JACKSON COUNTY

A-2745

STATE	PROJ. NO.	SHEET NO.
MO	DE-0031(803)	20
Sub No. 4-4-71-2D		

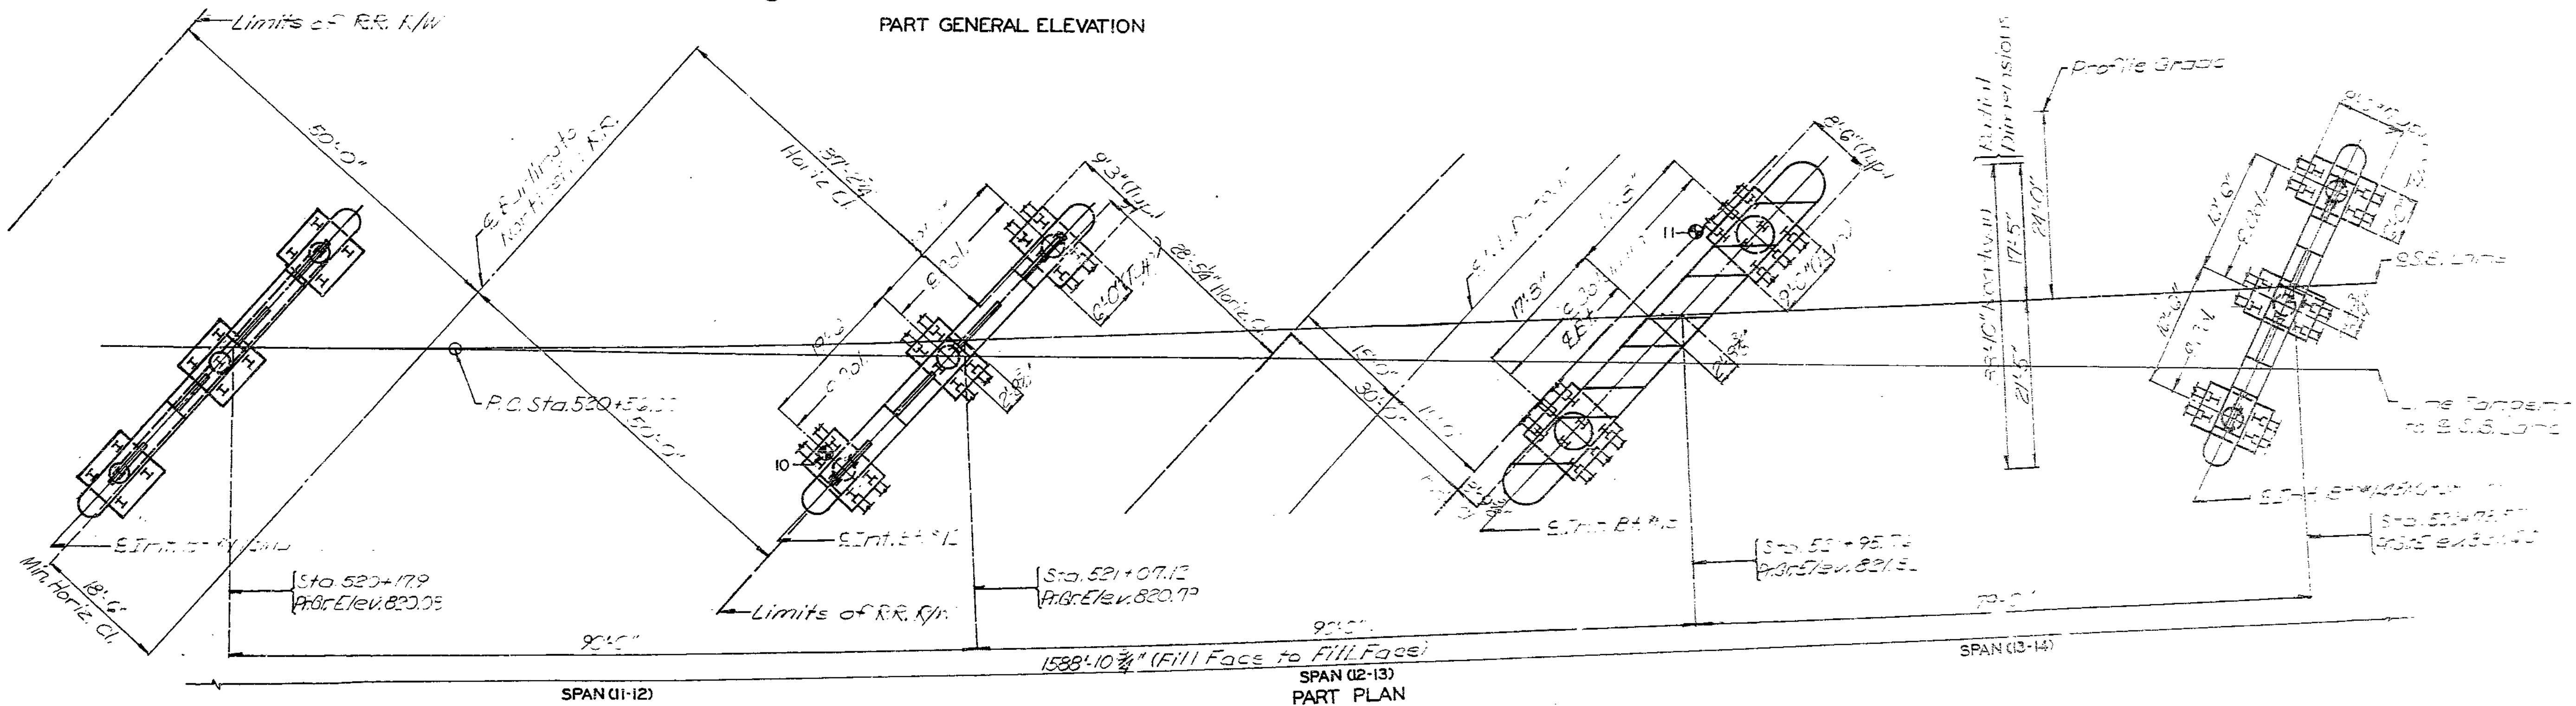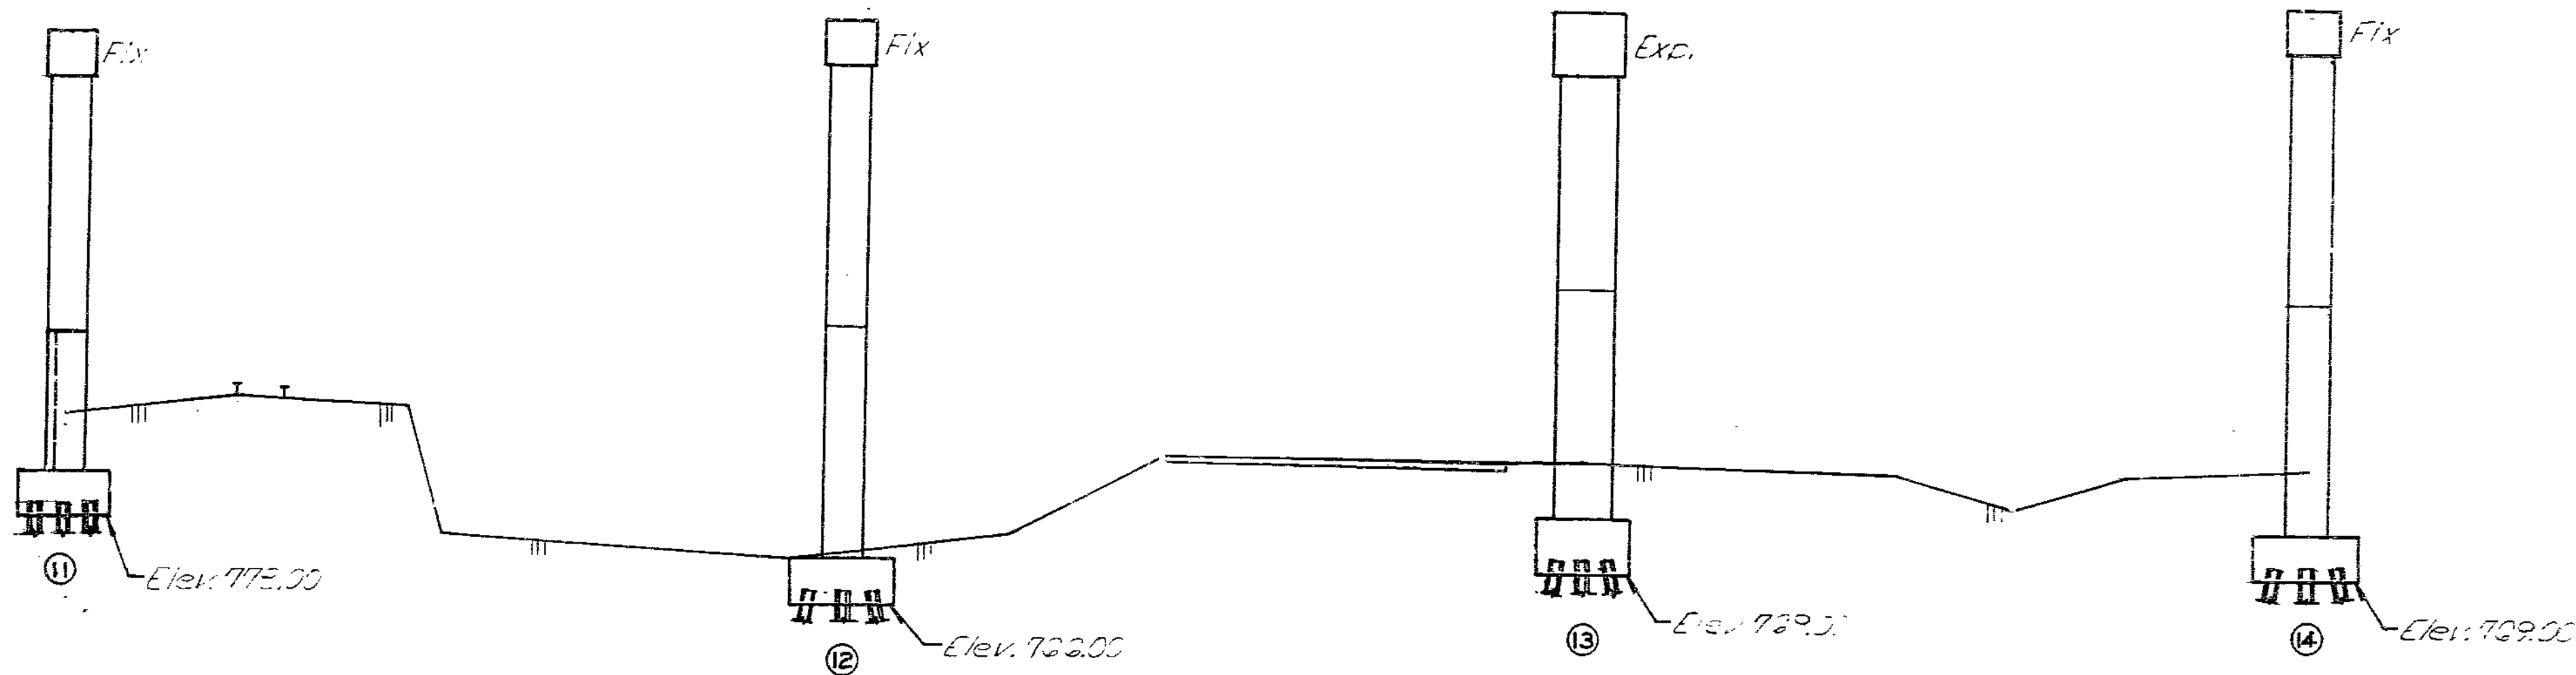

Note: For Borimo Data see sheet No. 10 & 11  
 \* Indicates location of Loring.

281 370

DETAILED JULY 1988  
 CHECKED Aug. 1988


Note: This drawing is not to scale. Follow dimensions.

Sheet No. EA of 55


JACKSON COUNTY A-2745

STATE	PROJ. NO.	SHEET NO.
MO	DE-0031 (980)	21

Sub No. 4-11-81-20

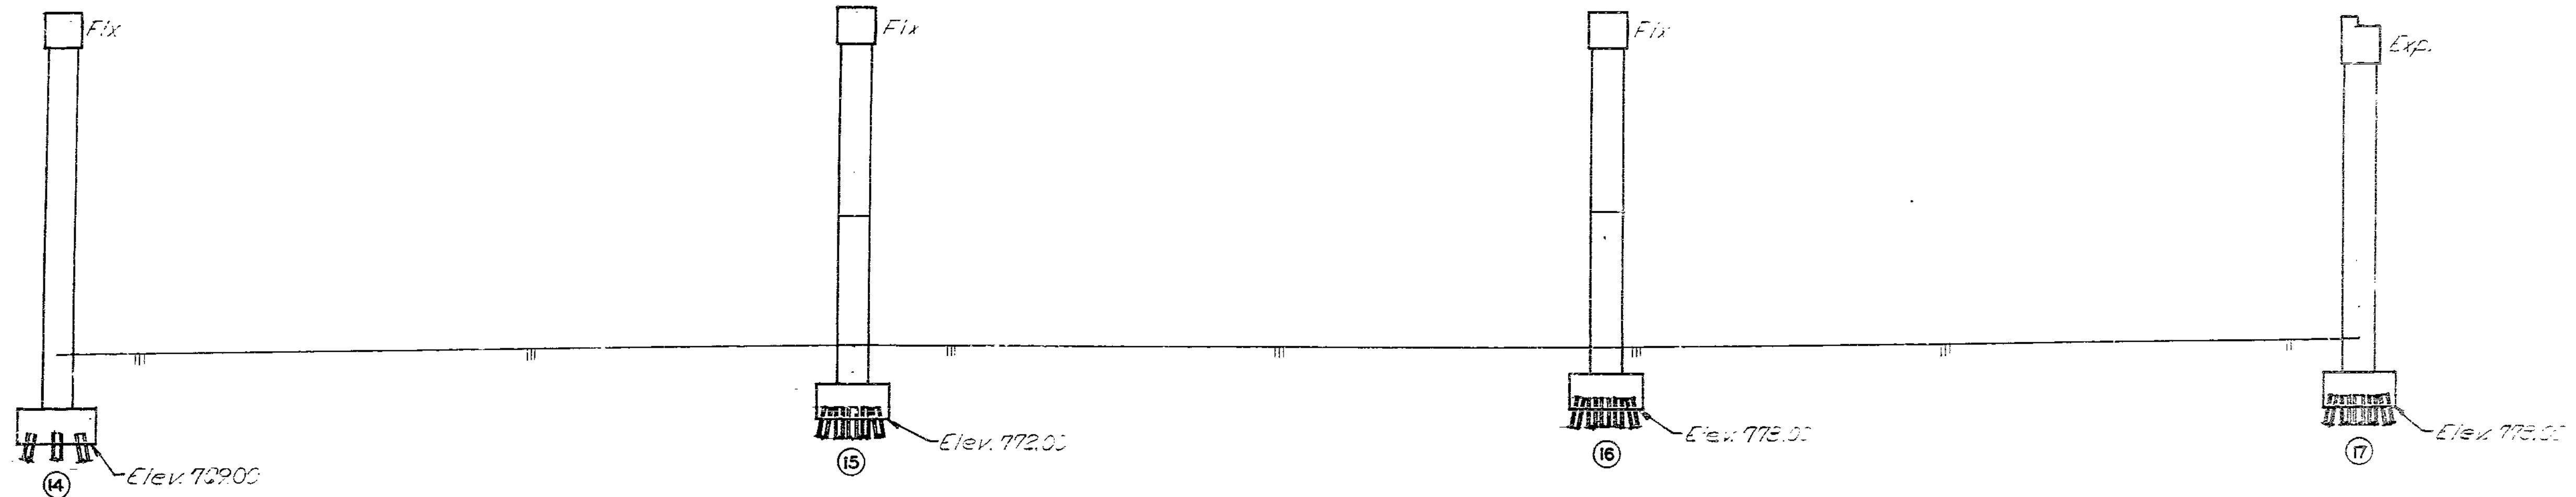

PART GENERAL ELEVATION

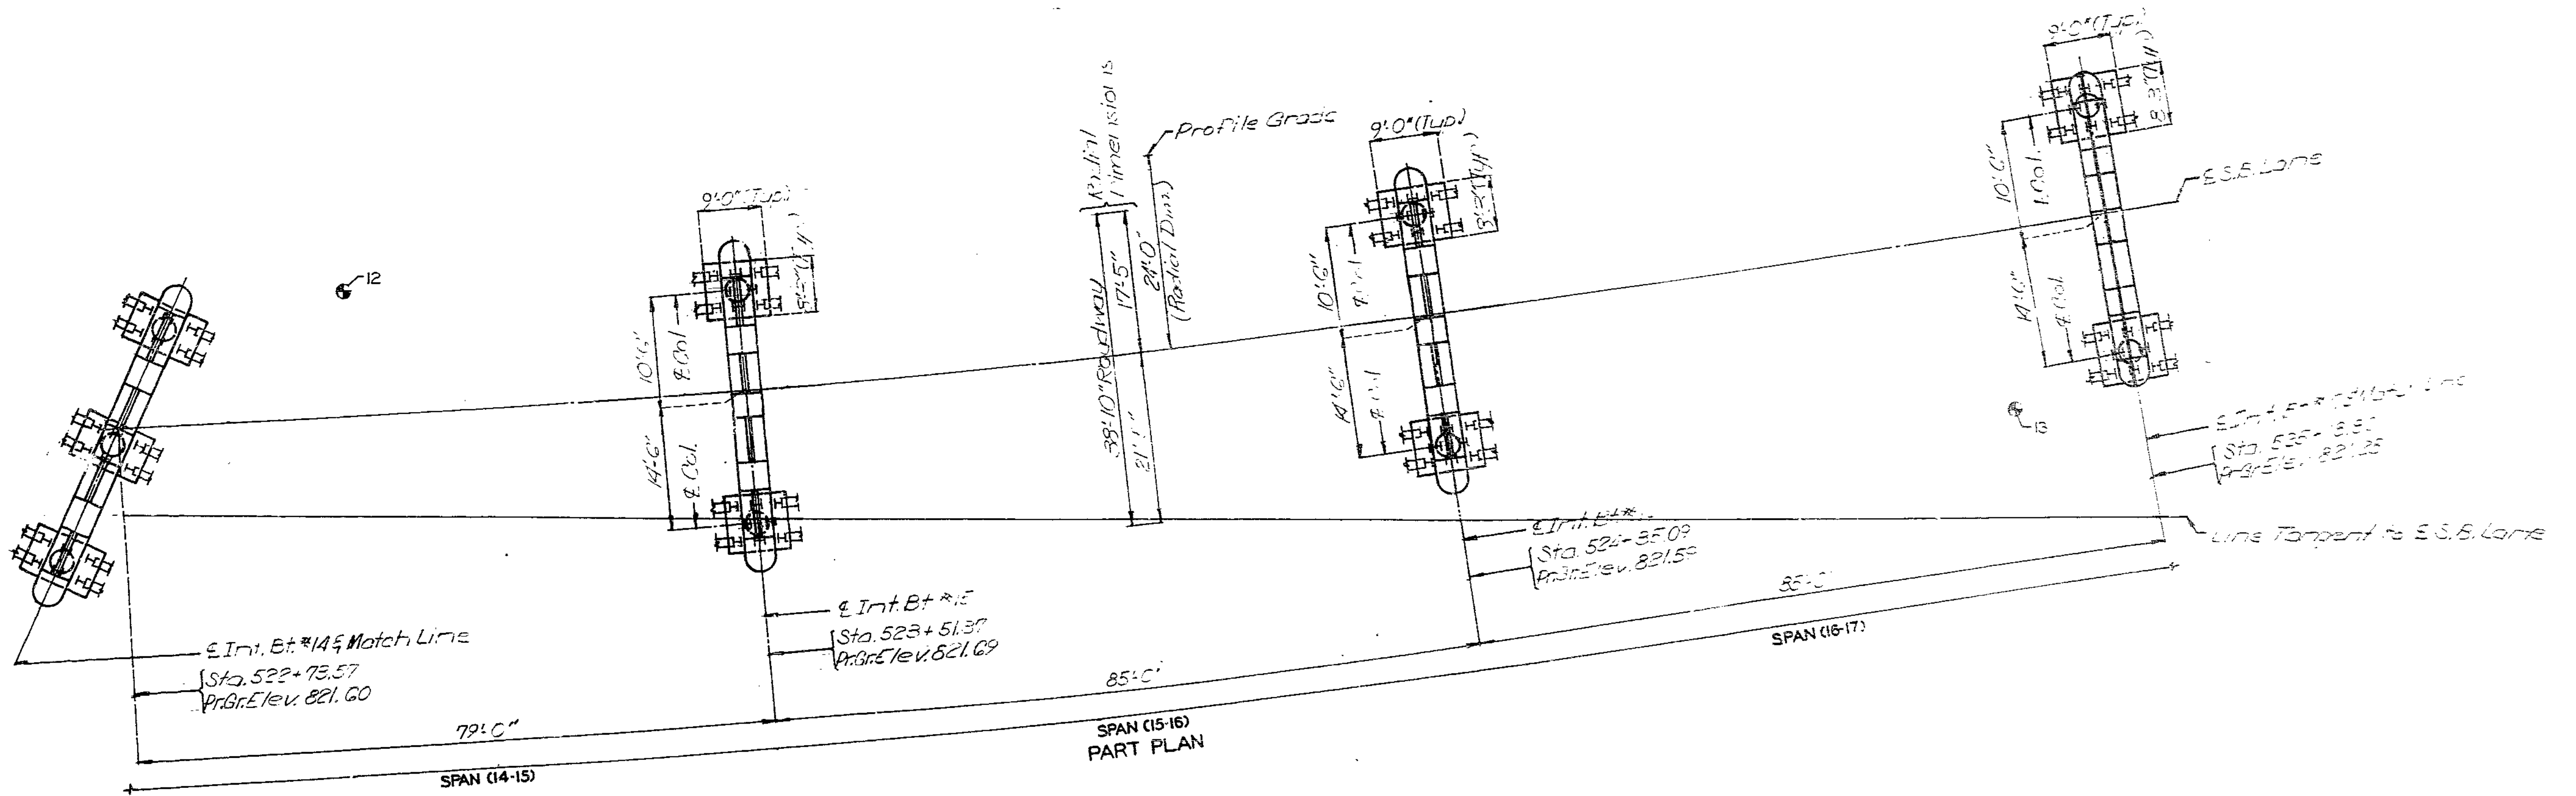

Note: For Earing Data see sheet No. 10 & 11.  
 \*Indicates location of barrier.

DETAILED JULY 1988  
 CHECKED AUG 1988

Note: This drawing is not to scale. Follow dimensions.

Sheet No. 6A of 55.



JACKSON COUNTY

A-2745


202 371



STATE	PROJ. NO.	SHEET NO.
MO.	DE-0031000	22
Job No 4-11-71-20		

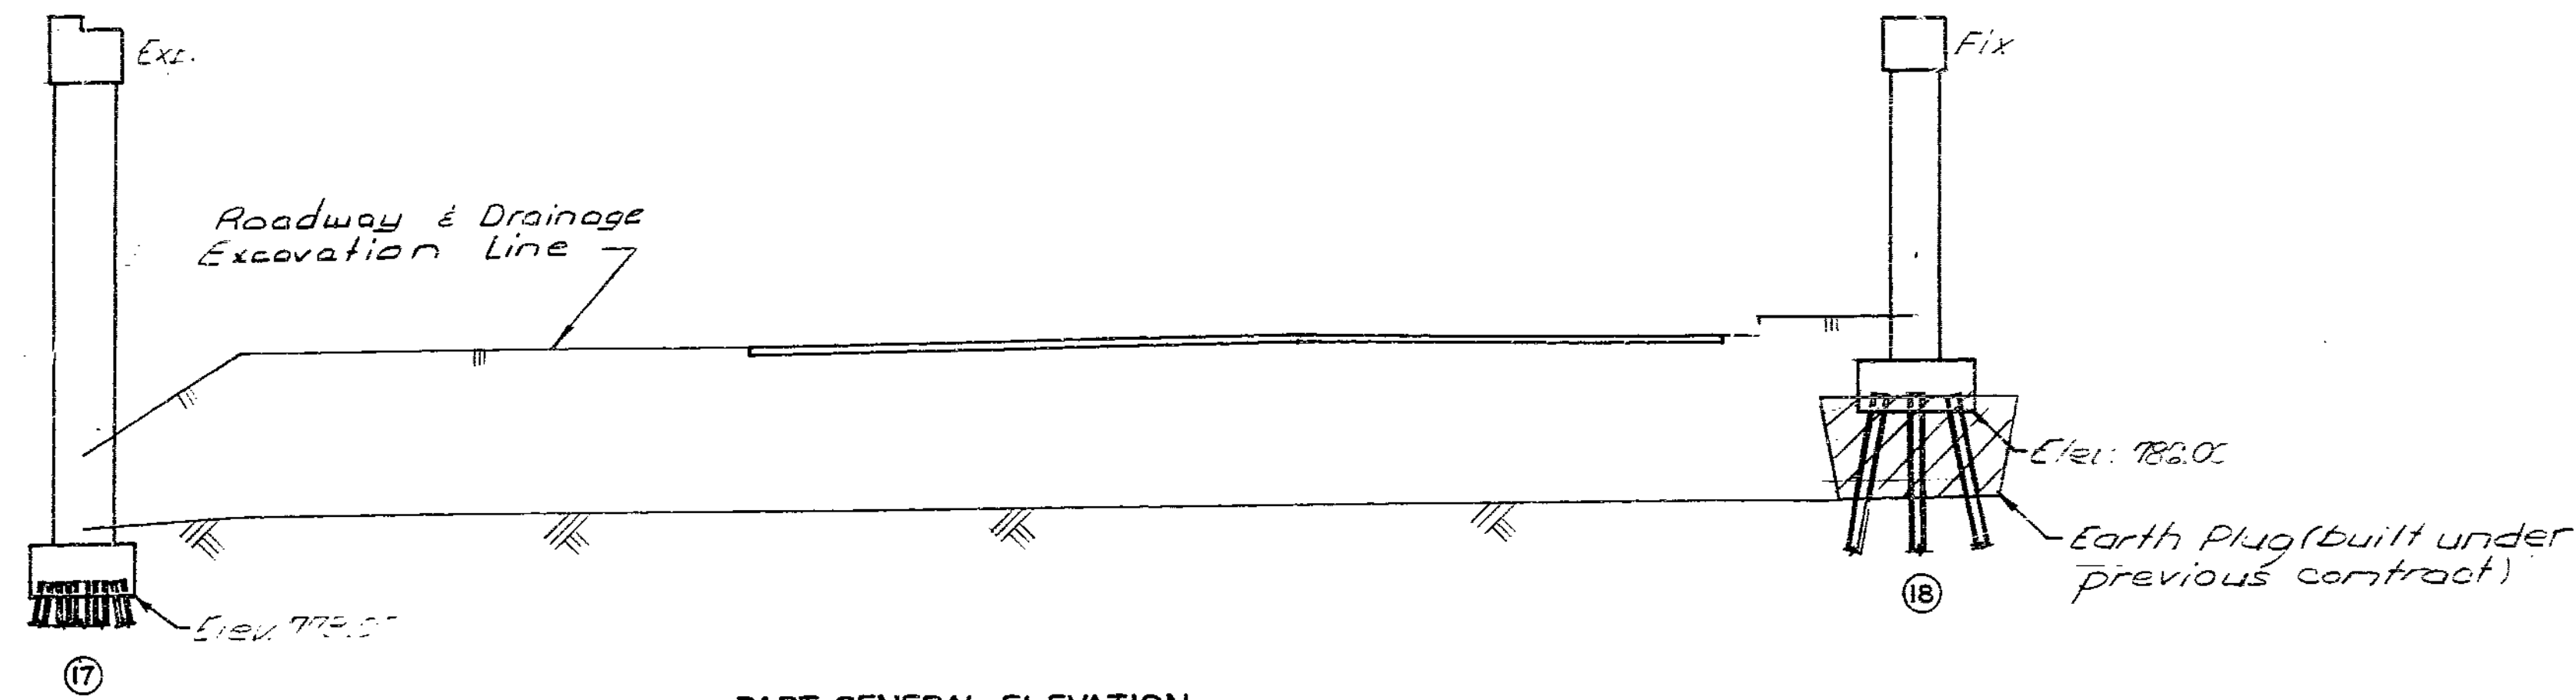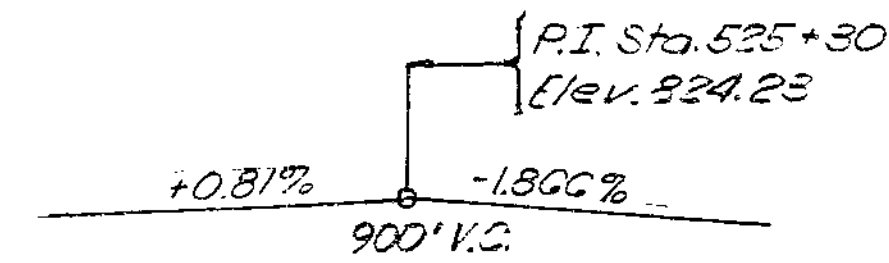

PART GENERAL ELEVATION

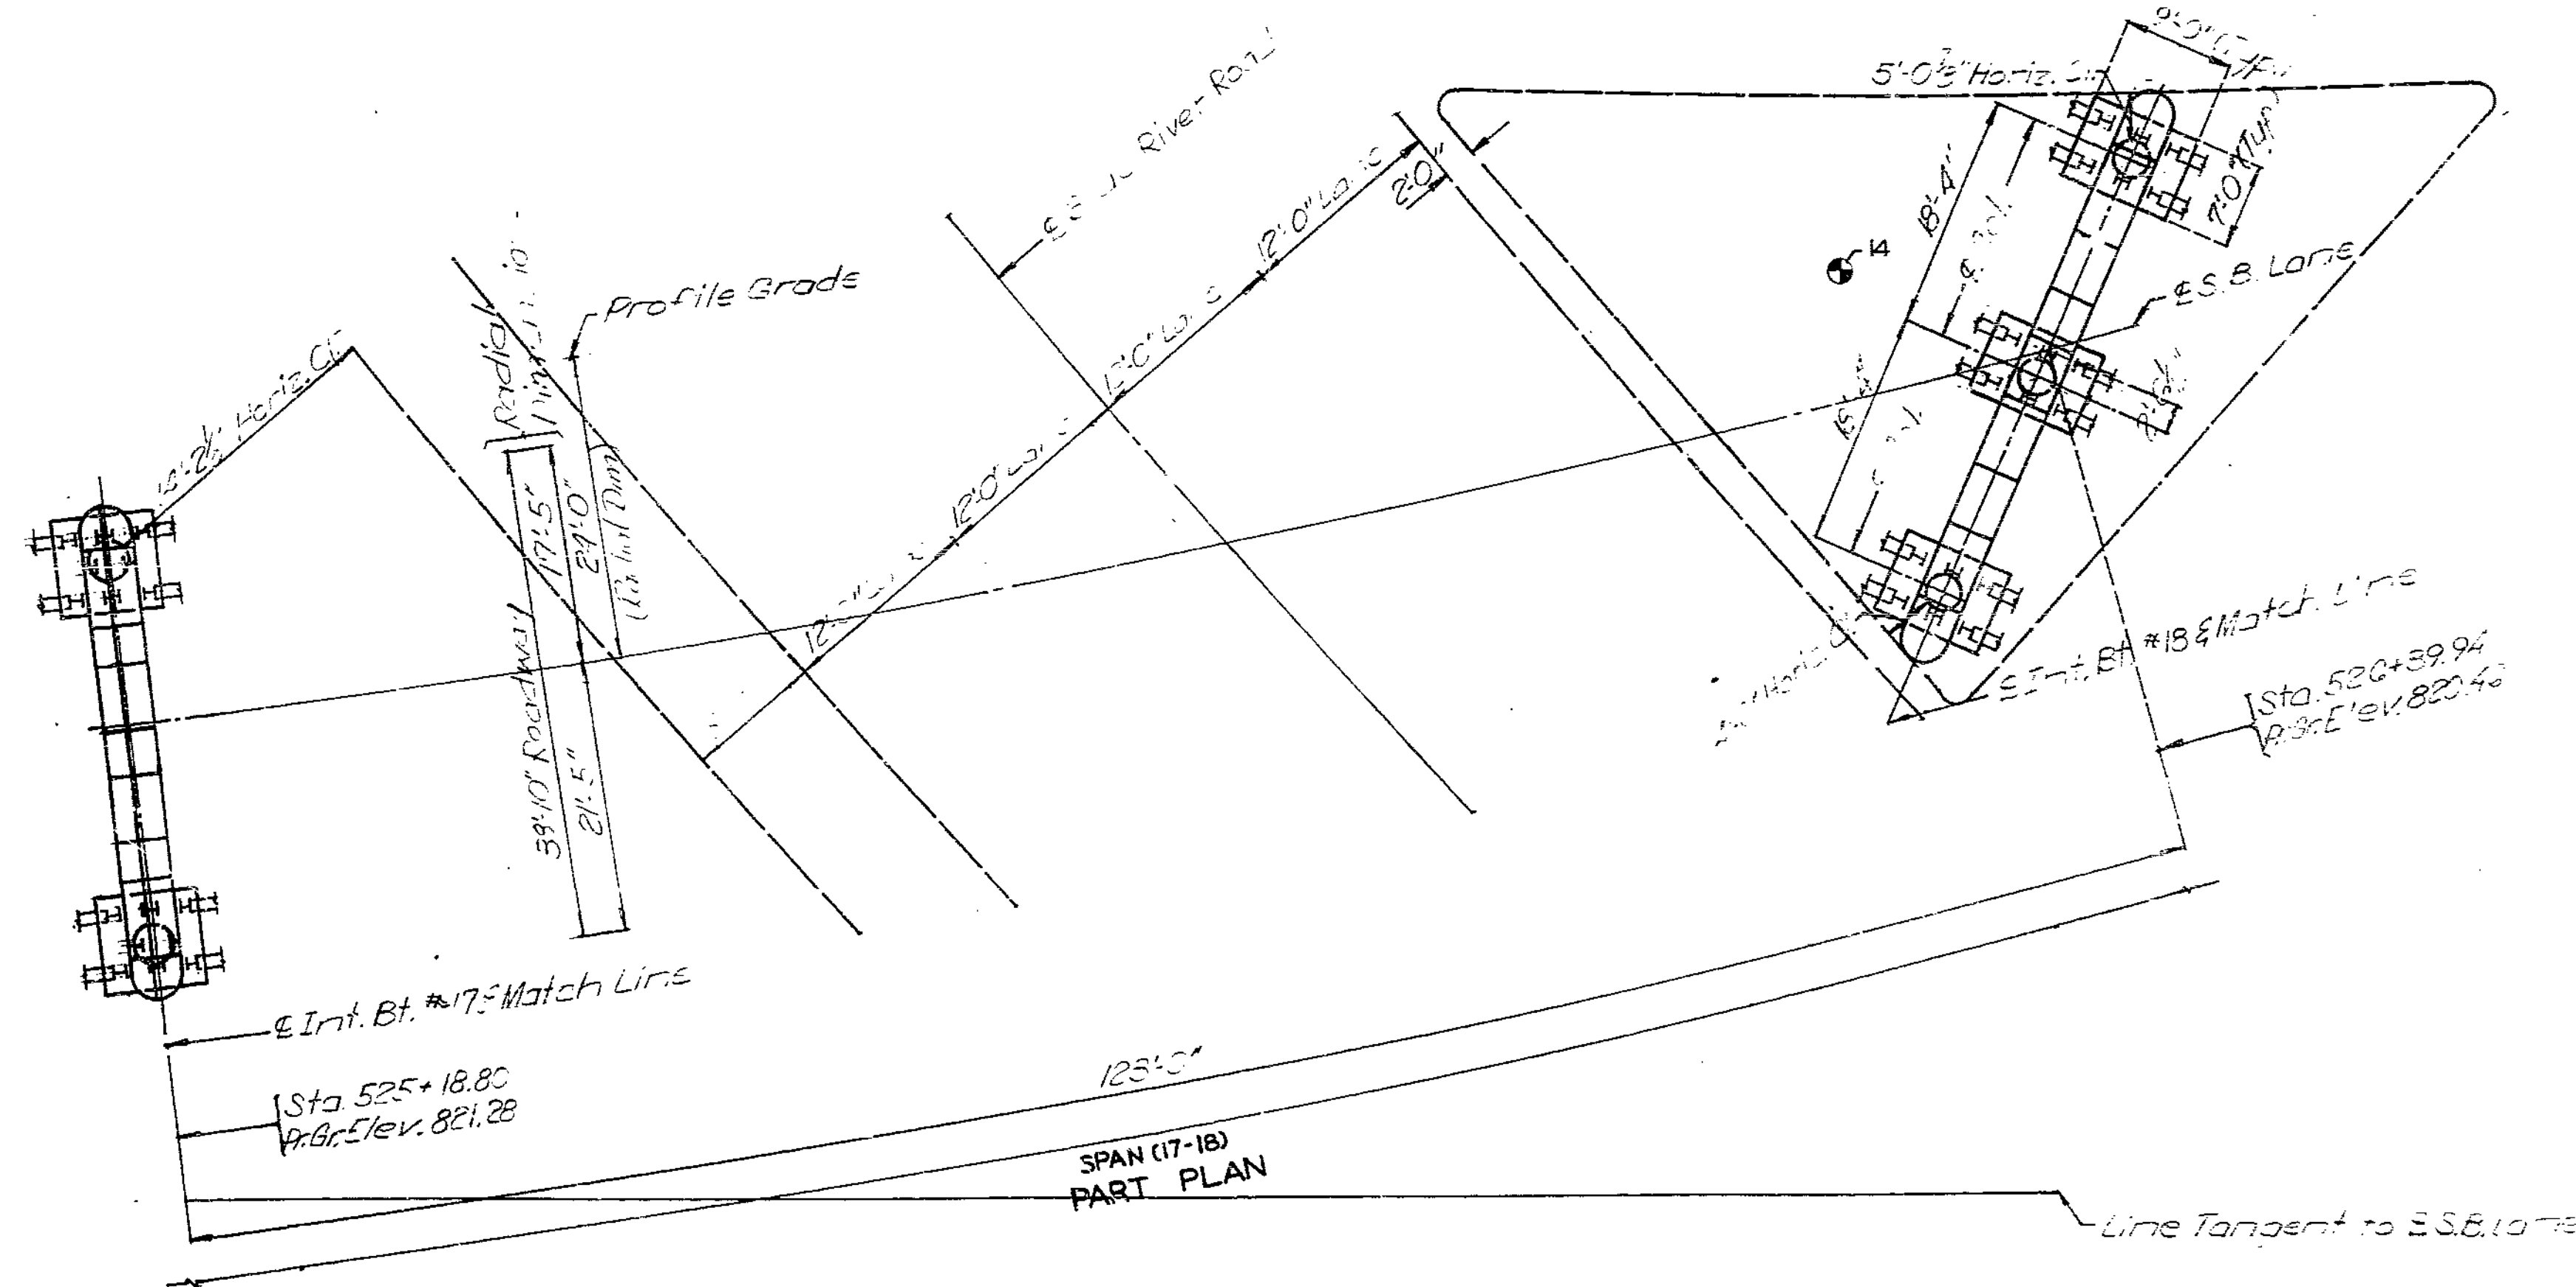

Note: For Boring Data see sheets No. 10 & 11.  
 ● Indicates location of boring.

203 372

DETAILED JULY 1988  
 CHECKED A.J. 1988

Note: This drawing is not to scale. Follow dimensions


Sheet No. 7A of 85

JACKSON COUNTY

A-2745


STATE	PROJ NO	SHEET NO
MO	1 E-00-1903	25

Job No. 4-0-71-20

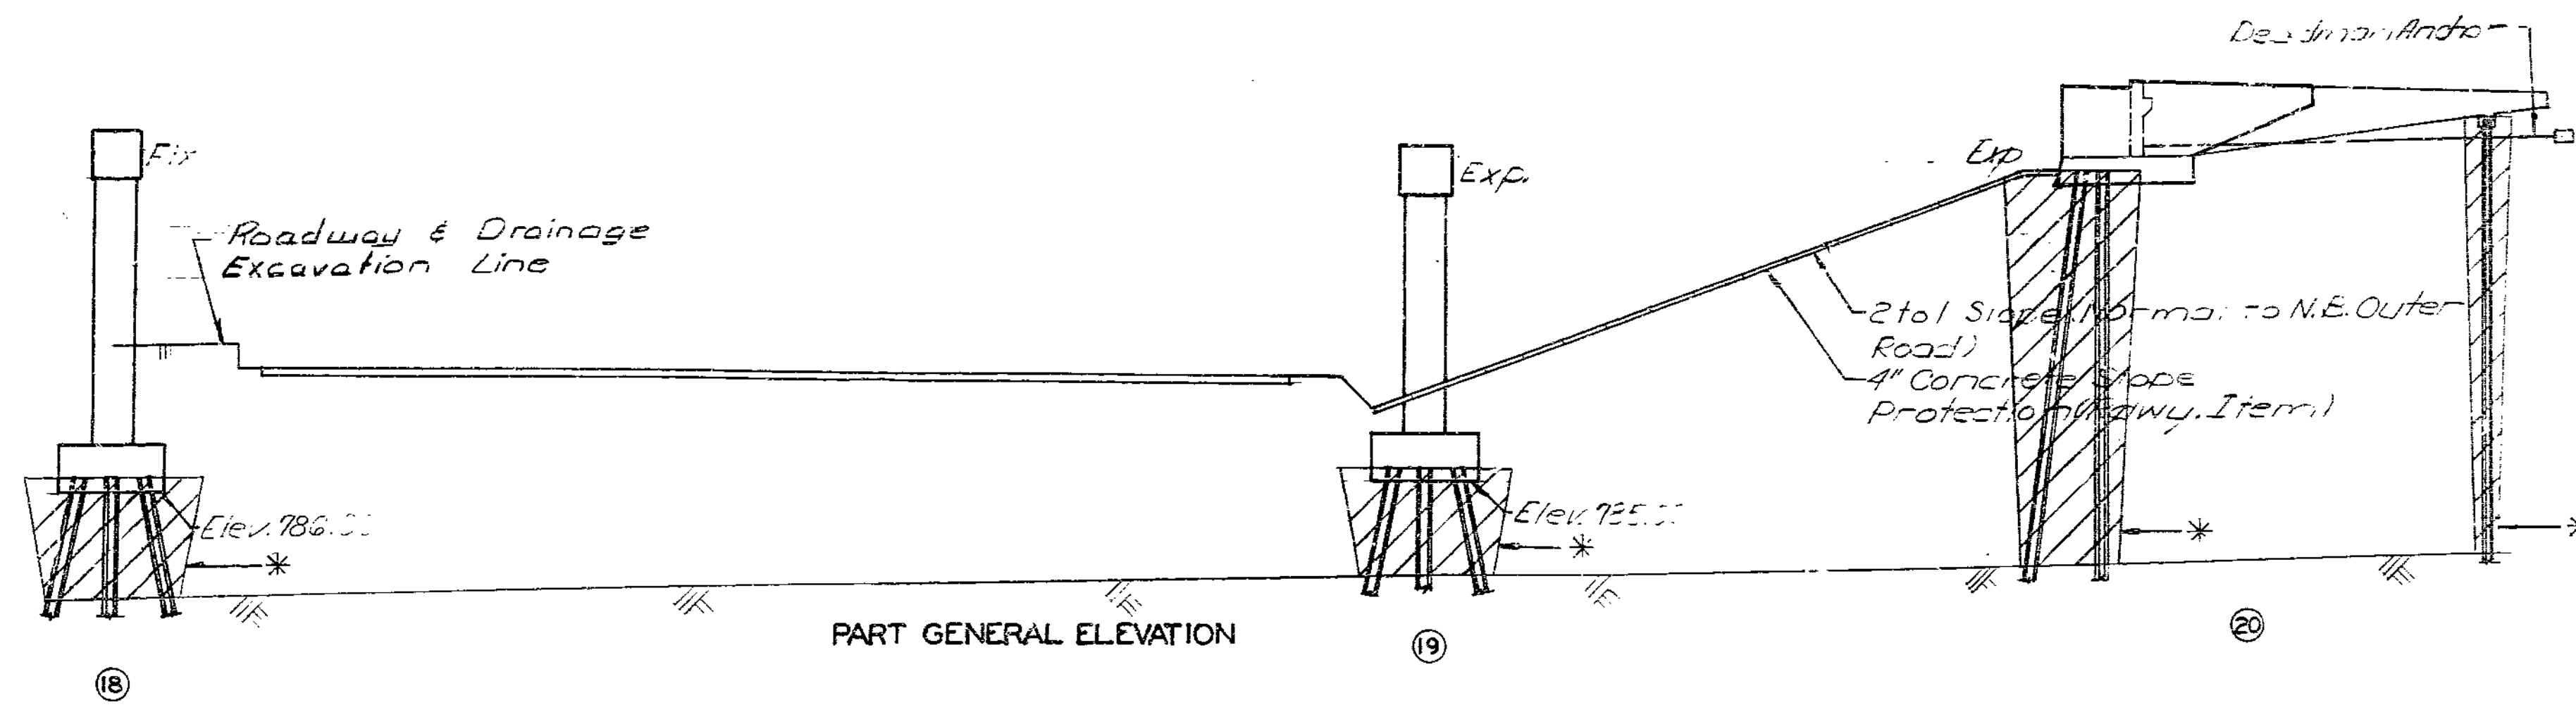

Note: Roadway fill shall be completed to the fire roadway section and up to the elevation of the bottom of the concrete beam within the limits of the structure and for not less than 25' in back of the fill face of the End Bents before piles are driven for any bents falling within the substructural section.

\*Earth Plug (built under previous contract)

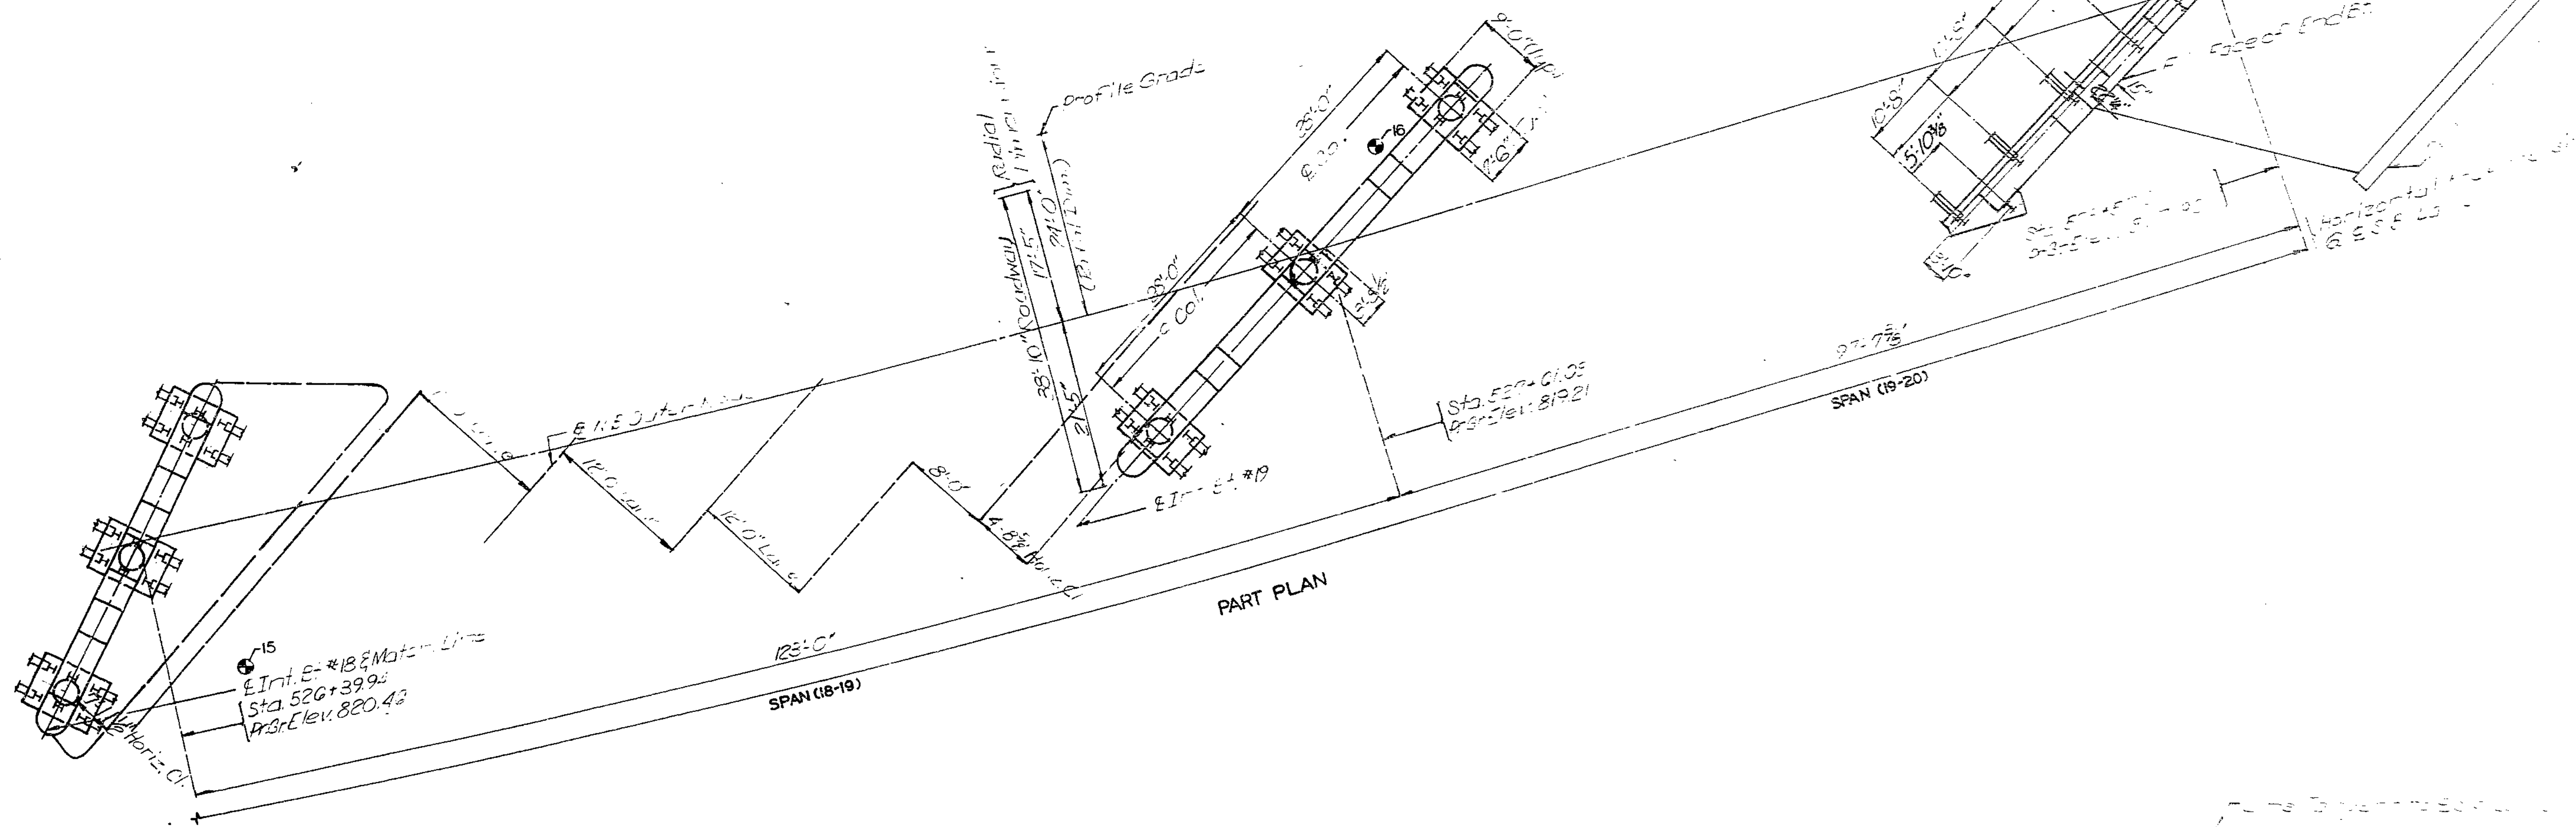

284 373

DETAILED JULY 1988  
CHECKED Aug 1988

Note: For boring data see sheets 10 & 11.  
Indicates location of bent 15.

Note: This drawing is not to scale. Follow dimensions.

Sheet No. 3A of 33

JACKSON COUNTY

A-2745

STATE	PROJ. NO.	SHEET NO.
MO	0E-005(1803)	24
Sht No 4-U-91-2L		

ITEM	QUANTITIES
Class 1 Excavation	Cu. Yd. 1144.5
Class 2 Excavation	Cu. Yd. 186.5
Structural Steel Piles (10")	Lin. Ft. 2008
Structural Steel Piles (12")	Lin. Ft. 8963
Pre-Bore for Piling	Lin. Ft. 306
Class B Concrete	Cu. Yd. 1769.1
Reinforcing Steel	Lb. 257,160
Reinforcing Steel (epoxy coated)	Lb. 1,950
Deadman Anchor Assembly	Each 2

HYDROLOGIC DATA
Drainage Area = 199.7 Sq. Mi.
Design Discharge = 57,500 c.f.s. (100 Years)
Design H.W. Elevation = 795.1
Backwater is negligible
BASIC FLOOD DATA

GENERAL NOTES:

Design Specifications:  
A.A.S.H.T.O. - 1983 and Interims 1984, 1985, 1986 & 1987  
Load Factor Design

Design Loading:  
HS20-44 35' Future Wearing Surface  
Modified 24,000# Tandem Axle  
Earth 120#/cu.ft., Equivalent Fluid Pressure 45#/cu.ft.

Design Unit Stresses:  
Class B concrete (Substructure)  $f_c = 3,000$  psi  
Reinforcing Steel (Grade 60)  $f_y = 60,000$  psi  
Steel Pile  $f_b = 9,000$  psi


Note: All reinforcing bars in tops of substructure beams or caps were spaced to clear anchor bolts for bearings by at least 1/2".  
Reinforcing Steel:  
Minimum clearance to reinforcing steel is 1/2", unless otherwise shown.

Construction Clearance:  
Monch. Trway, a minimum vert. clearance of 14'-6" from crown of existing lanes and a minimum lateral clearance of 52'-0" centered on existing lanes was maintained during construction.  
Burlington Northern R.R. minimum lateral clearance of 12'-0" from E Tracks, was in accordance with R.R. contract.  
N.B. Rte. 71 Detour a min. vert. clearance of 14'-6" from crown of existing lanes and a min. lateral clearance of 34'-0" centered on lanes.  
Blue River Rd. a min. vert. clearance of 14'-6" from crown of existing lanes and a min. lateral clearance of 52'-0" centered on lanes.  
North Outer Road a min. vert. clearance of 14'-6" from crown of existing lanes and a min. lateral clearance of 2'-0" from Pav't. edge (each side).


LOCATION	ANCHOR BOLT SIZE	C	D
BT. NO. 4, 9 & 13	2" $\phi$ *		
BT. NO. 17 SPAN (16-17)	1 1/2" $\phi$ *	15"	9 1/8"
END BENT NO. 20	1 1/2" $\phi$ *		
BT. NO. 17 SPAN (17-18)	2" $\phi$ *	18"	9 1/8"
BENT NO. 19			
BENT NO. 18	2 1/2" $\phi$ *	25"	9 1/8"

\*\* Bts. No. 4, 9, 13 & Bt. No. 17 Span (16-17) Use 2"  $\phi$  Anchor Bolts. However use the spiral reinforcement (W-Bars) as detailed on Int. Bt. sheets.


\* Anchor Bolts are included in future construction.

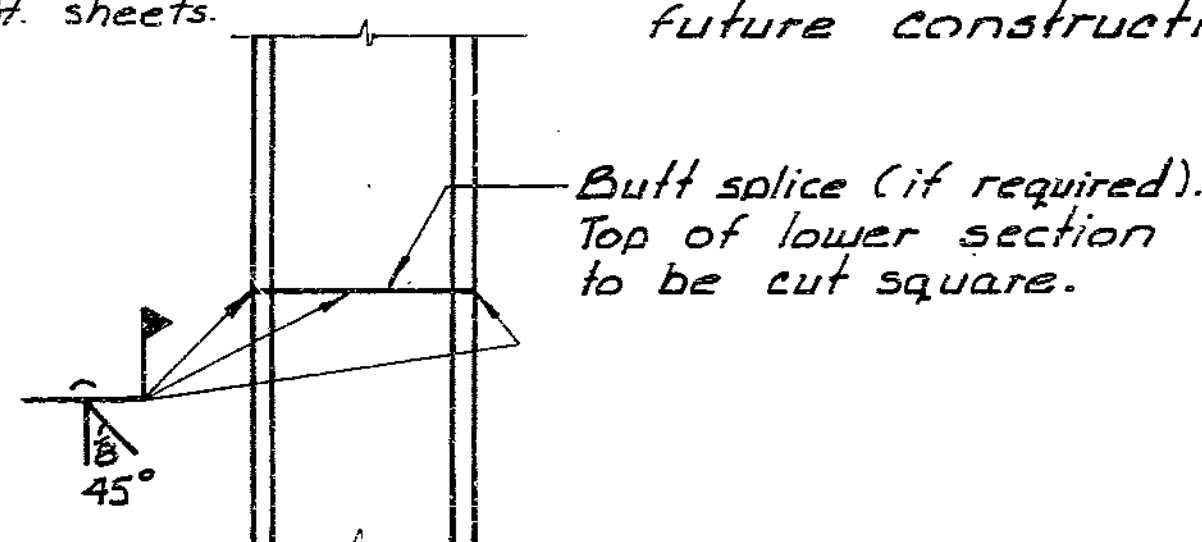

DETAIL OF STEEL PILE SPLICE

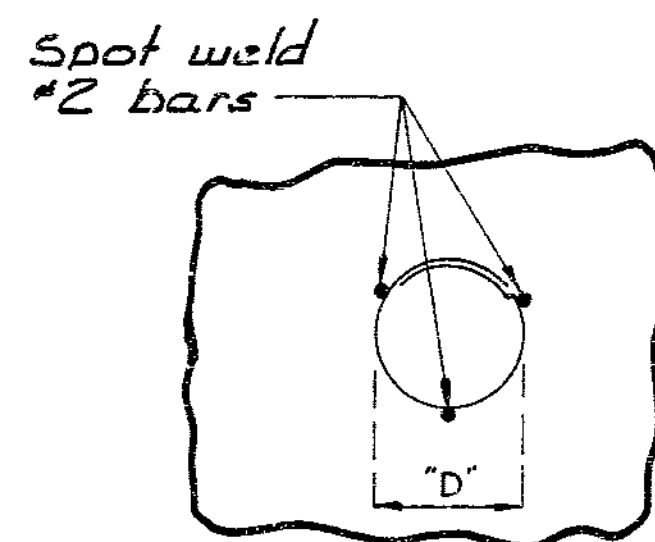

PLAN

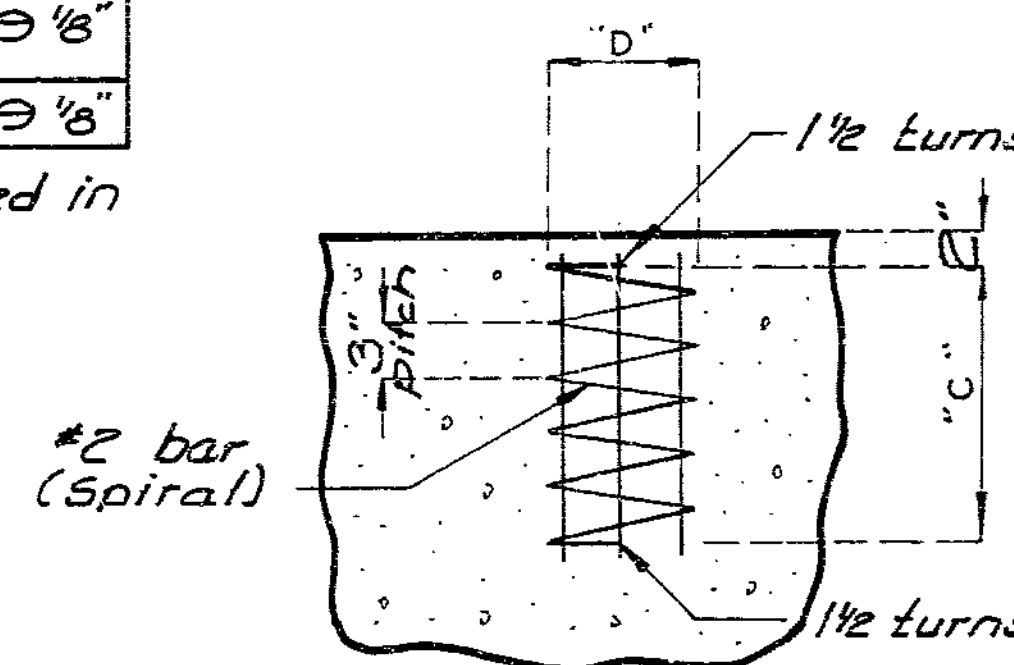

SECTION

DETAILS OF ANCHOR BOLT SPIRALS


BENT NO.	PILE DATA																				
	1	2	3	4	5	6	7	8	9	10	11	12	13	14	15	16	17	18	19	20	
PILE TYPE AND SIZE	HP12x53	HP12x53	HP12x53	HP10x42	HP12x53	HP12x53	HP12x53	HP12x53	HP12x53	HP12x53	HP12x53	HP12x53	HP12x53	HP12x53	HP12x53	HP12x53	HP10x42	HP12x53	HP12x53	HP10x42	
NUMBER	5	12	12	12	12	20	20	15	12	15	15	13	16	15	16	16	16	15	13	10	2
APPROXIMATE LENGTH FT.	71	50	46	46	46	14	14	29	30	31	35	31	33	33	36	36	37	51	49	75	59
DESIGN BEARING TONS	67	61	61	53	57	69	69	61	63	59	67	64	69	70	59	59	55	68	60	53	5
HAMMER ENERGY REQUIRED FT.-LBS.	14900	14300	14300	12400	13400	15400	15400	14300	14800	13800	14900	15000	16200	16500	13800	13800	12900	16000	14100	13100	9300

Note: Minimum energy requirement of hammer is based on plan length and design bearing value of piles.  
All piles shall be driven to practical refusal.  
Prebored for piles at Bent 20 to elevation 785.00.

305 374



STATE	PROJ. NO	SHEET NO
MO	DE-0021(803)	25
JOB NO. 4-11-71-20		

Note: For Details of Intermediate Bent No. 4 not shown see sheet No. 20.  
For detail of anchor bolt spirals see sheet No. 9

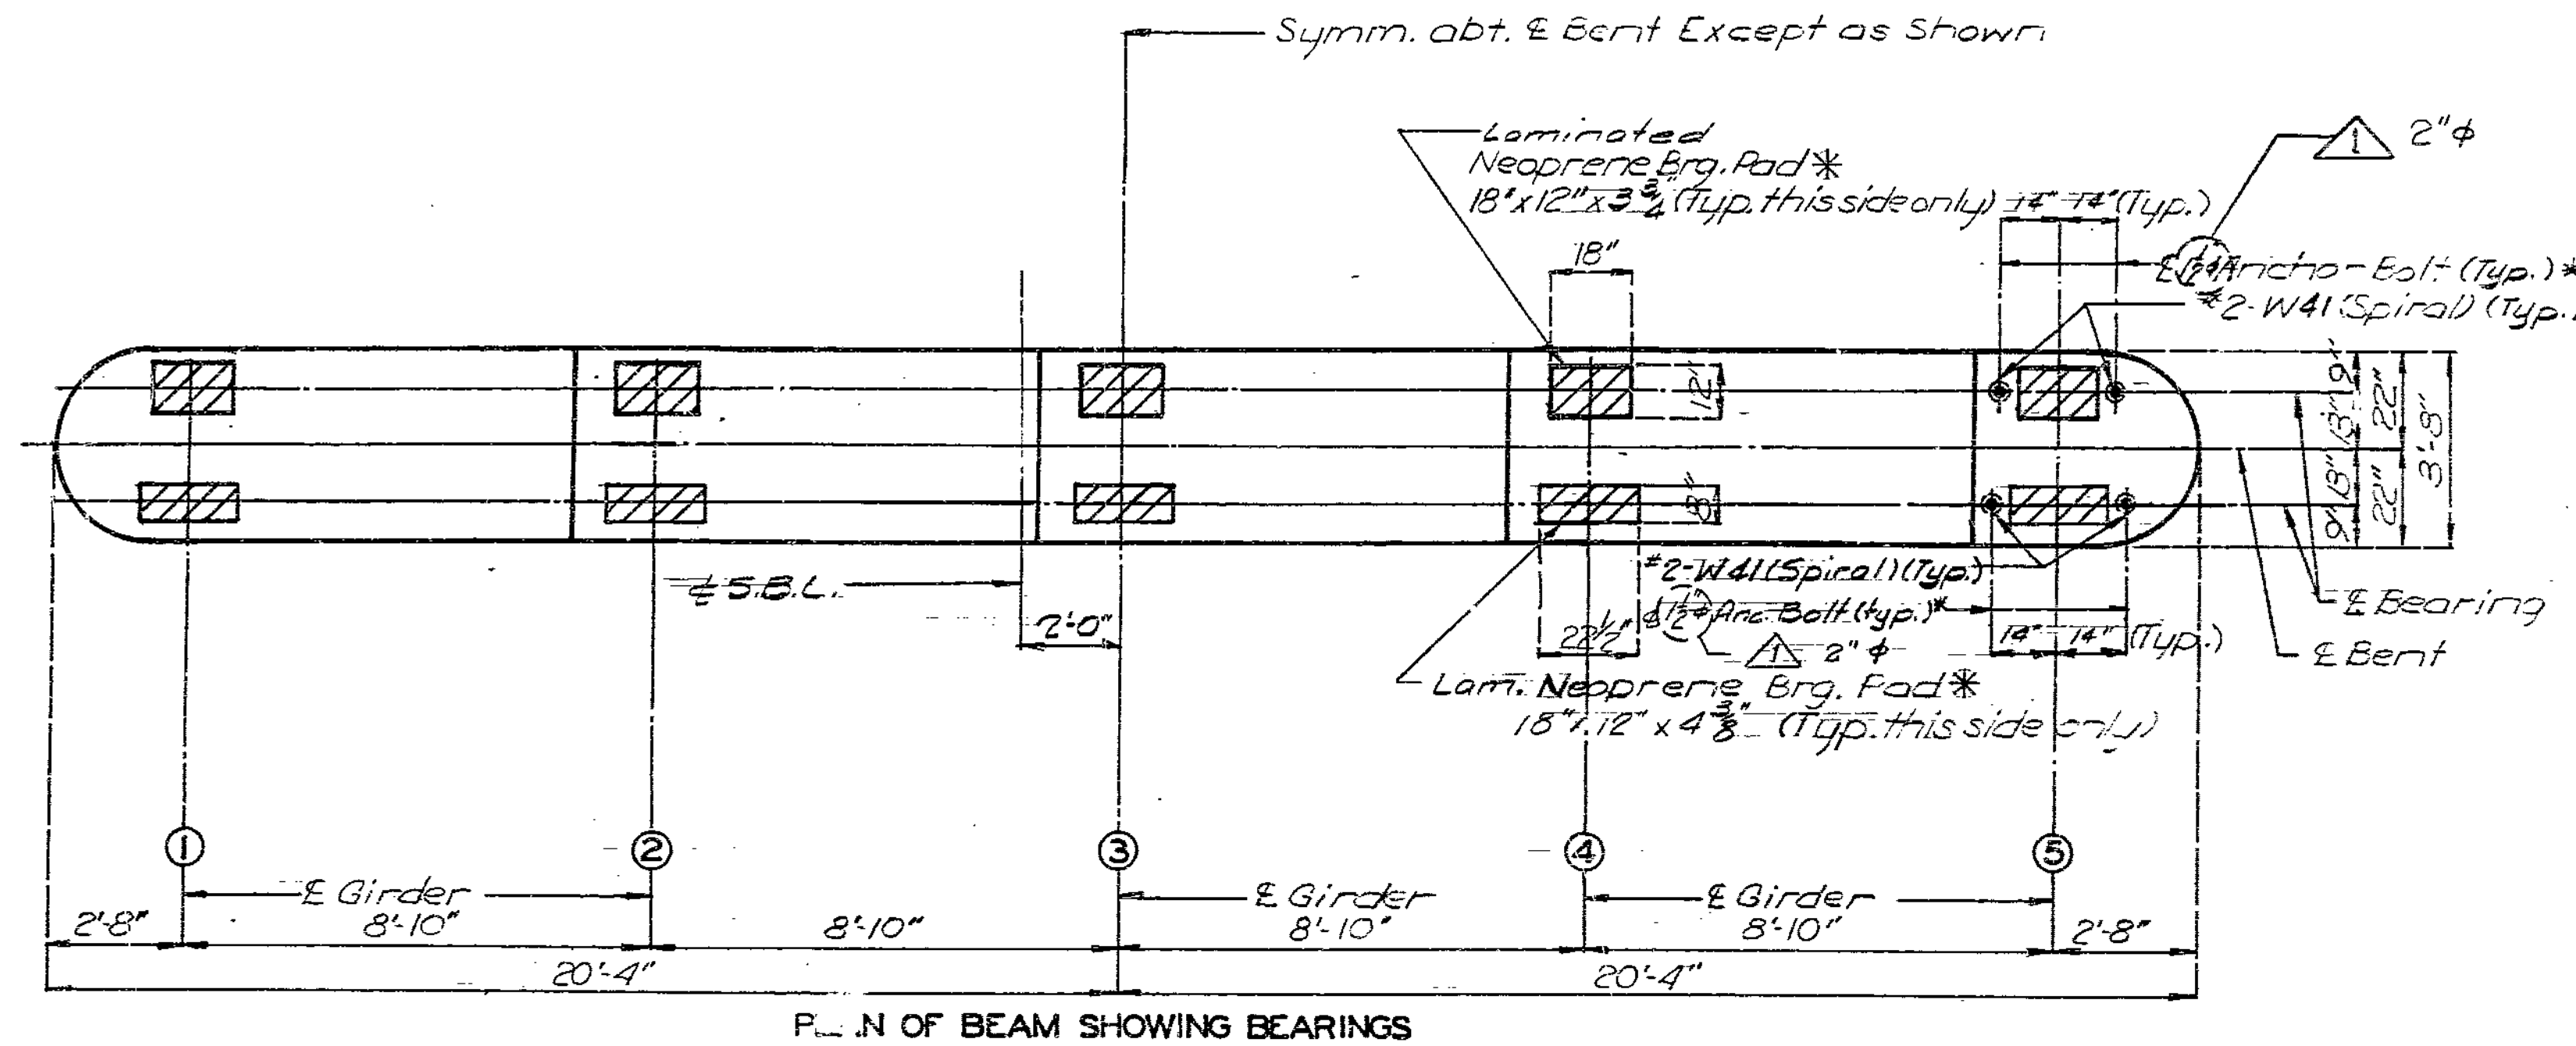

\* Bearings & Anchor Bolts are in future construction.

215 375

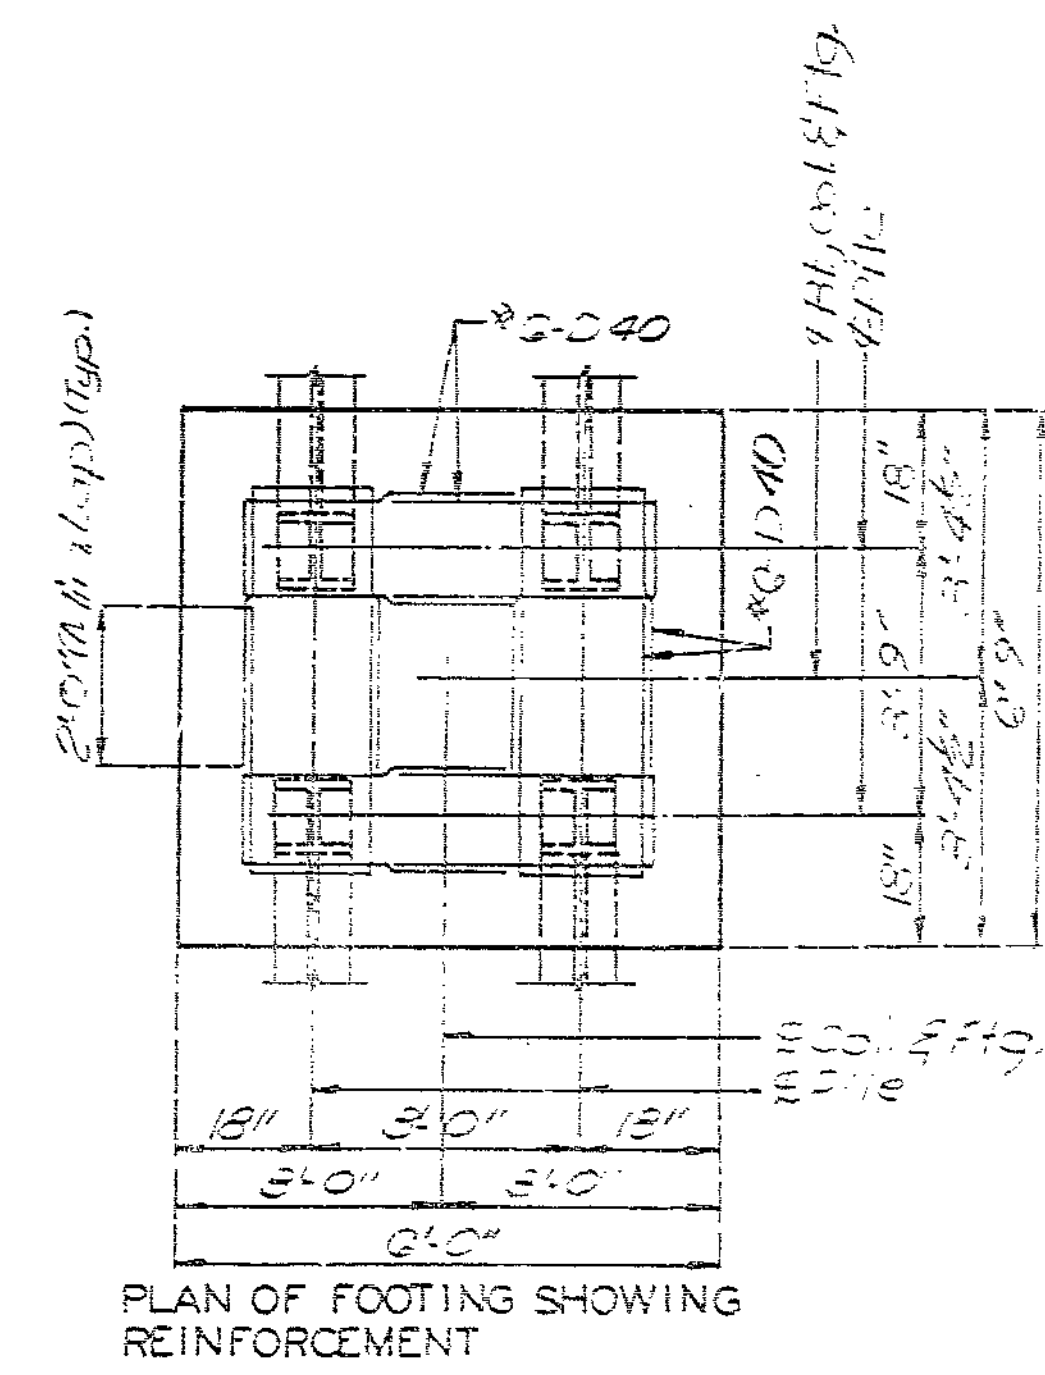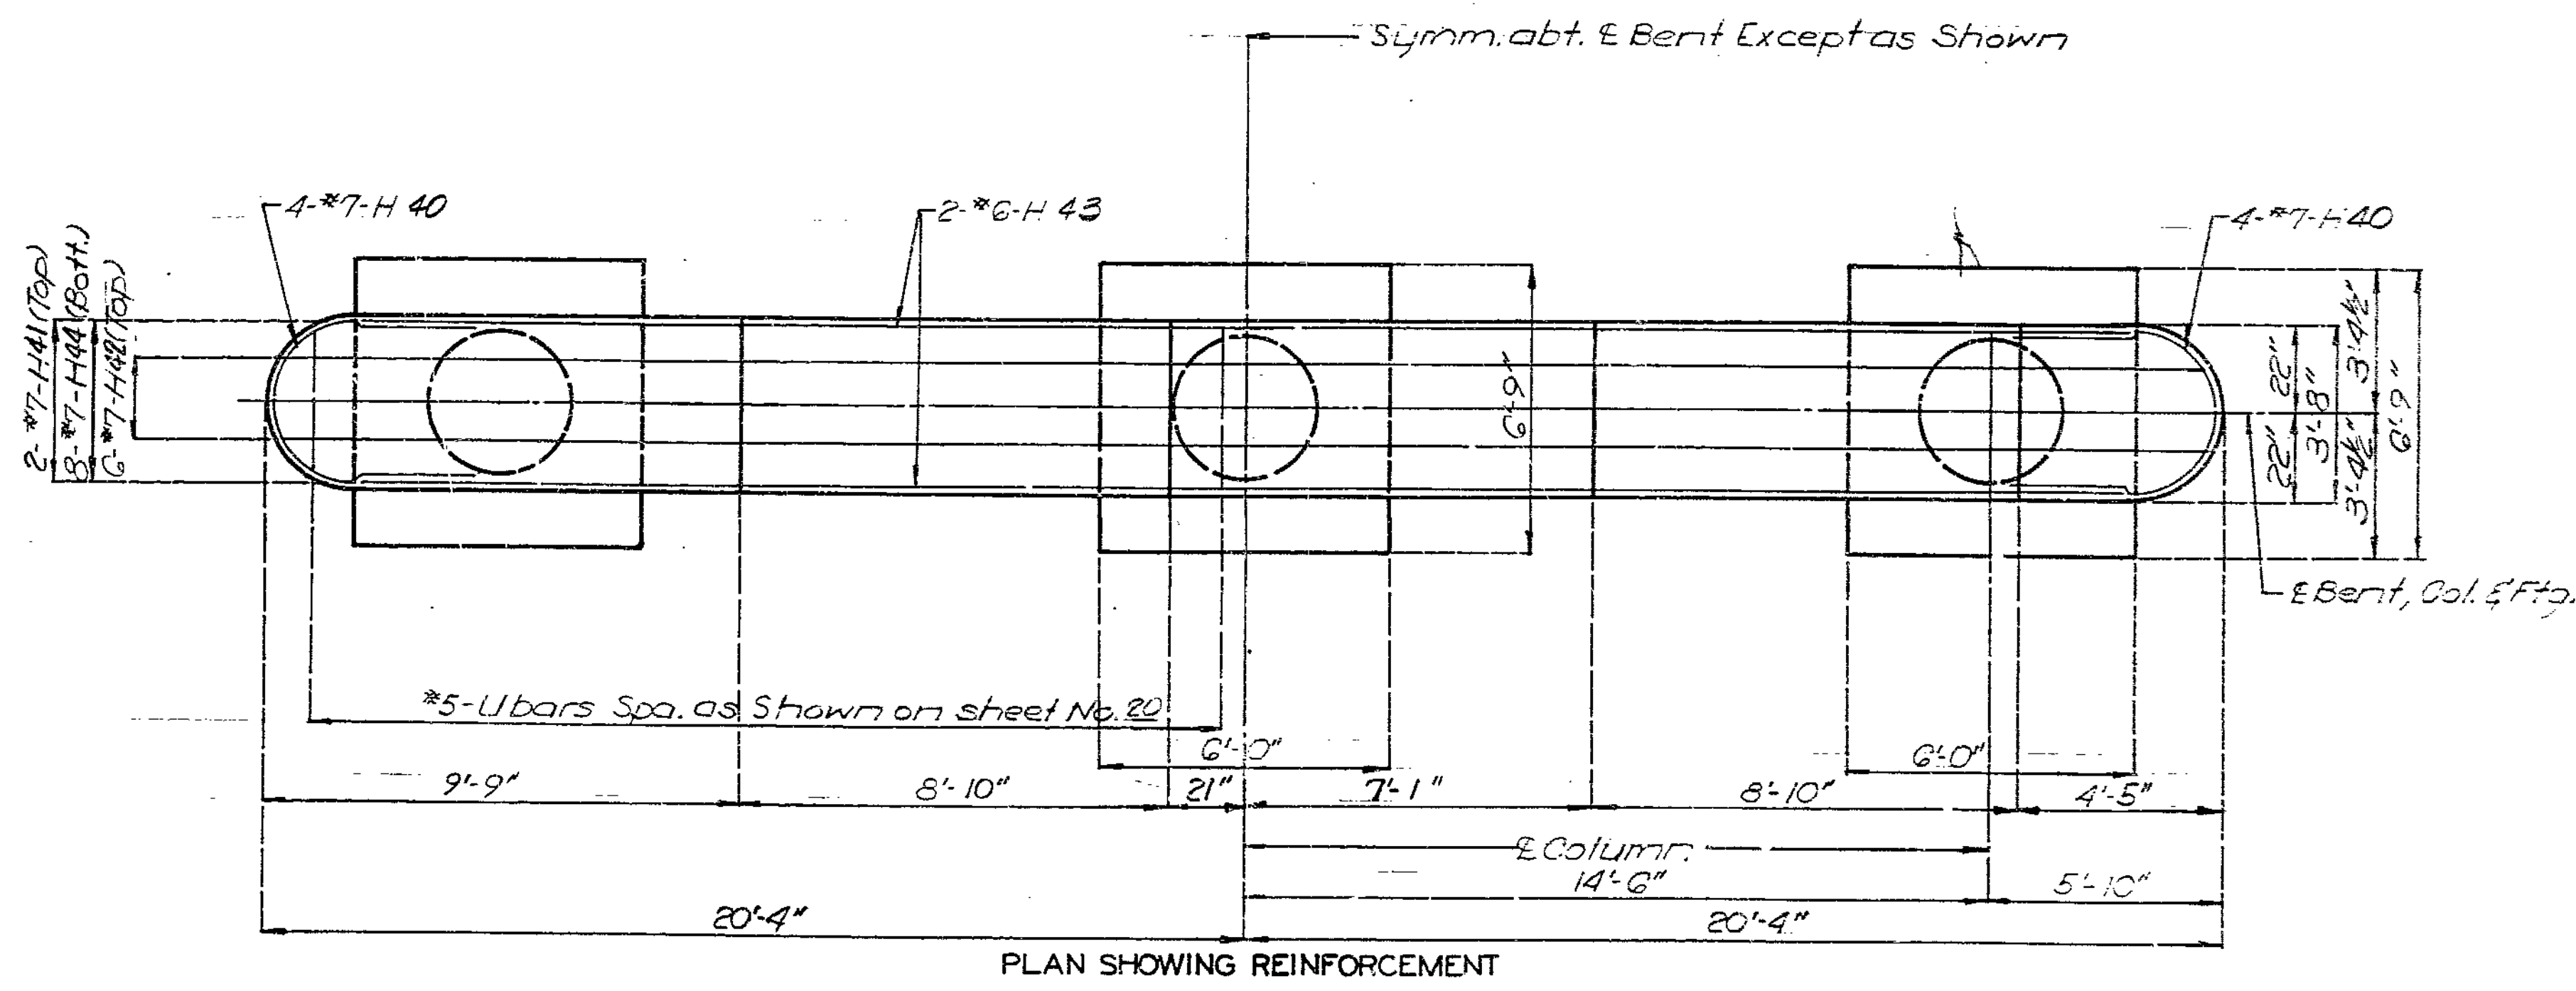

DETAILS OF INTERMEDIATE BENT NO. 4

DETAILED APR. 1988  
CHECKED AUG. 1988

Note: This drawing is not to scale. Follow dimensions.

Revised 3/8/89



Sheet No. 15 A of 55

JACKSON COUNTY


A-2745

STATE	PROJ NO	SHEET NO
MO	DE-0031 (805)	81
Sub No 4-U-71-BV		


Note: For details of Bt. No 9 not shown see sheet No. 28.  
 For Details of Anchor Bolt Spirals see sheet No. 9.  
 \* Bearings and Anchor Bolts are included in future construction.

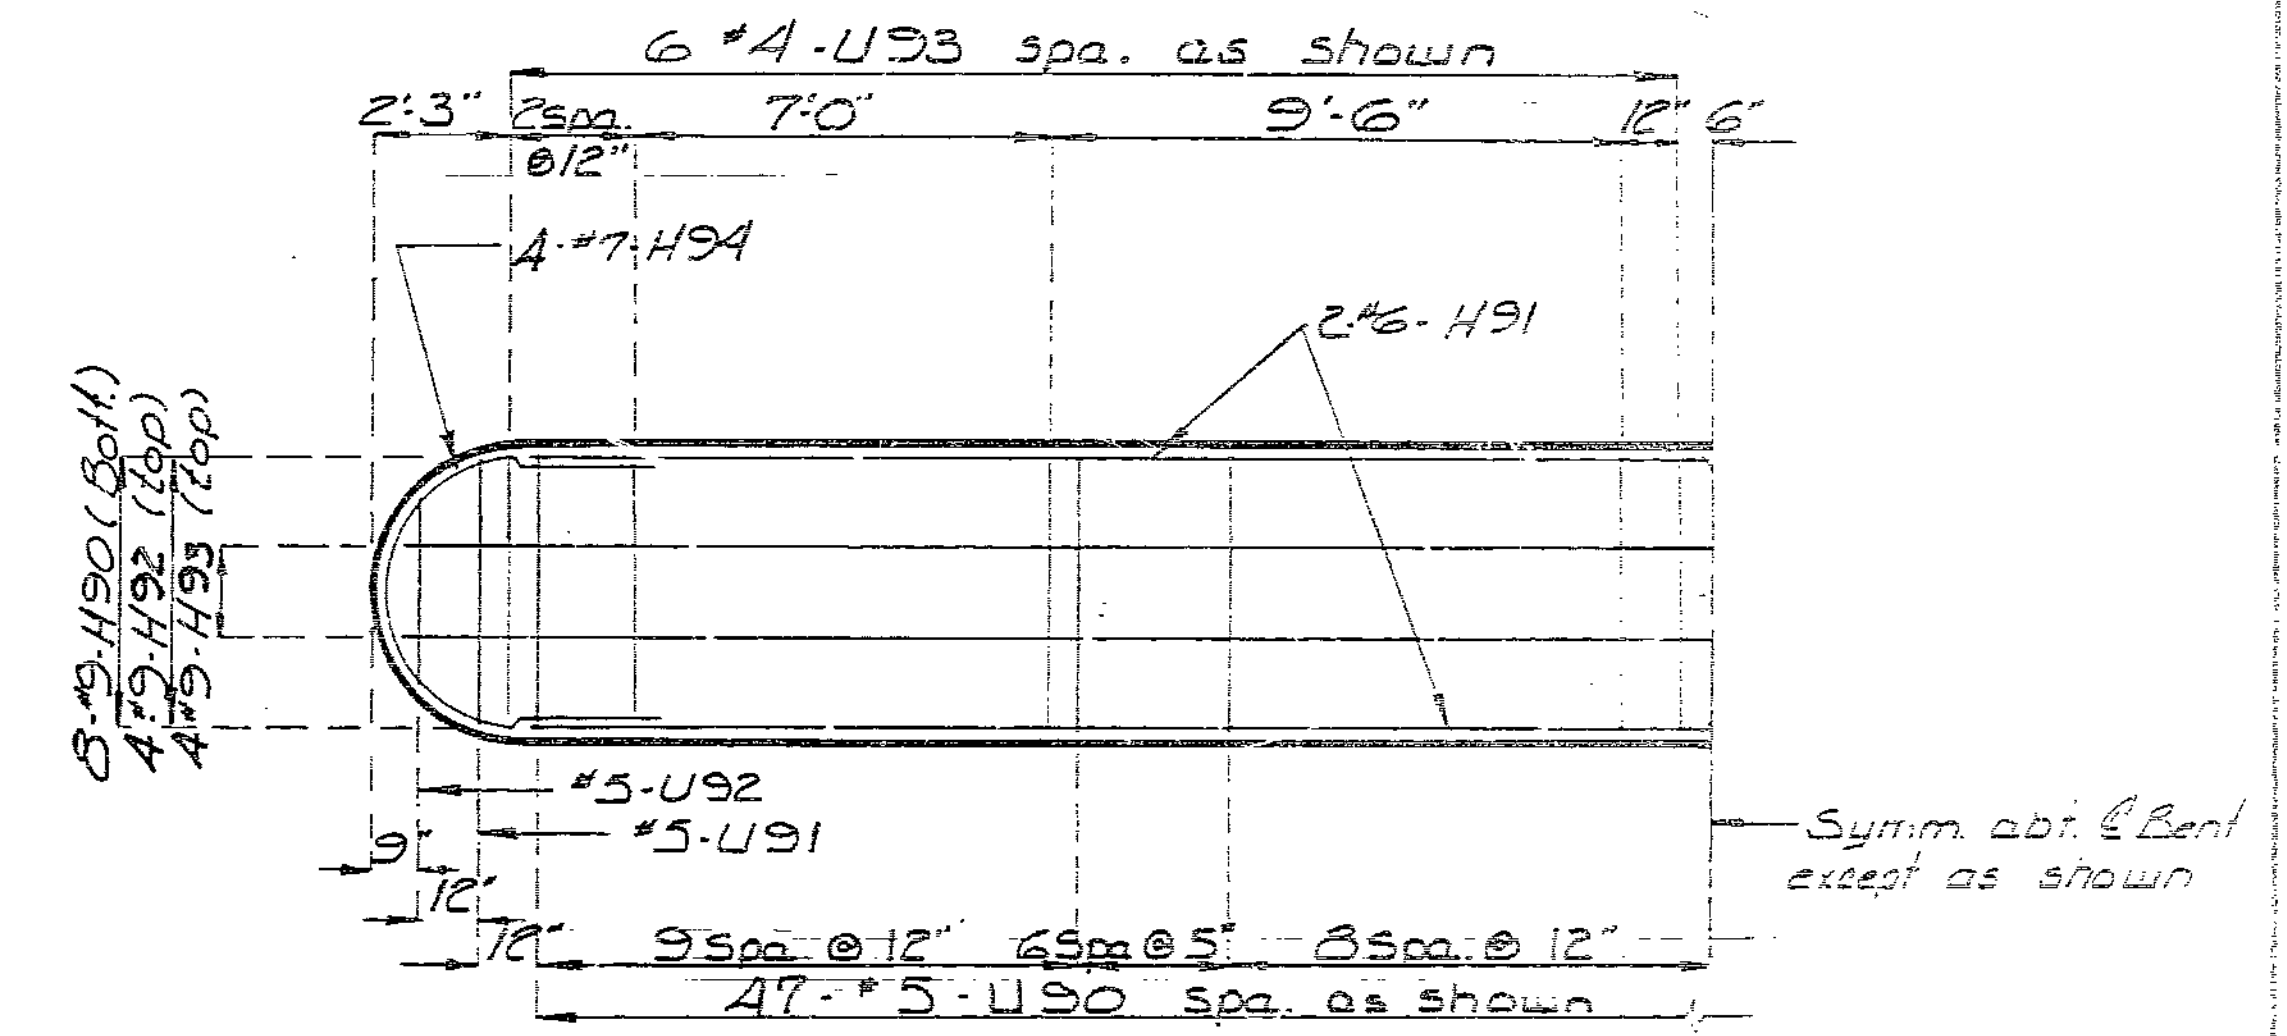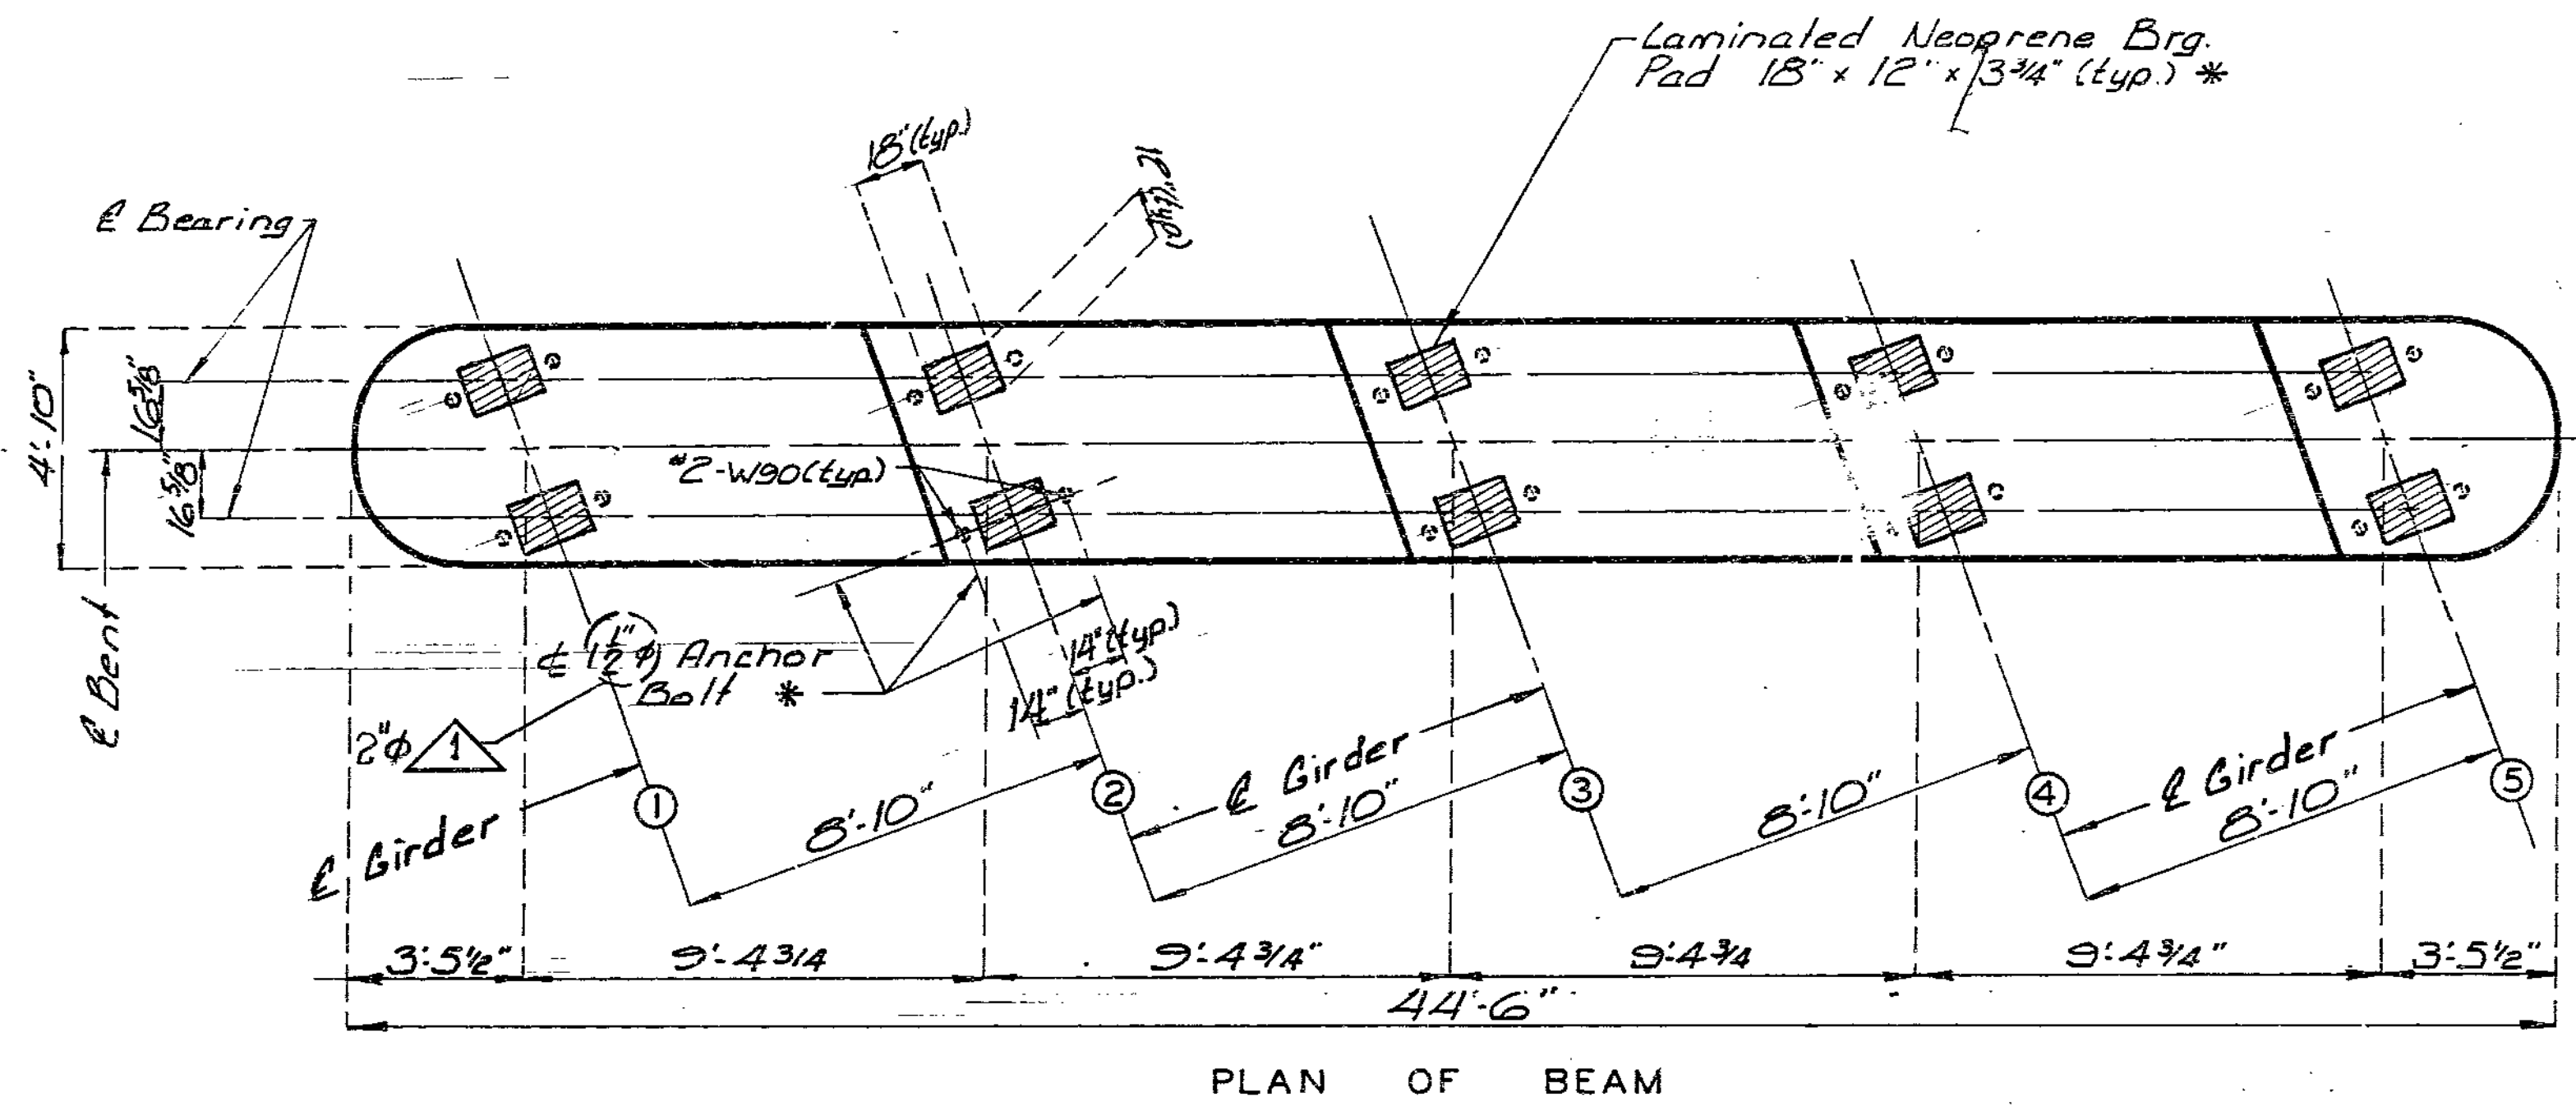

HALF PLAN OF BEAM SHOWING REINFORCEMENT

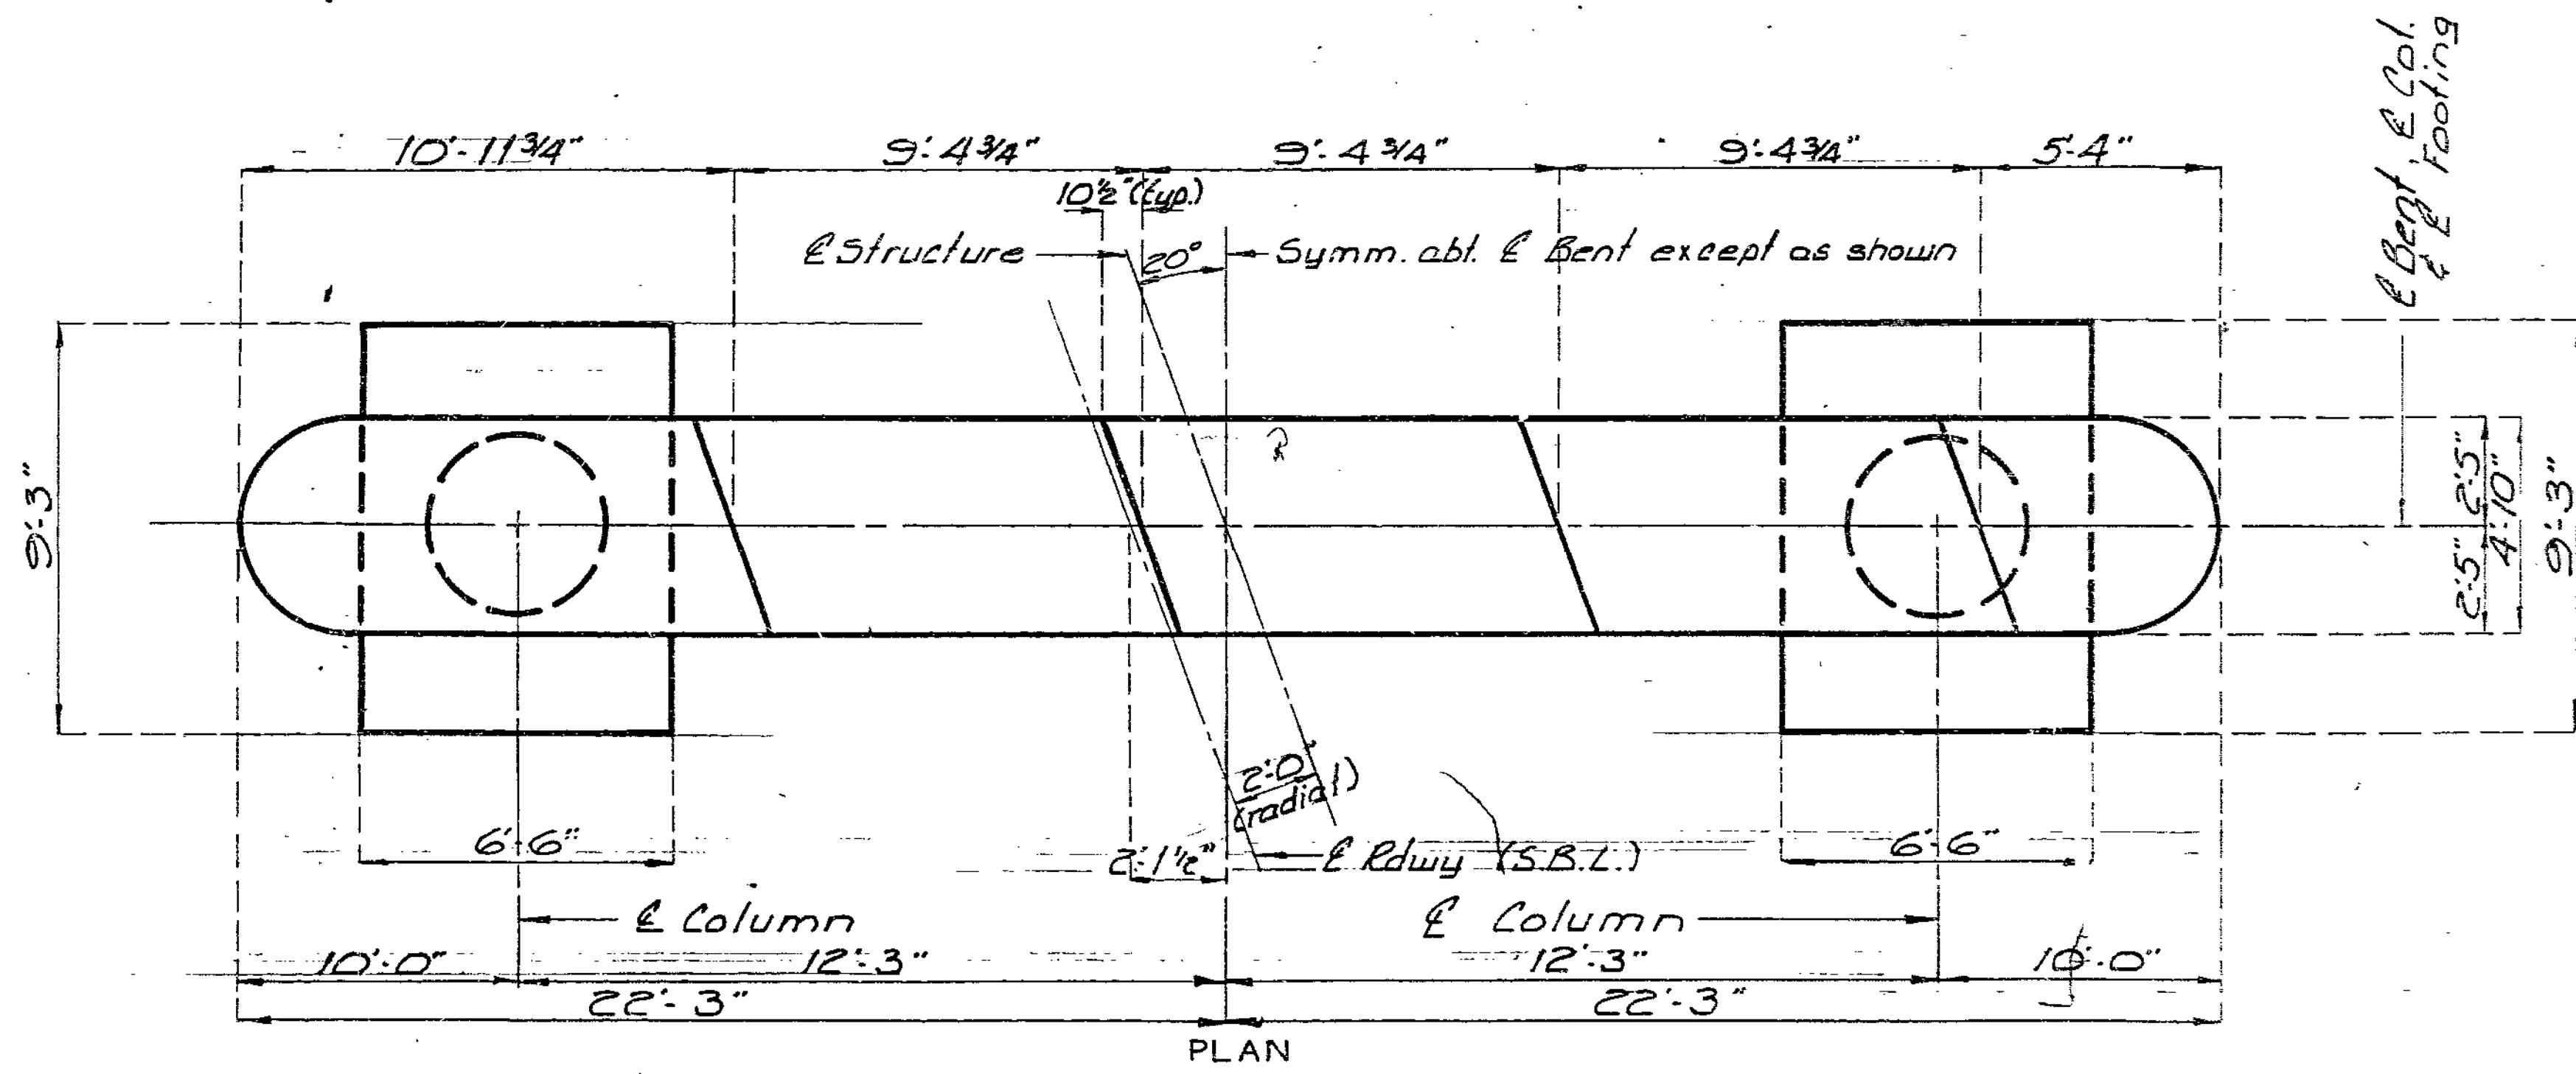

DETAILS OF INTERMEDIATE BENT NO. 9

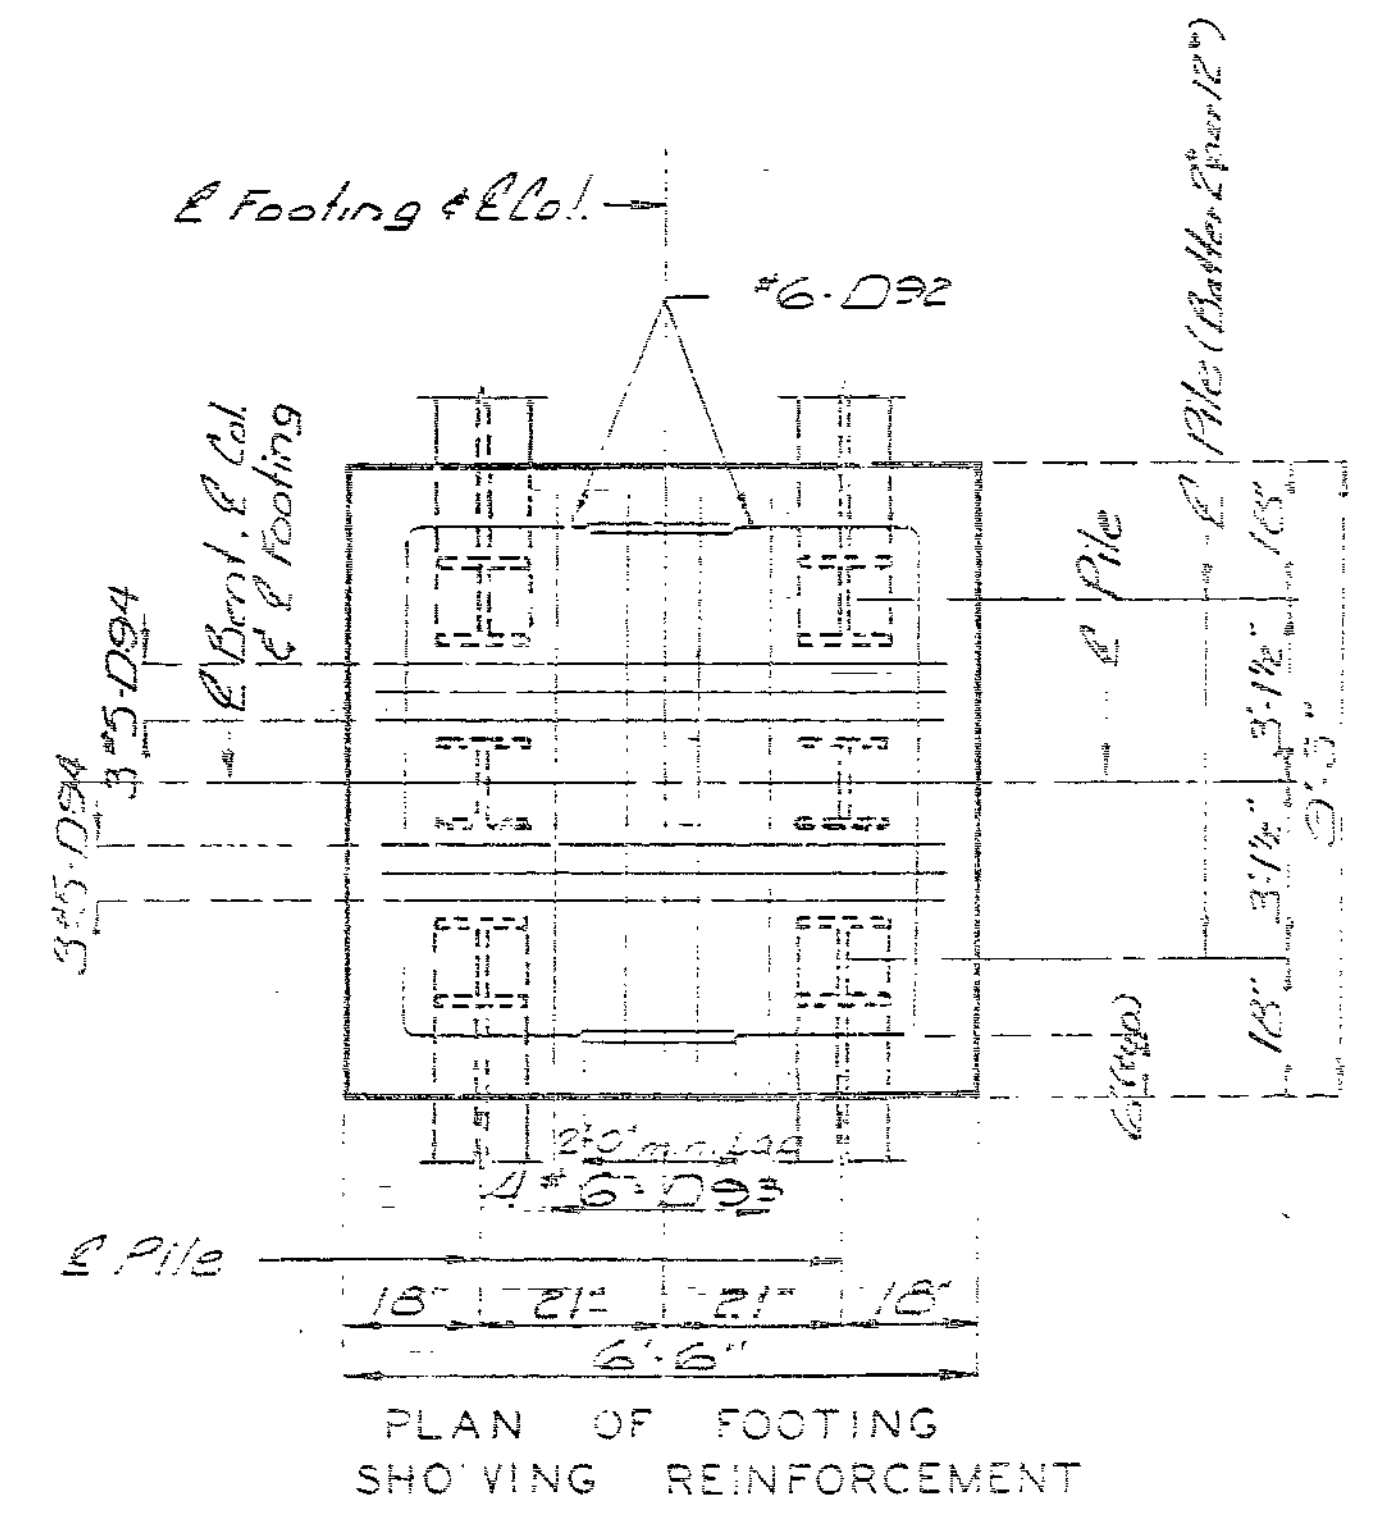

PLAN OF FOOTING SHOWING REINFORCEMENT

873 376

DETAILED MAY 1988  
 CHECKED August 1988

Note: This drawing is not to scale. Follow dimensions.

Revised 3/8/89

Sheet No. 27 of 30

JACKSON



COUNTY

A-2745

STATE	PROJ NO	SHEET NO
MO	DE-0031 (803)	27

Sub No 4-4-71-20

Note: For Details of Intermediate Bent No. 1, Mat shown, see sheet No 30

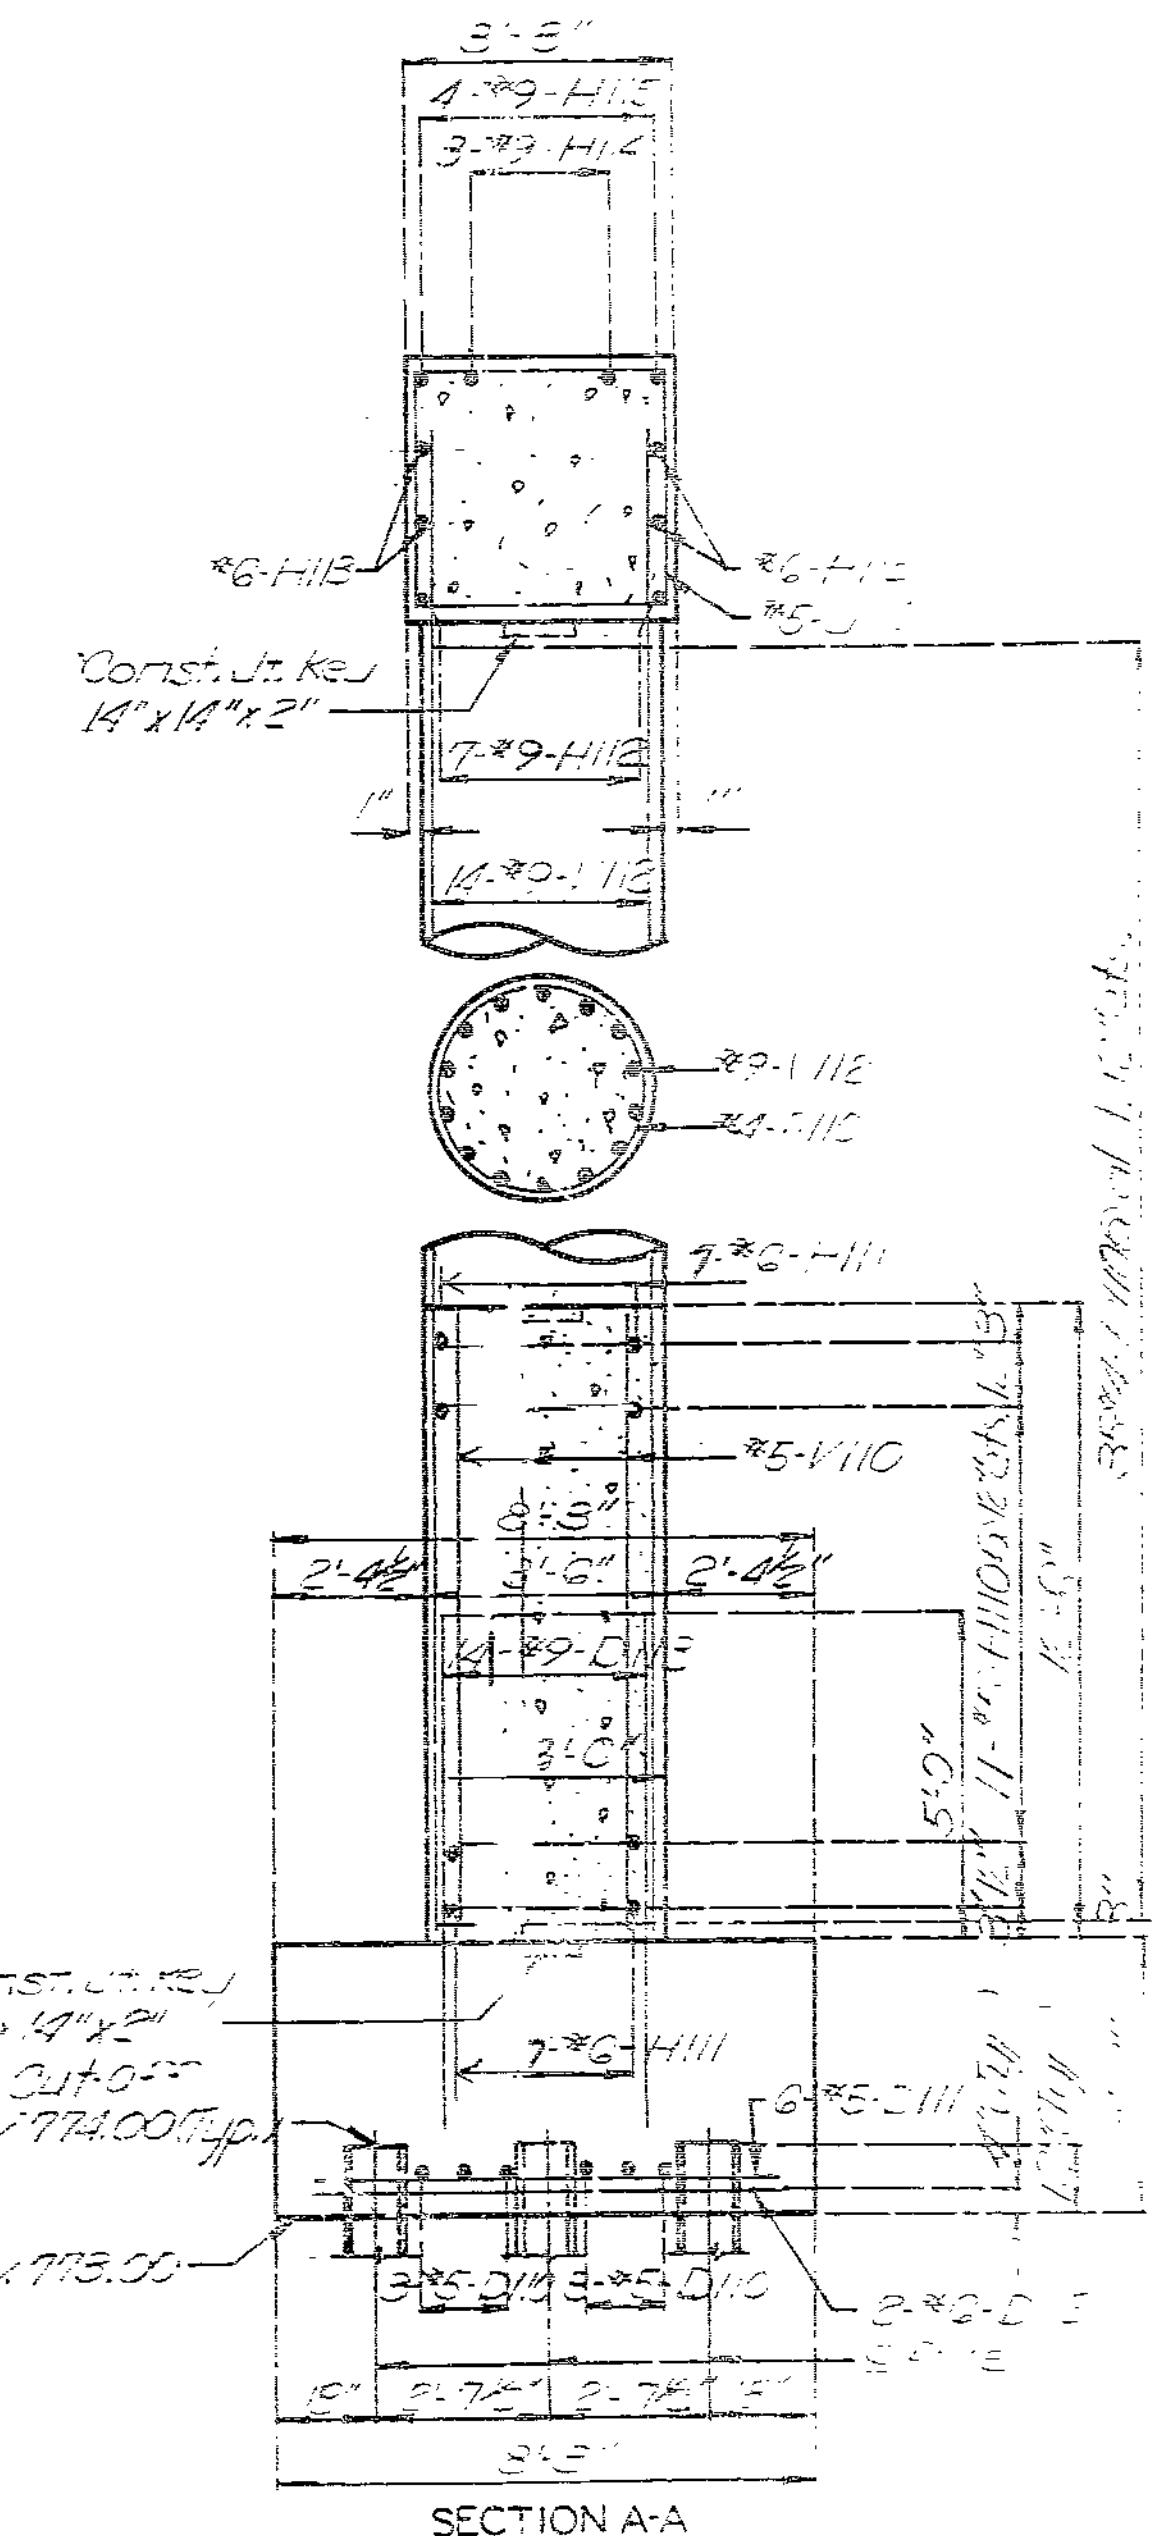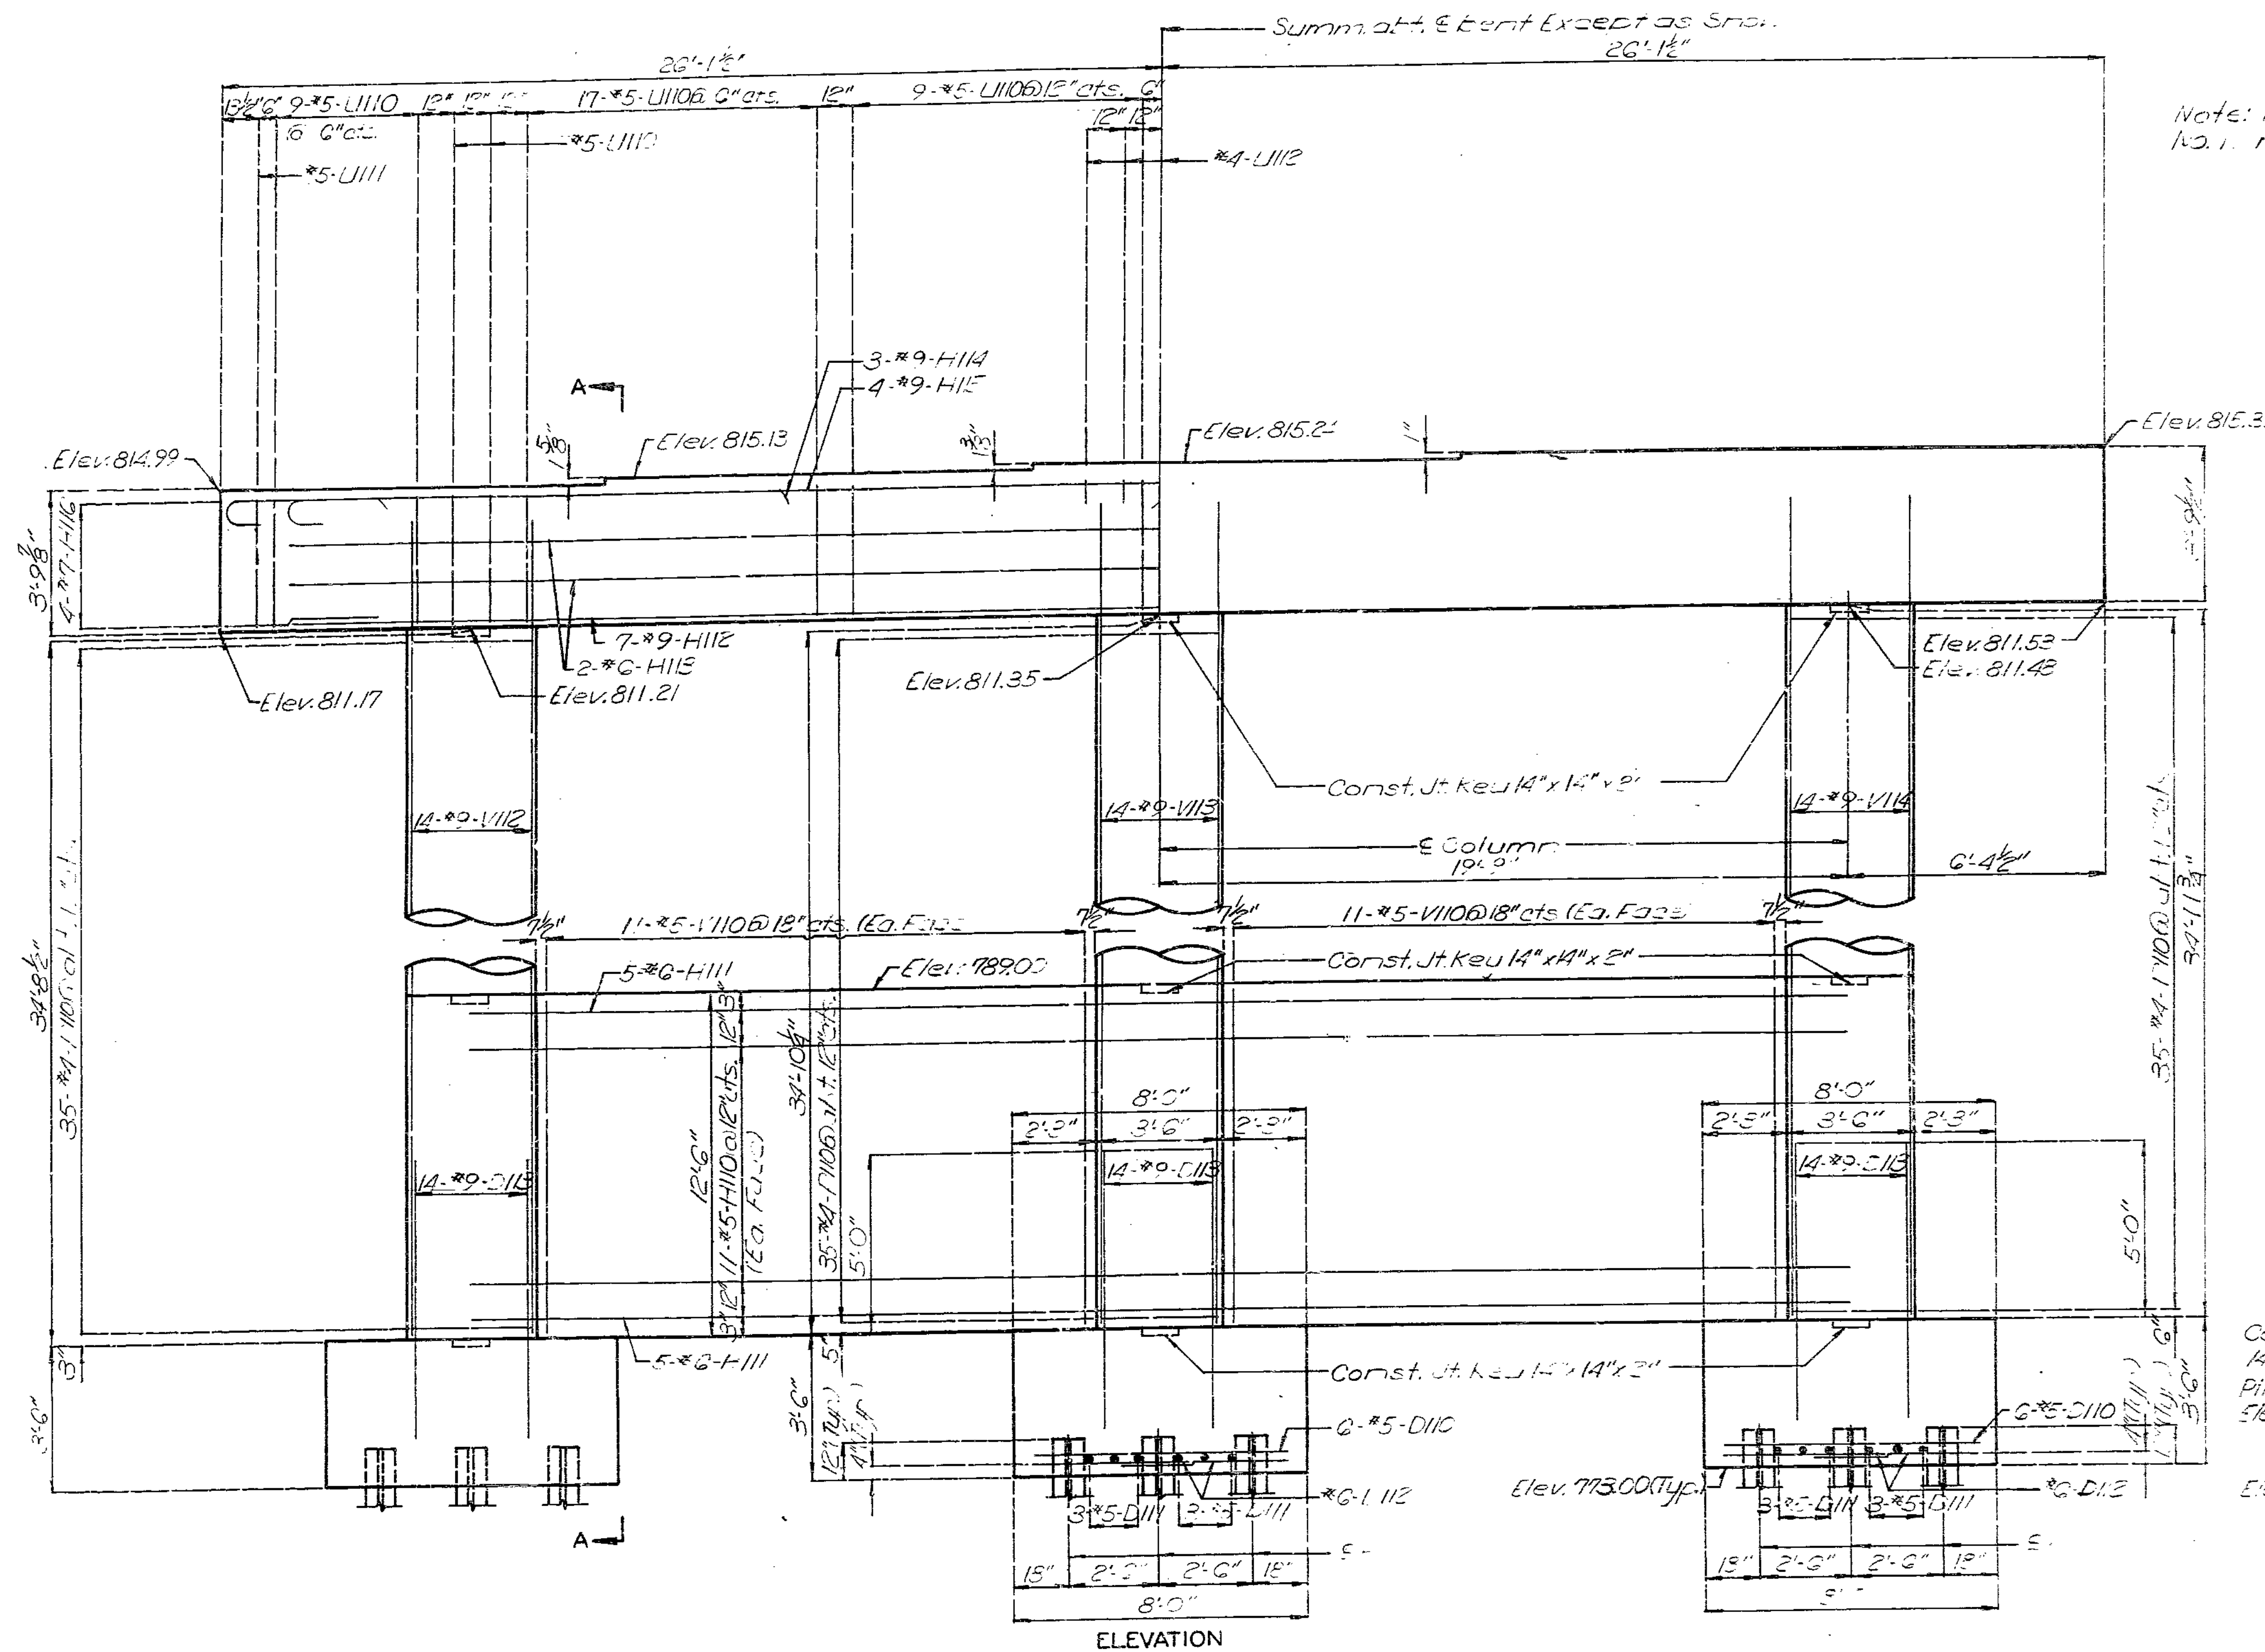

DETAILS OF INTERMEDIATE BENT NO. 11

377

DETAILED MAY 1988  
CHECKED Aug 1988


Note: This drawing is not to scale. Follow dimensions.

Sheet No. 31A of 33

JACKSON COUNTY

A-2745


STATE	PROJ. NO.	SHEET NO.
MO.	DE-06-1300	27
Job No 4-11-6D		

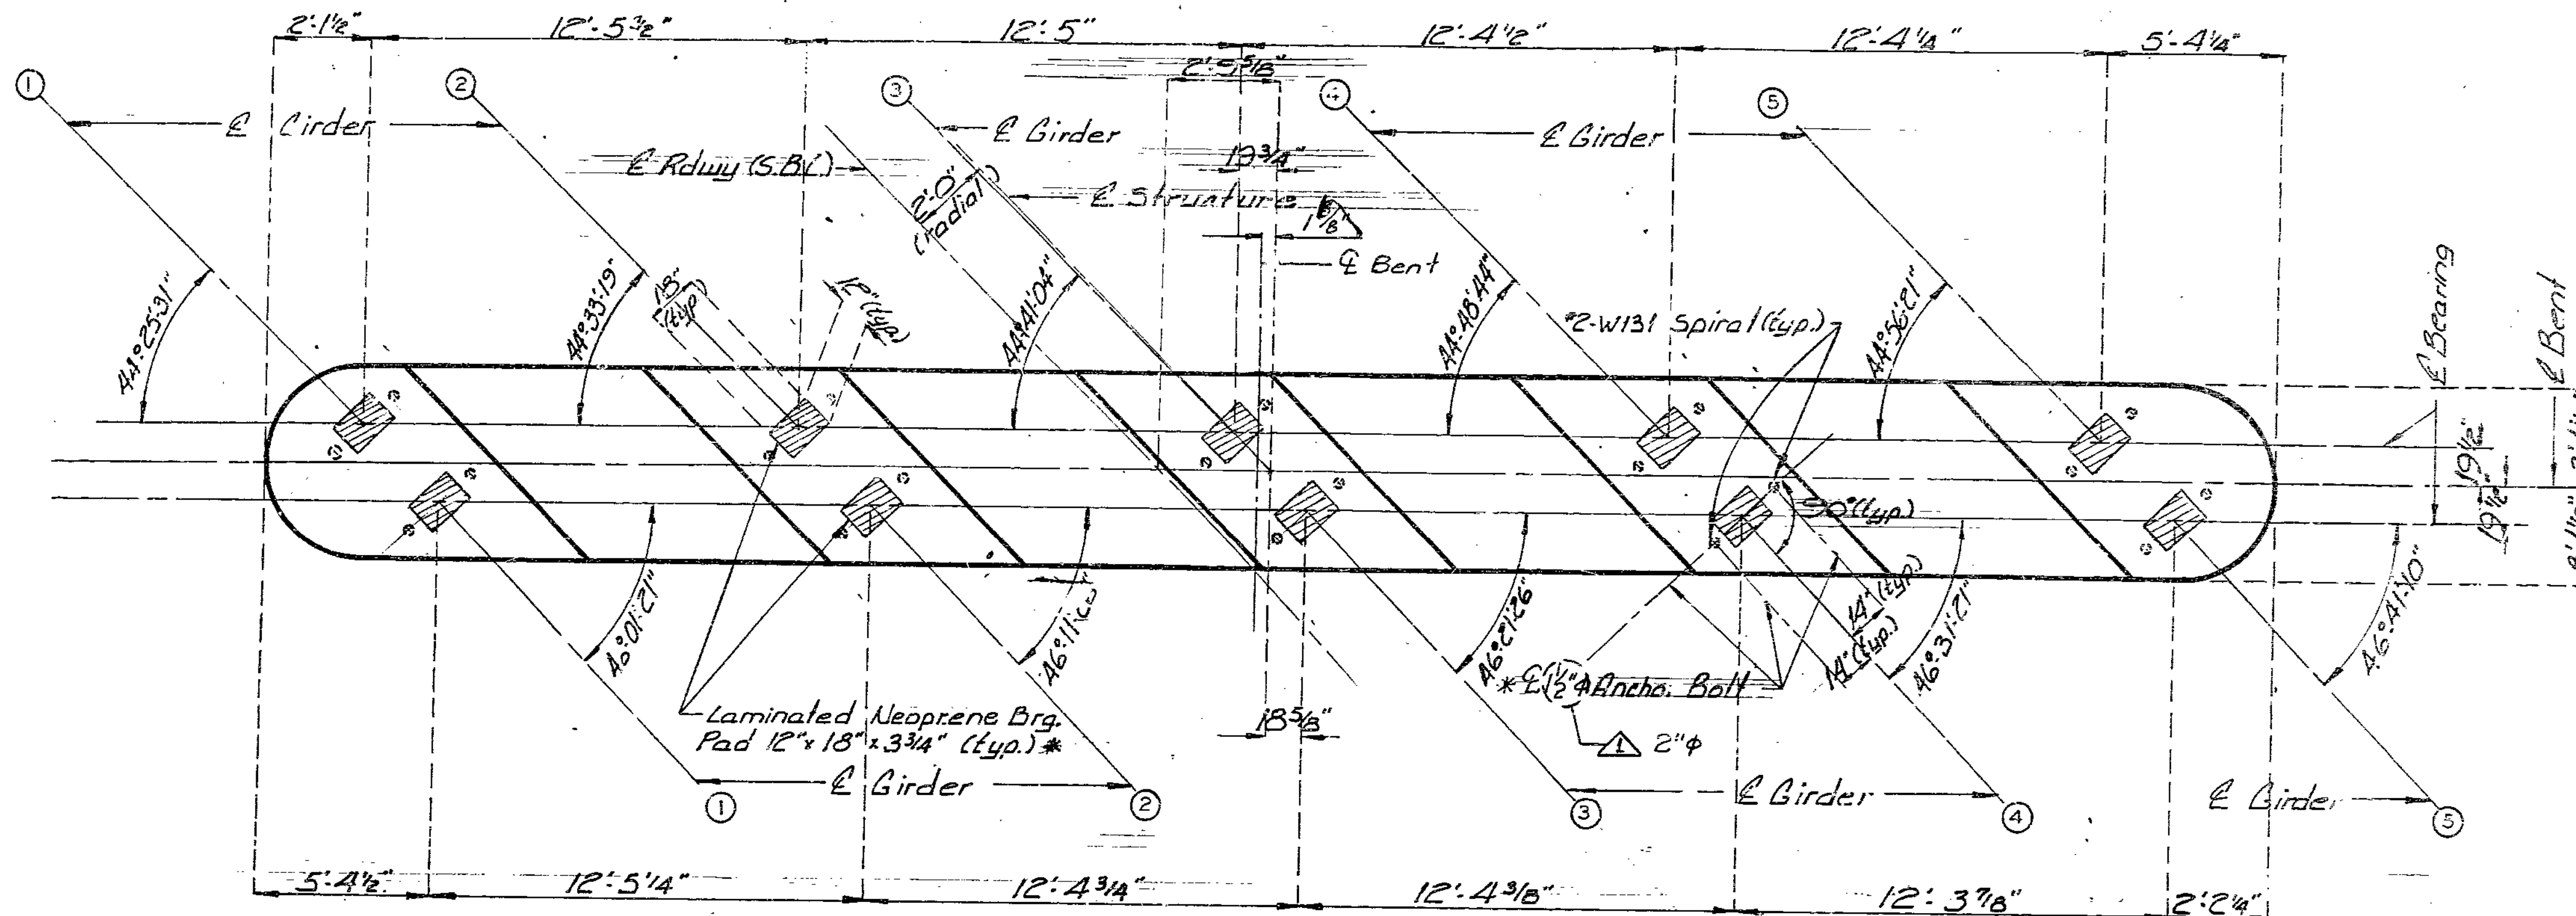


PLAN OF BEAM

Note: For details of Bl. No.13 not shown see sheet No. 35.  
 For Details of Anchor Bolt Spiral see sheet No. 9.  
 \* Bearings and Anchor Bolts are included in Future Construction.

230 370

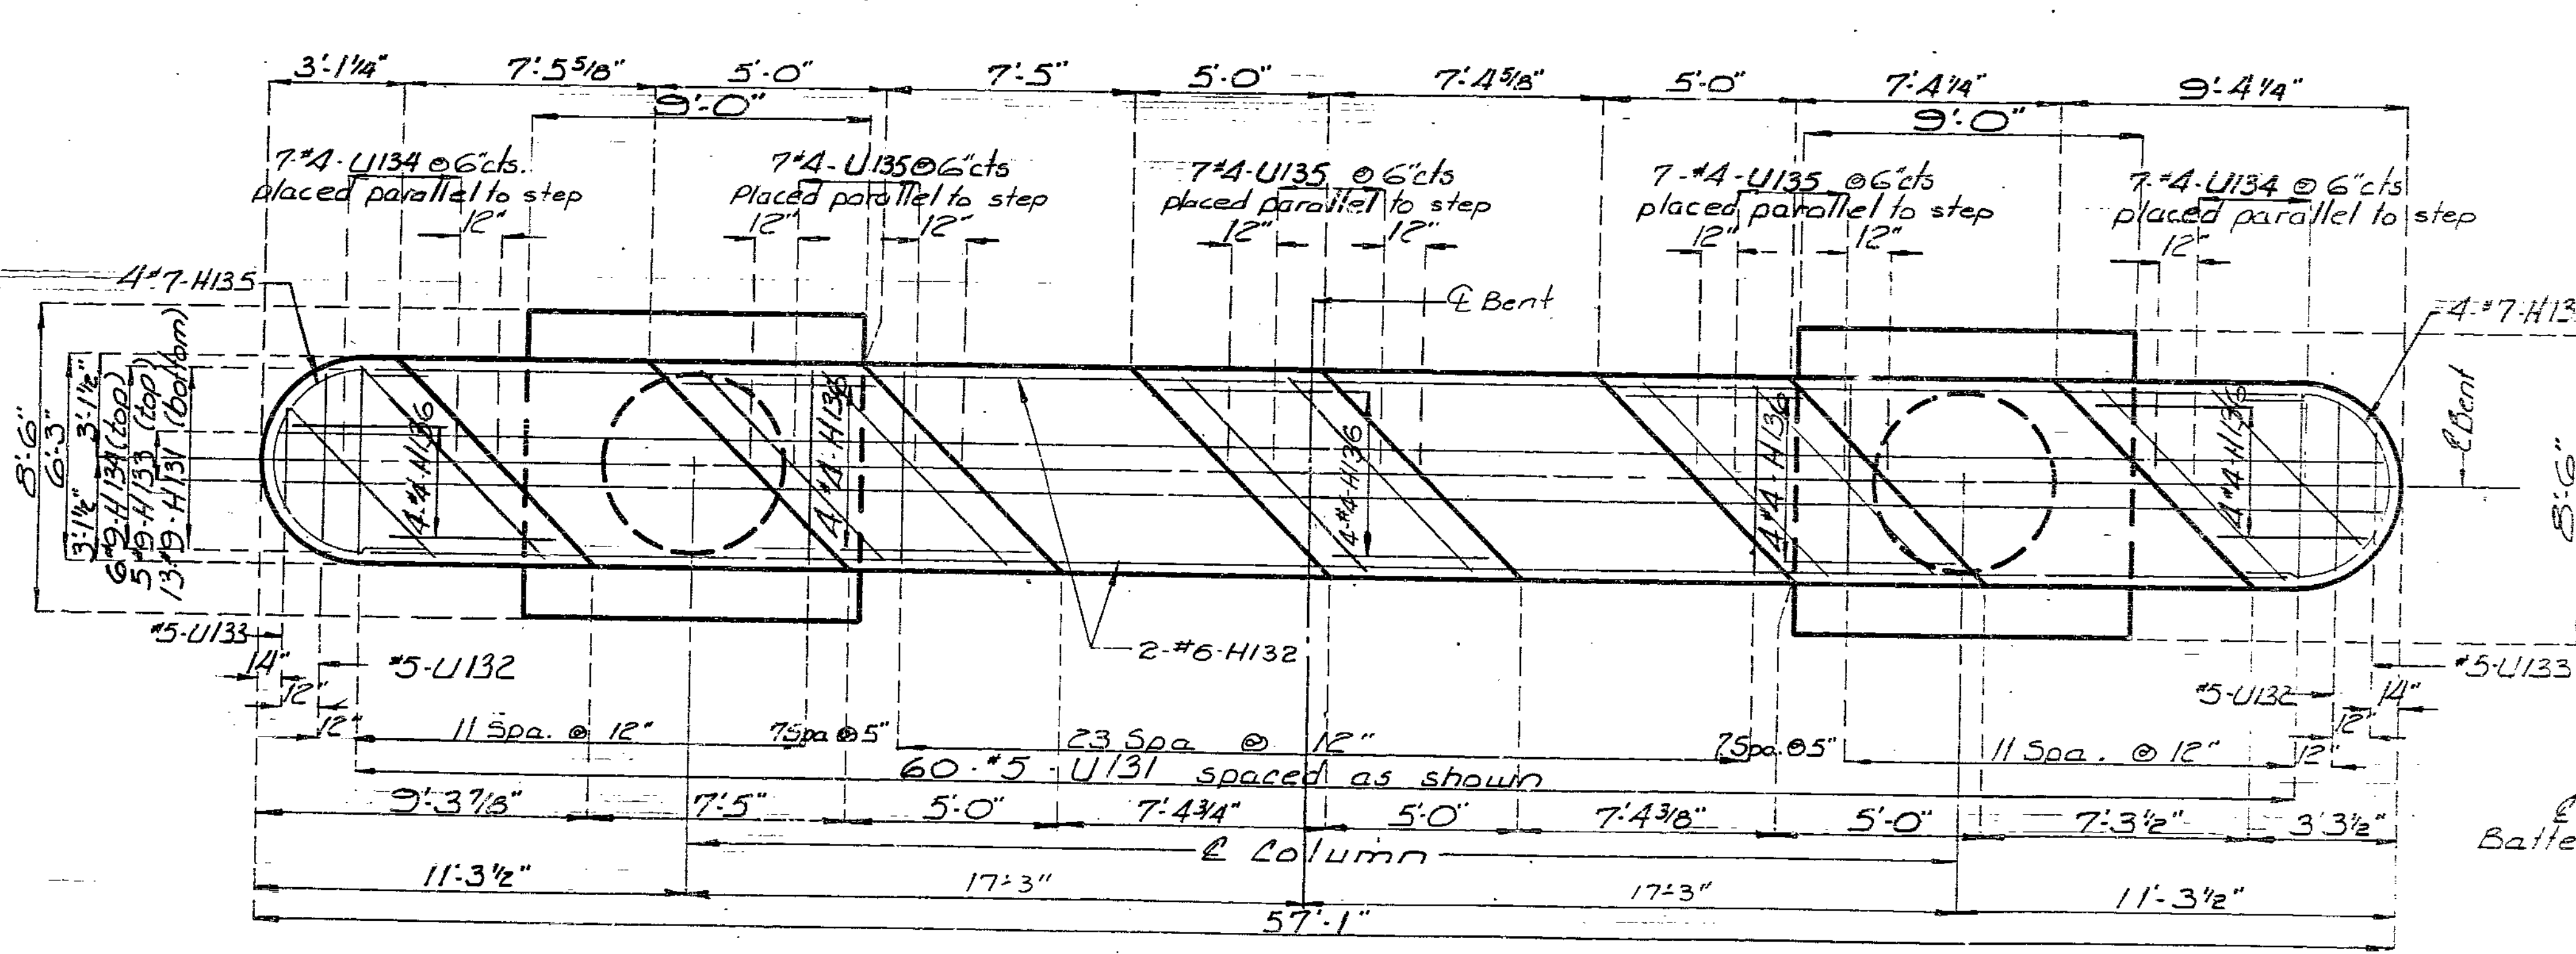

PLAN

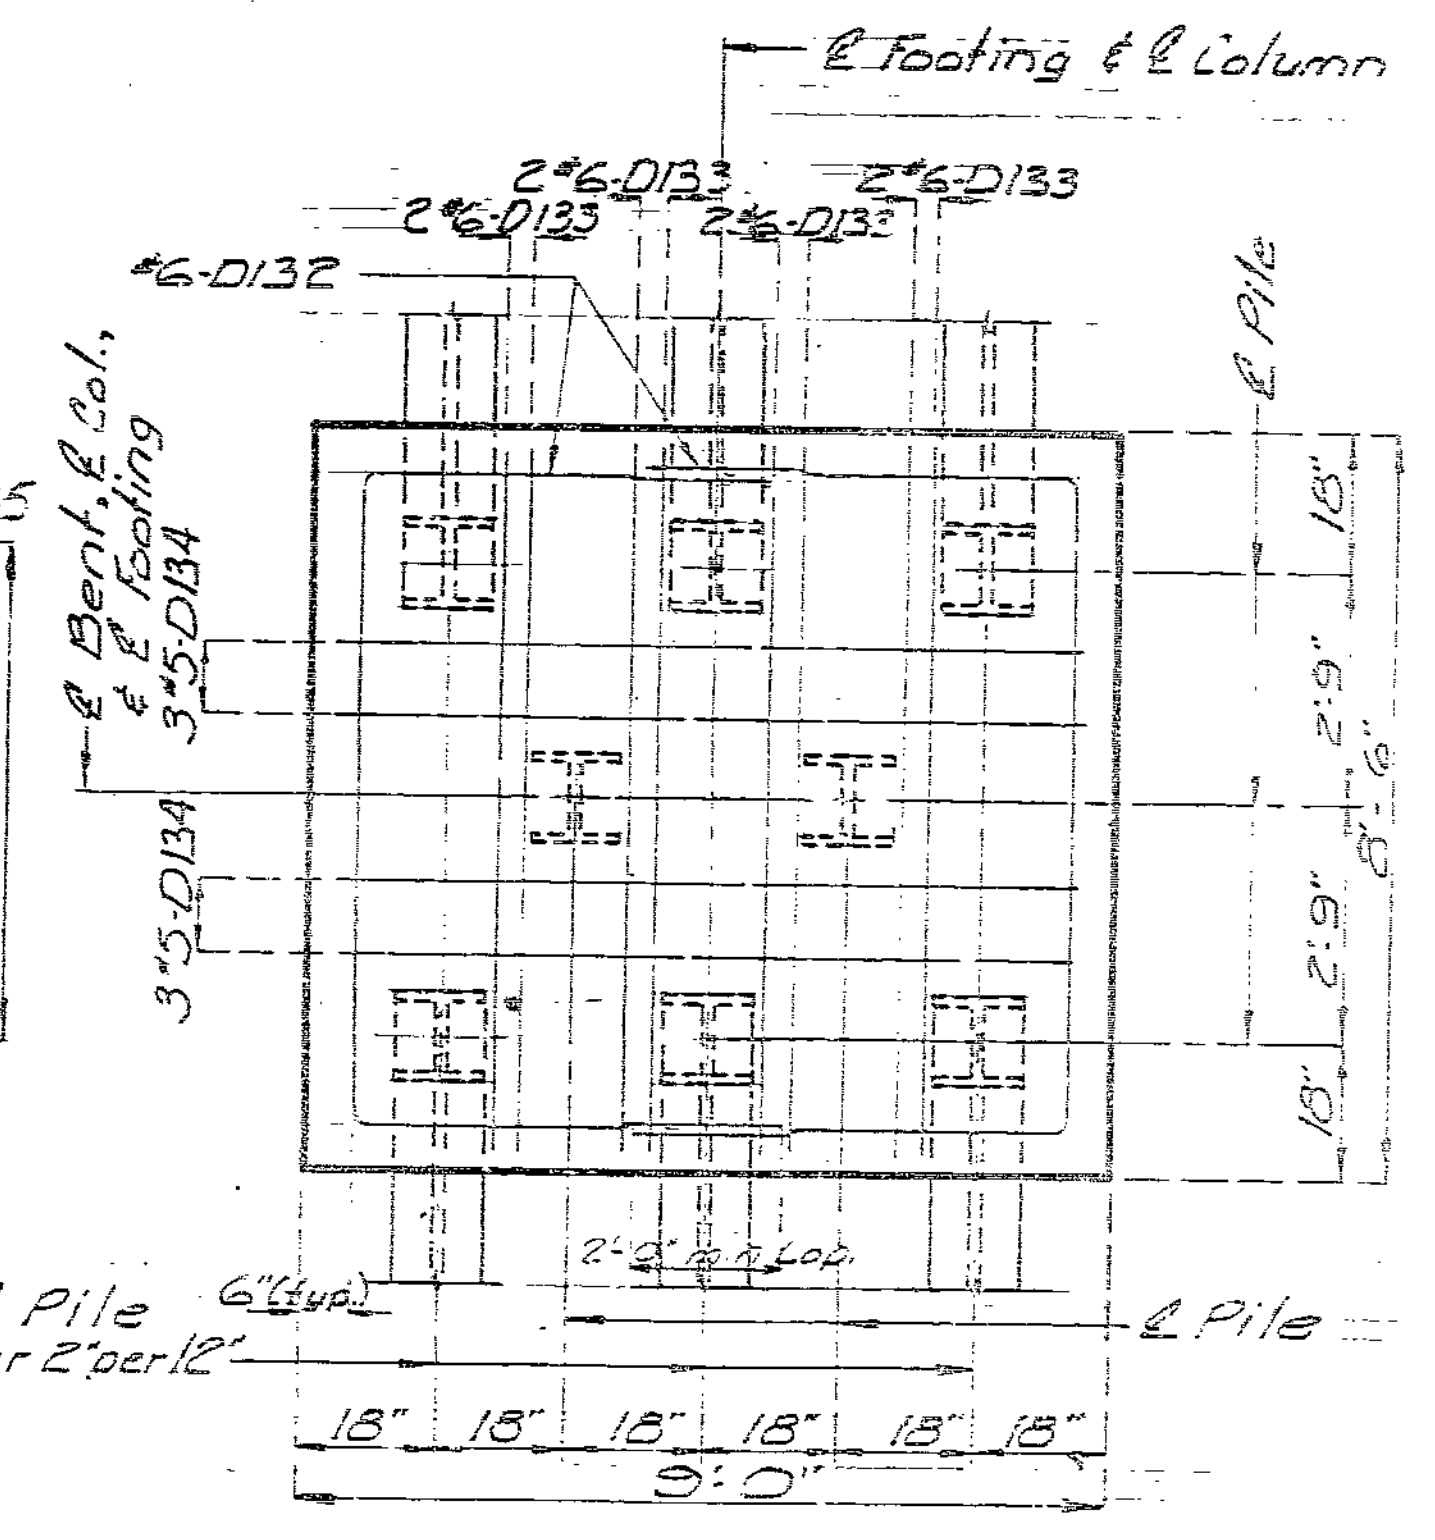

PLAN OF FOOTING SHOWING REINFORCEMENT

DETAILED MAY 1988  
 CHECKED August 1988

Note: This drawing is not to scale. Follow dimensions.

DETAILS OF INTERMEDIATE BENT NO. 13

Sheet No. 34 of 36


Revised 3/8/89 JACKSON

COUNTY



A-2745

STATE	PROJ NO	SHEET NO
MO	DE-6021 (805)	29
Sub No 4-6-81-81		

Note: For Details of Intermediate Bent No. 17 not shown see sheet No. 43  
 For Anchor Bolt Splice detail see sheet No. 9  
 For Pile Splice detail see sheet No. 9  
 \*Brgs & Anchor Bolts are in future construction.

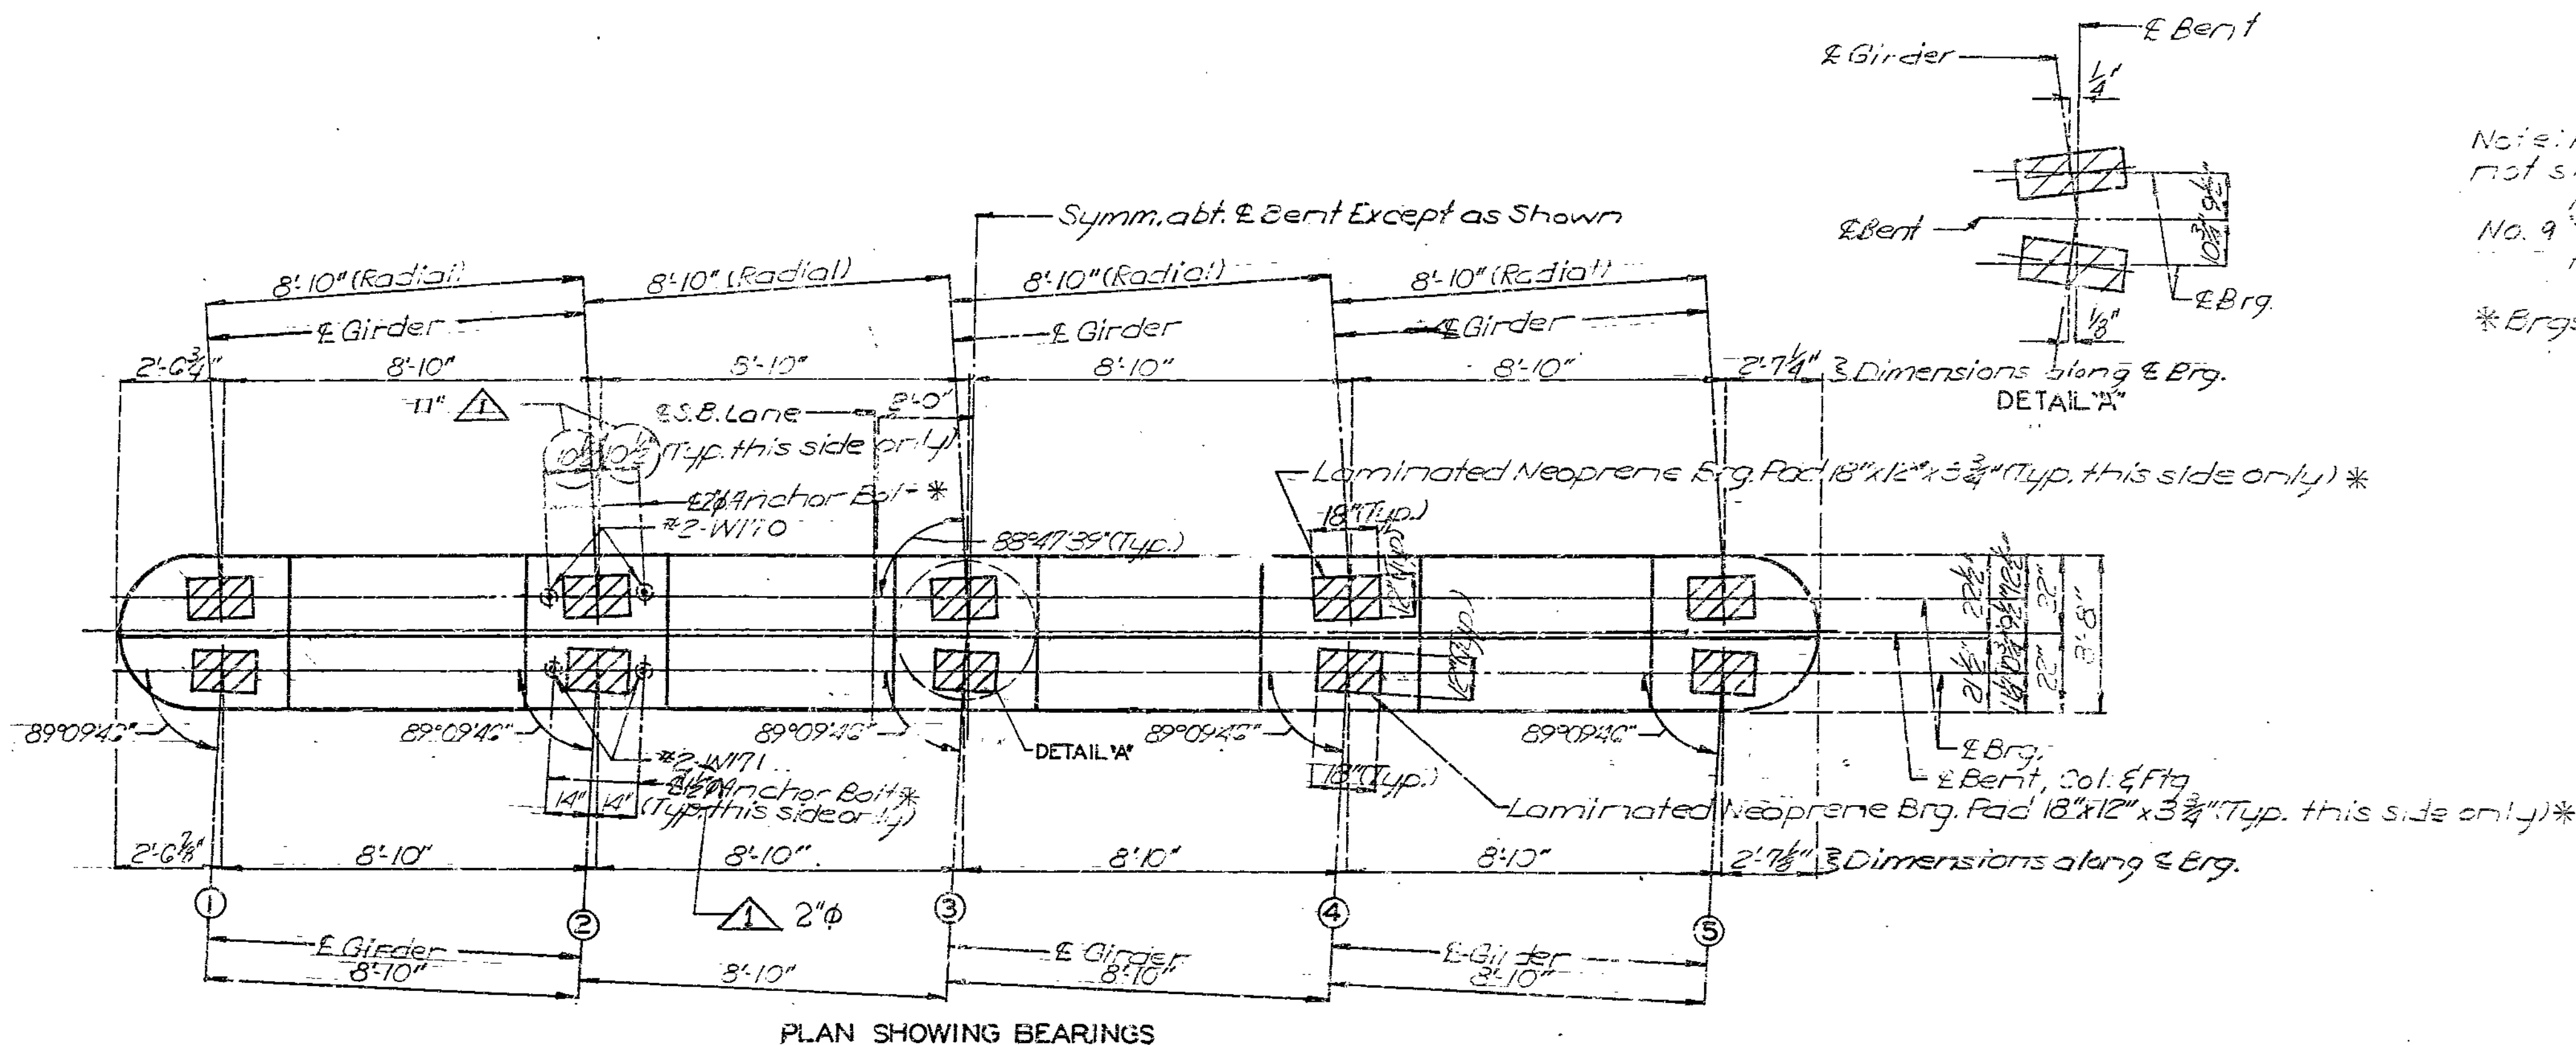

838 379

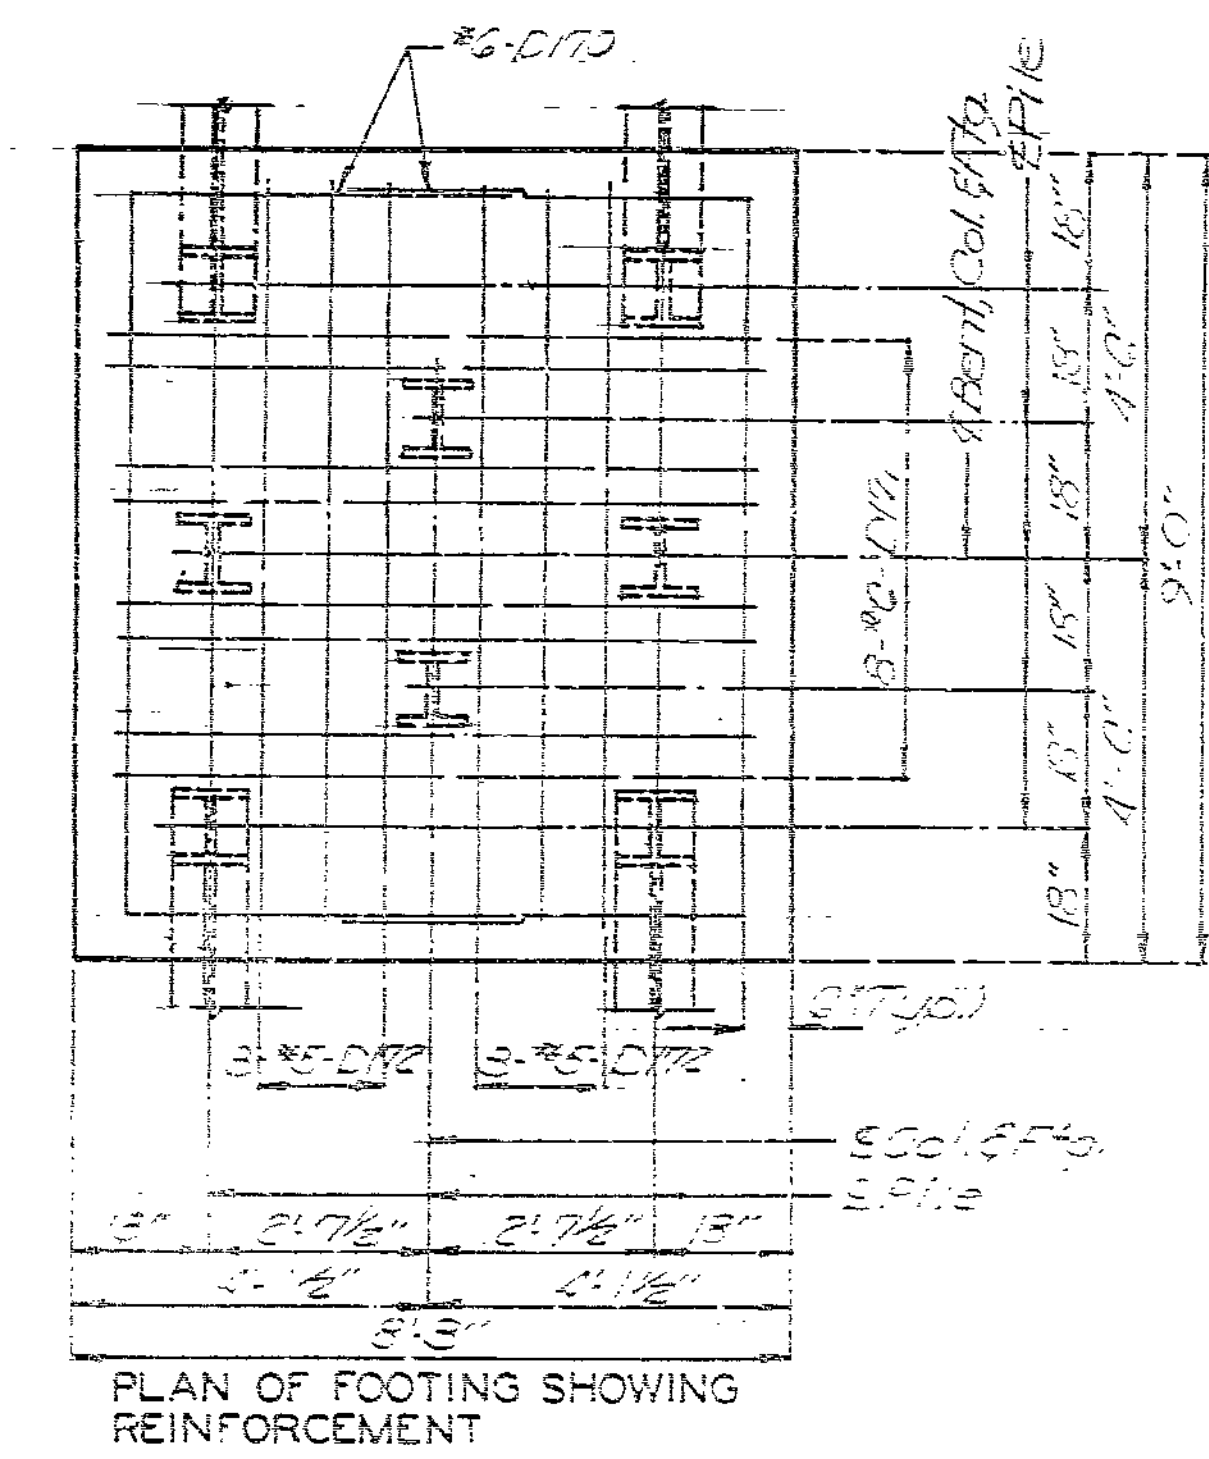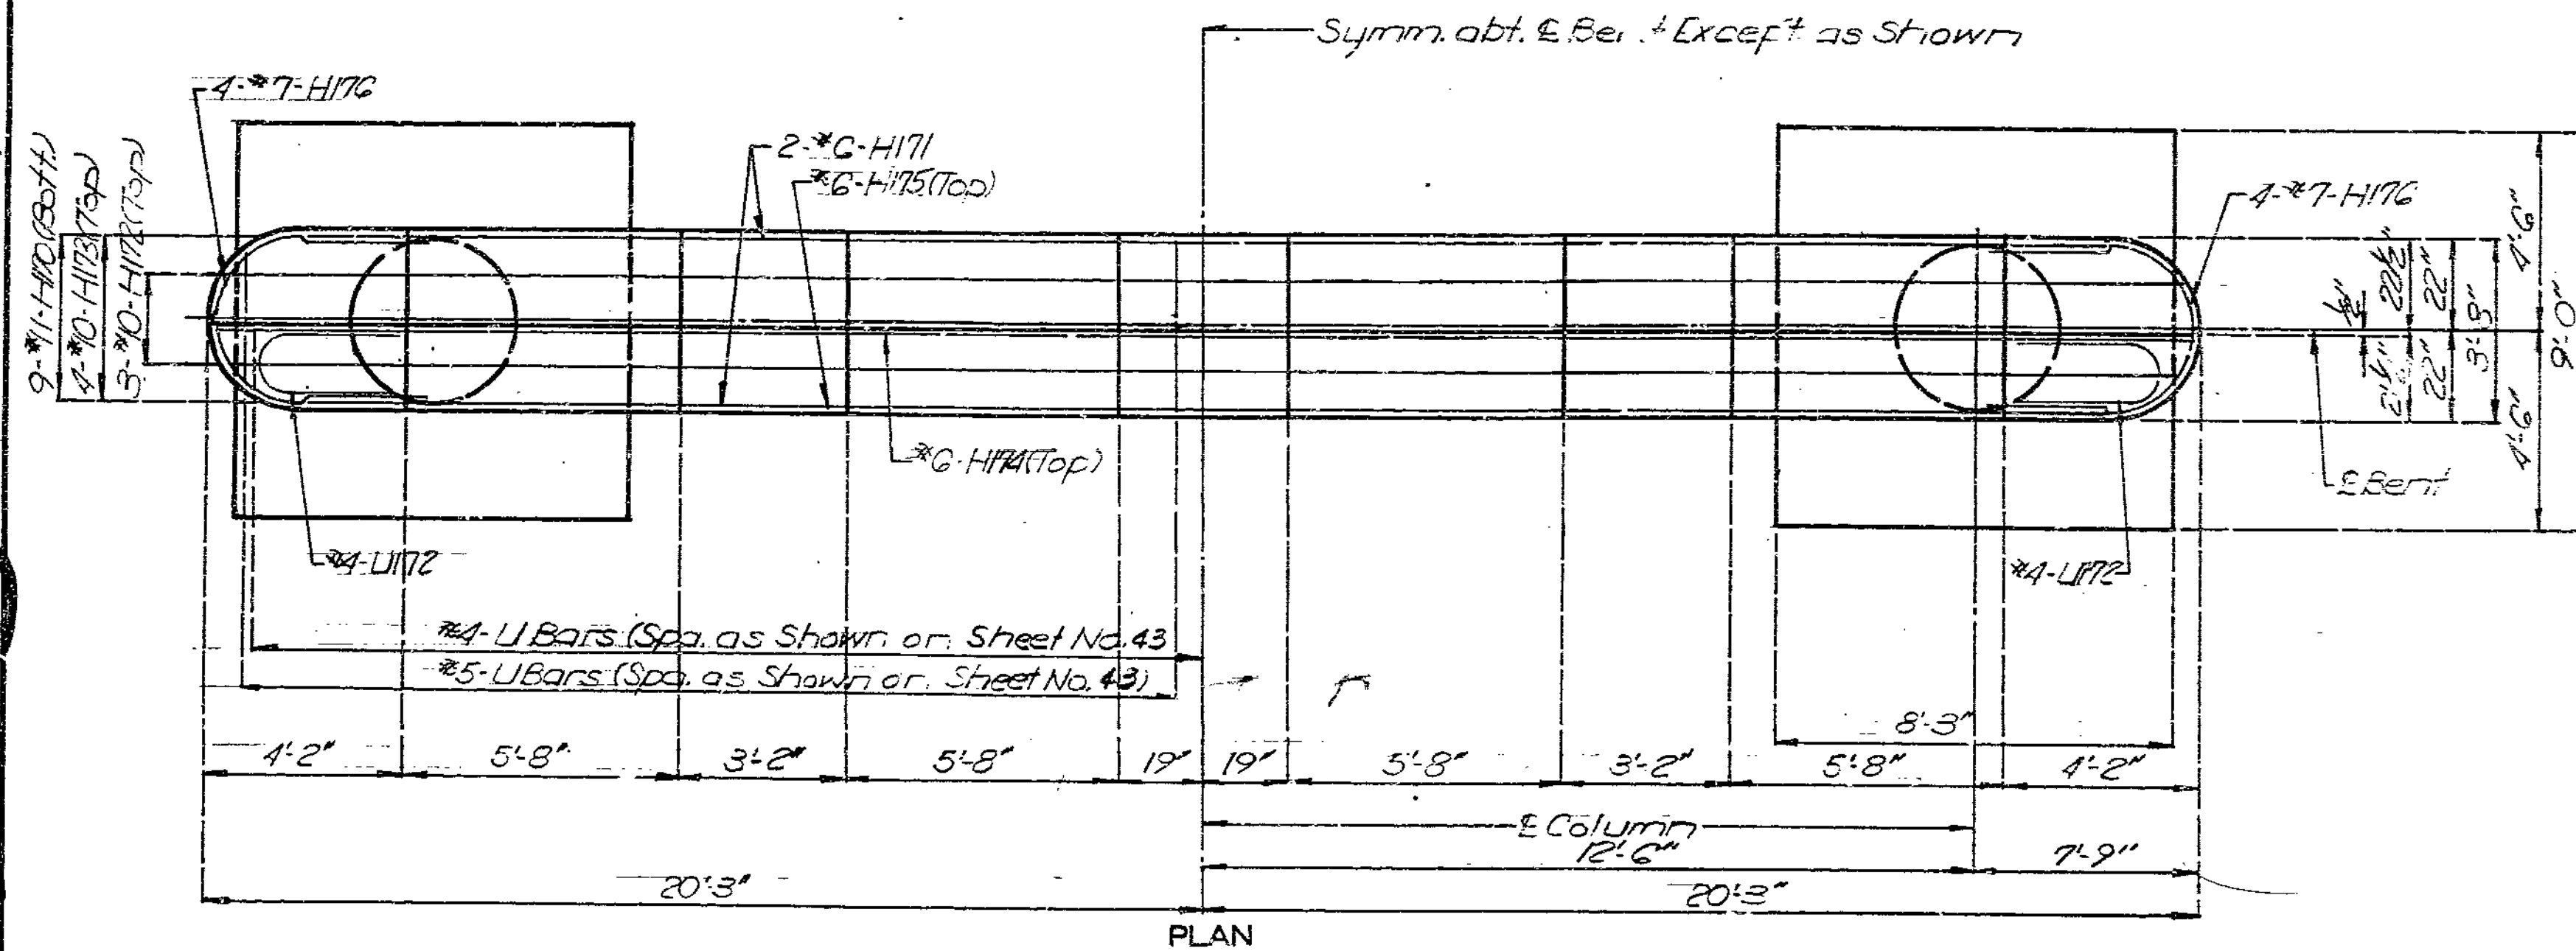

DETAILED JUN 1988  
 CHECKED ALB 1988

Note: This drawing is not to scale. Follow dimensions.

Revised 3/8/89

Sheet No 42A of 55

JACKSON COUNTY

A-2745




STATE	PROJ NO	SHEET NO
MO	DE-6011901	30

Note: For details of Intermediate Bent, No. 18 not shown see sheet No. 45  
 For detail of anchor bolt spirals see sheet No. 9

Note: For details of pile splice see sheet No. 9

\* Brgs. & Anchor bolts are in future construction.

248 380

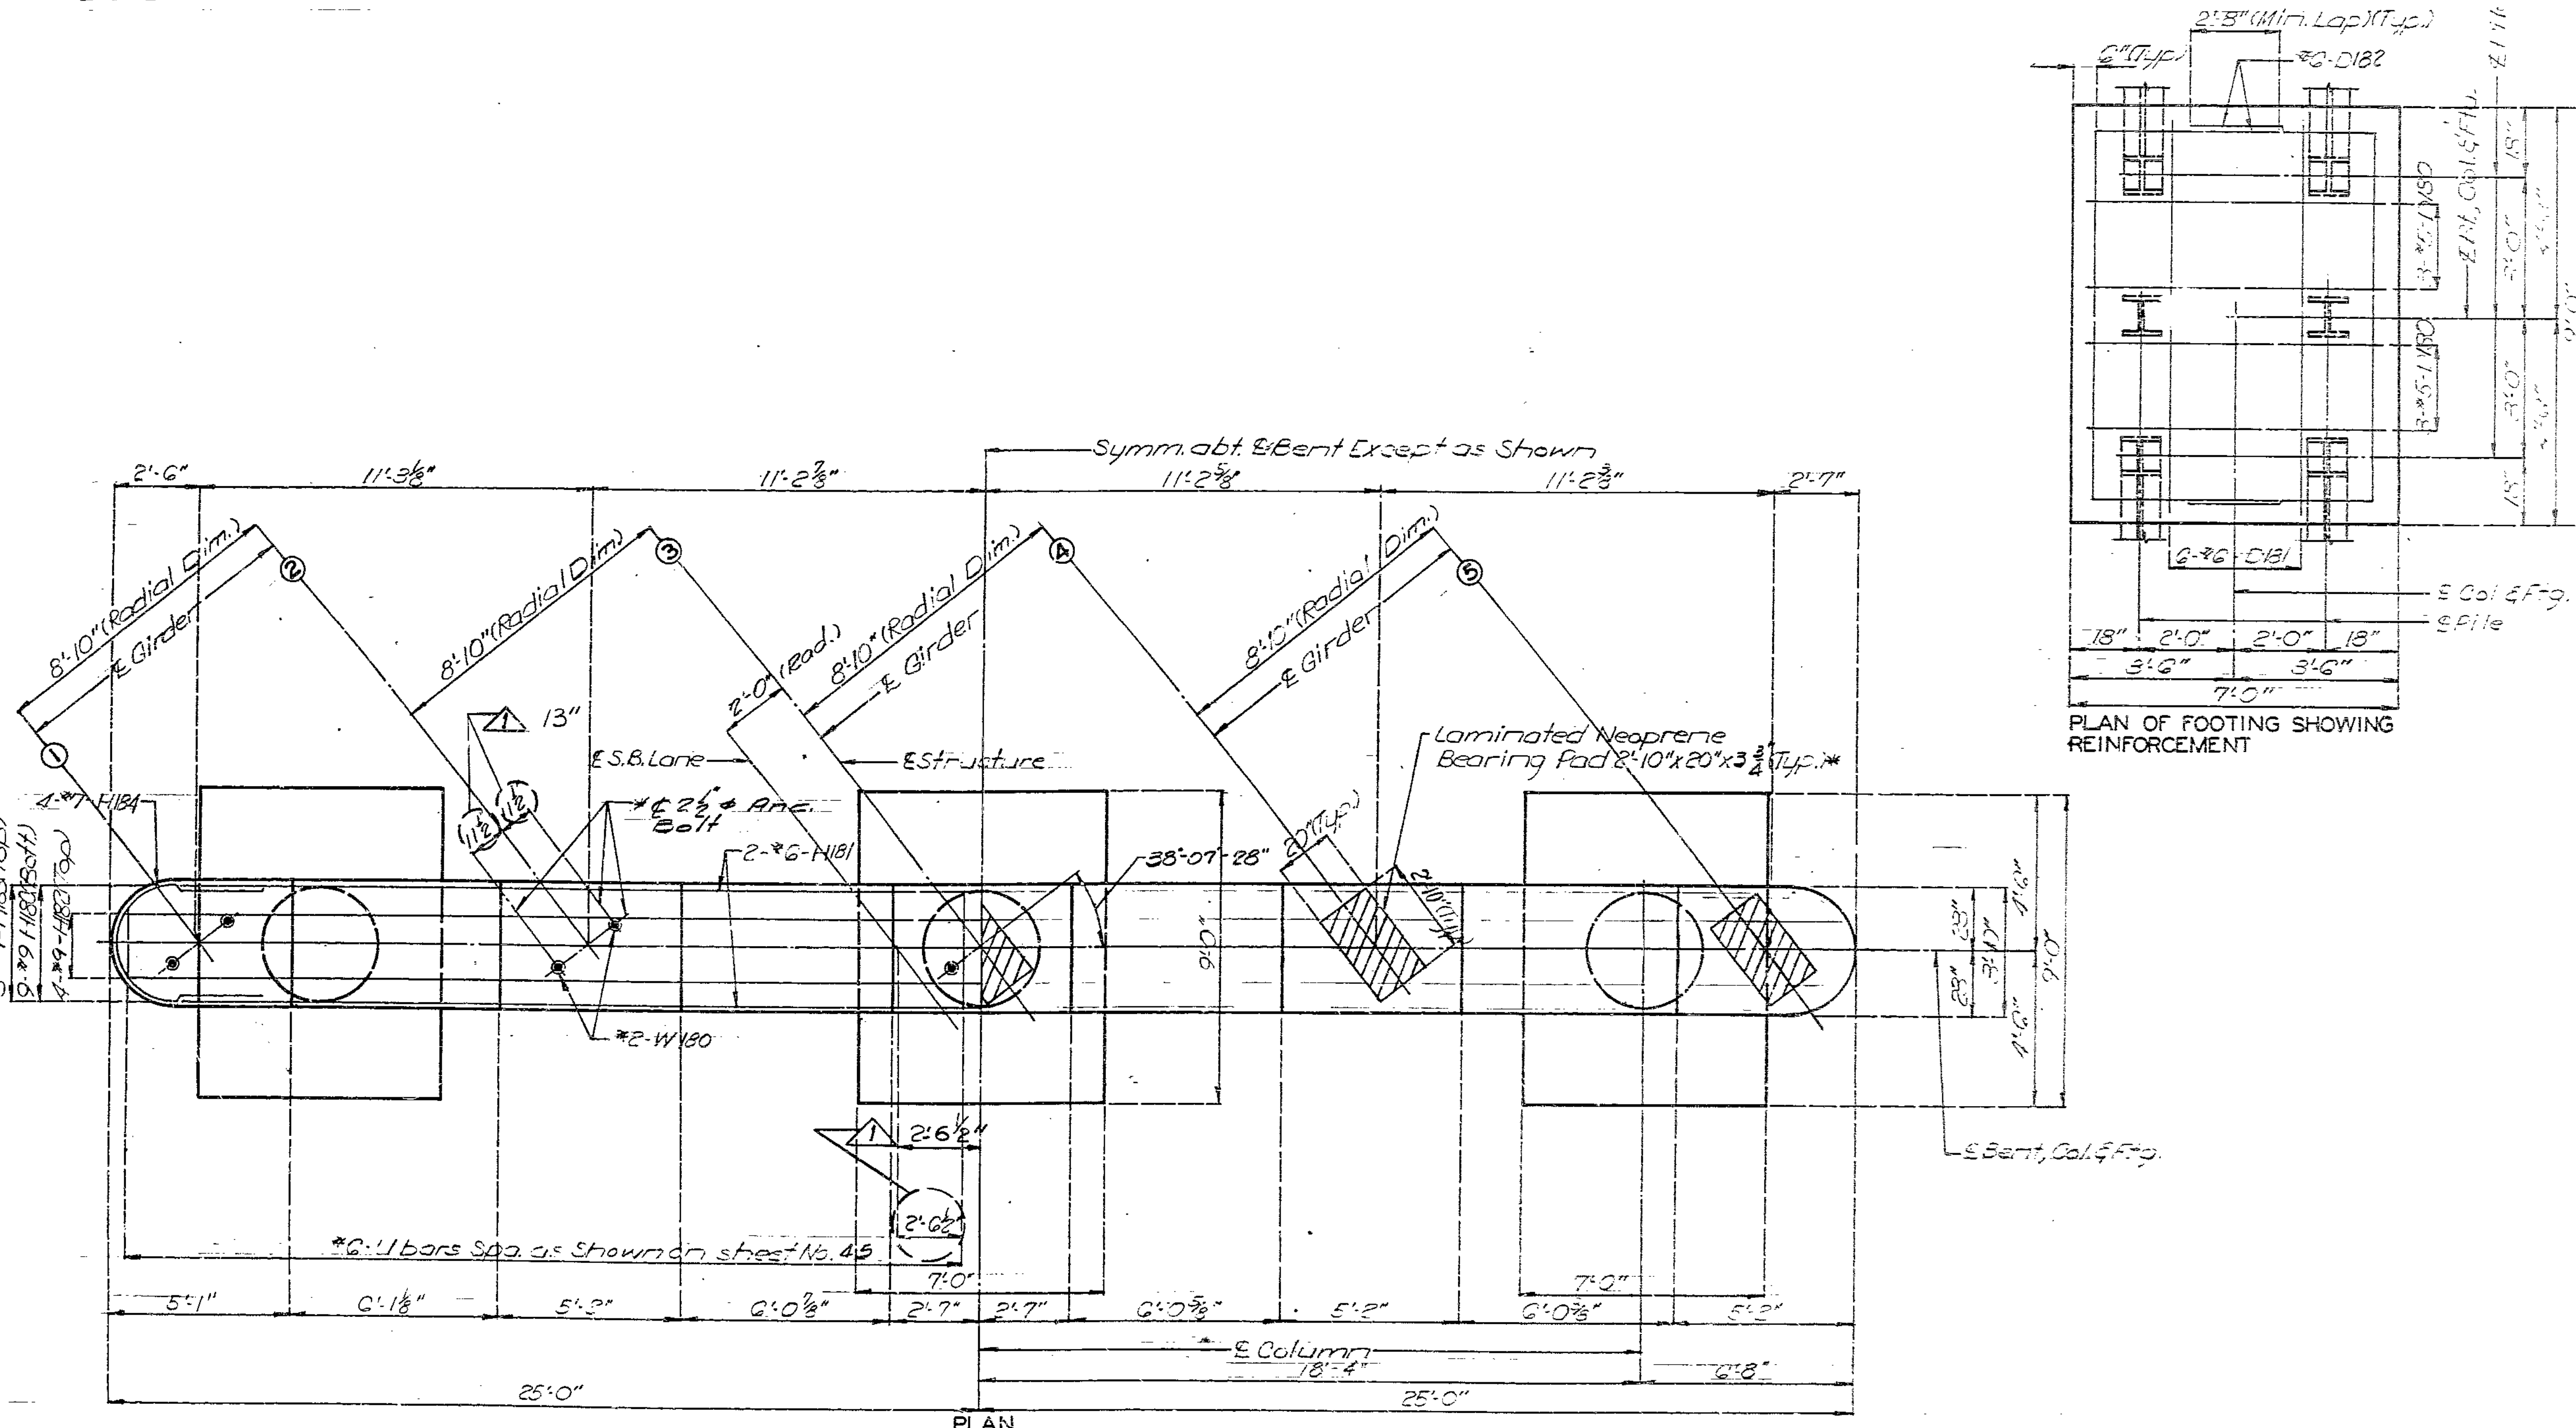

PLAN  
 DETAILS OF INTERMEDIATE BENT NO. 18

DETAILED JUNE 1988  
 CHECKED AUG 1988

Note: This drawing is not to scale. Follow dimensions

Revised 3/3/89

Sheet No. 248 of 55

JACKSON COUNTY


A-2745





MISSOURI HIGHWAY AND TRANSPORTATION COMMISSION

STATE	PROJ. NO.	SHEET NO.
MO.		87
SEC. 22	TWP. 48	RF. 33

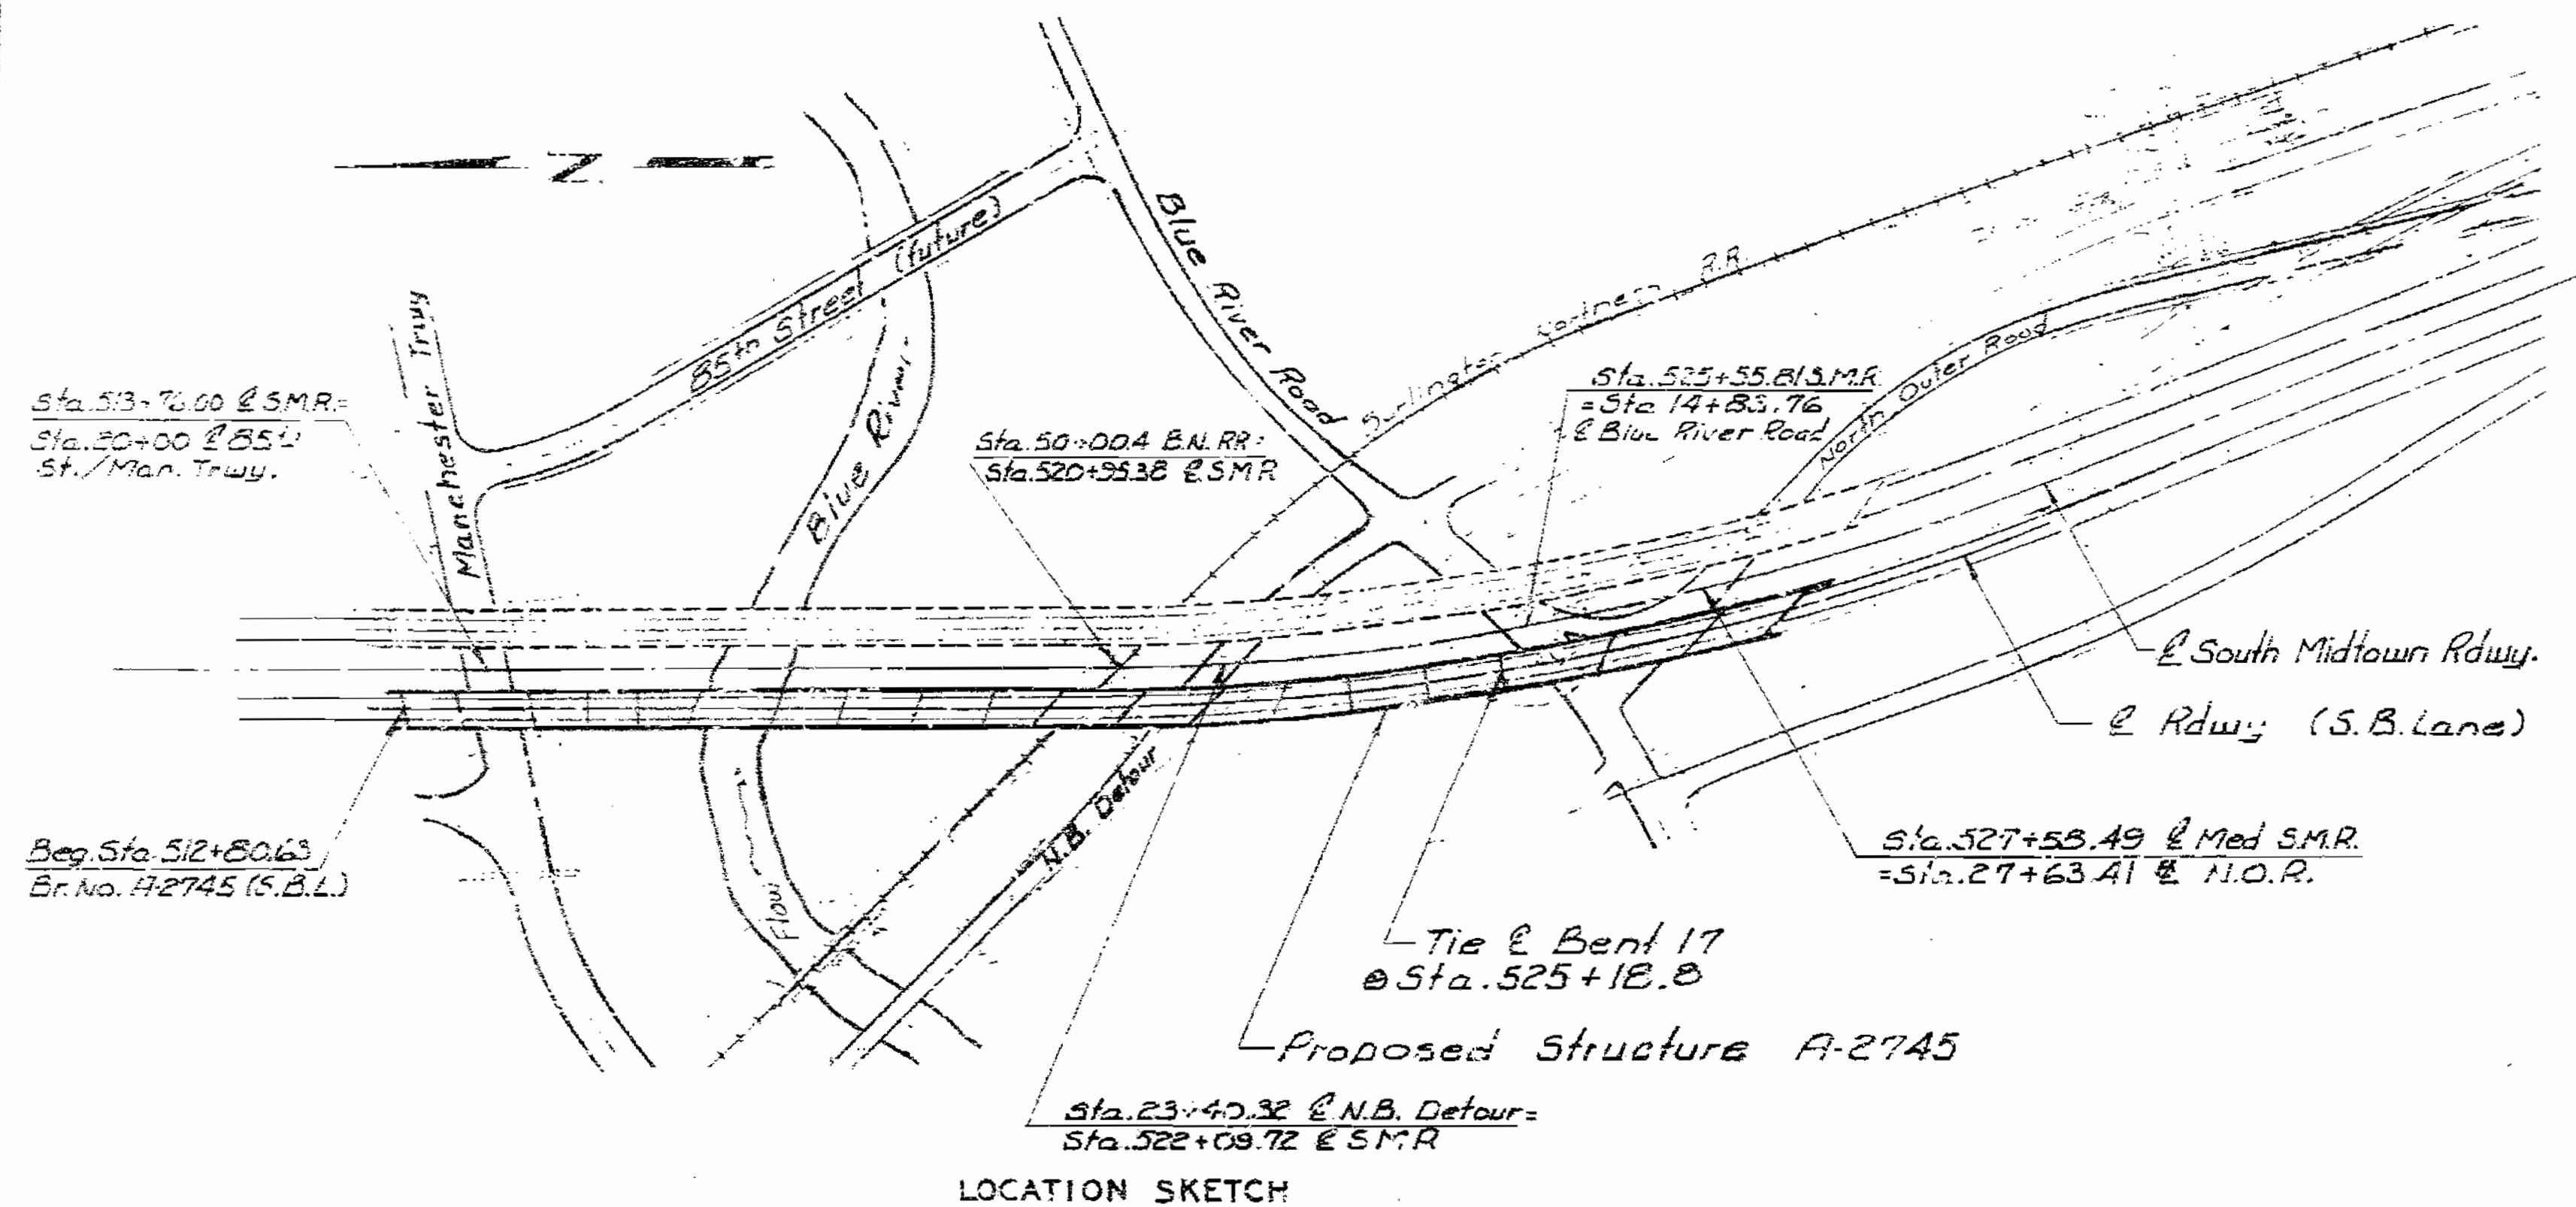

**BRIDGE NO. A-2745**  
**OVER**  
 MANCHESTER TRAFFICWAY, BLUE RIVER,  
 BURLINGTON NORTHERN RR,  
 N.B. DETOUR, BLUE RIVER ROAD  
 & NORTH OUTER ROAD

**SUPERSTRUCTURE CONTRACT**

LOCATION SKETCH

**INDEX OF DRAWINGS**

- |                                      |                              |                               |                                     |
|--------------------------------------|------------------------------|-------------------------------|-------------------------------------|
| 1. INDEX OF DRAWINGS                 | 26. P/S GIRDER LAYOUT        | 51. ELEV. OF P/S CONC. I-GDR  | 76. PLAN OF SLAB                    |
| 2. PART PLAN & ELEVATION             | 27. ELEV. OF P/S CONC. I-GDR | 52. ELEV. OF P/S CONC. I-GDR  | 77. PLAN OF SLAB                    |
| 3. PART PLAN & ELEVATION             | 28. ELEV. OF P/S CONC. I-GDR | 53. ELEV. OF P/S CONC. I-GDR  | 78. PLAN OF SLAB                    |
| 4. PART PLAN & ELEVATION             | 29. ELEV. OF P/S CONC. I-GDR | 54. ELEV. OF P/S CONC. I-GDR  | 79. PLAN OF SLAB                    |
| 5. PART PLAN & ELEVATION             | 30. ELEV. OF P/S CONC. I-GDR | 55. PART LONGITUDINAL SECTION | 80. SUPERELEVATION TRANSITION       |
| 6. PART PLAN & ELEVATION             | 31. ELEV. OF P/S CONC. I-GDR | 56. PLAN OF STRUCTURAL STEEL  | 81. SLAB POURING SEQUENCE           |
| 7. PART PLAN & ELEVATION             | 32. ELEV. OF P/S CONC. I-GDR | 57. ELEVATION OF GIRDER       | 82. SLAB DRAINS                     |
| 8. PART PLAN & ELEVATION             | 33. ELEV. OF P/S CONC. I-GDR | 58. ELEVATION OF GIRDER       | 83. SLAB DRAINS                     |
| 9. GENERAL NOTES & QUANTITIES        | 34. ELEV. OF P/S CONC. I-GDR | 59. FIELD FLANGE SPLICES      | 84. ELASTOMERIC JOINT SEAL          |
| 10. END BENT NO. 1                   | 35. ELEV. OF P/S CONC. I-GDR | 60. MISCELLANEOUS STEEL       | 85. ELASTOMERIC JOINT SEAL          |
| 11. END BENT NO. 1                   | 36. ELEV. OF P/S CONC. I-GDR | 61. EARTHQUAKE RESTRAINERS    | 86. ELASTOMERIC JOINT SEAL          |
| 12. END BENT NO. 1                   | 37. ELEV. OF P/S CONC. I-GDR | 62. EARTHQUAKE RESTRAINERS    | 87. ELASTOMERIC JOINT SEAL          |
| 13. INT. BENT NO. 2 thru NO. 7       | 38. ELEV. OF P/S CONC. I-GDR | 63. INT. BENT DIAPHRAGMS      | 88. LIGHT STANDARD - DELETE 9-22-89 |
| 14. INT. BENT NO. 11 & NO. 12        | 39. ELEV. OF P/S CONC. I-GDR | 64. INT. BENT DIAPHRAGMS      | 89. LEFT BARRIER CURB               |
| 15. INT. BENT NO. 13 & NO. 14        | 40. ELEV. OF P/S CONC. I-GDR | 65. INT. BENT DIAPHRAGMS      | 90. LEFT BARRIER CURB               |
| 16. INT. BENT NO. 15 & NO. 16        | 41. ELEV. OF P/S CONC. I-GDR | 66. INT. BENT DIAPHRAGMS      | 91. RIGHT BARRIER CURB              |
| 17. INT. BENT NO. 8, 9, 10 & 18      | 42. ELEV. OF P/S CONC. I-GDR | 67. INT. BENT DIAPHRAGMS      | 92. RIGHT BARRIER CURB              |
| 18. INT. BENT NO. 17 & NO. 19        | 43. ELEV. OF P/S CONC. I-GDR | 68. STEEL DIAPH. FOR P/S      | 93. BARRIER CURB AT END BTS.        |
| 19. END BENT NO. 20                  | 44. ELEV. OF P/S CONC. I-GDR | 69. SLAB HAUNCHING DIAGRAM    | 94. BAR LIST                        |
| 20. VERTICAL DRAIN AT END BENTS      | 45. ELEV. OF P/S CONC. I-GDR | 70. SLAB CURVE ORDINATES      | 95. BAR LIST                        |
| 21. LAMINATED NEOPRENE BRGS. (P/S)   | 46. ELEV. OF P/S CONC. I-GDR | 71. SLAB CURVE ORDINATES      | 96. BAR LIST                        |
| 22. LAMINATED NEOPRENE BRGS. (STEEL) | 47. ELEV. OF P/S CONC. I-GDR | 72. PRECAST P/S PANELS        | 97. BAR LIST                        |
| 23. TYPE "N" PTFE BEARINGS           | 48. ELEV. OF P/S CONC. I-GDR | 73. SECTION THRU SLAB (P/S)   | 98. BAR LIST                        |
| 24. P/S GIRDER LAYOUT                | 49. ELEV. OF P/S CONC. I-GDR | 74. PLAN OF SLAB              |                                     |
| 25. P/S GIRDER LAYOUT                | 50. ELEV. OF P/S CONC. I-GDR | 75. PLAN OF SLAB              |                                     |

B.M. TBM-1 Elevation 730.85 S.W. cor. signal base at S.W. cor. 87th St. and Hickman Mills Dr.

STATE ROAD: "SOUTH MIDTOWN ROADWAY"  
 IN KANSAS CITY  
 PROJECT NO. STA. 512+80.63  
 JOB NO. 4-U-71-2E RTE. 71 S.B.L.

JACKSON COUNTY

DATE 6-19-80

STD. 706.35
STD.
A-2745

DESIGNED March 1980  
 DETAILED March 1980  
 CHECKED April 1980

Note: This drawing is on a scale. Follow dimensions.


Sheet No. 1 of 98

*Handwritten signature/initials*

SEE TYPICAL PLANS

STATE	PROJ. NO.	SHEET NO.
MO		89


(64'-82'-65')(65'-65'-82'-82'-82')(82'-67'-90'-90')(79'-79'-85'-85') PRESTRESSED CONCRETE I-GIRDER SPANS  
(123'-123'-93') CONT. COMP. R. GIRDER SPANS

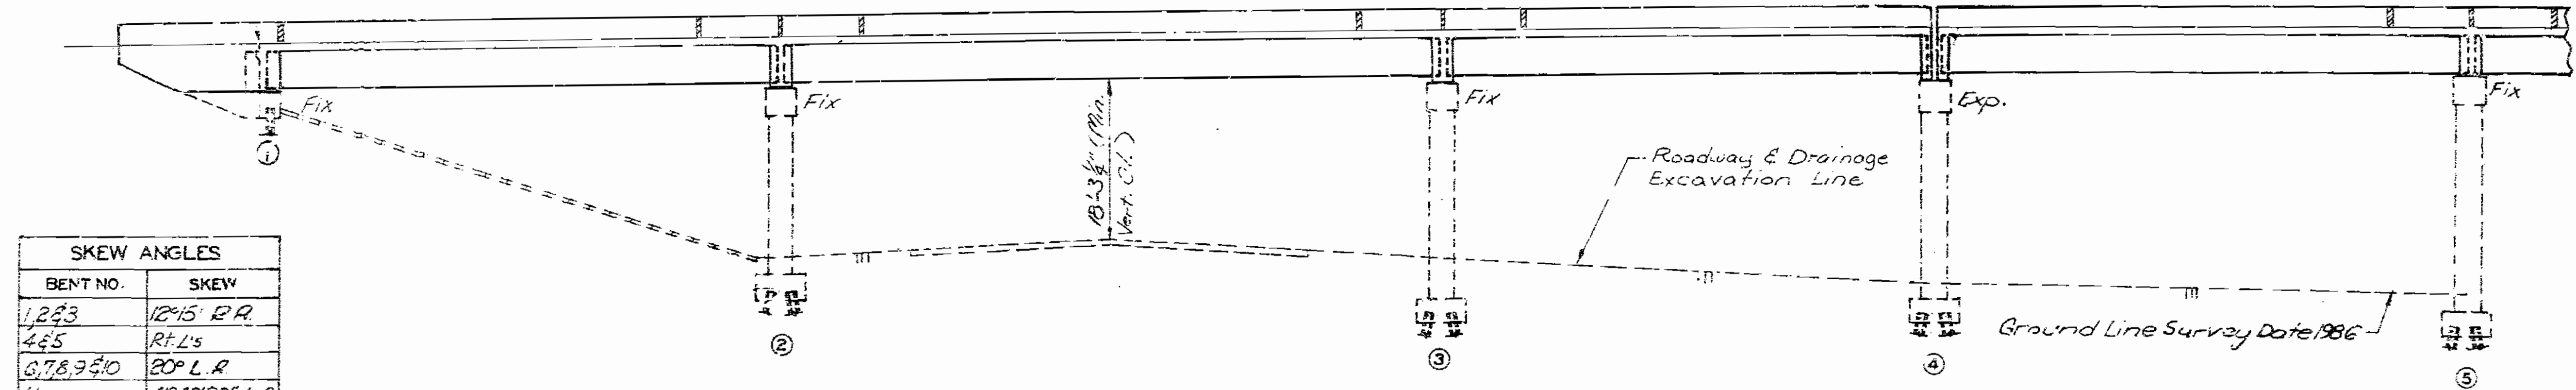

PART GENERAL ELEVATION

SKEW ANGLES	
BENT NO.	SKEW
1,2,3	12°15' R.R.
4,5	Rt. L's
6,7,8,9,10	20° L.R.
11	11°46'20" L.A.
12	42°47'38" L.A.
13	44°34'00" L.A.
14	26°18'44" L.A.
15,16,17	Radial
18	38°09'11" L.A.
19	57°25'06" L.A.
20	59°17'55" L.A.

Note: Skew angles are measured at  $\perp$  S.B.L.

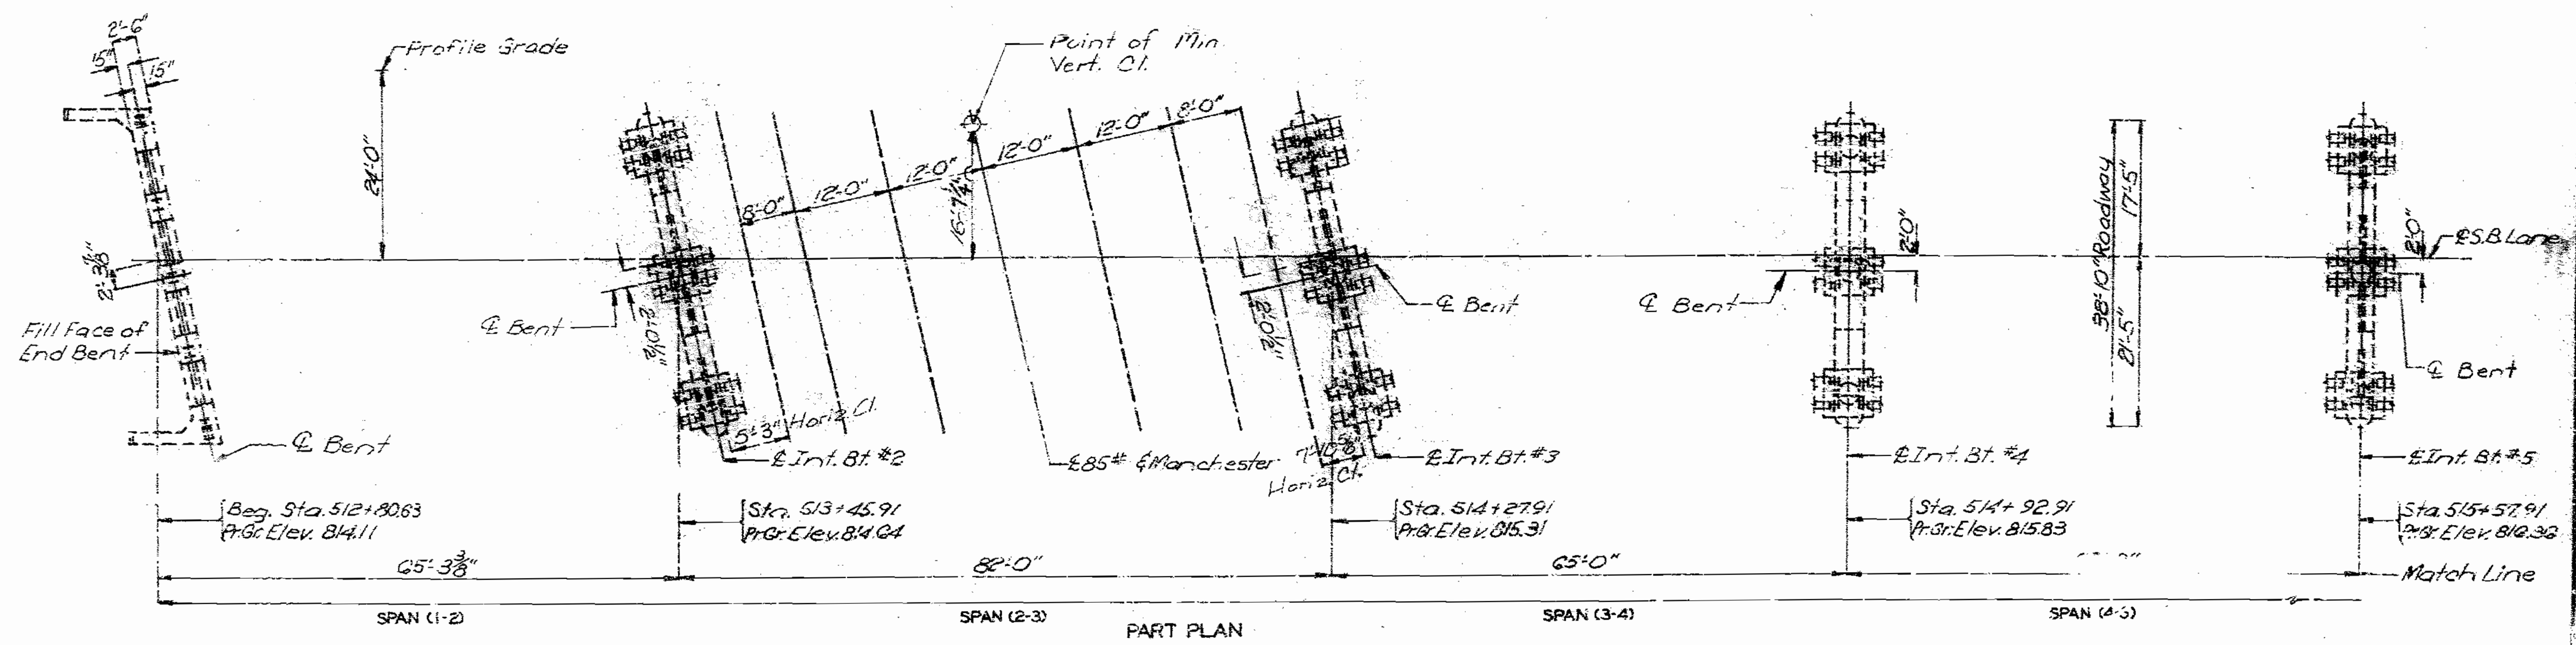

PART PLAN

Note: Deadman Anchor not shown for clarity.

1889

DETAILED Sept. 1988  
CHECKED March 1989


Note: This drawing is not to scale. Follow dimensions.

SEE PLAN PLANS  
Sheet No. 2 of 98


JACKSON COUNTY

A-2745

STATE	PROJ. NO.	SHEET NO.
MO		85

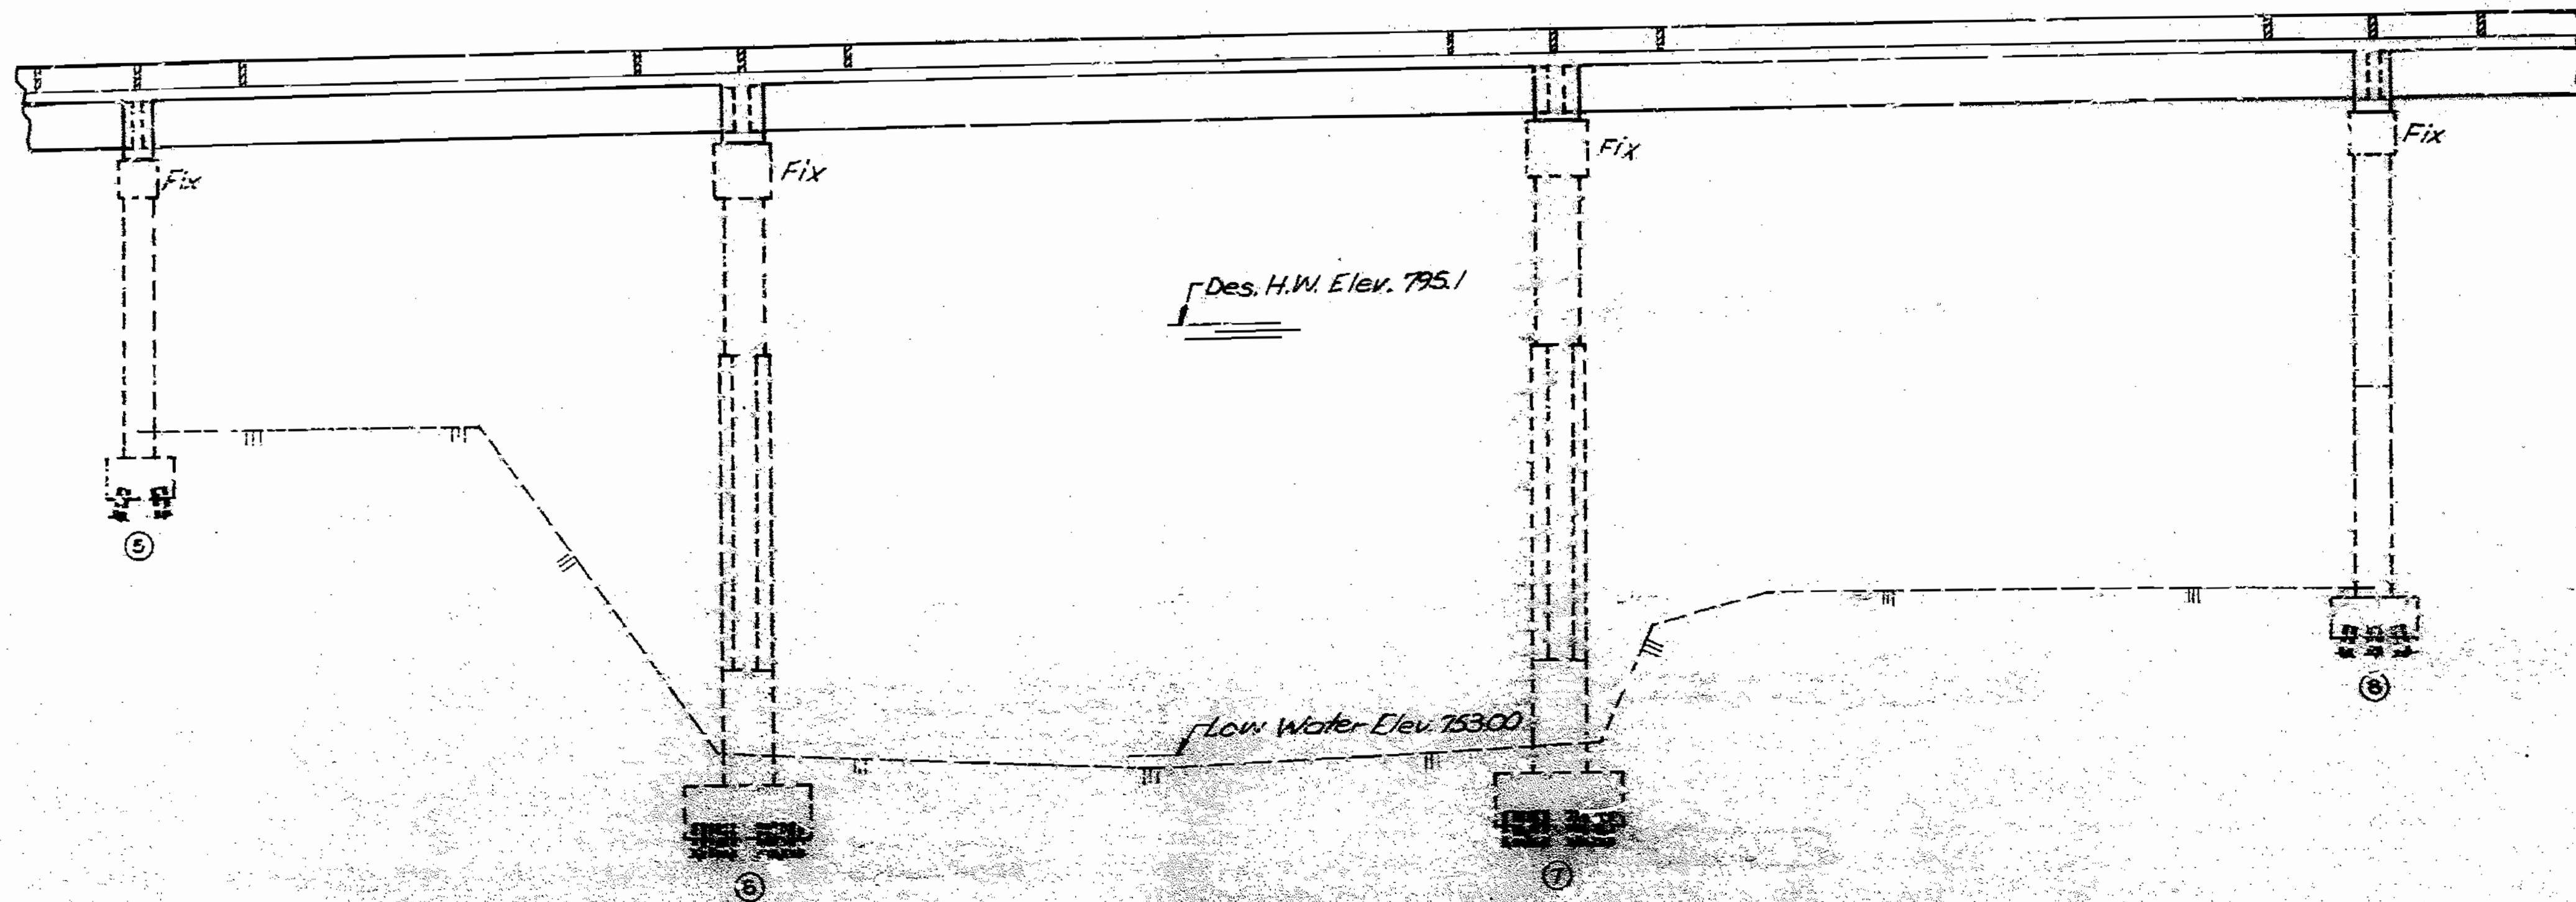

PART GENERAL ELEVATION

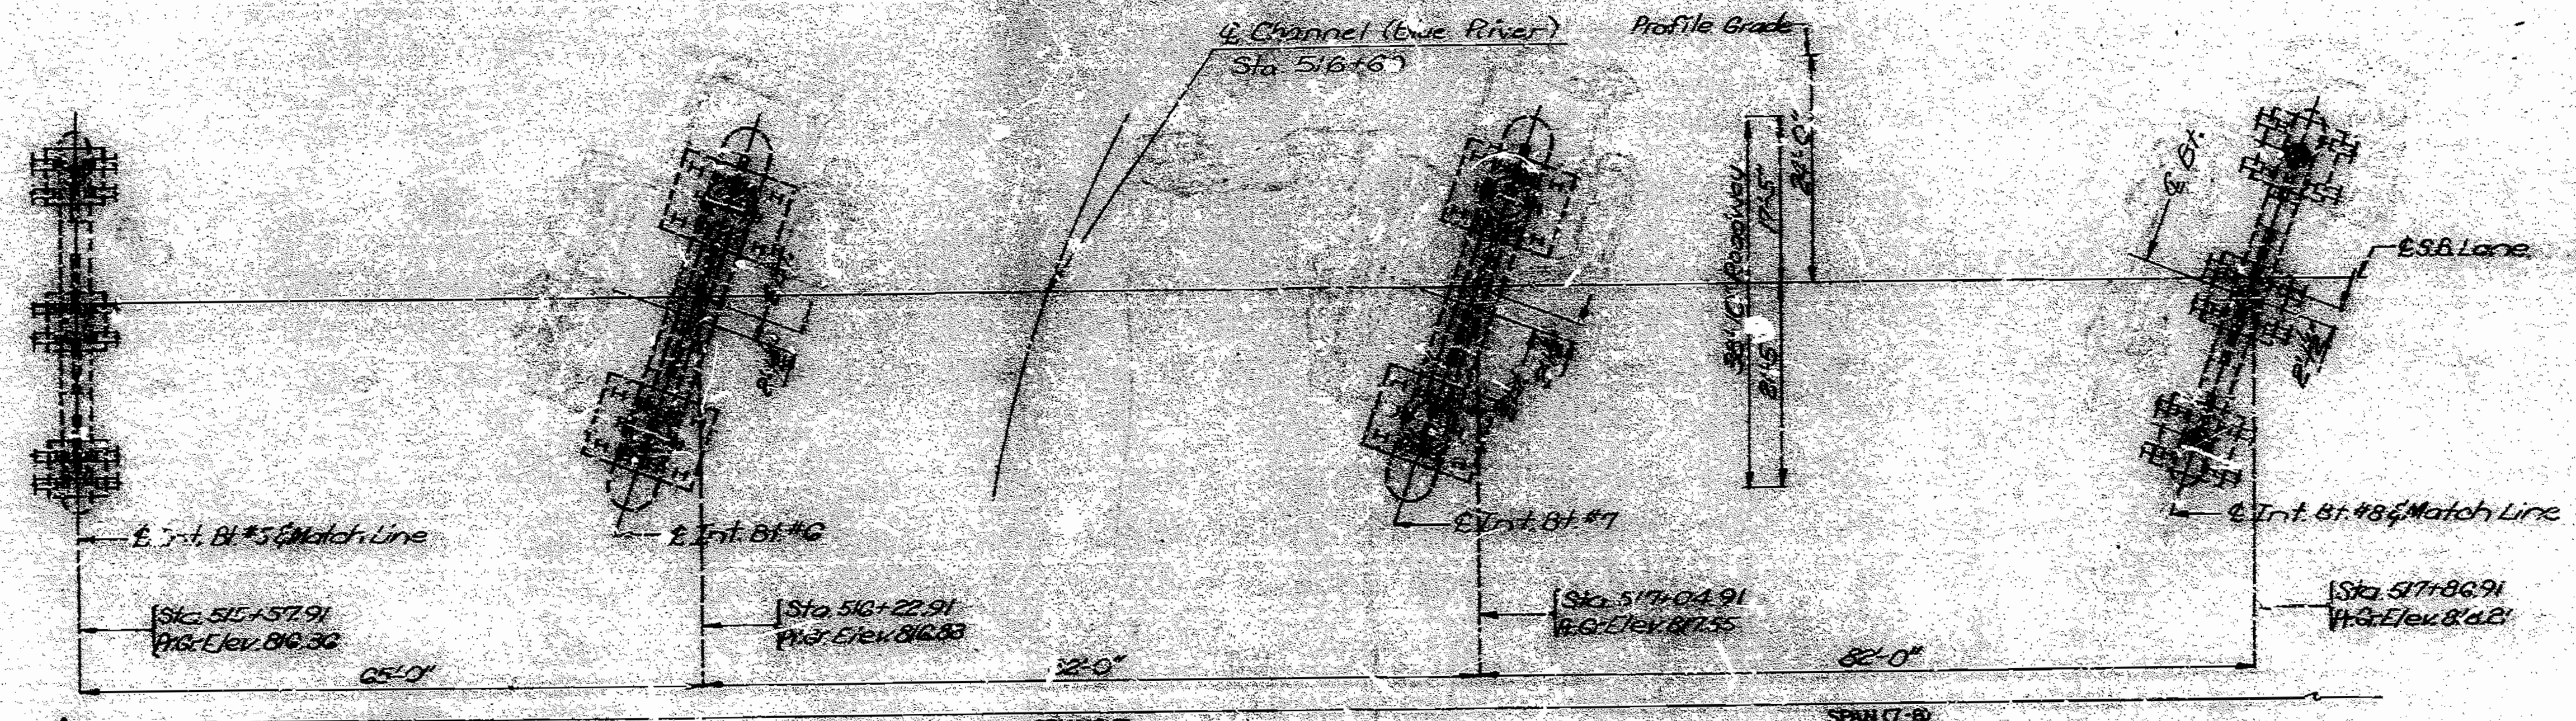

PART PLAN

98  
 185

DESIGNED *Sept* 1988  
 CHECKED *March* 1989


Note: This drawing is not to scale. Follow dimensions.

SEE TYPICAL PLANS  
 Sheet No. 90 of 98


JACKSON COUNTY

A-2745

STATE	PROJ. NO.	SHEET NO.
MO.		84

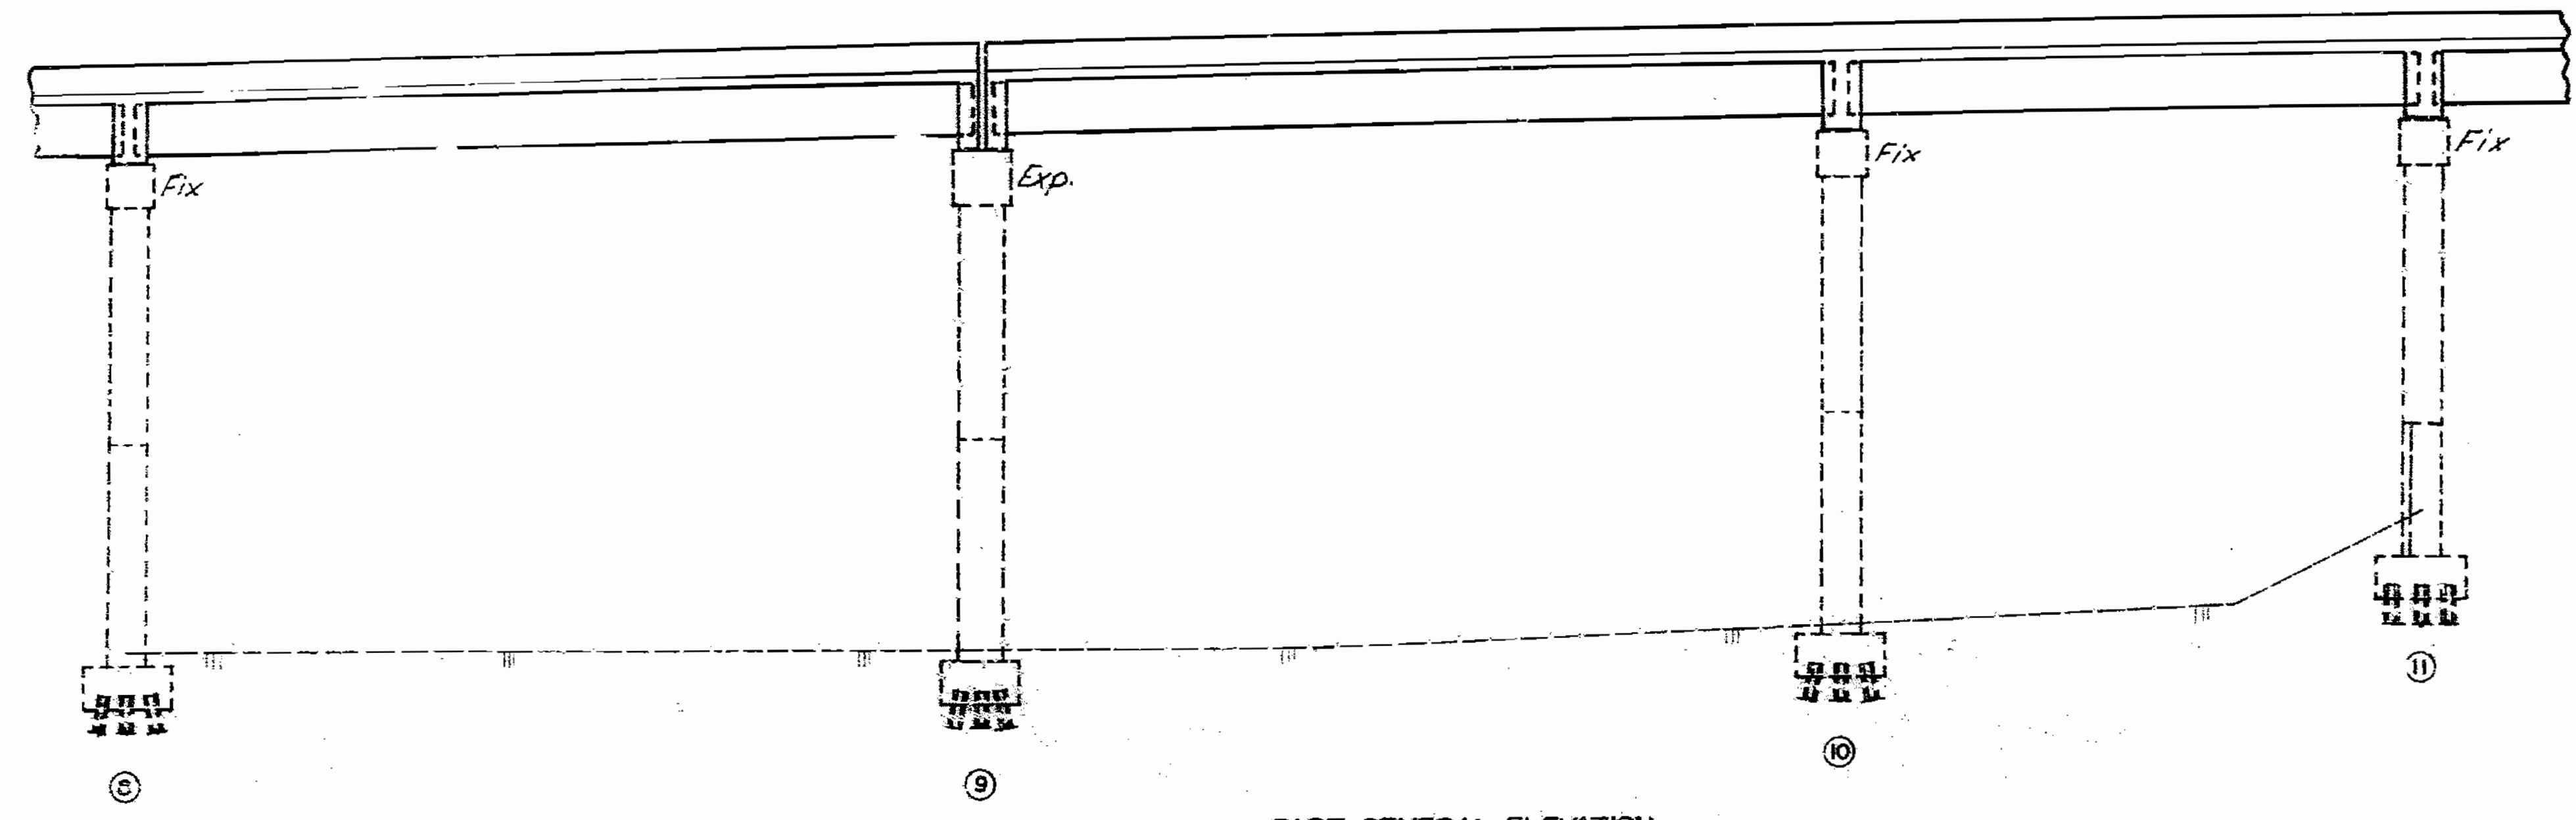

PART GENERAL ELEVATION

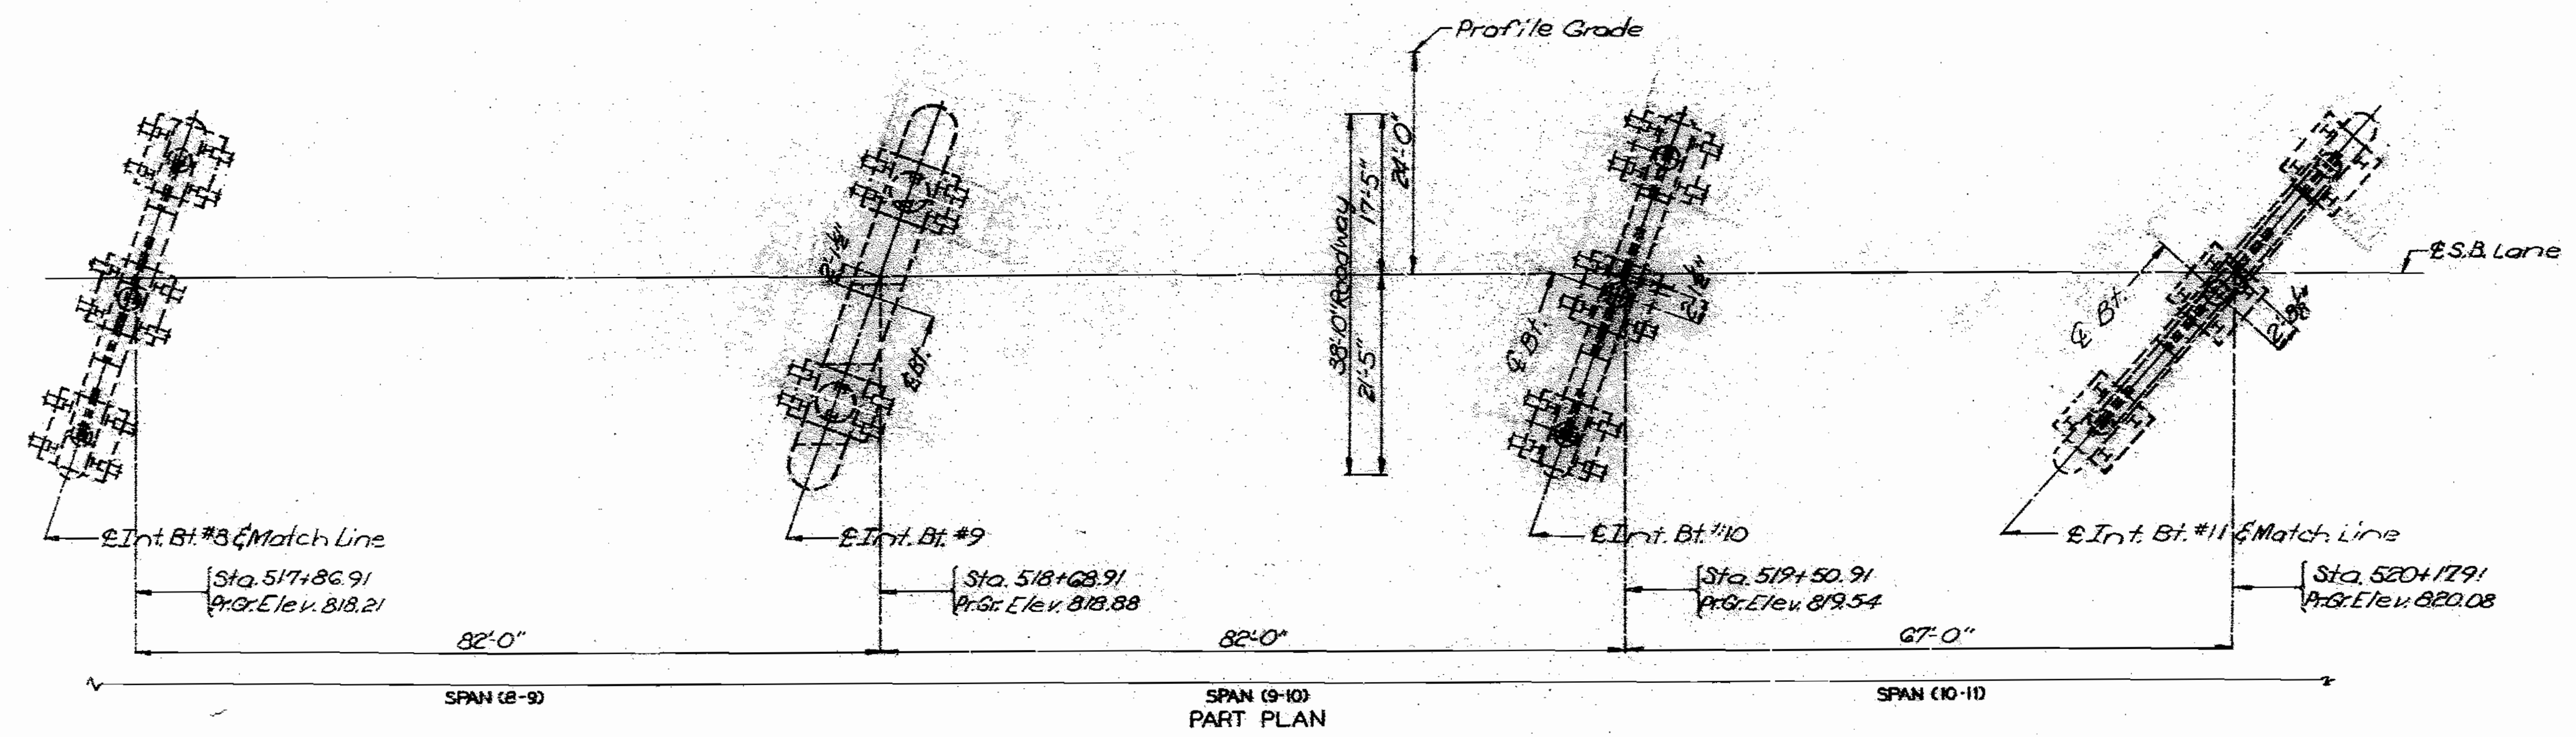

PART PLAN

99

DETAILED Sept. 1988  
CHECKED March 1989


Note: This drawing is not to scale. Follow dimensions.

SEE FINAL PLANS  
Sheet No. 4 of 98


JACKSON COUNTY

A-2745

STATE	PROJ. NO.	SHEET NO.
MO.		85

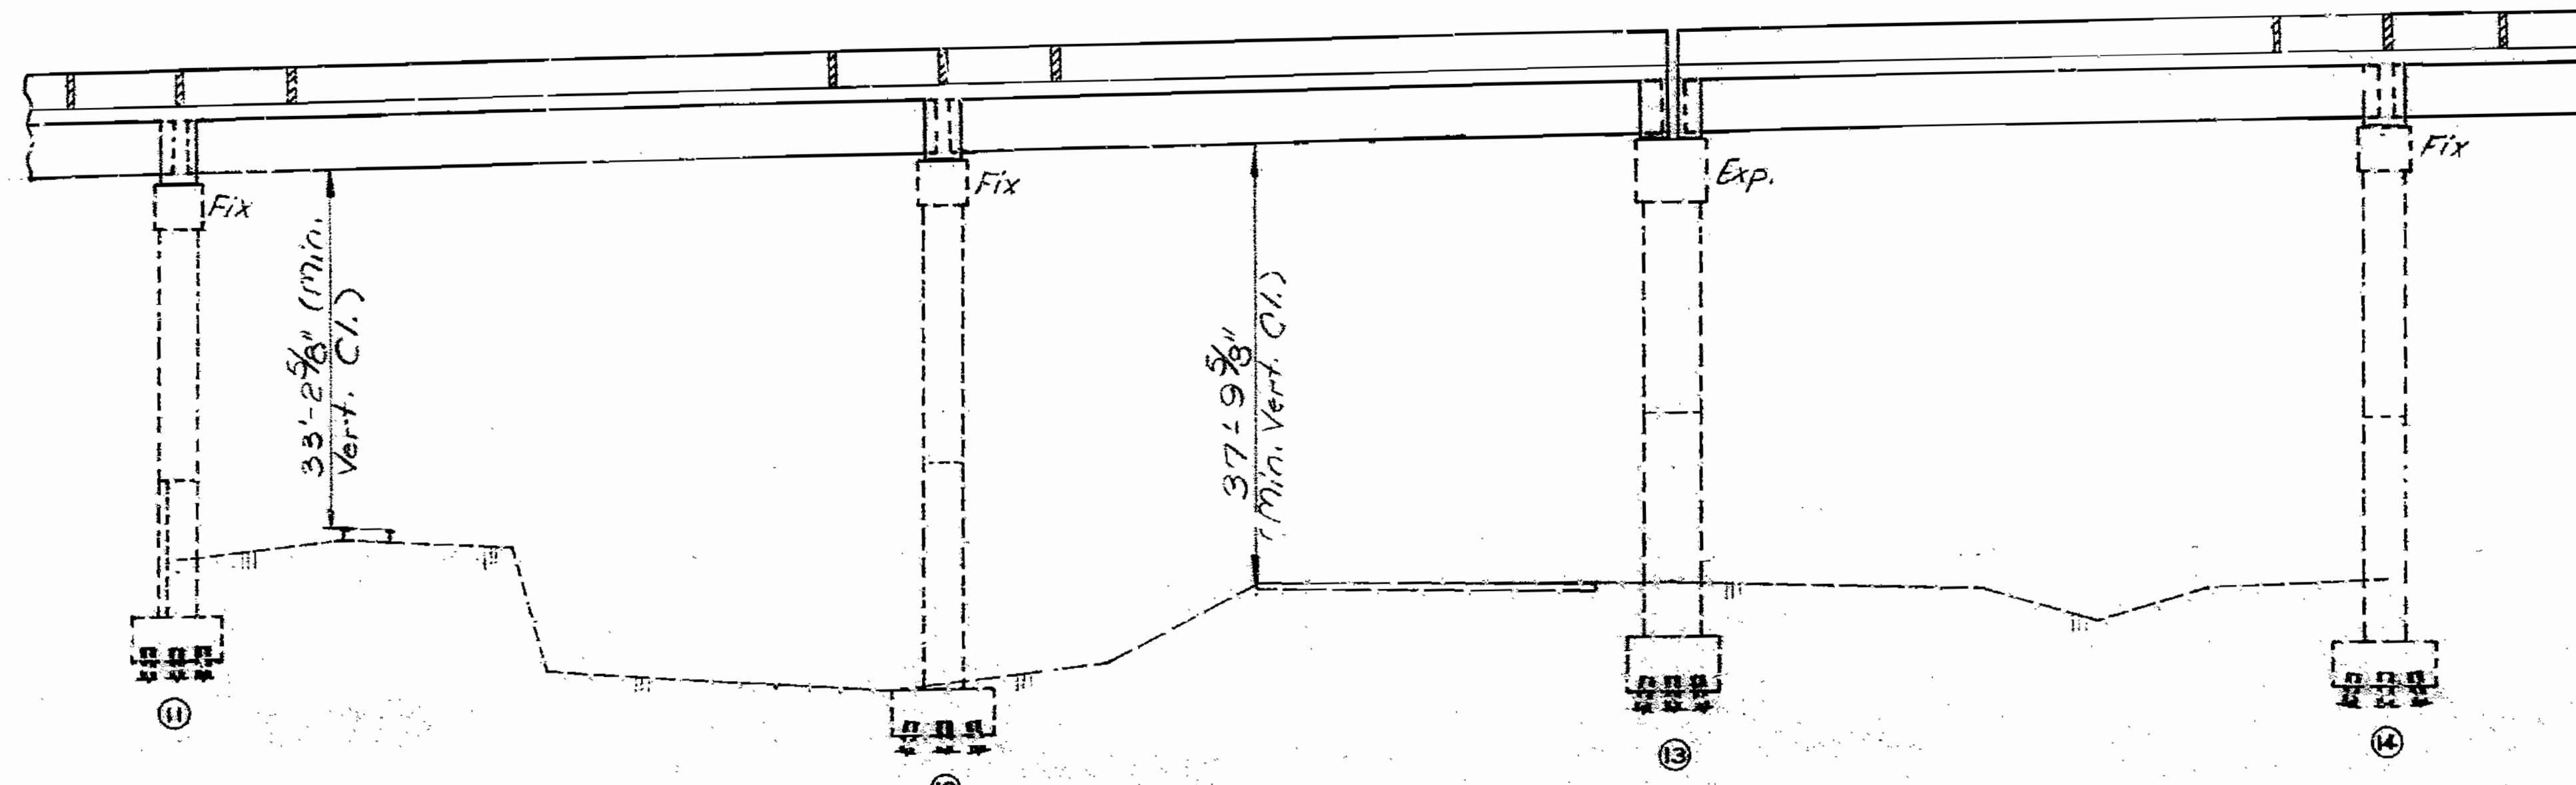

PART GENERAL ELEVATION

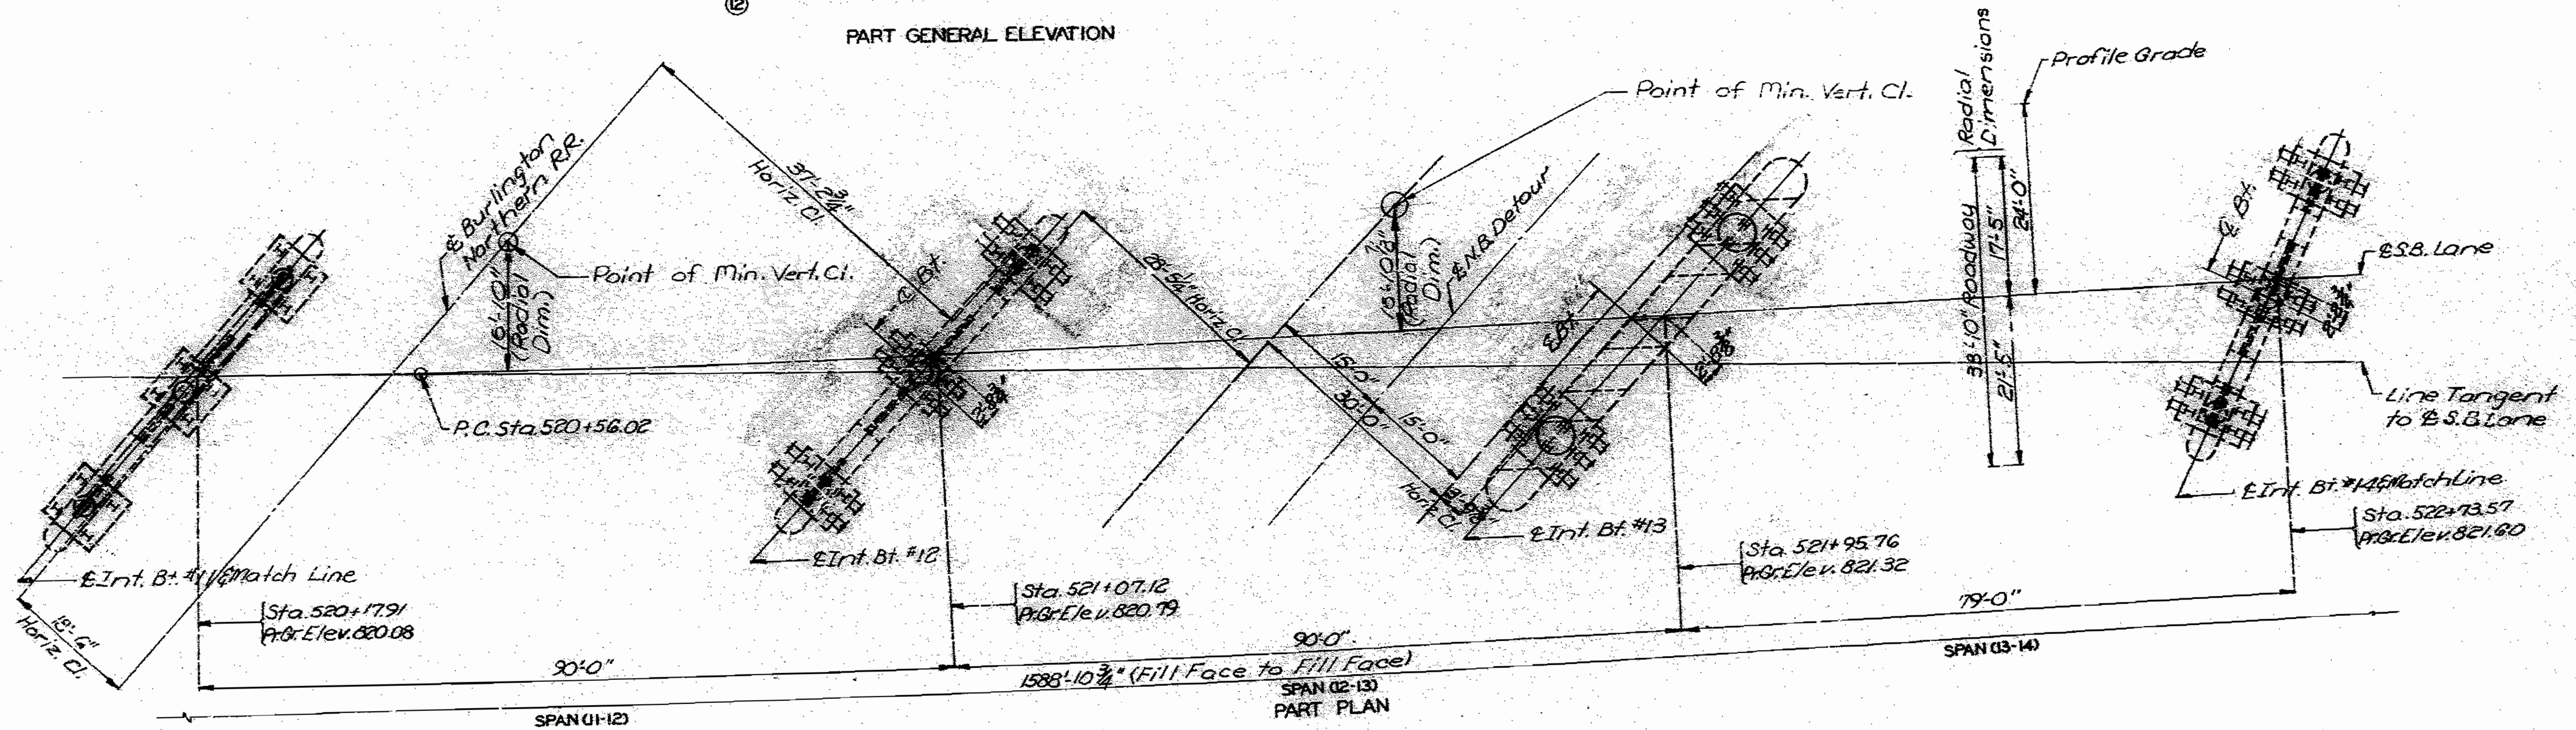

PART PLAN

187100

DETAILED Sept. 1988  
CHECKED March 1989

Note: This drawing is not to scale. Follow dimensions.

SEE FINAL PLANS


Sheet No. 5 of 23

JACKSON COUNTY


A-2745



STATE	PROJ NO.	SHEET NO.
MO.		80

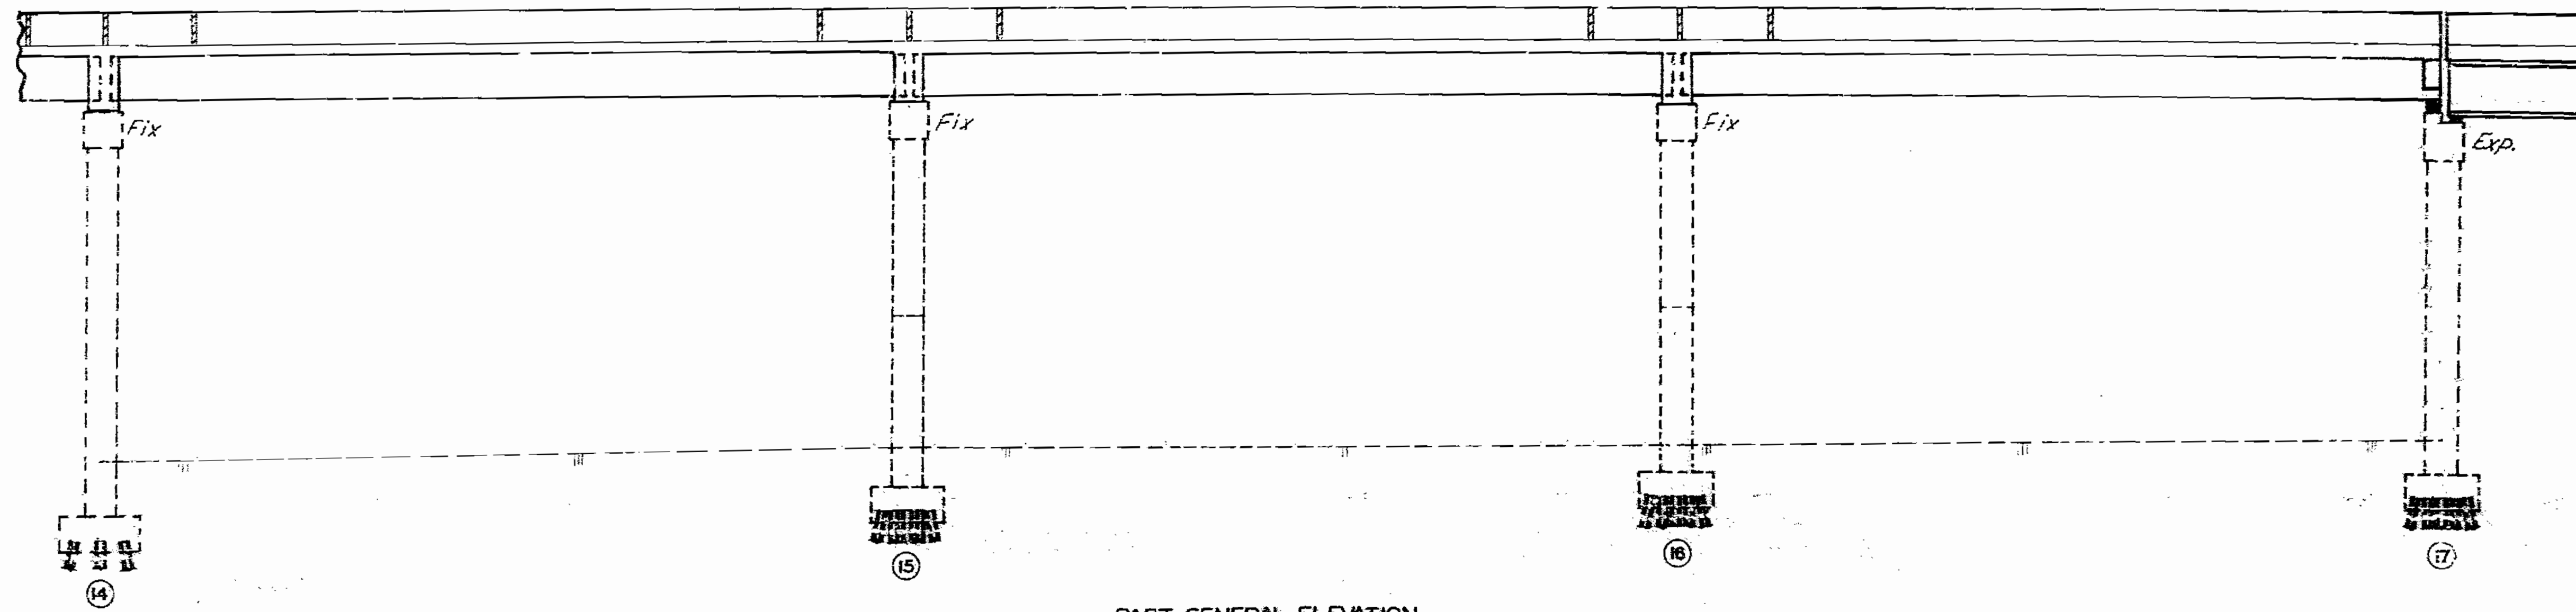

PART GENERAL ELEVATION

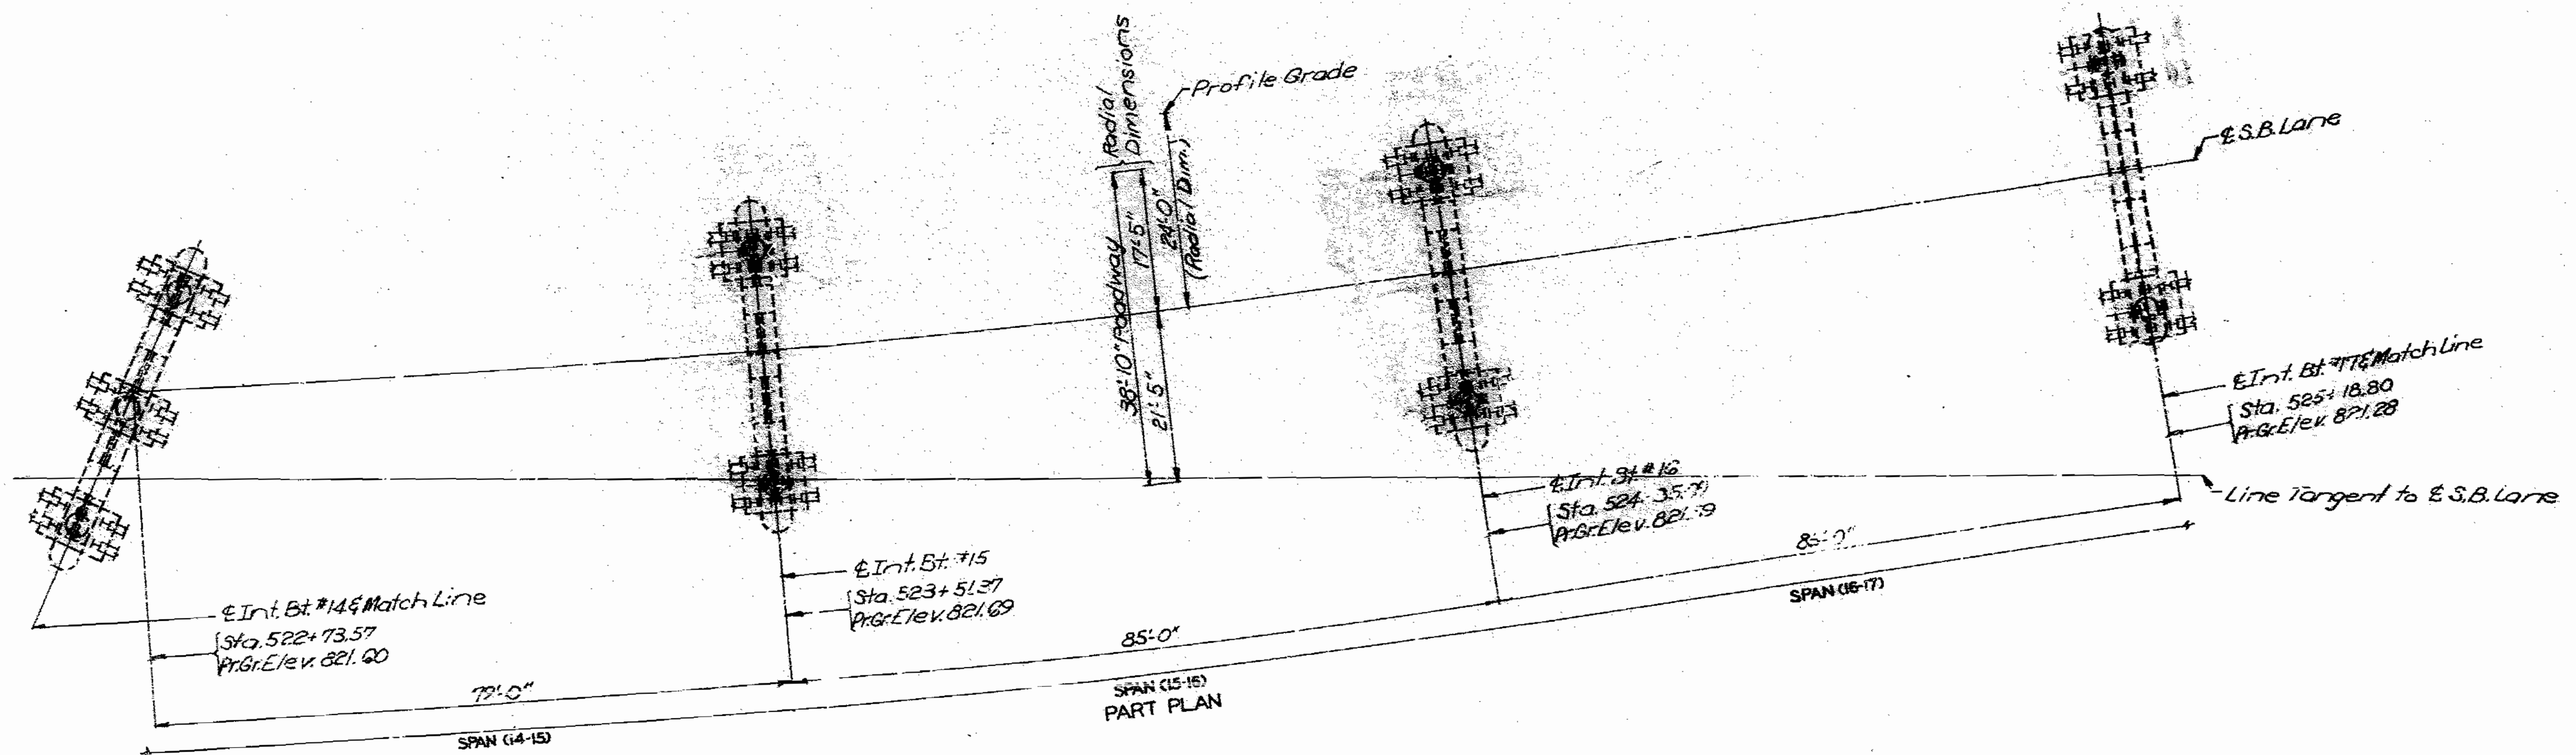

PART PLAN

10/88

DETAILED Oct. 1988  
CHECKED March 1989


Note: This drawing is not to scale. Follow dimensions.

Sheet No. 6 of 23


JACKSON COUNTY

A-2745

STATE	PROJ. NO.	SHEET NO.
MO.		87

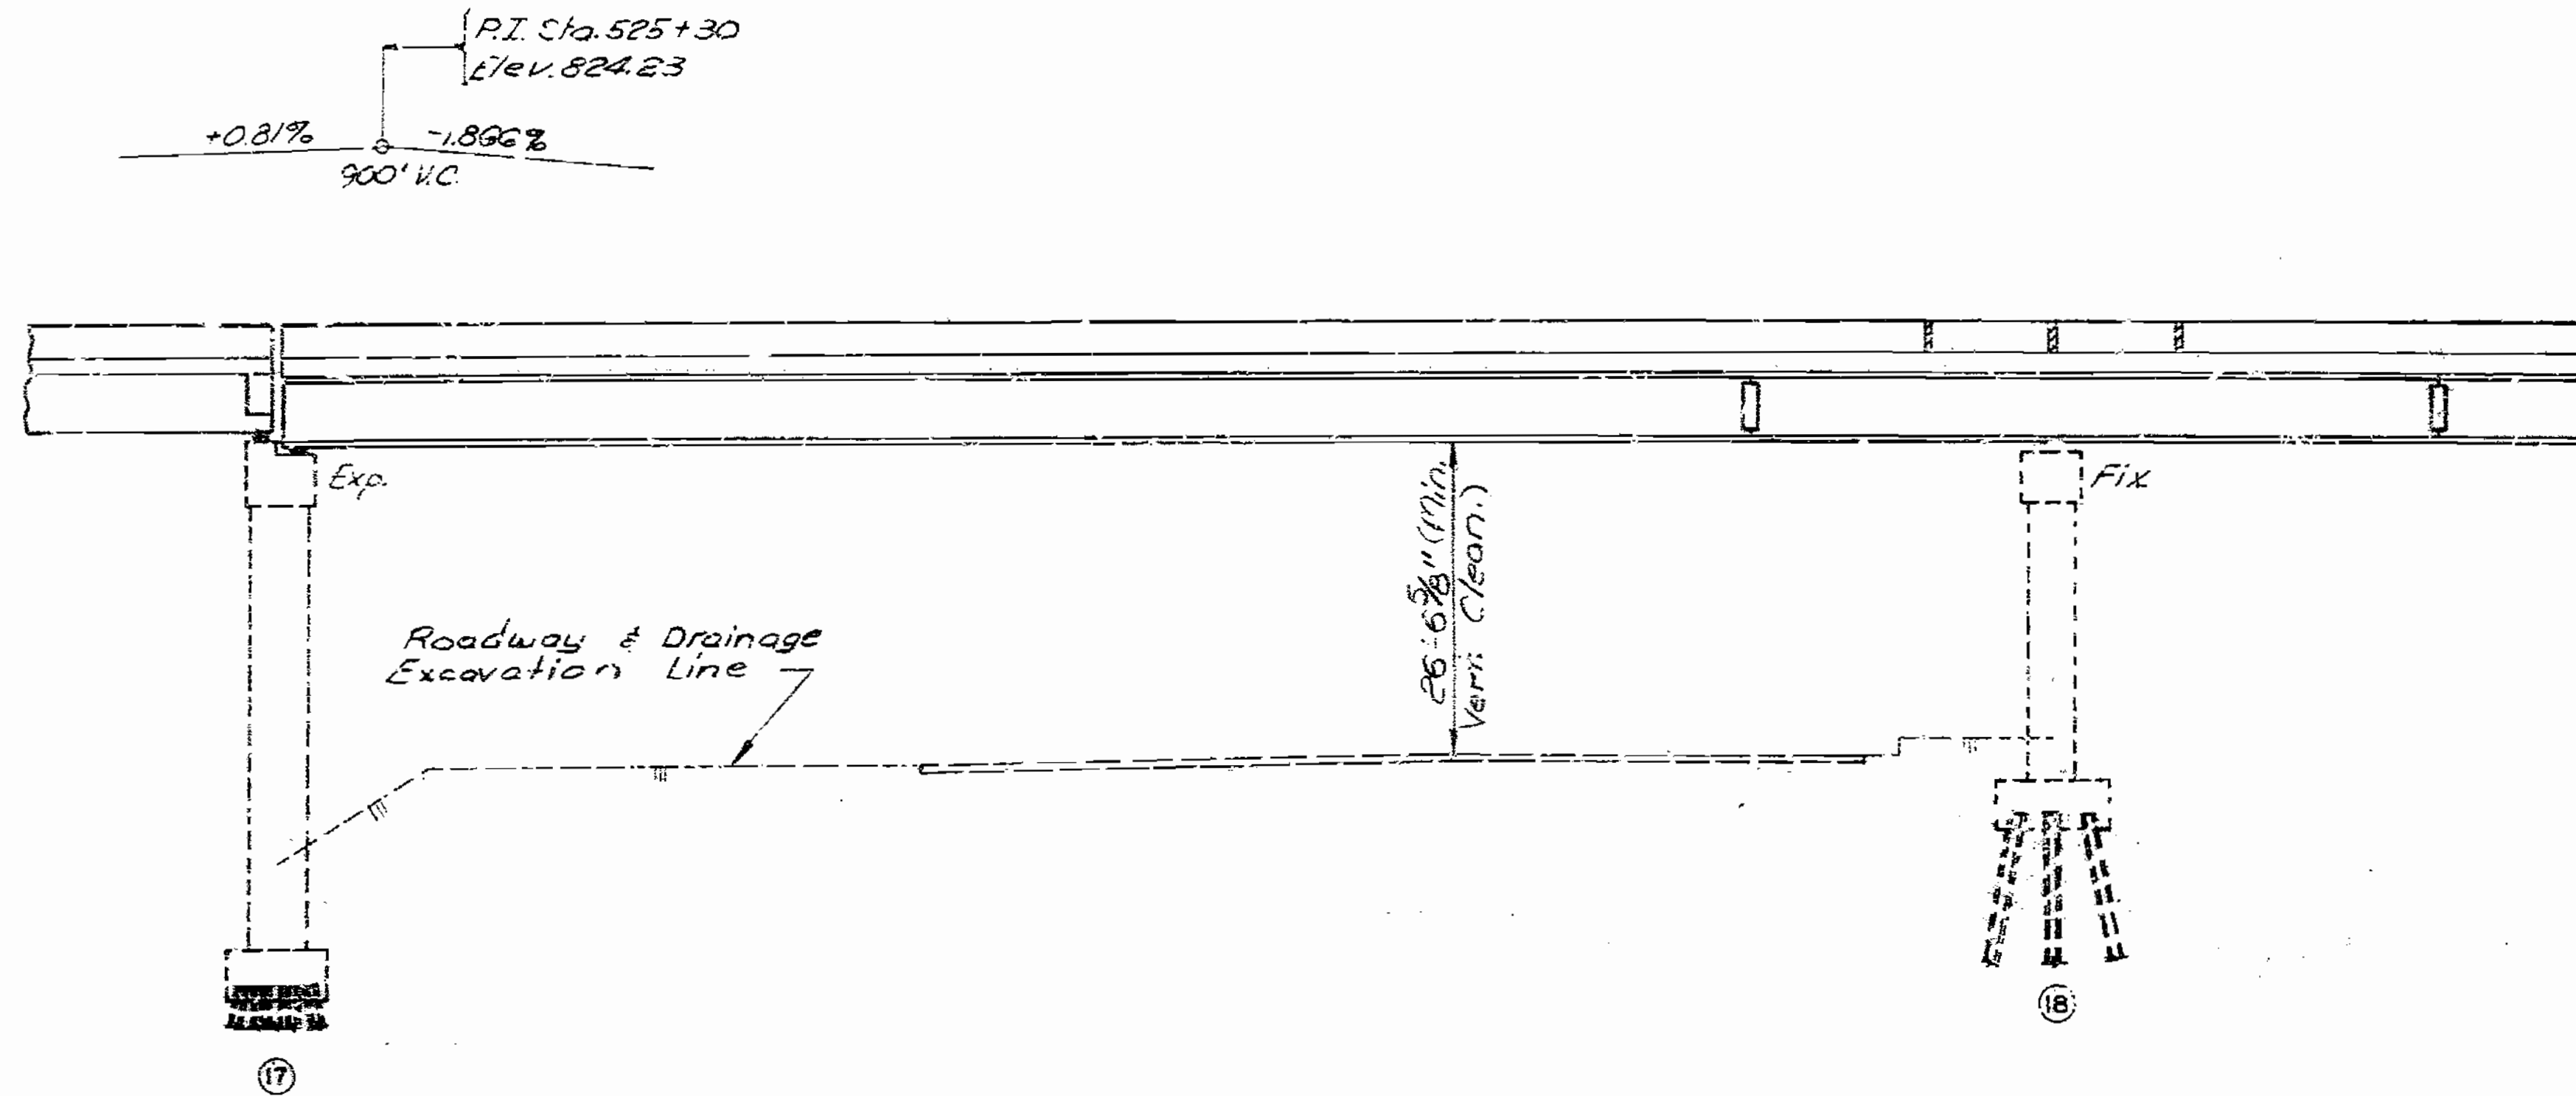

PART GENERAL ELEVATION

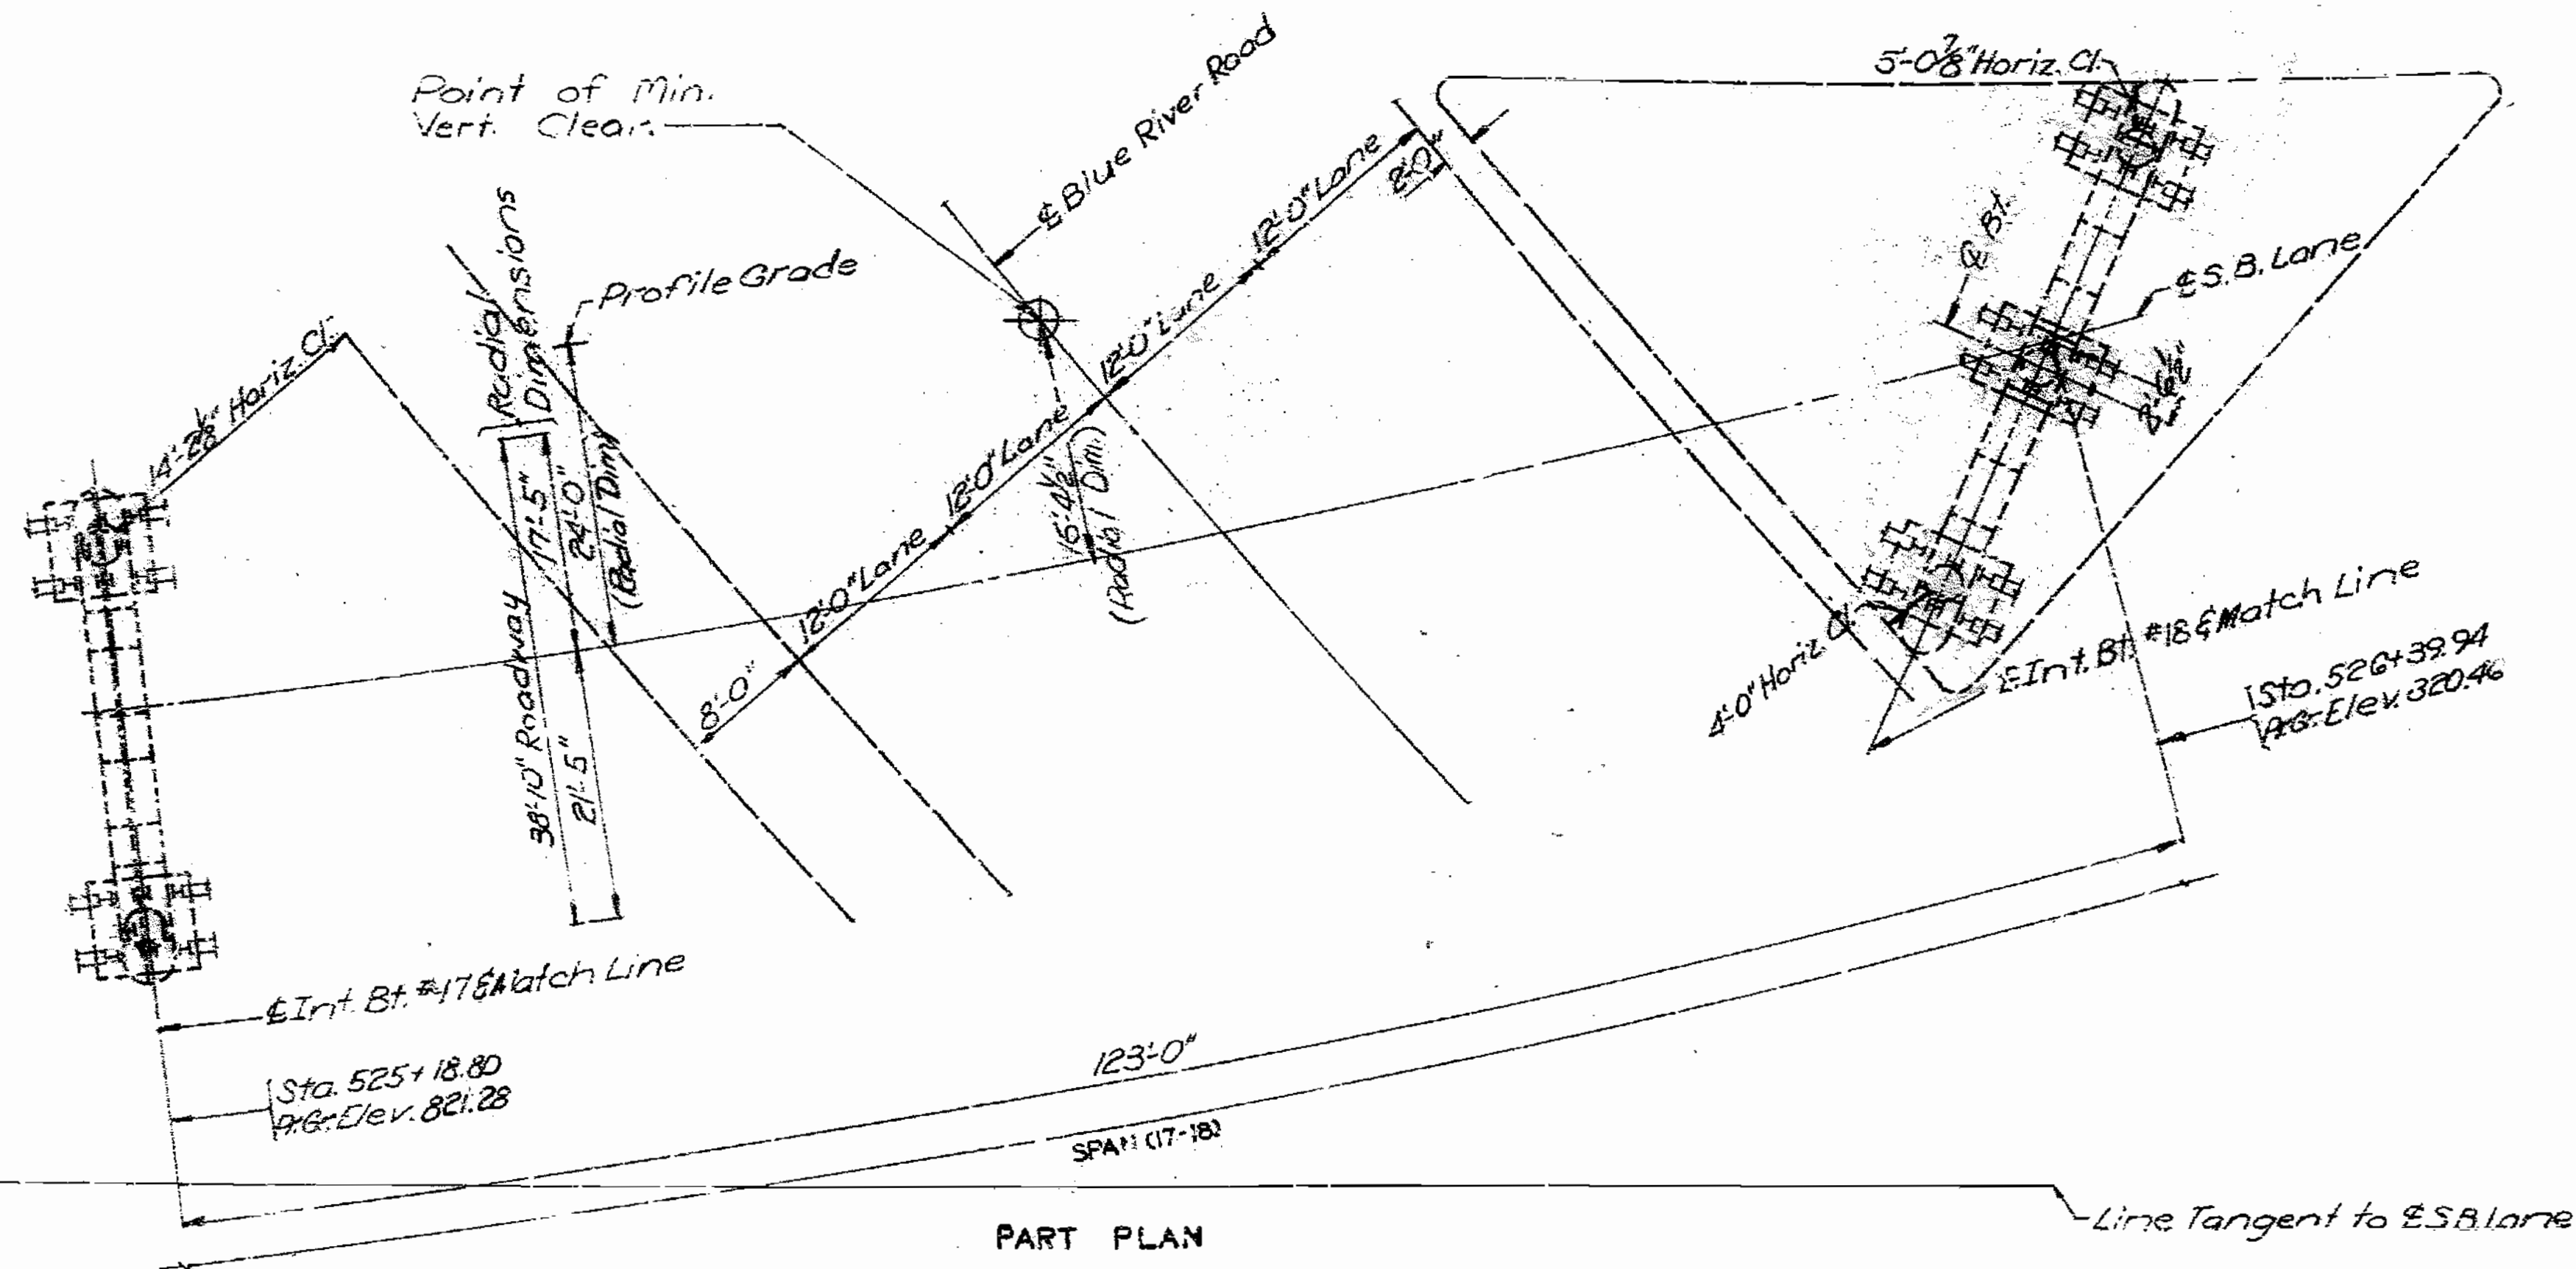

PART PLAN

102

DETAILED Oct. 1988  
CHECKED March 1989

Note: This drawing is not to scale. Follow dimensions.

SEE FINAL PLANS  
Sheet No. 7 of 98

JACKSON COUNTY

A-2745



STATE	PROJ. NO.	SHEET NO.
MO.		96

ESTIMATED QUANTITIES			
ITEM		SUPERSTR.	TOTAL
( ) SLAB ON STEEL, SEE SPECIAL PROVISIONS	SQ. YD.	1559	1559
( ) SLAB ON CONCRETE I-GIRDER, SEE SPECIAL PROVISIONS	SQ. YD.	5741	5741
SAFETY BARRIER C/PB	LIN. FT.	3243	3243
LAMINATED NEOPRENE BEARING PADS	EACH	160	160
LAMINATED NEOPRENE BEARING PADS (STEEL STRUCTURE)	EACH	15	15
TYPE N PTFE BEARINGS	EACH	5	5
ELASTOMERIC NEOPRENE EXPANSION JOINT SEAL (3.0 IN.)	LIN. FT.	93	93
ELASTOMERIC NEOPRENE EXPANSION JOINT SEAL (4.0 IN.)	LIN. FT.	156	156
PRESTRESSED CONCRETE I-GIRDER, 64 FT SPAN	EACH	5	5
PRESTRESSED CONCRETE I-GIRDER, 82 FT SPAN	EACH	25	25
PRESTRESSED CONCRETE I-GIRDER, 65 FT SPAN	EACH	15	15
PRESTRESSED CONCRETE I-GIRDER, 67 FT SPAN	EACH	5	5
PRESTRESSED CONCRETE I-GIRDER, 90 FT SPAN	EACH	10	10
PRESTRESSED CONCRETE I-GIRDER, 79 FT SPAN	EACH	10	10
PRESTRESSED CONCRETE I-GIRDER, 85 FT SPAN	EACH	10	10
FABRICATED STRUCTURAL CARBON STEEL (PLATE GIRDERS)	POUND	296,960	296,960
FABRICATED STRUCTURAL LOW ALLOY STEEL (PLATE GIRDERS) A-572	POUND	133,780	133,780
SLAB DRAINS	EACH	95	95
VERTICAL DRAIN AT END BENTS	EACH	2	2
PAINTING (SYSTEM C) GREEN	TON	212.3	212.3

NOTE: THE COST OF FURNISHING, FABRICATING AND INSTALLING NEOPRENE BEARING PADS, COMPLETE-IN-PLACE, WILL BE PAID FOR AT THE CONTRACT UNIT PRICE FOR LAMINATED NEOPRENE BEARING PADS PER EACH.

NOTE: THE PRESTRESSED PANEL QUANTITIES ARE NOT INCLUDED IN THE TABLE OF ESTIMATED QUANTITIES FOR ALTERNATE SLABS.

TYPE OF SLABS	SLAB ON STEEL		SLAB ON CONC. I-GDR.	
	REINF. (LBS.)	CONC. (CU. YD.)	REINF. (LBS.)	CONC. (CU. YD.)
	EPOXY		PLAIN	EPOXY
CAST-IN-PLACE CONVENTIONAL FORMS	100,130	391.7	10,460	356,790
PRECAST PANEL FORMS			10,460	290,490
STAY-IN-PLACE FORMS	100,130	* 395.0		*** 1,363.0

NOTE: THE TABLE OF ESTIMATED QUANTITIES FOR ALTERNATE SLABS REPRESENTS THE QUANTITIES USED BY THE STATE IN PREPARING THE COST ESTIMATE FOR CONCRETE SLABS. VARIATIONS MAY BE ENCOUNTERED IN THESE ESTIMATED QUANTITIES BUT THESE VARIATIONS CANNOT BE USED FOR AN ADJUSTMENT IN THE CONTRACT UNIT PRICE PER SQUARE YARD OF ALTERNATE SLAB USED.

SEE SPECIAL PROVISIONS FOR ALTERNATE METHODS OF FORMING SLABS.

PRECAST PANEL QUANTITIES ARE BASED ON SKEWED END PANELS.

\* DOES NOT INCLUDE CONCRETE REQUIRED TO FILL CORRUGATIONS OF S.I.P. FORMS.

\*\*\* BASED ON MINIMUM TOP FLANGE THICKNESS AND MINIMUM JOINT FILLER THICKNESS.

NOTE: CONCRETE AND REINFORCEMENT IN ESTIMATED QUANTITIES FOR "SLAB ON STEEL" INCLUDES CONCRETE AND REINFORCING IN BACKWALL, ABOVE UPPER CONST. JOINT, AT END BENT NO. 20.

GENERAL NOTES:

DESIGN SPECIFICATIONS: A.A.S.H.T.O.-1983 AND INTERIMS THRU 1988  
LOAD FACTOR DESIGN

DESIGN LOADING: HS20-44  
35#/SQ. FT. FUTURE WEARING SURFACE  
MODIFIED 24,000# TANDEM AXLE  
EARTH 120#/CU. FT., EQUIVALENT FLUID PRESSURE 45#/CU. FT.  
FATIGUE STRESS - CASE II (SPAN 17 THRU 19)

DESIGN UNIT STRESSES:

CLASS B2 CONCRETE (SUPERSTRUCTURE, EXCEPT PRESTRESSED GDERS. AND SAFETY BARRIER CURB) F'c=4,000 PSI  
CLASS B1 CONCRETE (SAFETY BARRIER CURB) F'c=4,000 PSI  
REINFORCING STEEL (GRADE 60) Fy=60,000 PSI  
STRUCTURAL CARBON STEEL Fy=36,000 PSI  
STRUCTURAL STEEL (A.S.T.M. A572) GRADE 50 Fy=50,000 PSI

FABRICATED STEEL CONNECTIONS:

FIELD CONNECTIONS, HIGH STRENGTH BOLTS 3/4"Ø, HOLES 13/16"Ø, EXCEPT AS NOTED.

JOINT FILLER:

ALL JOINT FILLER SHALL MEET THE REQUIREMENTS OF STD. SPEC. 1057.2.4, EXCEPT AS NOTED.

REINFORCING STEEL:

MINIMUM CLEARANCE TO REINFORCING STEEL SHALL BE 1-1/2", UNLESS OTHERWISE SHOWN.

PAINT:

SYSTEM C BY CONTRACTOR IN ACCORDANCE WITH STD. SPEC. 712.12. (COLOR OF THE FINAL FIELD COAT SHALL BE GREEN.)

PRESTRESSED GIRDER STRESSES:

FOR PRESTRESSED GIRDER STRESSES, SEE SHEET NO. 27 THRU 54.

CONSTRUCTION CLEARANCE:

MANCH. TRWAY.: A MINIMUM VERT. CLEARANCE OF 14'-6" FROM CROWN OF EXISTING LANES AND A MINIMUM LATERAL CLEARANCE OF 52'-0" CENTERED ON EXISTING LANES SHALL BE MAINTAINED DURING CONSTRUCTION.

N.B. RTE. 71 DETOUR: A MINIMUM VERT. CLEARANCE OF 14'-6" FROM CROWN OF EXISTING LANES AND A MINIMUM LATERAL CLEARANCE OF 34'-0" CENTERED ON LANES.

BLUE RIVER RD.: A MINIMUM VERT. CLEARANCE OF 14'-6" FROM CROWN OF EXISTING LANES AND A MINIMUM LATERAL CLEARANCE OF 52'-0" CENTERED ON LANES.

NORTH OUTER ROAD: A MINIMUM VERT. CLEARANCE OF 14'-6" FROM CROWN OF EXISTING LANES AND A MINIMUM LATERAL CLEARANCE OF 2'-0" FROM PAVY. EDGE (EACH SIDE).

BURLINGTON NORTHERN R.R. MINIMUM LATERAL CLEARANCE OF 12'-0" FROM TRACKS, SHALL BE IN ACCORDANCE WITH THE R.R. CONTRACT.

NEOPRENE PADS:

LAMINATED NEOPRENE BEARINGS SHALL BE 6J DUROMETER NEOPRENE PADS.


NOTE:

OUTLINE OF OLD WORK IS INDICATED BY LIGHT DASHED LINES.  
HEAVY LINES INDICATE NEW WORK.

137104


STATE	PROJ NO	SHEET NO
MO.		90

Note: For details of Laminated Neoprene Brg. Pad, see sheet No. 17.

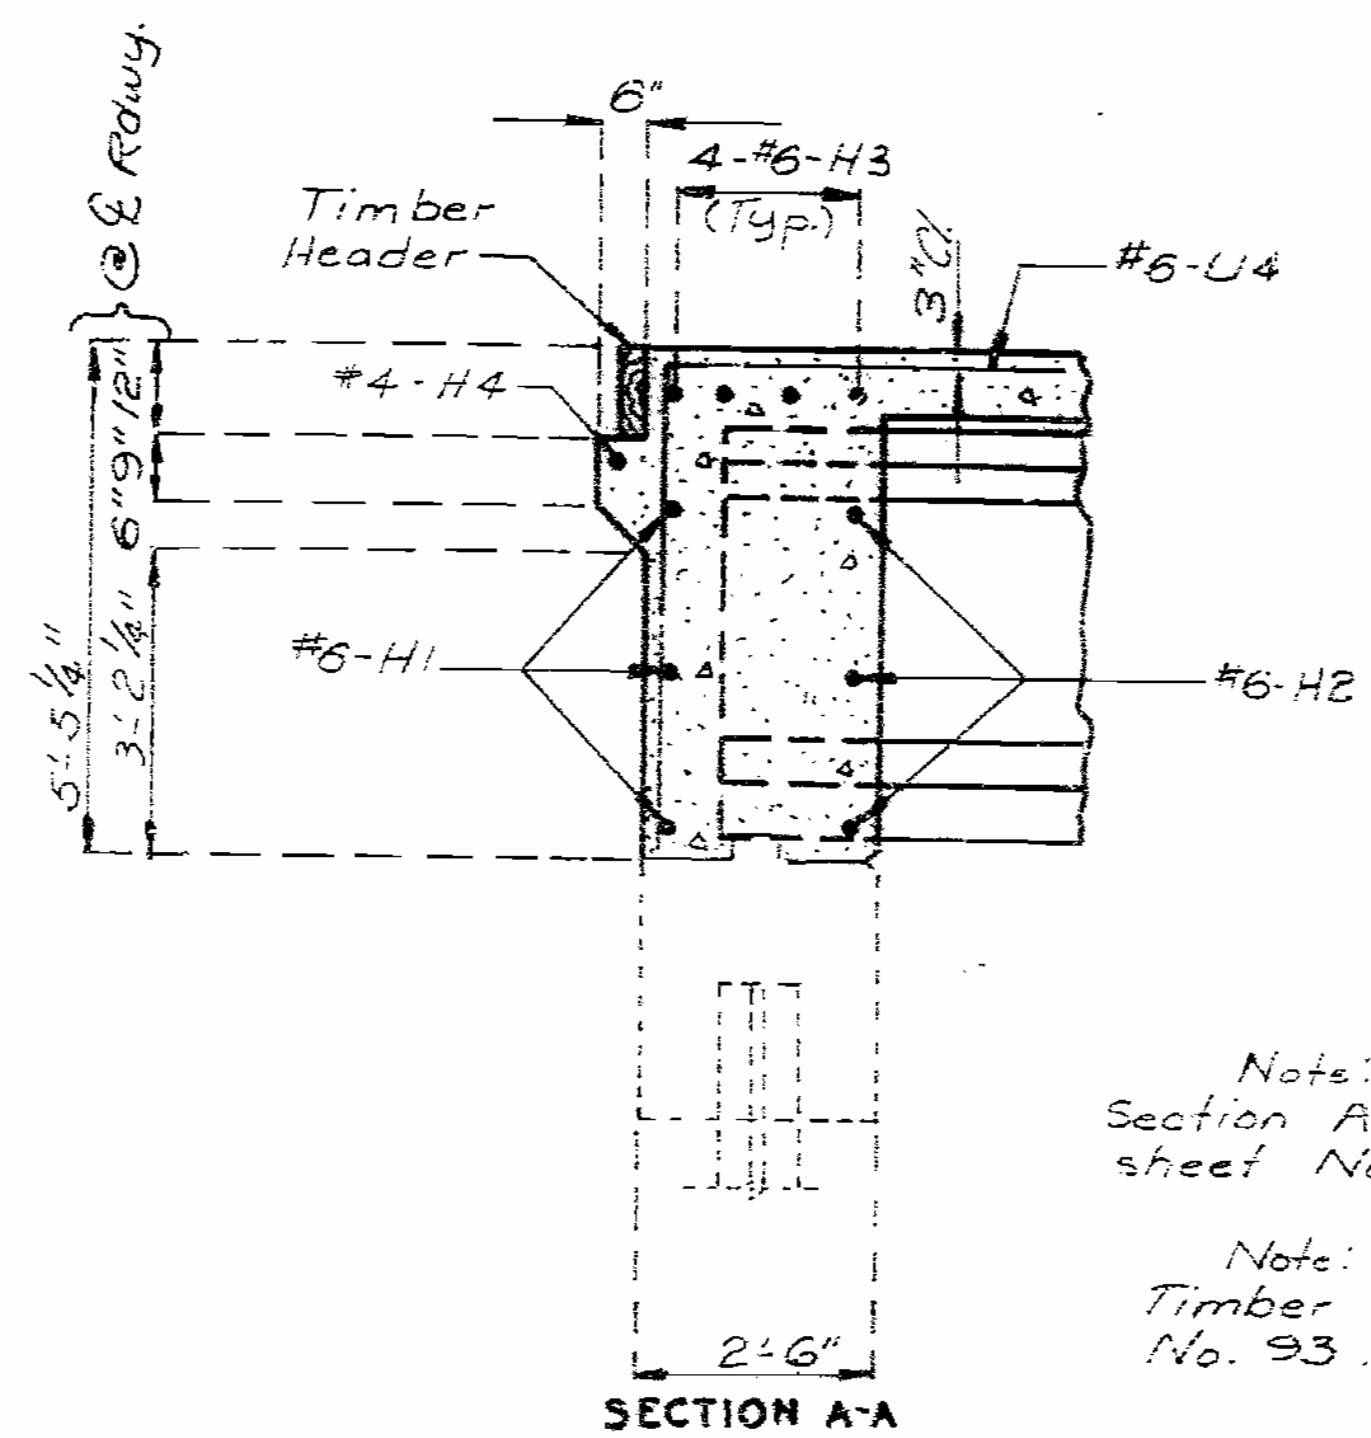


Note: For location of Section A-A, B-B & C-C see sheet No. 11.  
 Note: For detail of Timber Header see sheet No. 93.


SECTION A-A

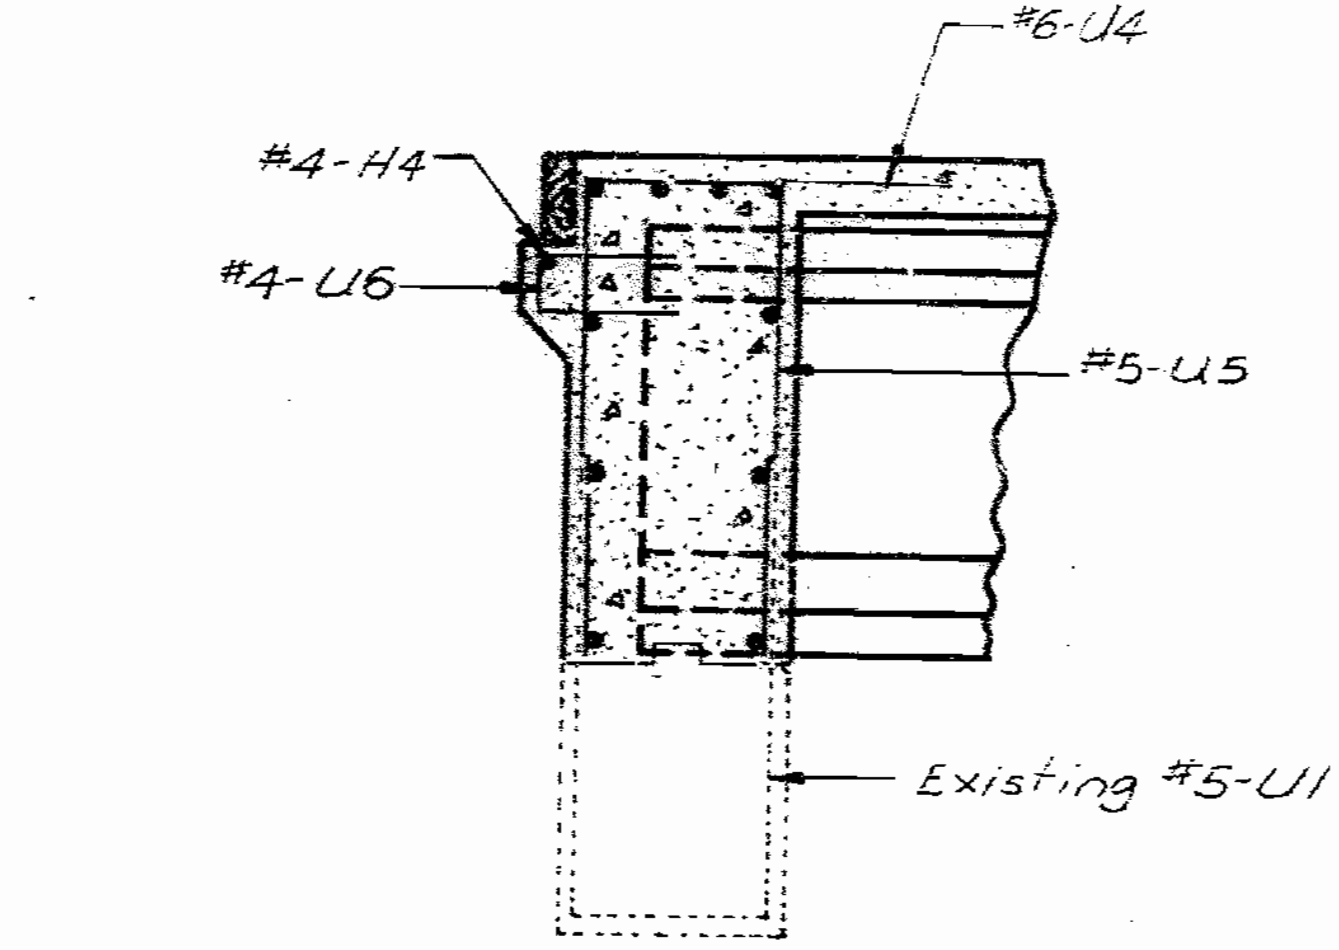

SECTION B-B

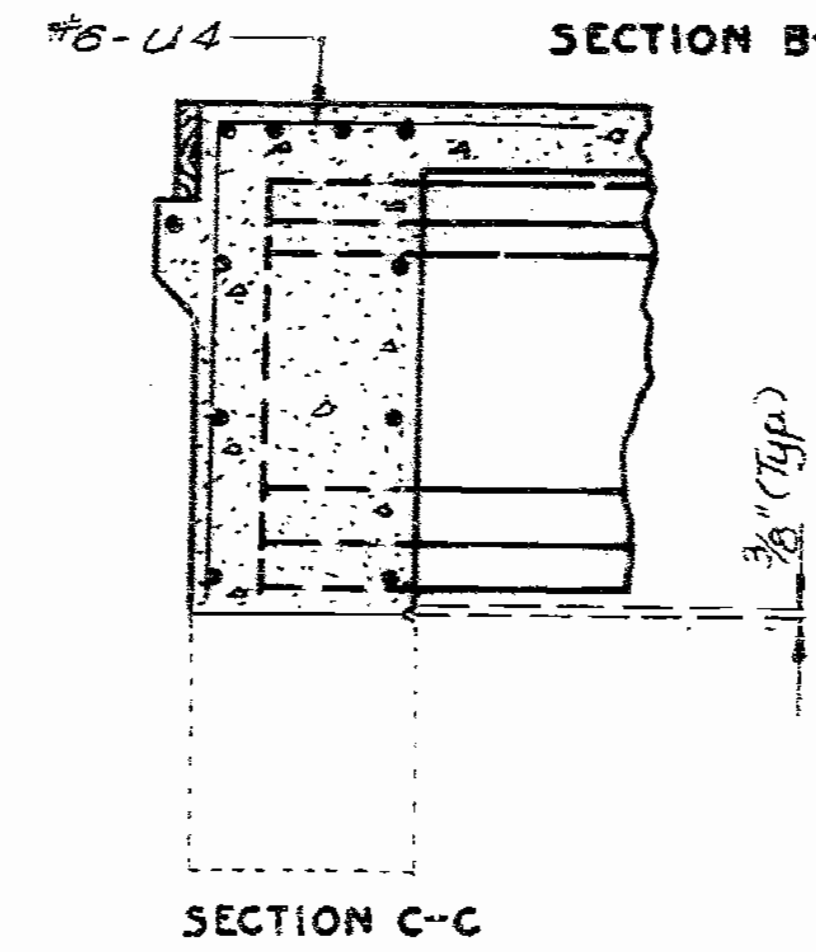

SECTION C-C

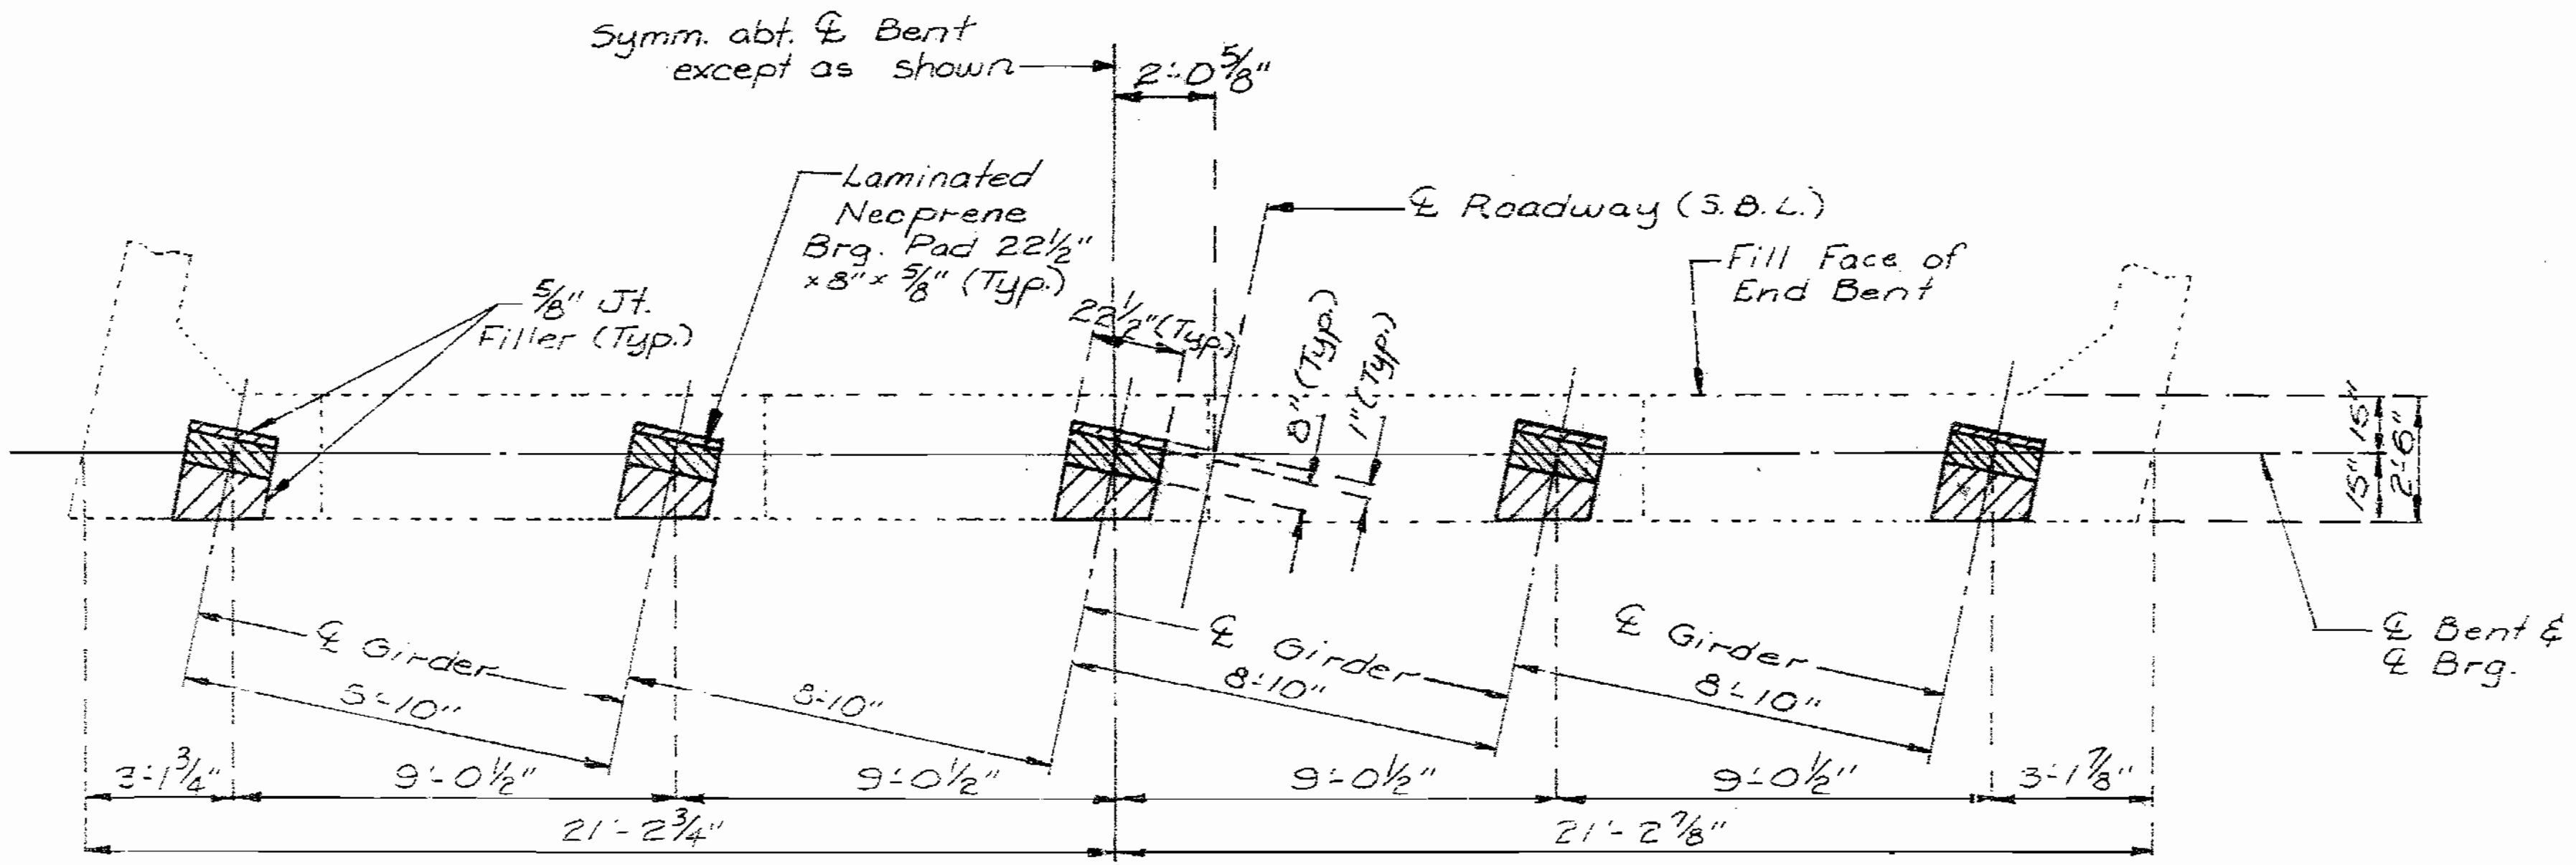

PLAN OF BEAM  
(BELOW LOWER CONST. JT.)

DETAILS OF END BENT NO. 1

Note: This drawing is not to scale. Follow dimensions.

Sheet No. 10 of 98

JACKSON


COUNTY

A-2745


105

DETAILED March 1988  
 CHECKED Feb. 1989

STATE	PROJ. NO.	SHEET NO.
MO		91

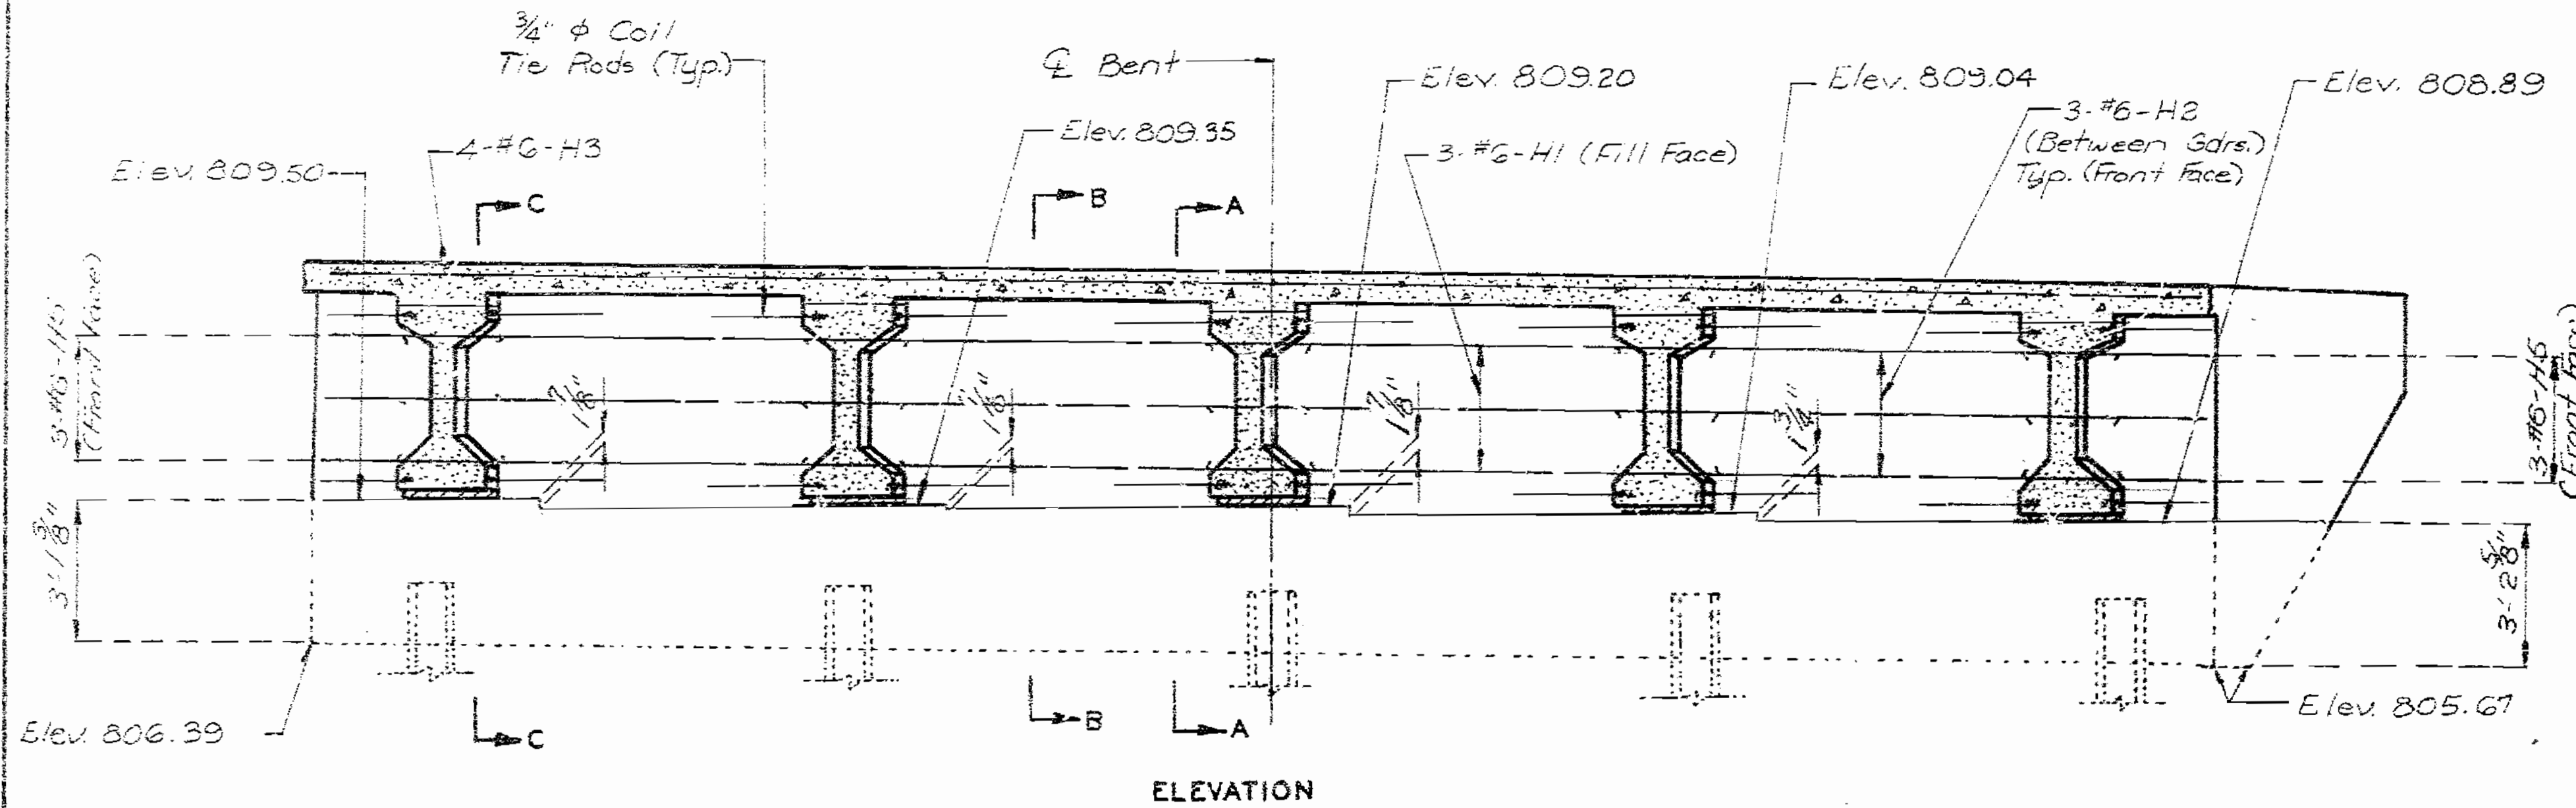

Note: For details of Section A-A, B-B & C-C, see sheet No. 10.  
For location of Elevation F-F, see sheet No. 12.

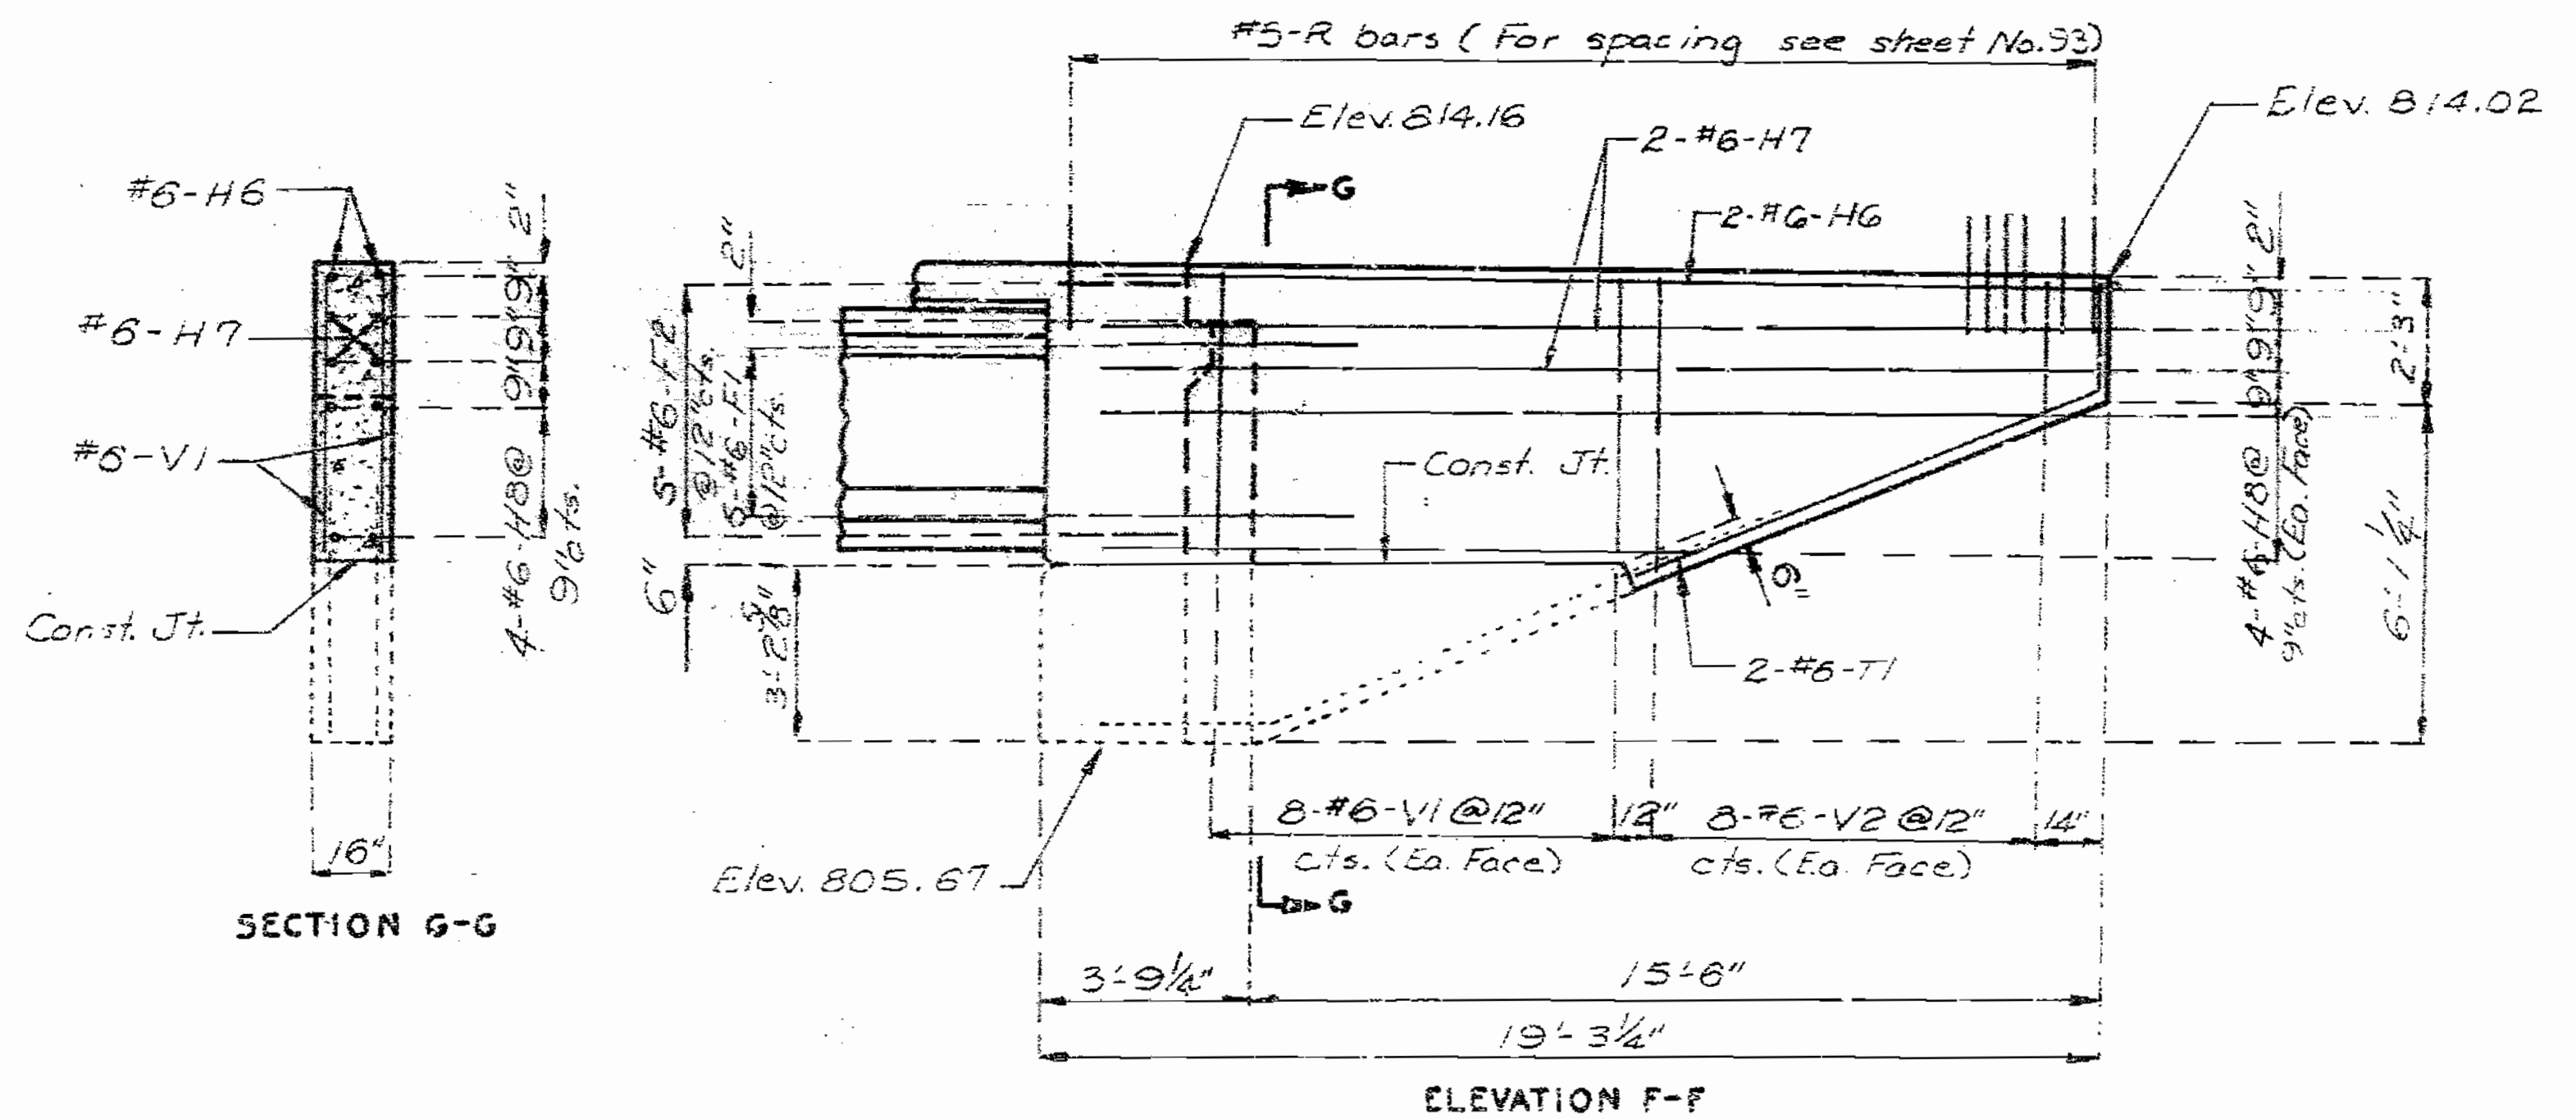

DETAILS OF END BENT NO. 1

133 106

DETAILED Sept 1988  
CHECKED Feb. 1989



Note: This drawing is not to scale. Follow dimensions.

Sheet No. 11 of 98


JACKSON COUNTY

A-2745

STATE	PROJ. NO.	SHEET NO.
MO		92

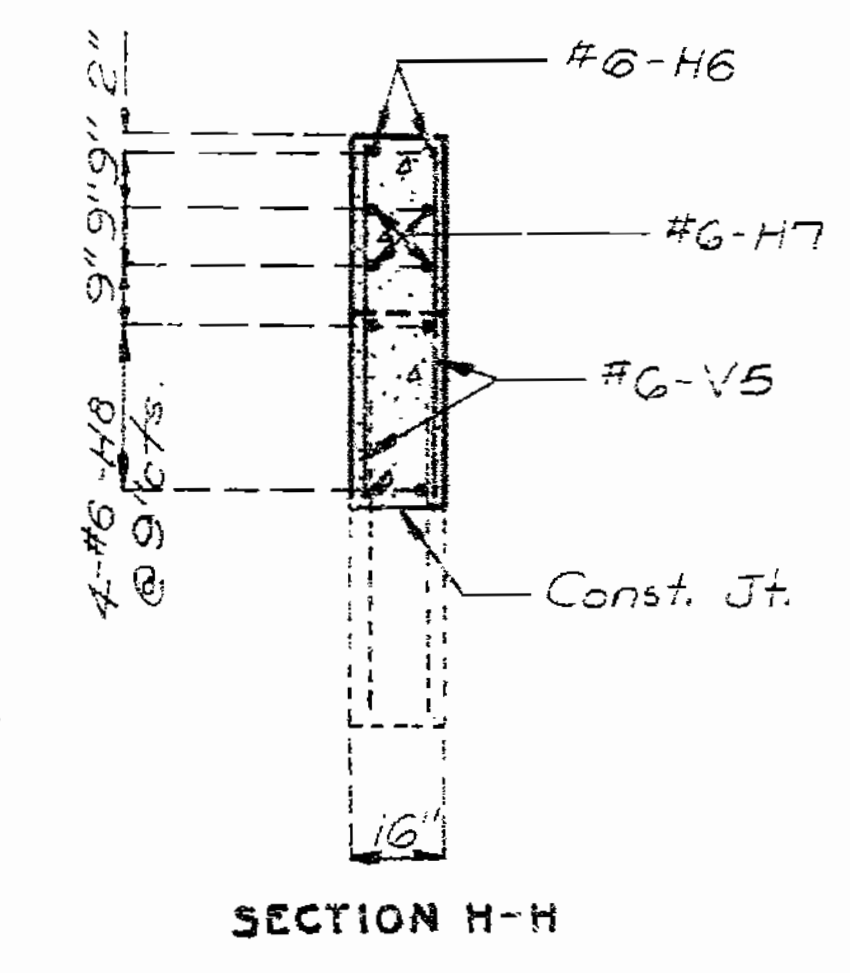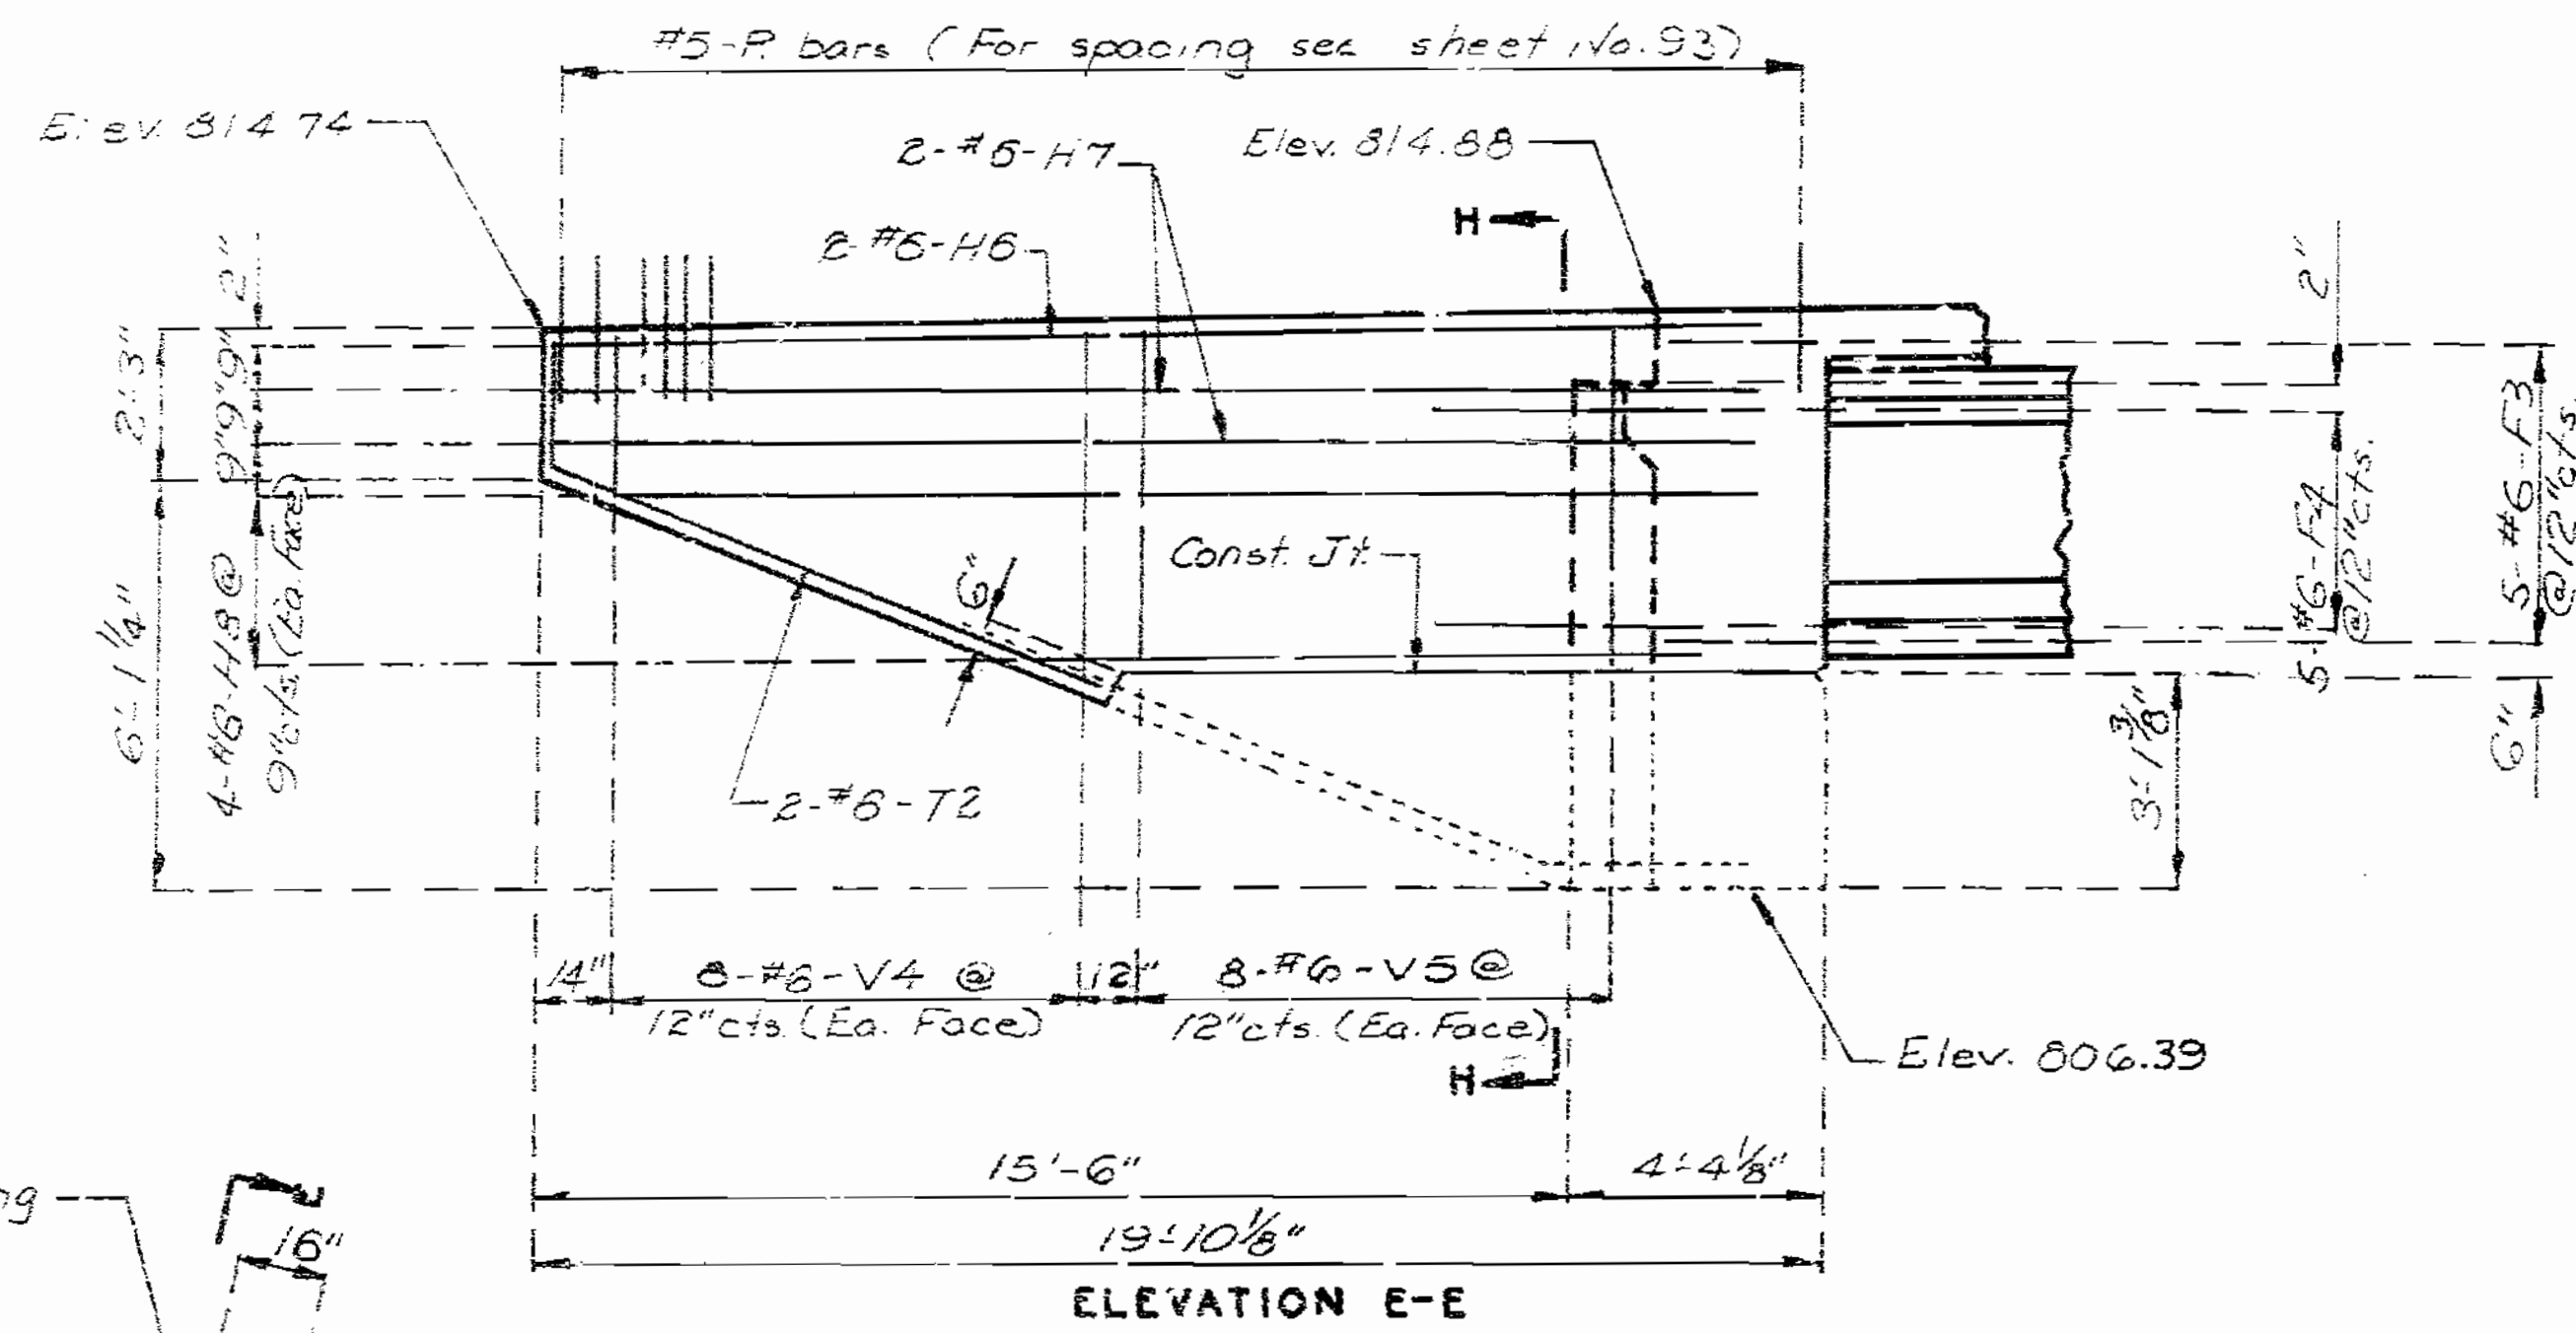

134107

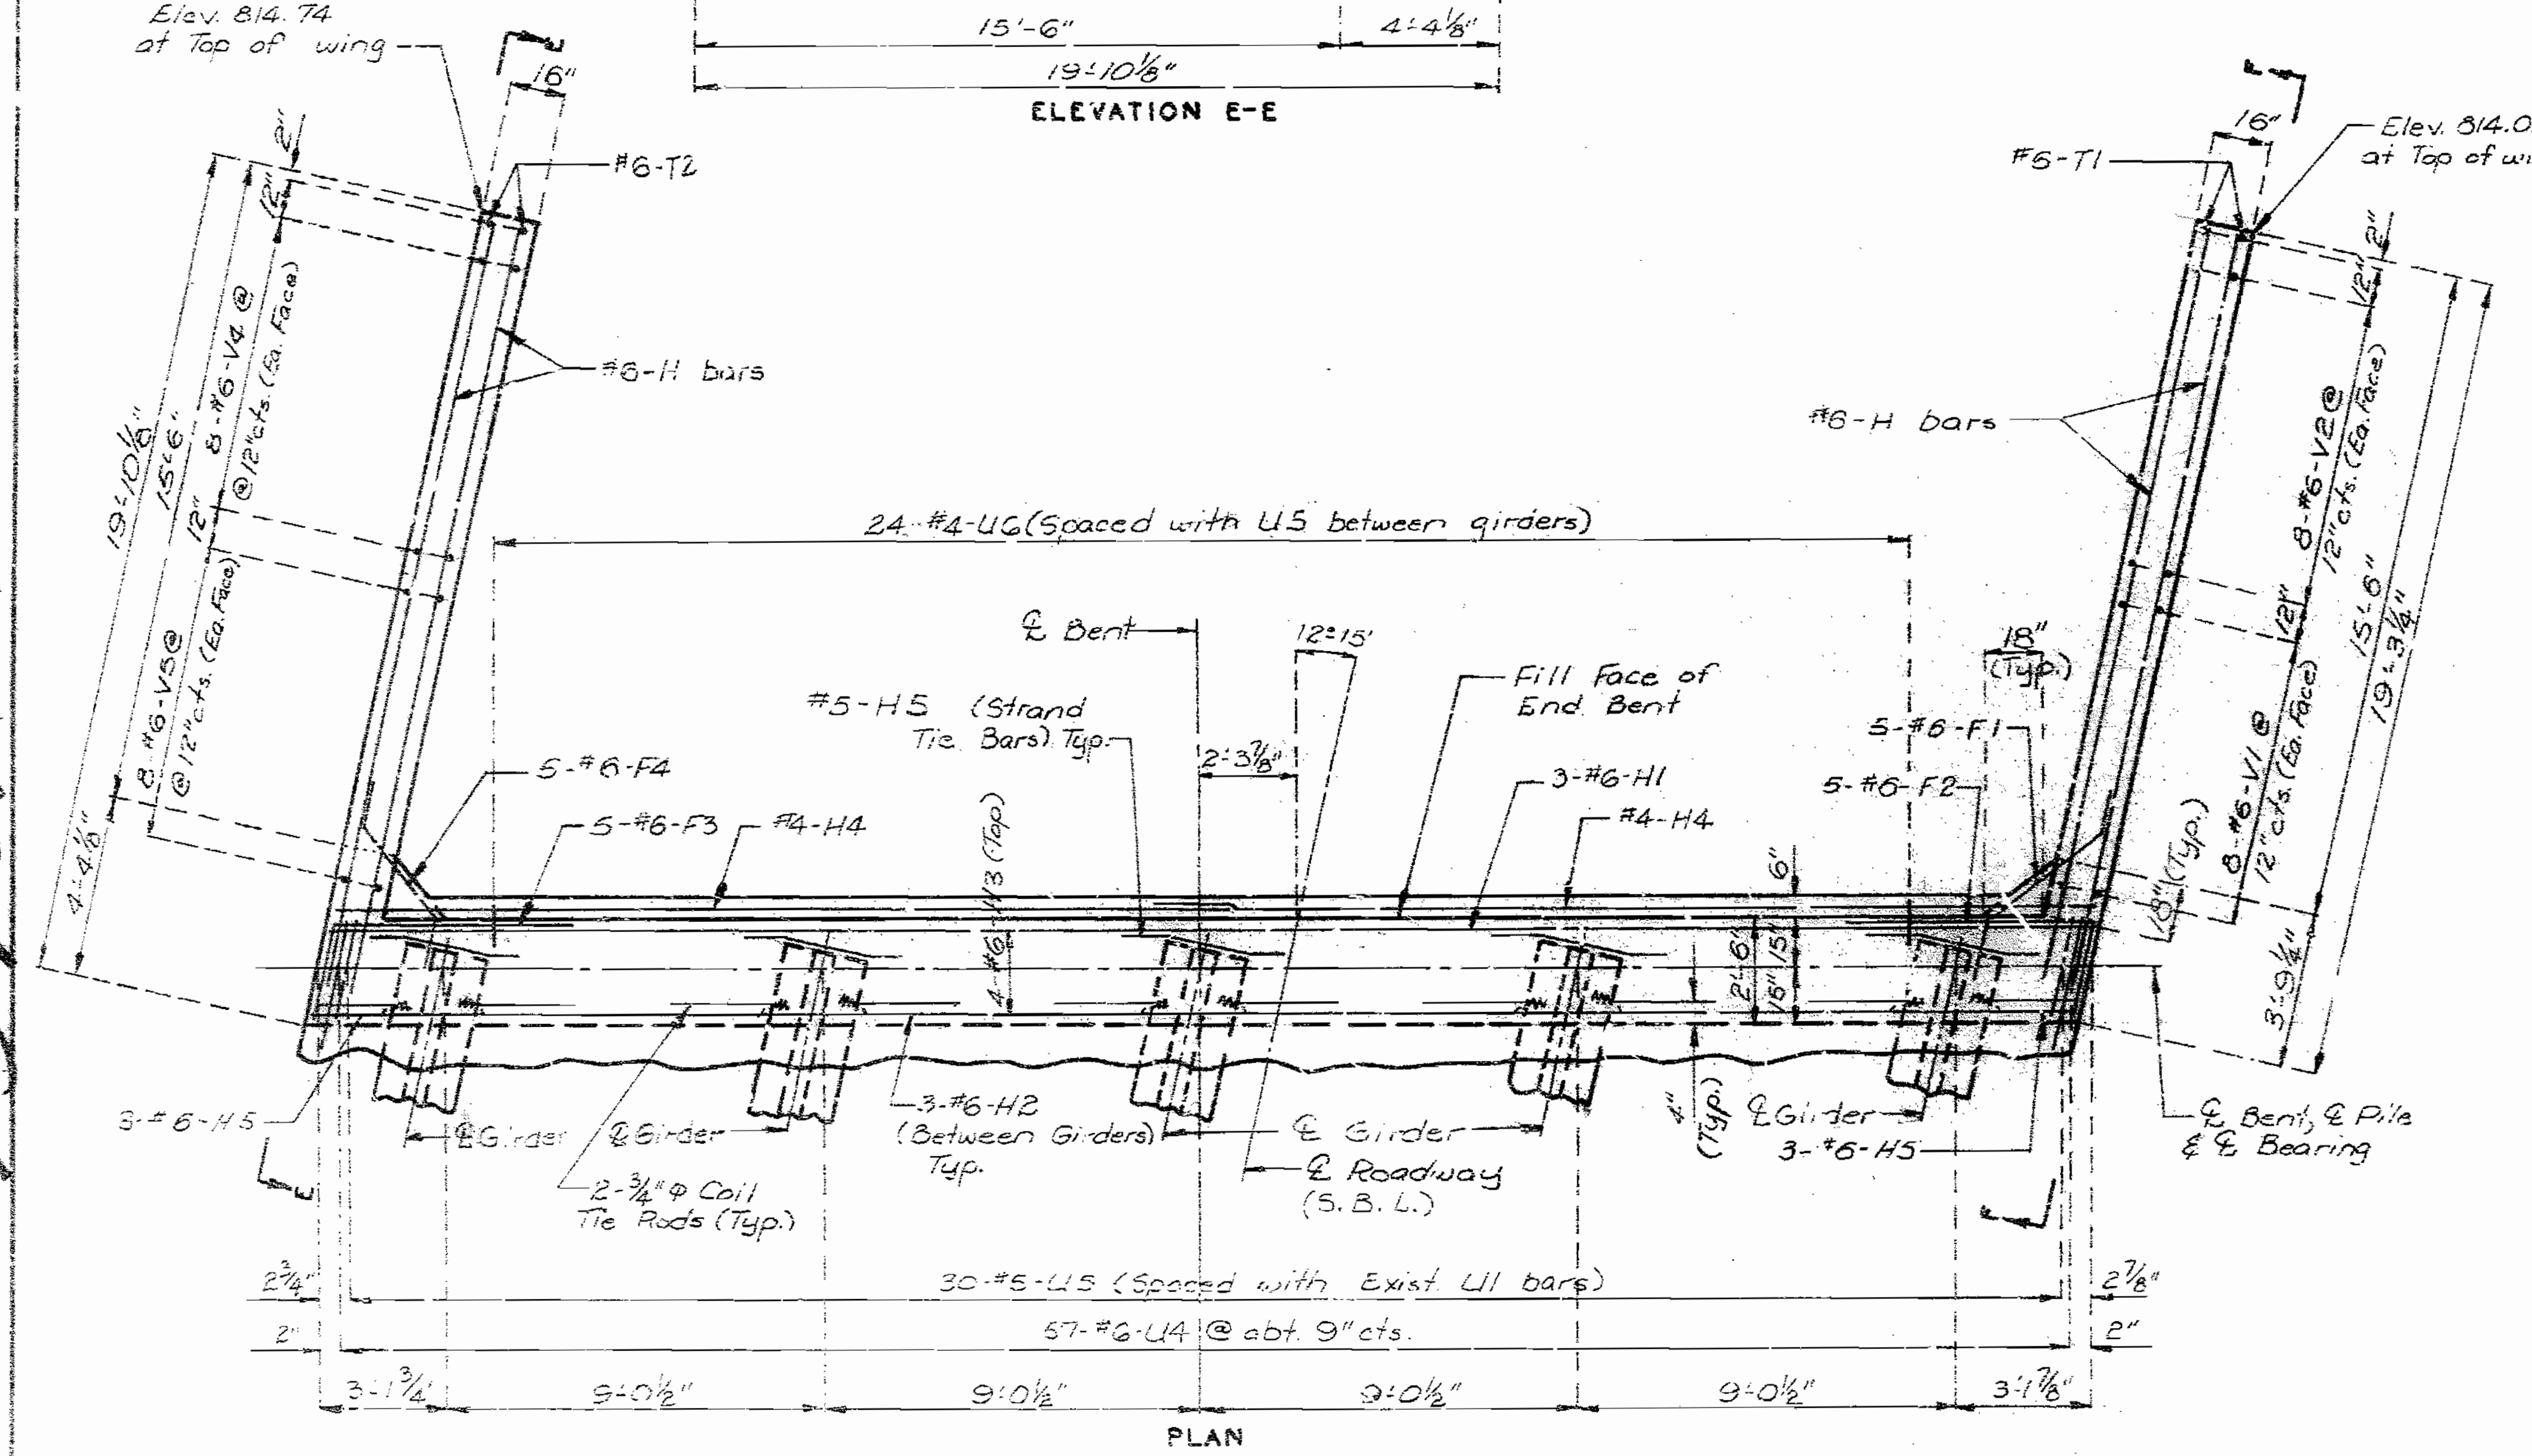

Note: Bend F1 & F4 bars in field to clear girders.  
 For details of Safety Barrier Curb see sheet No. 93.  
 All concrete in the End Bent above top of beam and below top of slab shall be Class B2.  
 Strands at end of girders shall be field bent or, if necessary, cut in field to maintain 1/2" minimum clearance to Fill Face of End Bent.  
 Field bending shall be required for F1 & F4 bars when necessary to conform to slope of wing.


DETAILED Sept 1968  
 CHECKED Feb 1989

Note: This drawing is not to scale. Follow dimensions.

DETAILS OF END BENT NO. 1  
 Sheet No. 12 of 33

JACKSON COUNTY A-2745


STATE	PROJ NO	SHEET NO
MC		33

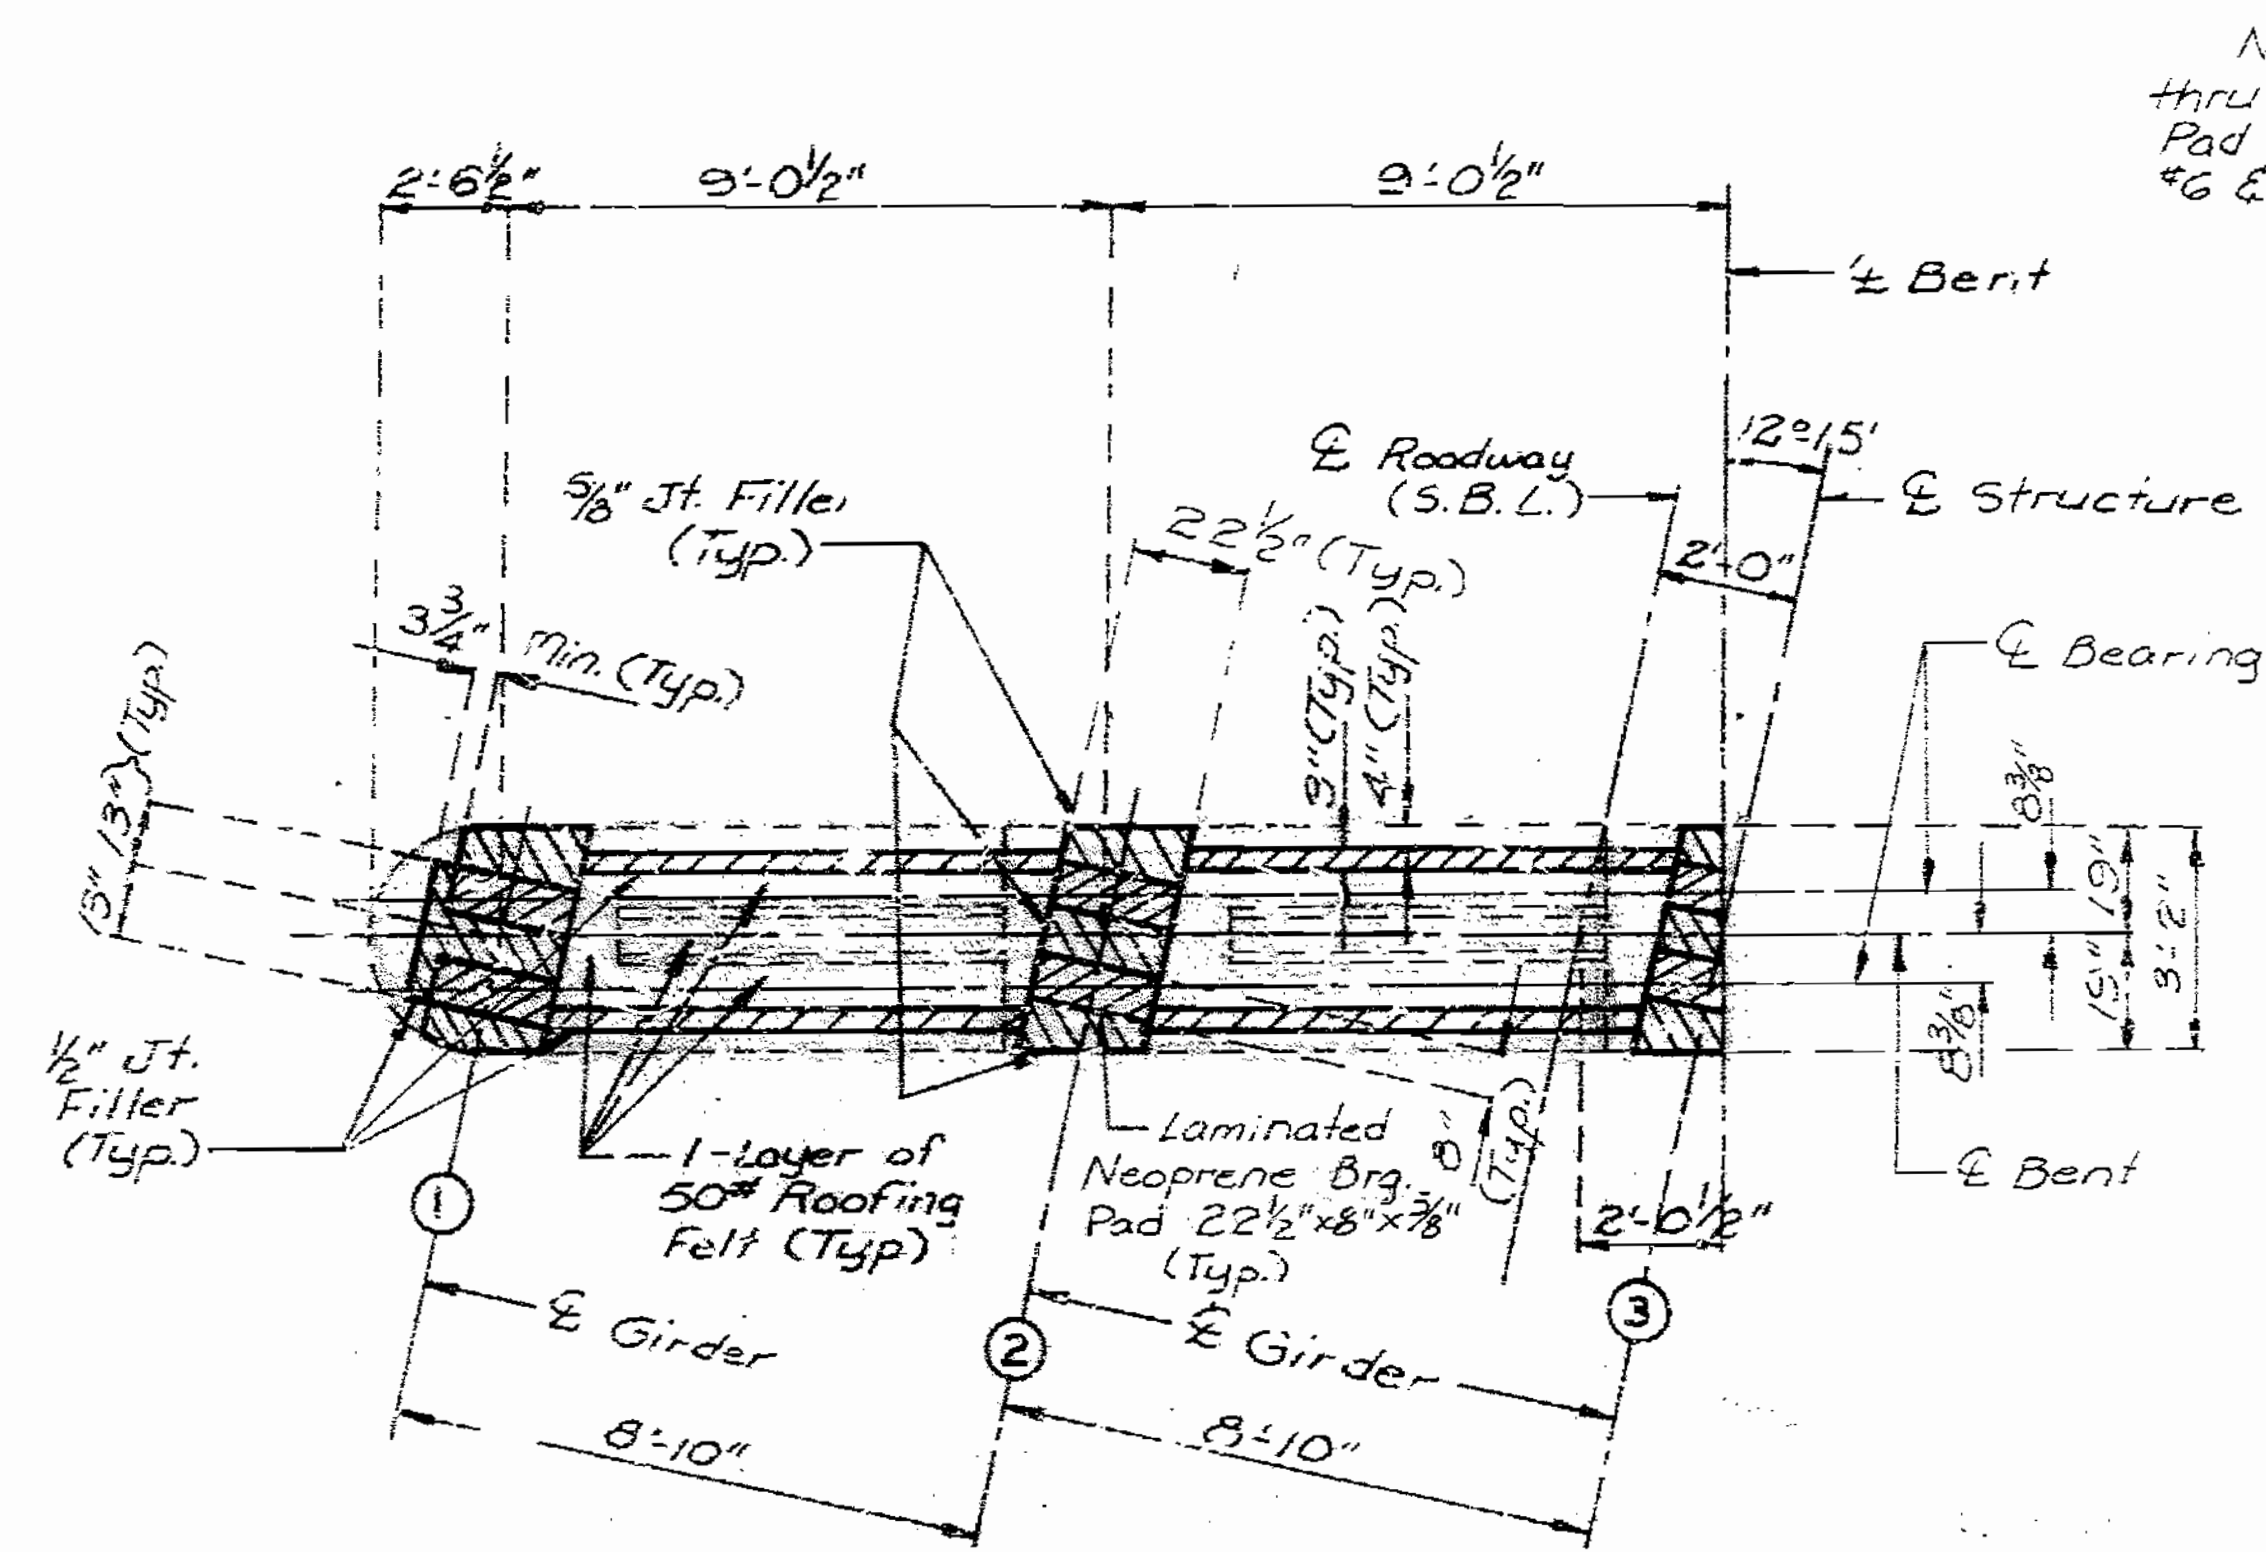


INT. BT. NO. 283

Note: For typical section thru Laminated Neoprene Brg Pad at Int. Bts. #2, #3, #5, #6 & #7, see sheet No. 17.


Note: For details of Bearings at Int. Bt. #4, see sheet No. 21.

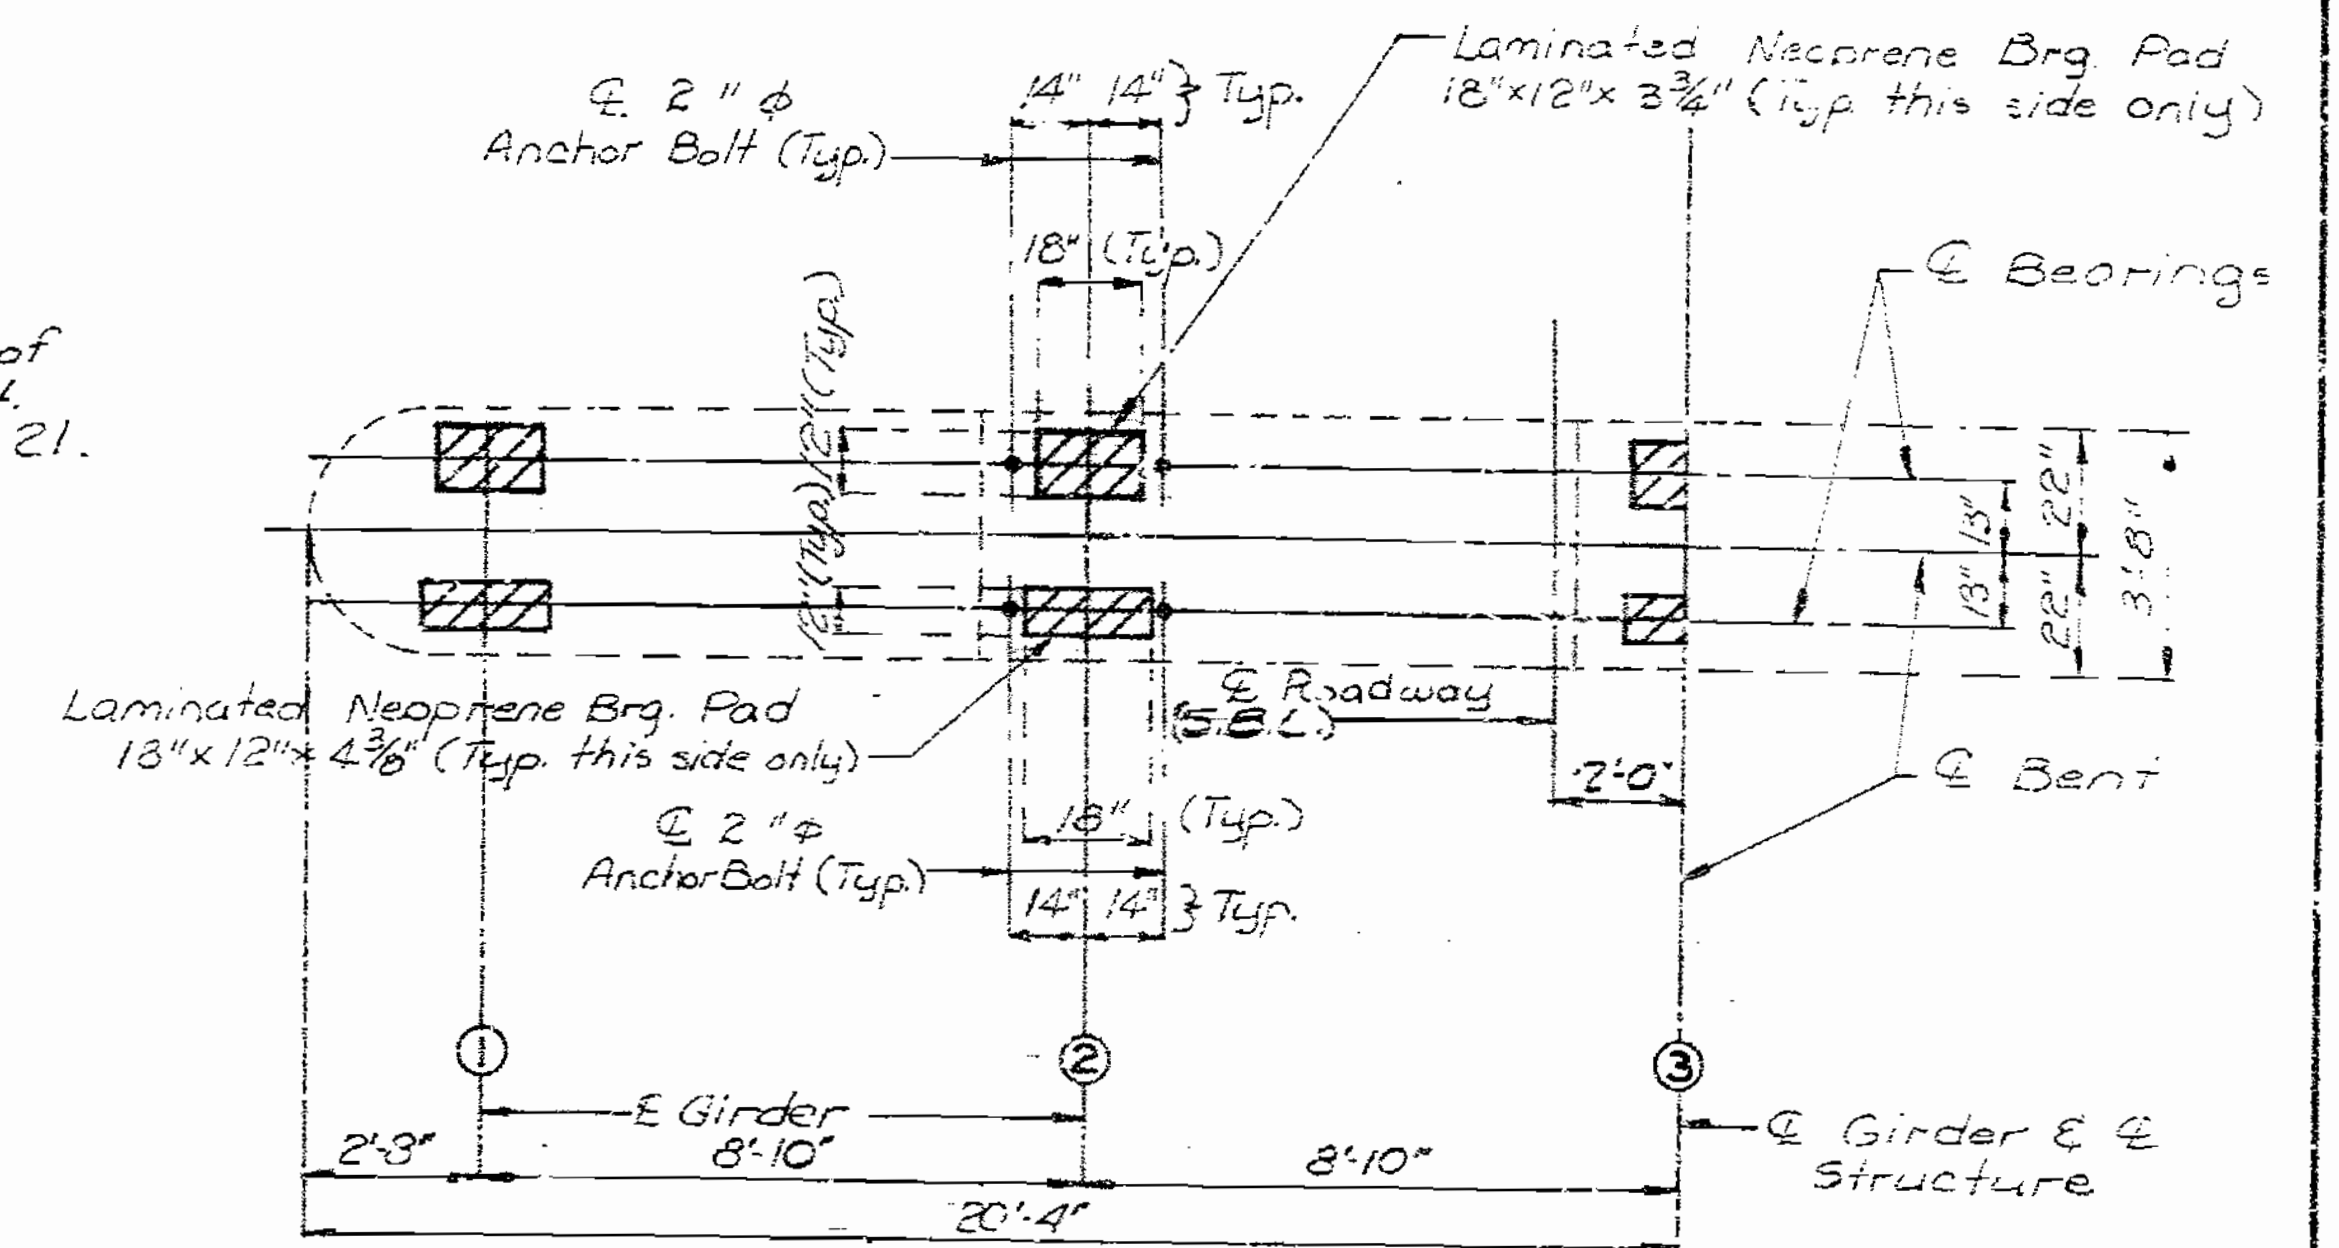

INT. BT. NO. 4

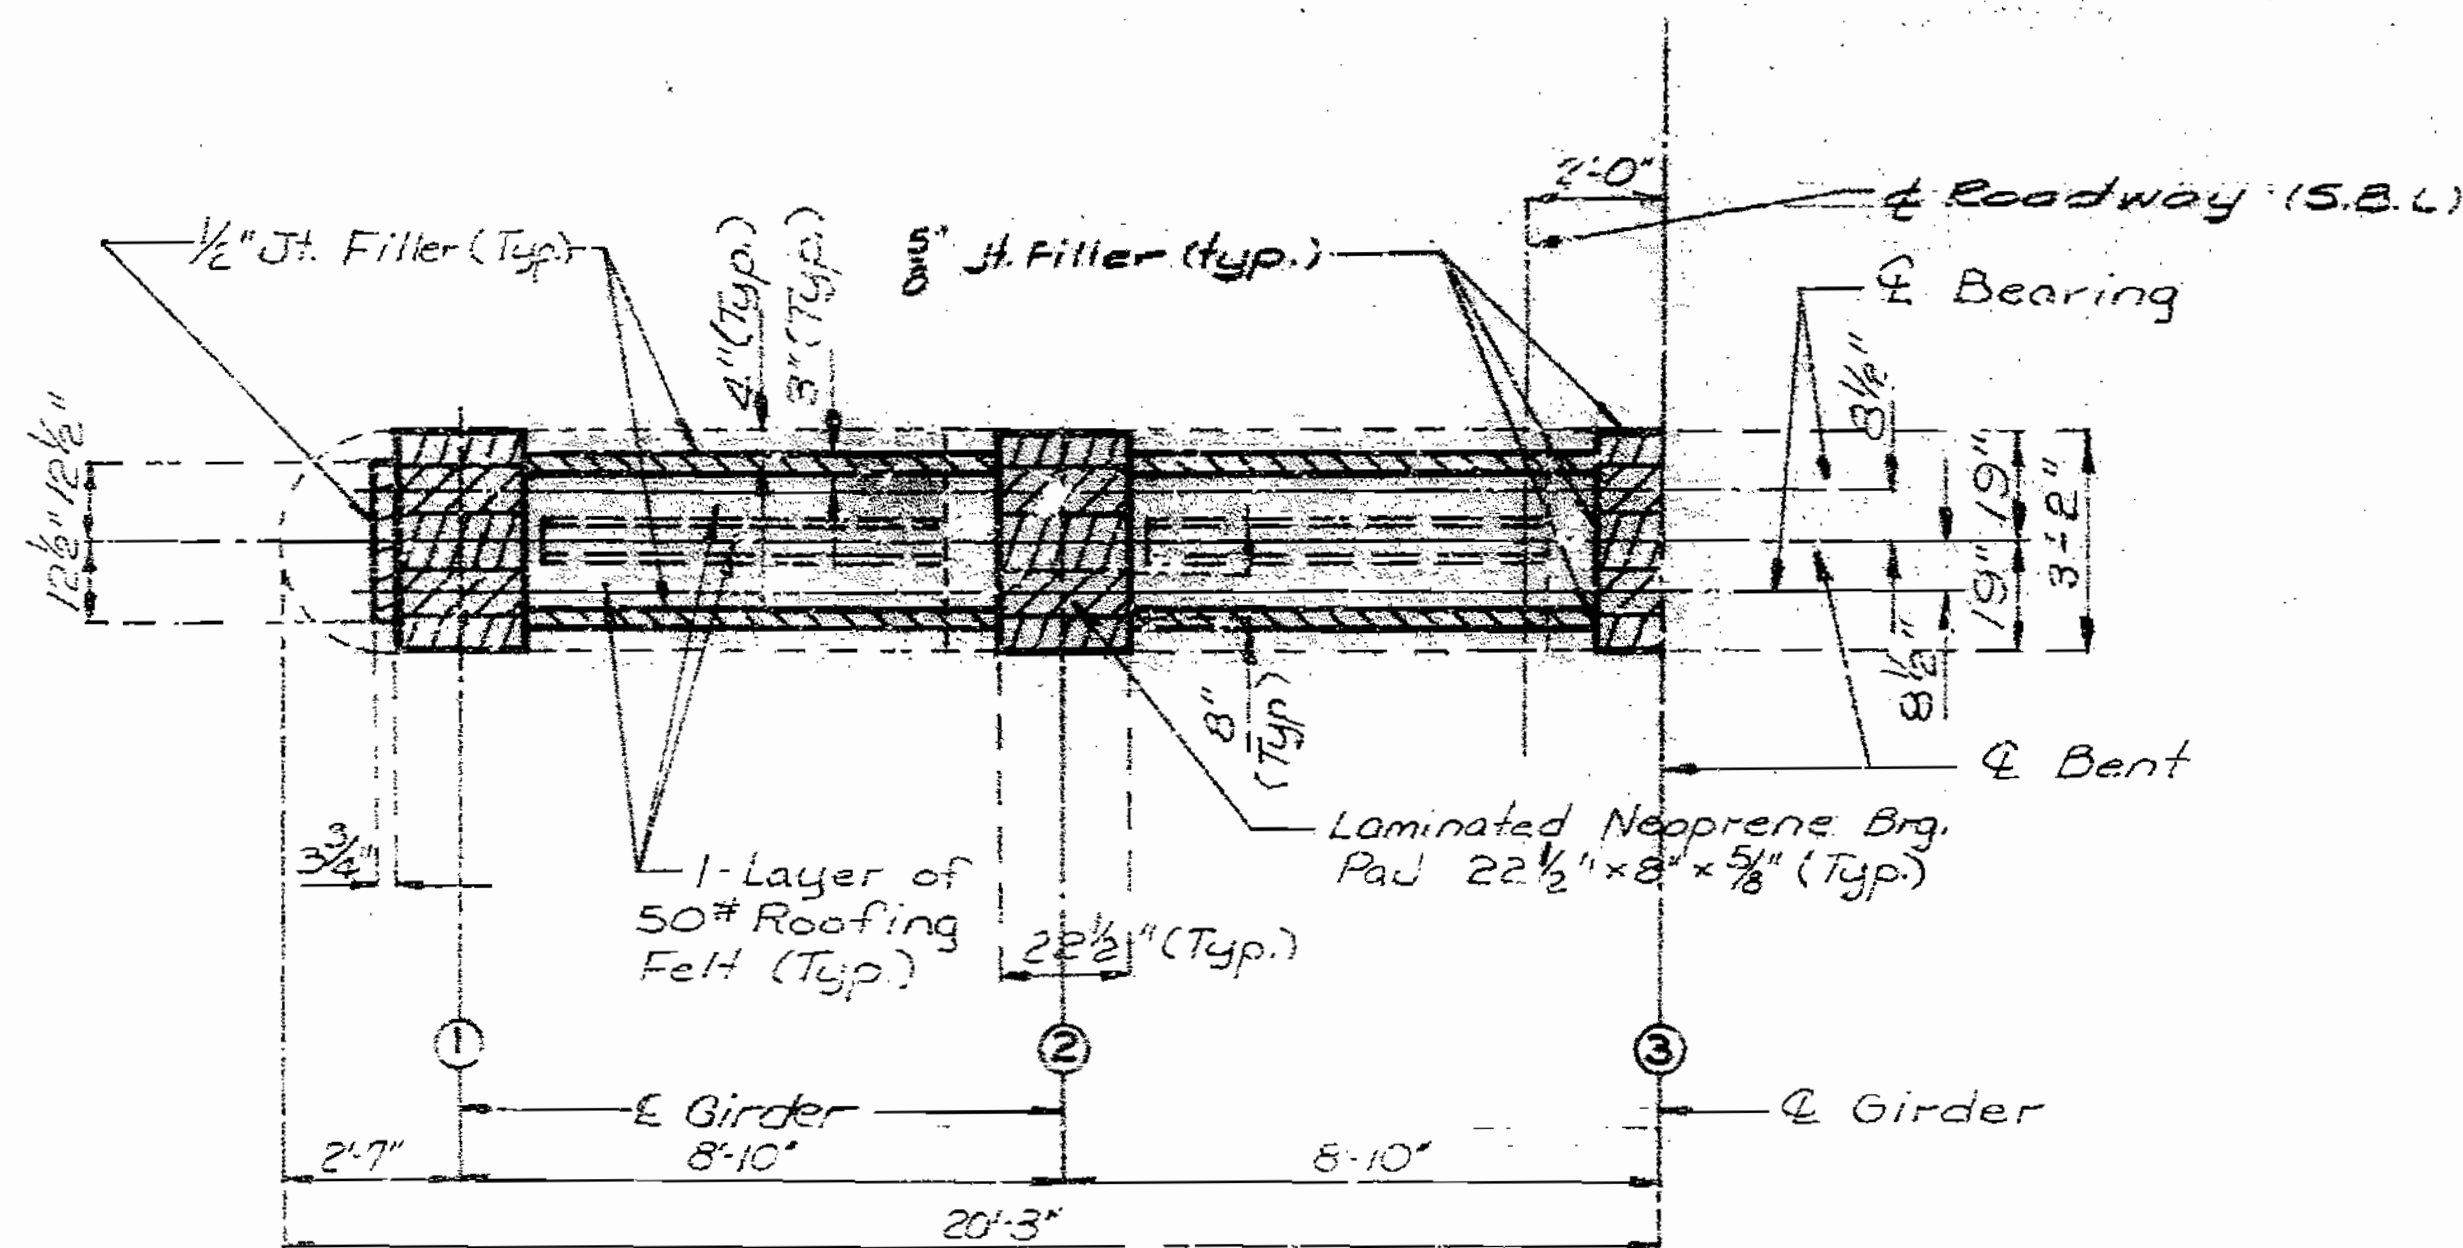

INT. BT. NO. 5

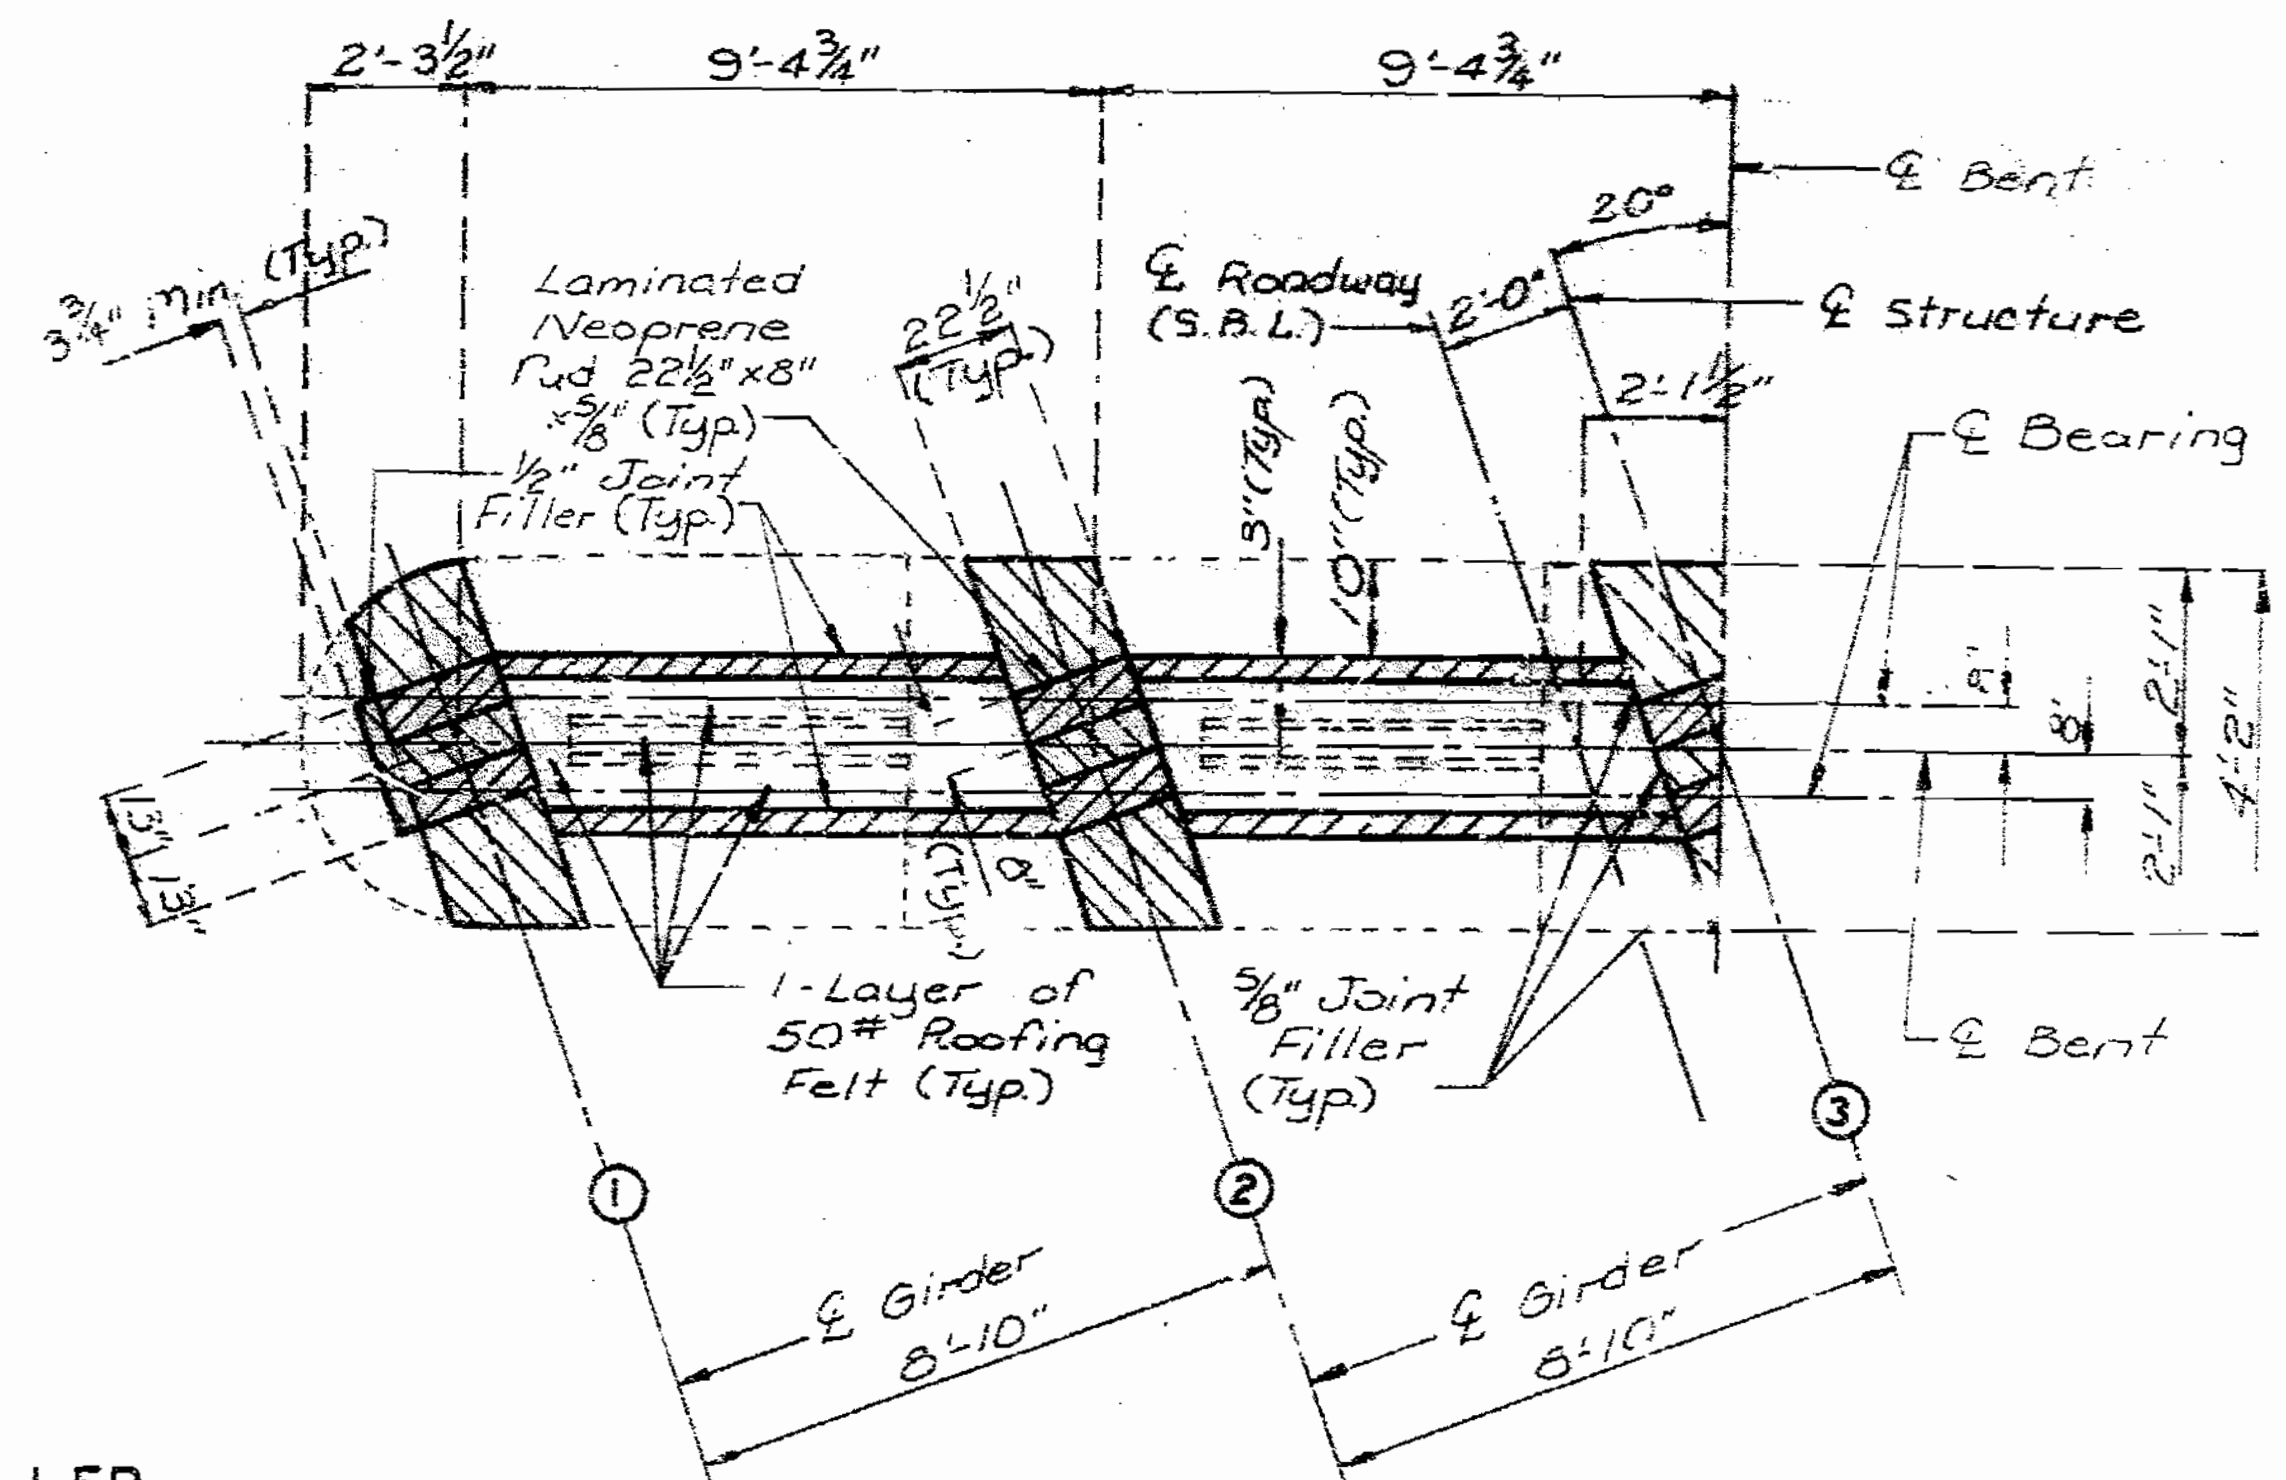


INT. BT. NO. 687

PART PLAN OF BEAM SHOWING BEARINGS, ROOFING FELT & JT. FILLER


135-100



STATE	PROJ. NO.	SHEET NO.
MO		34

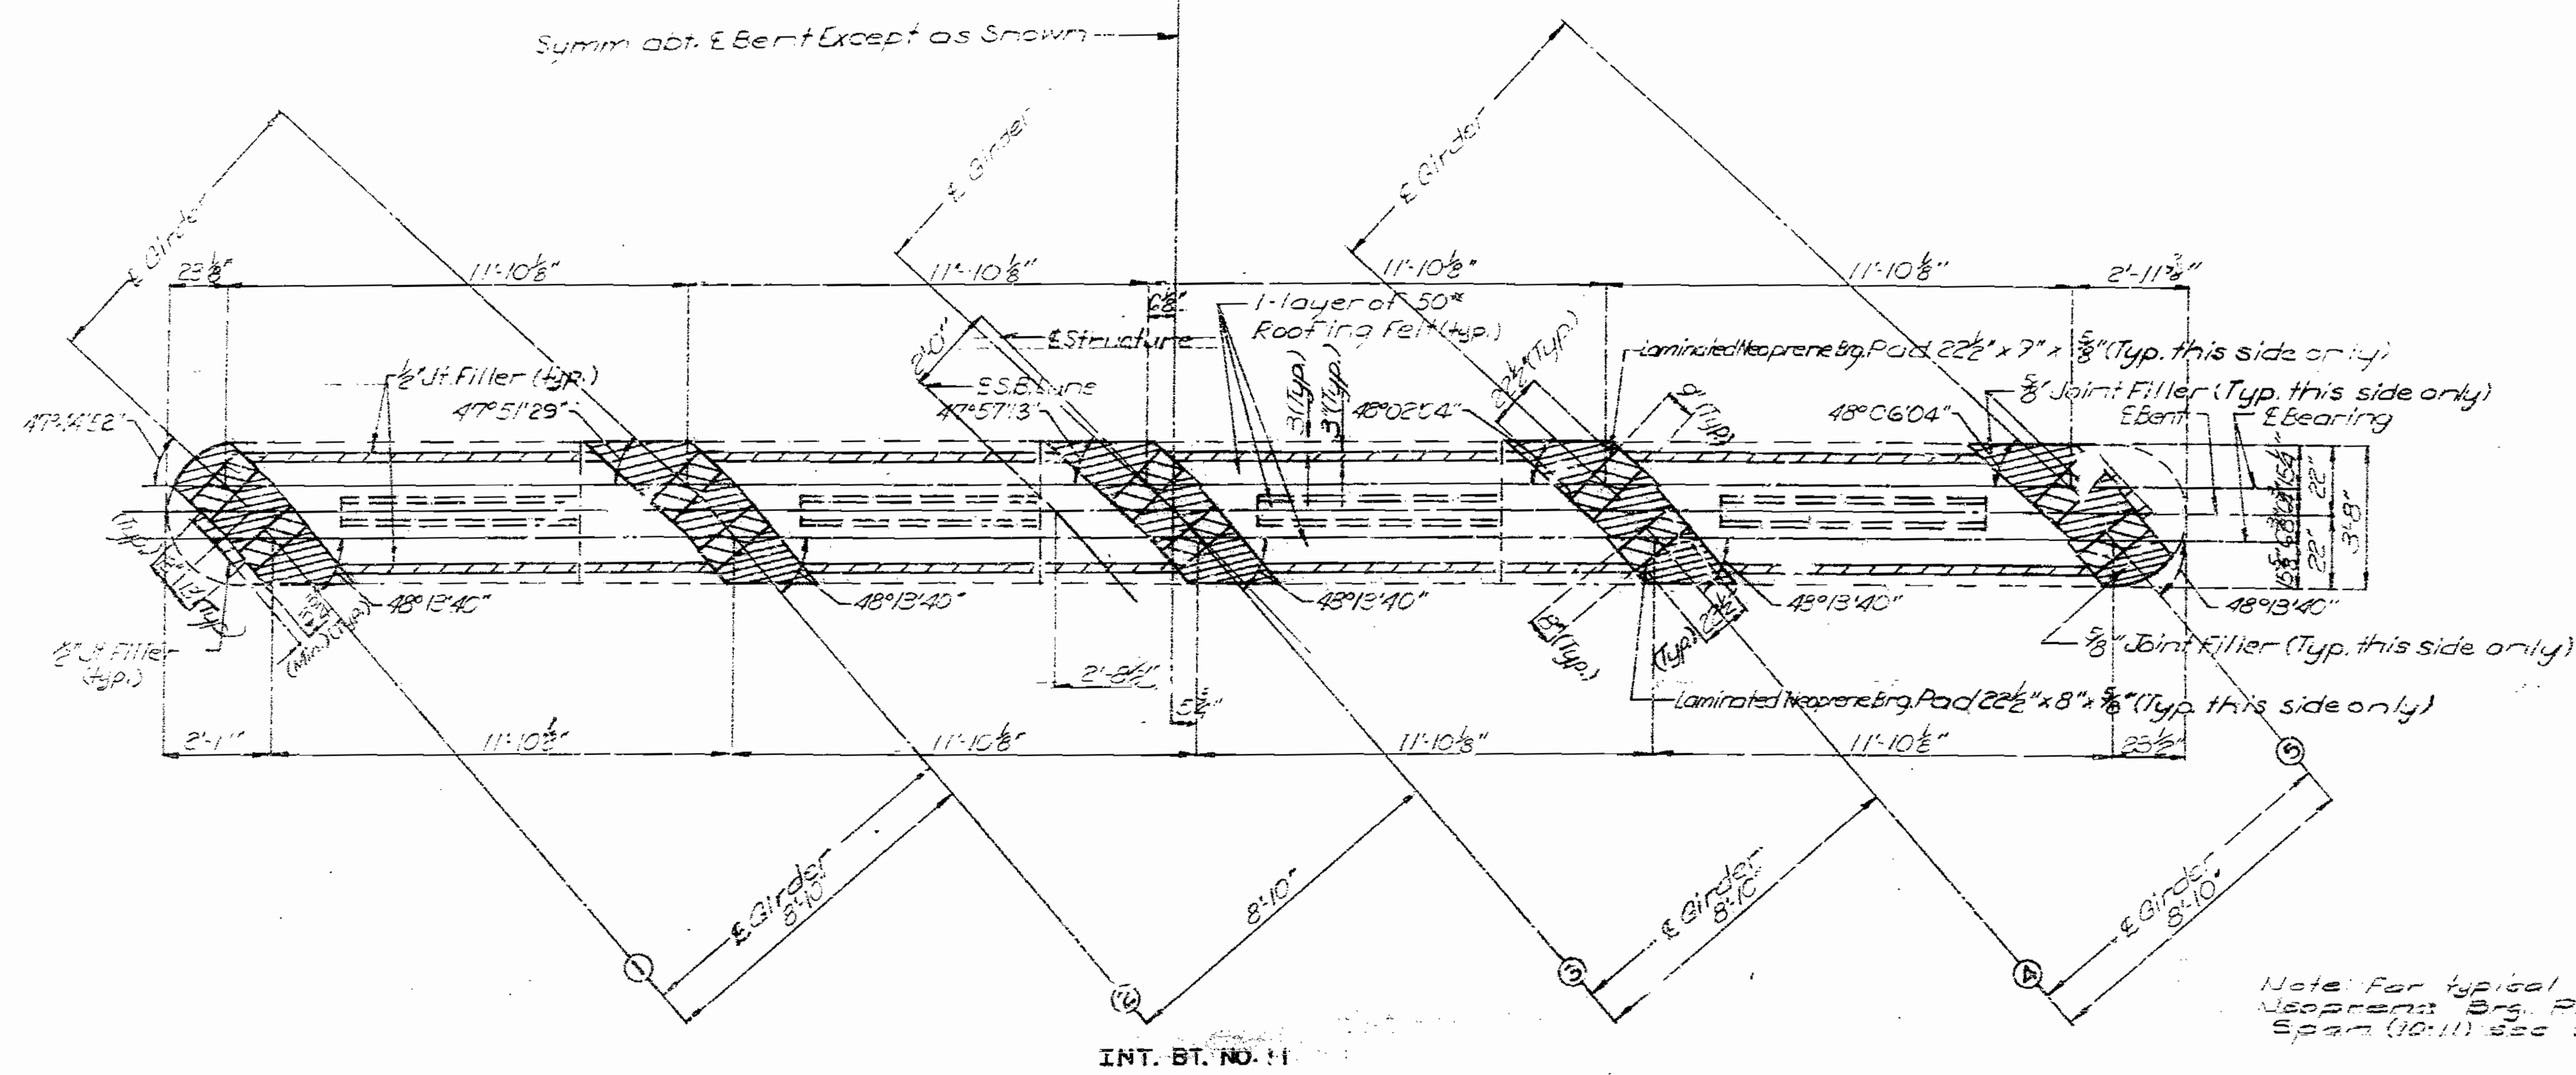

INT. BT. NO. 11

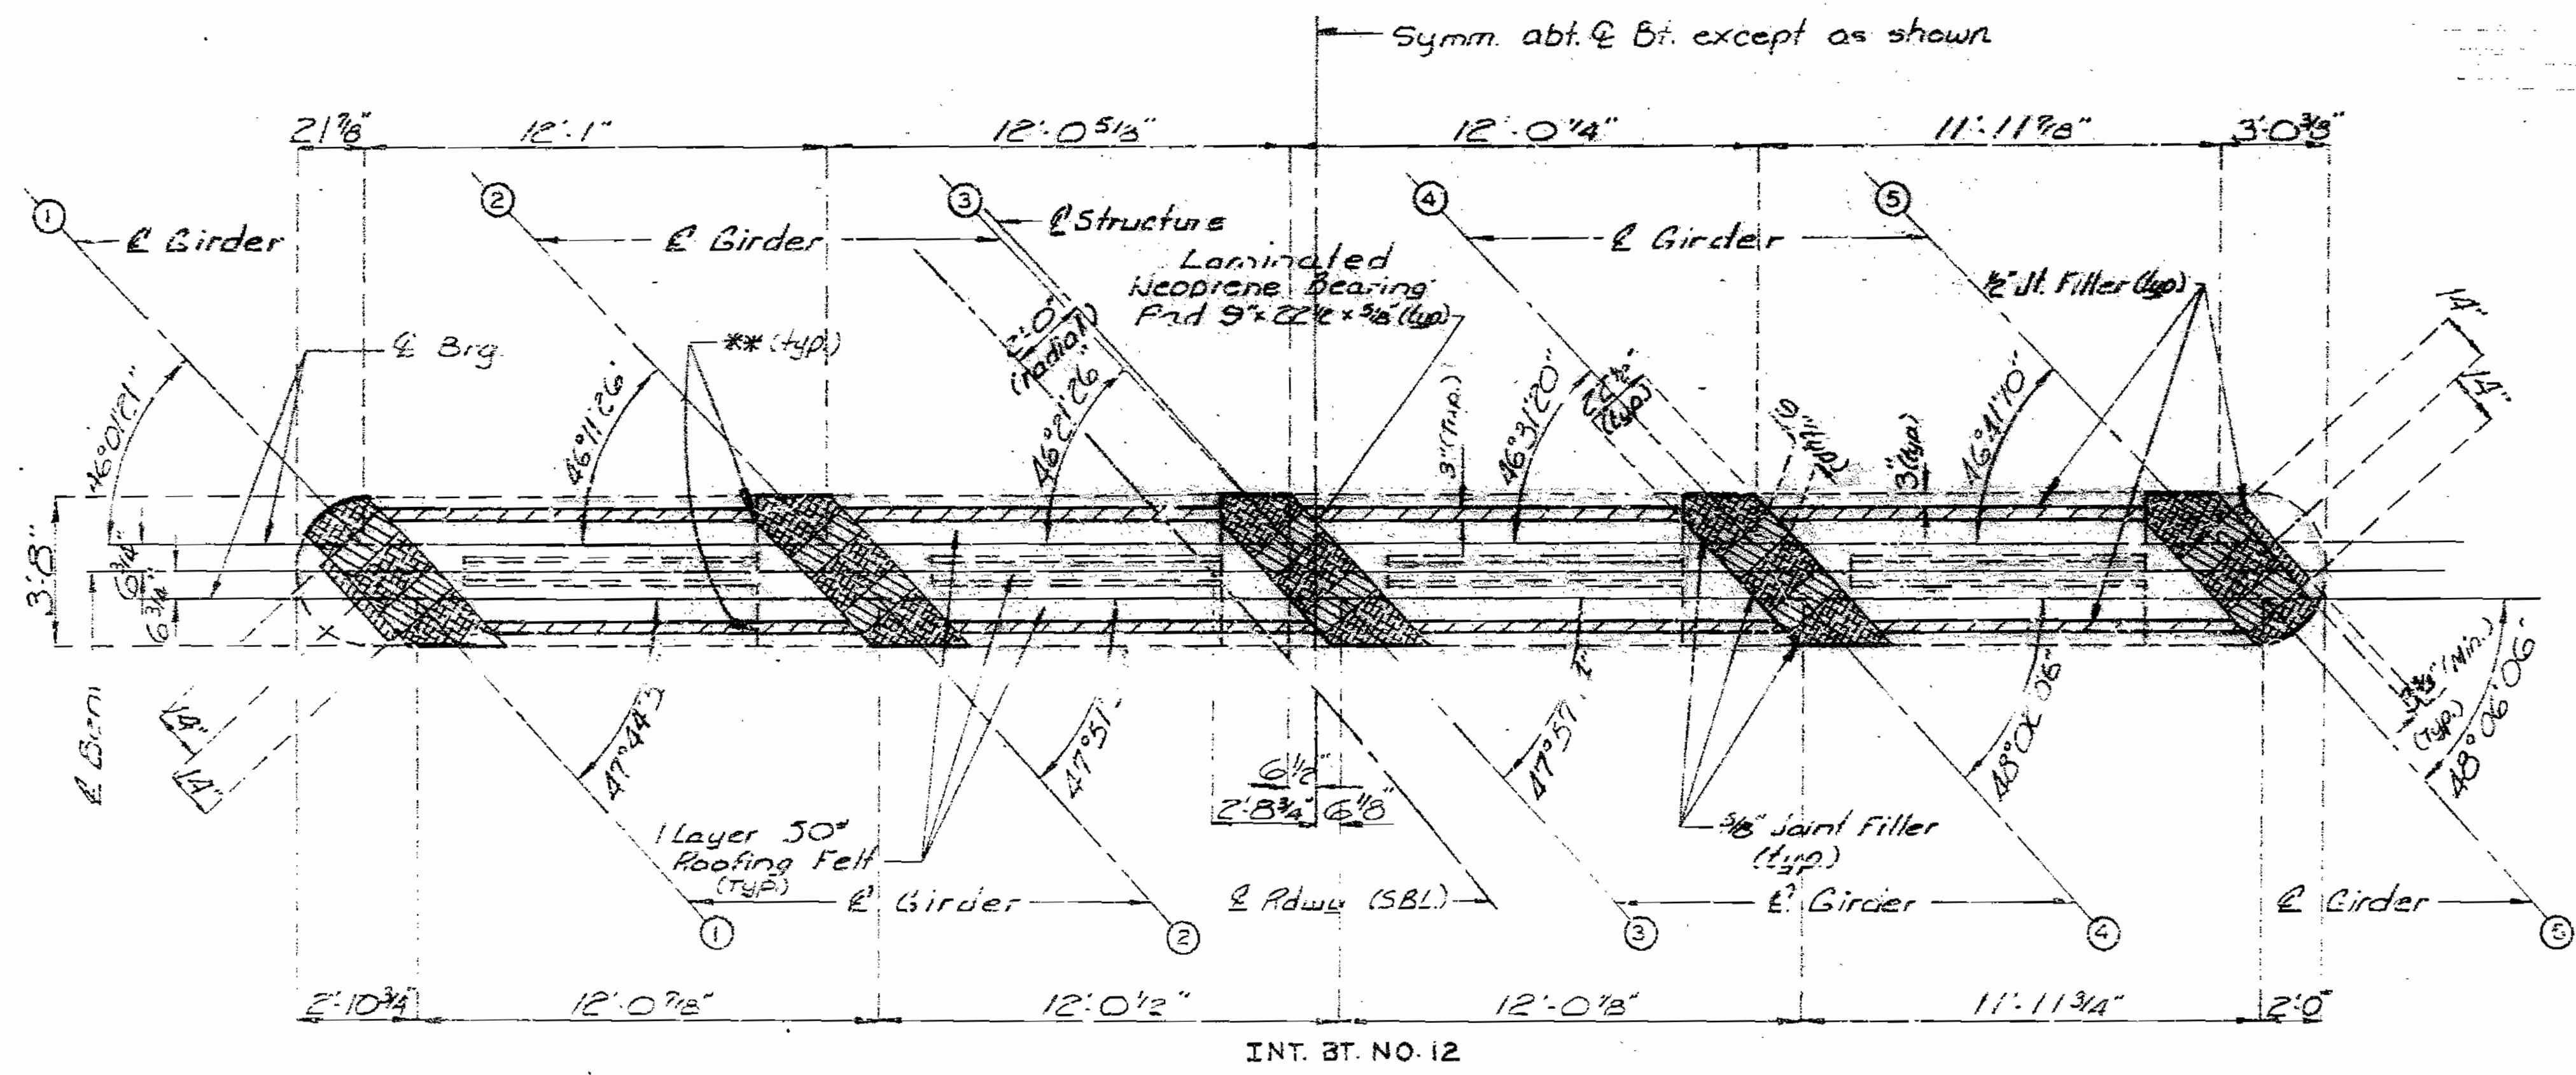

INT. BT. NO. 12

PART PLAN OF BEAM SHOWING BEARINGS, ROOFING FELT & JT. FILLER

\*\* 1/2" Jt. Filler on vertical face of steps over 2" high.

738 109

DETAILED Sept 1988  
CHECKED MAR 19 89


Note: This drawing is not to scale. Follow dimensions

Sheet No. 14 of 38

JACKSON COUNTY


A-2745

STATE	PROJ. NO.	SHEET NO.
MO.		35

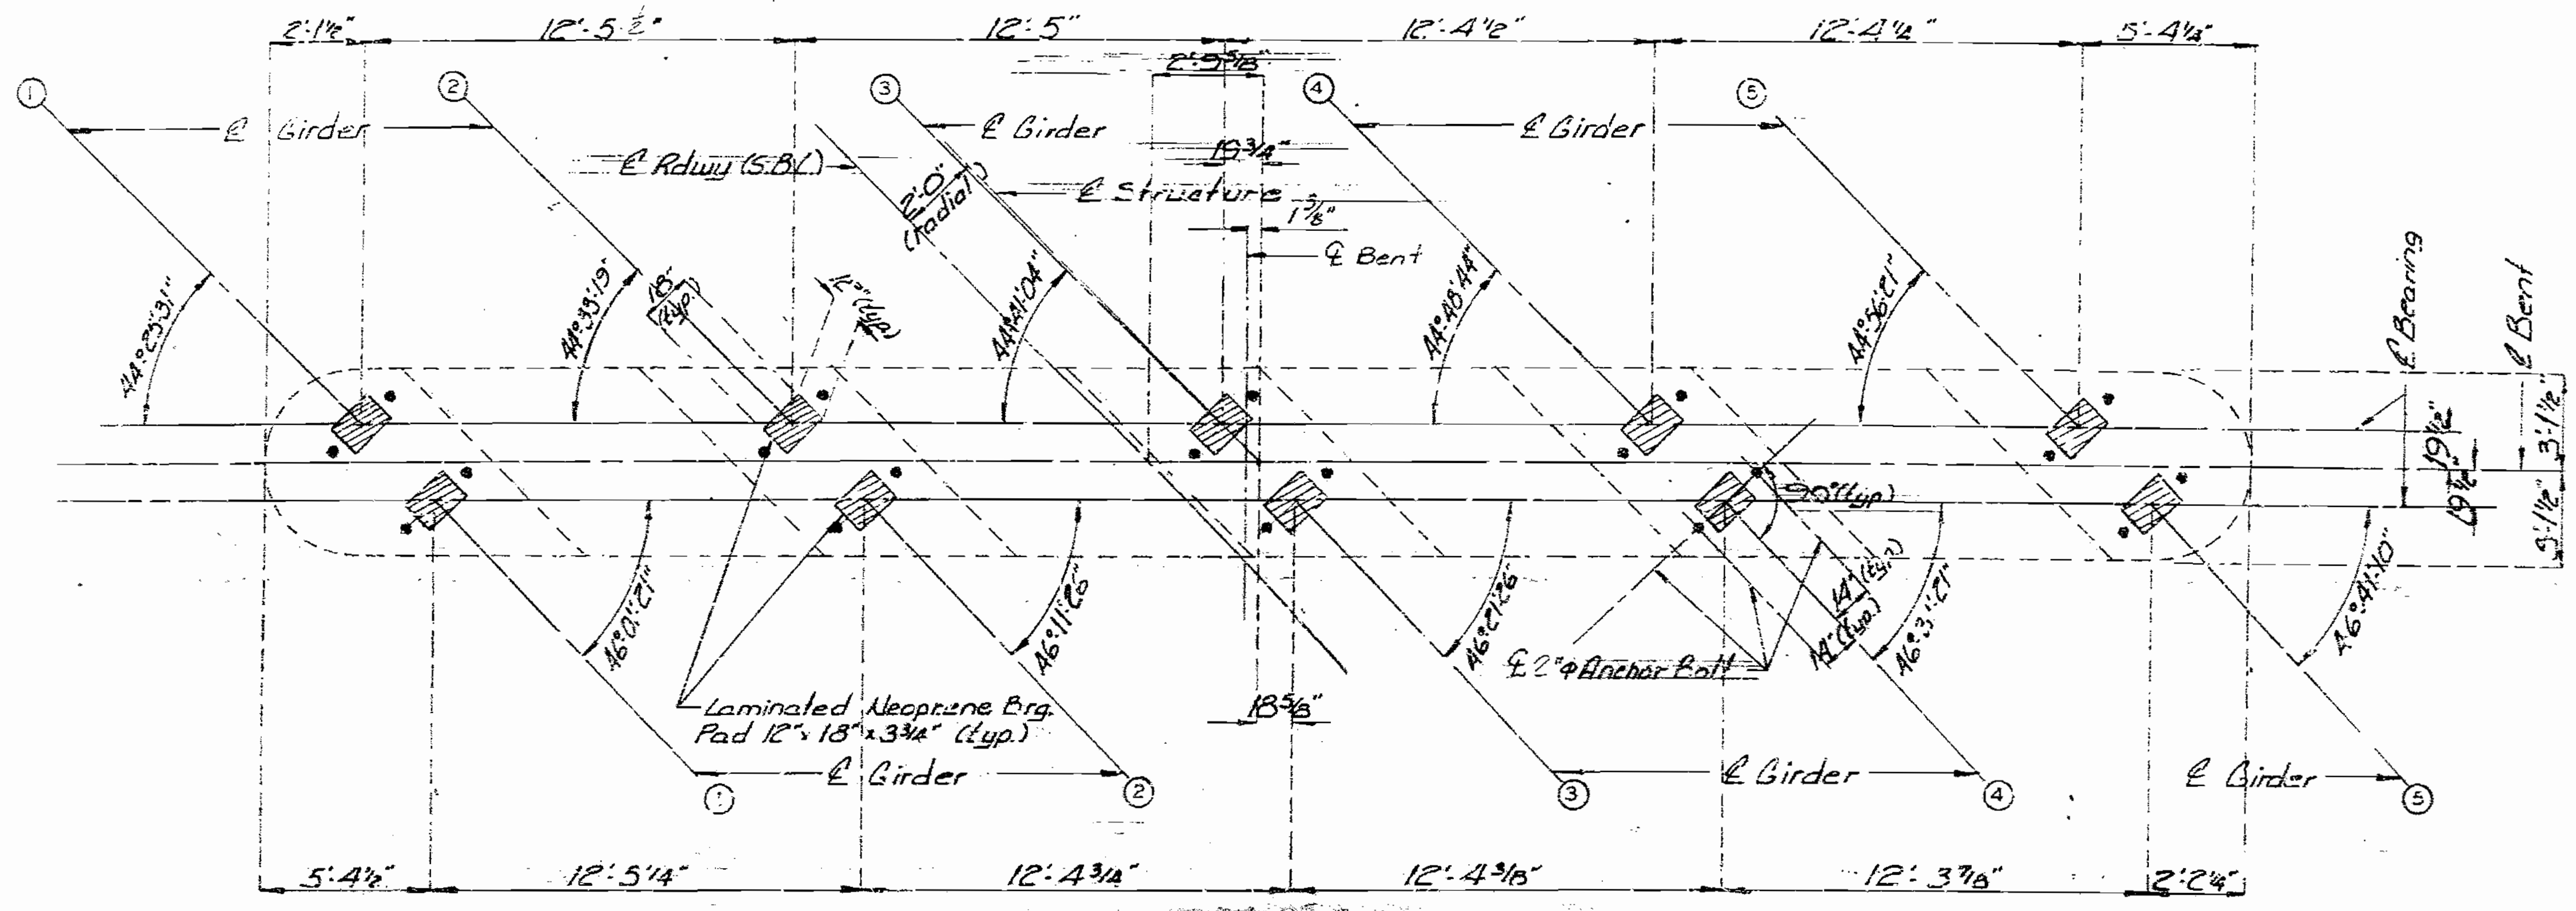

INT. BT. NO. 13

Note: For details of Bearings @ Int. Bt. No. 13 see sheet No. 27.

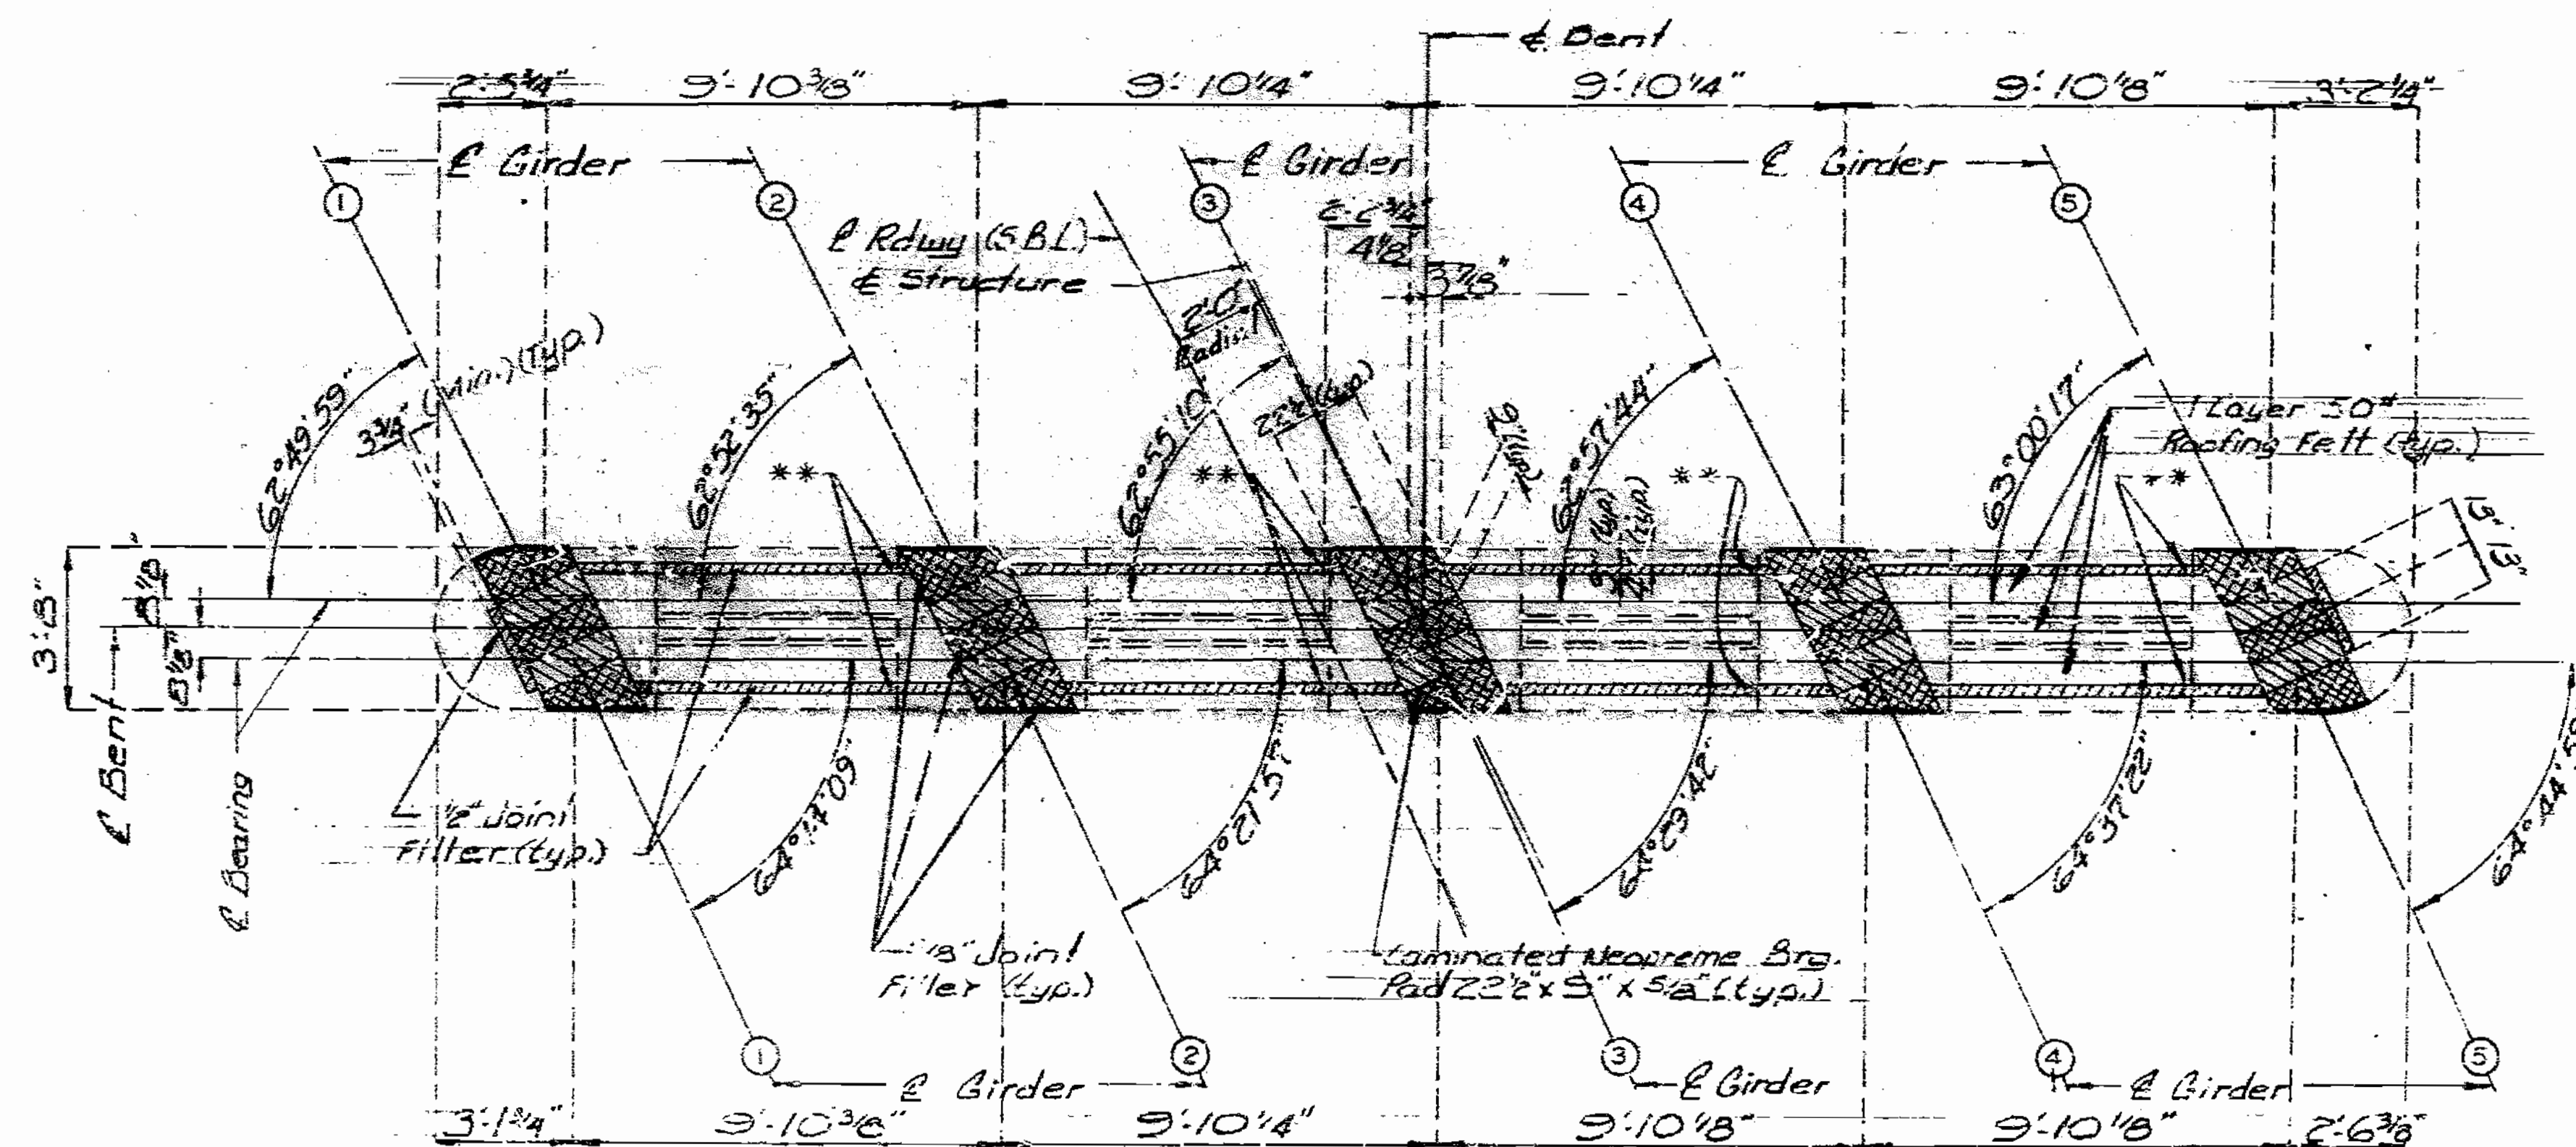

INT. BT. NO. 14


Note: For typical section thru Lam. Neoprene Brg. Pad at Int. Bt. #14 see sheet No. 16.

PART PLAN OF BEAM SHOWING BEARINGS, ROOFING FELT & JOINT FILLER



\*\* 1/2" Joint Filler on vertical face of steps.

13710

STATE	PROJ. NO.	SHEET NO.
MO.		96

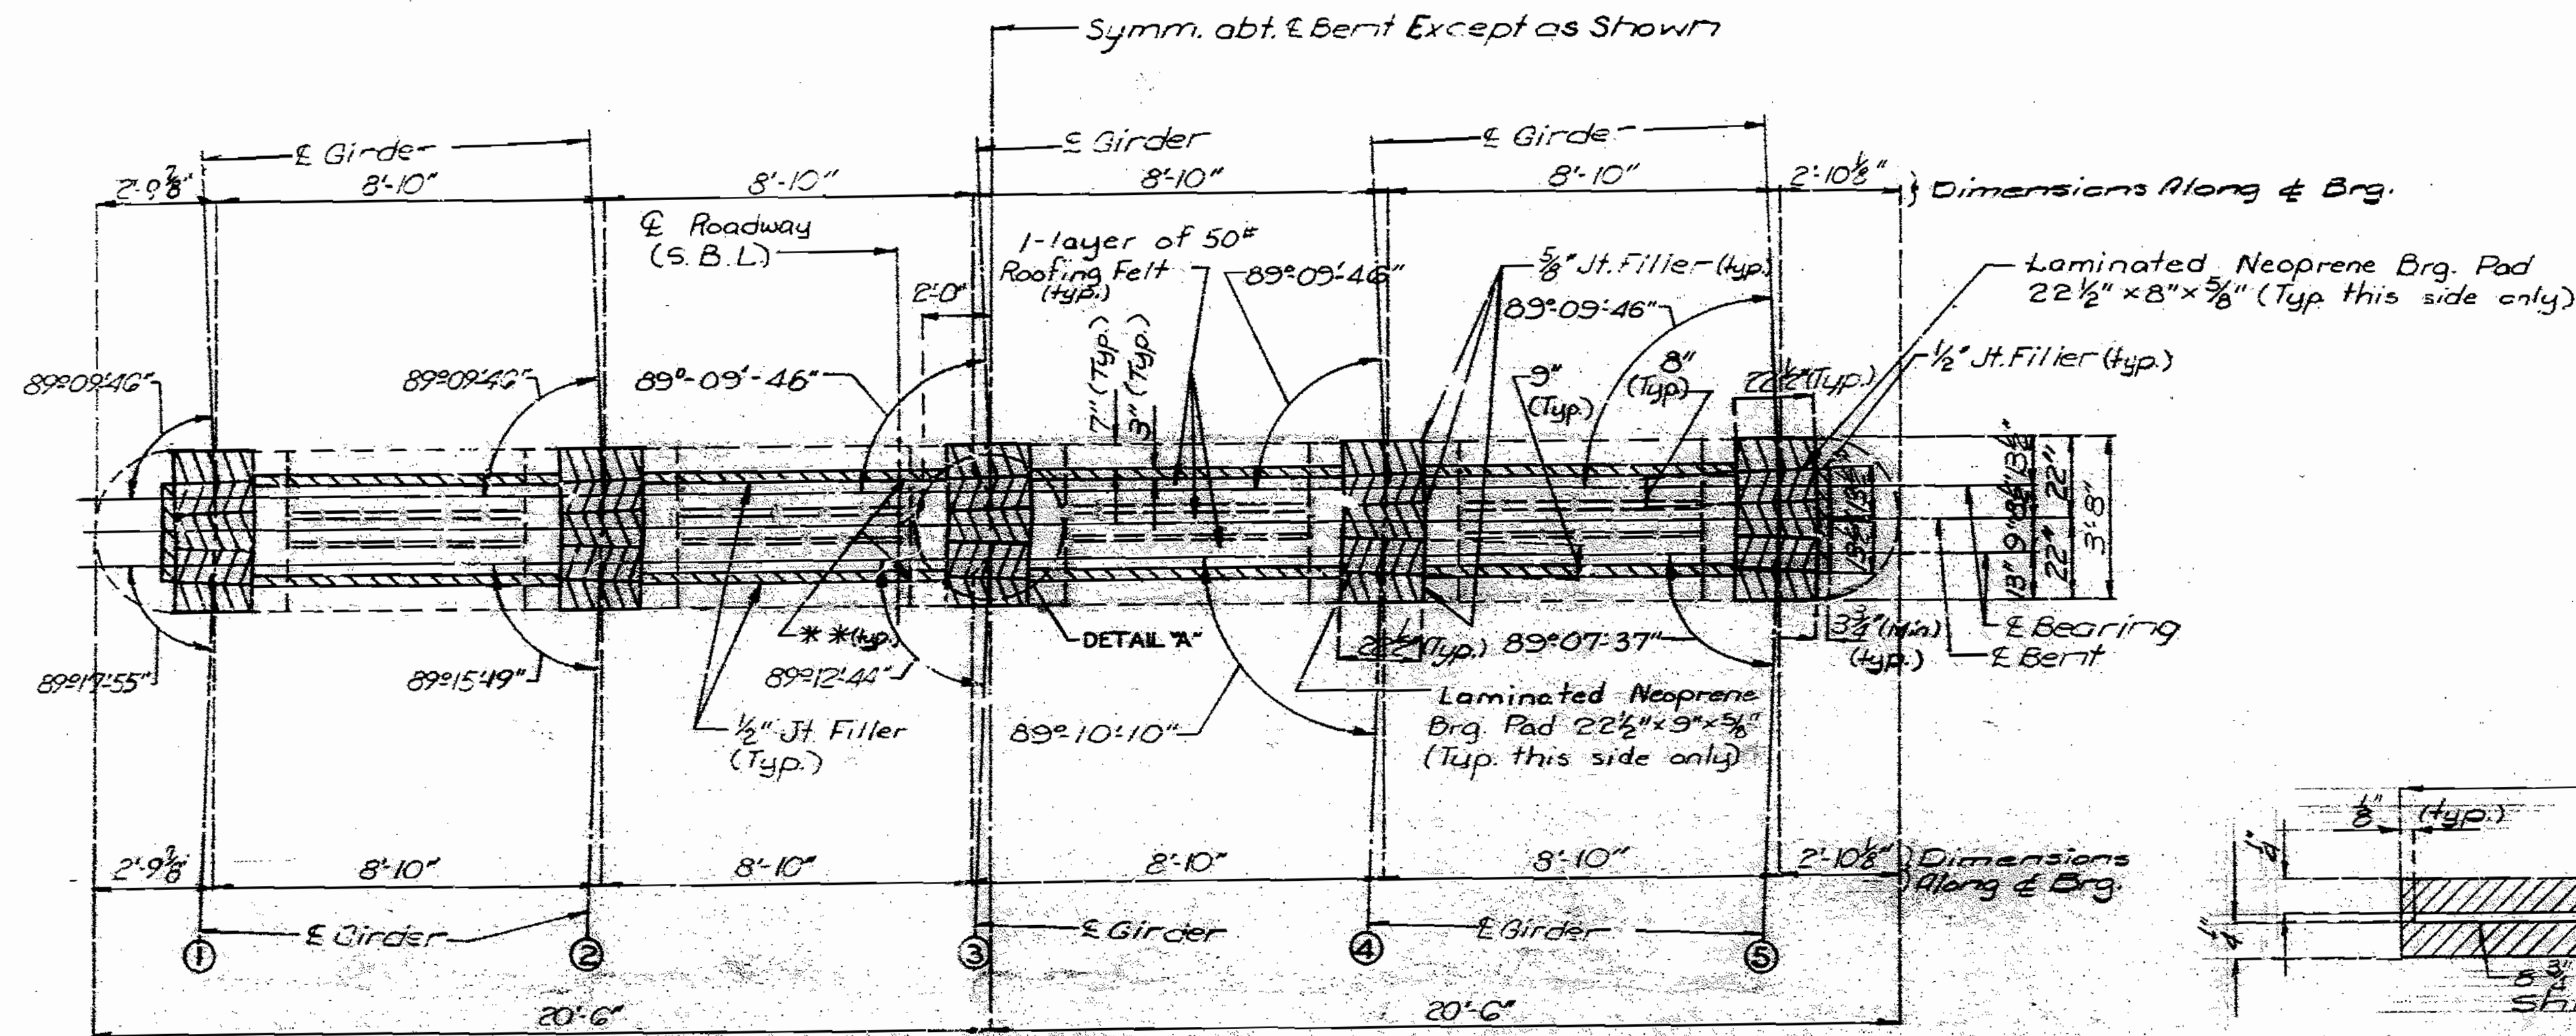


INT. BT. NO. 15

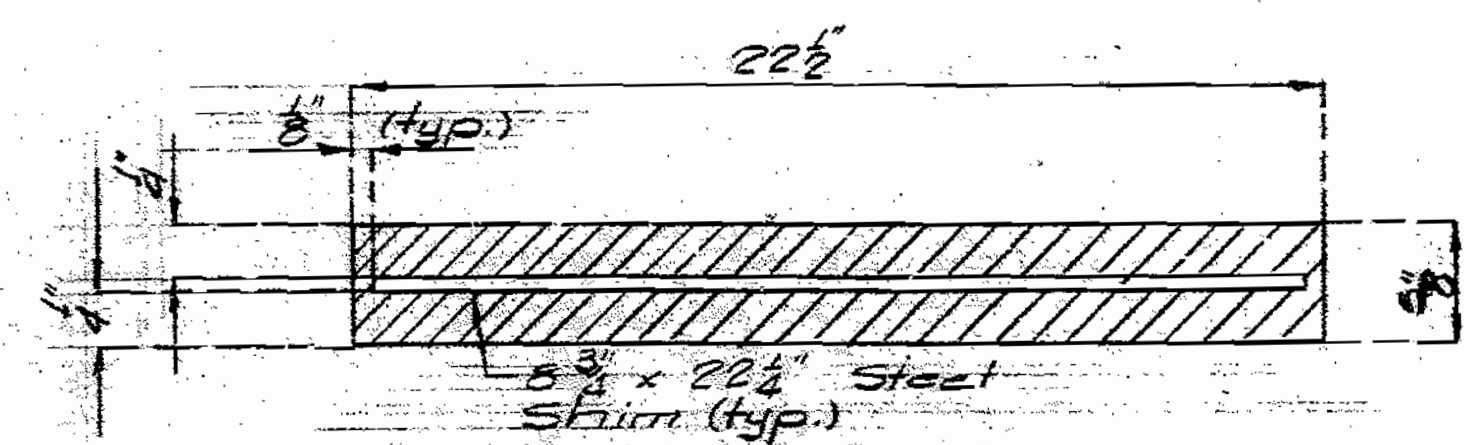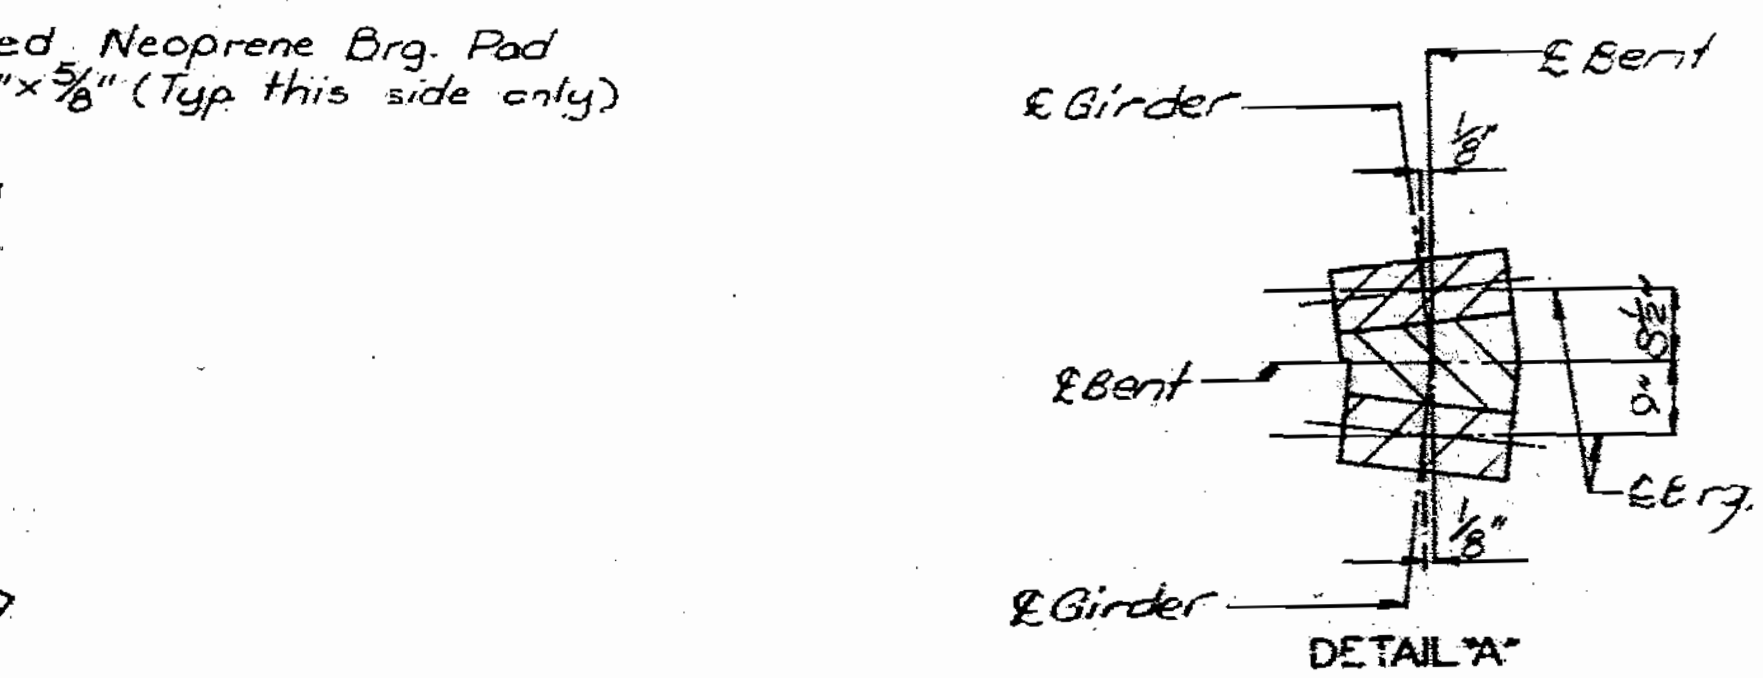


TYPICAL SECTION THRU LAMINATED NEOPRENE BRG. PAD 9" x 22 1/2" x 5/8" (INT. BT. NO. 14, 12 & 16) (INT. BT. NO. 15) SPAN (14-15) (INT. BT. NO. 11) SPAN (11-12)

Note: For typical section thru Lam. Neoprene Brg. Pad at Int. Bt. No. 15 Span (15-16) see sheet No. 17.

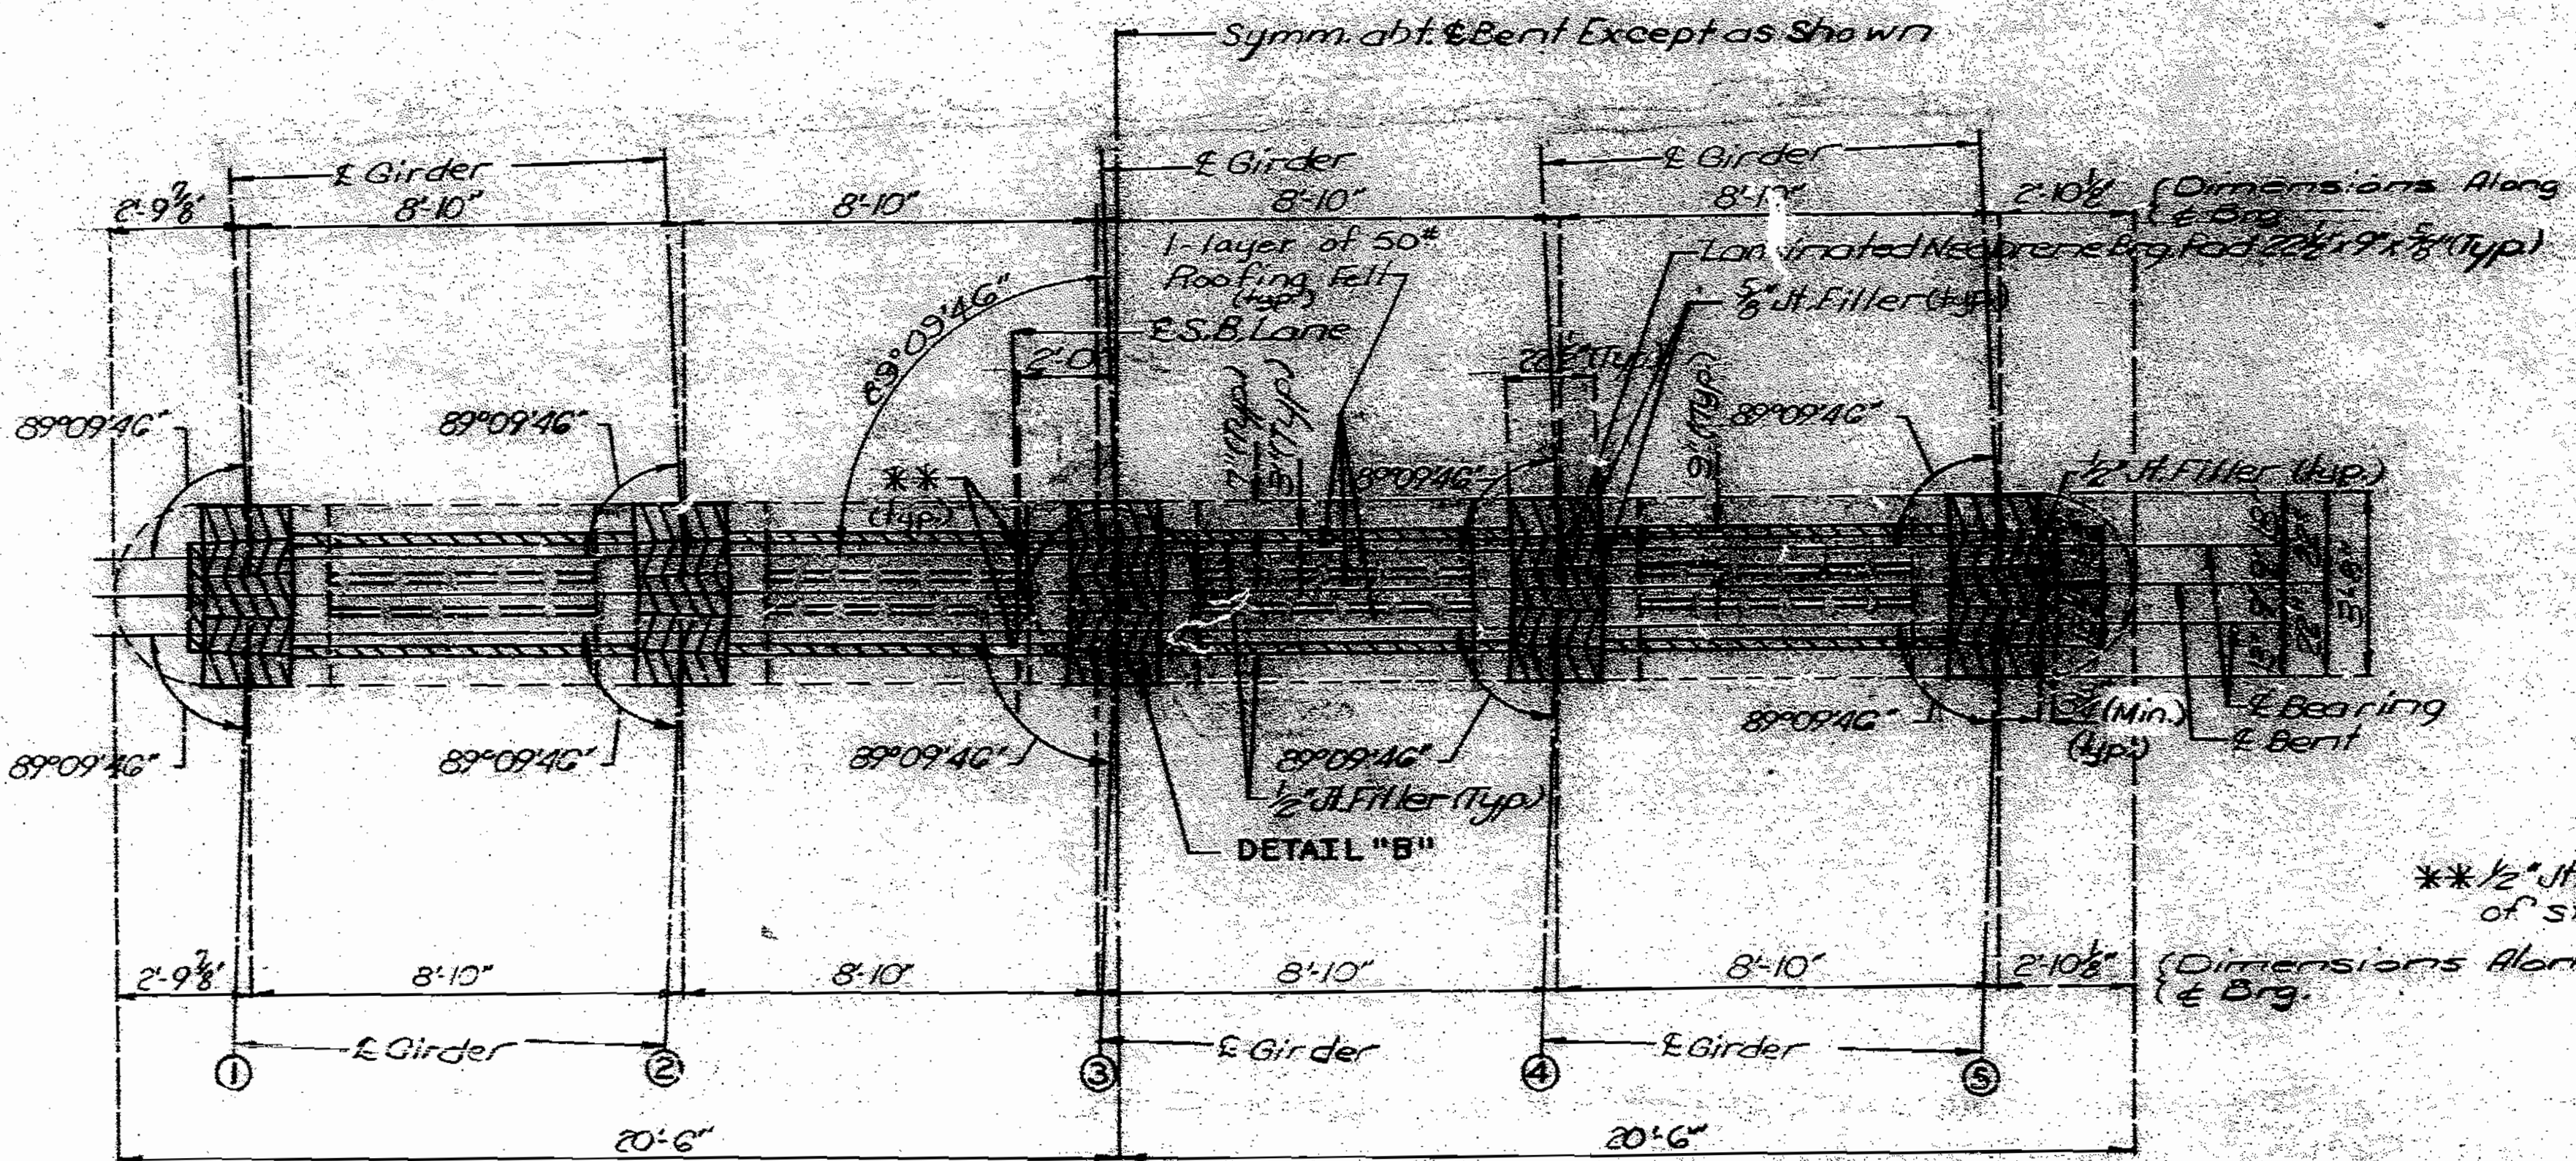

INT. BT. NO. 16

PART PLAN OF BEAM SHOWING BEARINGS, ROOFING FELT & JOINT FILLER

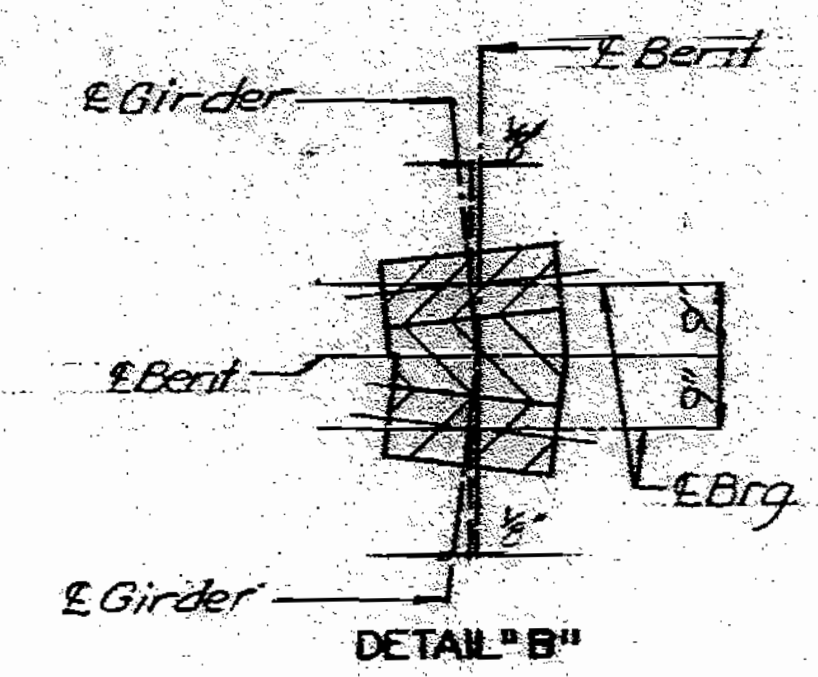

\*\* 1/2" Jt. Filler on vertical face of steps over 2" high (Typ.)

138  
 DETAILED Sept. 1988  
 CHECKED MARCH 19 89



Note: This drawing is not to scale. Follow dimensions.

Sheet No. 16 of 98

JACKSON COUNTY

A-2745


STATE	PRO. NO.	SHEET NO.
MO.		97

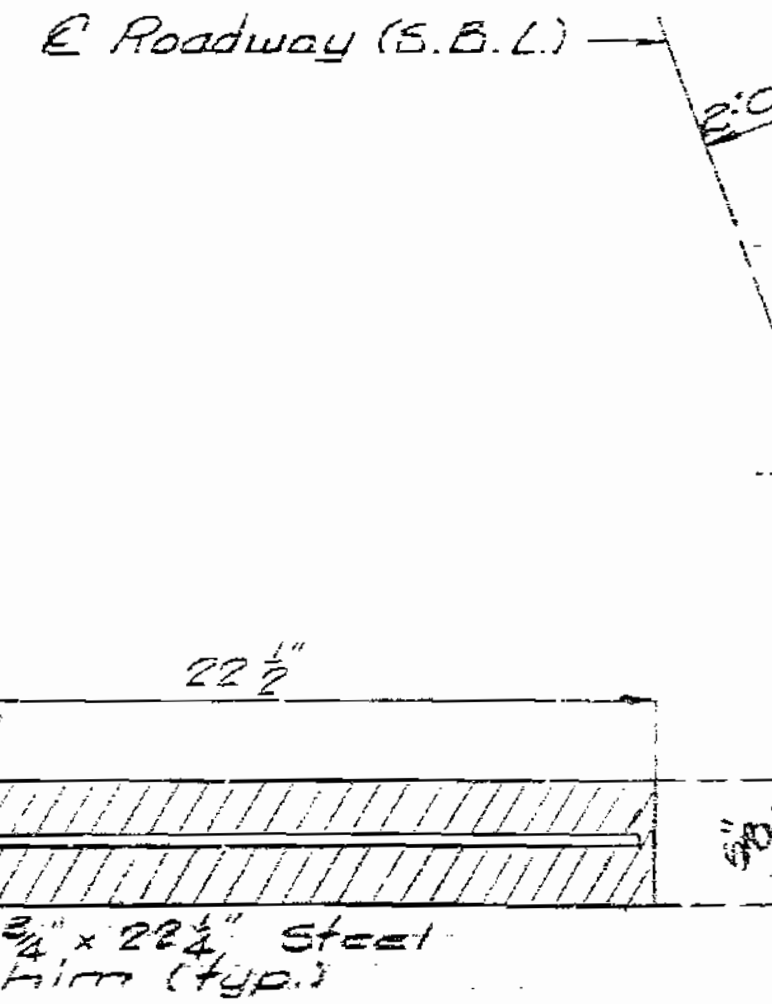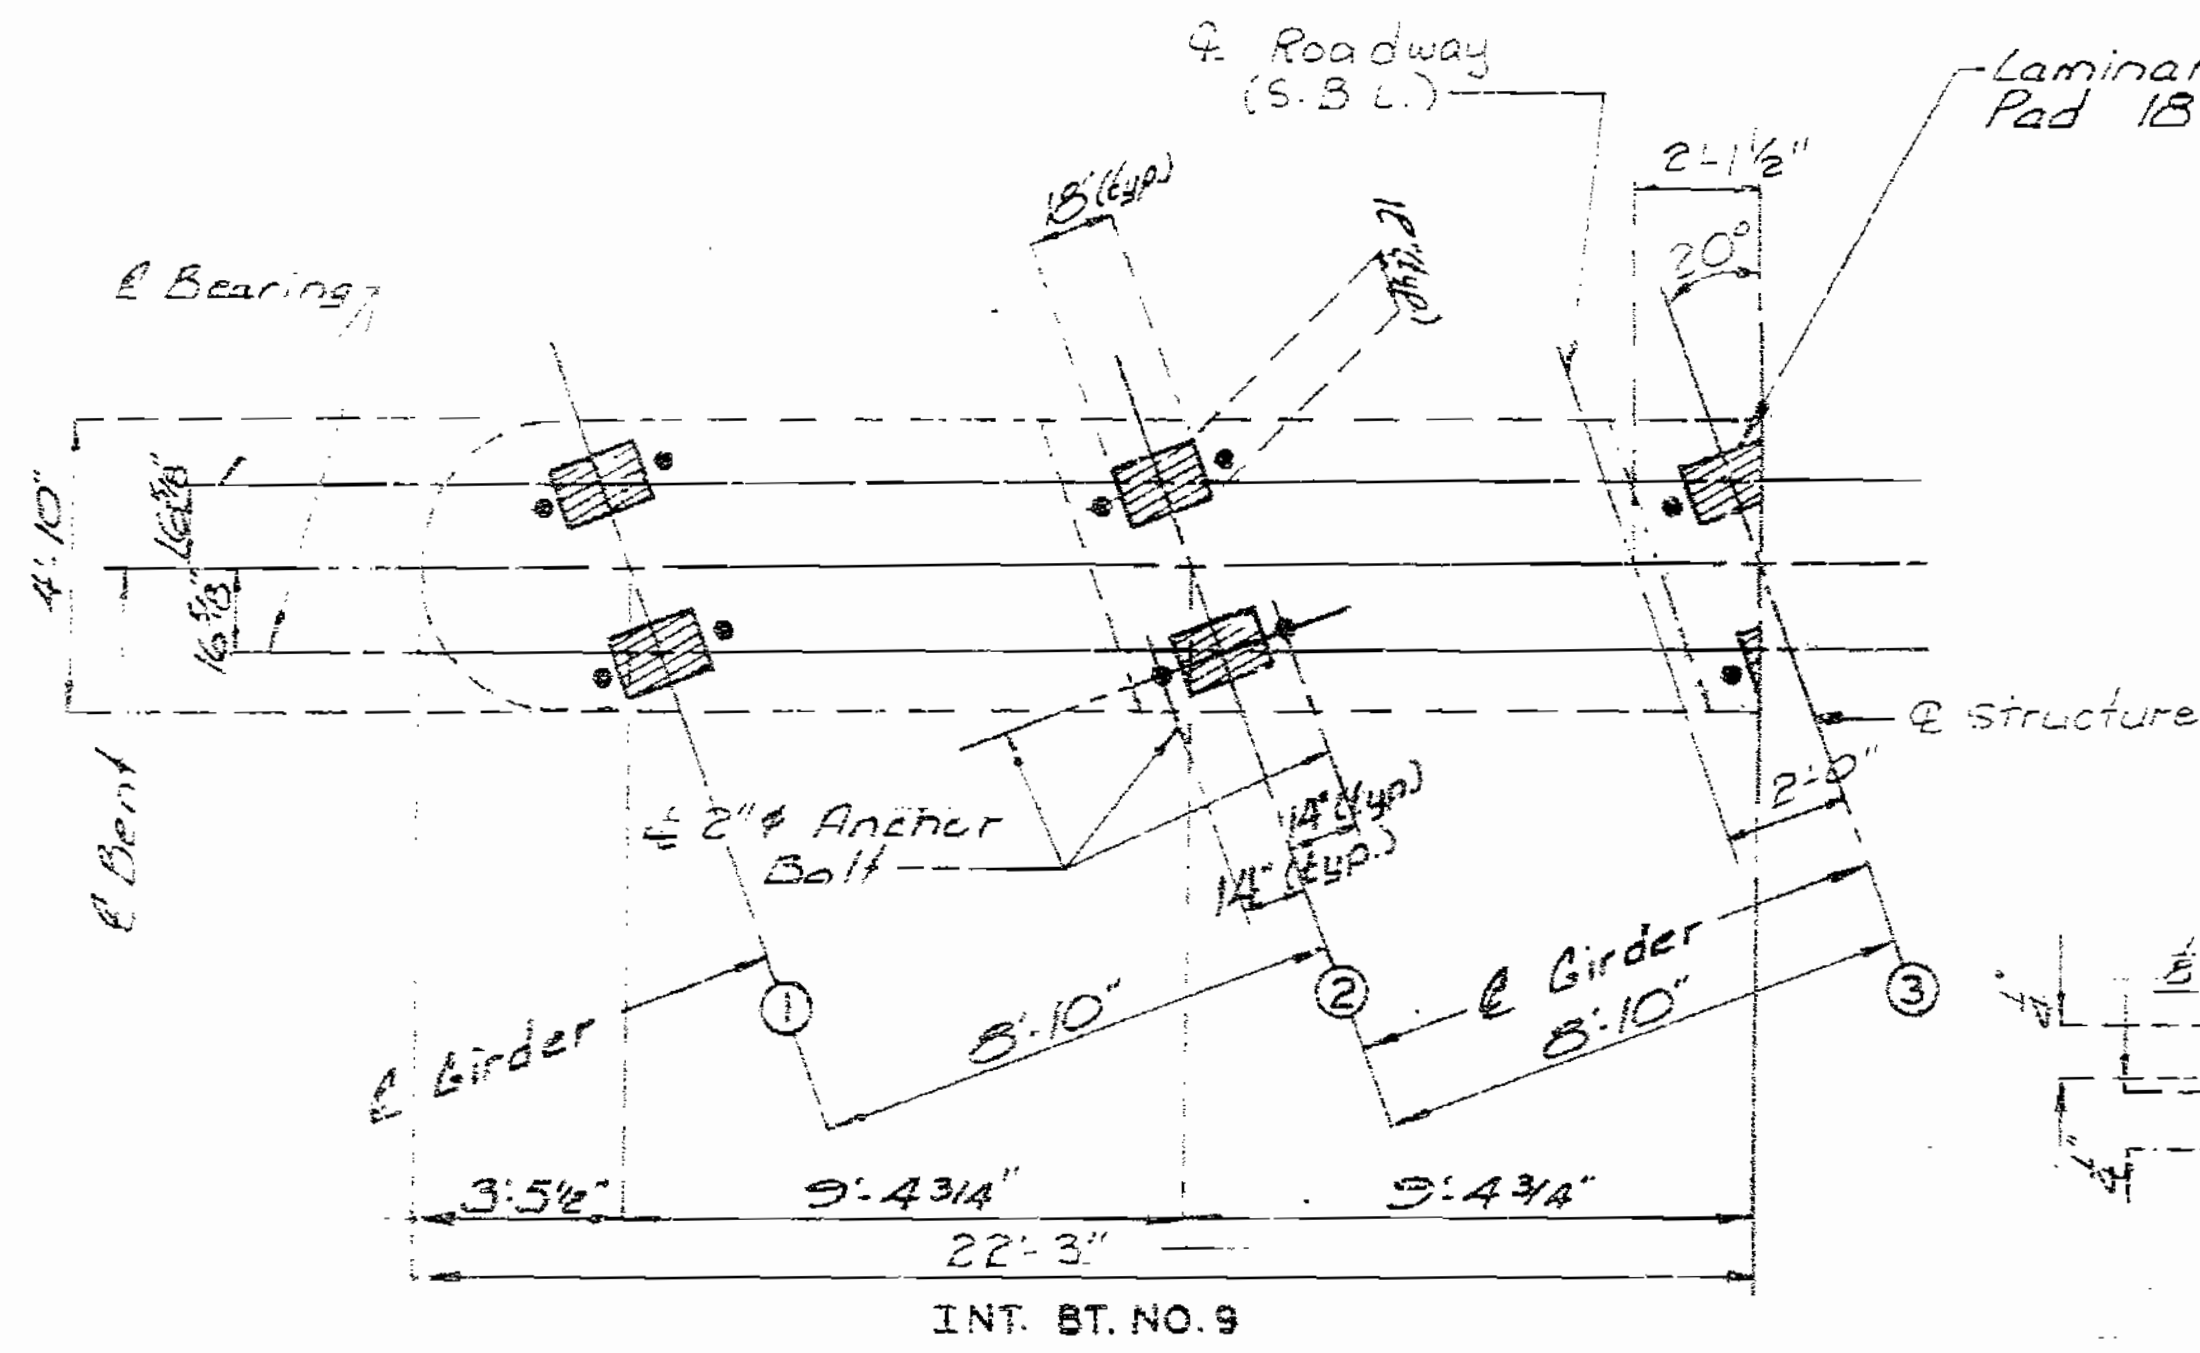

TYPICAL SECTION THRU LAMINATED NEOPRENE BRG. PAD 8" x 22 1/2" x 5/8" (BT. NO. 1,2,3,5,6,7, 8 & 10), (INT. BT. NO. 15) SPAN (15-16), (INT. BT. NO. 11) SPAN (10-11)

Note: For details of Bearings @ Int. Bt. No. 9 see sheet No. 21.

PART PLAN OF BEAM SHOWING BEARINGS ROOFING FELT & JT. FILLER

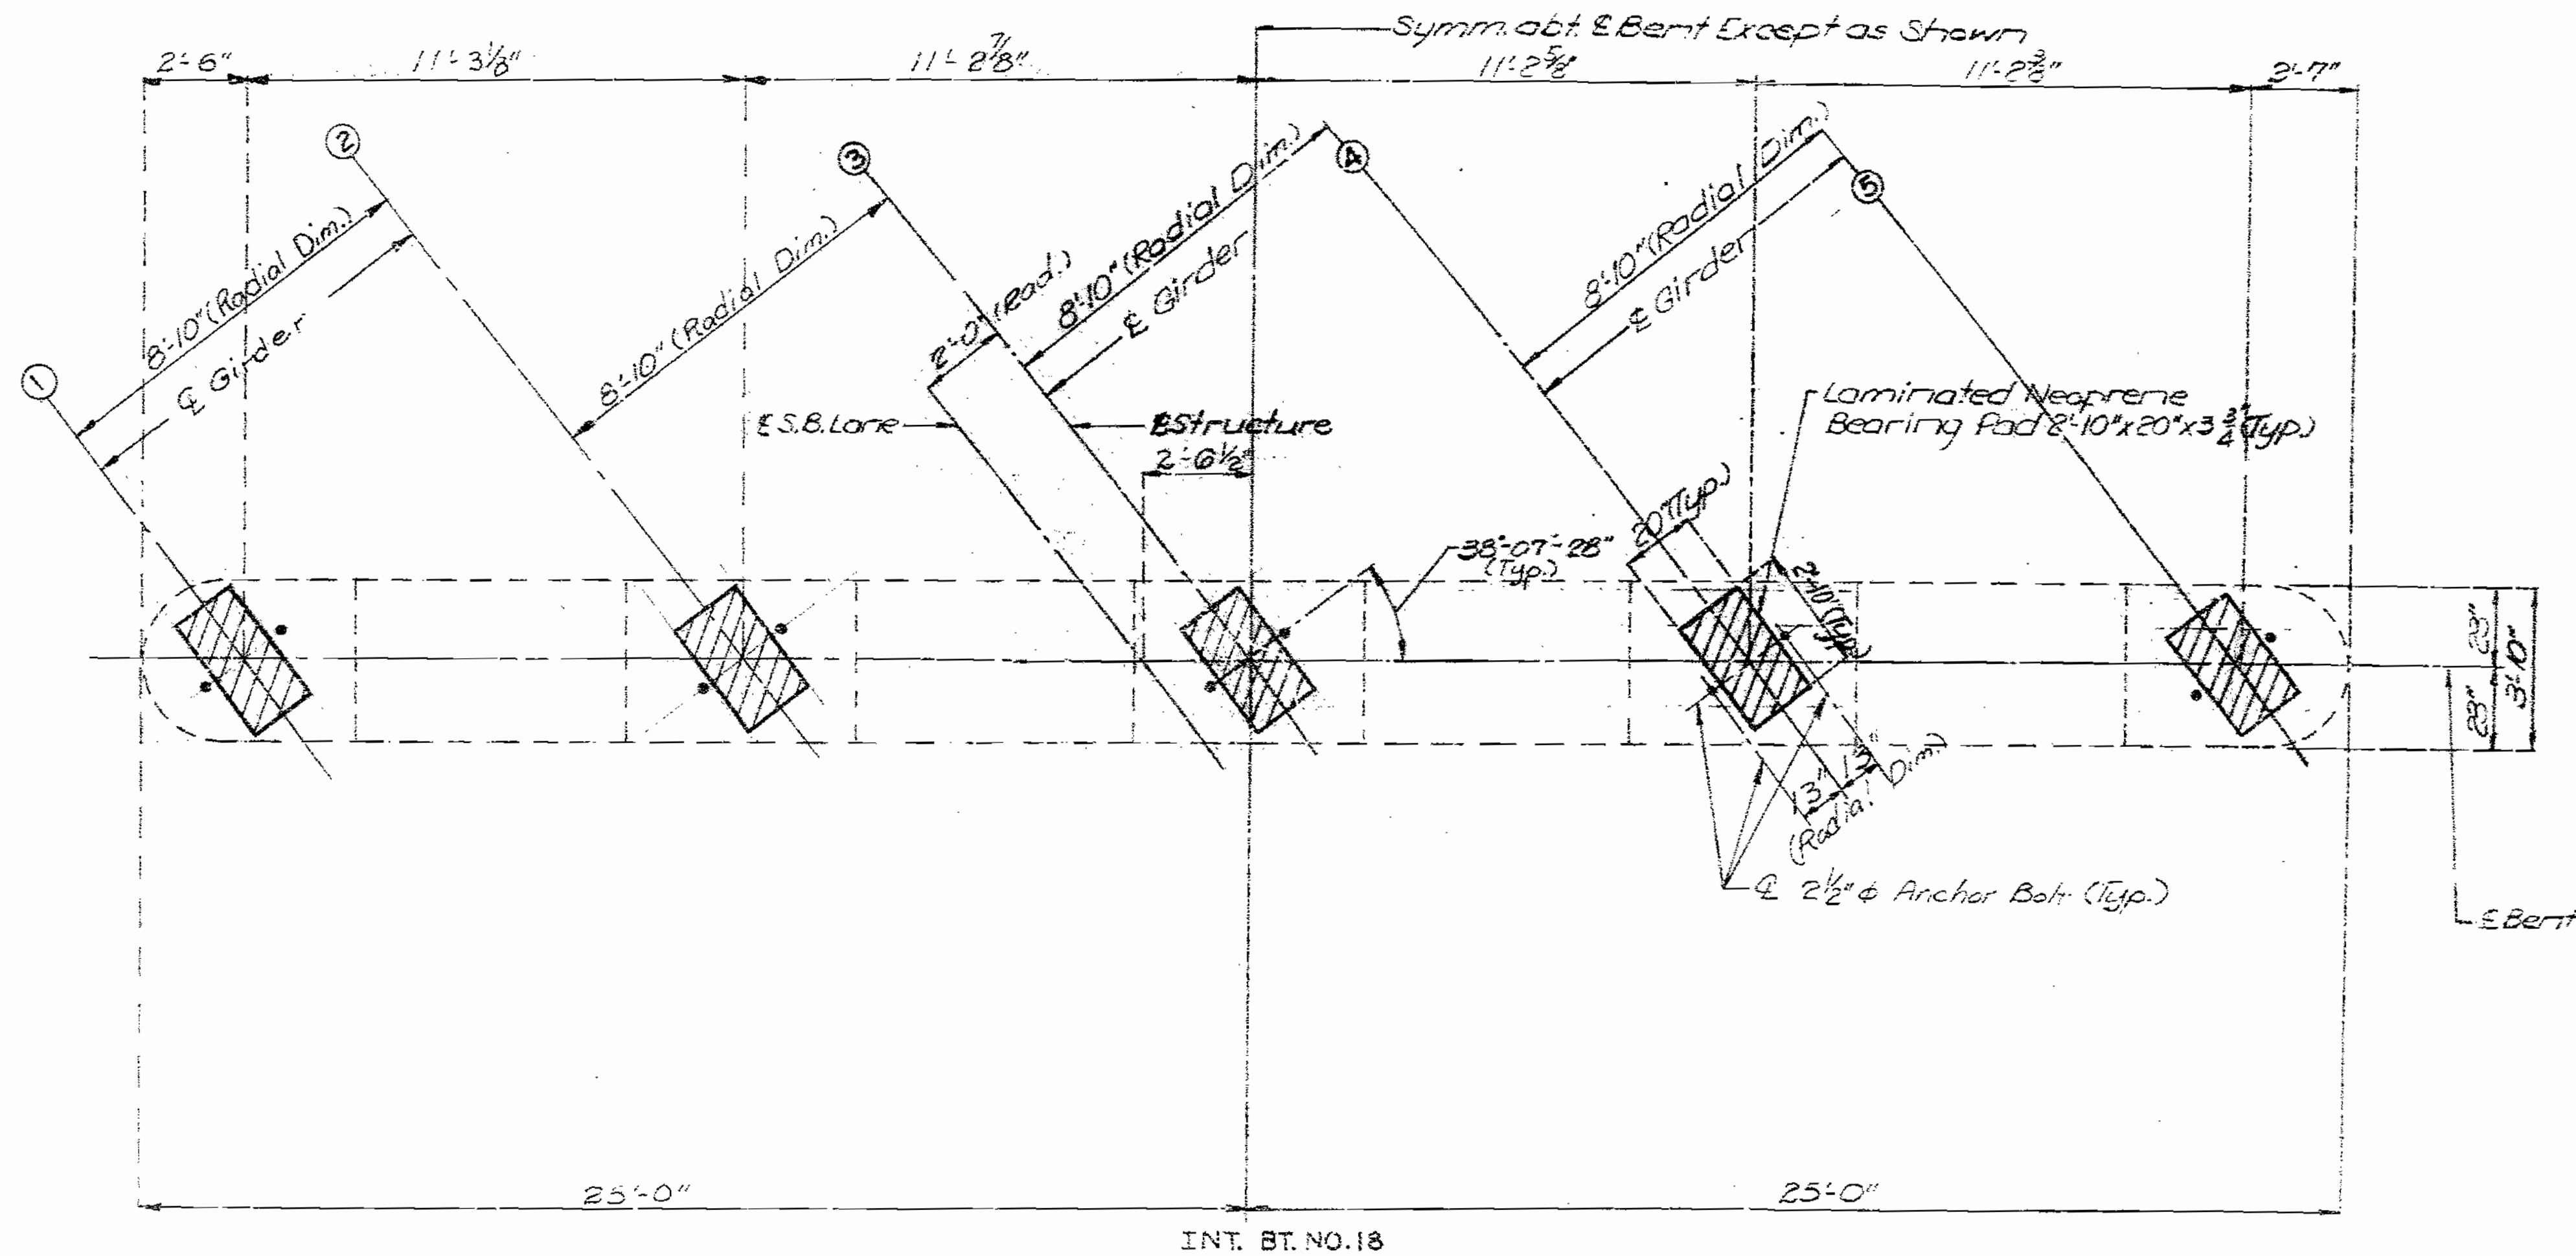

Note: For details of Bearings @ Int. Bt. No. 18 see sheet No. 22.

INT. BT. NO. 18

DETAILED Sept 1983  
CHECKED March 1988


Note: This drawing is not to scale. Follow dimensions.

Sheet No. 17 of 38


JACKSON COUNTY

A-2745

STATE	PRJ. NO.	SHEET NO.
MO.		38

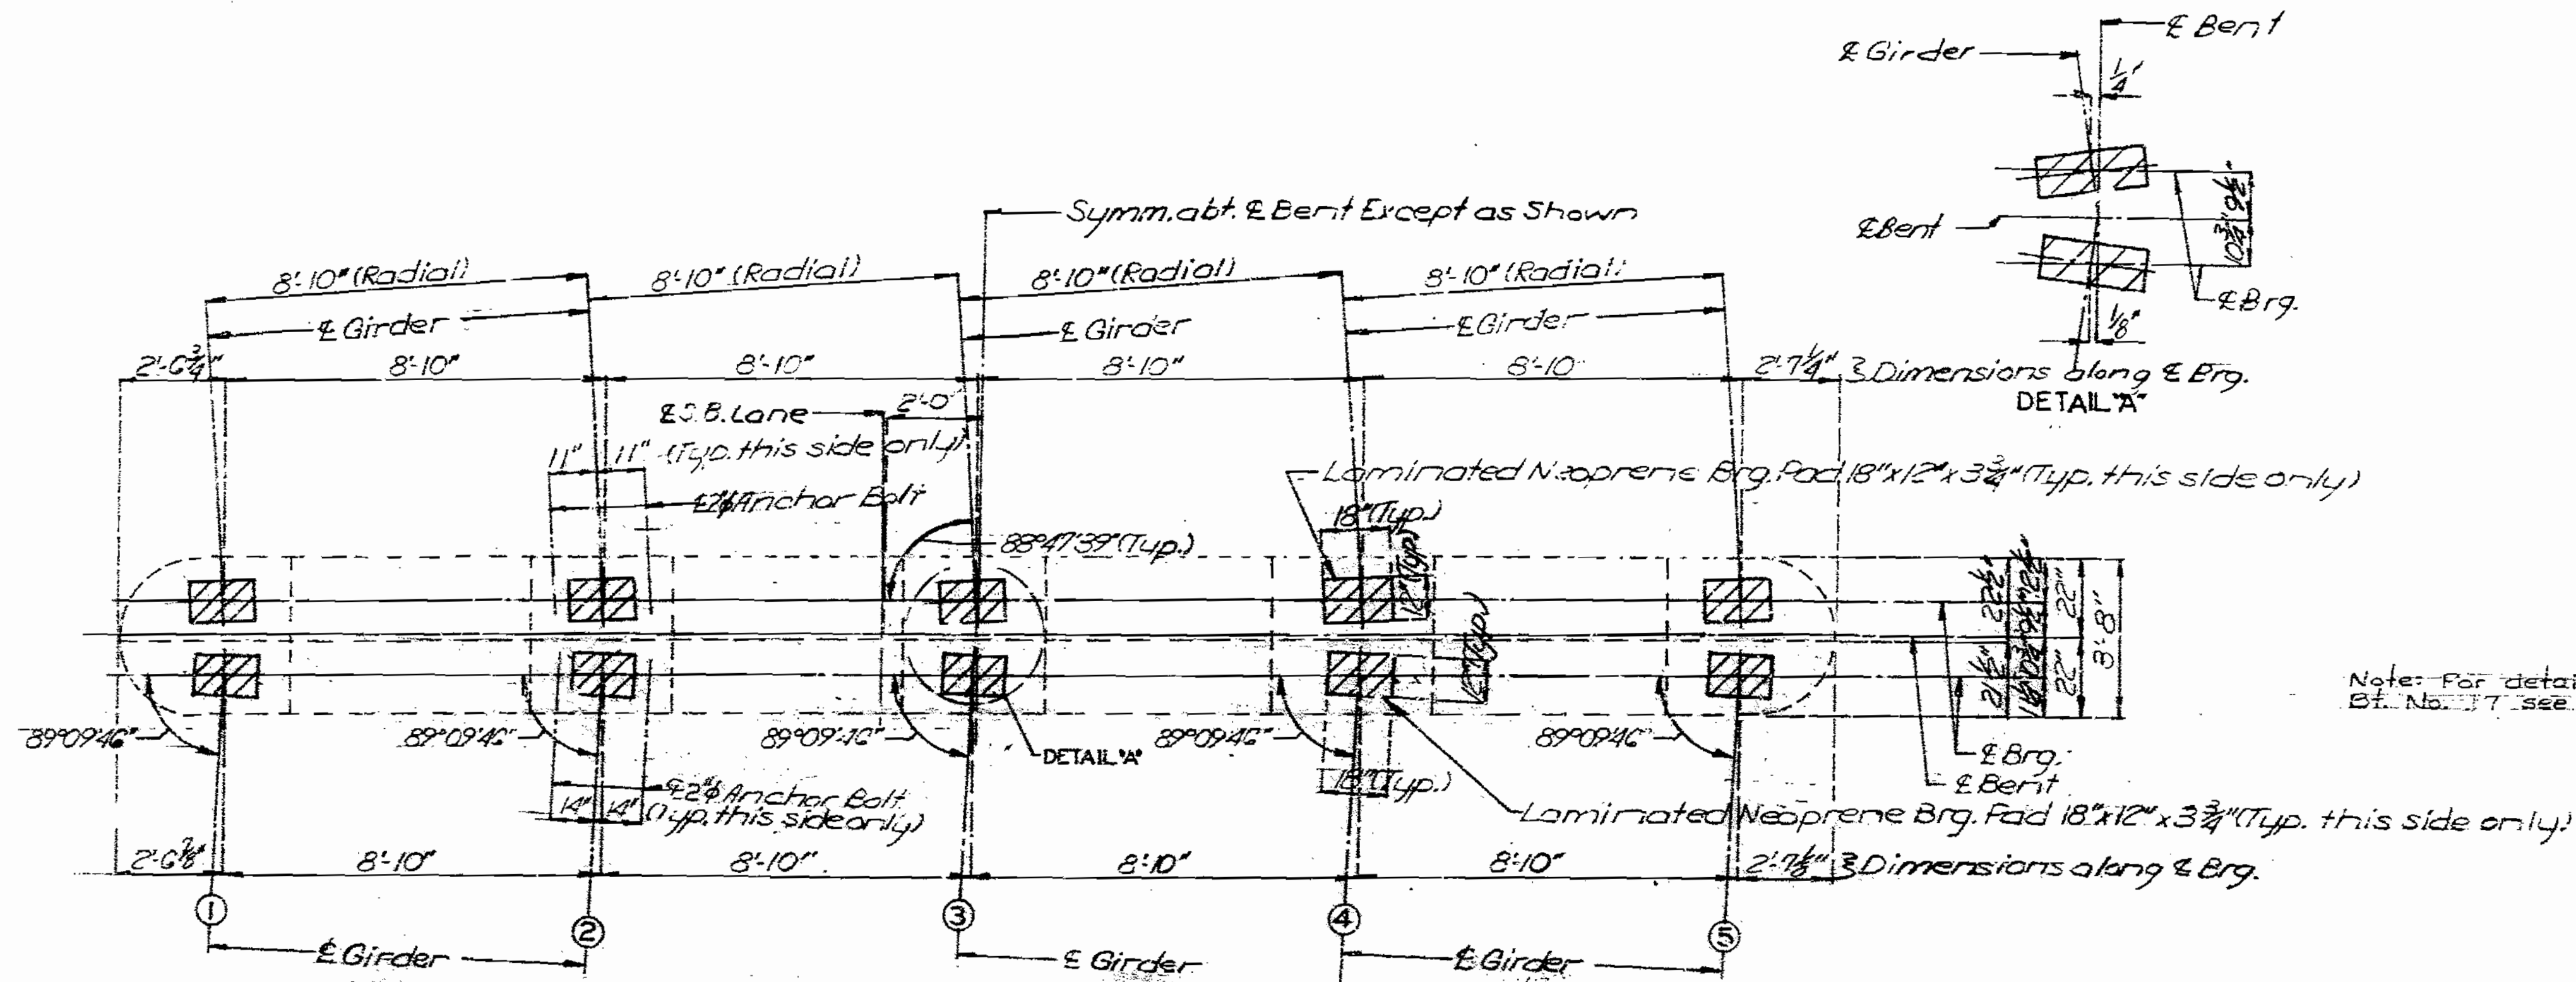

INT. BT. NO. 17

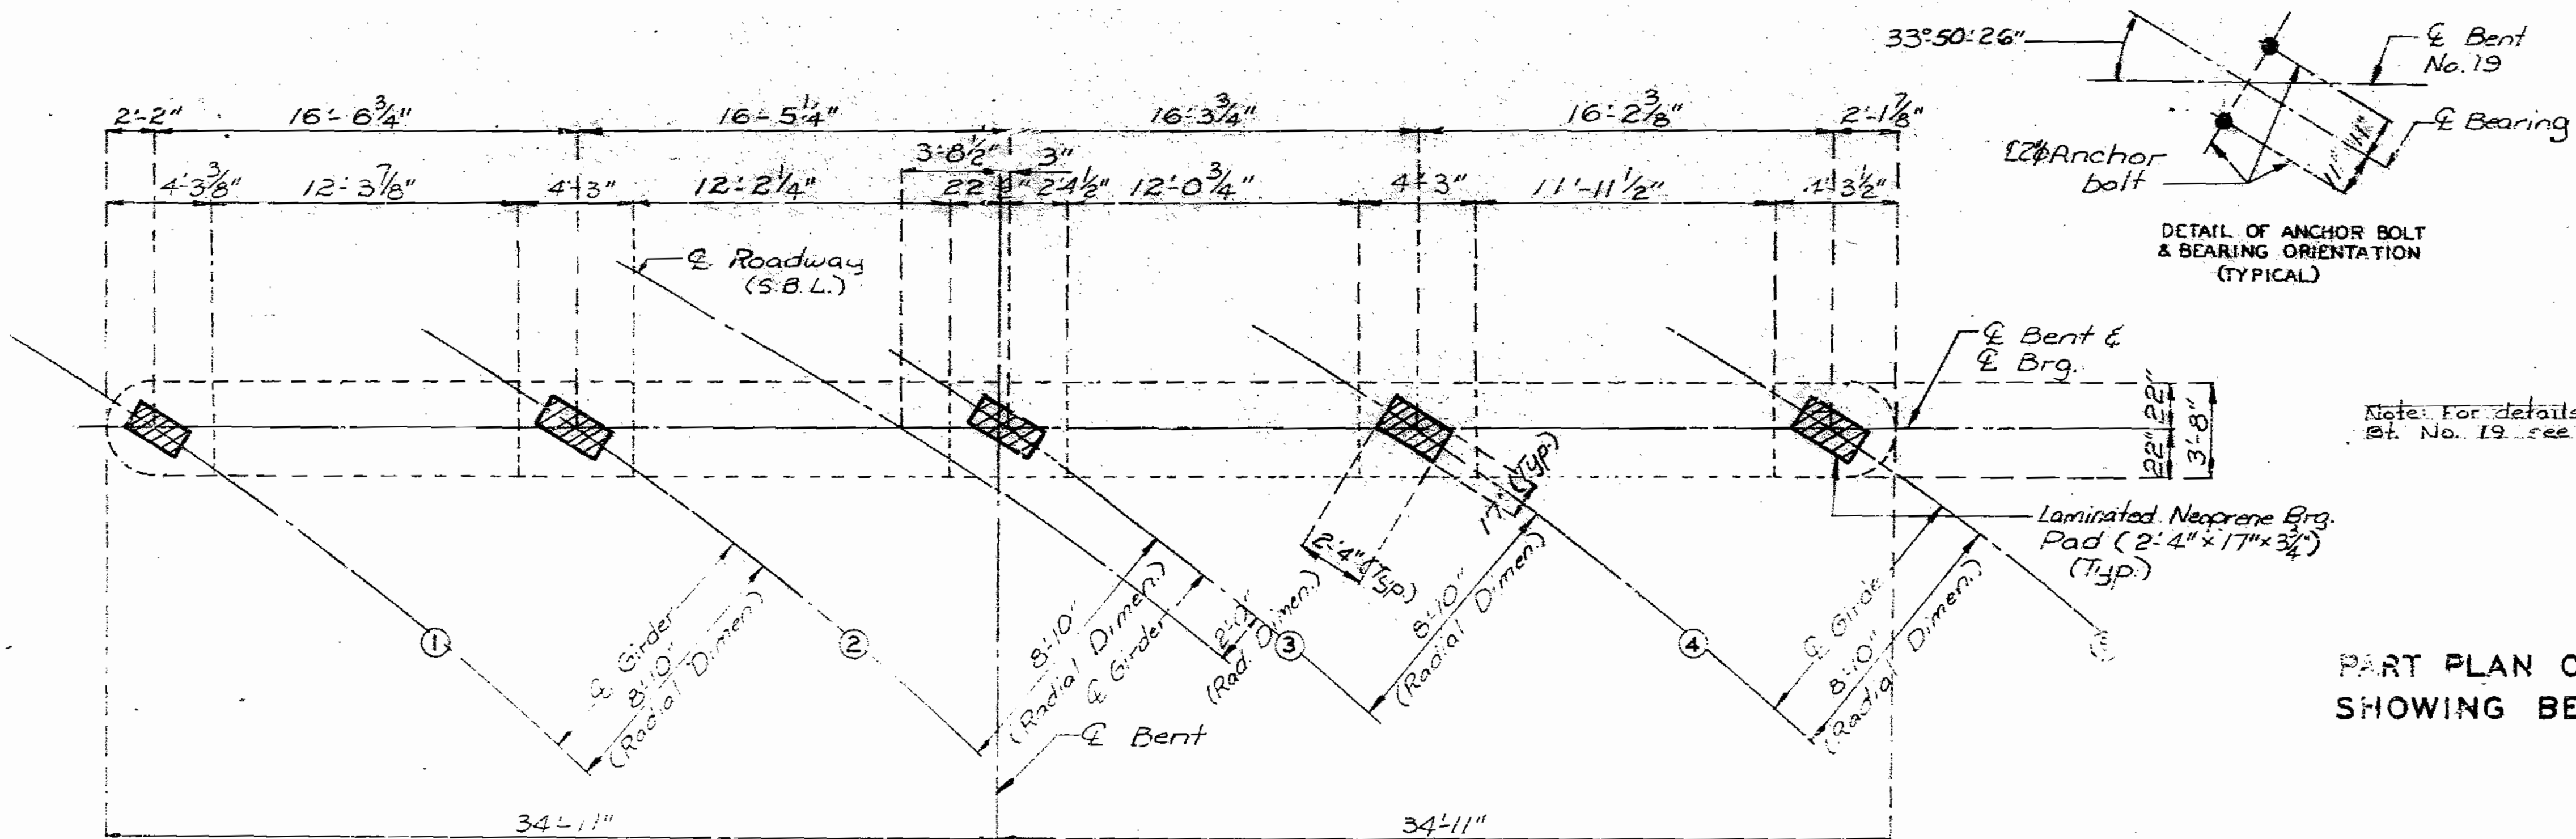

INT. BT. NO. 19

PART PLAN OF BEAM SHOWING BEARINGS

DETAILED Sept. 1988  
CHECKED March 1989



Note: This drawing is not to scale. Follow dimensions.

Sheet No. 18 of 38.


JACKSON COUNTY

A-2745

STATE	PROJ. NO.	SHEET NO.
MO		99

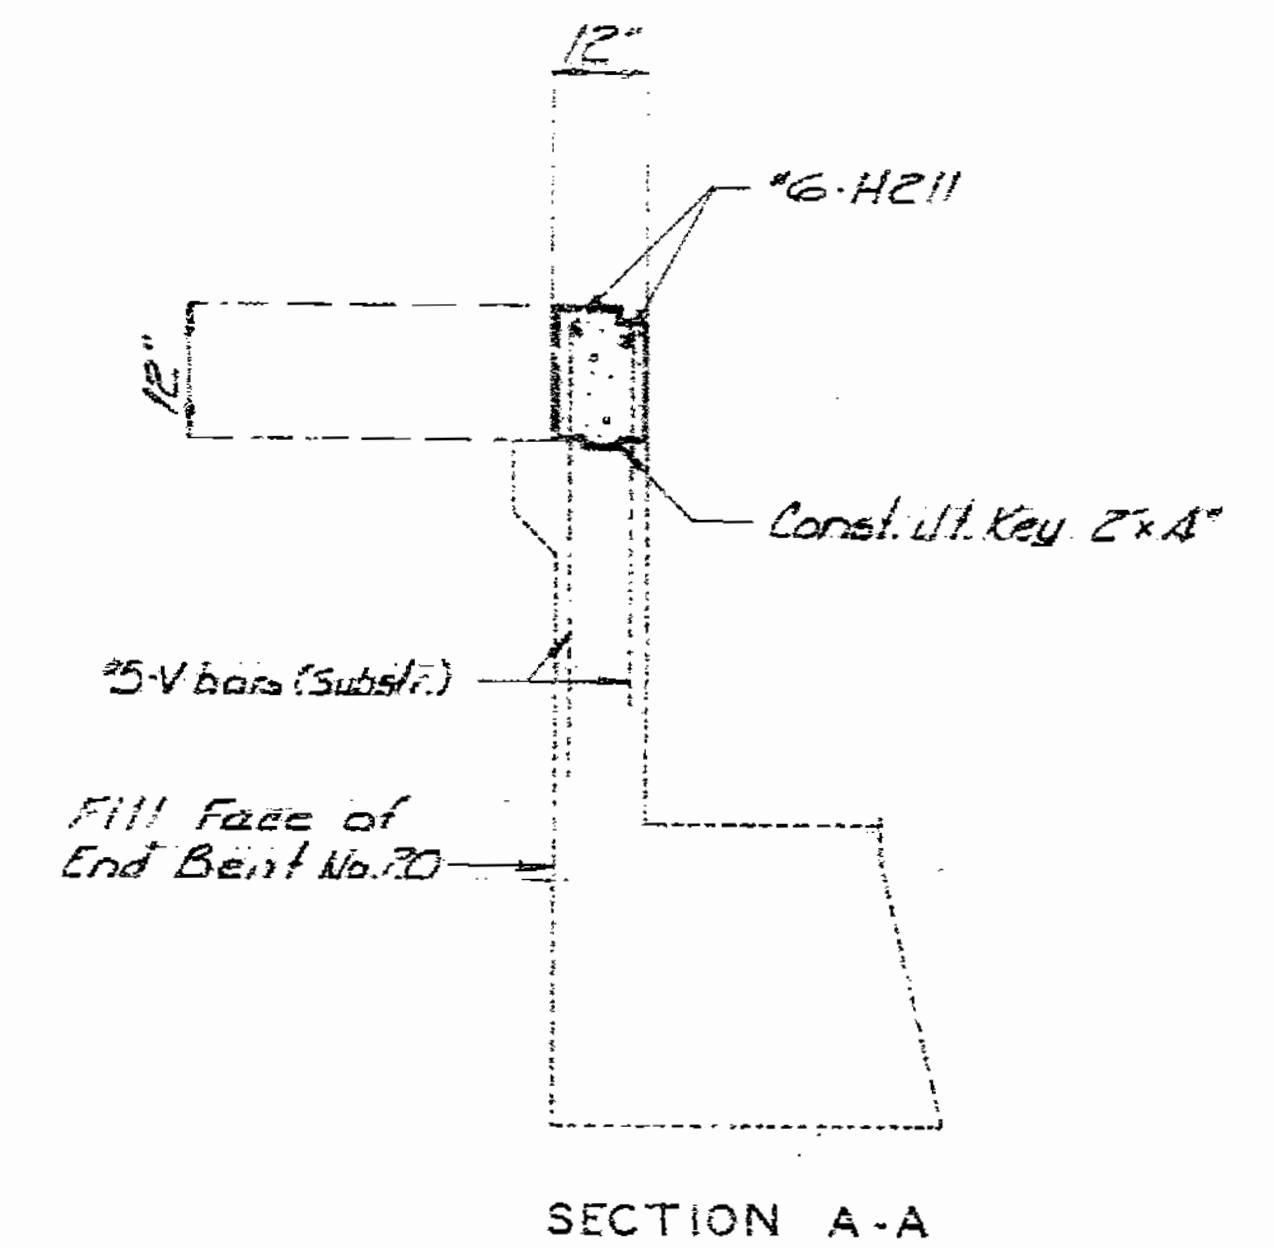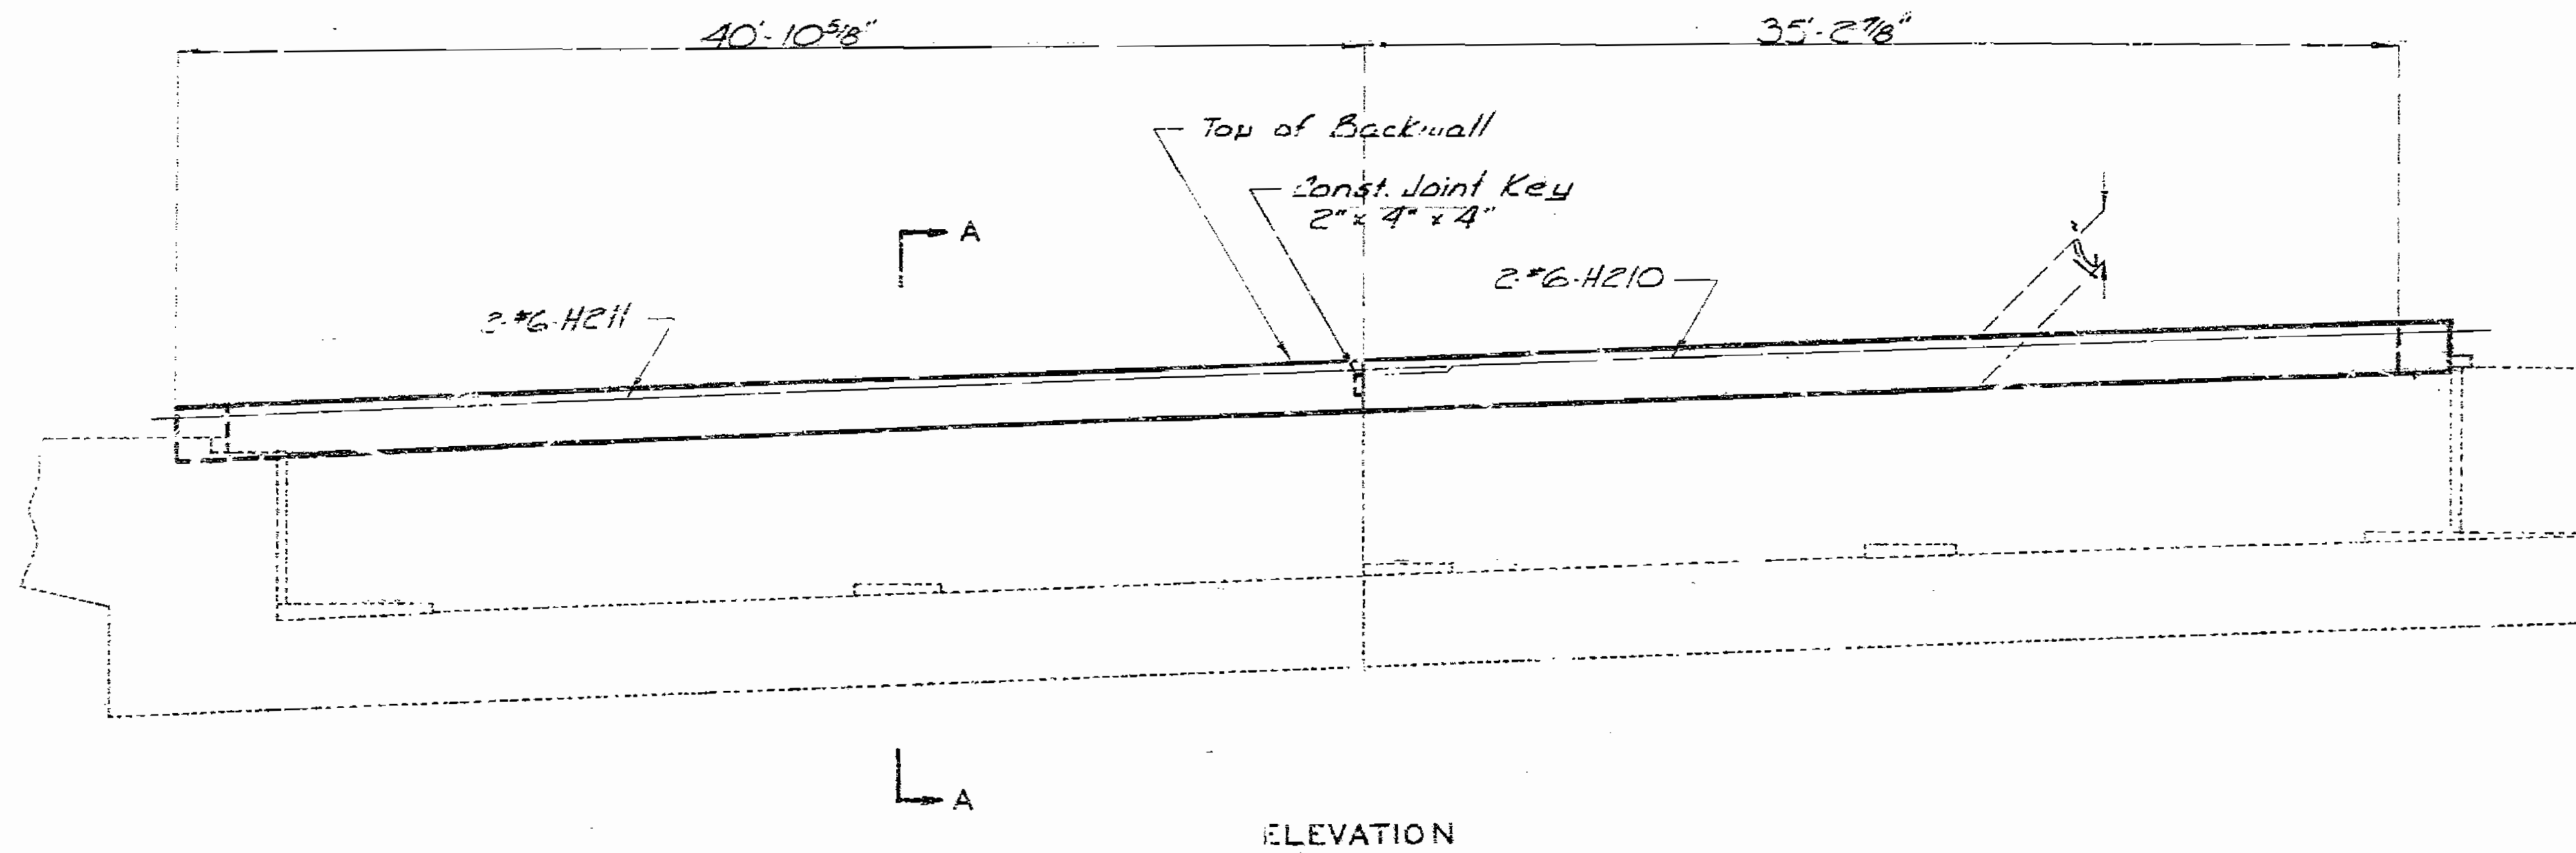

Note: Top of backwall and expansion device for End Bent No. 20 shall conform to the crown of roadway slab. Backwall above upper construction joint shall not be poured until the superstructure slab has been poured in the adjacent span.  
 All concrete shown shall be Class B2, included in Estimated Quantities for Alternate Slabs.  
 Field bending shall be required at wings for H210 & H211 bars in backwall.  
 For details of Bearings at End Bent No. 20 see sheet No. 23.

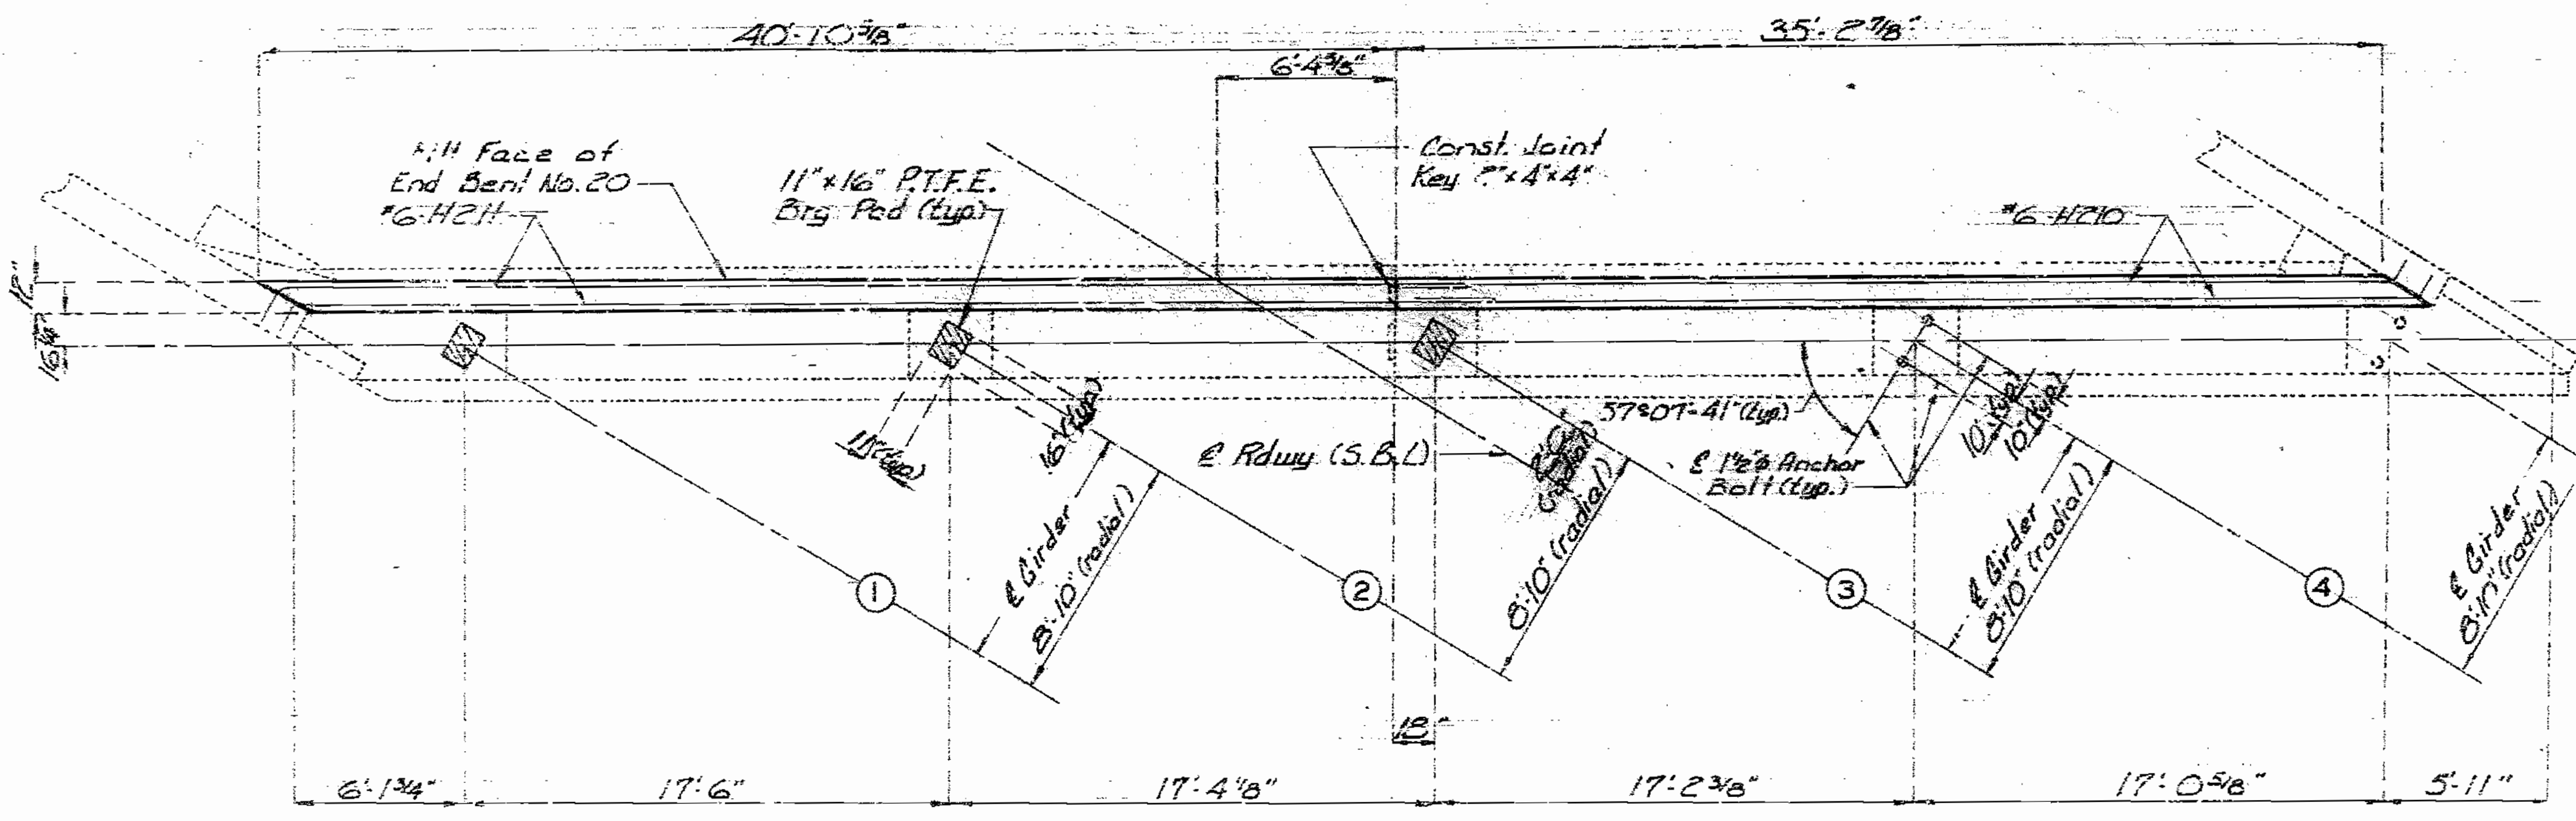

PLAN OF BEAM AND BACKWALL  
 DETAILS OF END BENT NO. 20

DETAILED OCT. 1988  
 CHECKED Nov. 1988


Note: This drawing is not to scale. Follow dimensions.

Sheet No. 19 of 38

JACKSON COUNTY

A-2745

STATE	PROJ. NO.	SHEET NO.
MO		100

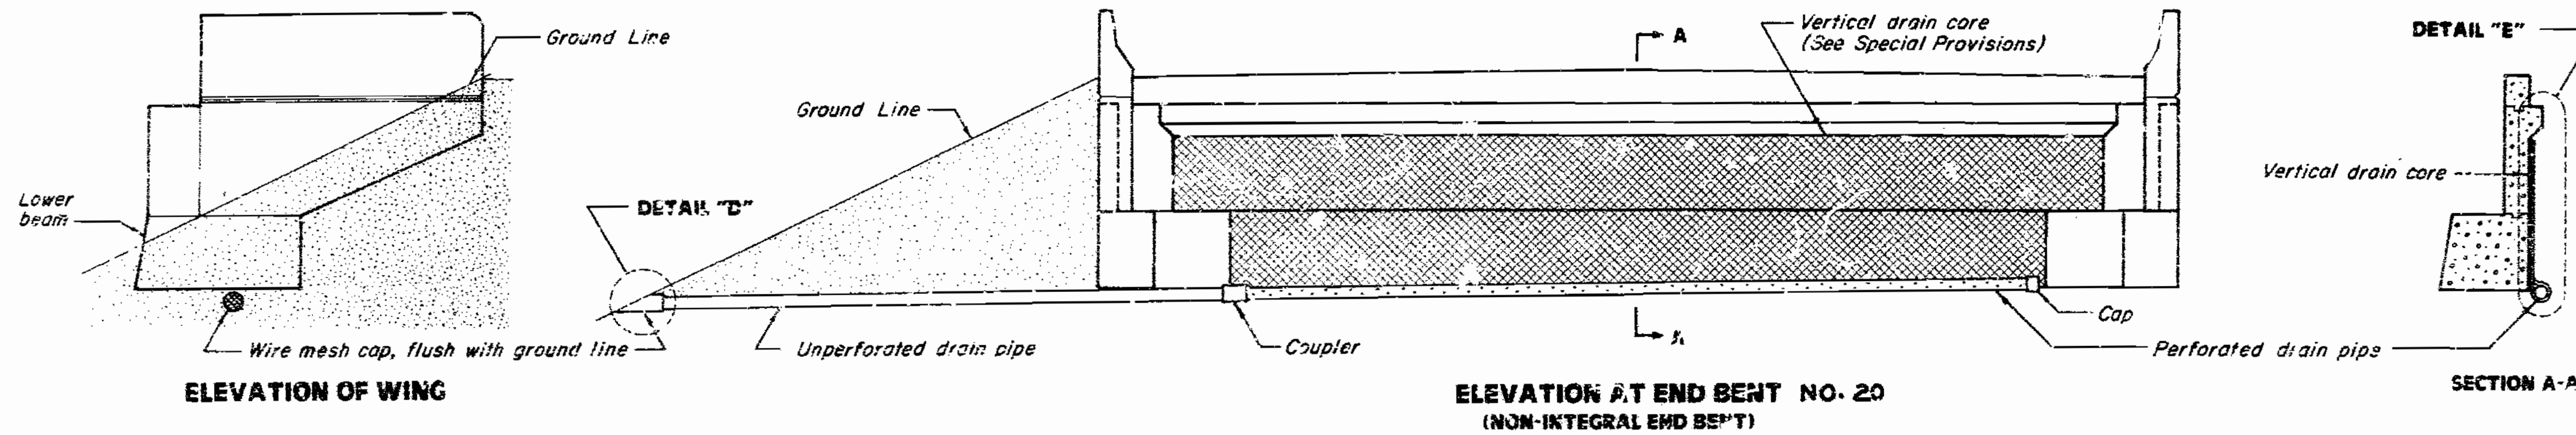


**GENERAL NOTES:**


DRAIN PIPE MAY BE EITHER 6" DIAMETER CORRUGATED METALLIC-COATED STEEL PIPE UNDERDRAIN, 4" DIAMETER CORRUGATED POLY VINYL CHLORIDE (PVC) DRAIN PIPE OR 6" DIAMETER CORRUGATED POLYETHYLENE (PE) DRAIN PIPE

PLACE DRAIN PIPE AT FULL FACE OF END BENT AND SLOPE TO LOWEST GRADE OF GROUND LINE, ALSO MISSING THE LOWER BEAM OF END BENT BY 1/4". (SEE ELEVATION AT END BENT)

PERFORATED PIPE SHALL BE PLACED AT FULL FACE SIDE AT THE BOTTOM OF END BENT AND PLAIN PIPE SHALL BE USED WHERE THE VERTICAL DRAIN ENDS TO THE EXIT AT GROUND LINE.

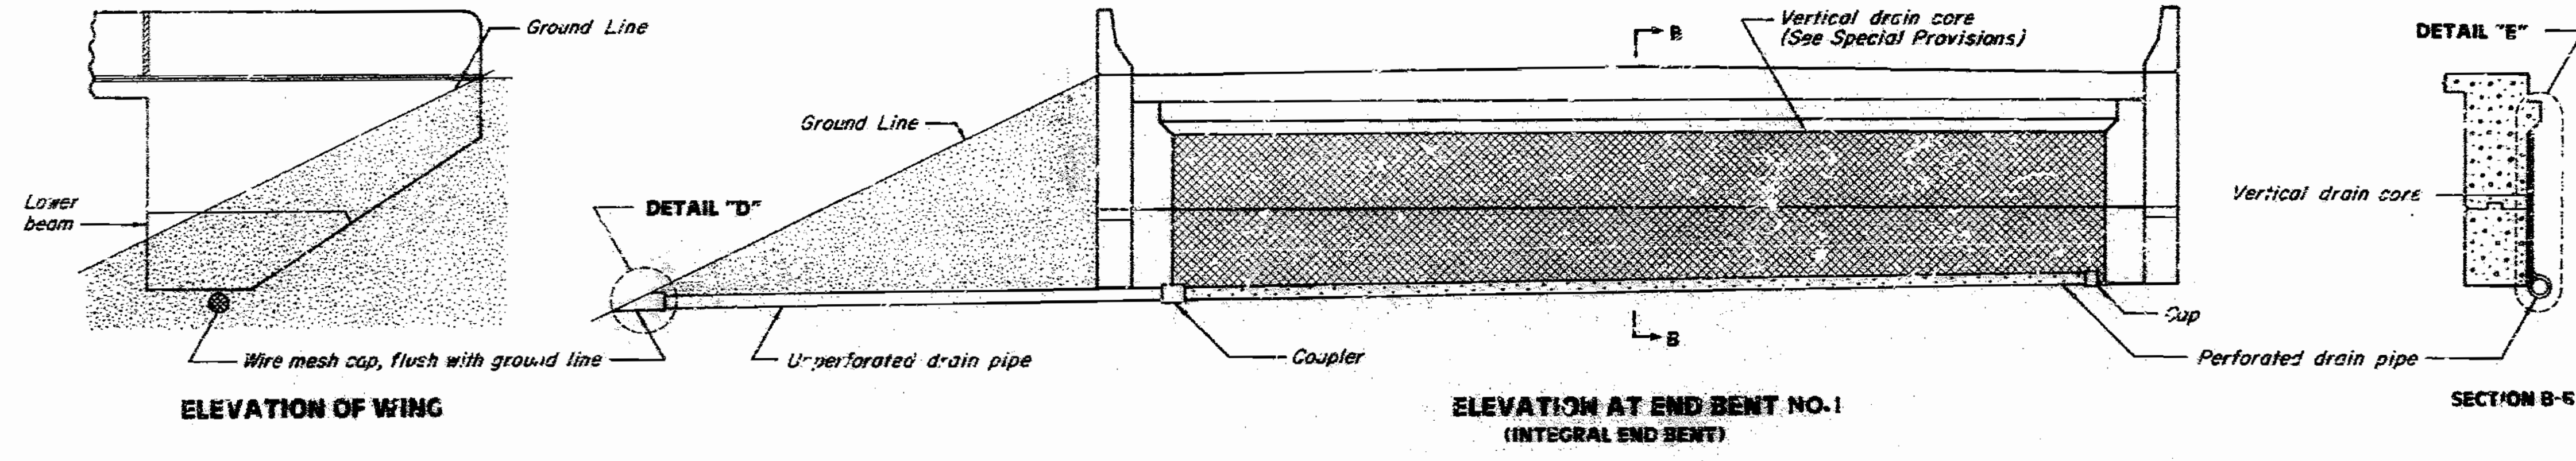

148 115

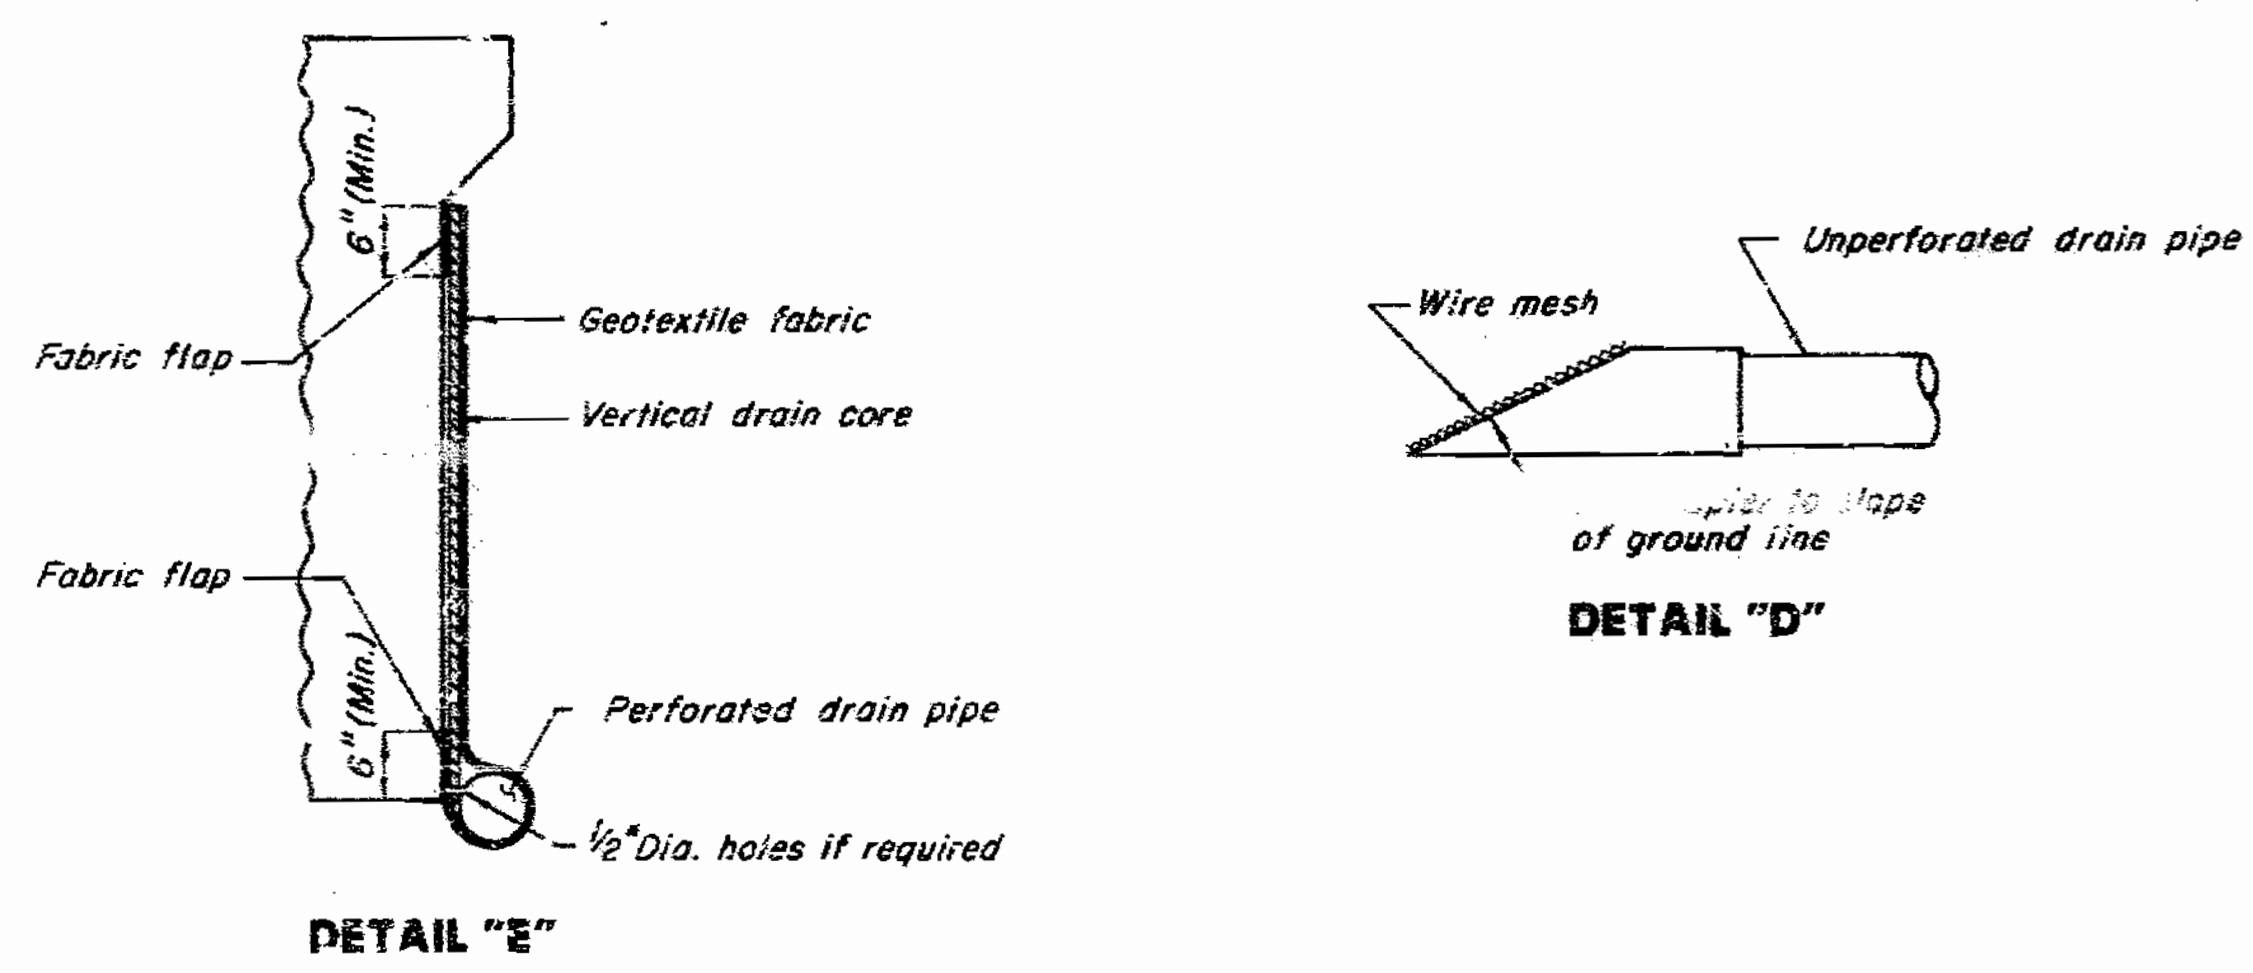


**VERTICAL DRAIN AT END BENTS**

Vert. Drain	Revised	MAR. 1987
MARCH 1983		



DETAILED March 1988  
 CHECKED Feb. 1989

Note: This drawing is not to scale. Allow dimensions.

STATE	PROJ. NO.	SHEET NO.
MO.		101

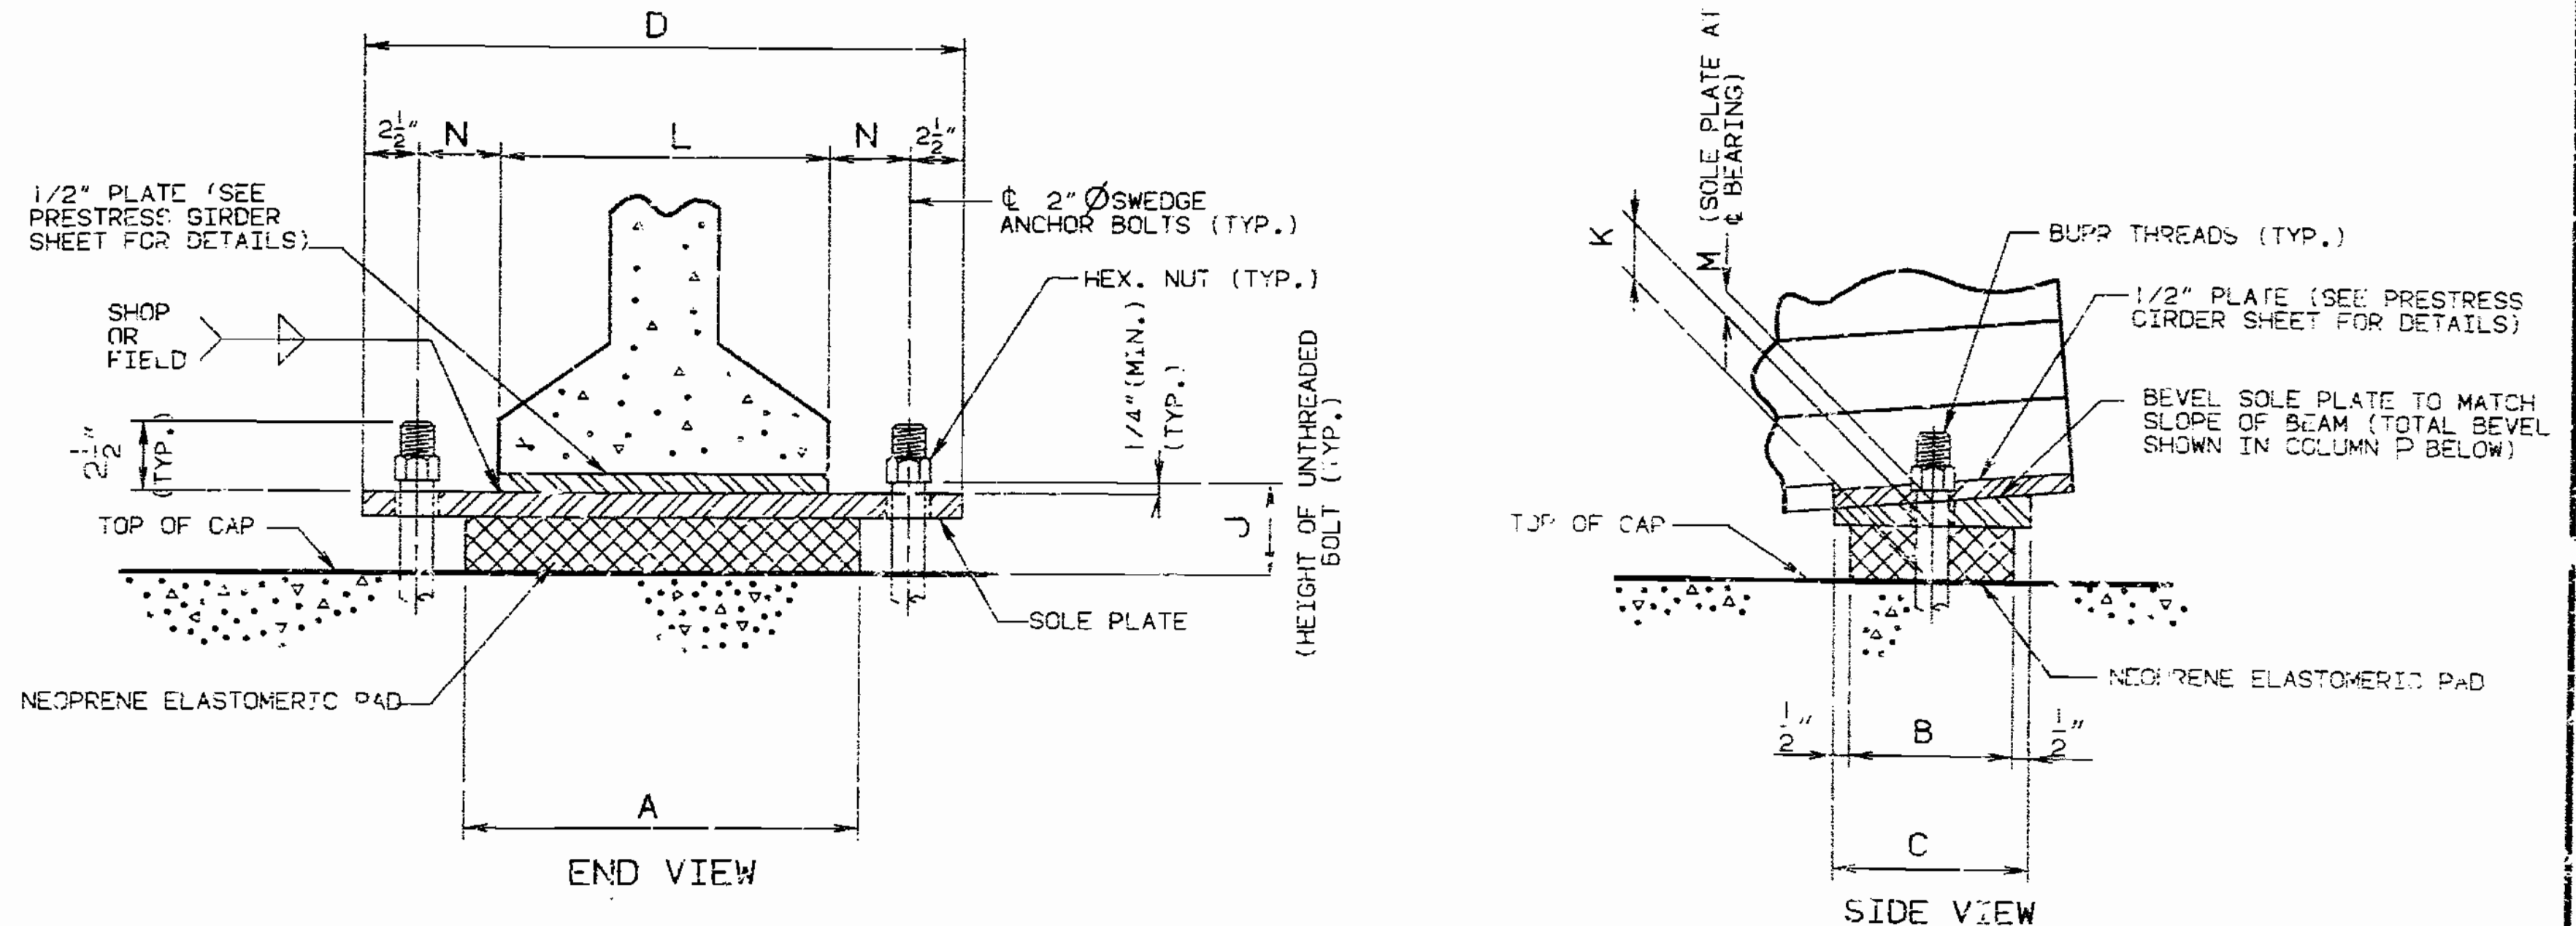

NOTE: THE LOCATION OF ANCHOR BOLTS IN RELATION TO THE SLOTTED HOLES IN THE SOLE PLATE SHALL CORRESPOND WITH THE TEMPERATURE AT THE TIME OF ERECTION. AT 60° F. THE SLOTTED HOLES SHOULD CENTER ON THE ANCHOR BOLTS.

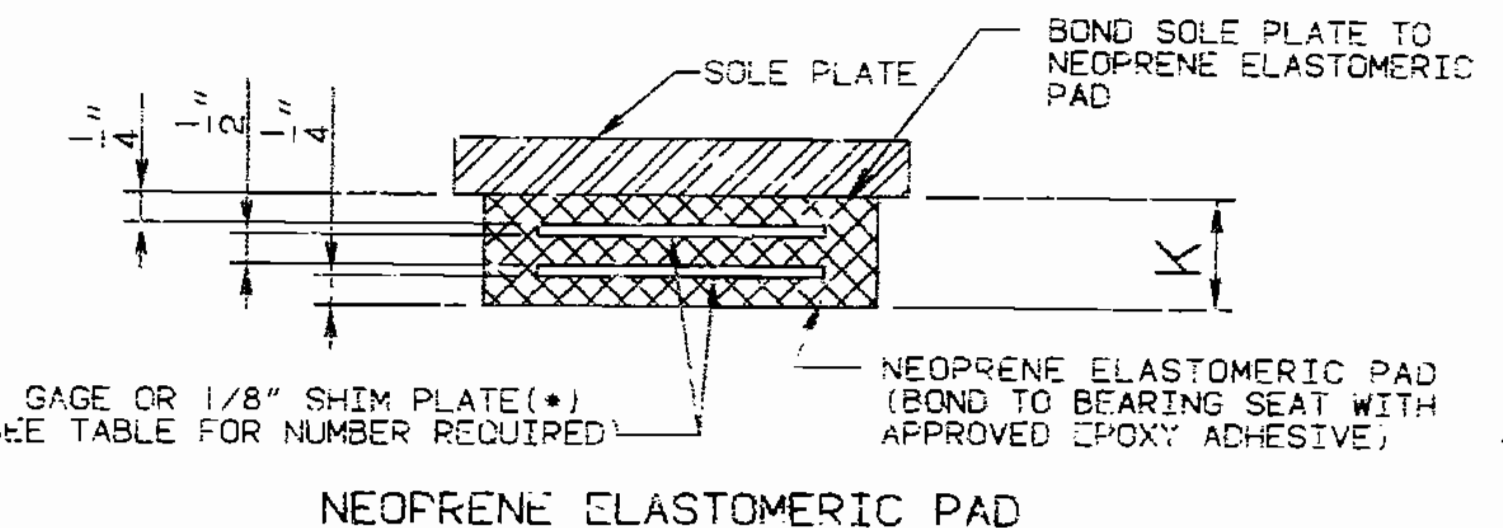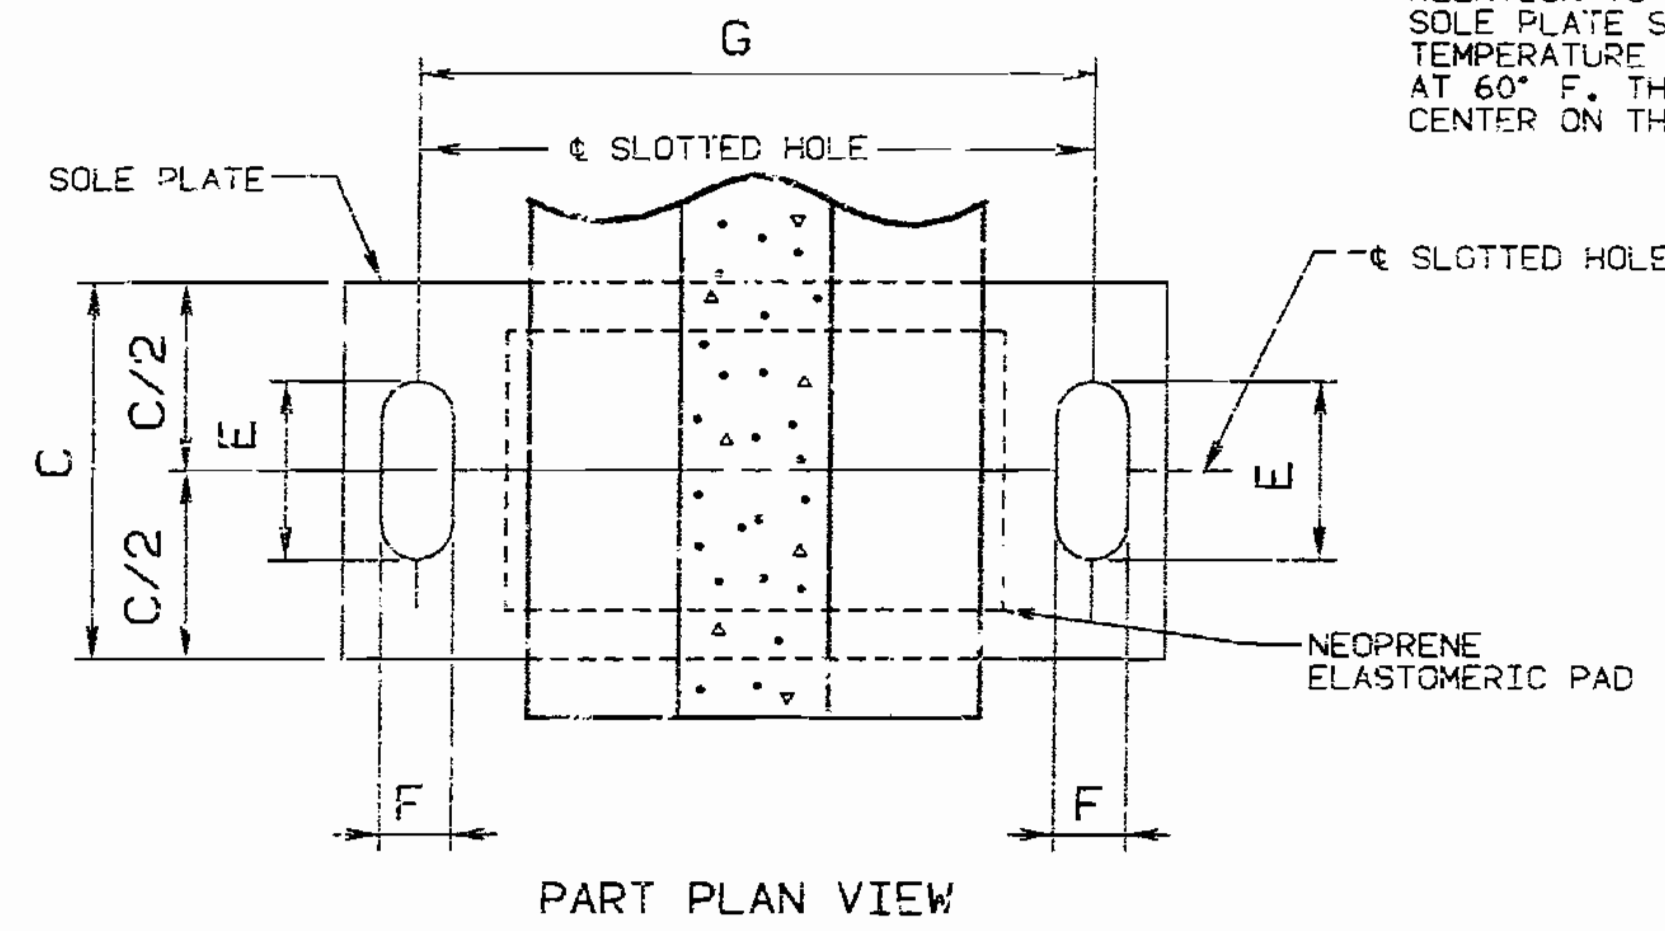

GENERAL NOTES:

- ANCHOR BOLTS SHALL BE 2" Ø A588 STEEL SWEDGED BOLTS AND SHALL EXTEND 18" INTO THE CONCRETE WITH A194-2, 2H OR A563-C, C3, D, DH, DH3 HEAVY HEXAGON NUTS. ACTUAL MANUFACTURER'S CERTIFIED MILL TEST REPORTS (CHEMICAL AND MECHANICAL) SHALL BE PROVIDED. (SWEDGING SHALL BE 1" LESS THAN THE EXTENSION INTO THE CONCRETE.)
- ALL STRUCTURAL STEEL FOR THE SOLE PLATE, ANCHOR BOLTS AND THE HEAVY HEXAGON NUTS SHALL BE PAINTED WITH 2 COATS (5 MILS MIN.) OF INORGANIC ZINC. WELD AREAS TO BE TOUCHED UP AFTER ASSEMBLY.
- THE NEOPRENE ELASTOMERIC PADS SHALL BE 60 DUROMETER.
- THE SOLE PLATE SHALL BE FURNISHED WITH THE BEARING ANCHOR FIELD OR SHOP WELDED TO THE GIRDERS.
- STRUCTURAL STEEL FOR THE SOLE PLATE SHALL BE A-36.
- PAYMENT FOR THE SOLE PLATE WILL BE INCLUDED IN THE COST OF THE BEARING ASSEMBLY, SEE SPECIAL PROVISIONS.
- THE ACCEPTED QUANTITY OF THE ELASTOMERIC BEARING ASSEMBLIES, COMPLETE-IN-PLACE, WILL BE PAID FOR AT THE CONTRACT UNIT PRICE FOR LAMINATED NEOPRENE BEARING PADS, EACH.
- WEIGHT OF THE ANCHOR BOLTS AND HEAVY HEXAGON NUTS FOR BEARINGS SHALL BE INCLUDED IN THE WEIGHT OF FABRICATED STRUCTURAL STEEL.

SPAN (3-4)  
SPAN (4-5)  
SPAN (16-17)

EXPANSION BEARINGS															NUMBER OF SHIM PLATES (*)	NUMBER REQUIRED
BENT NO.	A	B	C	D	E	F	G	J	K	L	M	N	P			
4	18"	12"	13"	33"	5 1/4"	2 1/8"	28"	6 1/8"	4 3/8"	24"	1 1/2"	2"	-	7	5	
4	18"	12"	13"	33"	5"	2 1/8"	28"	5 1/2"	3 3/4"	24"	1 1/2"	2"	-	6	5	
9	18"	12"	13"	33"	5"	2 1/5"	28"	5 1/2"	3 3/4"	24"	1 1/2"	2"	-	6	10	
13	18"	12"	13"	33"	5"	2 1/8"	28"	5 1/2"	3 3/4"	24"	1 1/2"	2"	-	6	10	
17	18"	12"	13"	33"	5"	2 1/8"	28"	5 1/2"	3 3/4"	24"	1 1/2"	2"	-	6	5	
														TOTAL BEARINGS	35	

(\*) THE REQUIRED SHIM PLATE SHALL BE PLACED BETWEEN EQUAL LAYERS OF ELASTOMERIC AND MOLDED TOGETHER TO FORM AN INTEGRAL UNIT.

DETAIL OF LAMINATED NEOPRENE BEARINGS FOR PRESTRESS GIRDERS

DETAILED AUG. 1988  
CHECKED MARCH 1989

NOTE: THIS DRAWING IS NOT TO SCALE. FOLLOW DIMENSIONS.





SHEET NO. 21 OF 58.

JACKSON COUNTY




A-2745



STATE	PROJ NO	SHEET NO
MO		102

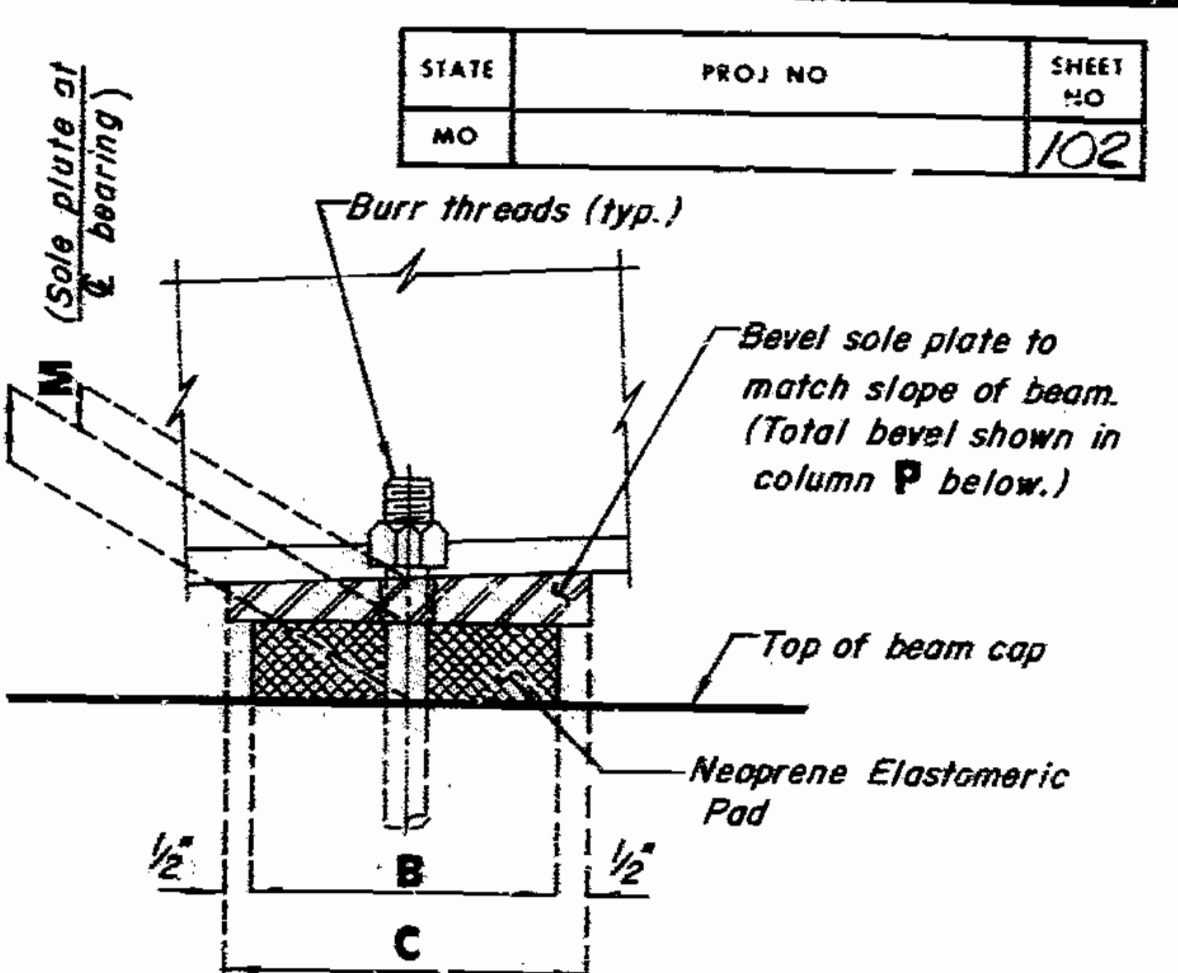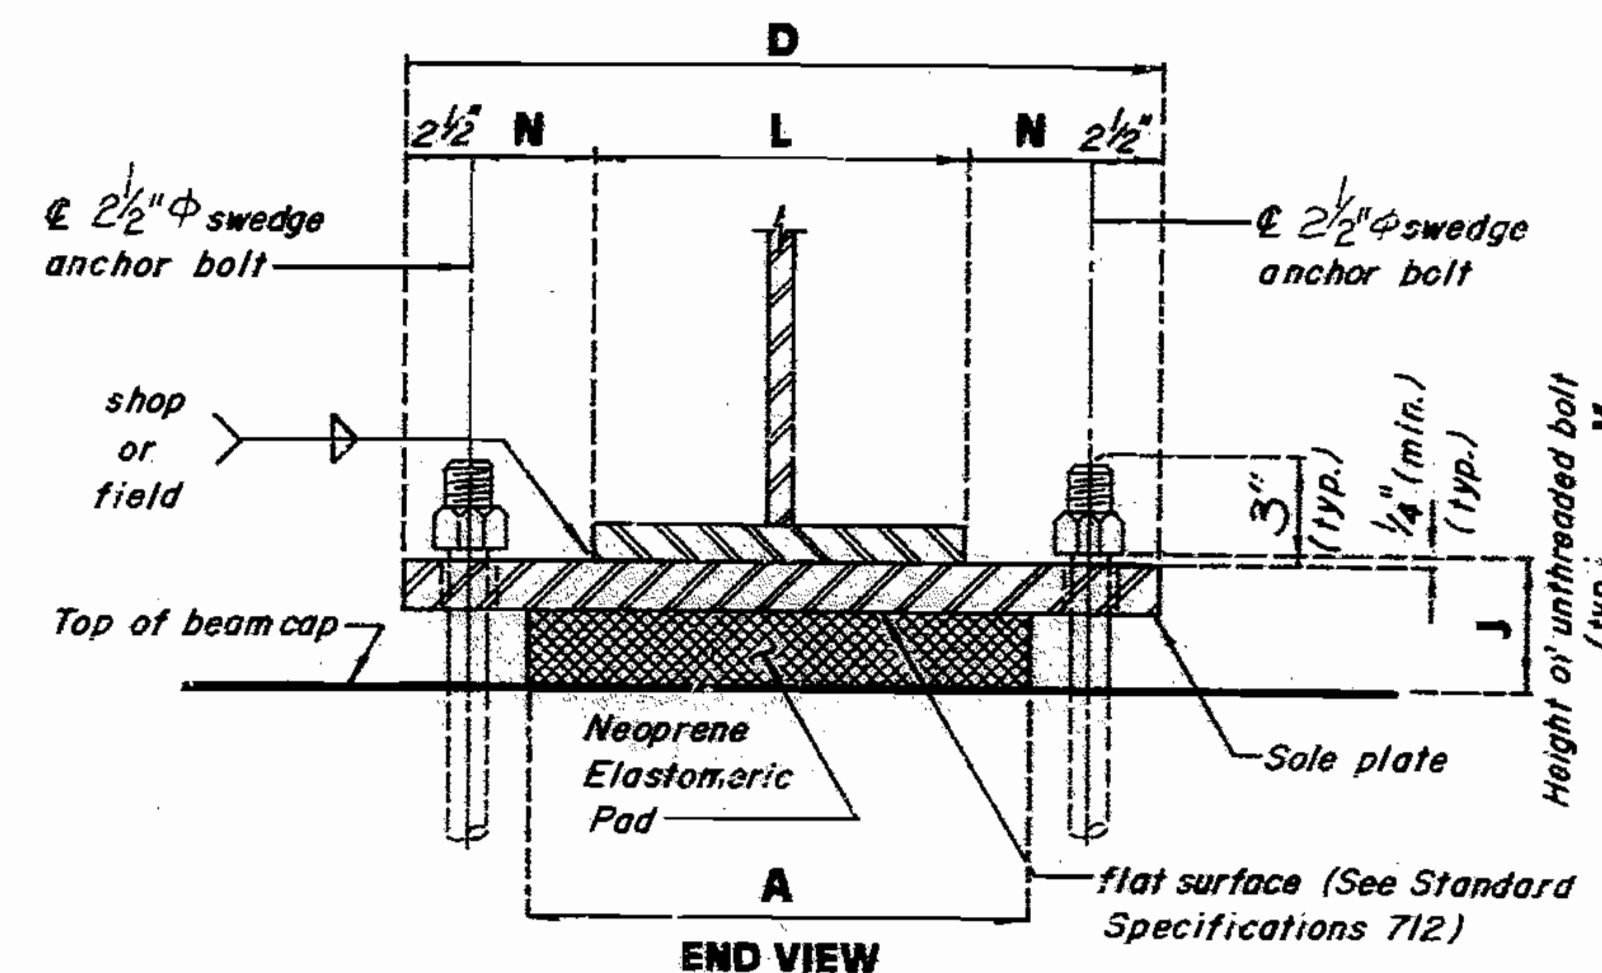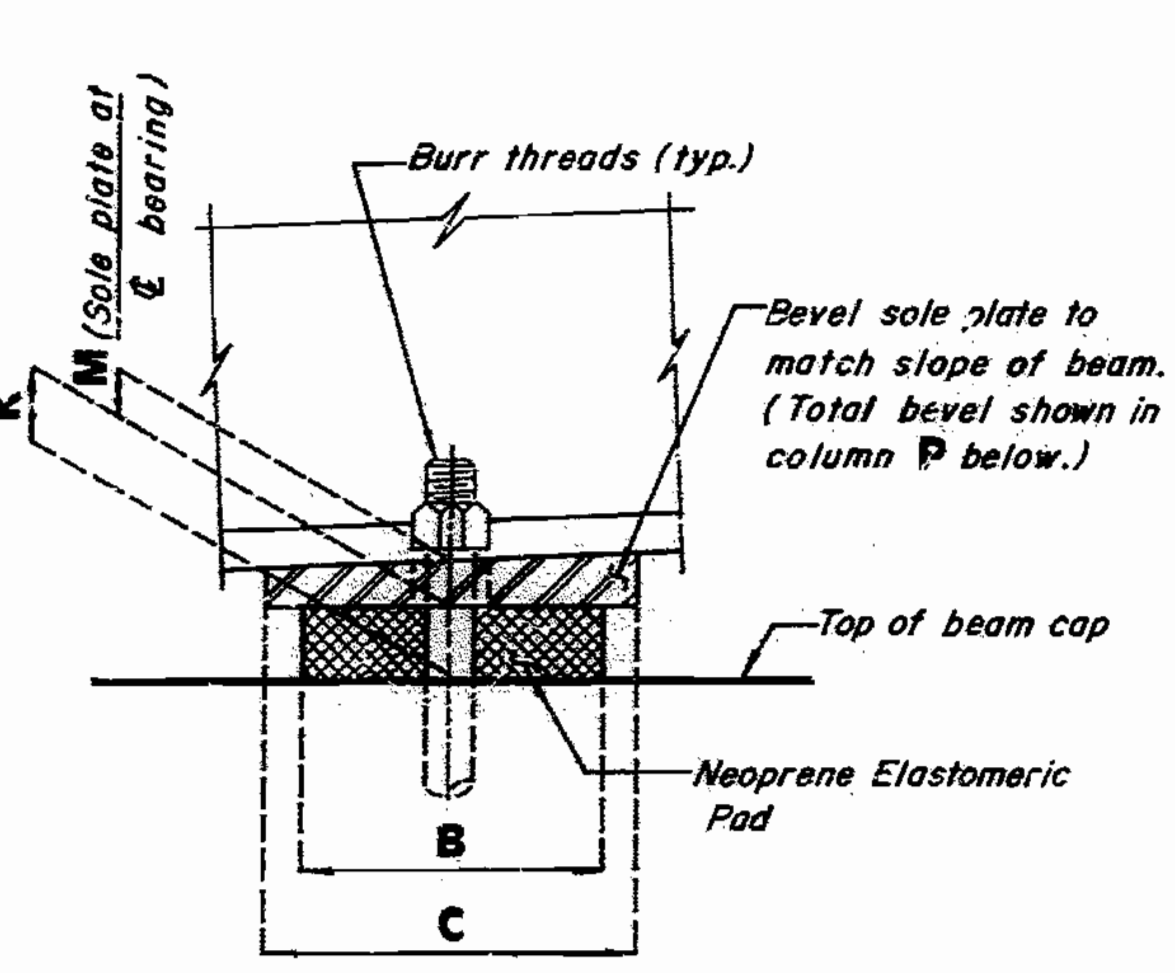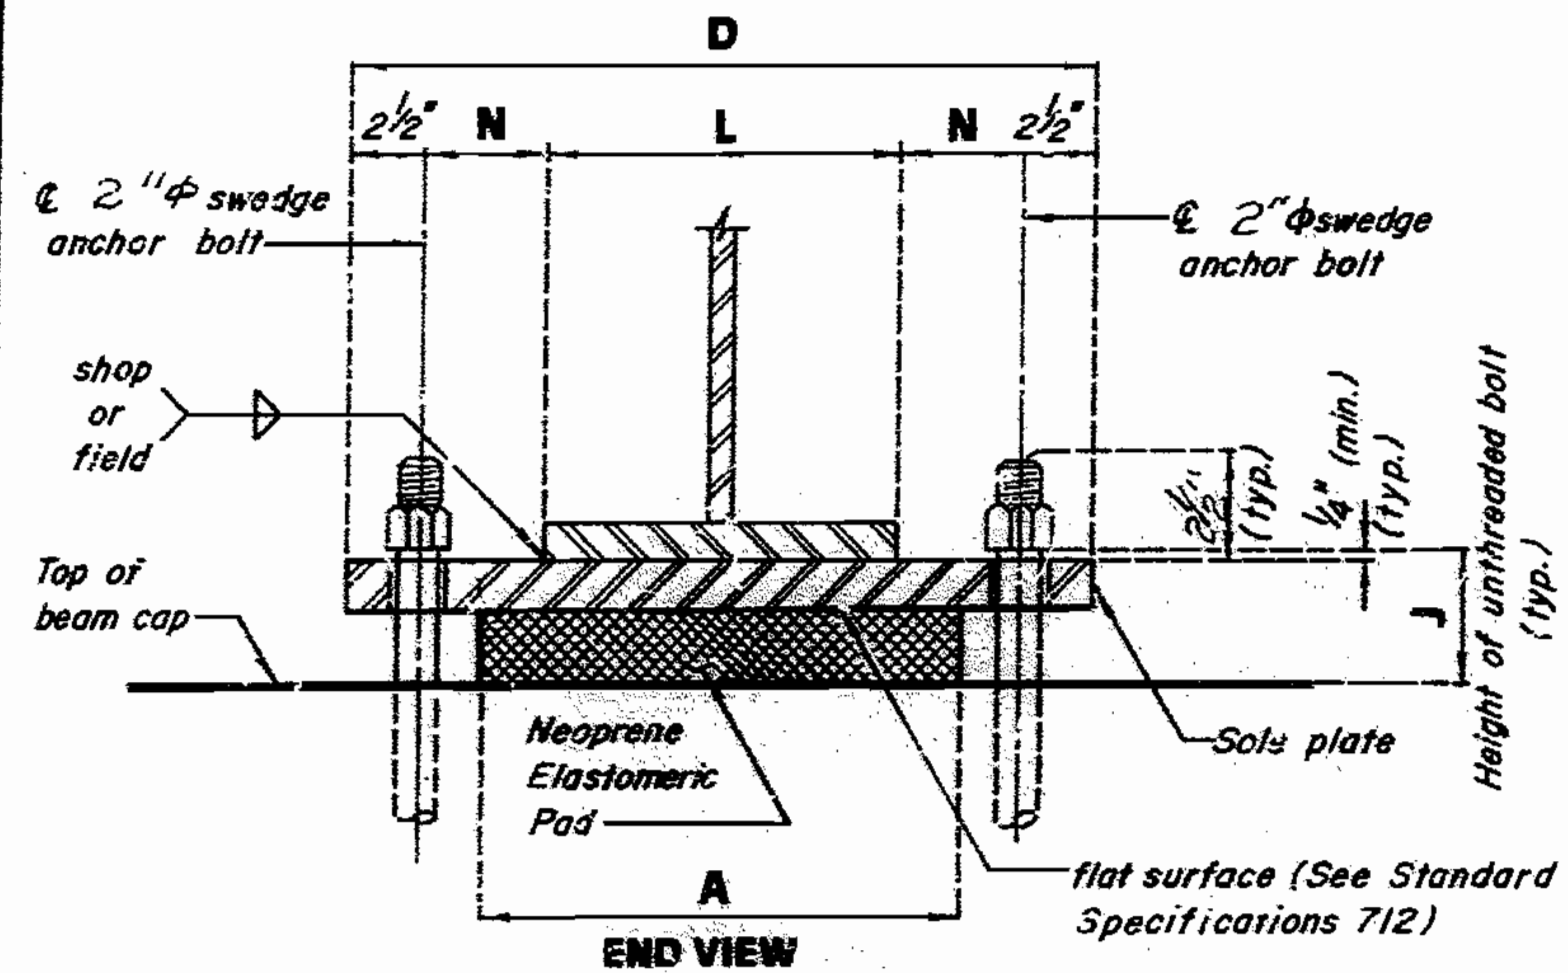

Note: The location of anchor bolts in relation to the slotted holes in the sole plate shall correspond with the temperature at the time of erection. At 60° F. the slotted holes should center on the anchor bolts.

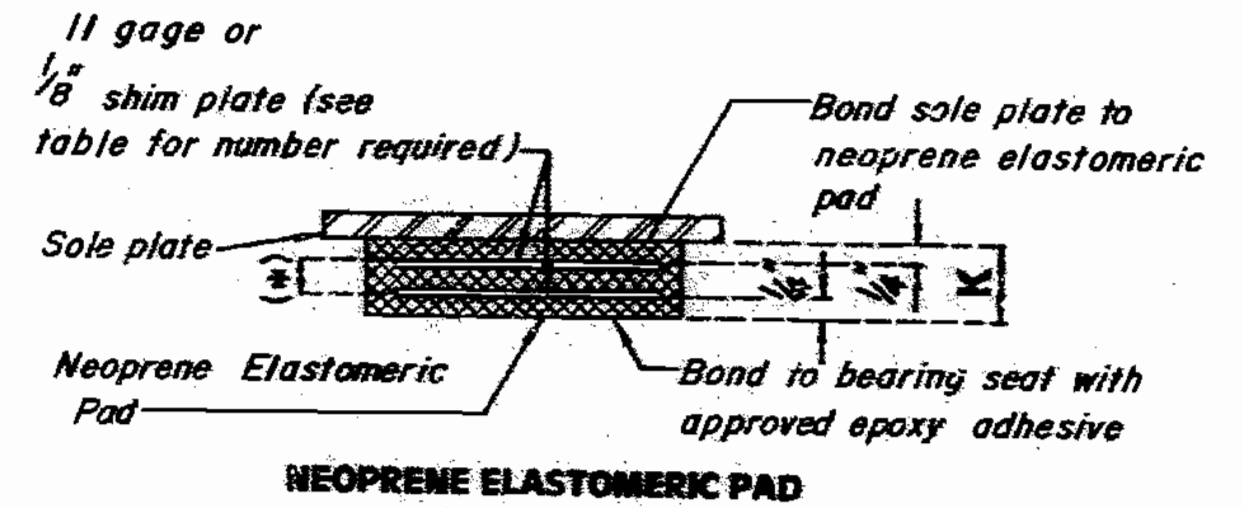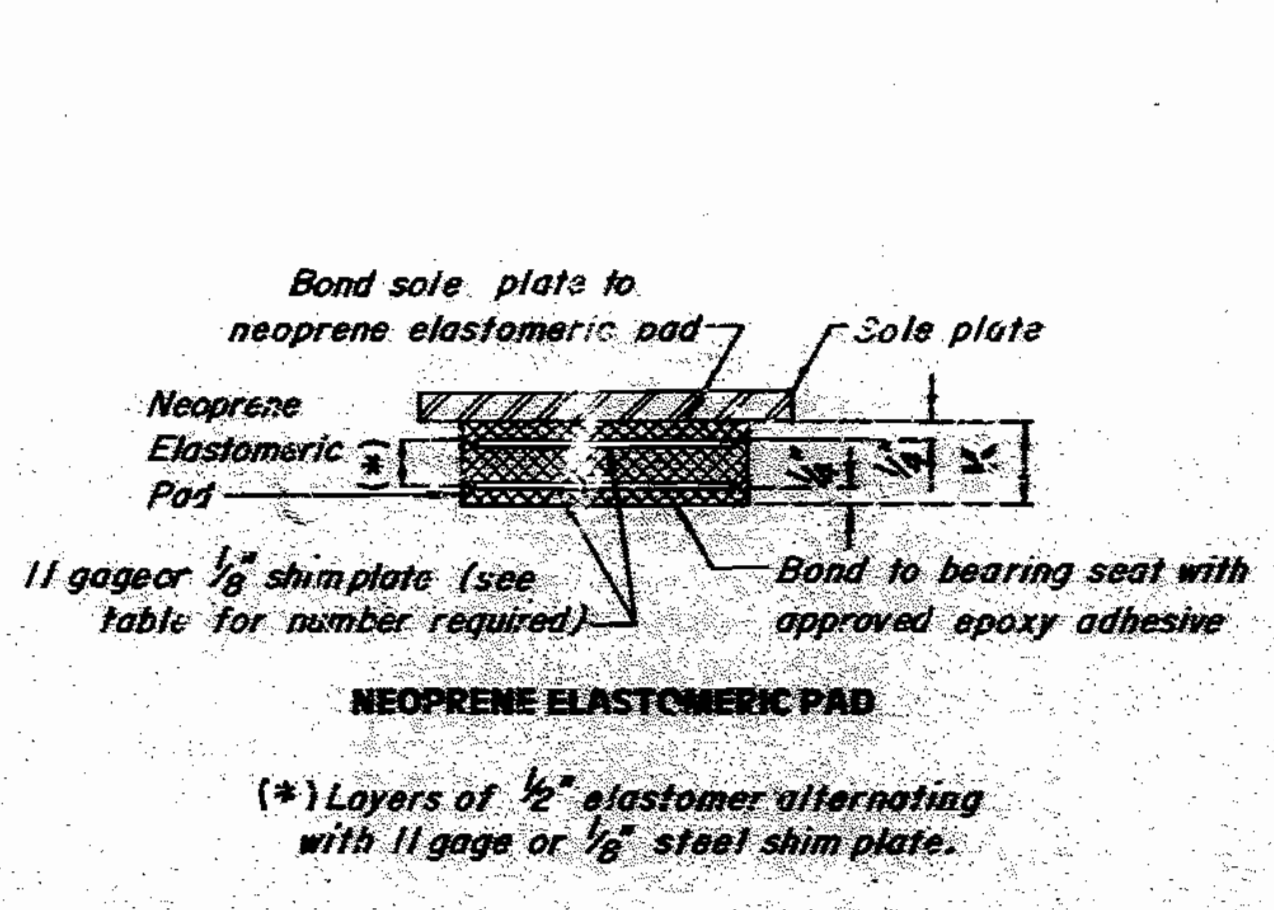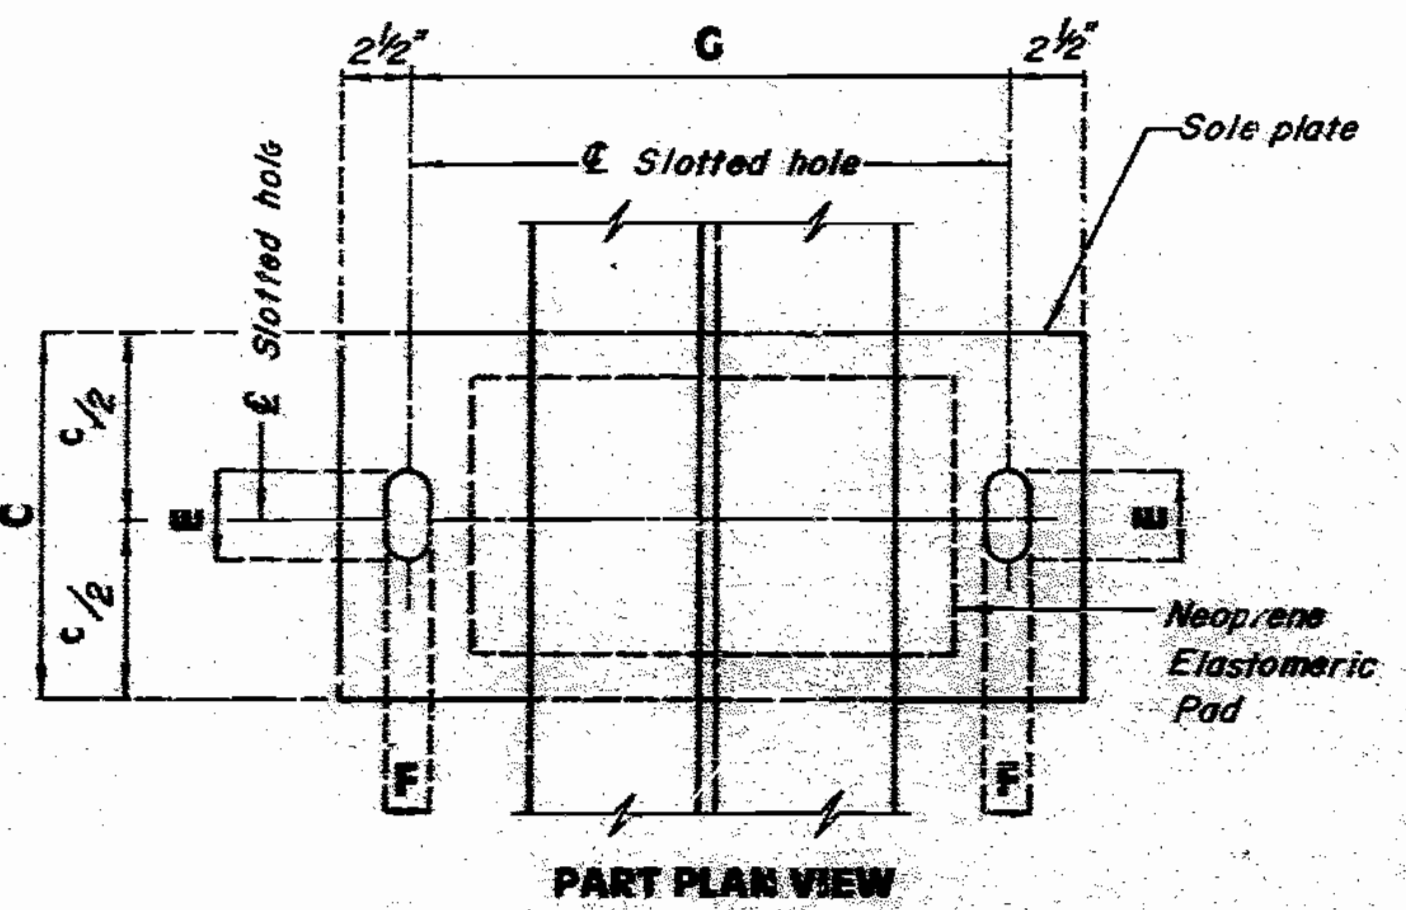

(\* ) Layers of 1/2" elastomer alternating with 11 gage or 1/8" steel shim plate.

**EXPANSION BEARINGS**

NUMBER REQUIRED = 5 @ Bent No. 17 (Span 17-18)  
5 @ Bent No. 19

- 5 Girders No. 1, 2 & 3 = 17"
- Girder No. 4 = 16"
- Girder No. 5 = 14"

- 6 Girders No. 1, 2 & 3 = 2 1/2"
- Girder No. 4 = 3"
- Girder No. 5 = 4"

\*\* 18" @ Bts. No. 17 & 19  
25" @ Bt. No. 18  
\*\*\* 2" φ @ Bts. No. 17 & 19  
2 1/2" φ @ Bt. No. 18

**FIXED BEARINGS**

NUMBER REQUIRED = 5 @ Bent No. 18

BENT NO.	A	B	C	D	E	F	G	J	K	L	M	N	P	NUMBER OF SHIM PLATES (*)
19	17"	28"	29"	27"	5"	2 1/8"	22"	5 1/16"	3 3/4"	3	1 1/16"	4	3 1/8"	6
17	18"	12"	13"	27"	5"	2 1/8"	22"	5 1/2"	3 3/4"	6	1 1/2"	6	-	6

(\*) THE REQUIRED SHIM PLATE SHALL BE PLACED BETWEEN LAYERS OF ELASTOMER AND MOLDED TOGETHER TO FORM AN INTEGRAL UNIT.  
\*\*\* Span (17-18)

- 4 Girders No. 1 = 2 1/2"
- Girder No. 2 = 3"
- Girders No. 3, 4 & 5 = 3 1/2"

- 3 Girders No. 1 = 17"
- Girder No. 2 = 16"
- Girders No. 3, 4 & 5 = 15"

**GENERAL NOTES:**

ANCHOR BOLTS SHALL BE \*\*\* A308 STEEL SWIDGED BOLTS AND SHALL EXTEND INTO THE CONCRETE WITH A194 - 2, 2H OR A563 - C, C1, D, DH, DHS HEAVY HEXAGON NUTS. ACRUAL MANUFACTURER'S CERTIFIED MILL TEST REPORTS (CHEMICAL AND MECHANICAL) SHALL BE PROVIDED. SWIDGING SHALL BE 1" LESS THAN EXTENSION INTO THE CONCRETE.  
ALL STRUCTURAL STEEL FOR THE SOLE PLATE, ANCHOR BOLTS AND HEAVY HEXAGON NUTS SHALL BE PAINTED WITH 2 COATS (5 MILS MIN) OF INORGANIC ZINC. WELD AREAS TO BE TOUCHED UP AFTER ASSEMBLY.  
WEIGHT OF ANCHOR BOLTS AND HEAVY HEXAGON NUTS FOR BEARINGS SHALL BE INCLUDED IN WEIGHT OF THE FABRICATED STRUCTURAL STEEL.  
NEOPRENE ELASTOMERIC PADS SHALL BE CALIBRATED.  
THE SOLE PLATE SHALL BE FURNISHED WITH THE BEARING AND FIELD OR SHOP WELDED TO THE STRINGERS OR GIRDERS.  
STRUCTURAL STEEL FOR SOLE PLATE SHALL BE A-36.  
PAYMENT FOR THE SOLE PLATE WILL BE INCLUDED IN THE COST OF THE BEARING ASSEMBLY. SEE SPECIAL PROVISIONS.  
THE ACCEPTED QUANTITY OF ELASTOMERIC BEARING ASSEMBLIES, COMPLETE IN PLACE, WILL BE PAID FOR AT THE CONTRACT UNIT PRICE FOR LAMINATED NEOPRENE BEARING PADS (STEEL STRUCTURES), EACH.

BENT NO.	A	B	C	D	F	G	J	K	L	M	N	P	NUMBER OF SHIM PLATES (*)
18	20"	34"	35"	31"	2 7/8"	26"	5 7/8"	3 3/4"	1	1 7/8"	2	1/4"	6

(\*) THE REQUIRED SHIM PLATE SHALL BE PLACED BETWEEN LAYERS OF ELASTOMER AND MOLDED TOGETHER TO FORM AN INTEGRAL UNIT.

- 1 Girders No. 1 & 2 = 20"
- Girders No. 3, 4 & 5 = 19"

- 2 Girders No. 1 & 2 = 3"
- Girders No. 3, 4 & 5 = 3 1/2"

**DETAILS OF LAMINATED NEOPRENE BEARINGS (STEEL STRUCTURES)**





Note: This drawing is not to scale. Follow dimensions. Revised 12-1-89

SEE FURTHER PLANS  
Sheet No. 22 of 38





L.A.M. NEOP. BRGS. MARCH 1979  
REVISED OCT. 1987

DETAILED June 1988  
CHECKED Feb 1989

STATE	PROJ NO	SHEET NO
MO		103

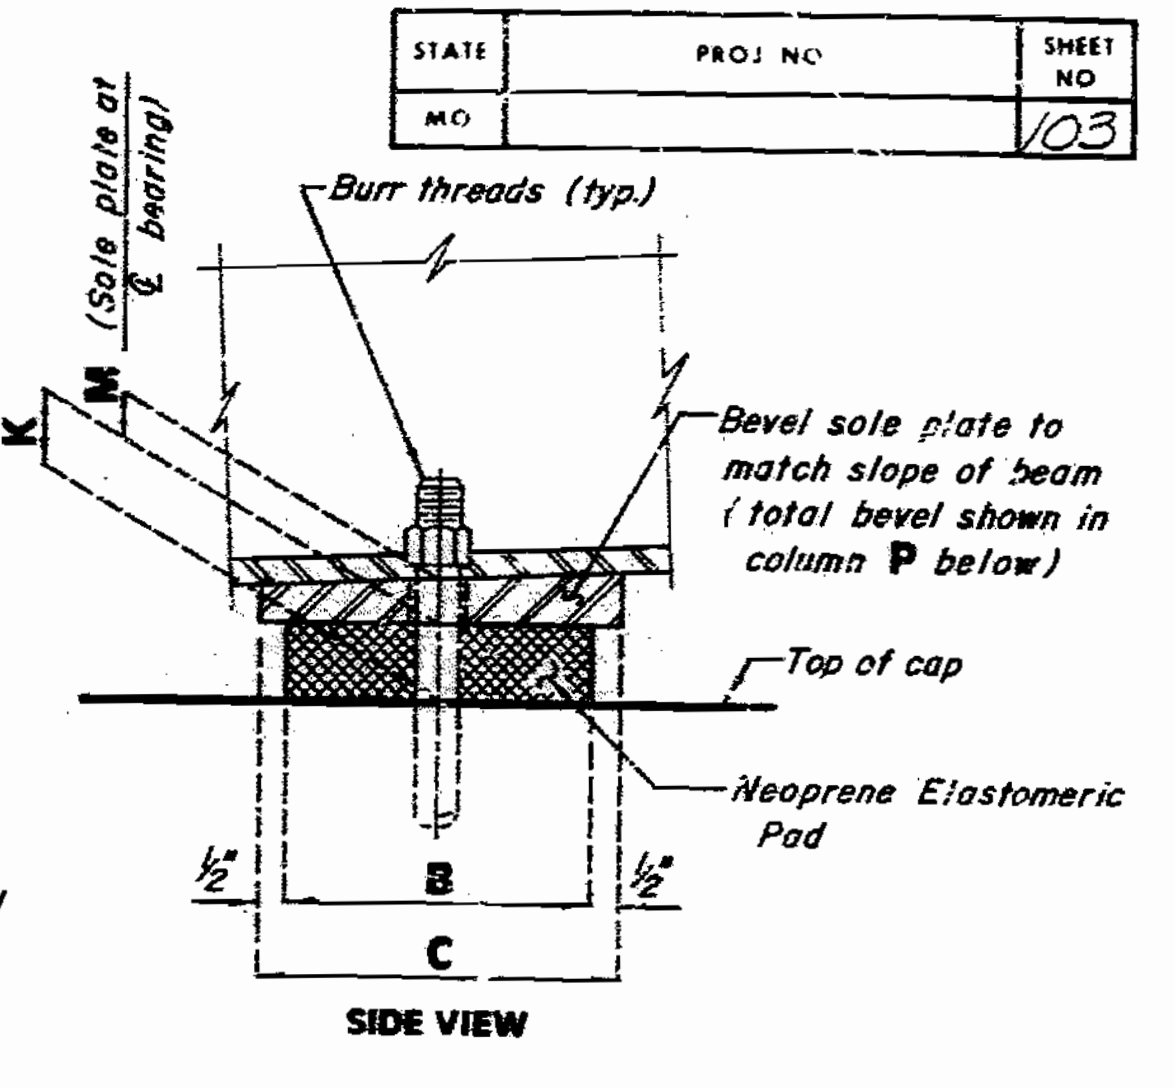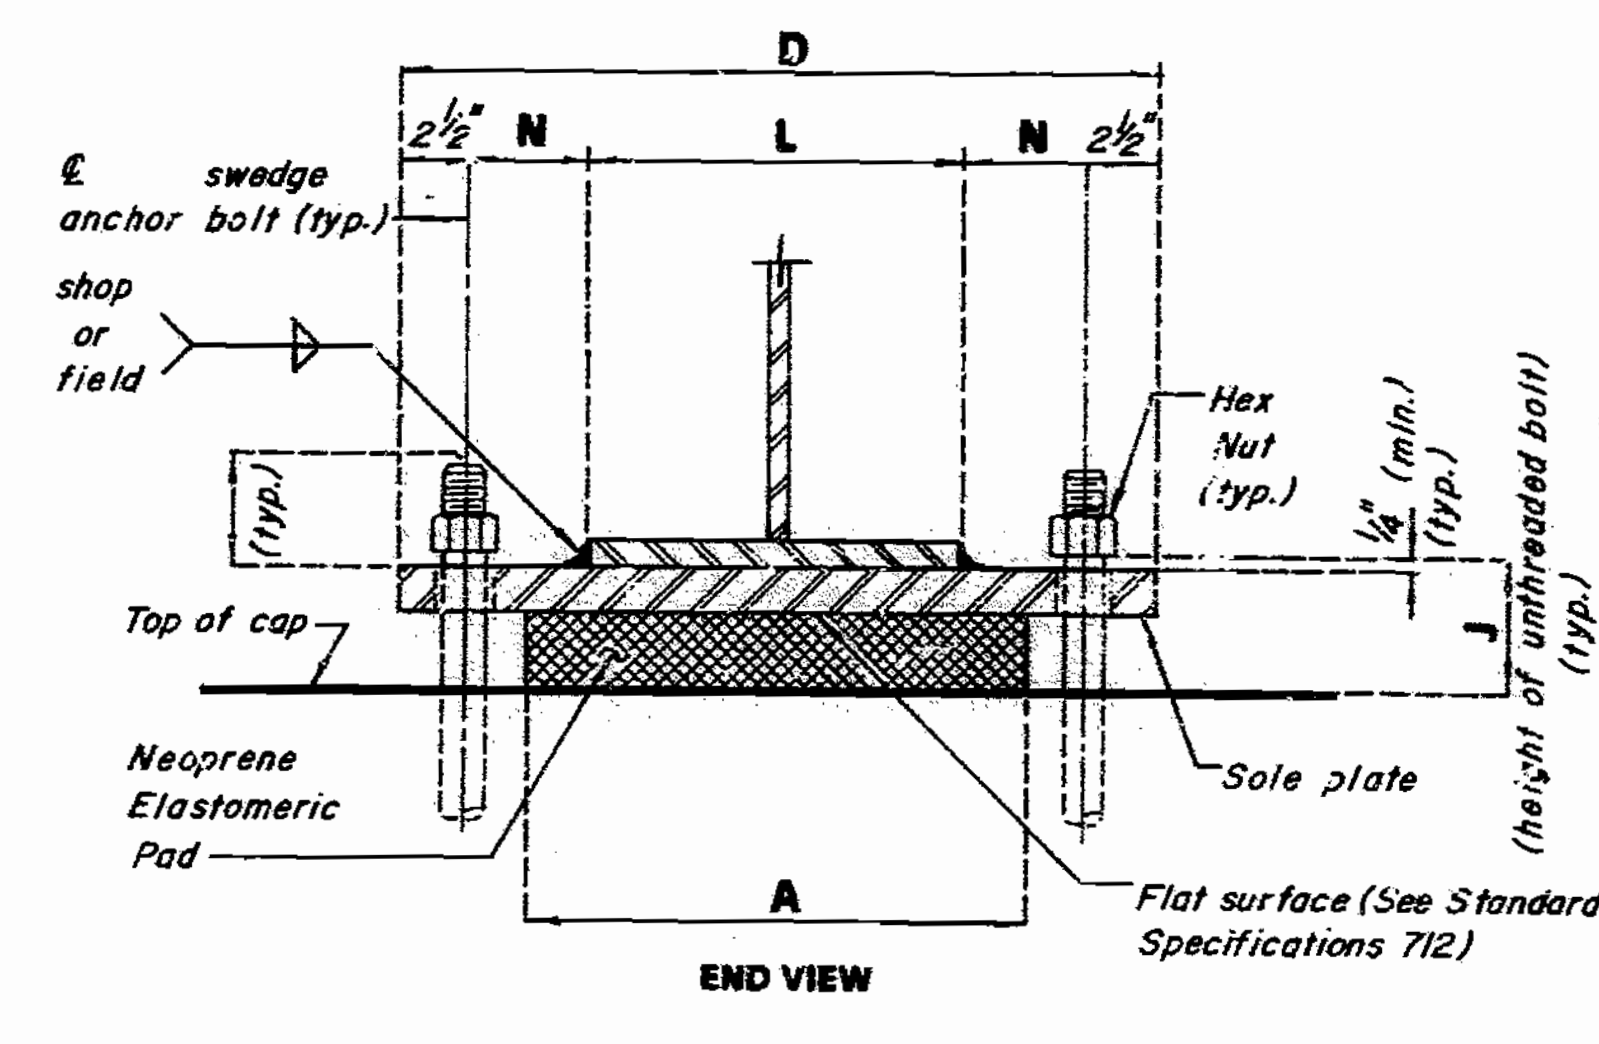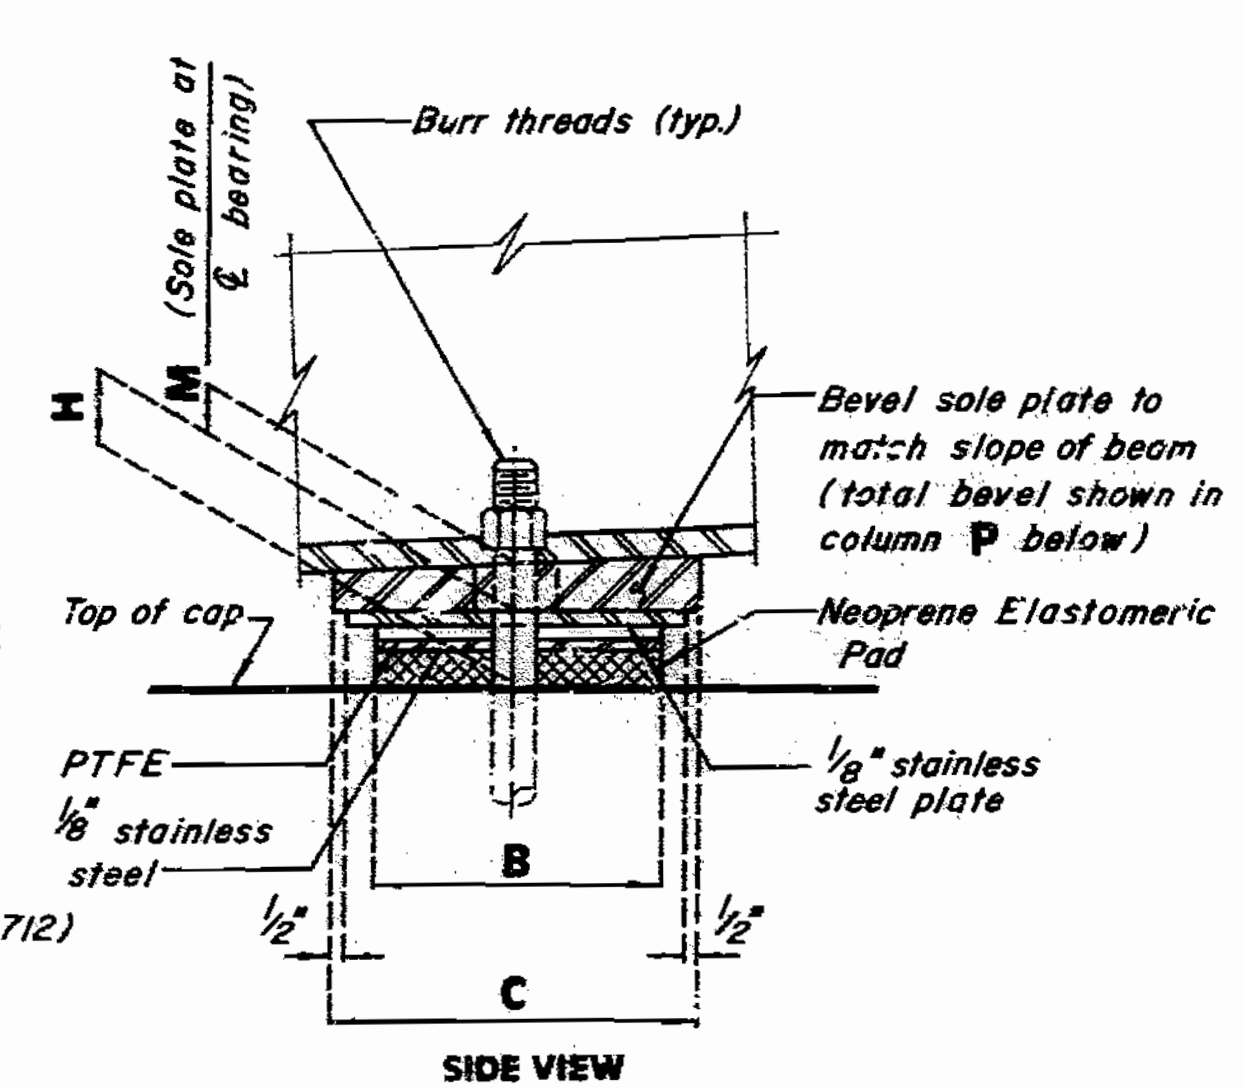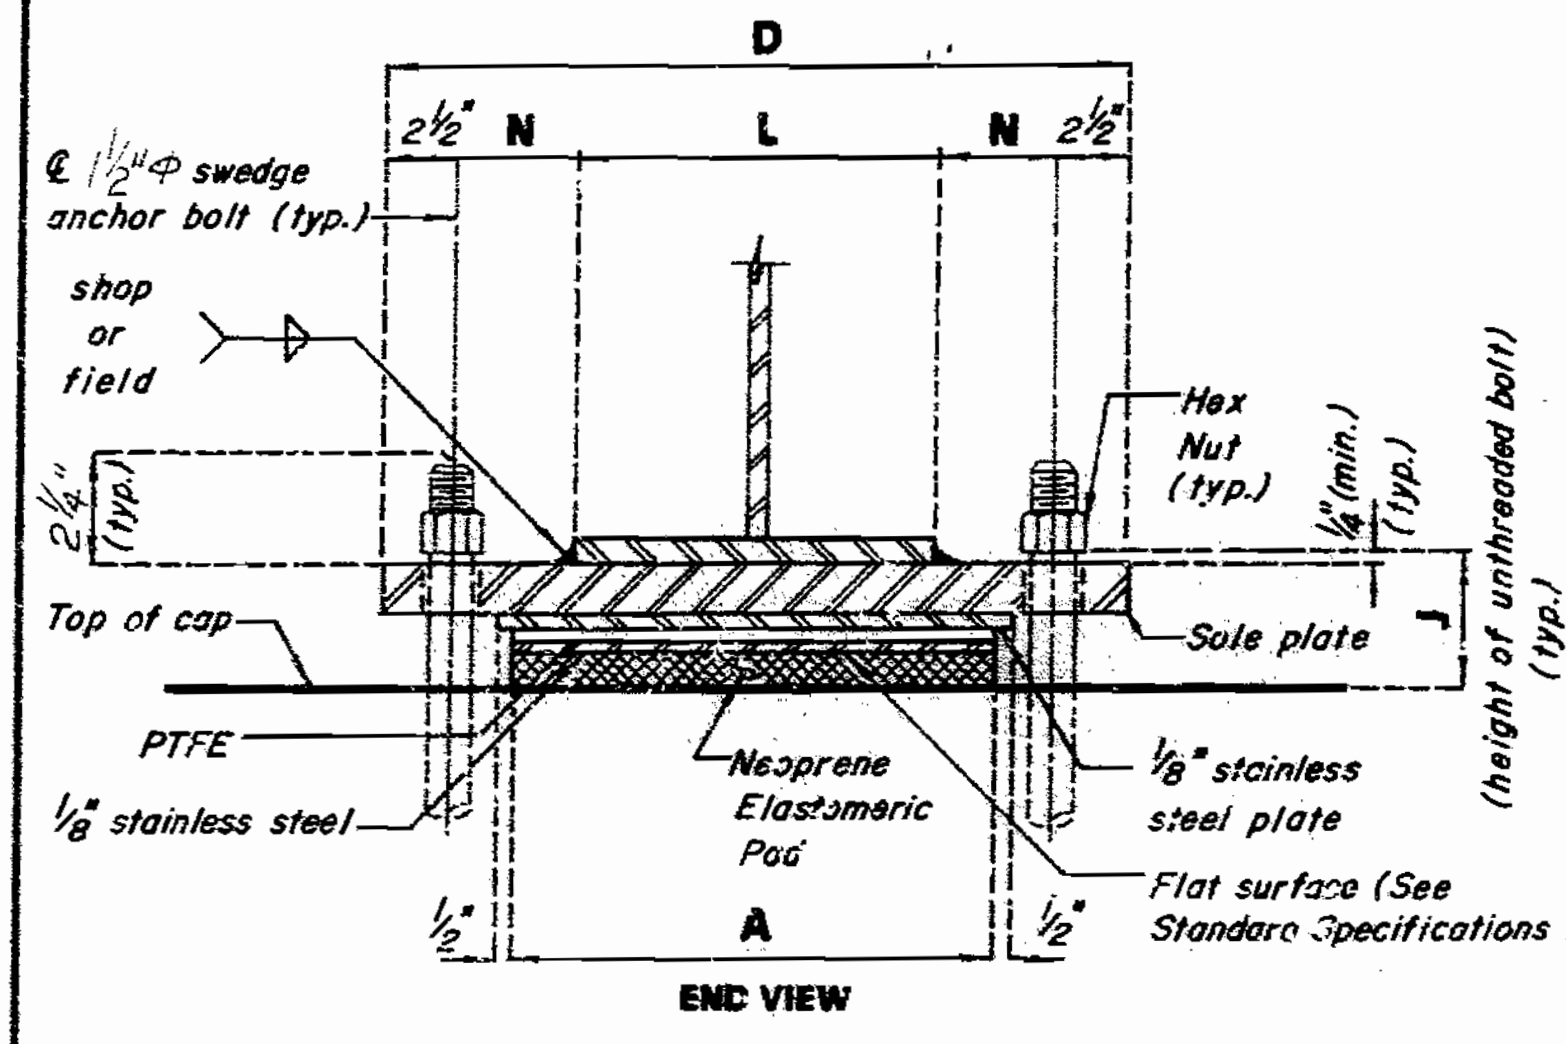

Note: The location of anchor bolts in relation to the slotted holes in the sole plate shall correspond with the temperature at the time of erection. At 60° F. the slotted holes should center on the anchor bolts.

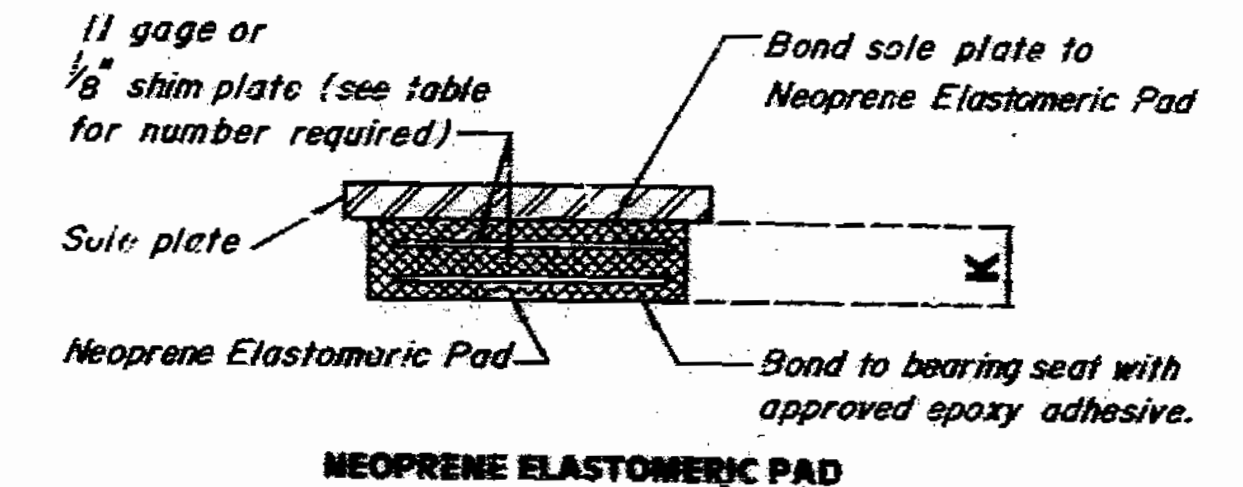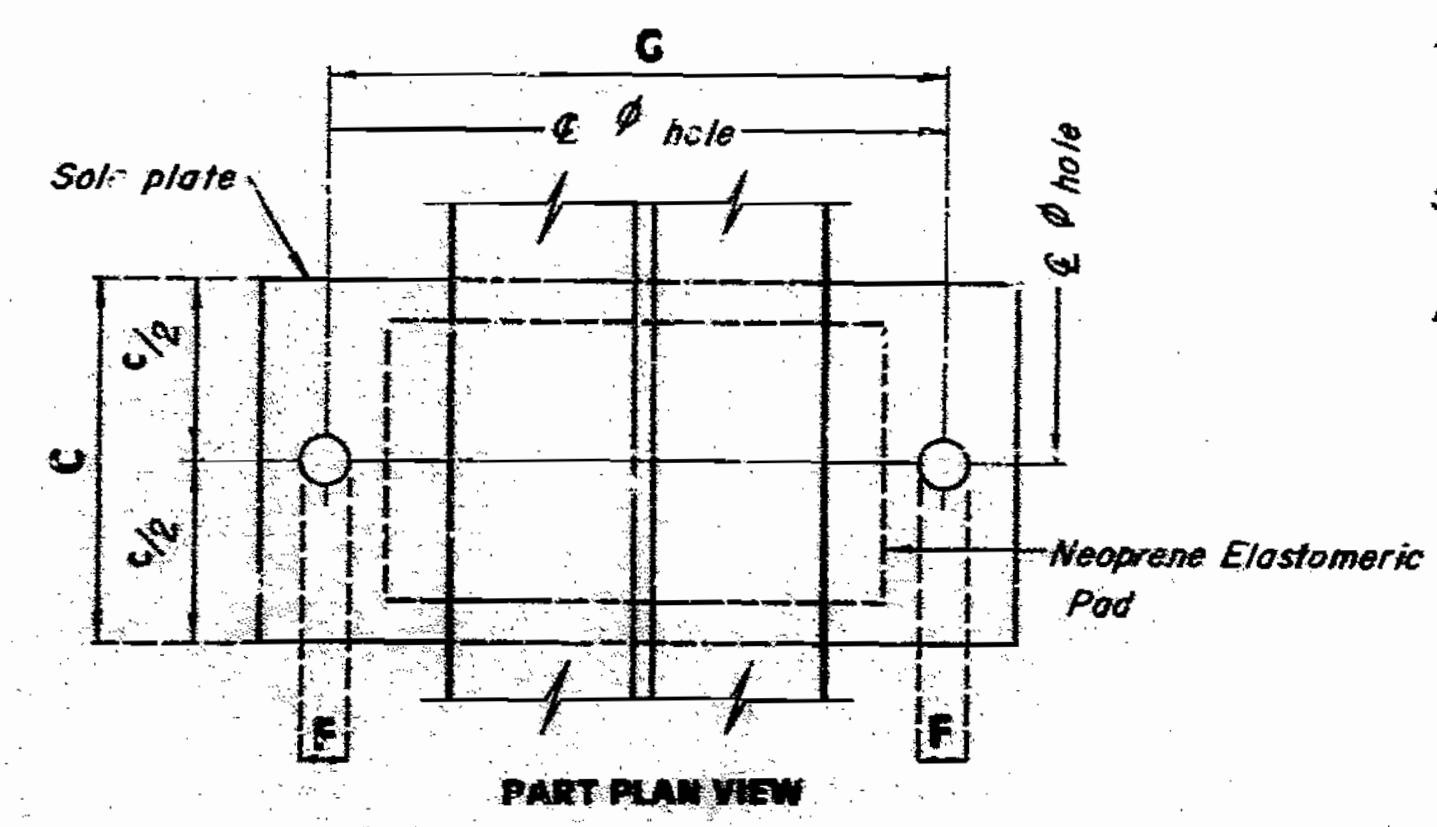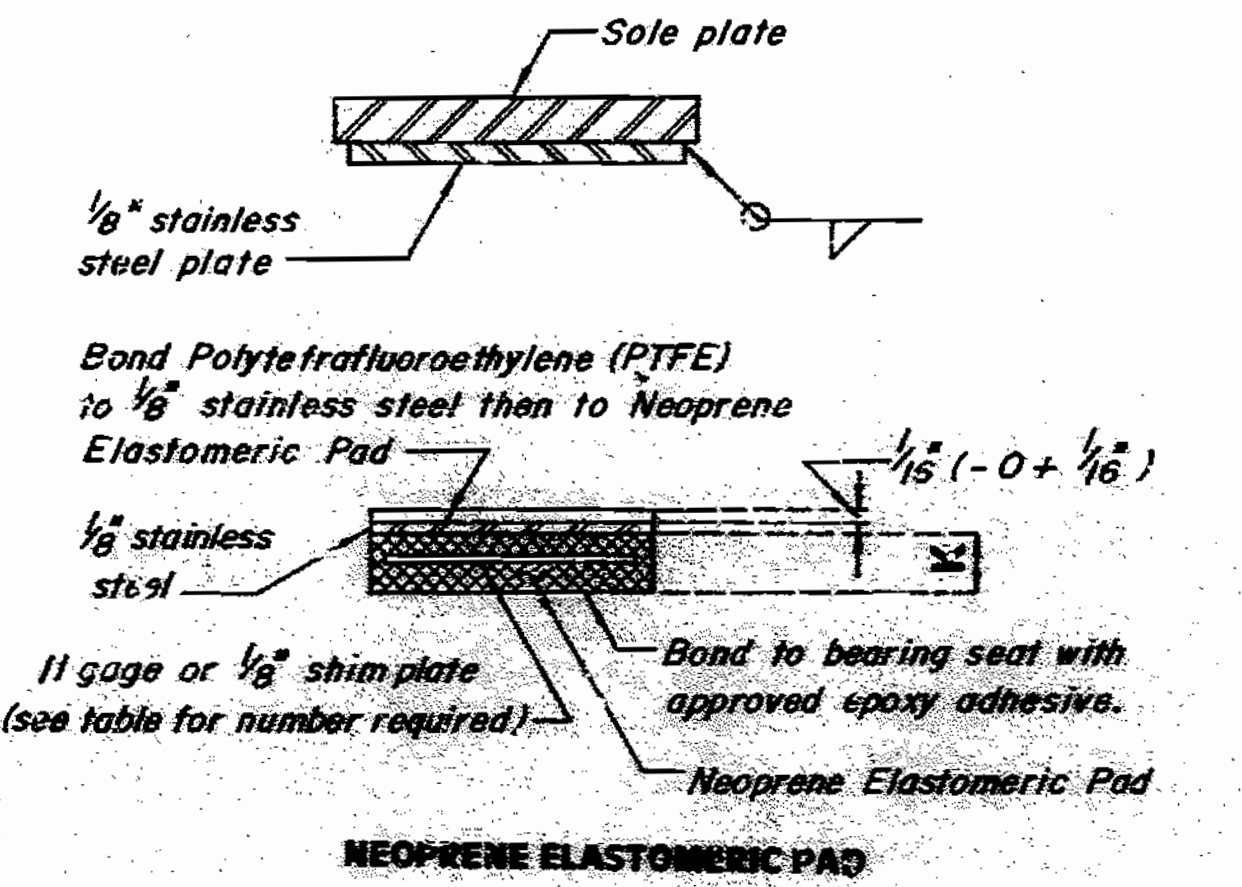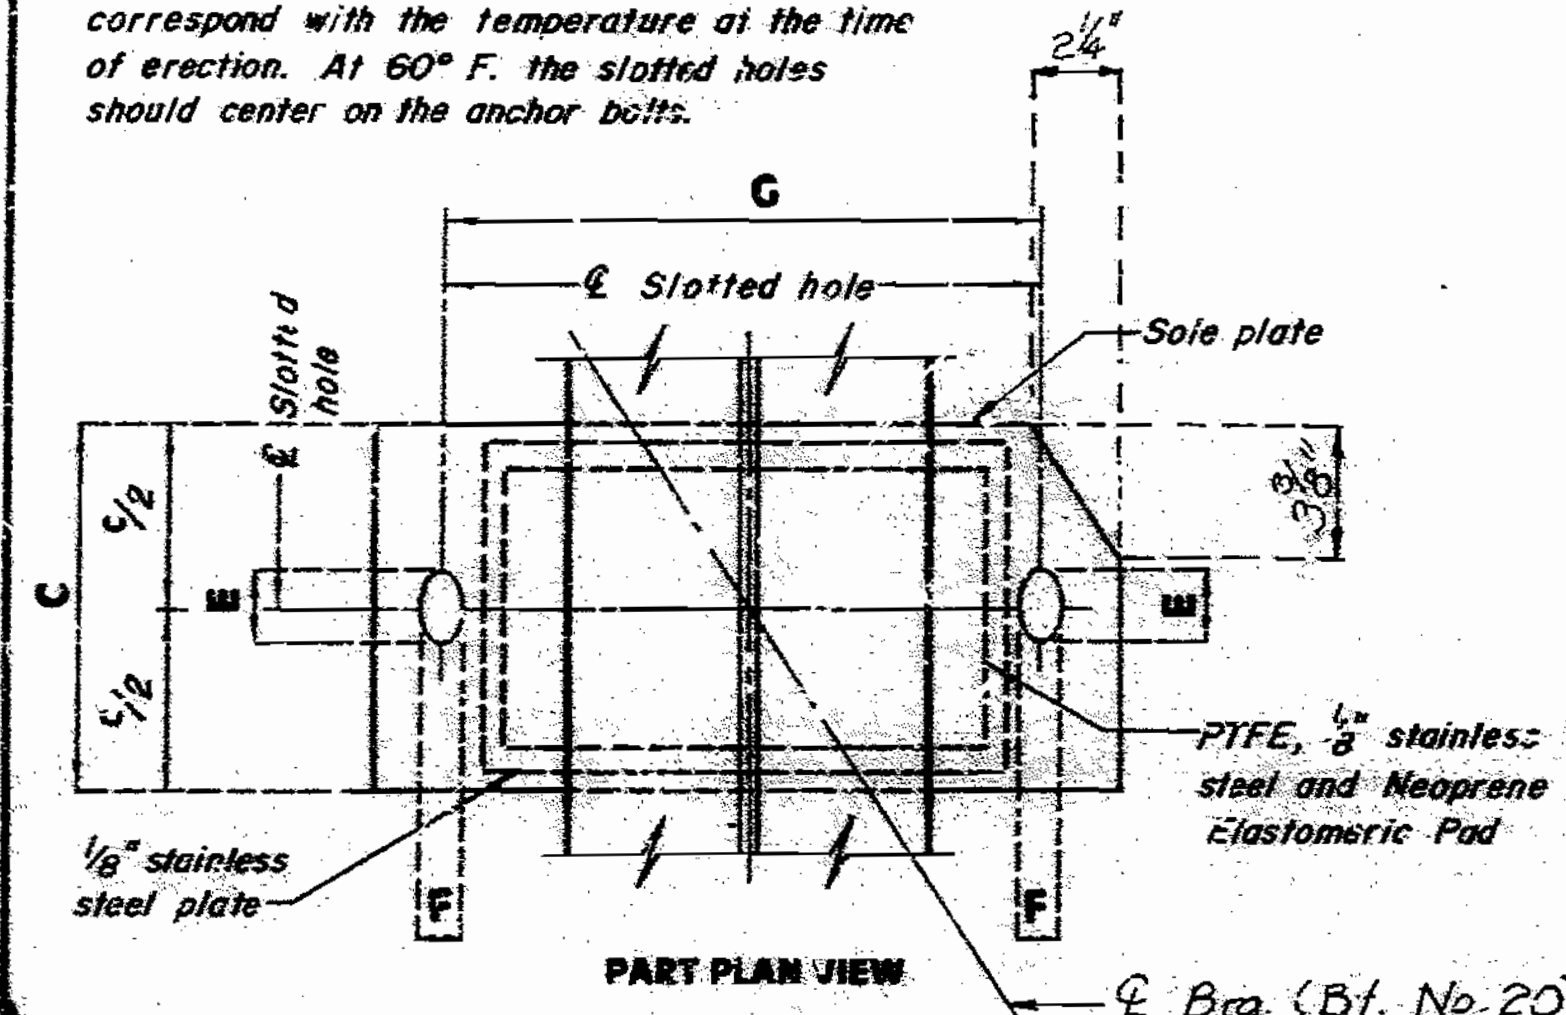

**PTFE SLIDING BEARINGS**  
NUMBER REQUIRED = 5 at Bent No. 20

**FIXED BEARINGS**  
NUMBER REQUIRED =

12" GDR #3  
1 3/8" GDR #1, #2, #4  
1 3/8" GDR #5

BENT NO.	A	B	C	D	E	F	G	H	J	K	L	M	N	P	NUMBER OF SHIM PLATES
20	16"	11"	16 1/2"	25"	6 1/2"	1 7/8"	20"	1 1/2"	3 1/16"	1 1/8"	***	1 7/8"	***	1/4"	1

(\*) THE REQUIRED SHIM PLATE SHALL BE PLACED BETWEEN EQUAL LAYERS OF ELASTOMER AND MOLDED TOGETHER TO FORM AN INTEGRAL UNIT.

**GENERAL NOTES:**  
ANCHOR BOLTS SHALL BE 1/2" A325 STEEL SWAGED BOLTS AND SHALL EXTEND 15" INTO THE CONCRETE WITH A194 - 2, 2H OR A563 - C, C3, D, DH, DH3 HEAVY HEXAGON NUTS. ACTUAL MANUFACTURER'S CERTIFIED MILL TEST REPORTS (CHEMICAL AND MECHANICAL) SHALL BE PROVIDED. (SWAGING SHALL BE 1" LESS THAN EXTENSION INTO THE CONCRETE.)  
ALL STRUCTURAL STEEL FOR THE SOLE PLATE, ANCHOR BOLTS AND HEAVY HEXAGON NUTS SHALL BE PAINTED WITH 2 COATS (5 MILS MIN.) OF INORGANIC ZINC. WELD AREAS TO BE TOUCHED UP AFTER ASSEMBLY.  
WEIGHT OF THE ANCHOR BOLTS AND HEAVY HEXAGON NUTS FOR BEARINGS SHALL BE INCLUDED IN THE WEIGHT OF FABRICATED STRUCTURAL STEEL.  
NEOPRENE ELASTOMERIC PADS SHALL BE 70 DUROMETER.  
THE SOLE PLATE SHALL BE FURNISHED WITH THE BEARING AND FIELD OR SHOP WELDED TO THE STRINGER, OR GIRDERS.  
STRUCTURAL STEEL FOR SOLE PLATE SHALL BE A-36  
PAYMENT FOR THE SOLE PLATE WILL BE INCLUDED IN THE COST OF THE BEARING ASSEMBLY. SEE SPECIAL PROVISIONS.  
THE ACCEPTED QUANTITY OF ELASTOMERIC BEARING ASSEMBLIES, COMPLETE-IN-PLACE, WILL BE PAID FOR AT THE CONTRACT UNIT PRICE FOR TYPE "N" PTFE BEARINGS, EACH.

BENT NO.	A	B	C	D	F	G	J	K	L	M	N	P	NUMBER OF SHIM PLATES

(\*) THE REQUIRED SHIM PLATE SHALL BE PLACED BETWEEN EQUAL LAYERS OF ELASTOMER AND MOLDED TOGETHER TO FORM AN INTEGRAL UNIT.

\*\* Girders No. 1, 2 & 5 = 3" Girders No. 3 & 4 = 2 1/2"  
\*\*\* Girders No. 1, 2 & 5 = 14" Girders No. 3 & 4 = 15"

**DETAILS OF TYPE 'N' PTFE BEARINGS**



Note: This drawing is not to scale. Follow dimensions. Revised 12-1-89

SEE FIELD PLANS  
Sheet No. 23 of 38

STEEL  
TYPE 'N' BRGS.  
JANUARY 1980  
REVISED  
OCT. 1987

DETAILED June 1988  
CHECKED March 1989

STATE	PROJ. NO.	SHEET NO.
MO.		104

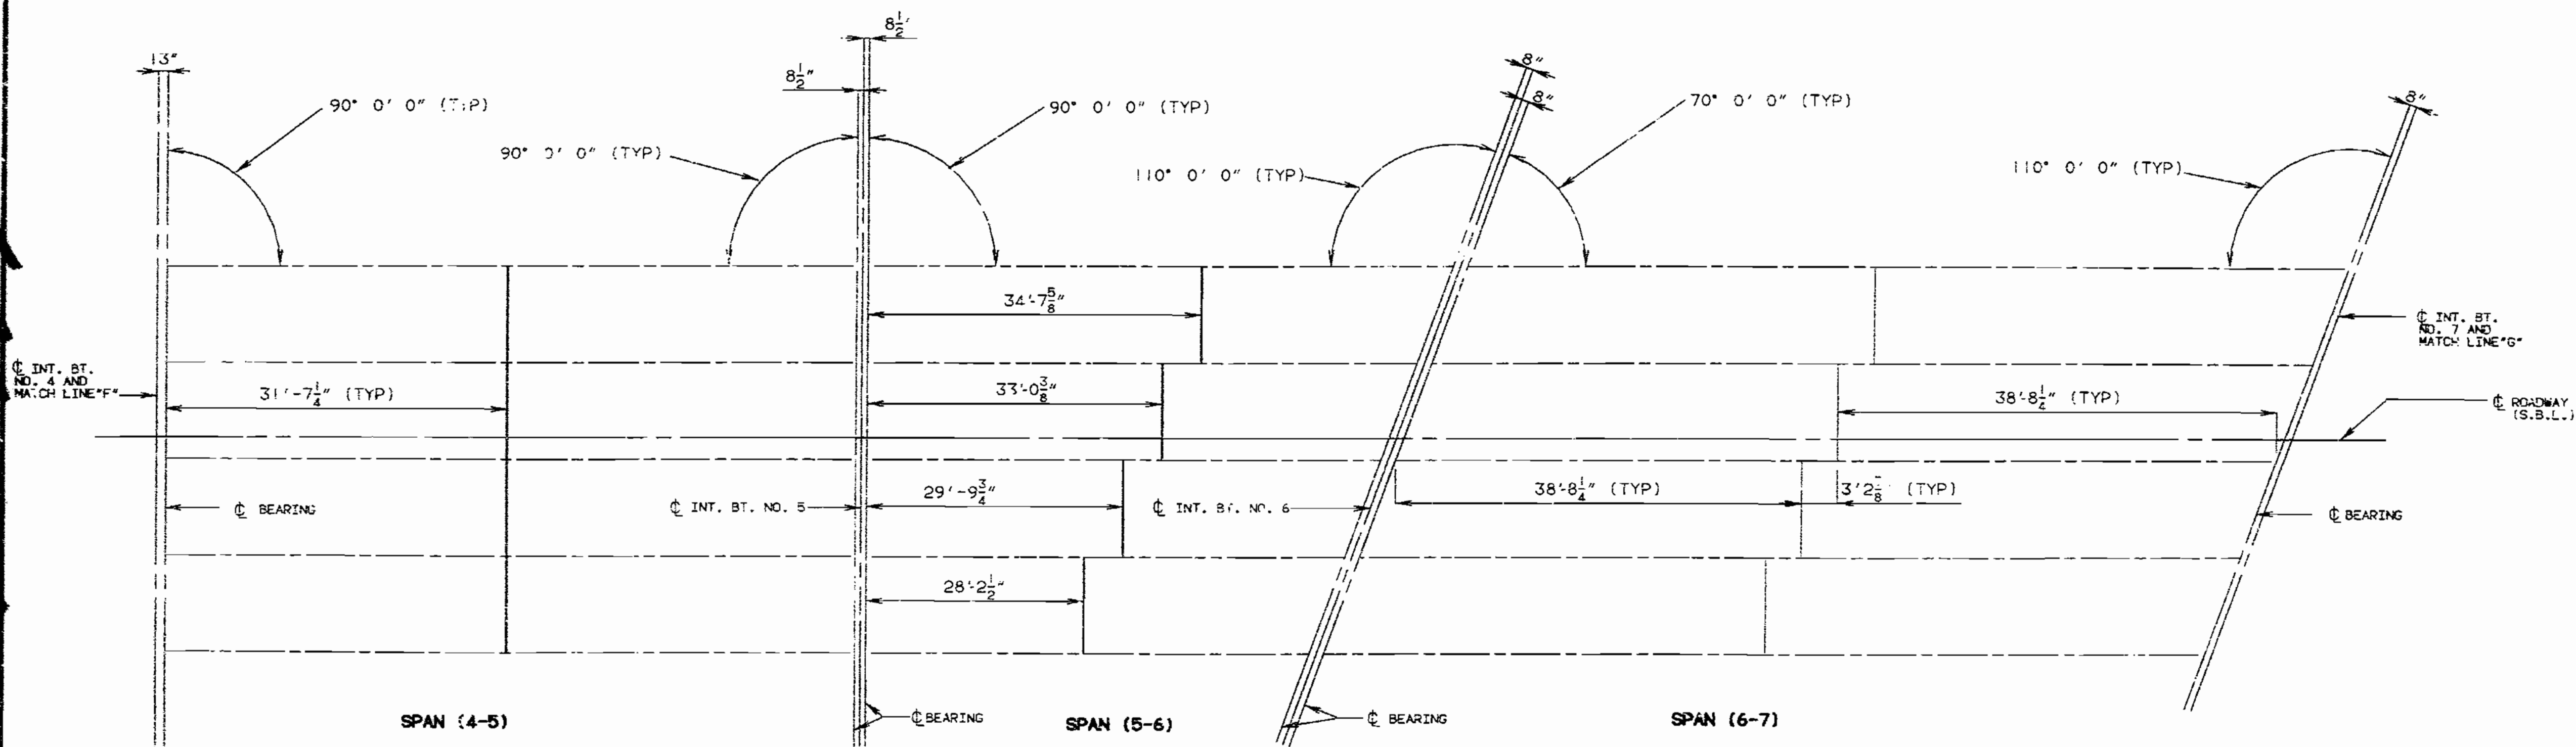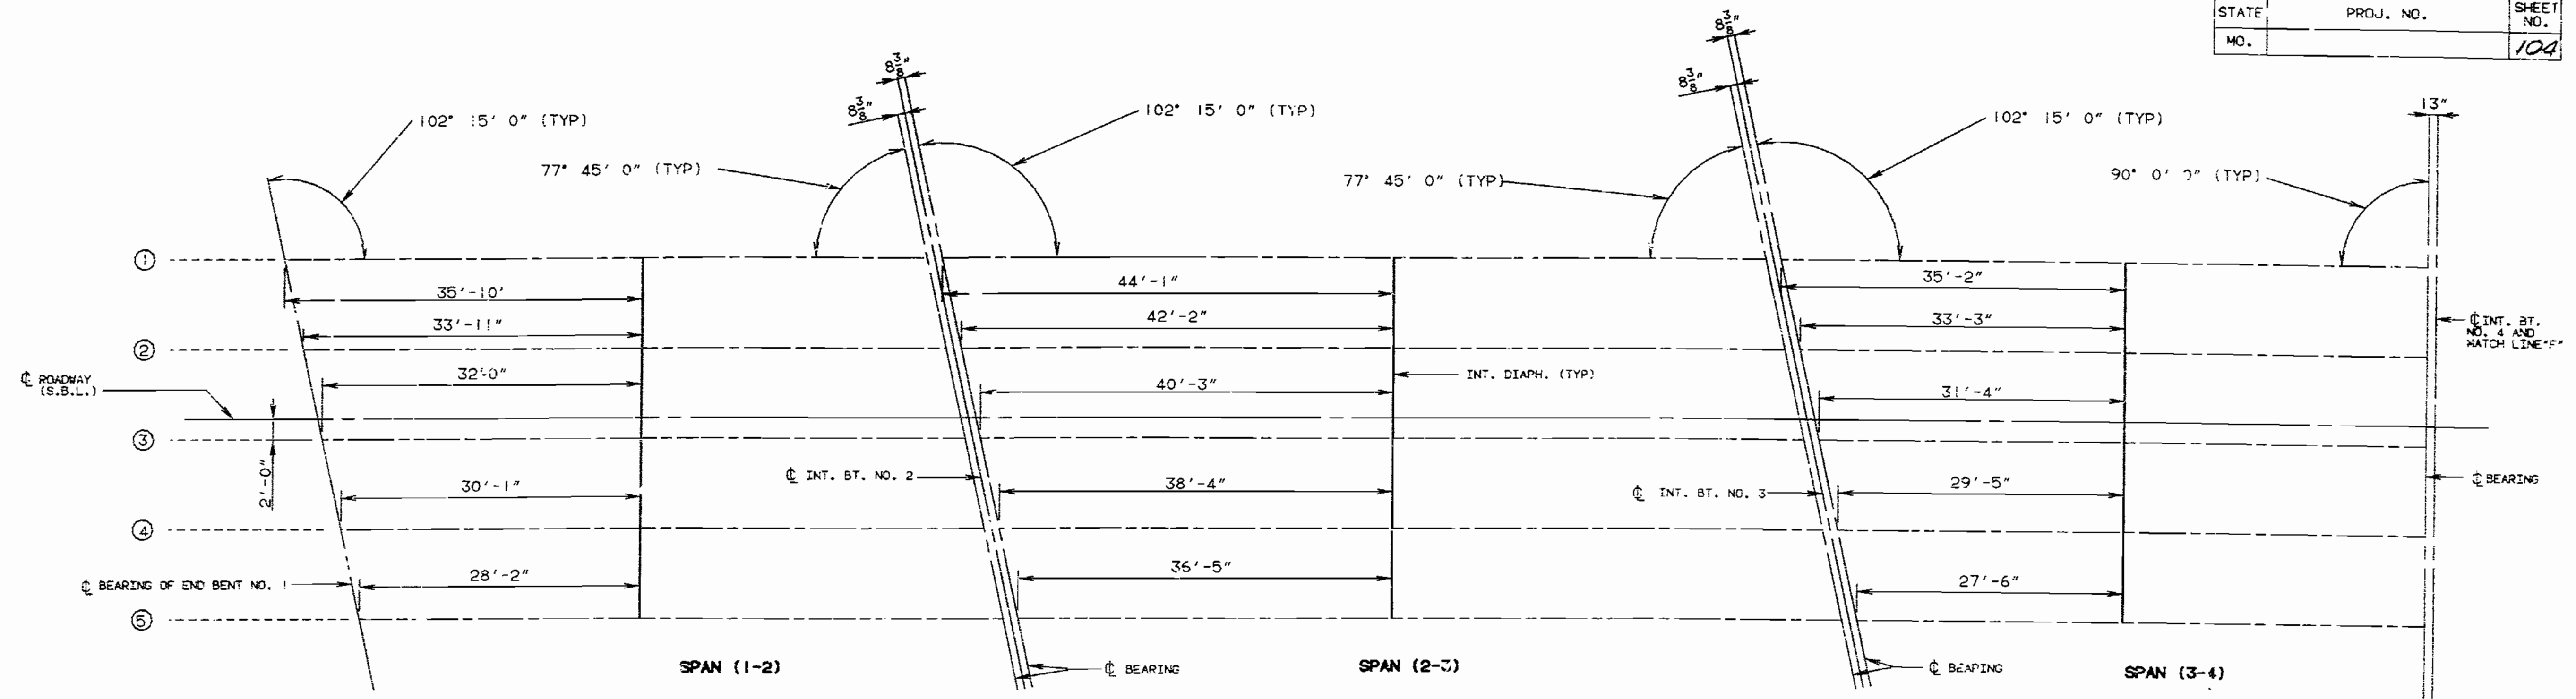

NOTE: ALL DIMENSIONS SHOWN ARE HORIZONTAL.

PART PLAN SHOWING PRESTRESSED GIRDER LAYOUT AND LOCATION OF INT DIAPHRAGMS

146  
1119

DETAILED JULY 1988  
CHECKED FEB. 1989


NOTE: THIS DRAWING IS NOT TO SCALE. FOLLOW DIMENSIONS.

SHEET NO. 24 OF 98

JACKSON COUNTY

A-2745

STATE	PROJ. NO.	SHEET NO.
MO.		105

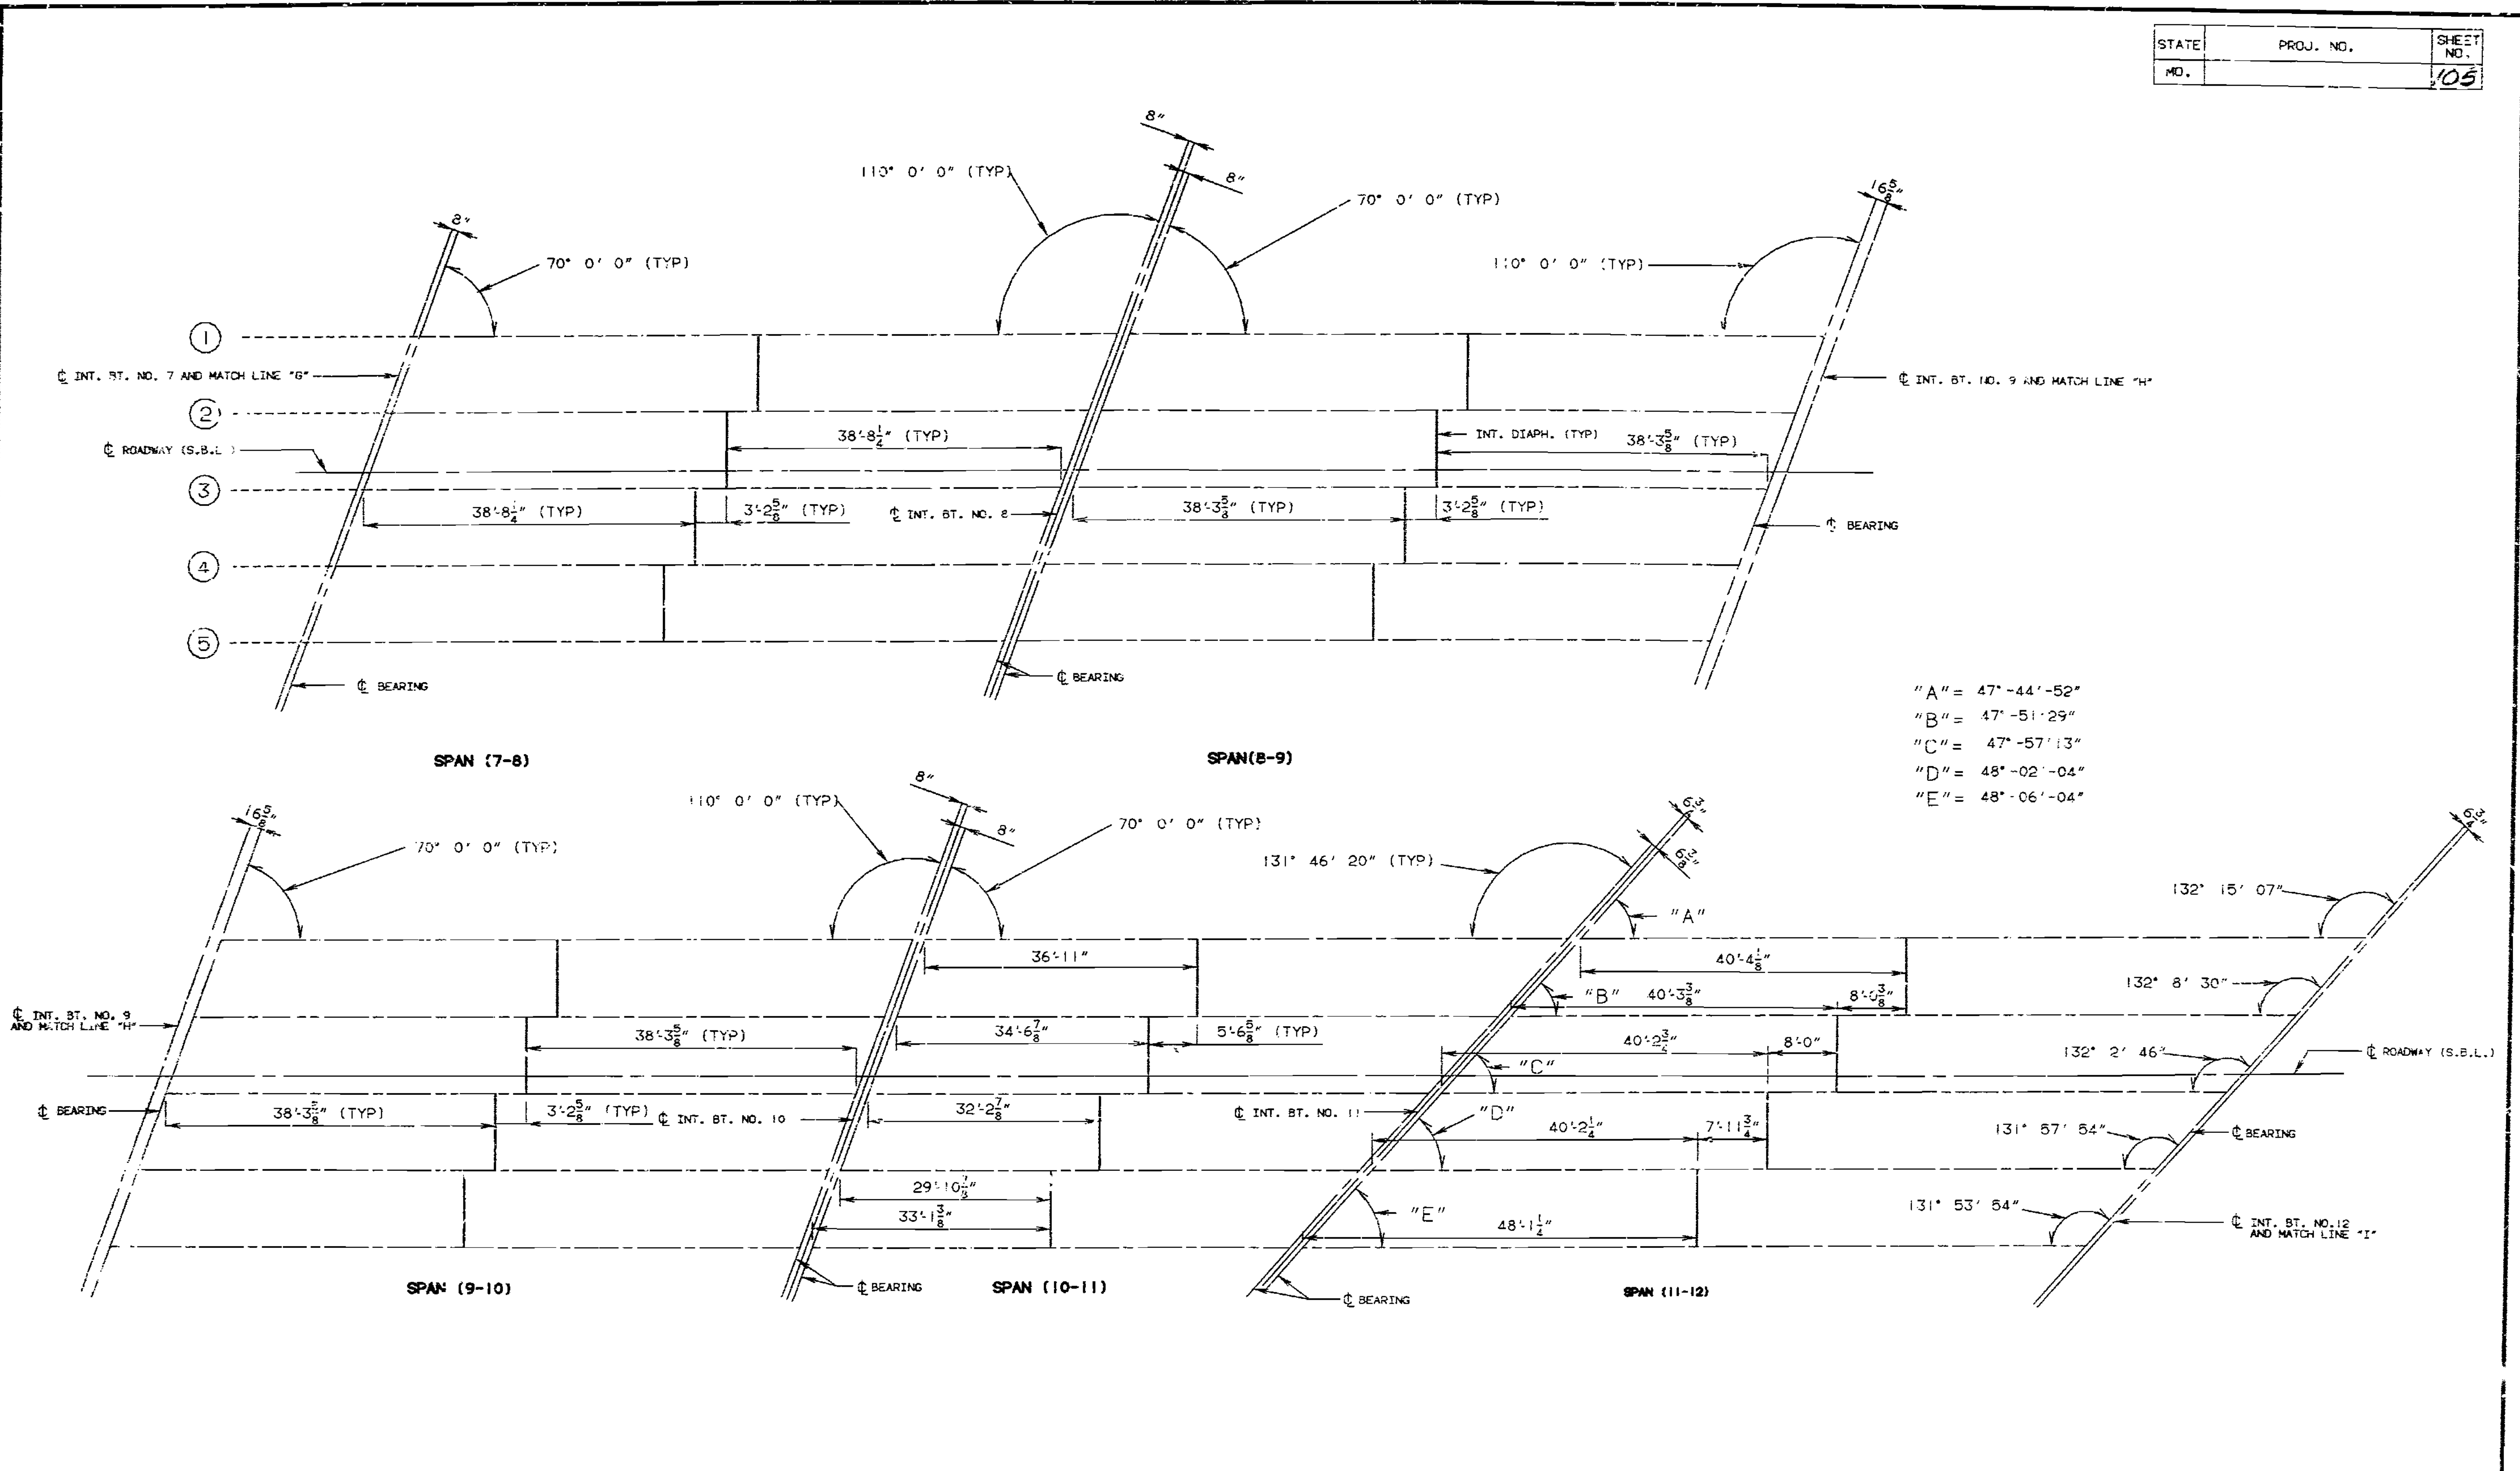

PART PLAN SHOWING PRESTRESSED GIRDER LAYOUT AND LOCATION OF INT. DIAPHRAGMS

NOTE: ALL DIMENSIONS SHOWN ARE HORIZONTAL AND TAKEN FROM & BEARING.

157120

DETAILED JULY 1988  
CHECKED FEB. 1989


NOTE: THIS DRAWING IS NOT TO SCALE. FOLLOW DIMENSIONS.

SHEET NO. 25 OF 98.


JACKSON COUNTY

A-2745

STATE	PROJ. NO.	SHEET NO.
MO.		106

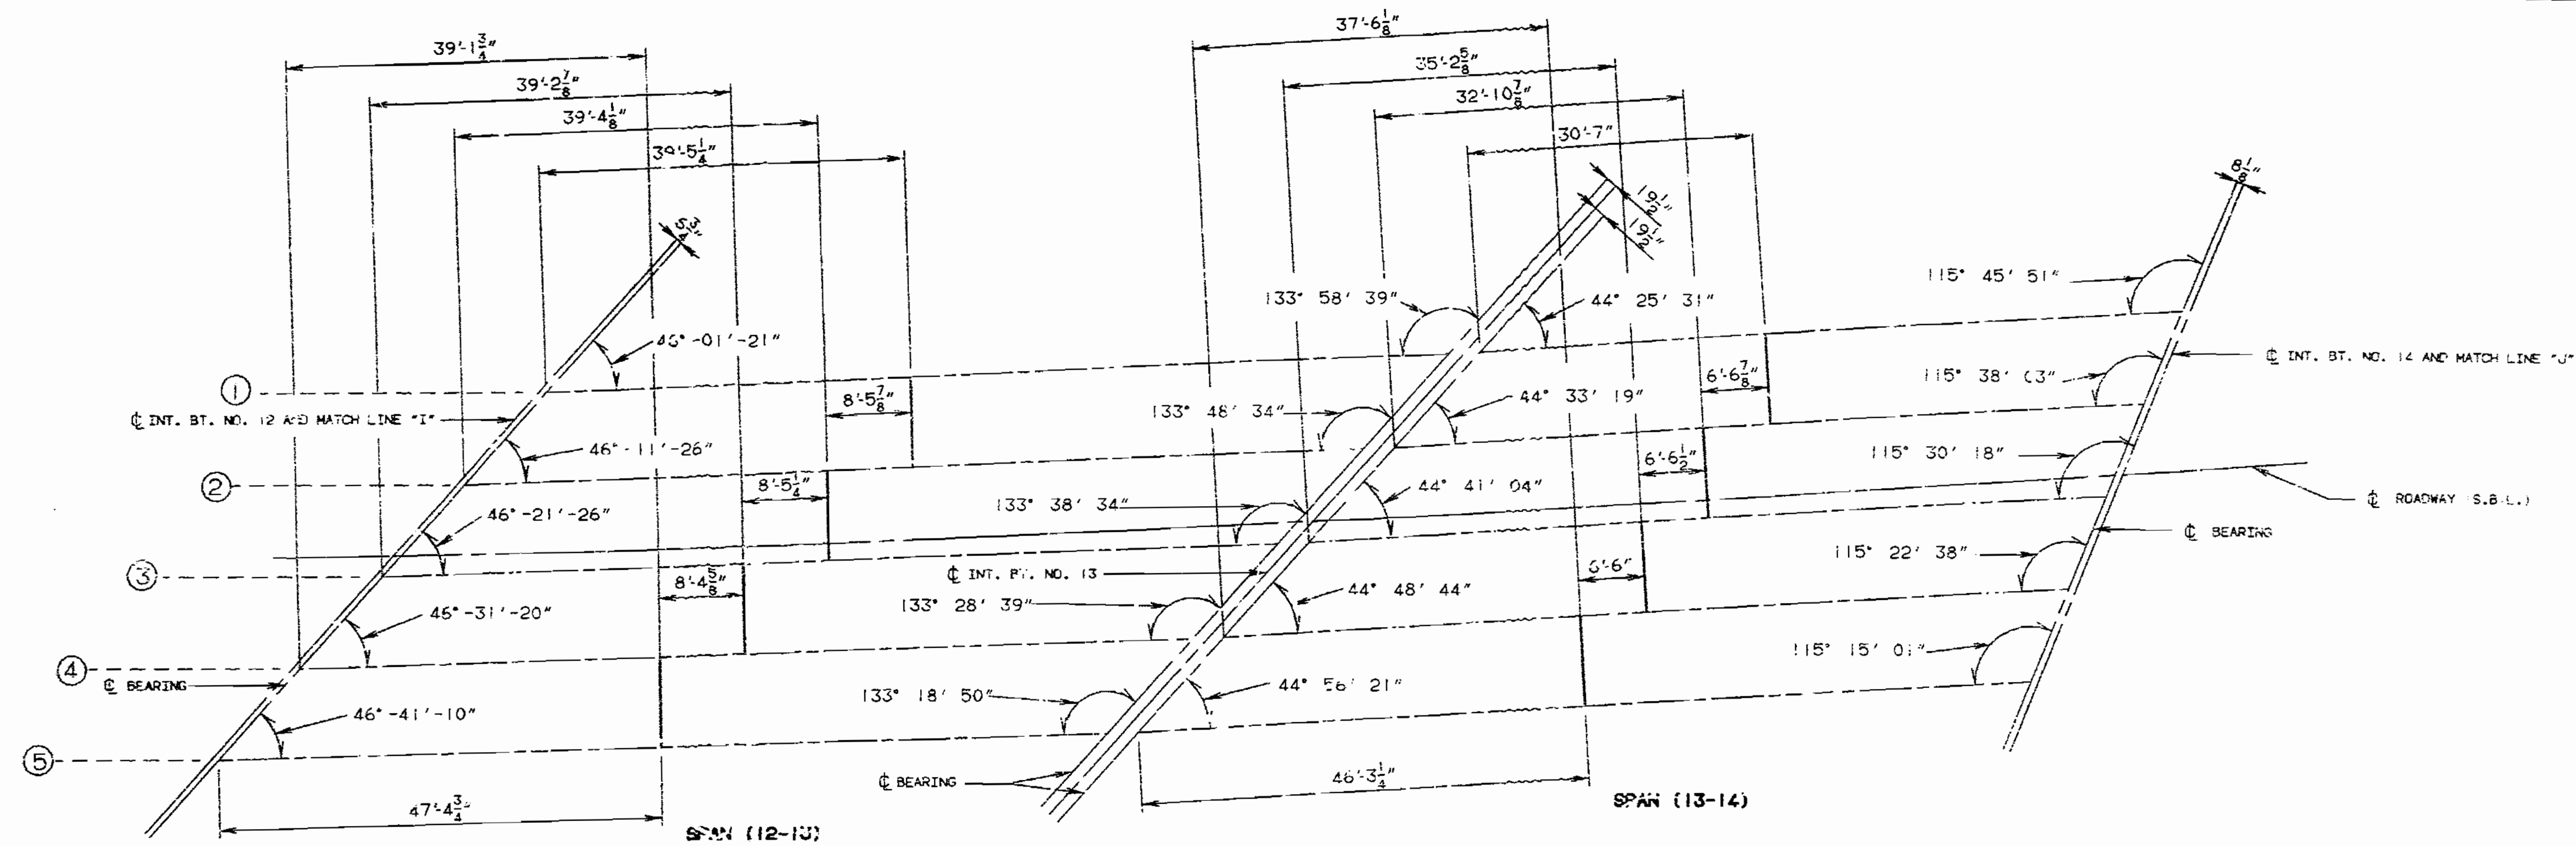

NOTE: ALL DIMENSIONS SHOWN ARE HORIZONTAL AND TAKEN FROM  $\phi$  BEARING.

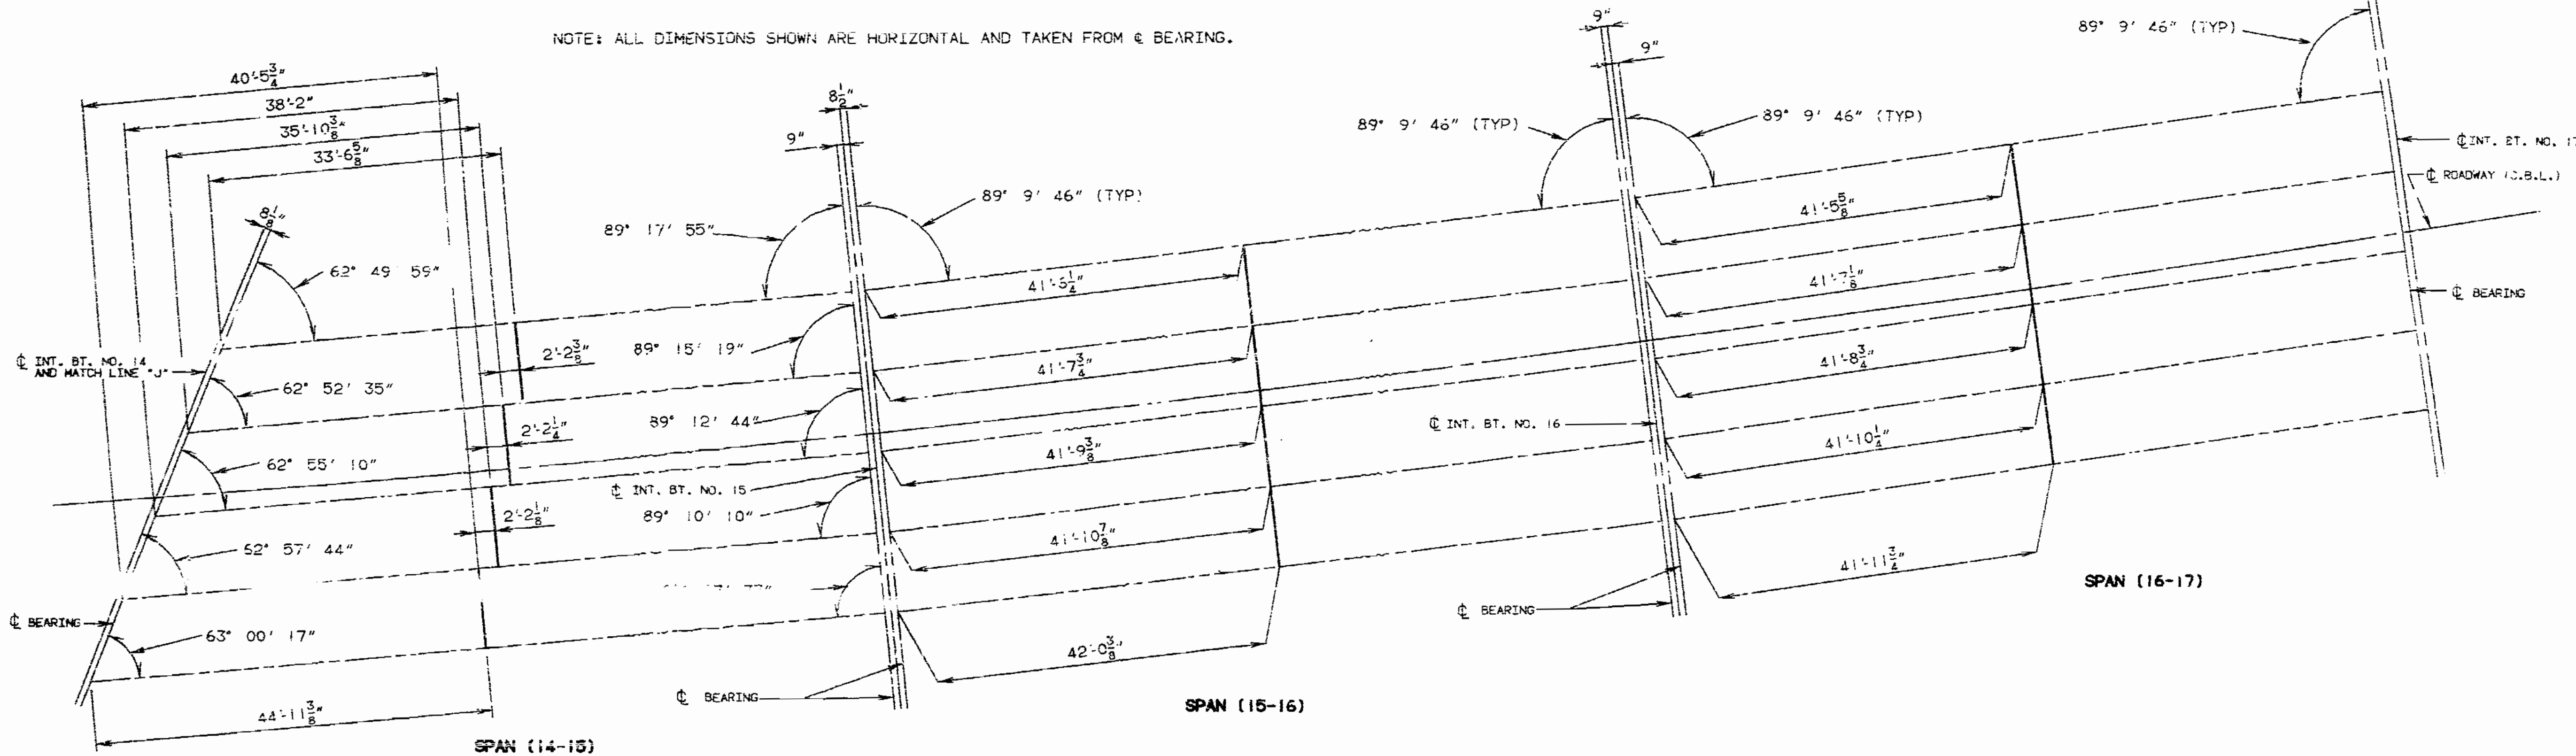

PART PLAN SHOWING PRESTRESSED GIRDER LAYOUT AND LOCATION OF INT. DIAPHRAGMS

7-18-88  
 DETAILED JULY 1988  
 CHECKED FEB. 1989

NOTE: THIS DRAWING IS NOT TO SCALE. FOLLOW DIMENSIONS.


SHEET NO. 26 OF 98.

JACKSON COUNTY


A-2745

CONCRETE FOR PRESTRESSED GIRDERS SHALL BE CLASS A WITH  $f_c = 5,000$  PSI.  
 (-) INDICATES PRESTRESSED STRAND.  
 USE 1/4" STRANDS WITH AN INITIAL PRESTRESS FORCE OF 430 KIPS.  
 PRESTRESSING TENDONS SHALL BE UNCOATED, SEVEN-WIRE, LOW RELAXATION STRANDS. 1/2" INCH DIAMETER CONFORMING TO A.A.S.H.T.O. #202, GRADE 270. SEE MO. STD. SPECIFICATIONS 703.4.8.


STATE	PROJ. NO.	SHEET NO.
MO.		107

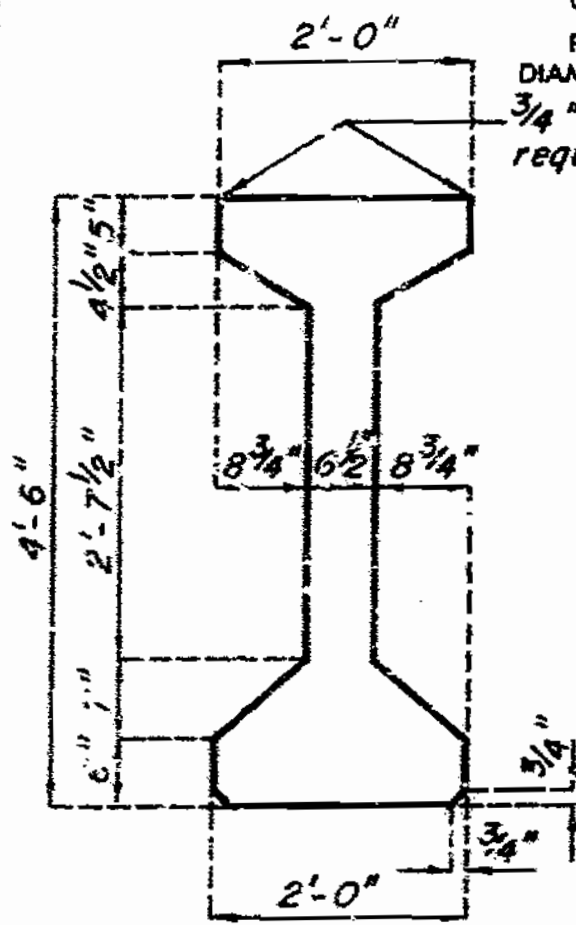


GIRDER DIMENSIONS  
CAST-IN-PLACE FORMS

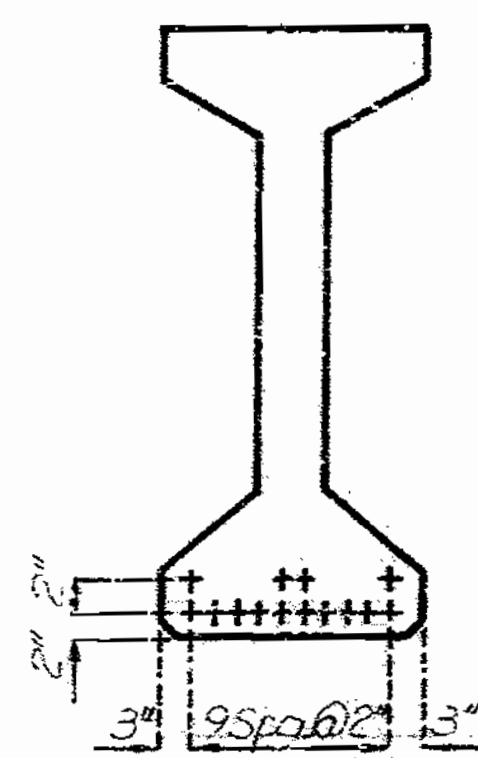


CL OF GIRDER  
STRAND ARRANGEMENTS

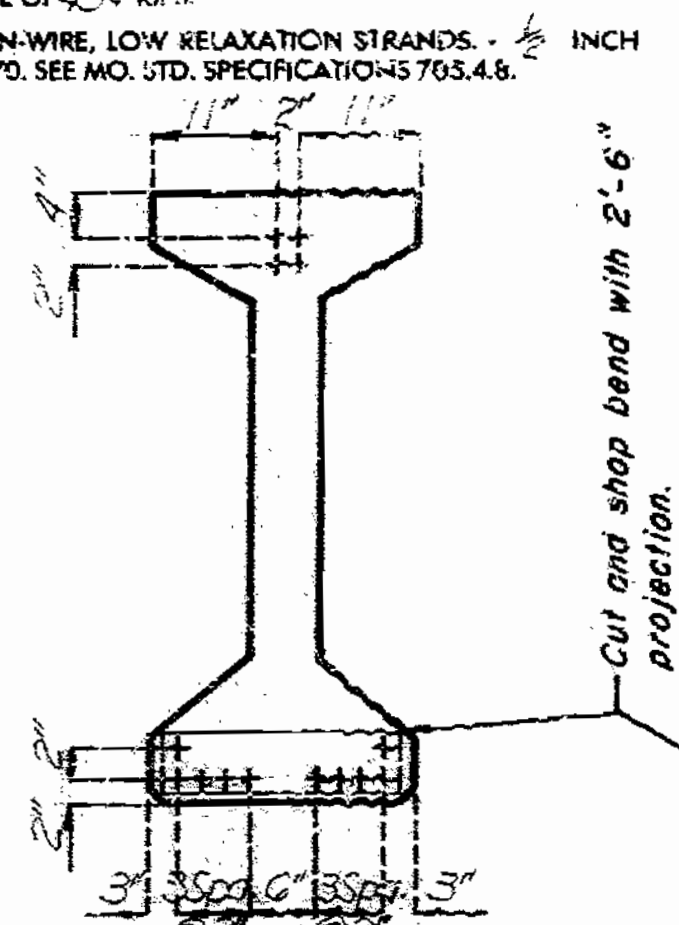

END OF GIRDER  
STRAND ARRANGEMENTS

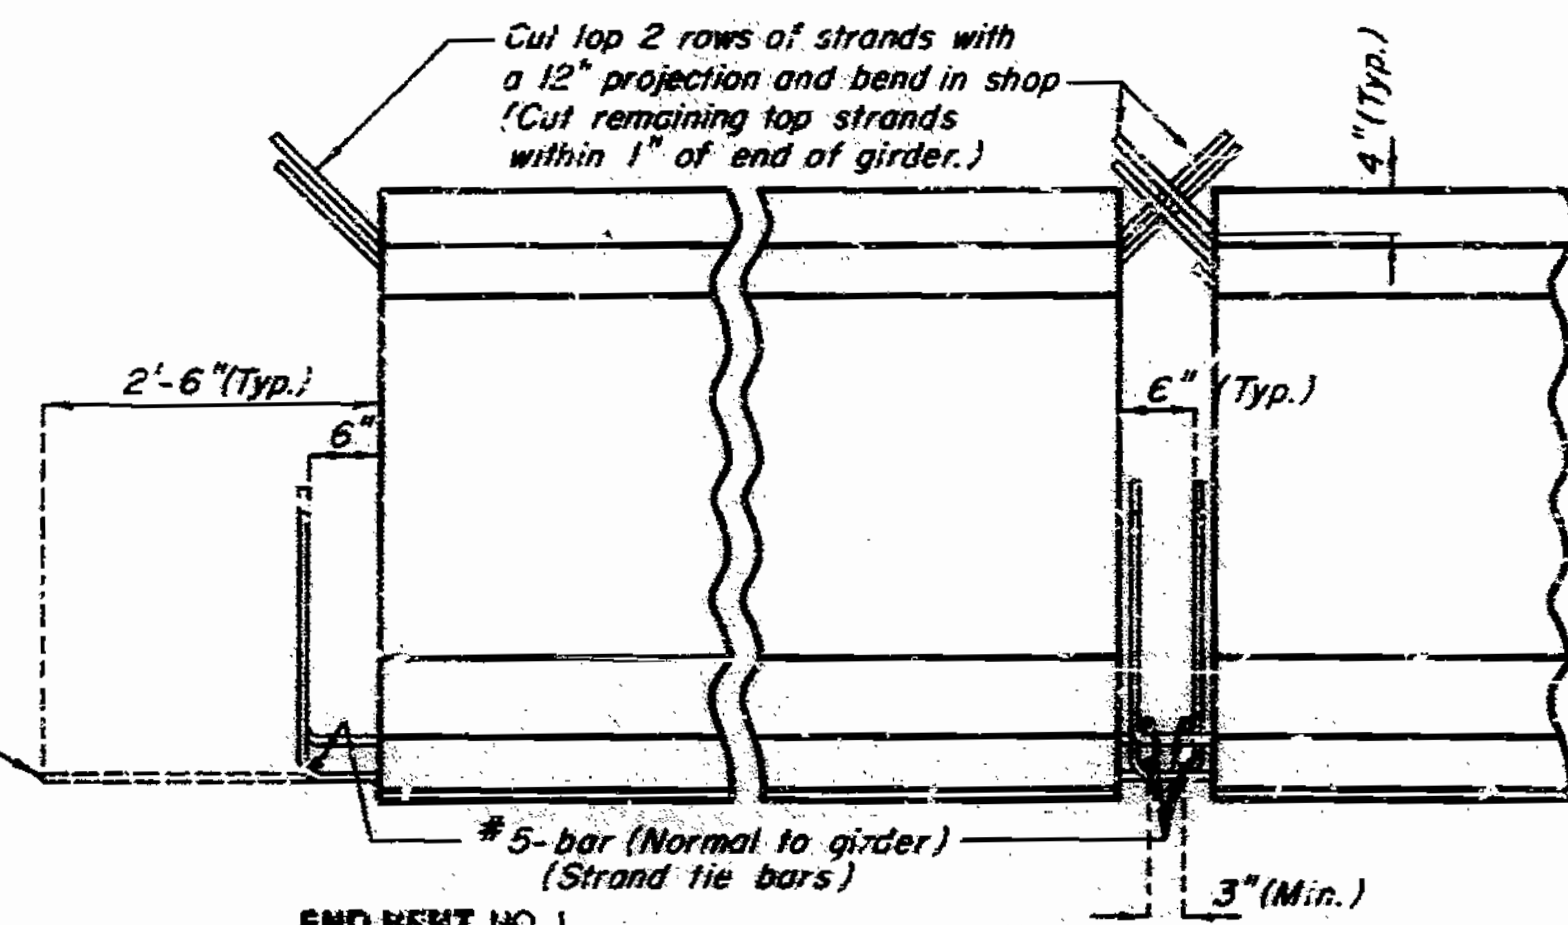


STRAND DETAILS AT GIRDER ENDS  
END BENT NO. 1 INTERMEDIATE BENT NO. 2

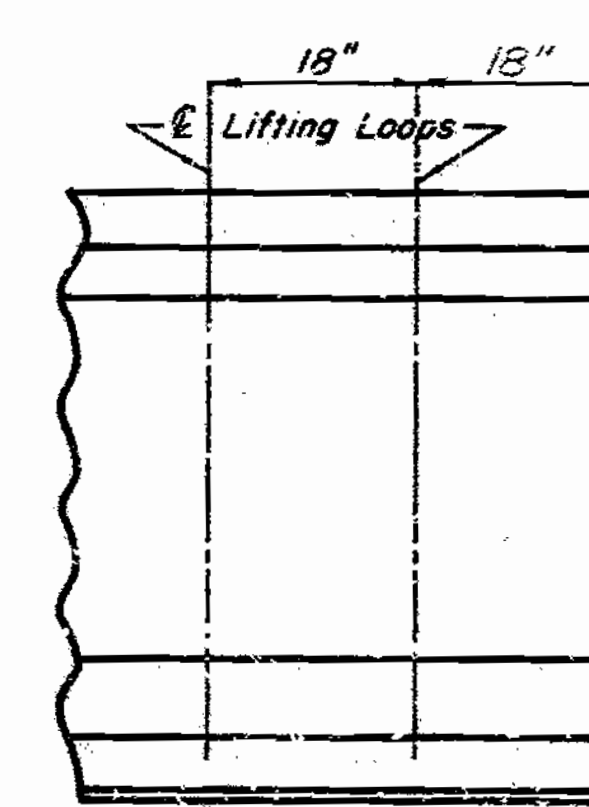


LOCATION OF LIFTING LOOPS

BILL OF REINFORCING STEEL - EACH GIRDER				
NO.	SIZE & MARK	ACTUAL LENGTH	SHAPE	BENDING DIAGRAMS
4	3A1	33'-0"	2C	
102	5B1	5'-11"	11	
4	3B2	5'-4"	11	
51	4C1	2'-2"	10	
102	4D1	3'-0"	9	

**NOTE:**  
 ALL DIMENSIONS IN BENDING DIAGRAM REFER TO OUT.  
 HOOKS AND BENDS SHALL BE IN ACCORDANCE WITH THE CSI MANUAL OF STANDARD PRACTICE FOR DETAILING REINFORCED CONCRETE STRUCTURES STIRRUP AND RE DIMENSIONS.  
 ACTUAL LENGTHS ARE MEASURED ALONG CENTERLINE BAR TO THE NEAREST 1/8".  
 MINIMUM CLEARANCE TO REINFORCING SHALL BE 1".  
 ALL REINFORCEMENT SHALL BE GRADE 60.  
 THE TWO D1 BARS MAY BE FURNISHED AS ONE BAR AT THE FABRICATOR'S OPTION.

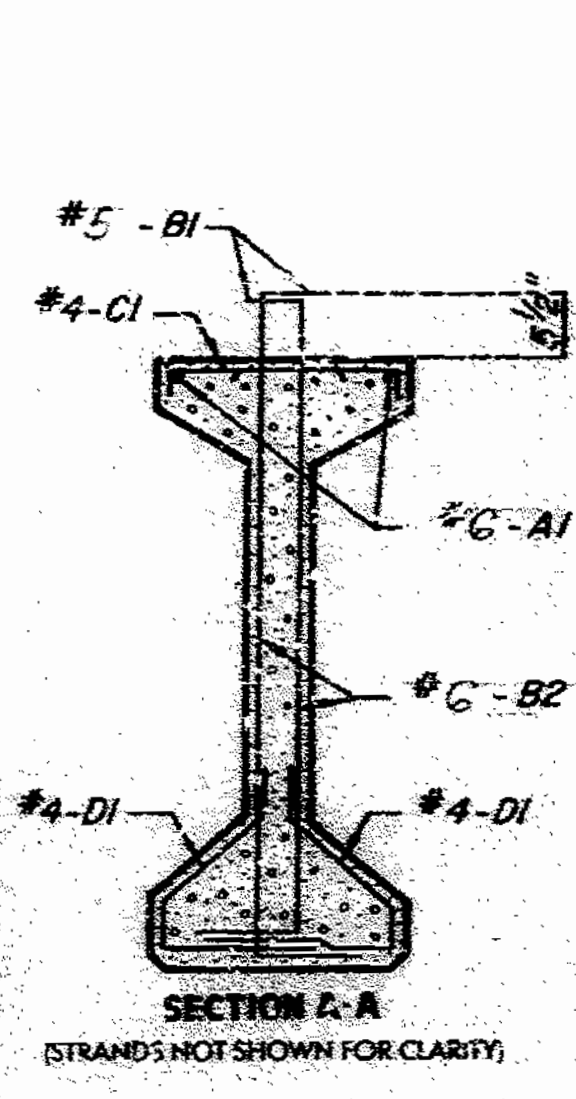


SECTION A-A  
STRANDS NOT SHOWN FOR CLARITY

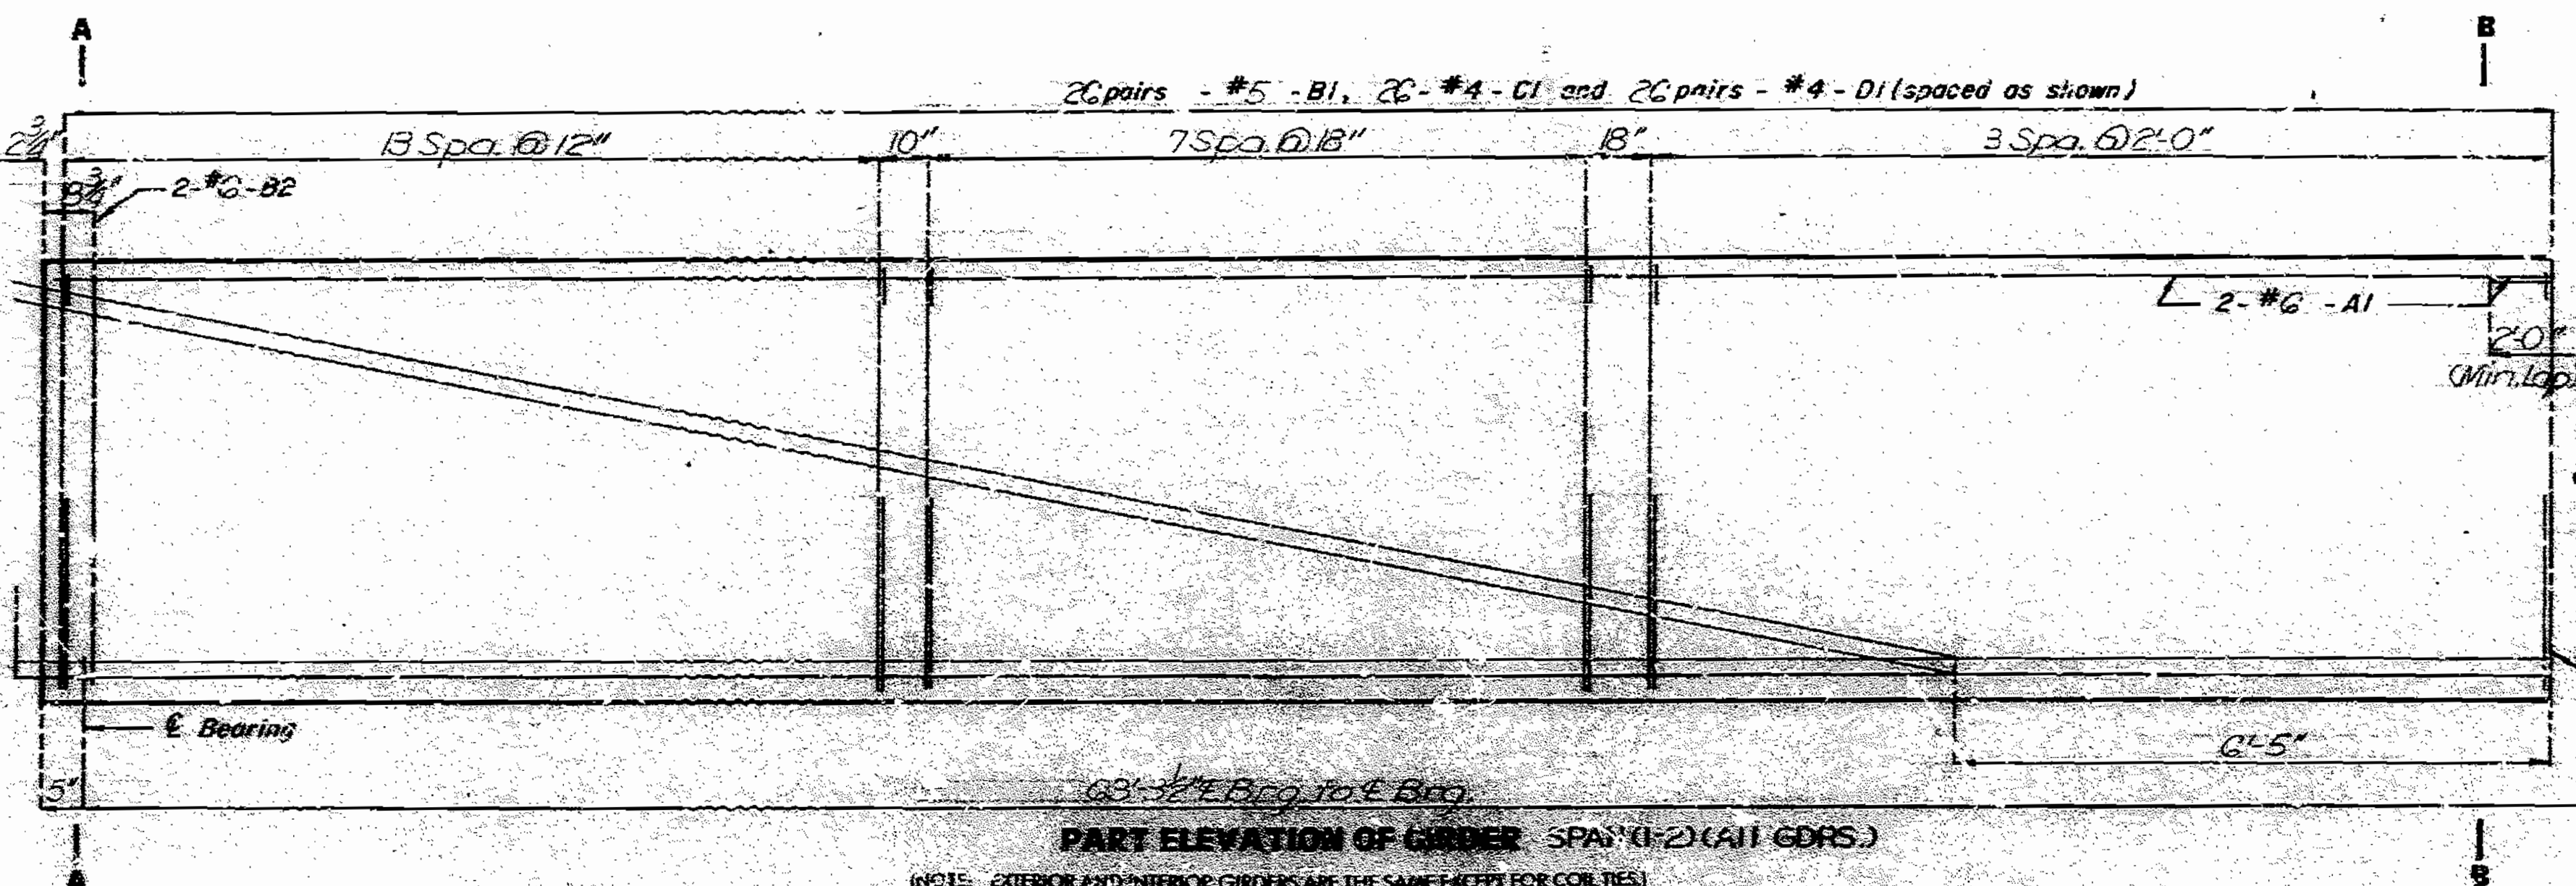


PART ELEVATION OF GIRDER SPAN (1-2) (ALL GDERS)  
 (NOTE: EXTERIOR AND INTERIOR GIRDERS ARE THE SAME EXCEPT FOR COIL TIES)

Note: For details of Int. Bt. Diaph., see sheet No. 63  
 For location of Int. Diaph. and general girder placement, see sheet No. 24  
 For Girder Camber and haunching see sheet No. 63

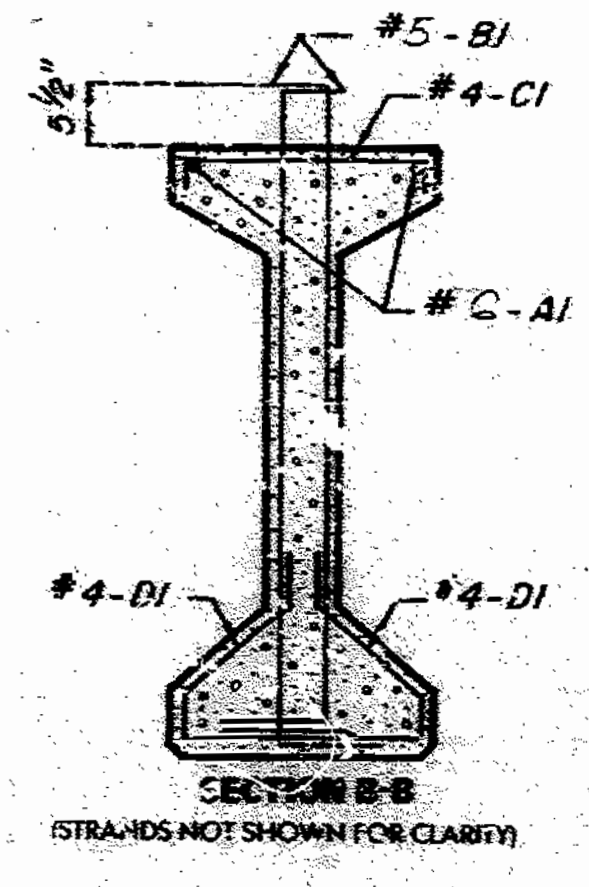


SECTION B-B  
STRANDS NOT SHOWN FOR CLARITY

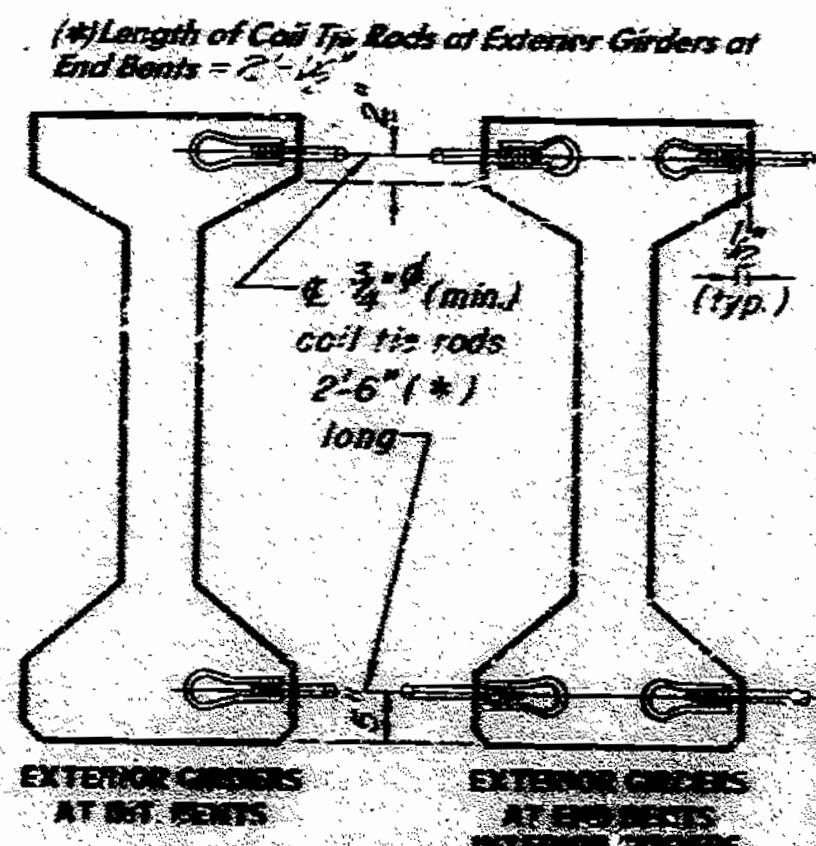

DETAILS OF COIL TIES

**NOTE:**  
 COST OF 3/4" COIL TIE RODS PLACED IN DIAPHRAGMS IS INCLUDED IN CONTRACT UNIT PRICE FOR PRESTRESSED CONCRETE MEMBERS.  
 COIL TIES SHALL BE PLACED IN PLACE IN THE FORMS BY SLOTTED WIRE-SETTING STUDS PROJECTING THRU FORMS. STUDS ARE TO BE LEFT IN PLACE OR REPLACED WITH TEMPORARY PLUGS UNTIL GIRDERS ARE ERECTED AND THEN REPLACED BY COIL TIE RODS.  
**NOTE:**  
 The 1/2" holes shall be cast in the web for steel intermediate diaphragms. Drilling is not allowed.

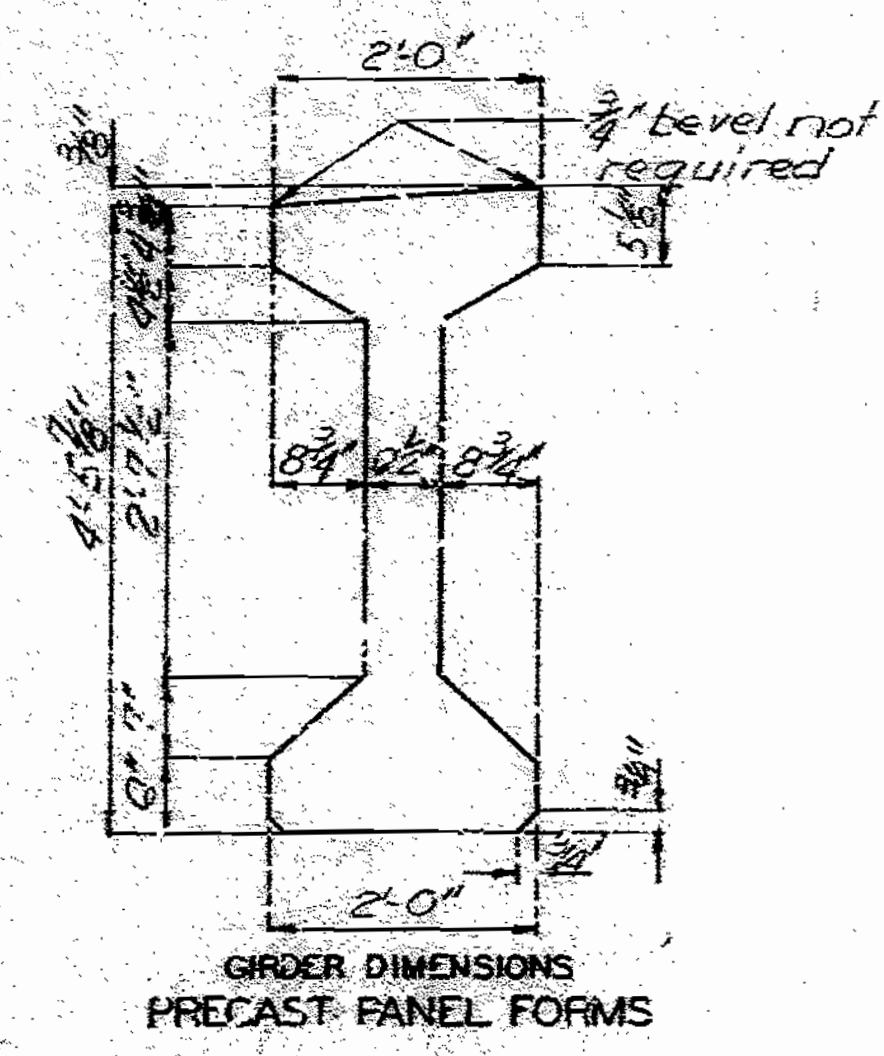

GIRDER DIMENSIONS  
PRECAST PANEL FORMS

147 123

SPS 55.6 6/8 REVISION  
FEB 1977 JUNE 1987

DETAILED FEB. 1988  
 CHECKED OCT. 1988

Note: This drawing is not to scale. Follow dimensions.


Sheet No. 27 of 38

JACKSON COUNTY

A-2745

NOTE:  
 CONCRETE: FOR PRESTRESSED GIRDERS SHALL BE CLASS A1 WITH  $f_c = 5,000$  PSI.  
 (+) INDICATES PRESTRESSED STRAND.  
 USE 22 STRANDS WITH AN INITIAL PRESTRESS FORCE OF 682 KIPS.  
 PRESTRESSING TENDONS SHALL BE UNCOATED, SEVEN-WIRE, LOW RELAXATION STRANDS -  $\frac{1}{2}$  INCH DIAMETER CONFORMING TO A.A.S.H.T.O. M203, GRADE 270. SEE MO. STD. SPECIFICATIONS 703.4.8.

STATE	PROJ. NO.	SHEET NO.
MO		108

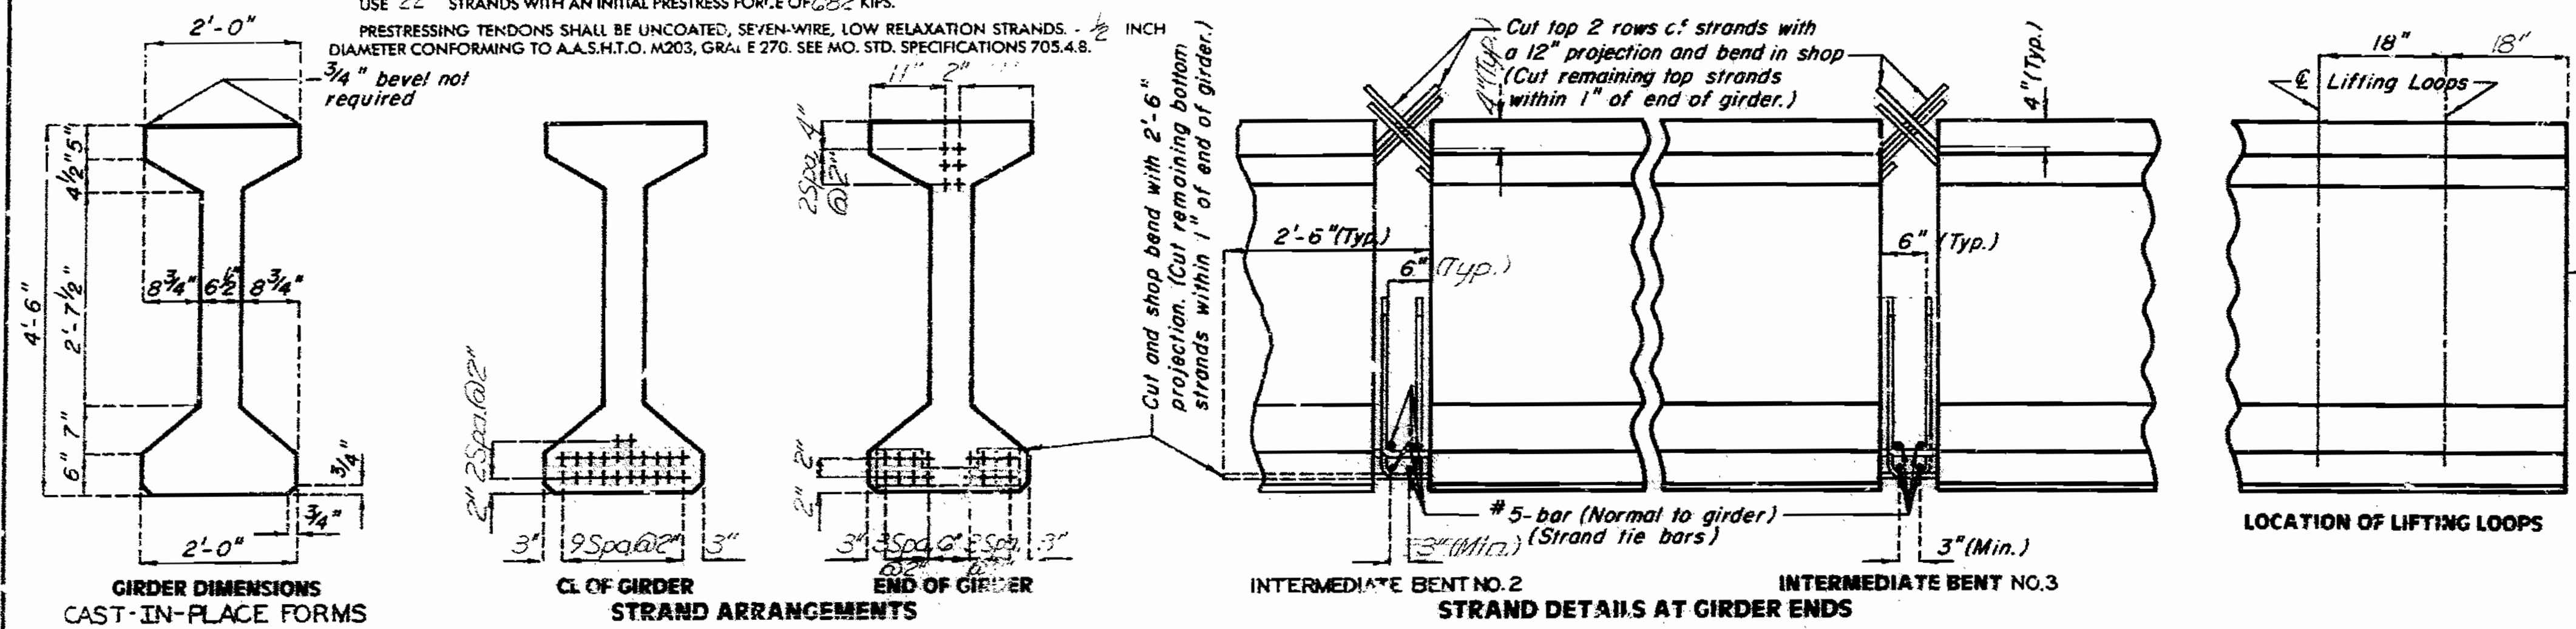

**BILL OF REINFORCING STEEL - EACH GIRDER**

NO.	SIZE & MARK	ACTUAL LENGTH	SHAPE
4	6A1	41'-7"	20
138	5B1	5'-11"	11
8	6B2	5'-4"	11
69	4C1	2'-2"	10
138	4D1	3'-0"	9

**BENDING DIAGRAMS**



SHAPE 10: 22" top flange, 8 3/4" web height, 4 1/2" bottom flange.

SHAPE 9: 18" top flange, 4 1/2" web height, 4'-10 1/2" BI, 4'-4" B2, 9 1/2" top leg.

SHAPE 20: 18" top flange, 4 1/2" web height.

SHAPE 11: 4'-10 1/2" BI, 4'-4" B2, 9 1/2" top leg.


**NOTE:**  
 ALL DIMENSIONS IN BENDING DIAGRAM ARE OUT TO OUT.  
 HOOKS AND BENDS SHALL BE IN ACCORDANCE WITH THE CRSI MANUAL OF STANDARD PRACTICE FOR DETAILING REINFORCED CONCRETE STRUCTURES STRIPPED AND TIE DIMENSIONS.  
 ACTUAL LENGTHS ARE MEASURED ALONG CENTERLINE BAR TO THE NEAREST INCH.  
 MINIMUM CLEARANCE TO REINFORCING SHALL BE 1".  
 ALL REINFORCEMENT SHALL BE GRADE 60.  
 THE TWO D1 BARS MAY BE FURNISHED AS ONE BAR AT THE FABRICATOR'S OPTION.

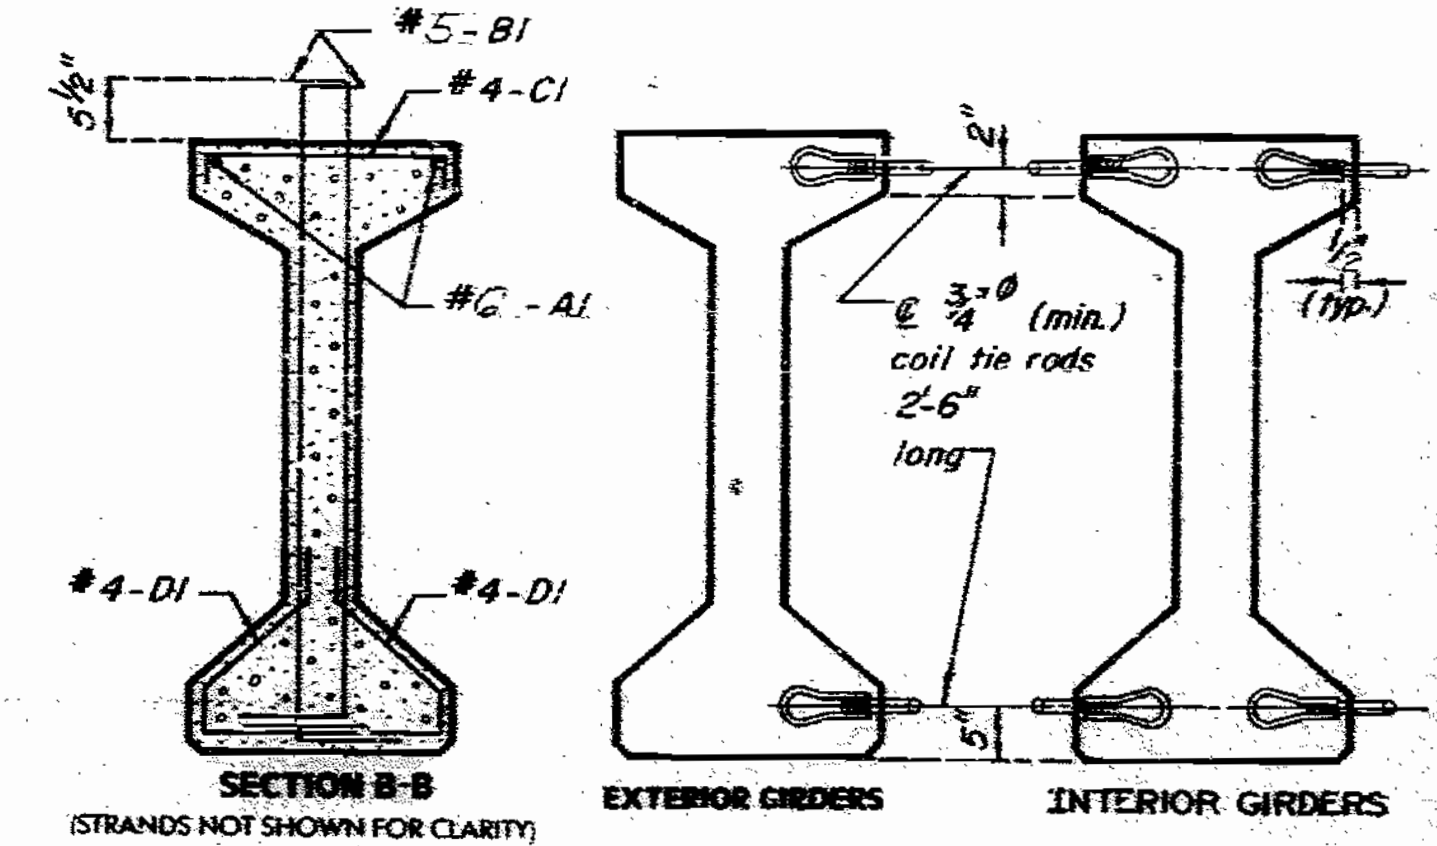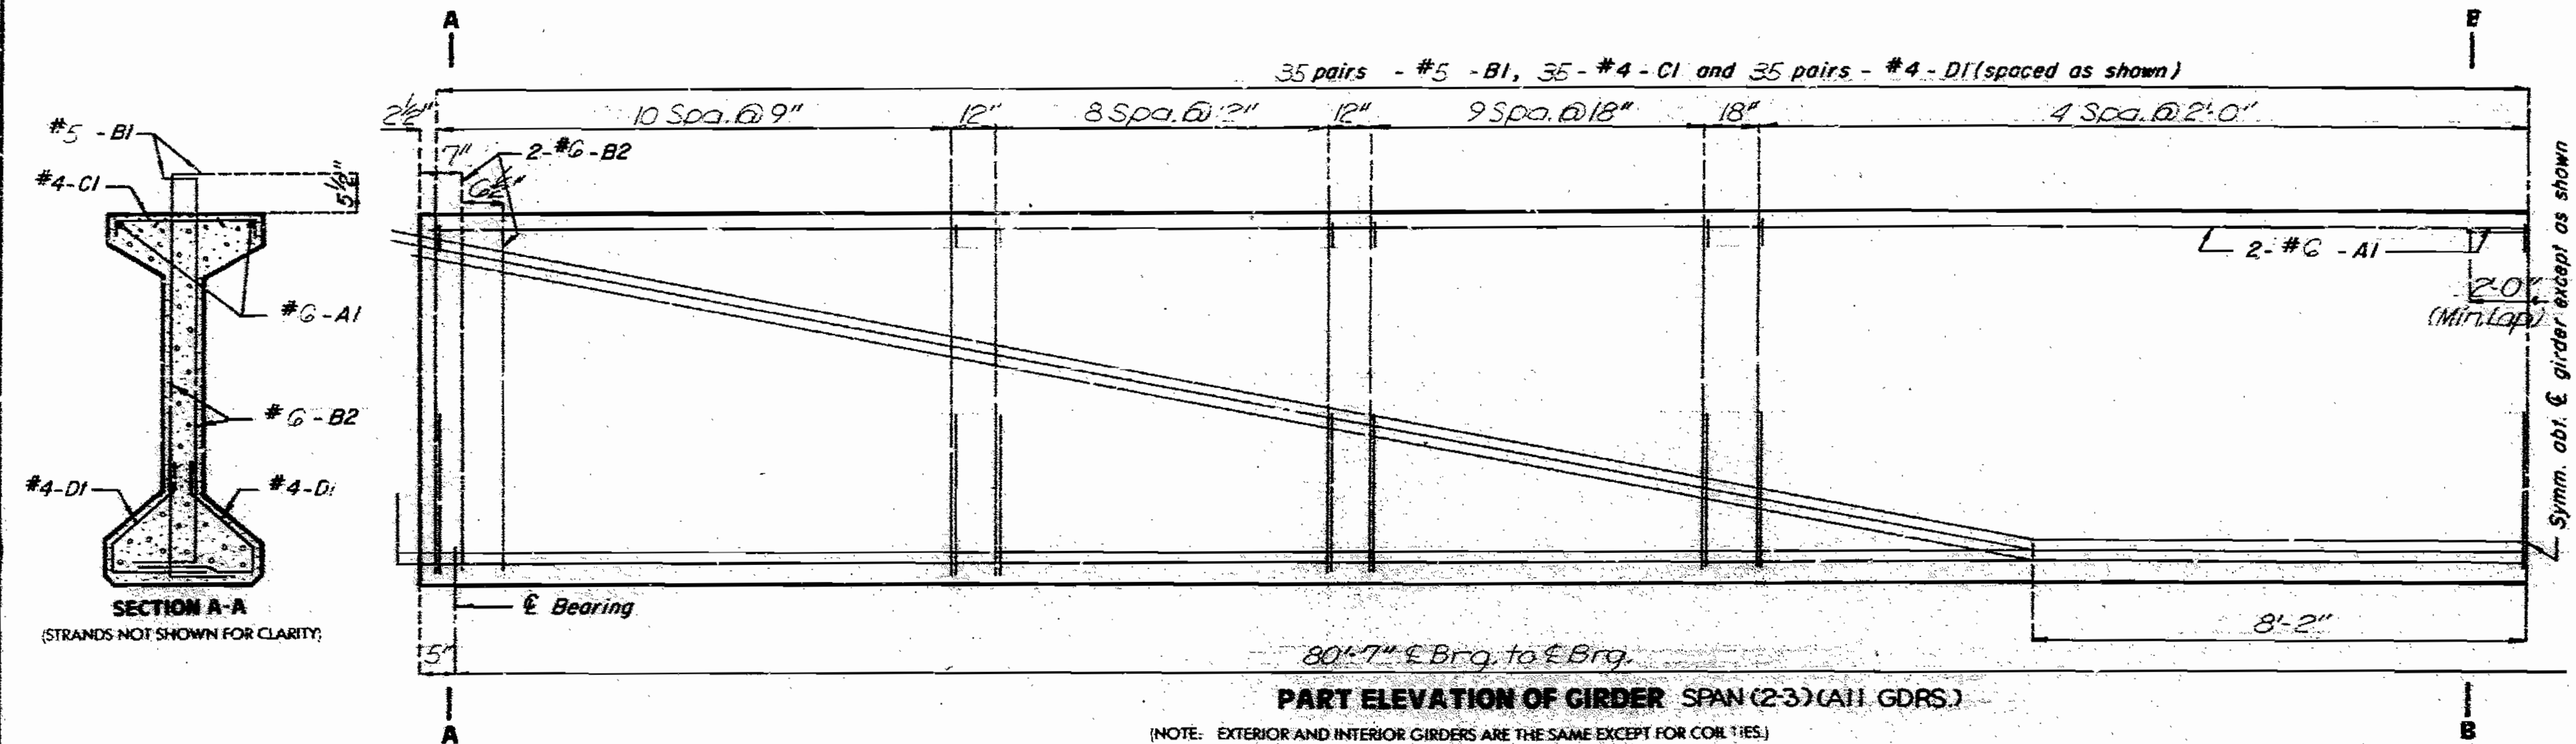

**NOTE:**  
 COST OF 3/4" COIL TIE RODS PLACED IN DIAPHRAGMS IS INCLUDED IN CONTRACT UNIT PRICE FOR PRESTRESSED CONCRETE MEMBERS.  
 COIL TIES SHALL BE HELD IN PLACE IN THE FORMS BY SLOTTED WIRE-SETTING STUDS PROJECTING THRU FORMS. STUDS ARE TO BE LEFT IN PLACE OR REPLACED WITH TEMPORARY PLUGS UNTIL GIRDERS ARE ERECTED AND THEN REPLACED BY COIL TIE RODS.

**NOTE:**  
 The 1/2" holes shall be cast in the web for steel intermediate diaphragms. Drilling is not allowed.

Note: For details of Int. Bt. Diaphr., see sheet No. 63  
 For location of Int. Diaphr. and general girder placement, see sheet No. 24  
 For Girder Camber and haunching see sheet No. 69

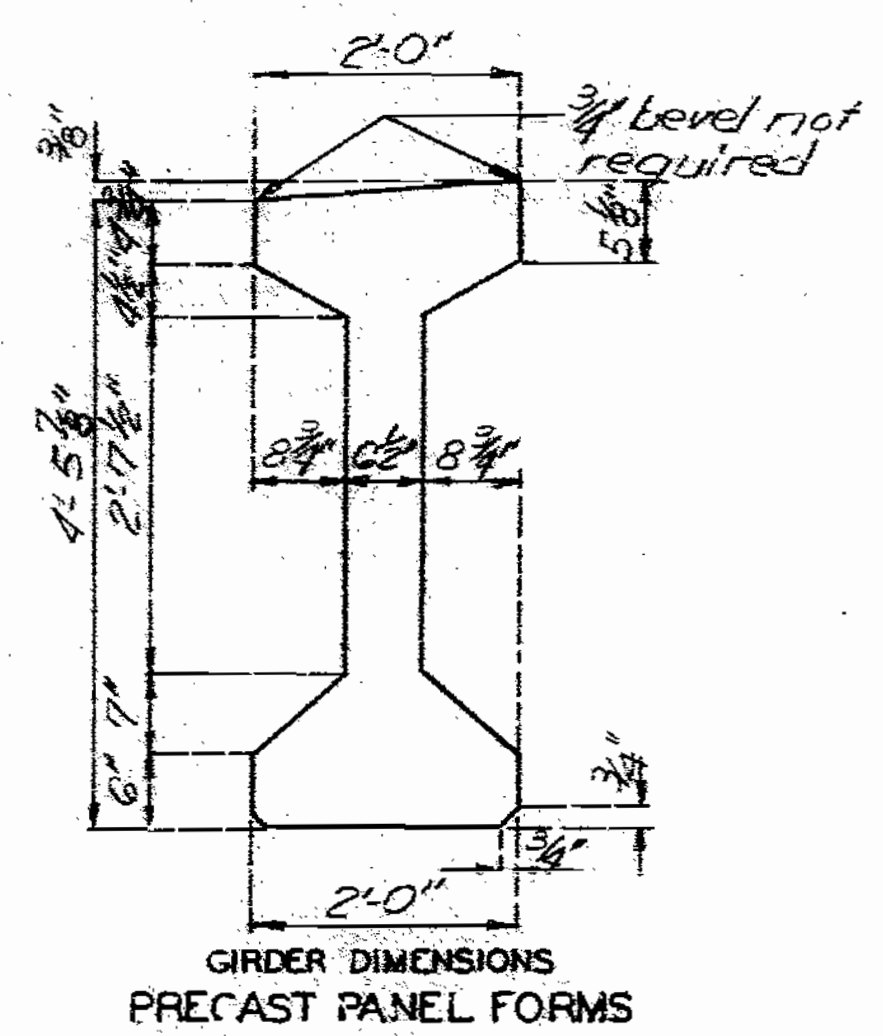

158 185






SPS 55.6.6 1/2 REVISED FEB. 1974 JUNE 1987

DETAILED FEB. 1988  
 CHECKED OCT. 1988

Note: This drawing is not to scale. Follow dimensions.

Sheet No. 28 of 38





**NOTE:**  
 CONCRETE FOR PRESTRESSED GIRDERS SHALL BE CLASS A1 WITH  $f_c = 5,000$  PSI.  
 (+) INDICATES PRESTRESSED STRAND.  
 USE 1/6" STRANDS WITH AN INITIAL PRESTRESS FORCE OF 420 KIPS.  
 PRESTRESSING TENDONS SHALL BE UNCOATED, SEVEN-WIRE, LOW RELAXATION STRANDS, 1/2" INCH DIAMETER CONFORMING TO A.A.S.H.T.O. M203, GRADE 270. SEE MO. STD. SPECIFICATIONS 705.4.8.  
 3/4" bevel not required

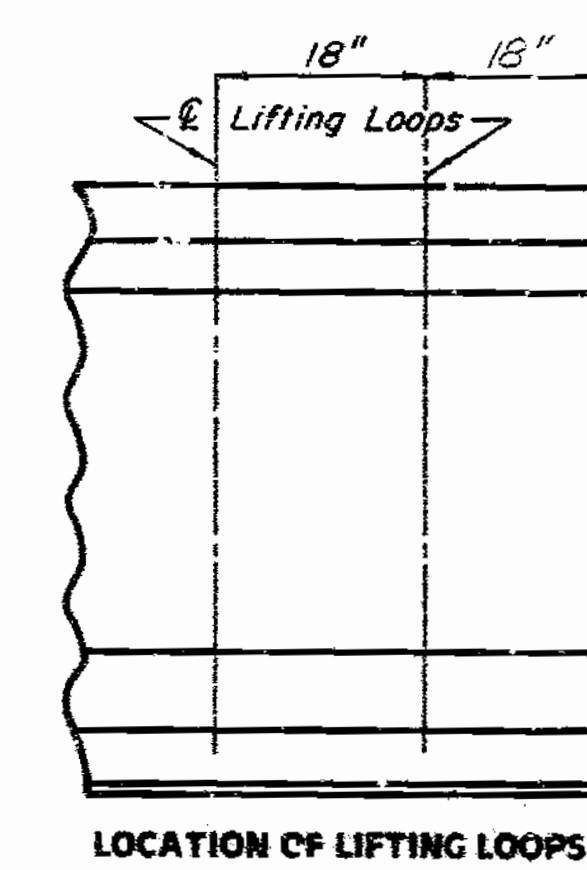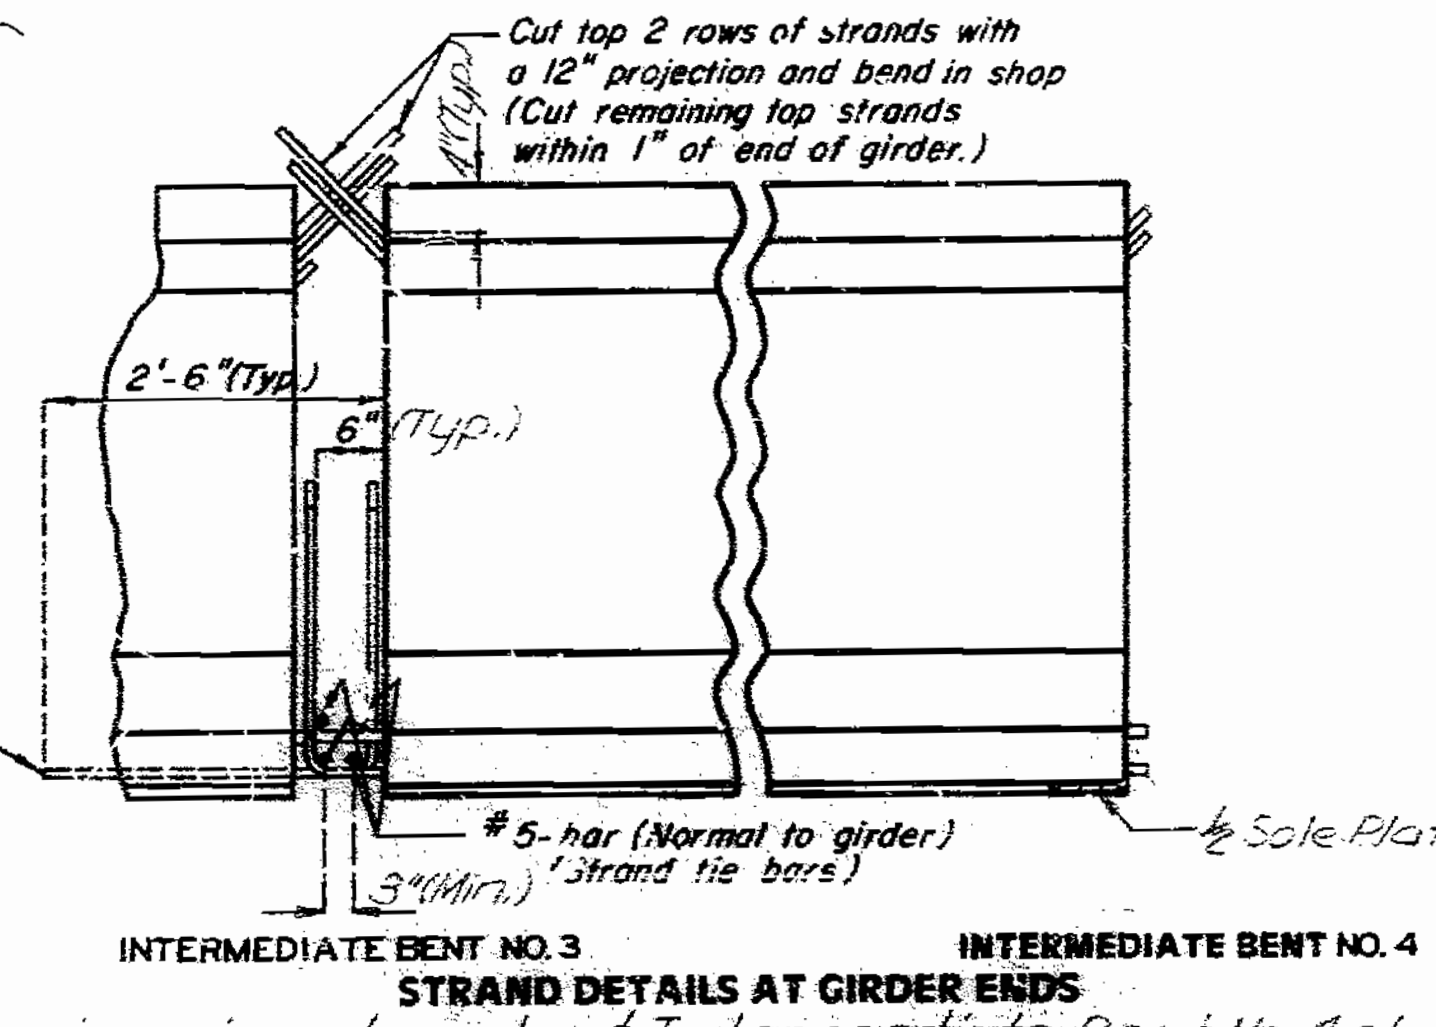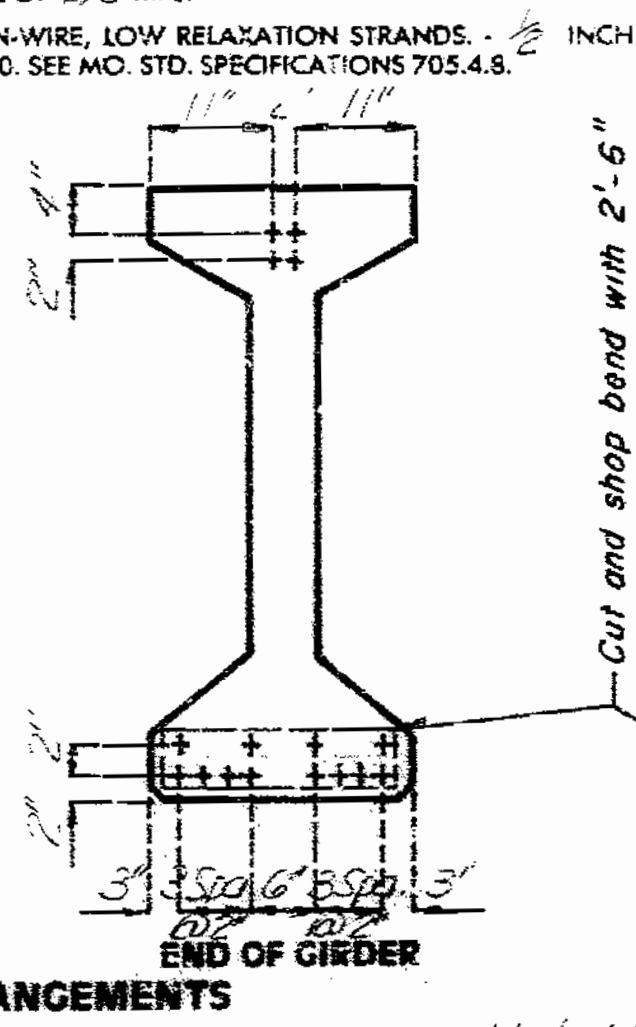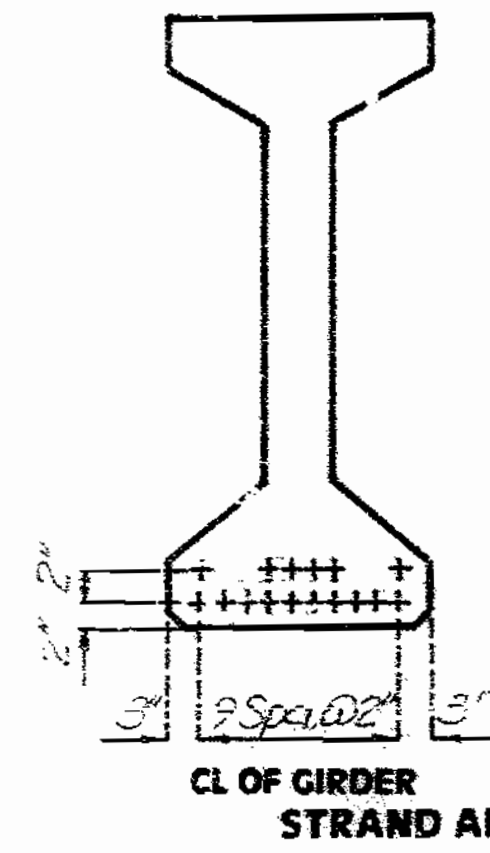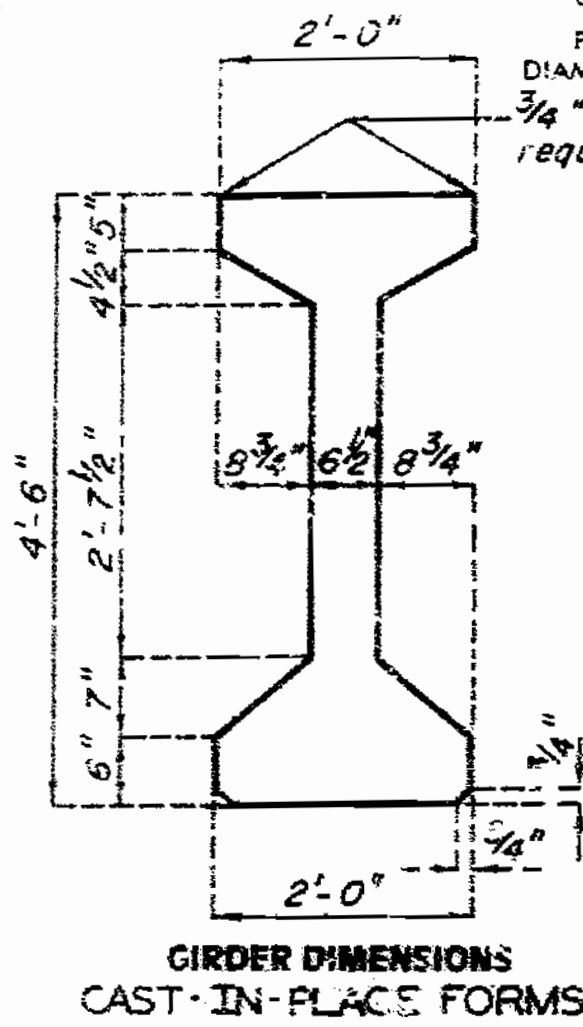

BILL OF REINFORCING STEEL - EACH GIRDER				
NO.	SIZE & MARK	ACTUAL LENGTH	SHAPE	BENDING DIAGRAMS
4	G A1	①	20	SHAPE 10
122	S B1	5'-11"	11	SHAPE 10
8	S B2	5'-4"	11	SHAPE 10
G1	4 C1	2'-2"	10	SHAPE 9
122	4 D1	3'-0"	9	SHAPE 20

**NOTE:**  
 ALL DIMENSIONS IN BENDING DIAGRAM ARE OUT TO OUT.  
 HOOKS AND BENDS SHALL BE IN ACCORDANCE WITH THE CRSI MANUAL OF STANDARD PRACTICE FOR DETAILING REINFORCED CONCRETE STRUCTURES STIRRUPS AND TIE DIMENSIONS.  
 ACTUAL LENGTHS ARE MEASURED ALONG CENTERLINE BAR TO THE NEAREST INCH.  
 MINIMUM CLEARANCE TO REINFORCING SHALL BE 1".  
 ALL REINFORCEMENT SHALL BE GRADE 60.  
 THE TWO D1 BARS MAY BE FURNISHED AS ONE BAR AT THE FABRICATOR'S OPTION.


Note: Prestressing strands at Intermediate Bent No. 4 shall be trimmed to within 1/2 inch of concrete if exposed, or 1 inch of concrete if encased. Exposed ends of girders shall be given 2 coats of an asphalt paint. Ends of girders which will be encased in concrete diaphragms shall not be painted.  
 31 pairs - #5 - b., 31 - #4 - C1 and 31 pairs - #4 - D1 (spaced as shown)

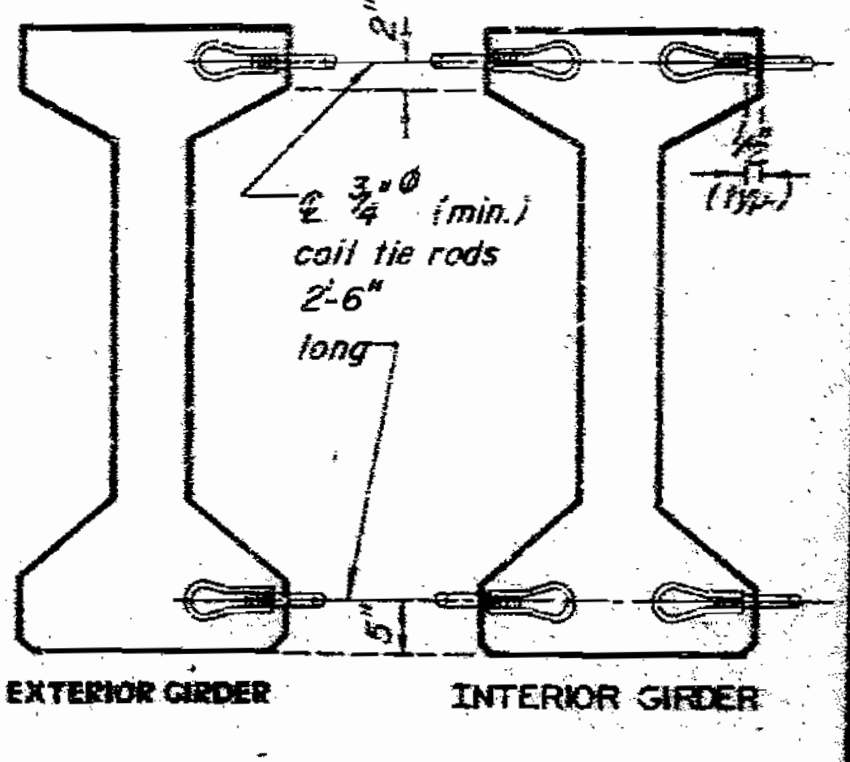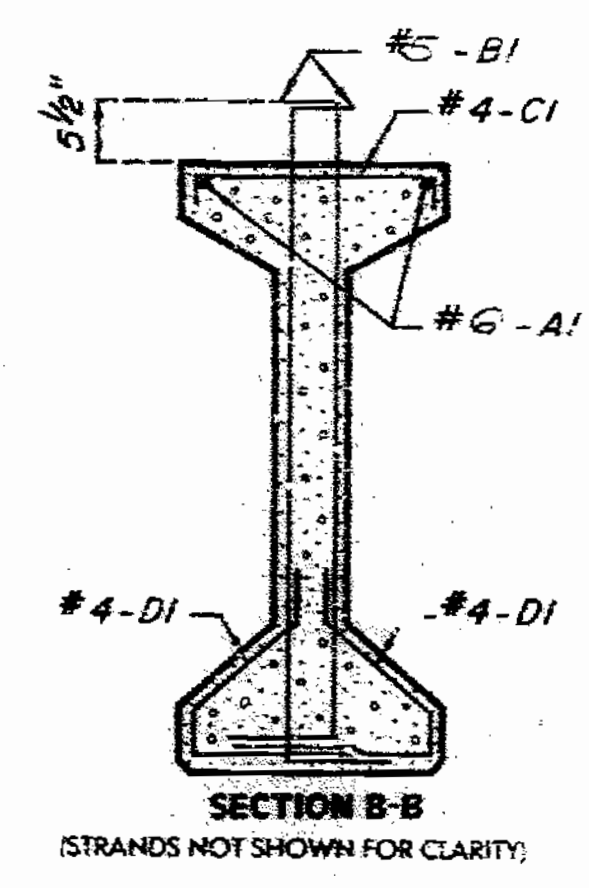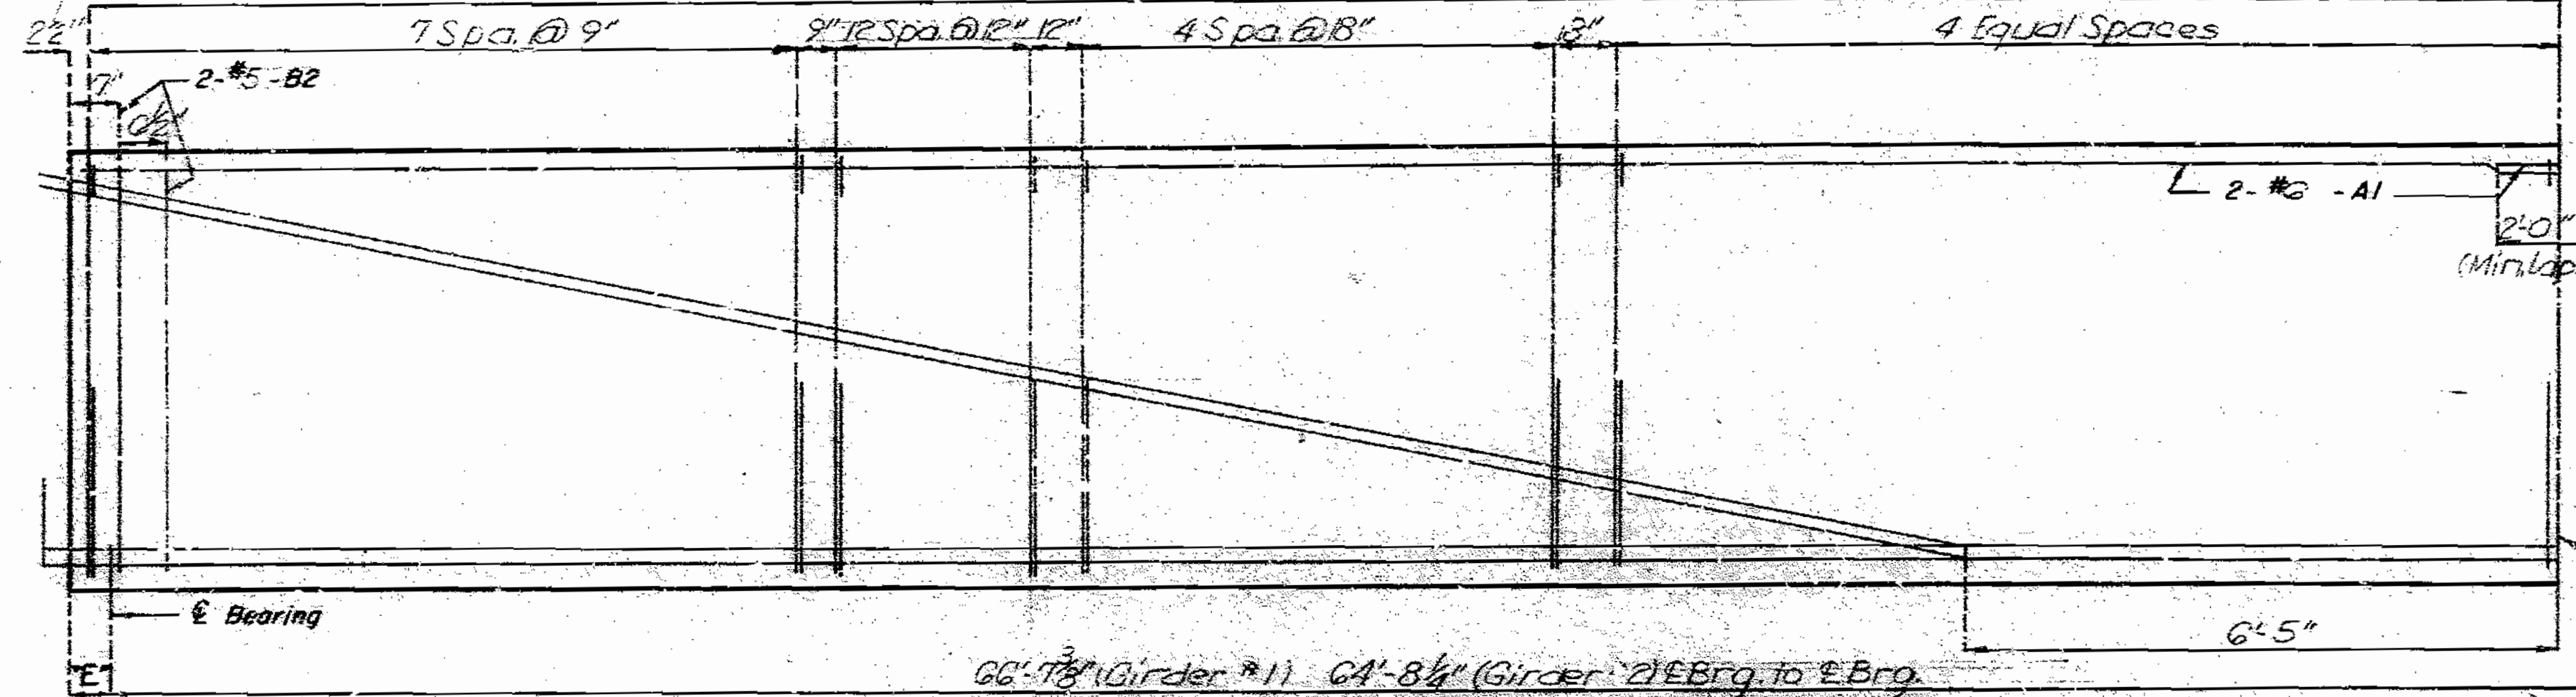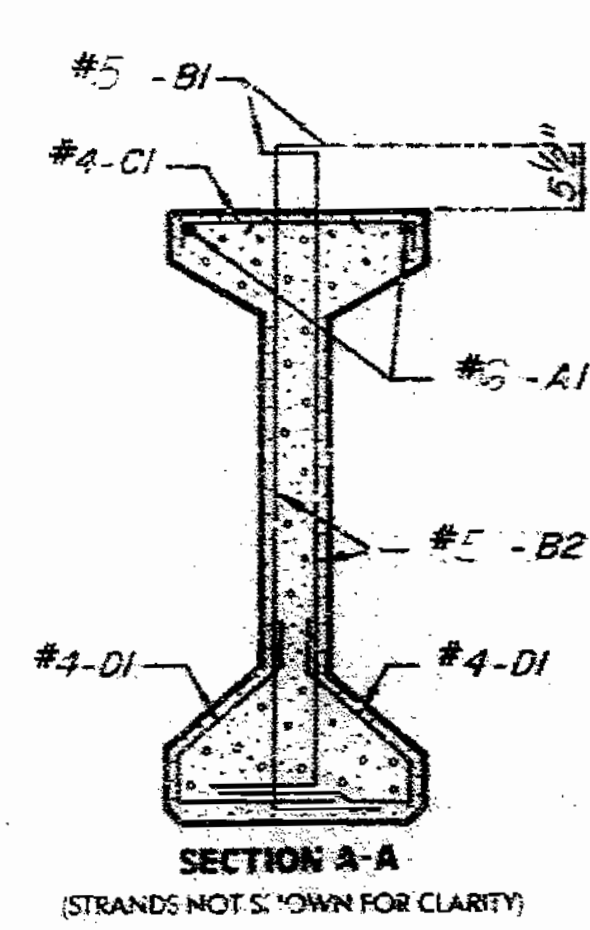


**DETAILS OF COIL TIES AT INT. BENT NO. 3**

**NOTE:**  
 COST OF 3/4" COIL TIE RODS PLACED IN DIAPHRAGMS IS INCLUDED IN CONTRACT UNIT PRICE FOR PRESTRESSED CONCRETE MEMBERS.  
 COIL TIES SHALL BE HELD IN PLACE IN THE FORMS BY SLOTTED WIRE-SETTING-STUDS PROJECTING THRU FORMS. STUDS ARE TO BE LEFT IN PLACE OR REPLACED WITH TEMPORARY PLUGS UNTIL GIRDERS ARE ERECTED AND THEN REPLACED BY COIL TIE RODS.


**NOTE:**  
 The 1/2" holes shall be cast in the web for steel intermediate diaphragms. Drilling is not allowed.

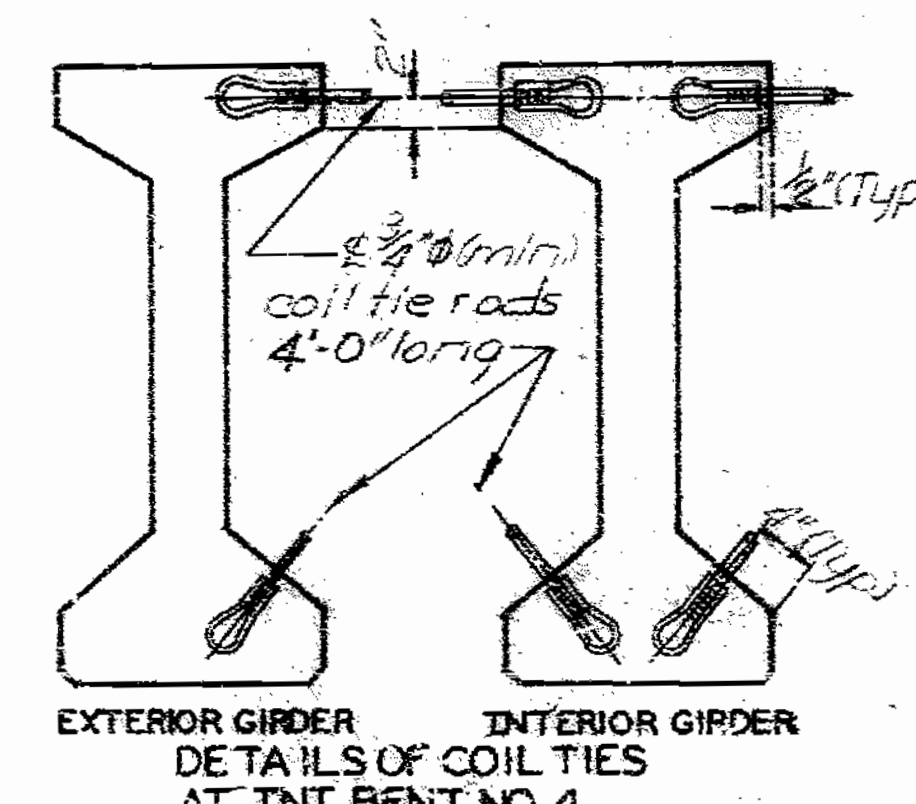

Note: Cost of furnishing and installing plates and welded studs in girders shall be included in price bid for Prestressed Concrete I-Girders per each. See Special Provisions for painting.

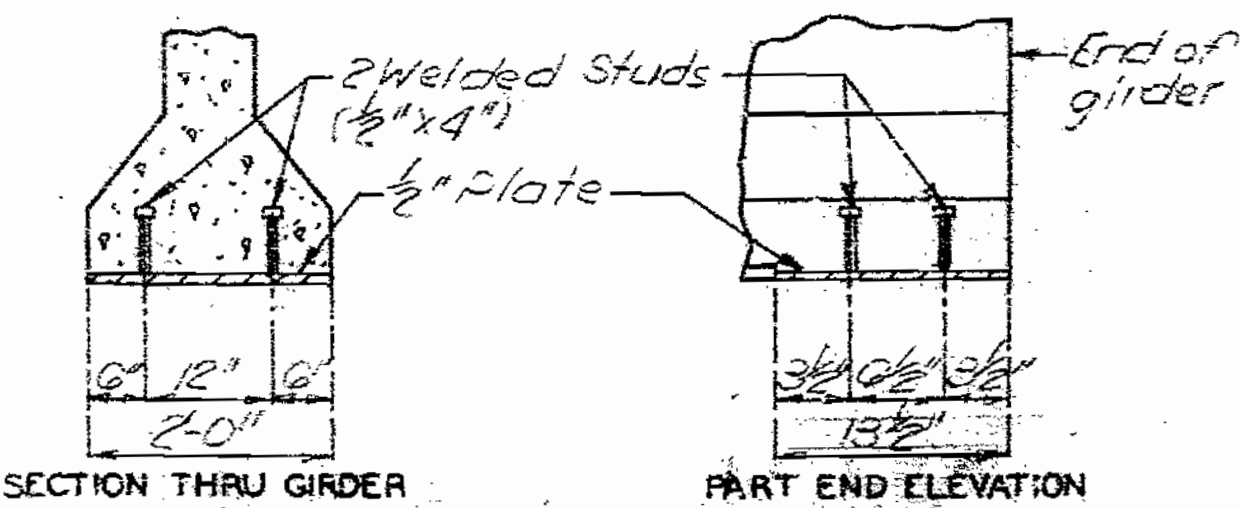

Note: Sole Plate to be placed at Bent No. 4 end of girder only.  
 Note: This drawing is not to scale. Follow dimensions.

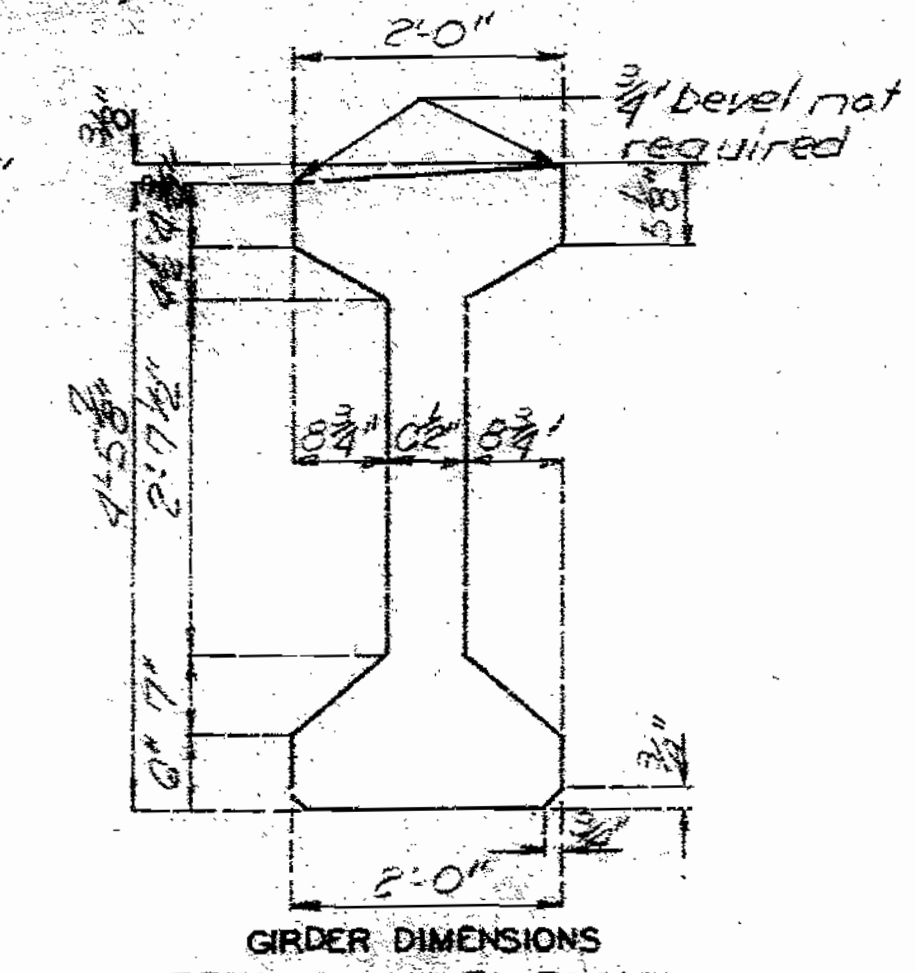

\*E\* = 5" Gdr. #1 (F#2) At Bt. #3  
 7" (Gdr. #1) At Bt. #4  
 ① 34'-9" (Girder #1)  
 33'-9" (Girder #2)

157 1074

REVISED JUNE 1987  
 FEB. 1974  
 SPS 55.6.6.2

DETAILED FEB. 1988  
 CHECKED OCT. 1988

Sheet No. 23 of 38

JACKSON COUNTY





A-2745



NOTE:

CONCRETE FOR PRESTRESSED GIRDERS SHALL BE CLASS A1 WITH  $f_c = 5,000$  PSI.  
 (+) INDICATES PRESTRESSED STRAND.  
 USE  $\phi$  STRANDS WITH AN INITIAL PRESTRESS FORCE OF 434 KIPS.  
 PRESTRESSING TENDONS SHALL BE UNCOATED, SEVEN-WIRE, LOW RELAXATION STRANDS,  $\frac{1}{2}$  INCH DIAMETER CONFORMING TO A.S.A.H.T.O. M203, GRADE 270. SEE MC. STD. SPECIFICATIONS 705.4.8.



STATE	PROJ NO	SHEET NO
MO		110

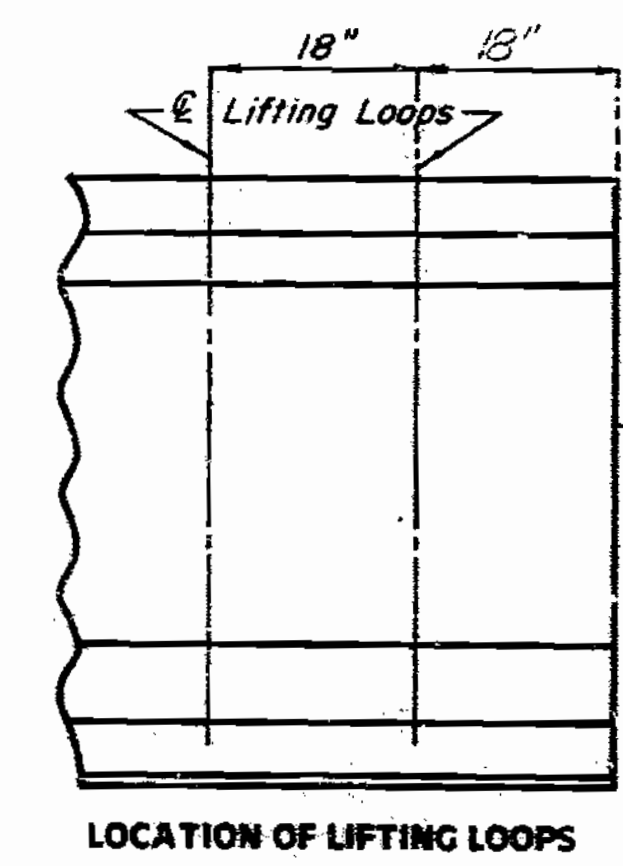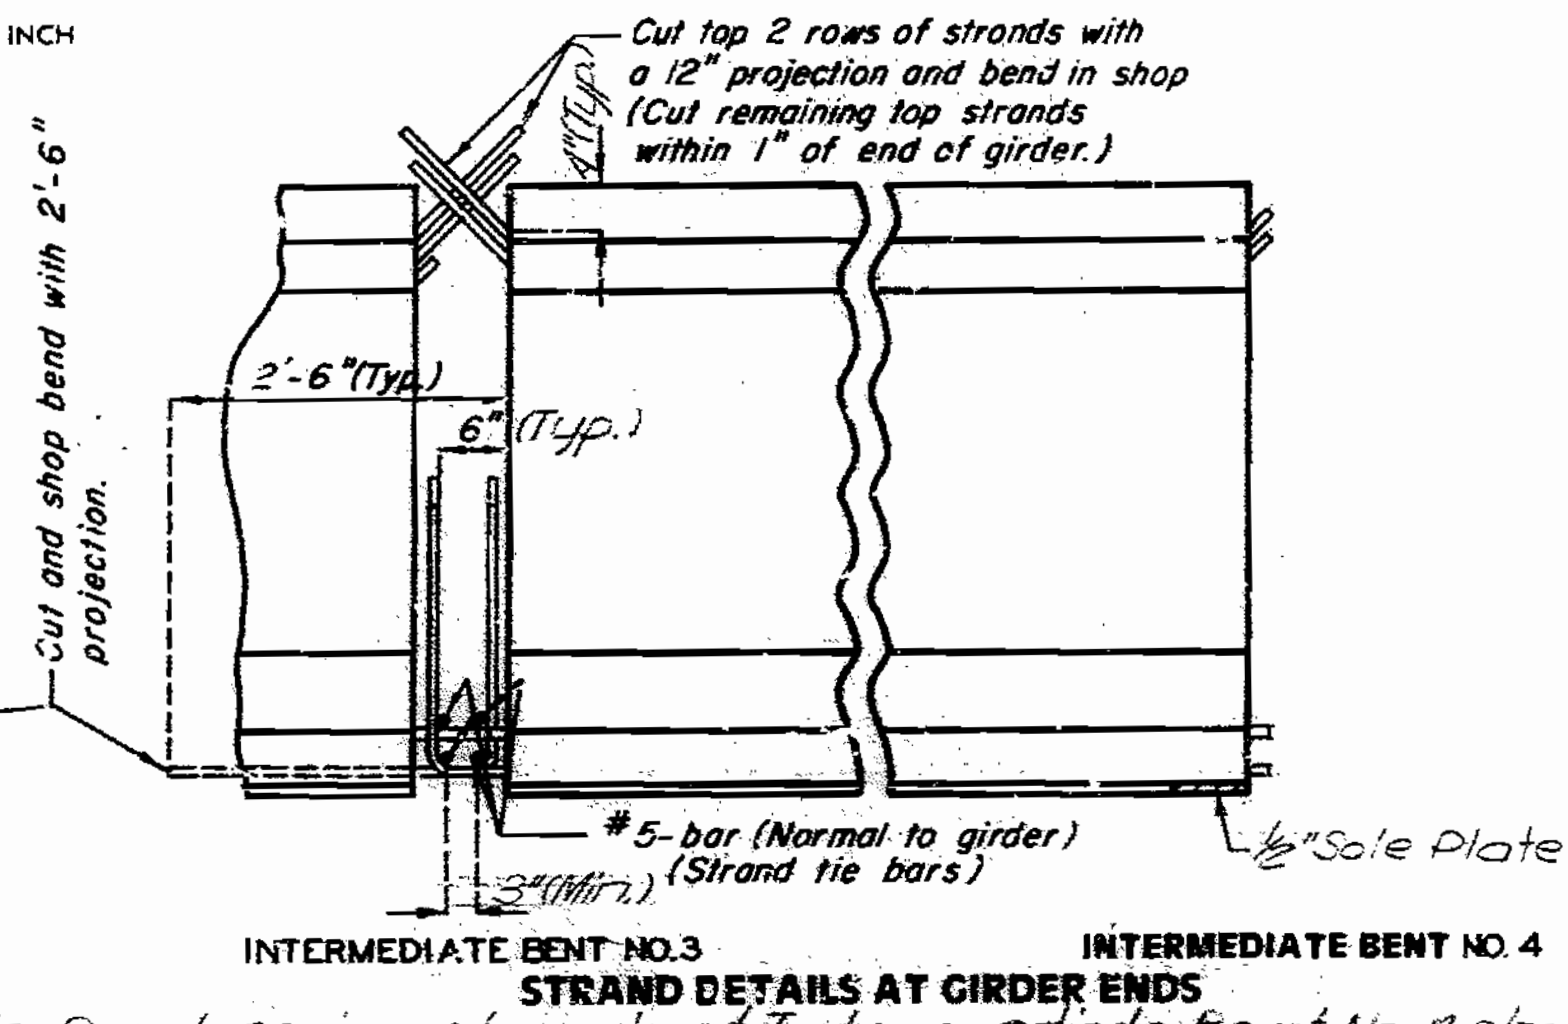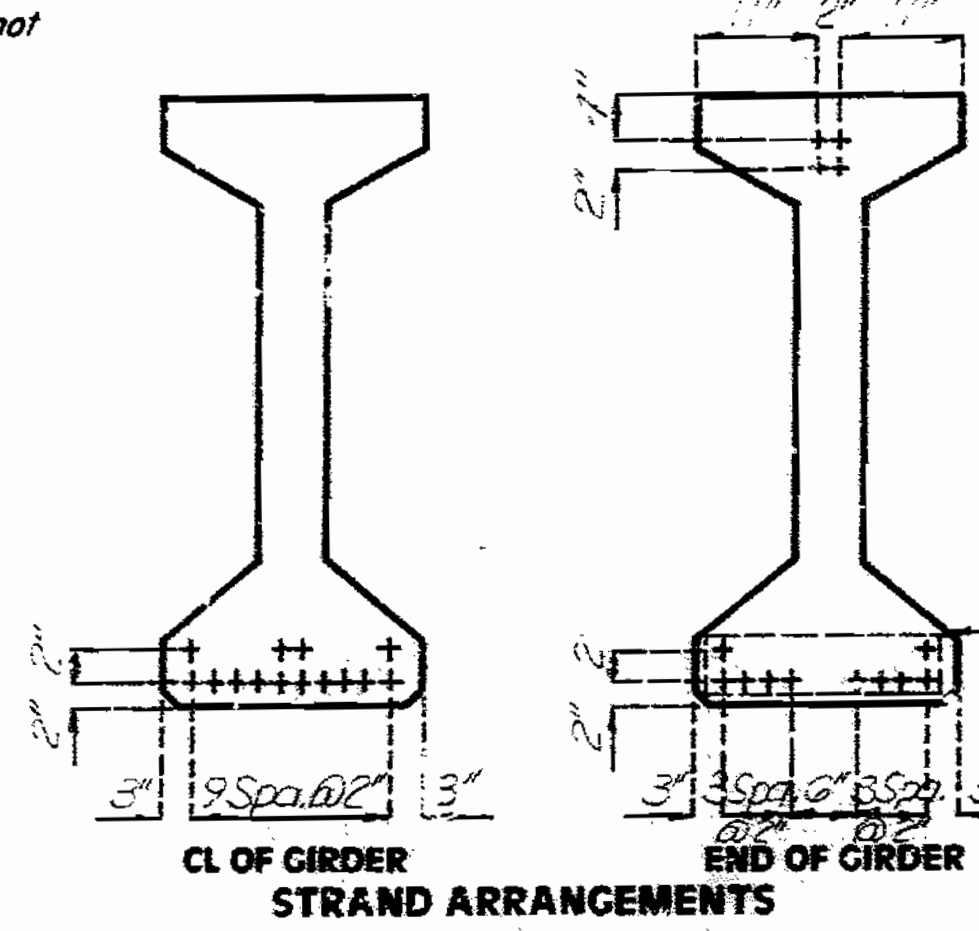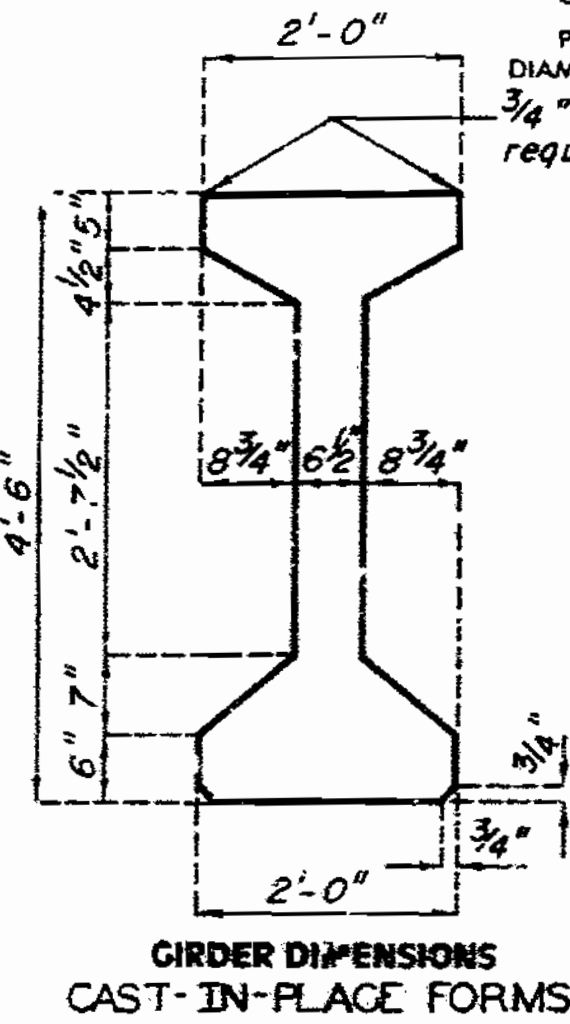

BILL OF REINFORCING STEEL - EACH GIRDER				BENDING DIAGRAMS	
NO.	SIZE & MARK	ACTUAL LENGTH	SHAPE		
1	CA1	①	20		
1/4	5B1	5'-11"	11	SHAPE 10	
4	GB2	5'-4"	11	SHAPE 9	
57	4C1	2'-2"	10	SHAPE 20	
1/4	4D1	3'-0"	9	SHAPE 11	

NOTE:  
 ALL DIMENSIONS IN BENDING DIAGRAM ARE OUT TO OUT.  
 HOOKS AND BENDS SHALL BE IN ACCORDANCE WITH THE CRSI MANUAL OF STANDARD PRACTICE FOR DETAILING REINFORCED CONCRETE STRUCTURES STRIPPED AND THE DIMENSIONS.  
 ACTUAL LENGTHS ARE MEASURED ALONG CENTERLINE BAR TO THE NEAREST INCH.  
 MINIMUM CLEARANCE TO REINFORCING SHALL BE 1".  
 ALL REINFORCEMENT SHALL BE GRADE 60.  
 THE TWO D1 BARS MAY BE FURNISHED AS ONE BAR AT THE FABRICATOR'S OPTION.

Note: Prestressing strands at Intermediate Bent No. 4 shall be trimmed to within 1/2 inch of concrete if exposed, or 1 inch of concrete if encased. Exposed ends of girders shall be given 2 coats of an asphalt paint. Ends of girders which will be encased in concrete diaphragms shall not be painted.  
 29 pairs - #5 - B1, 29 - #4 - C1 and 29 pairs - #4 - D1 (spaced as shown)

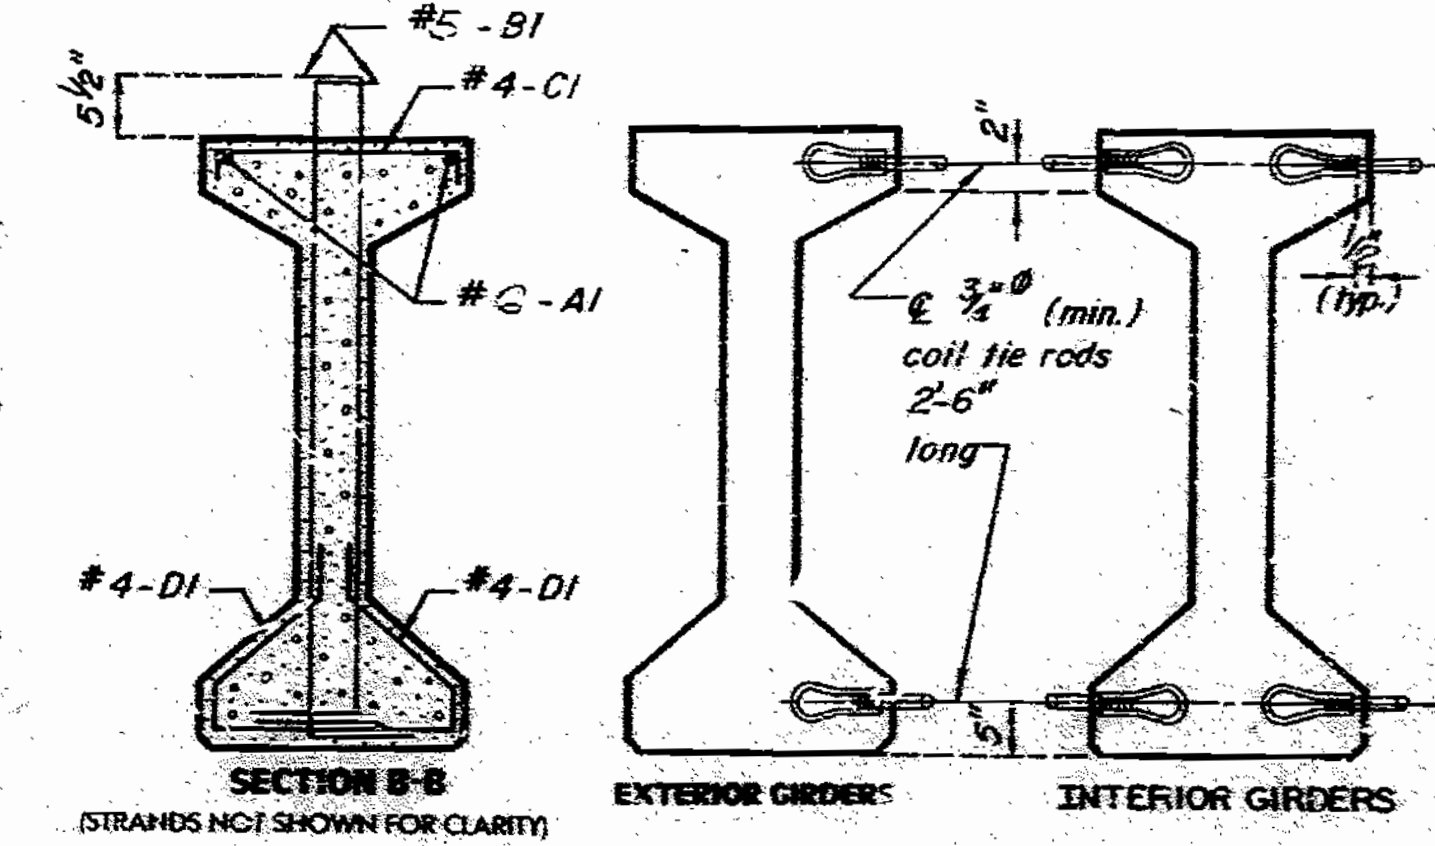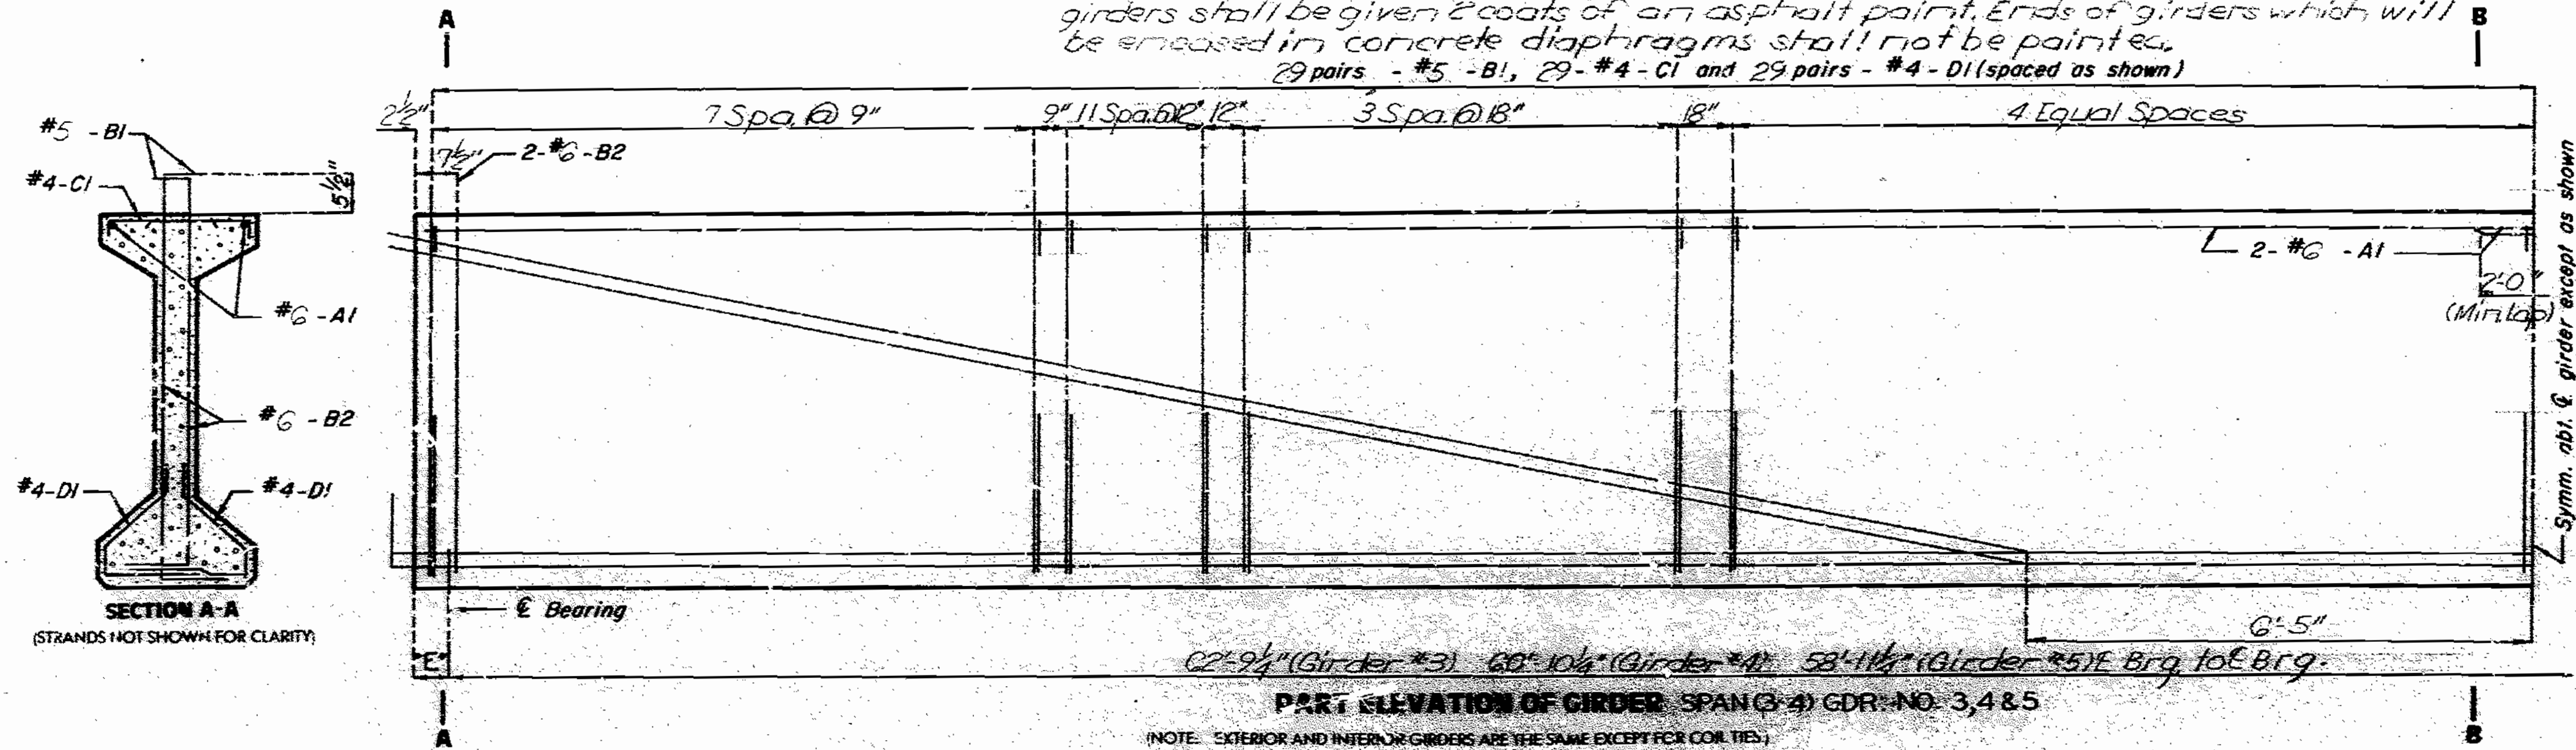




DETAILS OF COIL TIES AT INT. BENT NO. 3

NOTE:  
 COST OF 3/4" COIL TIE RODS PLACED IN DIAPHRAGMS IS INCLUDED IN CONTRACT UNIT PRICE FOR PRESTRESSED CONCRETE MEMBERS.  
 COIL TIES SHALL BE HELD IN PLACE IN THE FORMS BY SLOTTED WIRE SETTING STUDS PROJECTING THRU FORMS. STUDS ARE TO BE LEFT IN PLACE OR REPLACED WITH TEMPORARY PLUGS UNTIL GIRDERS ARE ERECTED AND THEN REPLACED BY COIL TIE RODS.

NOTE:  
 The 1/2" holes shall be cast in the web for steel intermediate diaphragms. Drilling is not allowed.

Note: For details of slotted wells to be cast in top of girder at Int. Bt. #4 end only see sheet No. 64.  
 For details of Int. Bt. Diaph. see sheet No. 63.  
 For location of Int. Diaph. and general girder placement see sheet No. 24.  
 For Girder camber and haunching see sheet No. 69.

E = 5' (Gdr. #3, #4, #5) At Bt. #3  
 7' (Gdr. #3, #4, #5) At Bt. #4  
 ① 32'-10" (Girder #3)  
 31'-10" (Girder #4)  
 30'-0" (Girder #5)

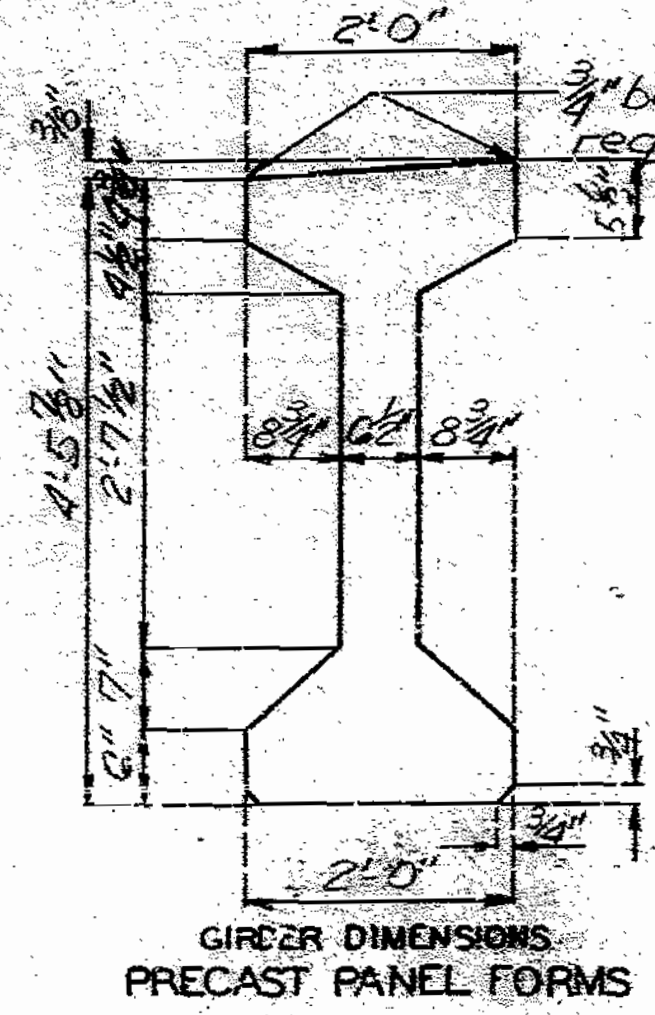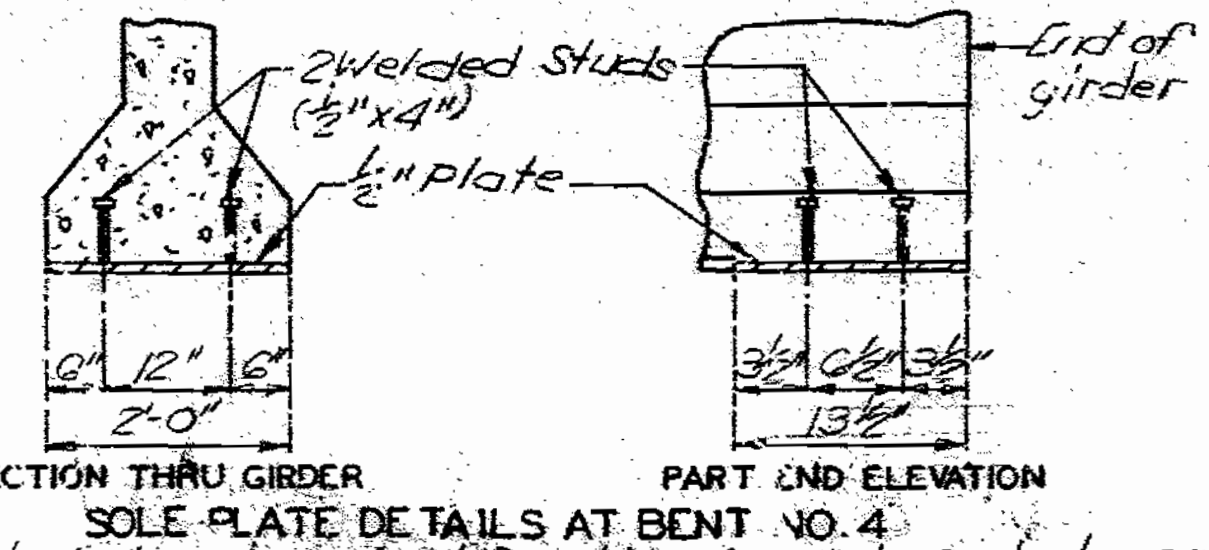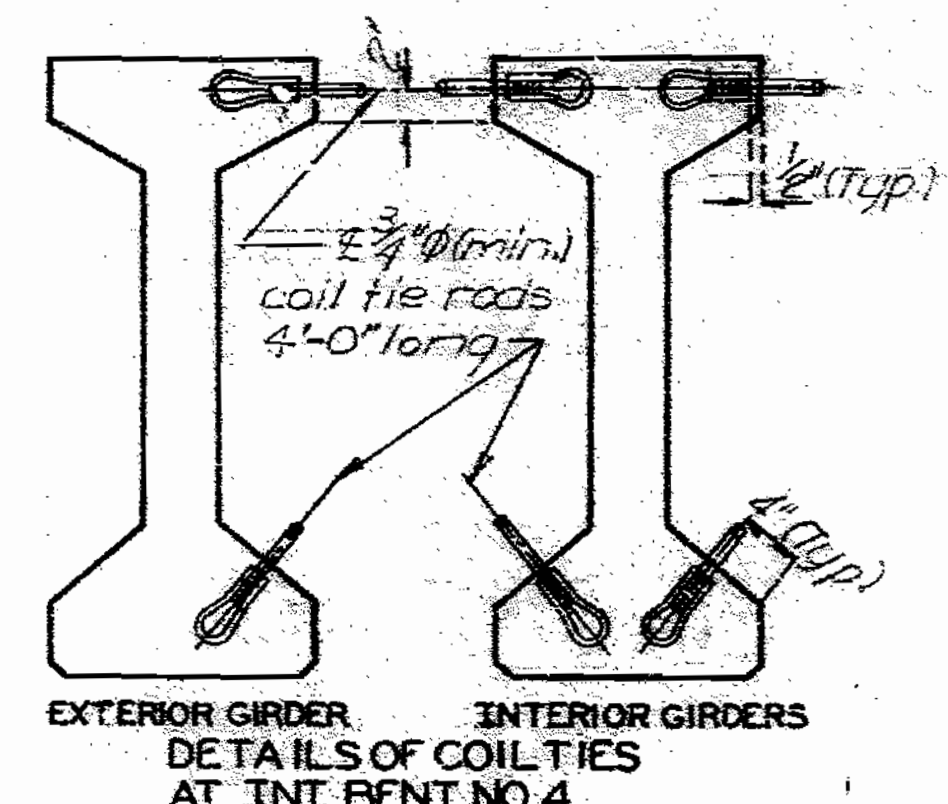

Note: Sole Plate to be placed at Bent No. 4 end of girder only.  
 Note: This drawing is not to scale. Follow dimensions.

158-125

SPS 55.6.6/4  
FEB. 1974  
REVISED  
JUNE 1987

DETAILED FEB. 1988  
 CHECKED OCT. 1988


**NOTE:**

CONCRETE FOR PRESTRESSED GIRDERS SHALL BE CLASS A1 WITH  $F_c = 5,000$  PSI.


(+) INDICATES PRESTRESSED STRAND.

USE 1/4" STRANDS WITH AN INITIAL PRESTRESS FORCE OF 43.2 KIPS.


PRESTRESSING TENDONS SHALL BE UNCOATED, SEVEN-WIRE, LOW RELAXATION STRANDS, 1/4" DIAMETER CONFORMING TO A.A.S.H.T.O. M203, GRADE 270. SEE MO. STP. SPECIFICATIONS 705.4.3.

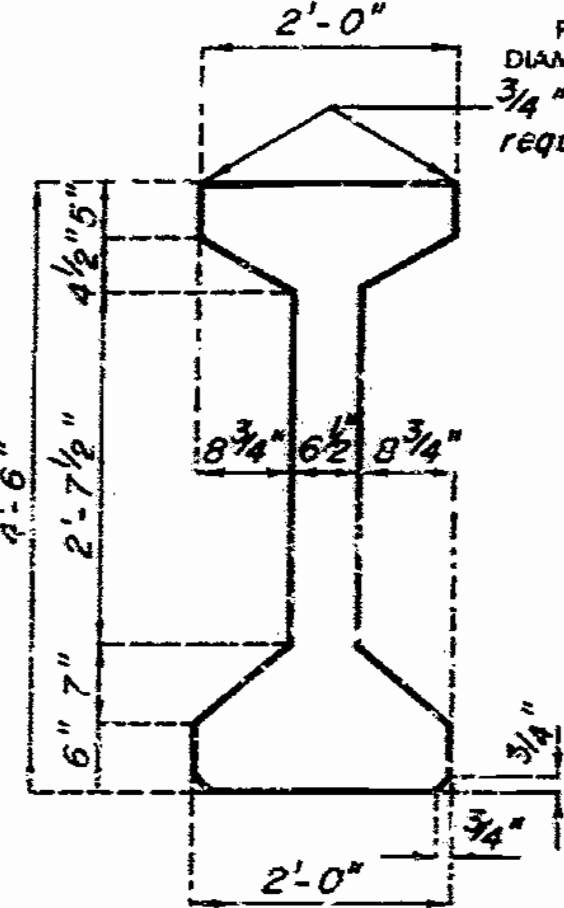


GIRDER DIMENSIONS  
CAST-IN-PLACE FORMS

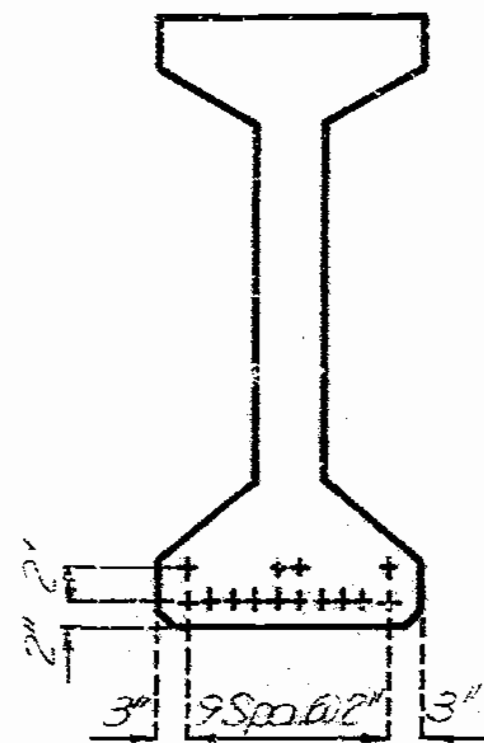

CL OF GIRDER  
STRAND ARRANGEMENTS

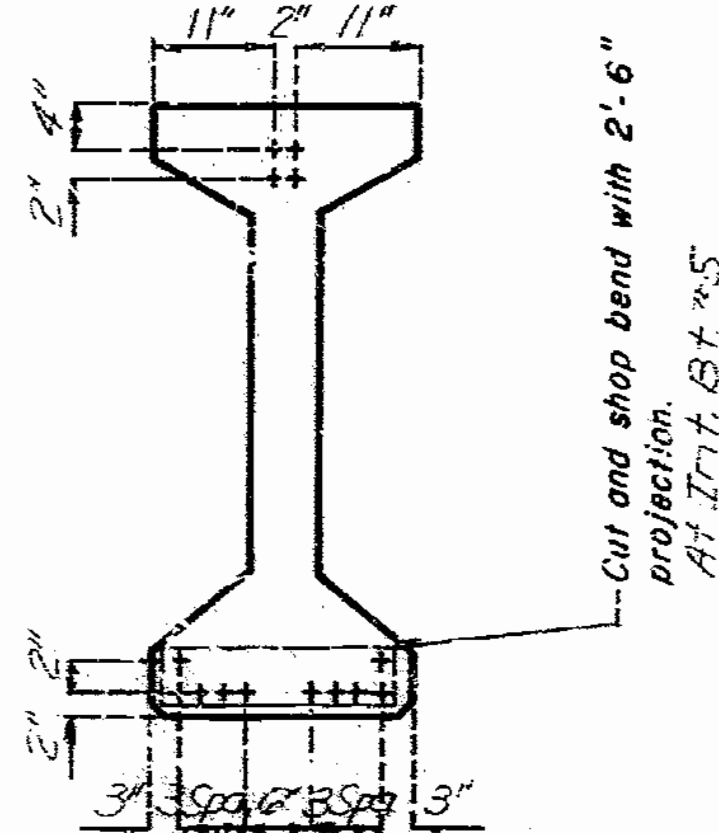

END OF GIRDER

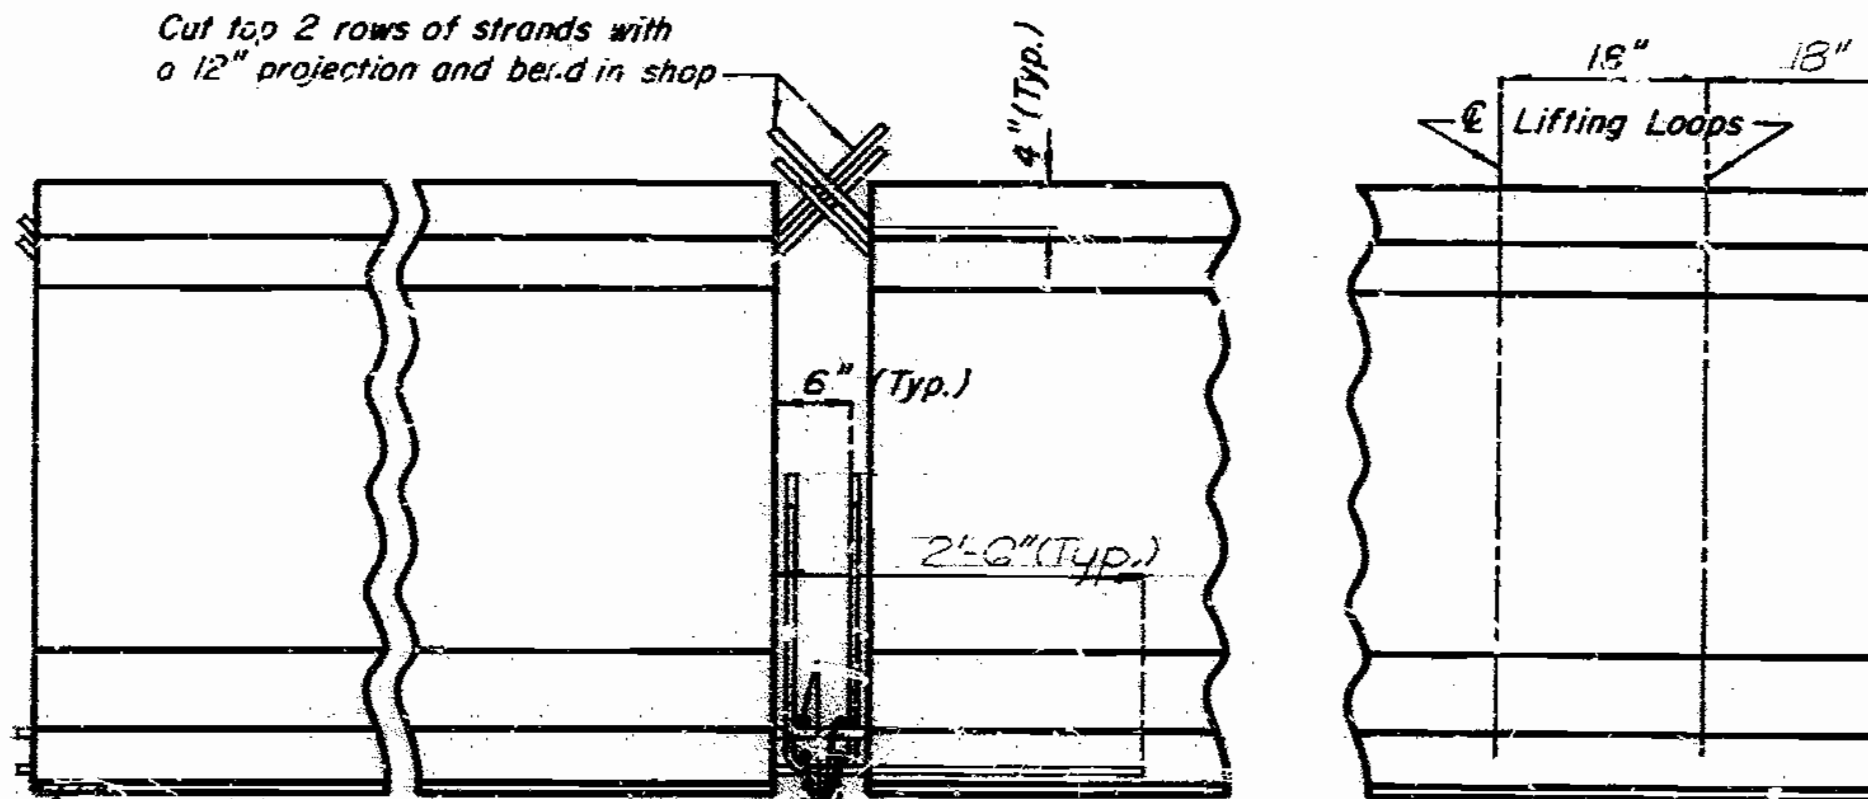


INTERMEDIATE BENT NO. 4  
INTERMEDIATE BENT NO. 5  
STRAND DETAILS AT GIRDER ENDS

Note: Prestressing strands at Intermediate Bent No. 4 shall be trimmed to within 3/8 inch of concrete if exposed, or 1 inch of concrete if encased. Exposed ends of girders shall be given 2 coats of an asphalt paint. Ends of girders which will be encased in concrete diaphragms shall not be painted.  
25 pairs - #5 - B1, 25 - #4 - C1 and 25 pairs - #4 - D1 (spaced as shown)

BILL OF REINFORCING STEEL - EACH GIRDER				BENDING DIAGRAMS	
NO.	SIZE & MARK	ACTUAL LENGTH	SHAPE		
4	CA1	33'-0"	20	SHAPE 10	
98	5.57	5'-11"	11	SHAPE 9	
4	CE2	5'-4"	11	SHAPE 11	
49	AC1	2'-2"	10	SHAPE 20	
98	4D1	3'-0"	9	SHAPE 11	

**NOTE:**

ALL DIMENSIONS IN BENDING DIAGRAM ARE CUT TO OUT.  
HOOKS AND BENDS SHALL BE IN ACCORDANCE WITH THE CRSI MANUAL OF STANDARD PRACTICE FOR DETAILING REINFORCED CONCRETE STRUCTURES STEEL AND TIE DIMENSIONS.  
ACTUAL LENGTHS ARE MEASURED ALONG CENTERLINE BAR TO THE NEAREST INCH.  
MINIMUM CLEARANCE TO REINFORCING SHALL BE 1".  
ALL REINFORCEMENT SHALL BE GRADE 50.  
THE TWO D1 BARS MAY BE FURNISHED AS ONE BAR AT THE FABRICATOR'S OPTION.

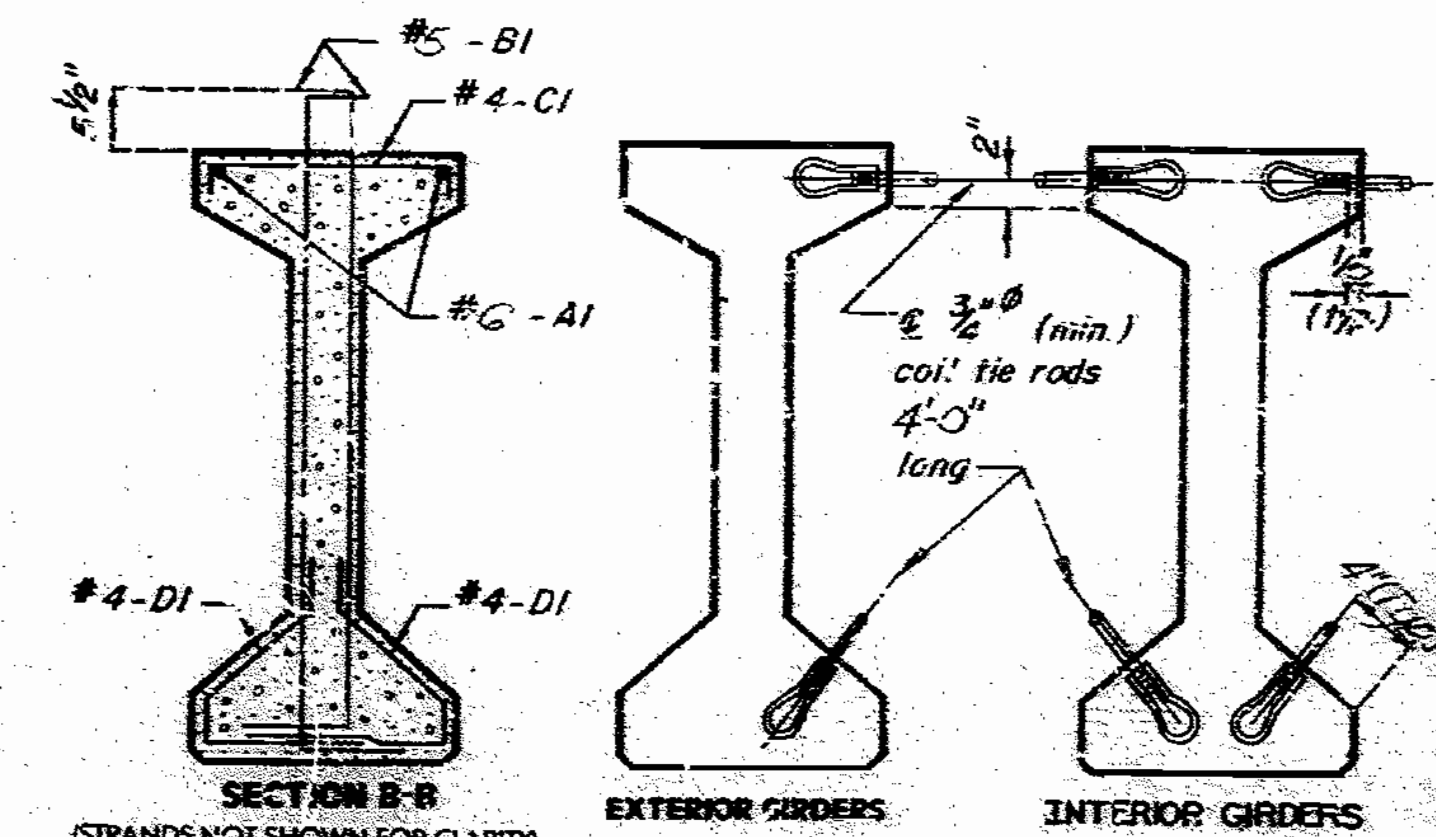


DETAILS OF COIL TIES  
AT INT. BENT NO. 4

**NOTE:**

COST OF 3/4" COIL TIE RODS PLACED IN DIAPHRAGMS IS INCLUDED IN CONTRACT UNIT PRICE FOR PRESTRESSED CONCRETE MEMBERS.  
COIL TIES SHALL BE HELD IN PLACE IN THE FORMS BY SLOTTED WIRE SETTING STUDS PROJECTING THRU FORMS. STUDS ARE TO BE LEFT IN PLACE OR REPLACED WITH TEMPORARY PLUGS UNTIL GIRDERS ARE ERECTED AND THEN REPLACED BY COIL TIE RODS.

**NOTE:**


The 1/2" holes shall be cast in the web for steel intermediate diaphragms. Drilling is not allowed.

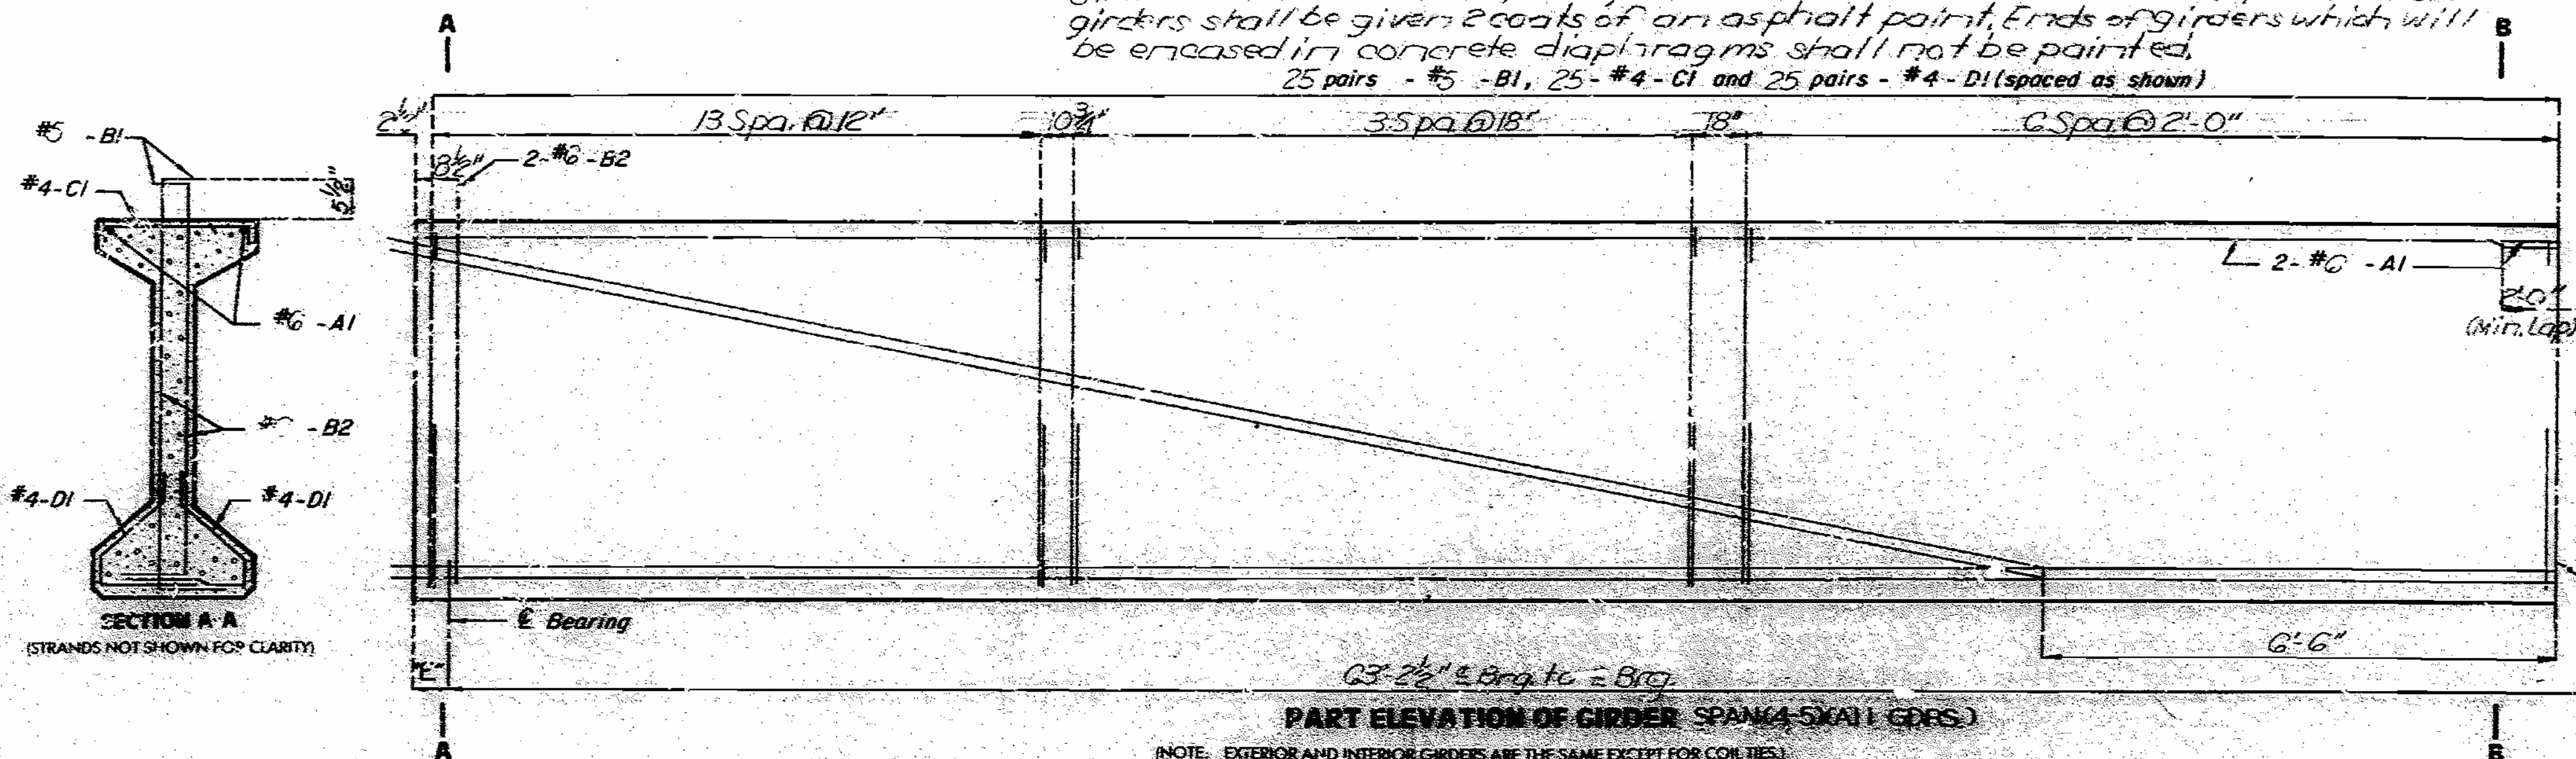

PART ELEVATION OF GIRDER SPAN(S) SMALL GIRDERS


(NOTE: EXTERIOR AND INTERIOR GIRDERS ARE THE SAME EXCEPT FOR COIL TIES.)

Note: For details of slotted wells to be cast in top of girder (at Int. Bt. #4 end only) see sheet No. 64.  
For details of Int. Bt. Diaphragm, see sheet No. 63.  
For location of Int. Diaphragm and general girder placement, see sheet No. 24.  
For Girder camber and haunching, see sheet No. 63.

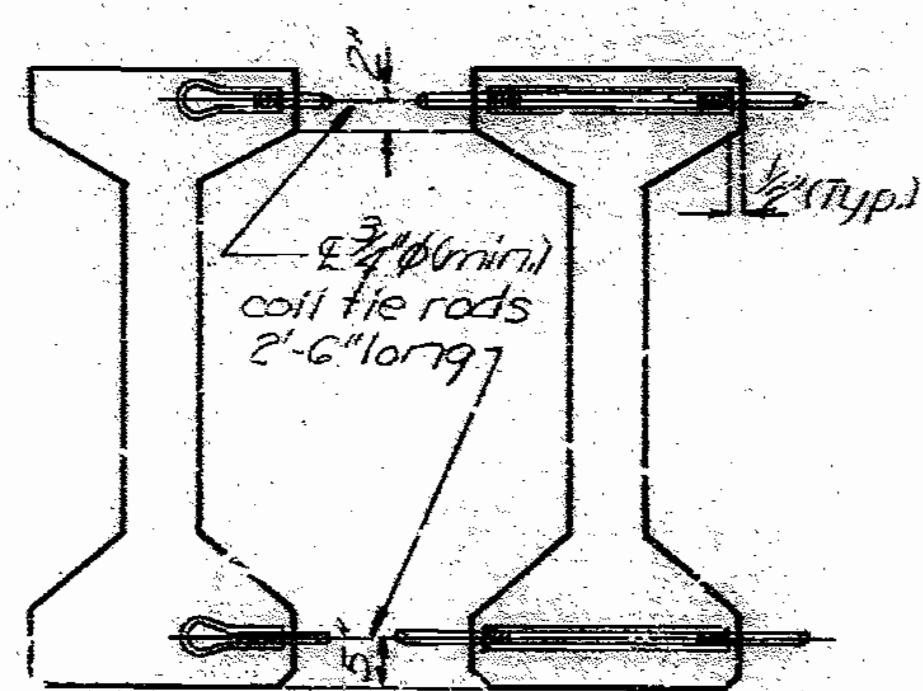

EXTERIOR GIRDERS  
INTERIOR GIRDERS  
DETAILS OF COIL TIES  
AT INT. BENT NO. 5


Note: Cost of furnishing and installing plates and welded studs in girders shall be included in price bid for Prestressed Concrete I-Girders per each. See Special Provisions for painting.

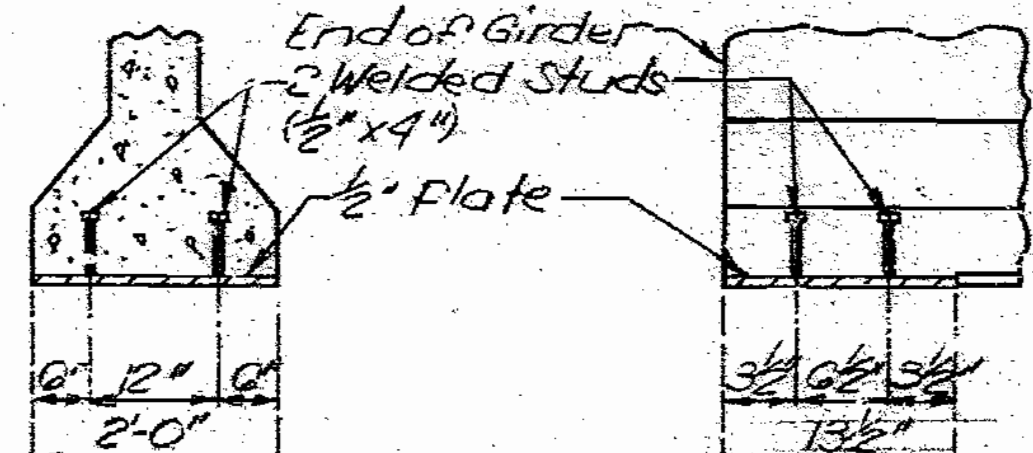

SECTION THRU GIRDER  
PART END ELEVATION

Note: Sole Plate to be placed at Bent No. 4 end of girder only.

Note: This drawing is not to scale. Follow dimensions.

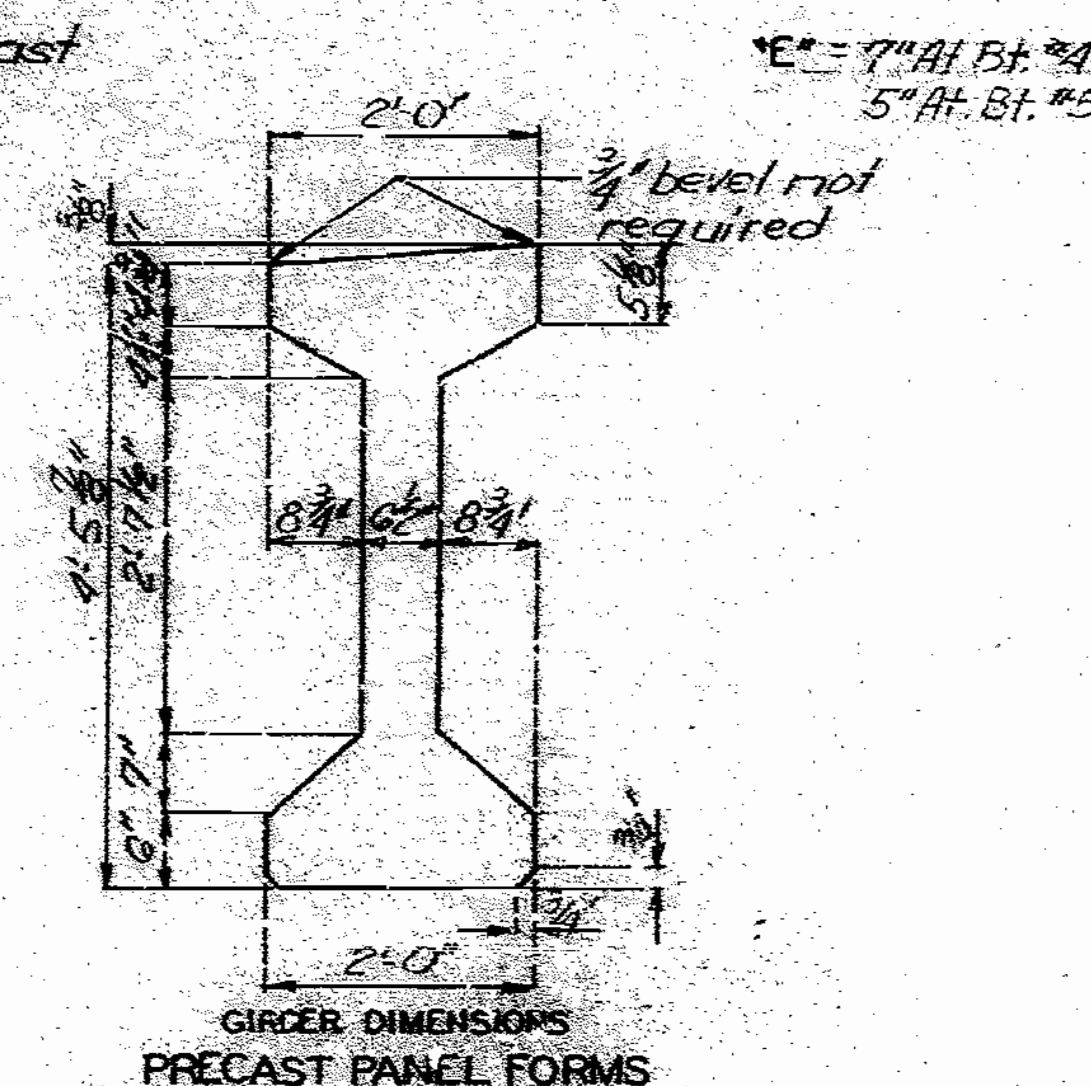


GIRDER DIMENSIONS  
PRECAST PANEL FORMS

SPS 55.5.6 1/2  
REVISED  
JUNE 1987  
FEB. 1974


DETAILED FEB. 1988  
CHECKED OCT. 1988

NOTE:


CONCRETE FOR PRESTRESSED GIRDERS SHALL BE CLASS A1 WITH  $f_c = 5,000$  PSI.  
 (+) INDICATES PRESTRESSED STRAND.  
 USE #16 STRANDS WITH AN INITIAL PRESTRESS FORCE OF 450 KIPS.  
 PRESTRESSING TENDONS SHALL BE UNCOATED, SEVEN-WIRE, LOW RELAXATION STRANDS, 1/2 INCH DIAMETER CONFORMING TO A.A.S.H.T.O. M203, GRADE 270. SEE MO. STD. SPECIFICATIONS 705.4.8.

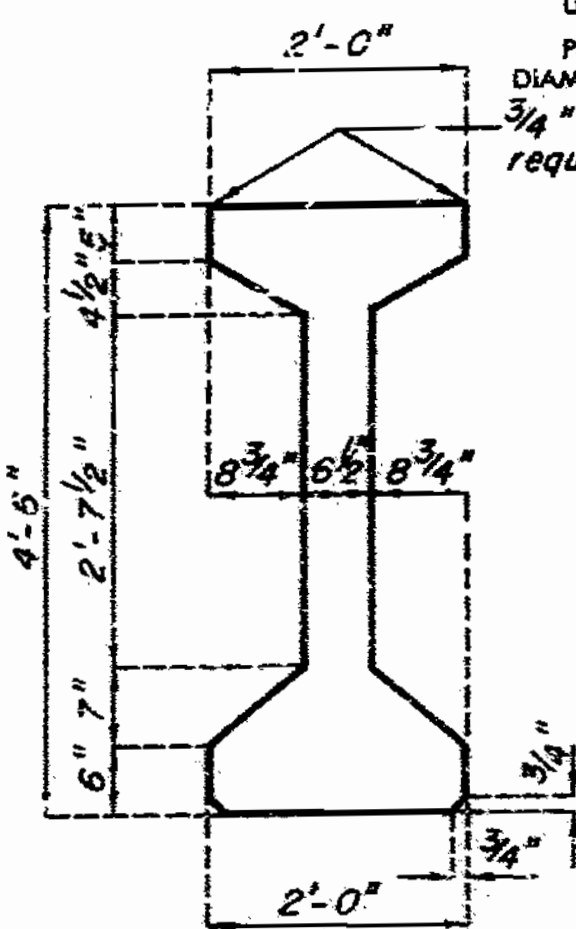


GIRDER DIMENSIONS  
CAST-IN-PLACE FORMS

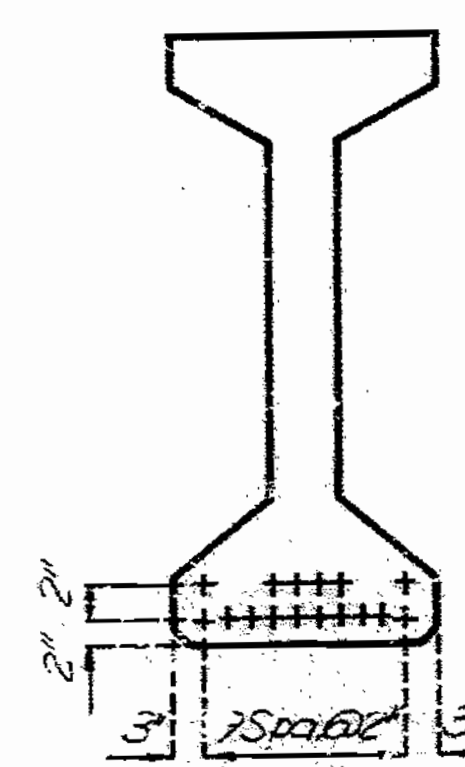


CL OF GIRDER  
STRAND ARRANGEMENTS

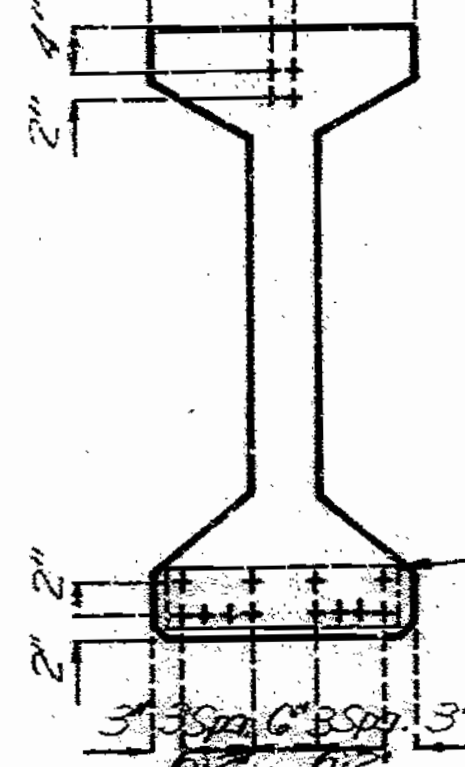

END OF GIRDER  
STRAND ARRANGEMENTS

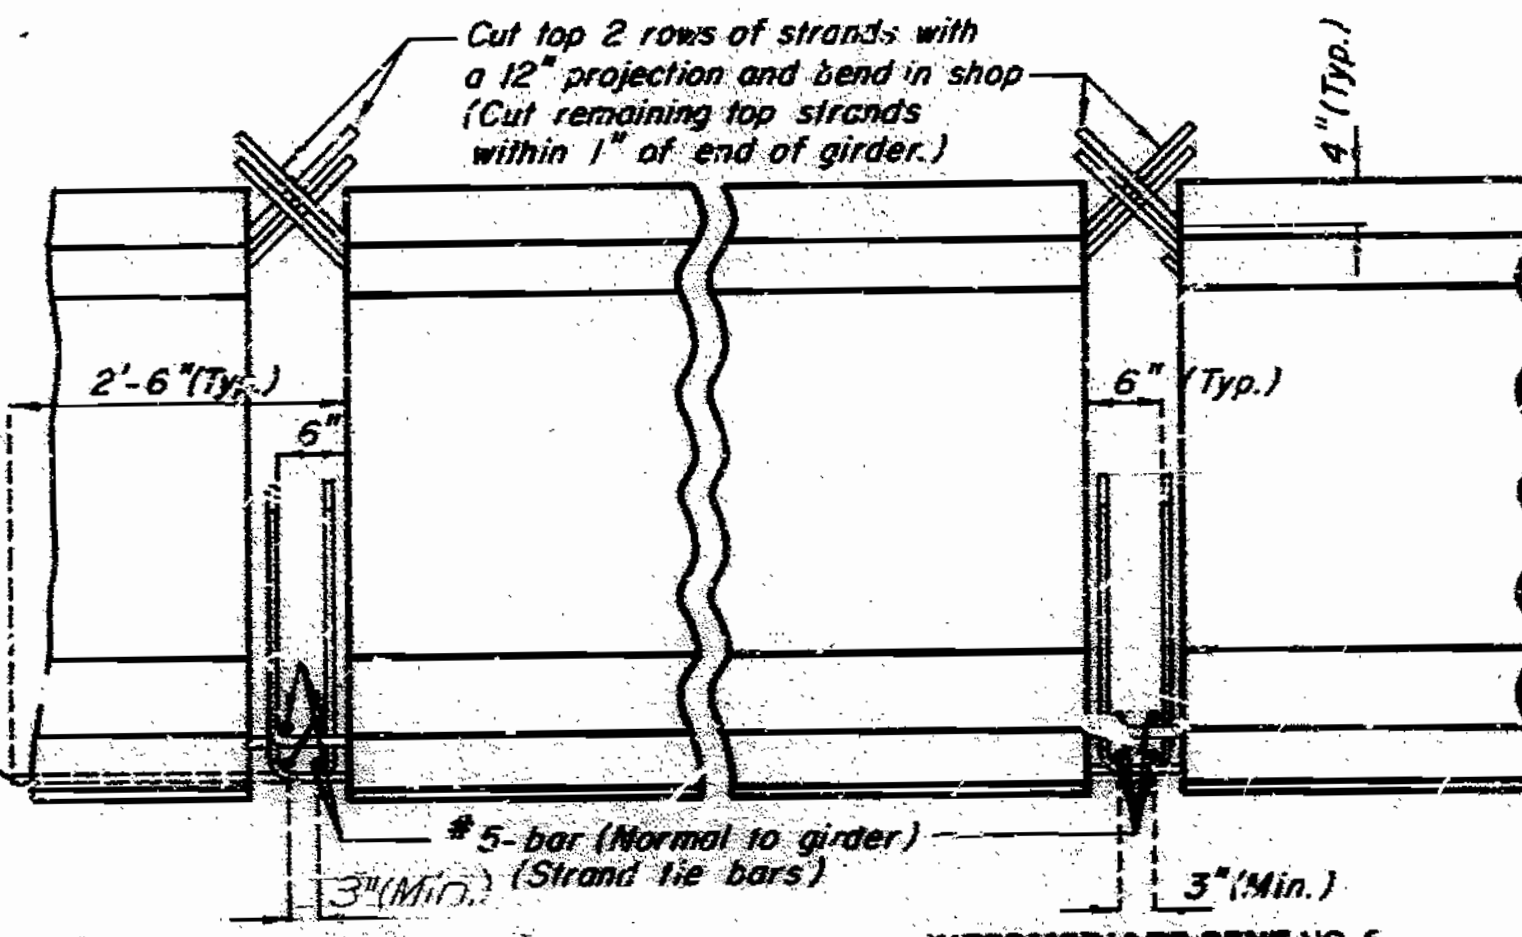

INTERMEDIATE BENT NO. 5  
STRAND DETAILS AT GIRDER ENDS

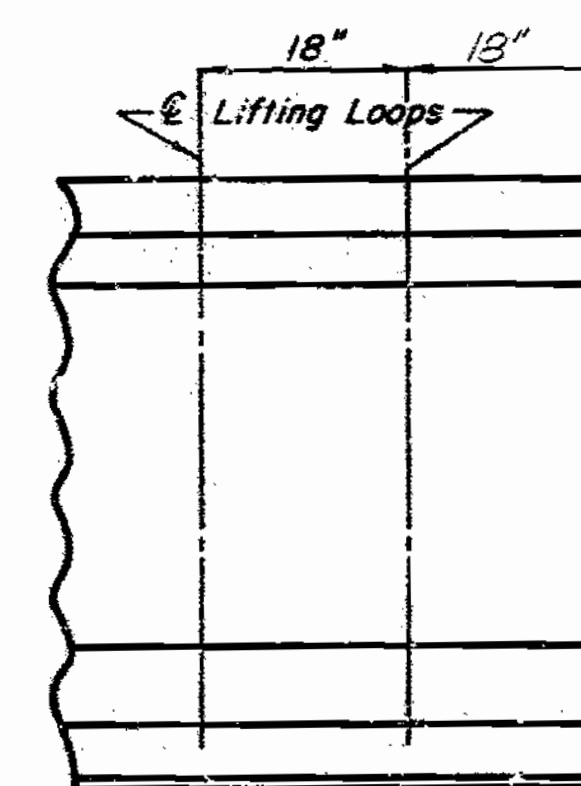


LOCATION OF LIFTING LOOPS


BILL OF REINFORCING STEEL - EACH GIRDER				BENDING DIAGRAMS	
NO.	SIZE & MARK	ACTUAL LENGTH	SHAPE		
4	6A1	30'-0"	20	SHAPE 9	SHAPE 10
106	5B1	5'-11"	11		
3	5B2	5'-4"	11	SHAPE 11	SHAPE 10
53	4C1	2'-2"	10		
108	4D1	3'-0"	9	SHAPE 20	

NOTE:

ALL DIMENSIONS IN BENDING DIAGRAM ARE OUT-TO-OUT.  
 HOOKS AND BENTS SHALL BE IN ACCORDANCE WITH THE CRSI MANUAL OF STANDARD PRACTICE FOR DETAILING REINFORCED CONCRETE STRUCTURES STRIPPED AND THE DIMENSIONS.  
 ACTUAL LENGTHS ARE MEASURED ALONG CENTERLINE BAR TO THE NEAREST INCH.  
 MINIMUM CLEARANCE TO REINFORCING SHALL BE 1".  
 ALL REINFORCEMENT SHALL BE GRADE 60.  
 THE TWO D1 BARS MAY BE FURNISHED AS ONE BAR AT THE FABRICATOR'S OPTION.

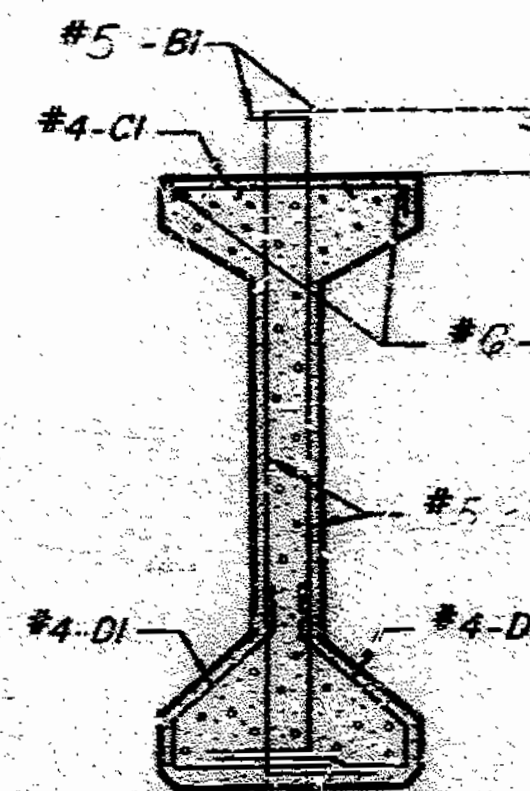


SECTION A-A  
(STRANDS NOT SHOWN FOR CLARITY)

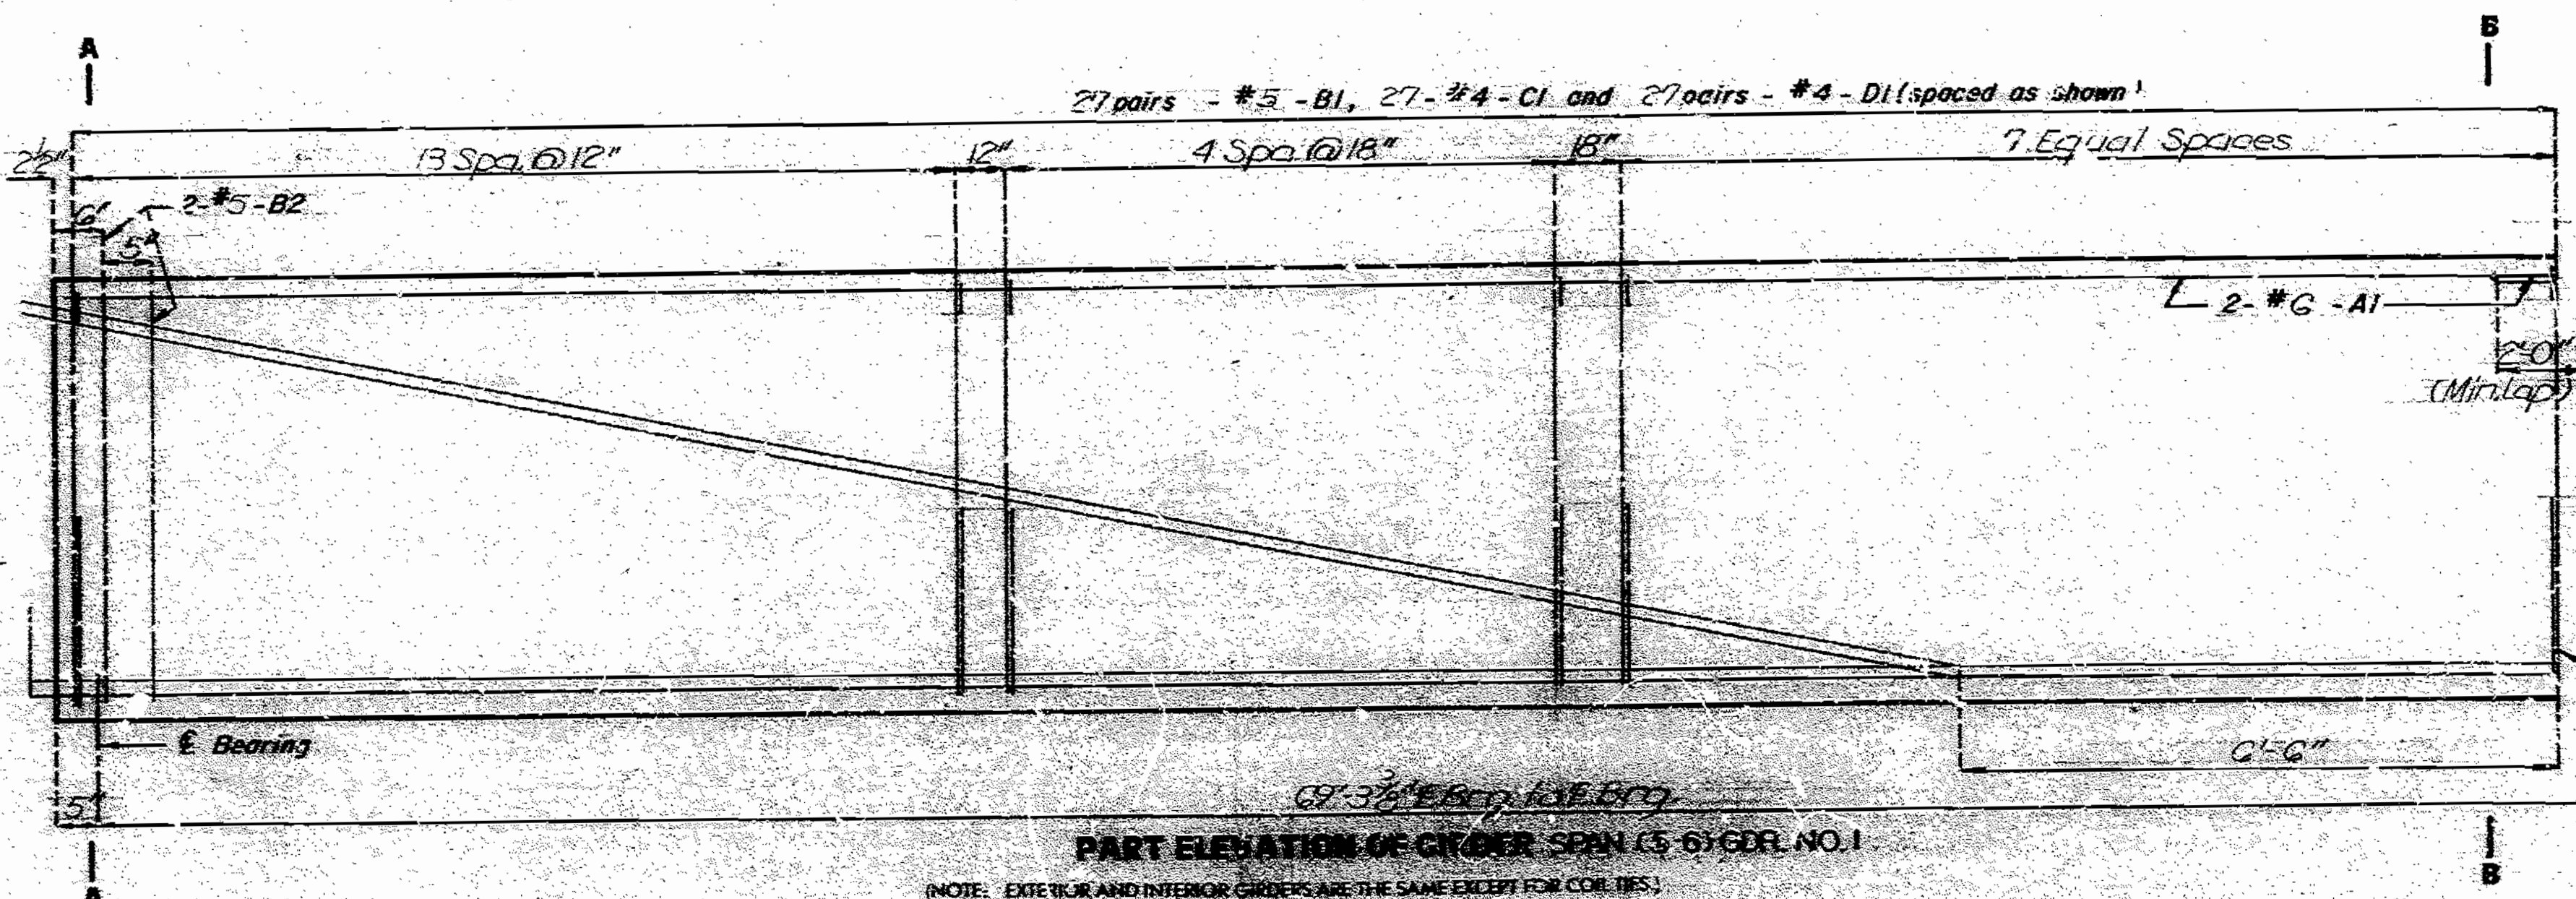


PART ELEVATION OF GIRDER SPAN (5-6) GDR. NO. 1

(NOTE: EXTERIOR AND INTERIOR GIRDERS ARE THE SAME EXCEPT FOR COIL TIES.)

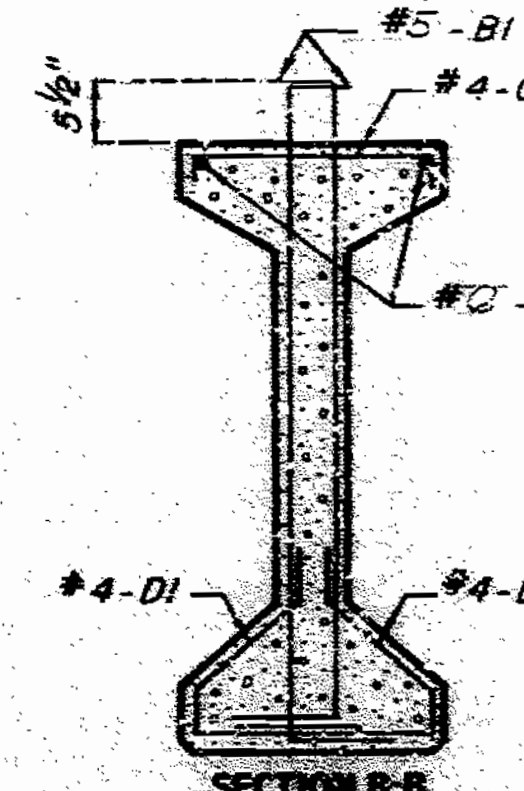

SECTION B-B  
(STRANDS NOT SHOWN FOR CLARITY)

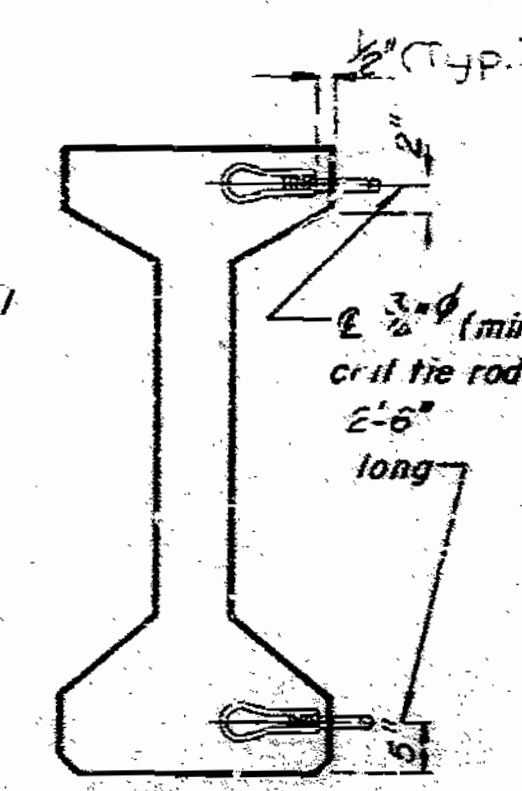

EXTERIOR GIRDERS


DETAILS OF COIL TIES AT INT. BENT NO. 5

NOTE:

COST OF 3/4" COIL TIE RODS PLACED IN DIAPHRAGMS IS INCLUDED IN CONTRACT UNIT PRICE FOR PRESTRESSED CONCRETE MEMBERS.  
 COIL TIES SHALL BE HELD IN PLACE IN THE FORMS BY SLOTTED WIRE-SETTING STUDS PROJECTING THRU FORMS. STUDS ARE TO BE LEFT IN PLACE OR REPLACED WITH TEMPORARY PLUGS UNTIL GIRDERS ARE ERECTED AND THEN REPLACED BY COIL TIE RODS.


NOTE:

The 1/2" notes shall be cast in the web for steel intermediate diaphragms. Drilling is not allowed.

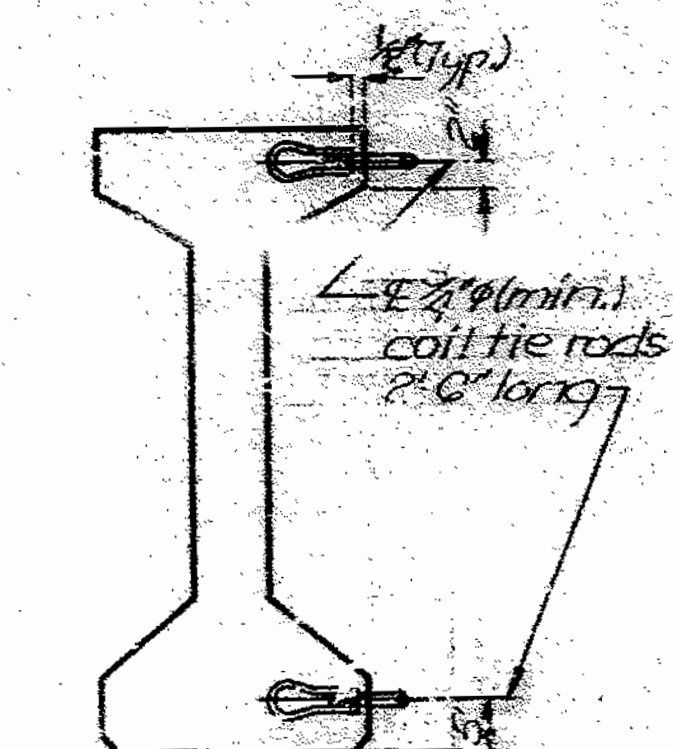

EXTERIOR GIRDERS  
DETAILS OF COIL TIES AT INT. BENT NO. 6

Note: For details of Int. Bt. Diaph. see sheet No. 63 & No. 64.  
 For location of Int. Diaph. and general girder placement, see sheet No. 24.  
 For girder camber and haunching see sheet No. 69.

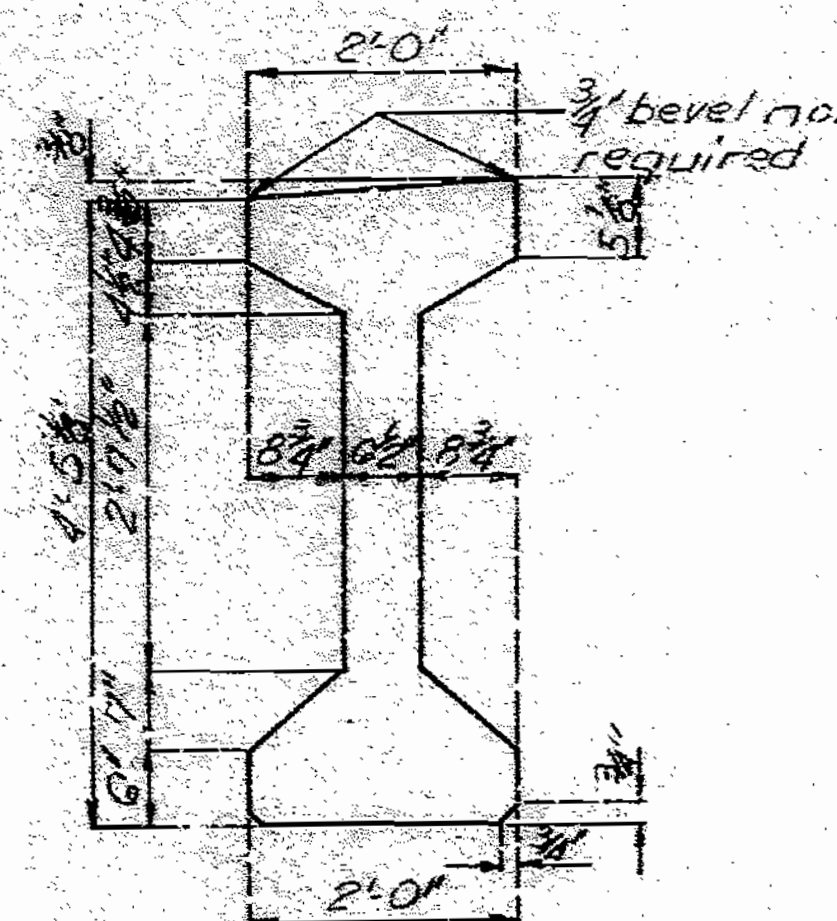

GIRDER DIMENSIONS  
PRECAST PANEL FORMS

154 102

SPS 5A.6.6/2  
FEB. 1974  
REVISED  
JUNE 1987

DETAILED FEB. 1988  
CHECKED OCT. 1988

Note: This drawing is not to scale. Follow dimensions.

Sheet No. 32 of 38


JACKSON COUNTY

A2745

NOTE:

CONCRETE FOR PRESTRESSED GIRDERS SHALL BE CLASS A1 WITH  $f_c = 5,000$  PSI.  
 (\*) INDICATES PRESTRESSED STRAND.  
 USE STRANDS WITH AN INITIAL PRESTRESS FORCE OF 47% KIPS.  
 PRESTRESSING TENDONS SHALL BE UNCOATED, SEVEN-WIRE, LOW RELAXATION STRANDS, 1/2 INCH DIAMETER CONFORMING TO A.A.S.H.T.O. M203, GRADE 270. SEE MO. STD. SPECIFICATIONS 705.4 P.

STATE	PROJ. NO.	SHEET NO.
MO.		113


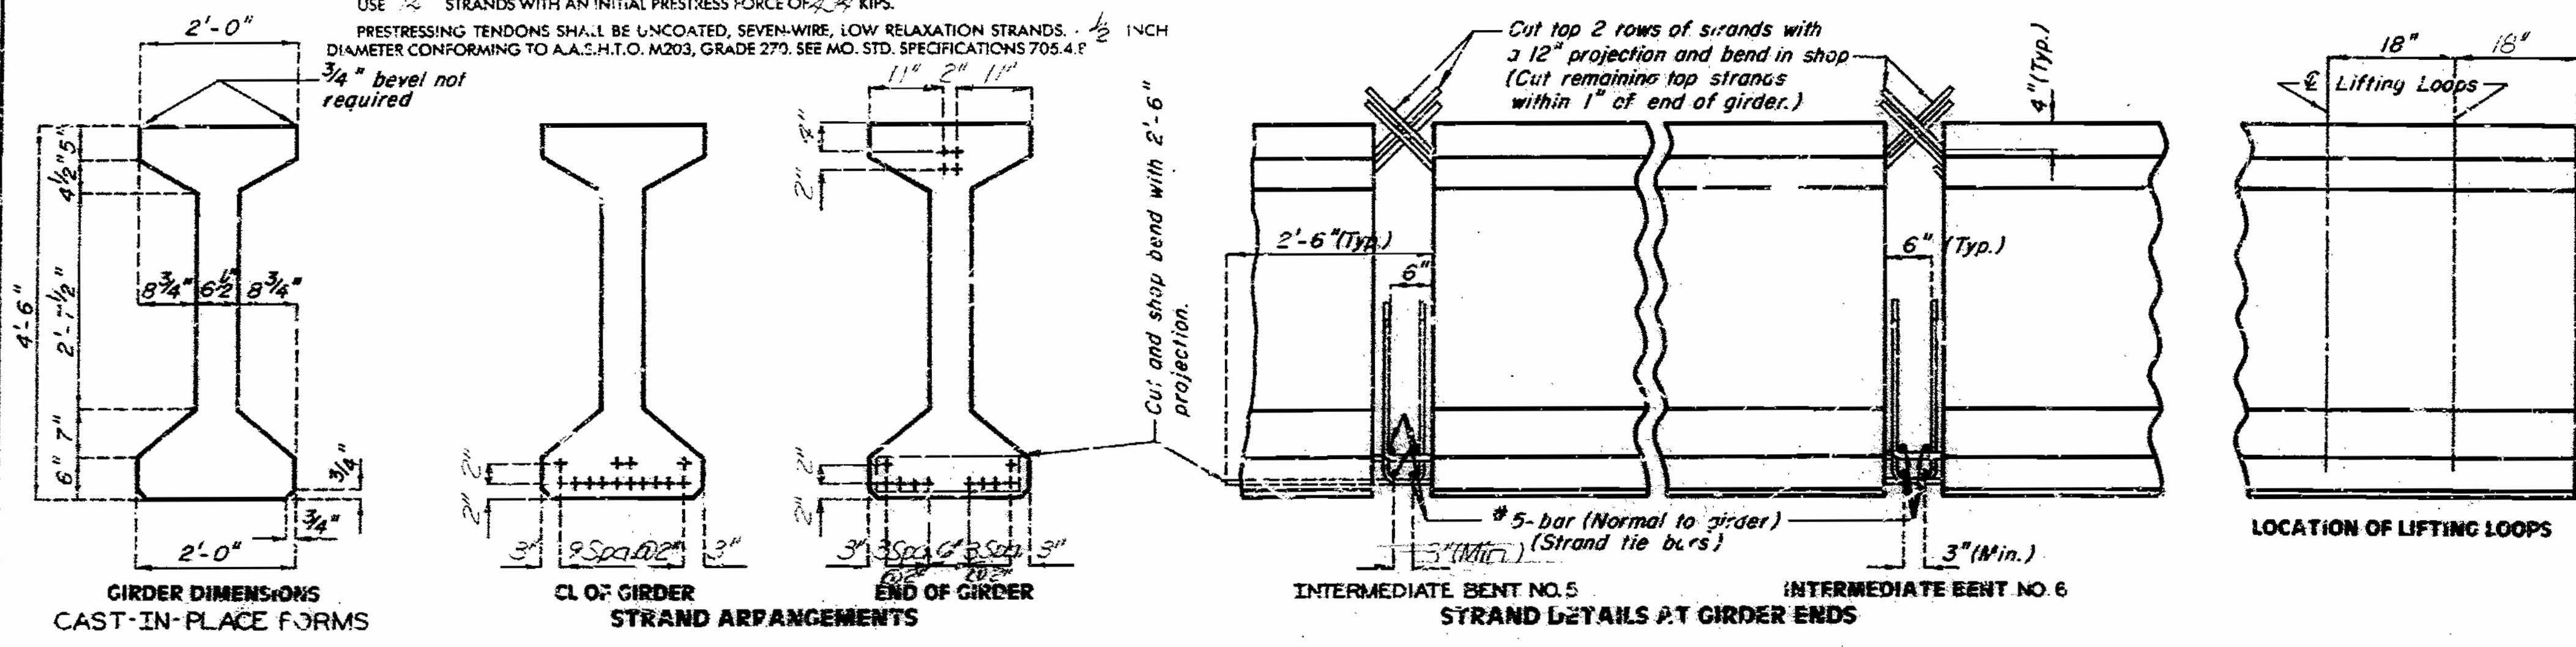


**BILL OF REINFORCING STEEL - EACH GIRDER**


NO.	SIZE & MARK	ACTUAL LENGTH	SHAPE	BENDING DIAGRAMS
4	GAI	(*)	20	SHAPE 9
102	SBI	5'-11"	11	SHAPE 10
4	GB2	5'-4"	11	SHAPE 10
51	4CI	2'-2"	10	SHAPE 9
102	4DI	3'-0"	9	SHAPE 20

**BENDING DIAGRAMS**  
 SHAPE 9: 9 3/4" top leg, 18" bottom leg.  
 SHAPE 10: 22" top leg, 4-10 1/2" BI, 4-4" PE, 6" top leg.  
 SHAPE 20: 18" top leg, 18" bottom leg.


NOTE:  
 ALL DIMENSIONS IN BENDING DIAGRAM ARE OUT TO OUT.  
 HOOKS AND BENDS SHALL BE IN ACCORDANCE WITH THE CRSI MANUAL OF STANDARD PRACTICE FOR DETAILING REINFORCED CONCRETE STRUCTURES STRIPUP AND TIE DIMENSIONS.  
 ACTUAL LENGTHS ARE MEASURED ALONG CENTERLINE BAR TO THE NEAREST INCH.  
 MINIMUM CLEARANCE TO REINFORCING SHALL BE 1".  
 ALL REINFORCEMENT SHALL BE GRADE 60.  
 THE TWO D1 BARS MAY BE FURNISHED AS ONE BAR AT THE FABRICATOR'S OPTION.

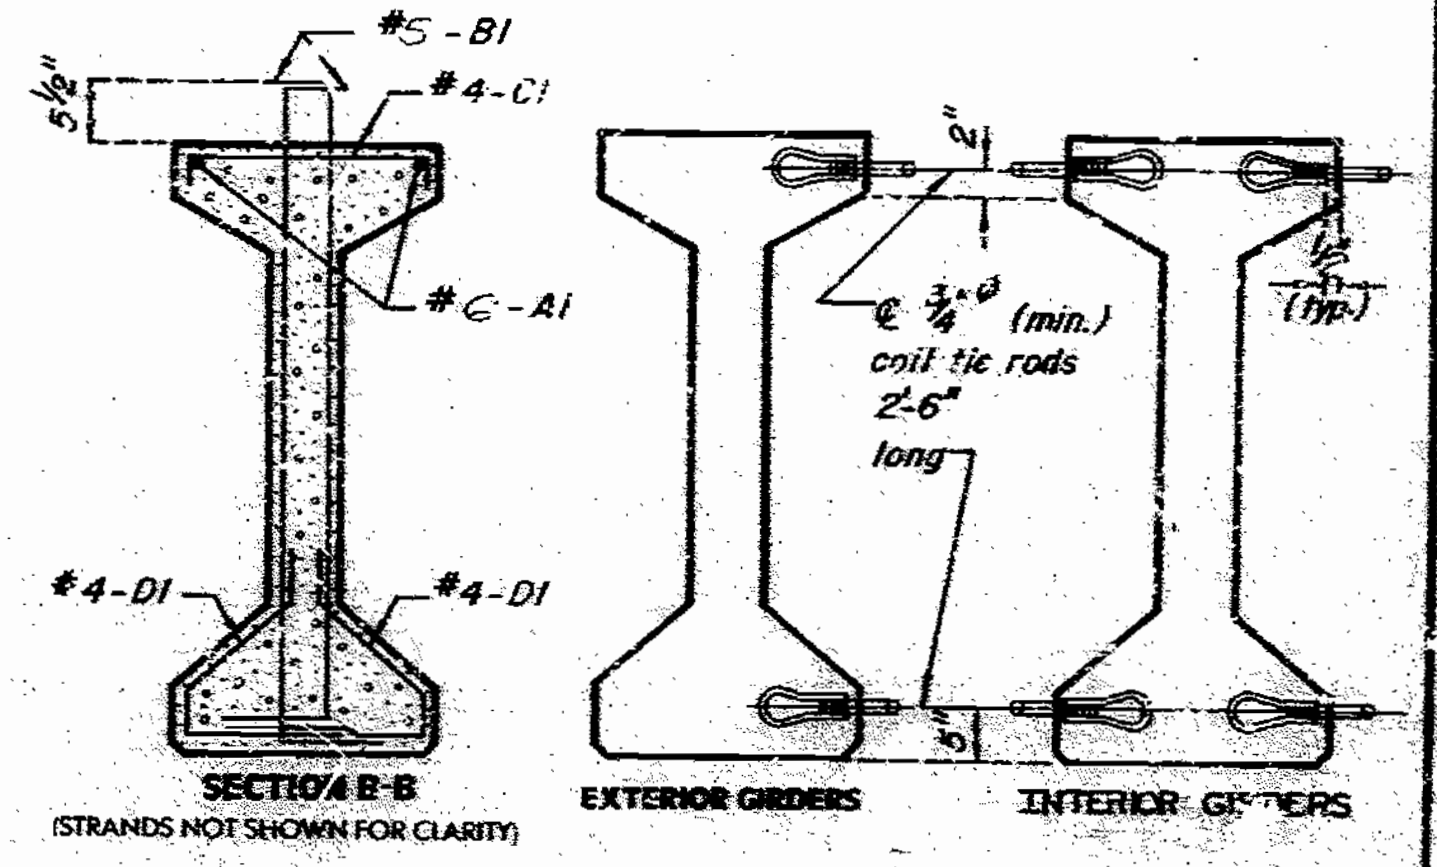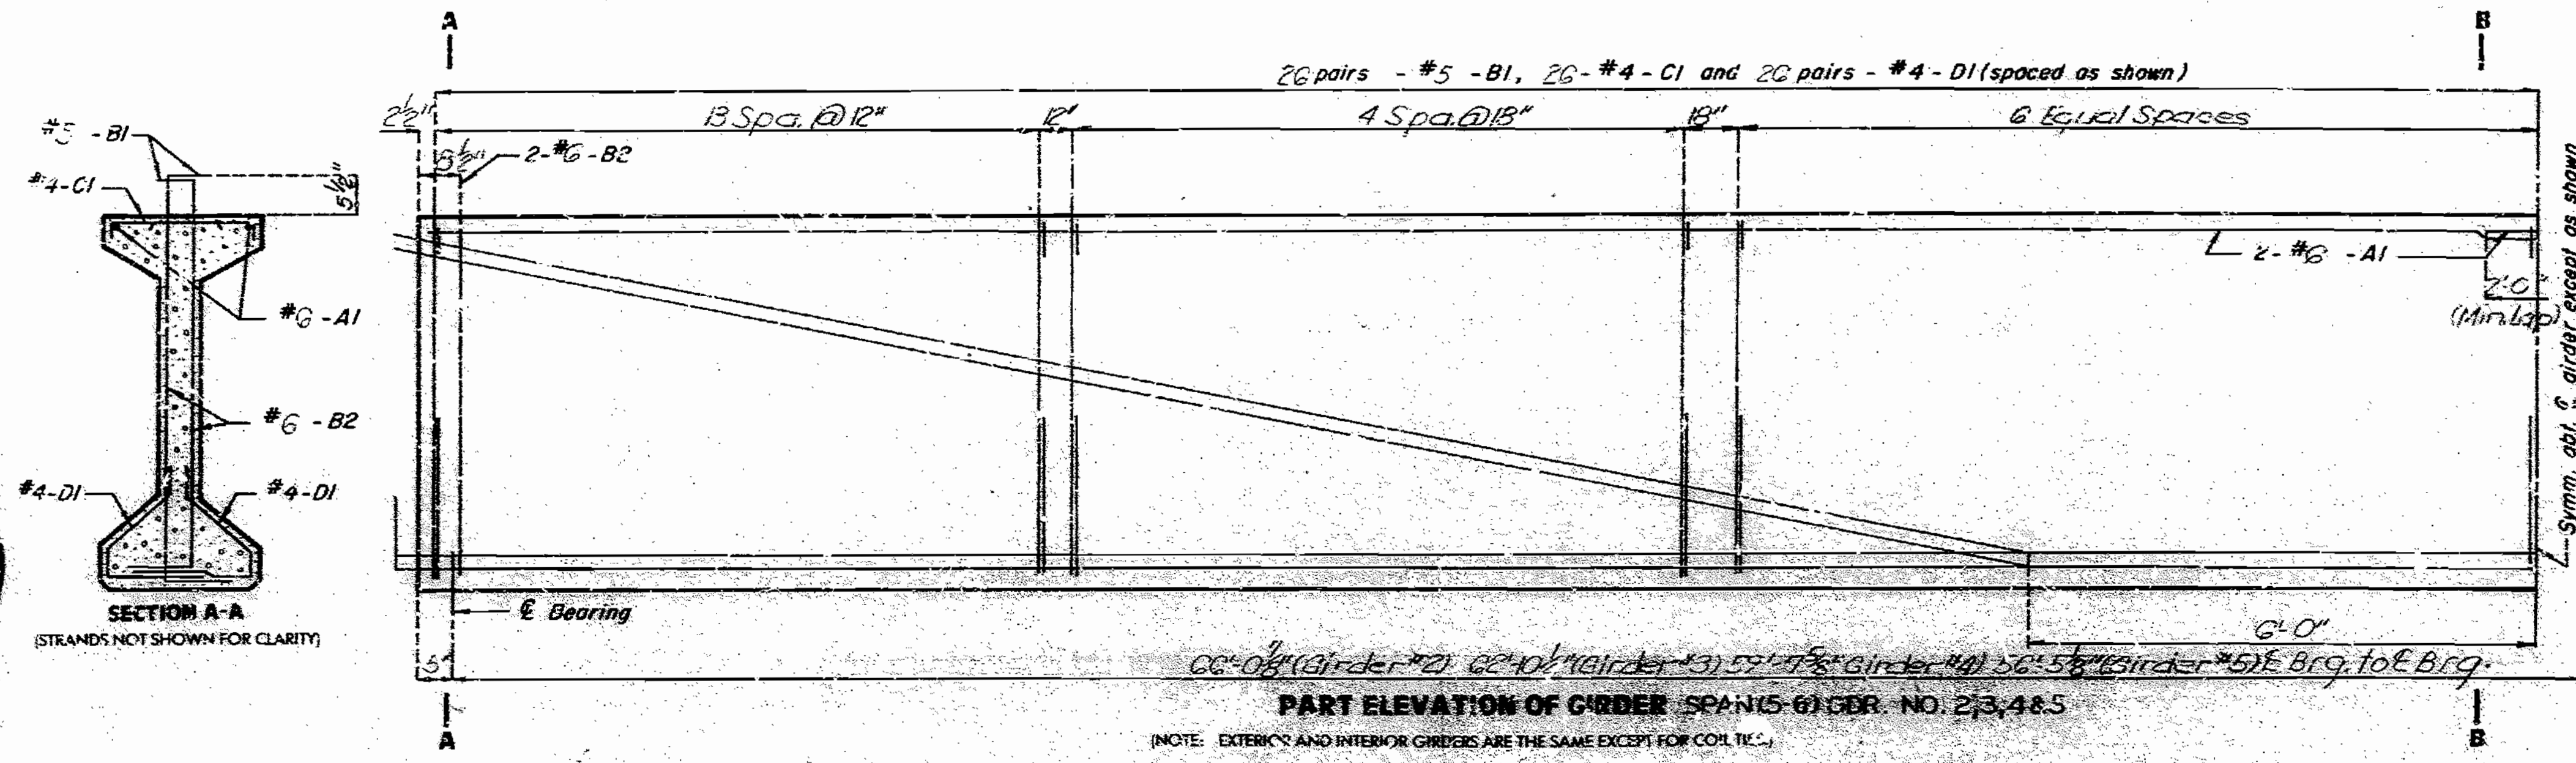

NOTE:  
 COIL TIES SHALL BE HELD IN PLACE IN THE FORMS BY SLOTTED WIRE-SETTING STUDS PROJECTING THROUGH FORMS. STUDS ARE TO BE LEFT IN PLACE OR REPLACED WITH TEMPORARY PLUGS UNTIL GIRDERS ARE ERECTED AND THEN REPLACED BY COIL TIE RODS.

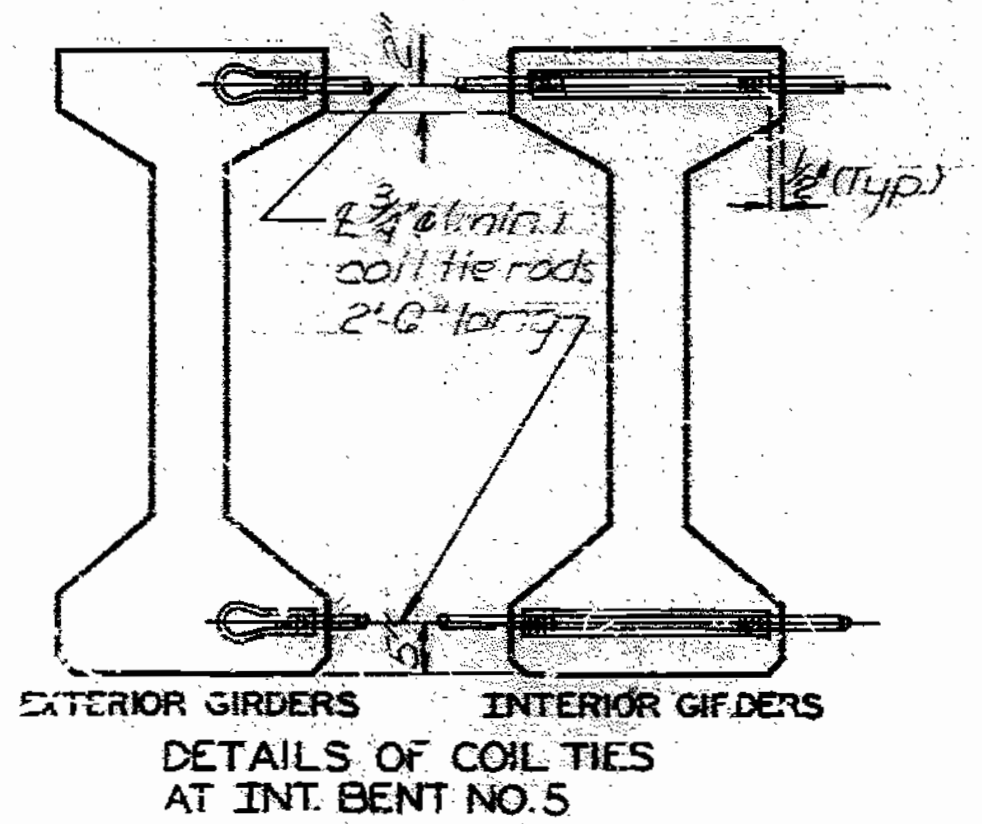

Note: For details of Int. B1 Diaph. see sheet No. 63 & No. 64.  
 For location of Int. Diaph. and general girder placement, see sheet No. 24.  
 For Girder camber and haunching see sheet No. 69.

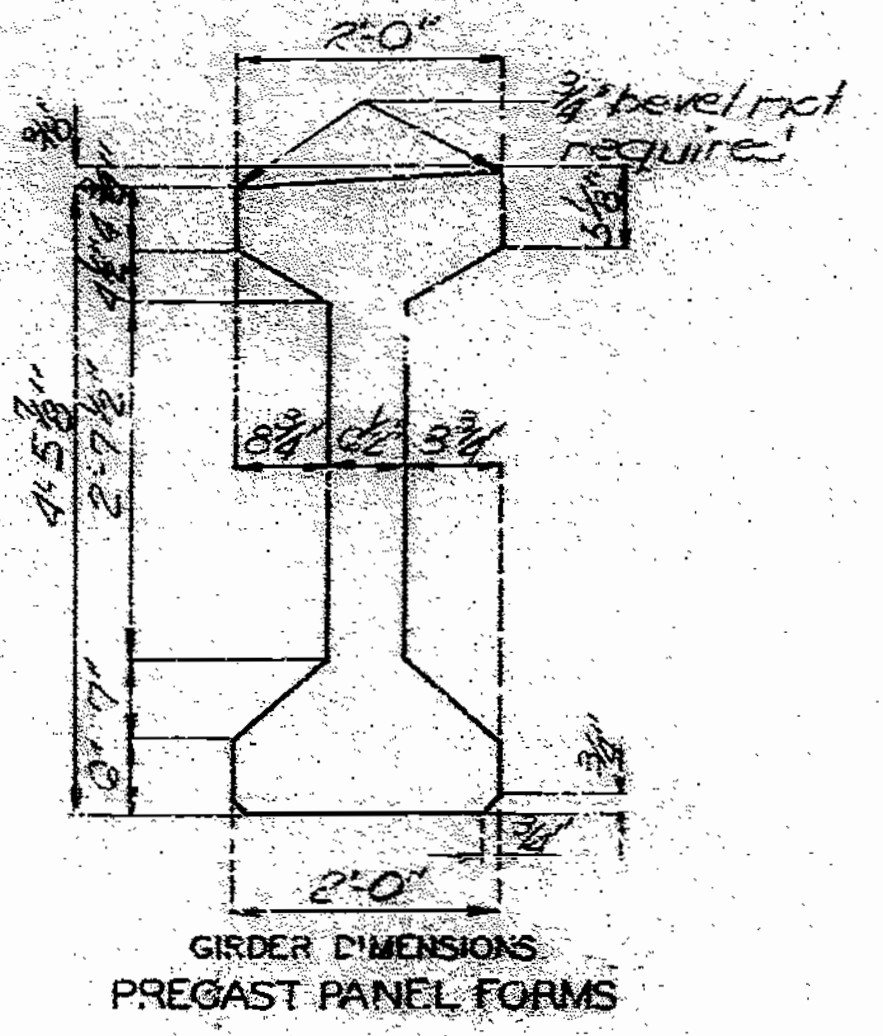

- (\*) 31'-4" (Girder #2)
- 32'-9" (Girder #3)
- 31'-5" (Girder #4)
- 29'-6" (Girder #5)

155-120

SPS 55.6.6/2  
 FEB. 1974  
 REVISED  
 JUNE 1987

DETAILED FEB. 1988  
 CHECKED OCT. 1988

Note: This drawing is not to scale. Follow dimensions.





Sheet No. 33 of 98

JACKSON COUNTY

A-2745



**NOTE:**  
 CONCRETE FOR PRESTRESSED GIRDERS SHALL BE CLASS A1 WITH  $f_c = 5,000$  PSI.  
 (-) INDICATES PRESTRESSED STRAND.  
 USE 22 STRANDS WITH AN INITIAL PRESTRESS FORCE OF 282 KIPS.  
 PRESTRESSING TENDONS SHALL BE UNCOATED, SEVEN-WIRE, LOW RELAXATION STRANDS, 1/2 INCH DIAMETER CONFORMING TO A.A.S.H.T.O. M203, GRADE 270. SEE MO. STD. SPECIFICATIONS 705.4.8.

STATE	PROJ NO	SHEET NO
		114
MO		

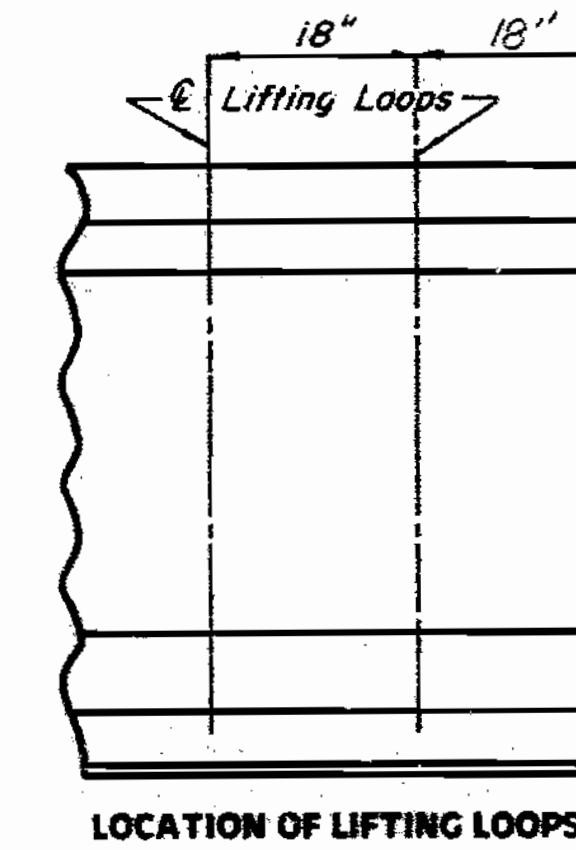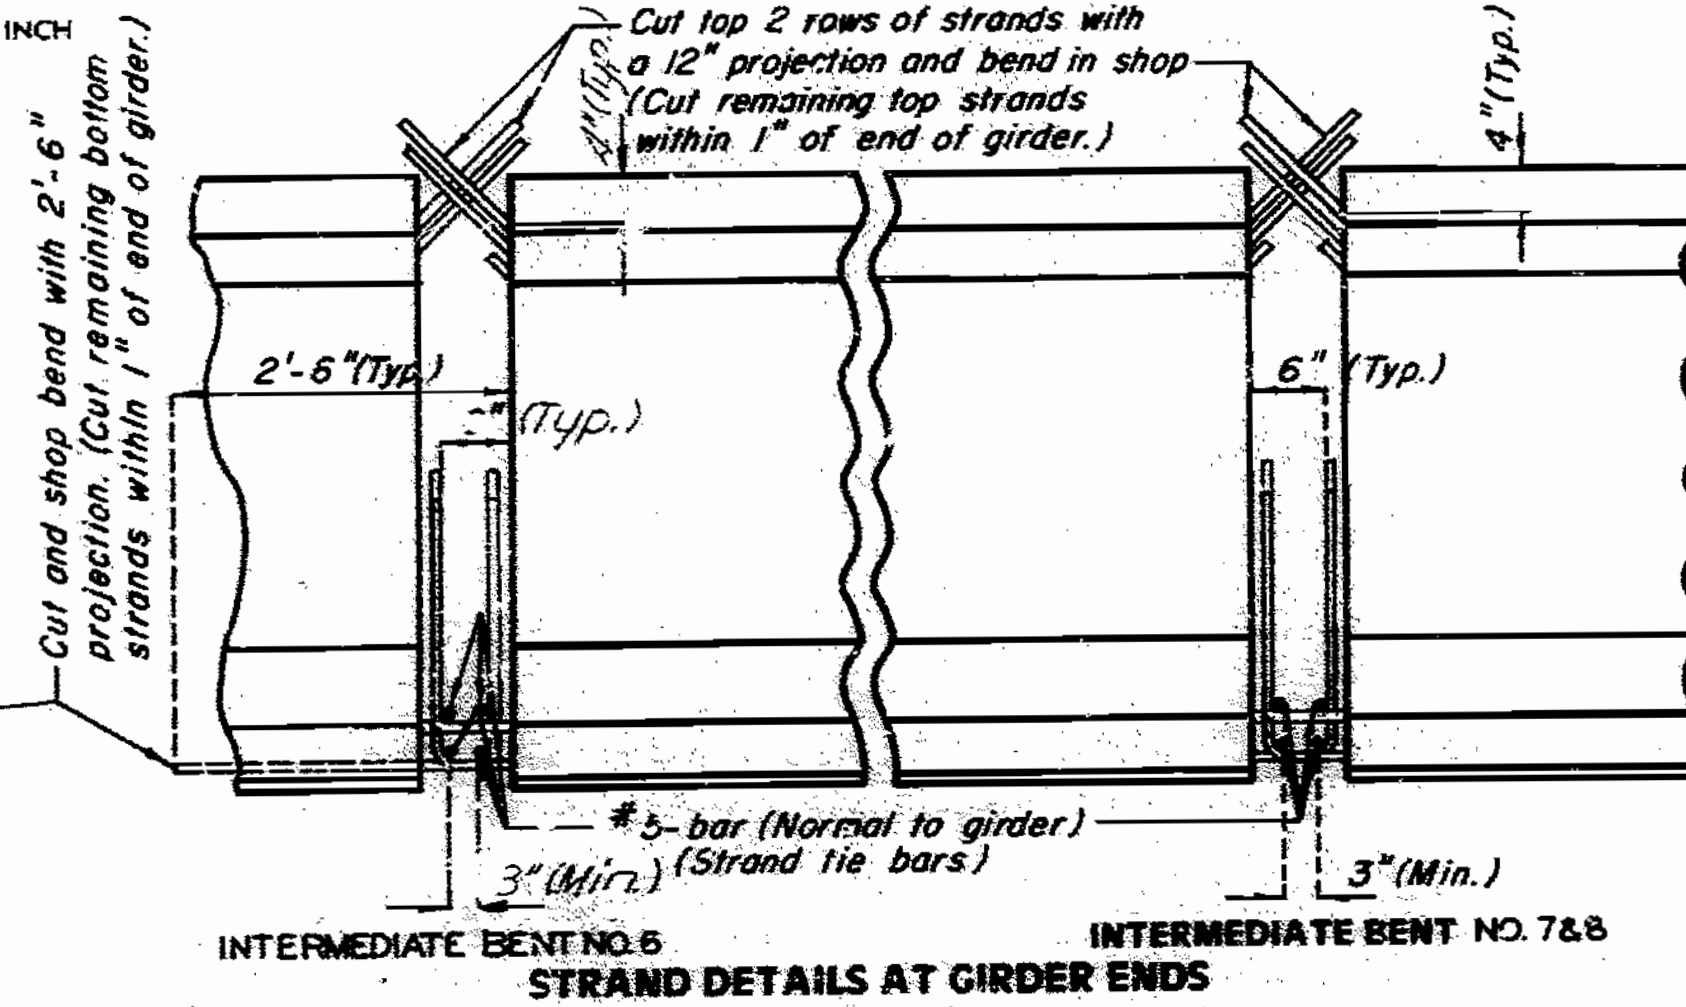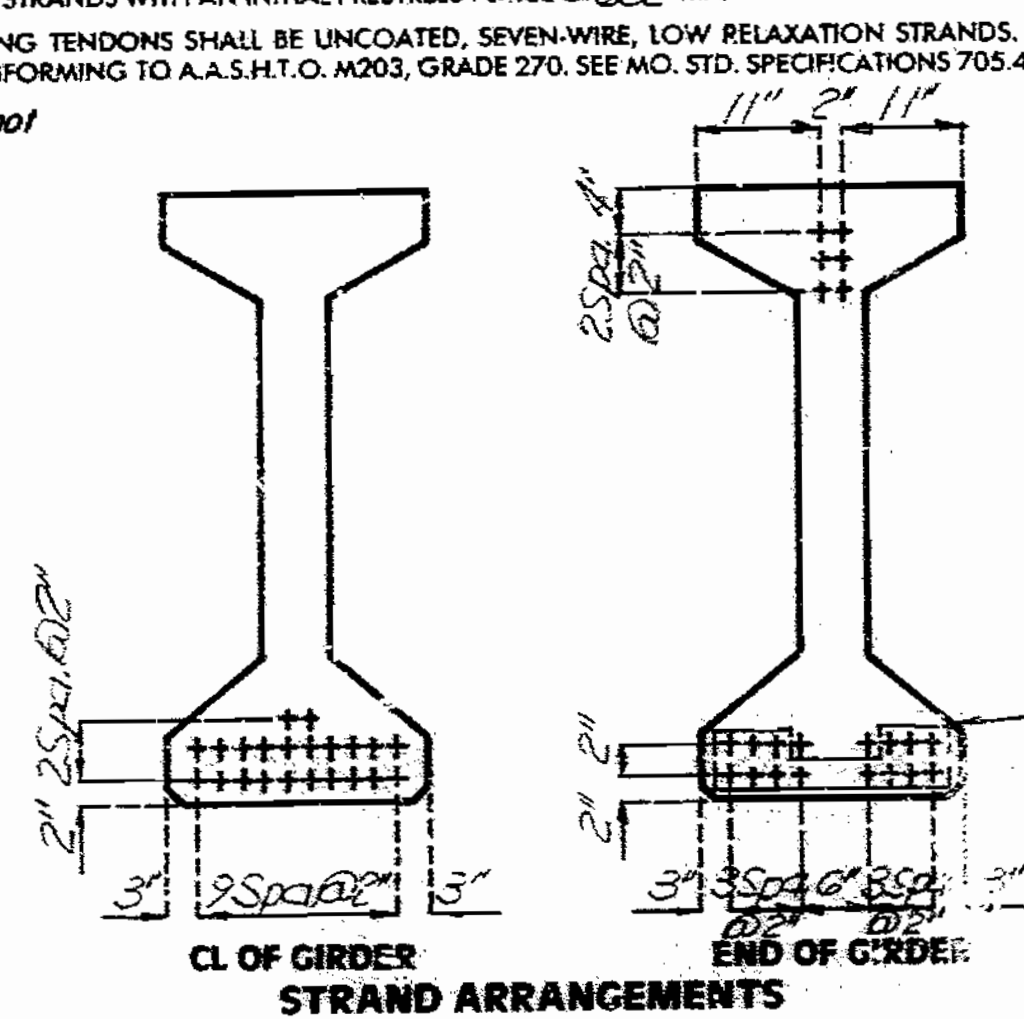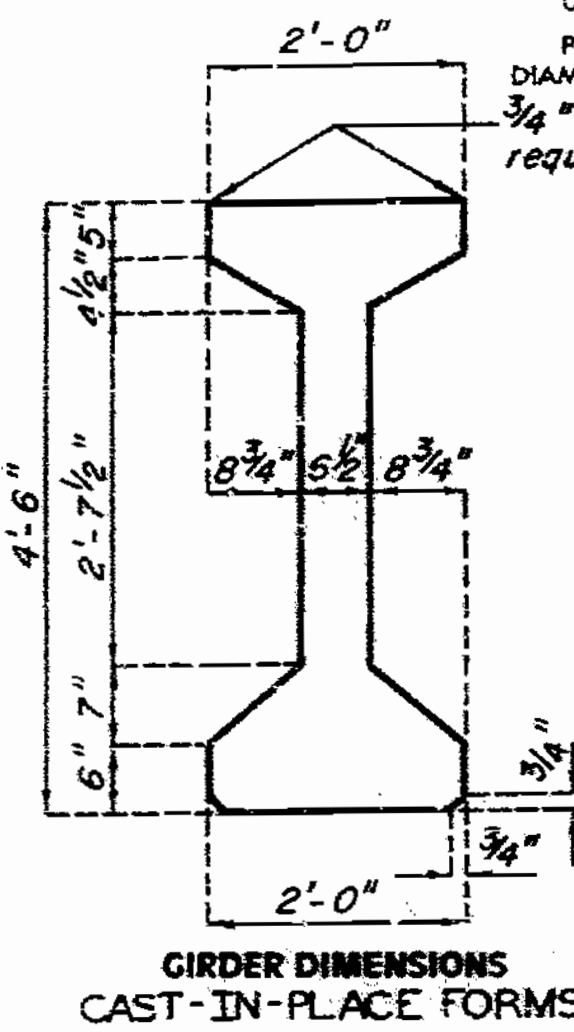

BILL OF REINFORCING STEEL - EACH GIRDER				BENDING DIAGRAMS	
NO.	SIZE & MARK	ACTUAL LENGTH	SHAPE		
4	6A1	41'-7"	20	SHAPE 9	SHAPE 10
13A	5B1	5'-11"	11		
8	6B2	5'-4"	11	SHAPE 11	SHAPE 10
67	4C1	2'-2"	10		
13A	4D1	3'-0"	9	SHAPE 20	


**NOTE:**  
 ALL DIMENSIONS IN BENDING DIAGRAM ARE OUT TO OUT.  
 HOOKS AND BENDS SHALL BE IN ACCORDANCE WITH THE CRSI MANUAL OF STANDARD PRACTICE FOR DETAILING REINFORCED CONCRETE STRUCTURES STIRRUP AND TIE DIMENSIONS.  
 ACTUAL LENGTHS ARE MEASURED ALONG CENTERLINE BAR TO THE NEAREST INCH.  
 MINIMUM CLEARANCE TO REINFORCING SHALL BE 1".  
 ALL REINFORCEMENT SHALL BE GRADE 60.  
 THE TWO D1 BARS MAY BE FURNISHED AS ONE BAR AT THE FABRICATOR'S OPTION.

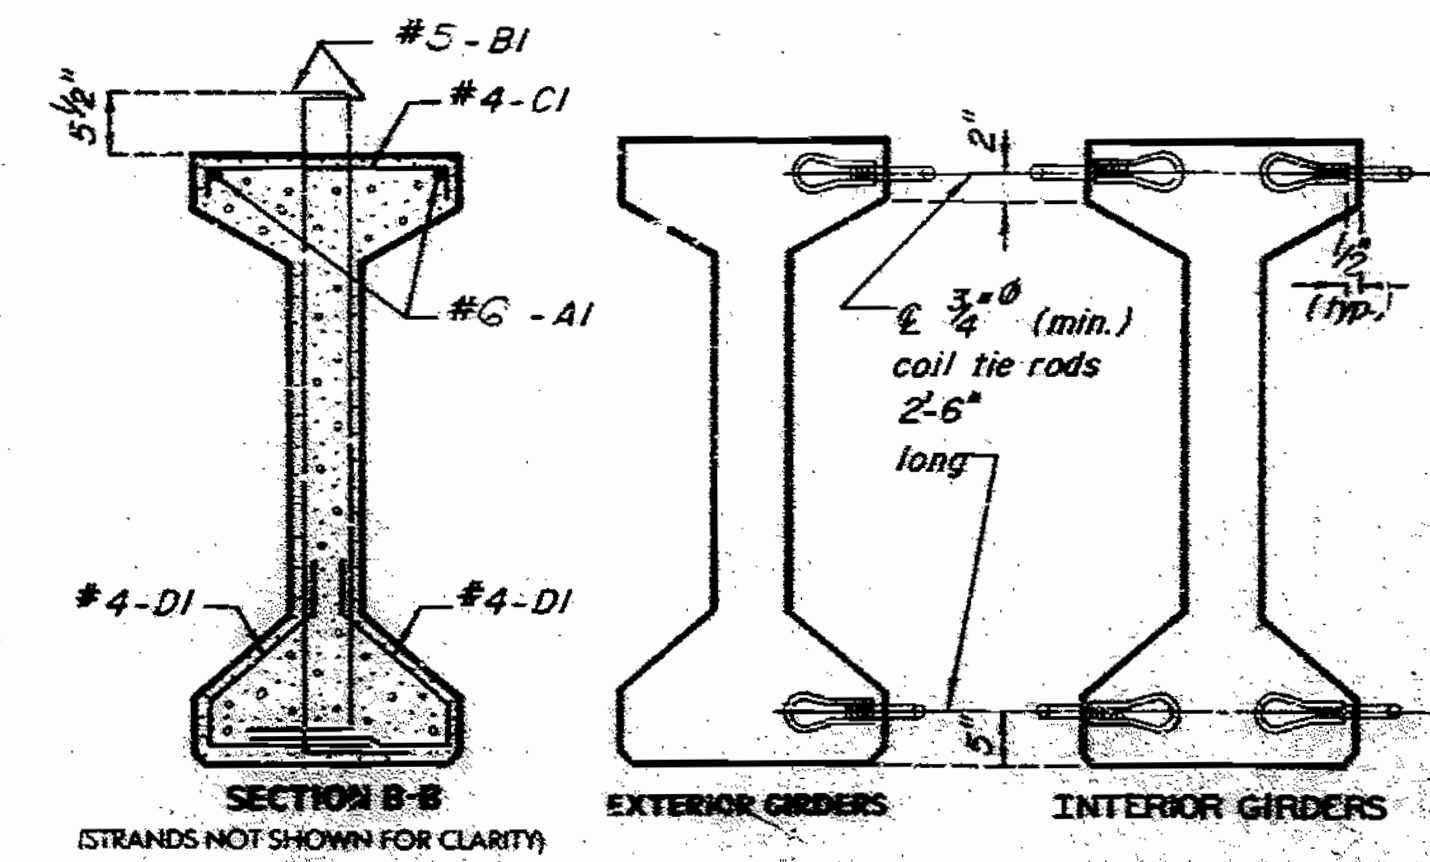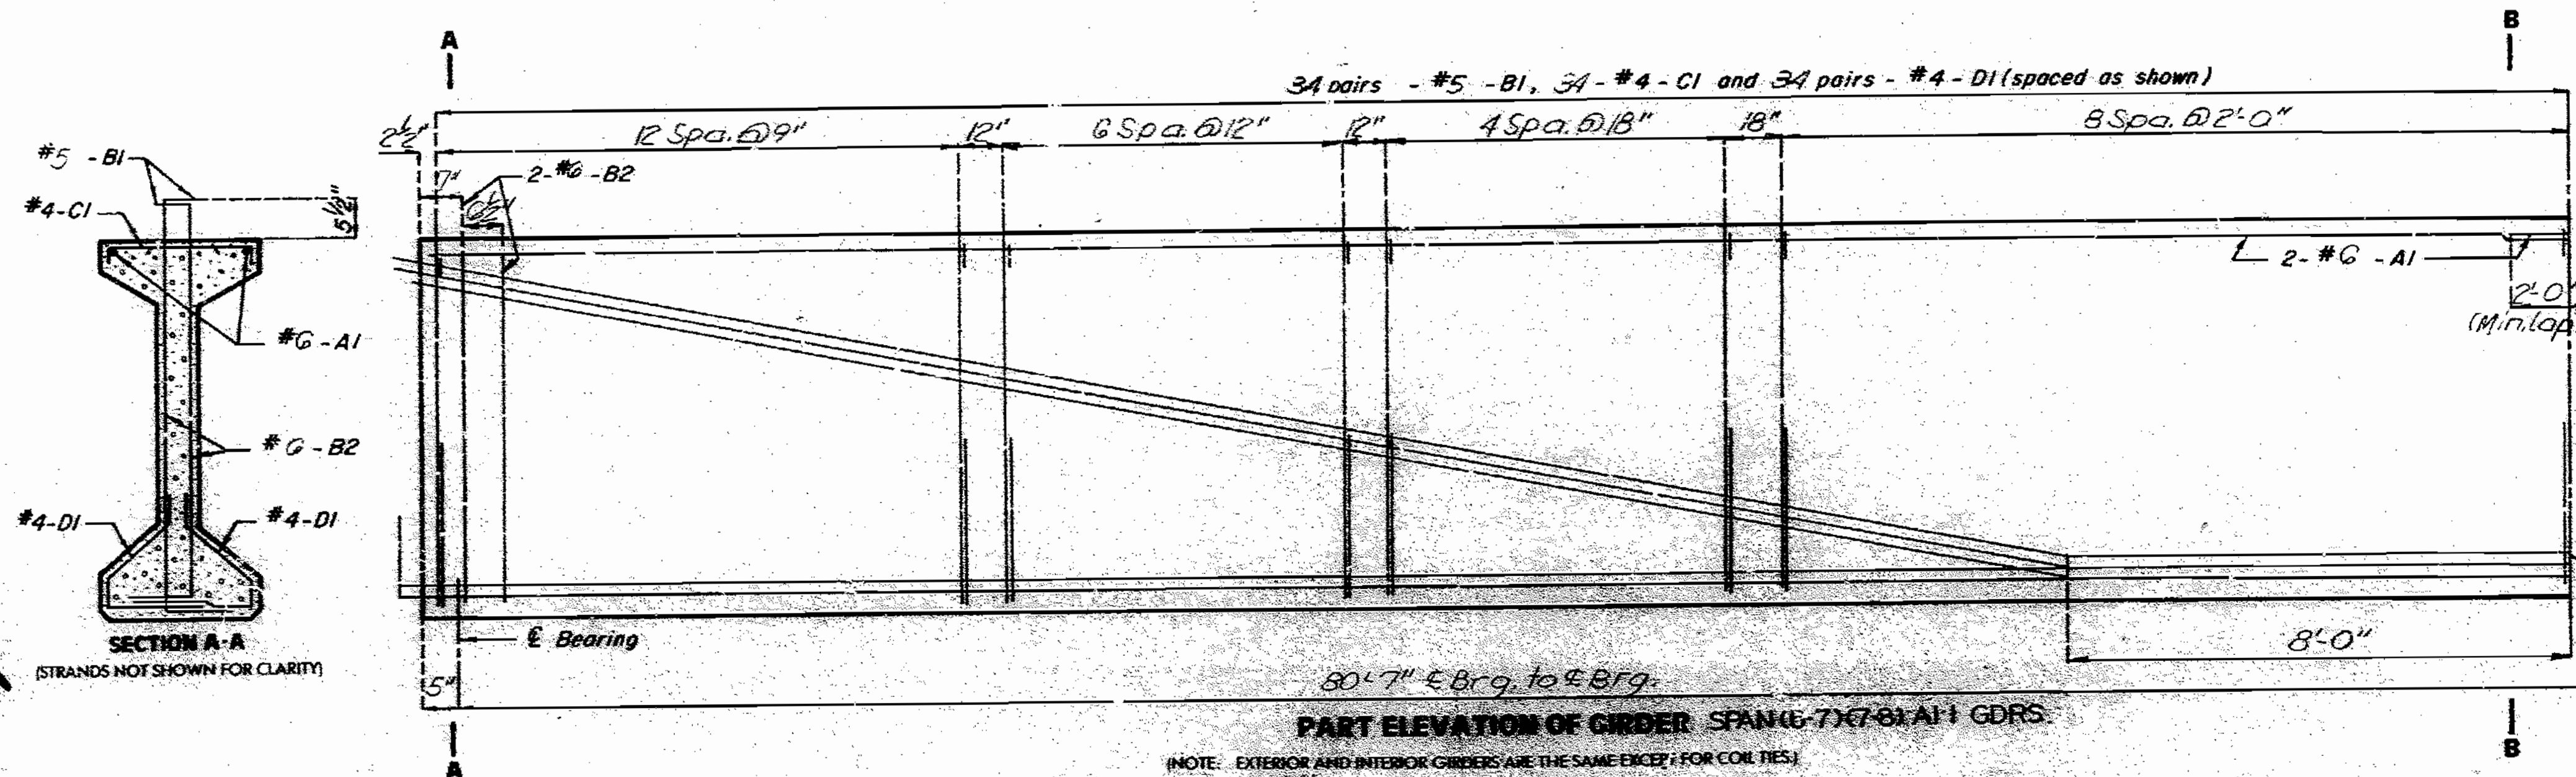

**NOTE:**  
 COST OF 3/4" COIL TIE RODS PLACED IN DIAPHRAGMS IS INCLUDED IN CONTRACT UNIT PRICE FOR PRESTRESSED CONCRETE MEMBERS.  
 COIL TIES SHALL BE HELD IN PLACE IN THE FORMS BY SLOTTED WIRE SETTING STUDS PROJECTING THRU FORMS. STUDS ARE TO BE LEFT IN PLACE OR REPLACED WITH TEMPORARY PLUGS UNTIL GIRDERS ARE ERECTED AND THEN REPLACED BY COIL TIE RODS.

**NOTE:**  
 The 1/2" holes shall be cast in the web for steel intermediate diaphragms. Drilling is not allowed.

*Note: For details of Int. Bl. Diaph. see sheet No. 64.  
 For location of Int. Diaph. and general girder placement, see sheet No. 24 & No. 25.  
 For Girder Camber and haunching see sheet No. 69*

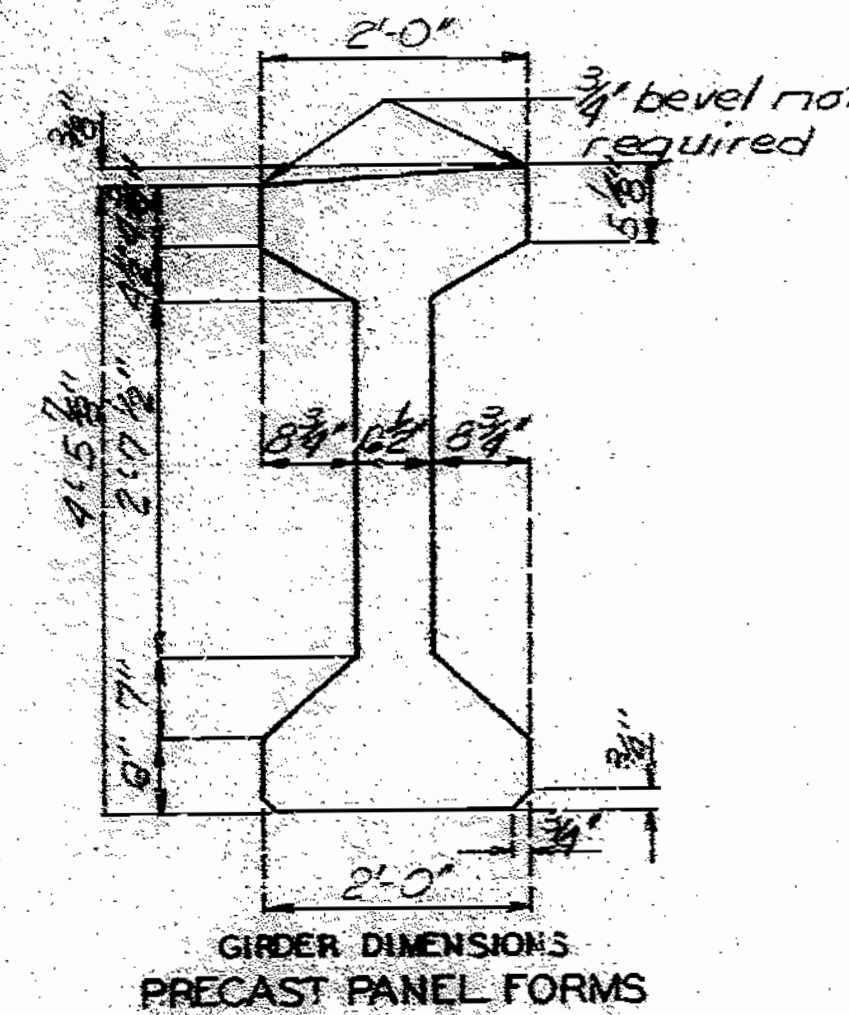

756 189

SPS 65.6.6 1/2  
 FEB. 1974  
 REVISIONS  
 JUNE 1987  
 DETAILED FEB. 1988  
 CHECKED OCT. 1988

Note: This drawing is not to scale. Follow dimensions.

Sheet No. 34 of 98






JACKSON COUNTY

A-2745

NOTE: CONCRETE FOR PRESTRESSED GIRDERS SHALL BE CLASS A1 WITH  $f_c = 4000$  PSI.  
 \* INDICATES PRESTRESSED STRAND.  
 USE 7 STRANDS WITH AN INITIAL PRESTRESS FORCE OF 225 KIPS.  
 PRESTRESSING TENDONS SHALL BE UNCOATED, SEVEN-WIRE, LOW RELAXATION STRANDS - 1/2 INCH DIAMETER CONFORMING TO A.A.S.H.T.O. M203, GRADE 270. SEE MOI. STD. SPECIFICATIONS 705.4.8.





Note: Release str. for 2000 cor. 11-4-50...  
 \* 100 lbs. 2000 7-10  
 \* 100 lbs. 3-20 (18-9)

SHEET NO.	PROJ. NO.	SHEET NO.
NO.		115

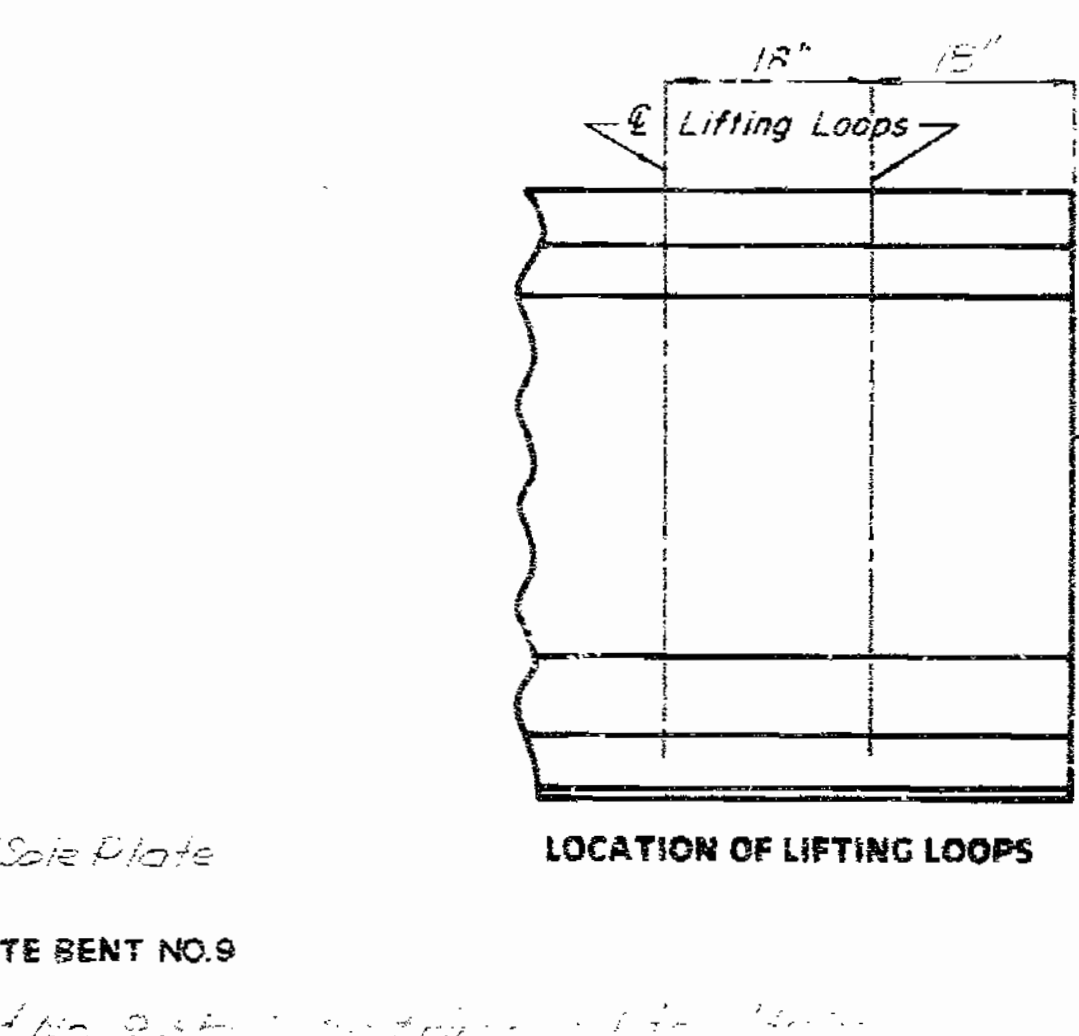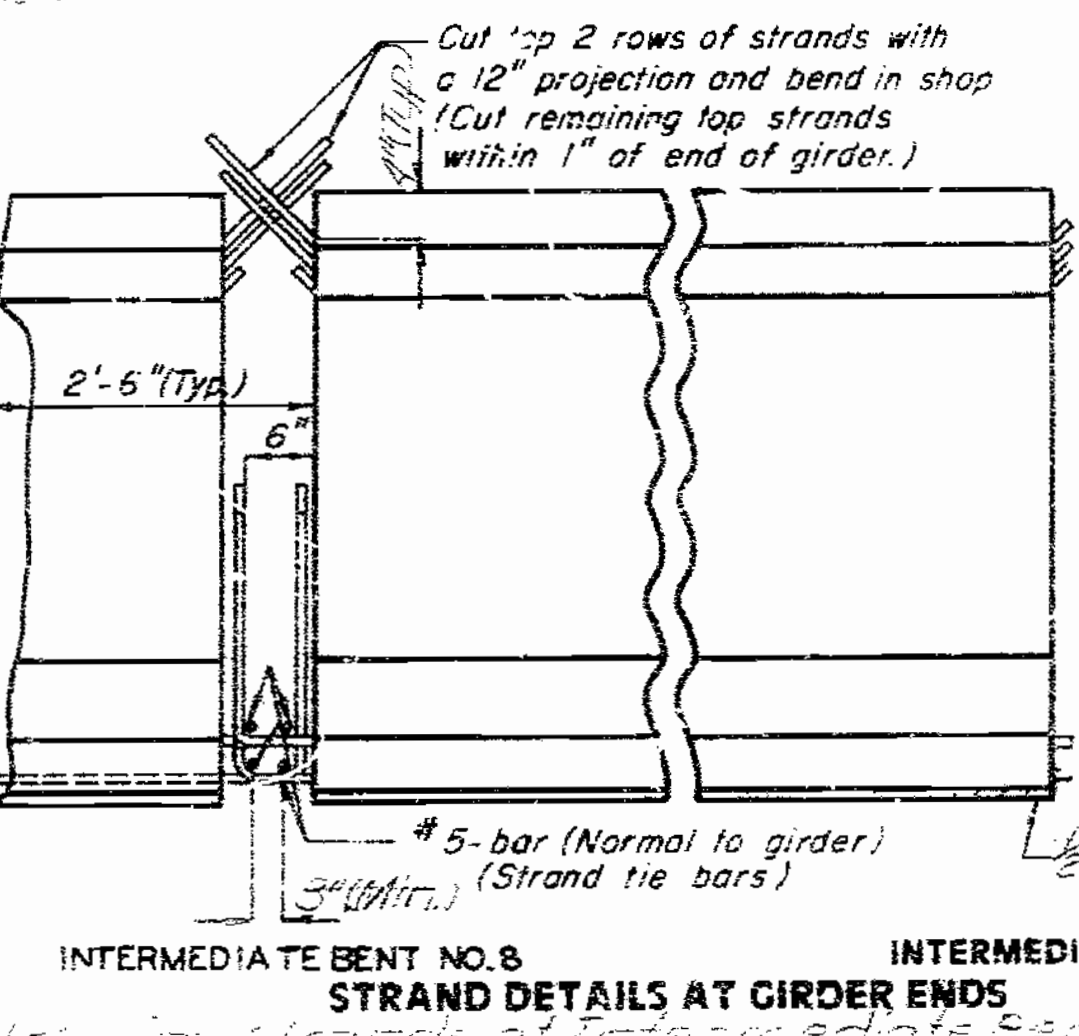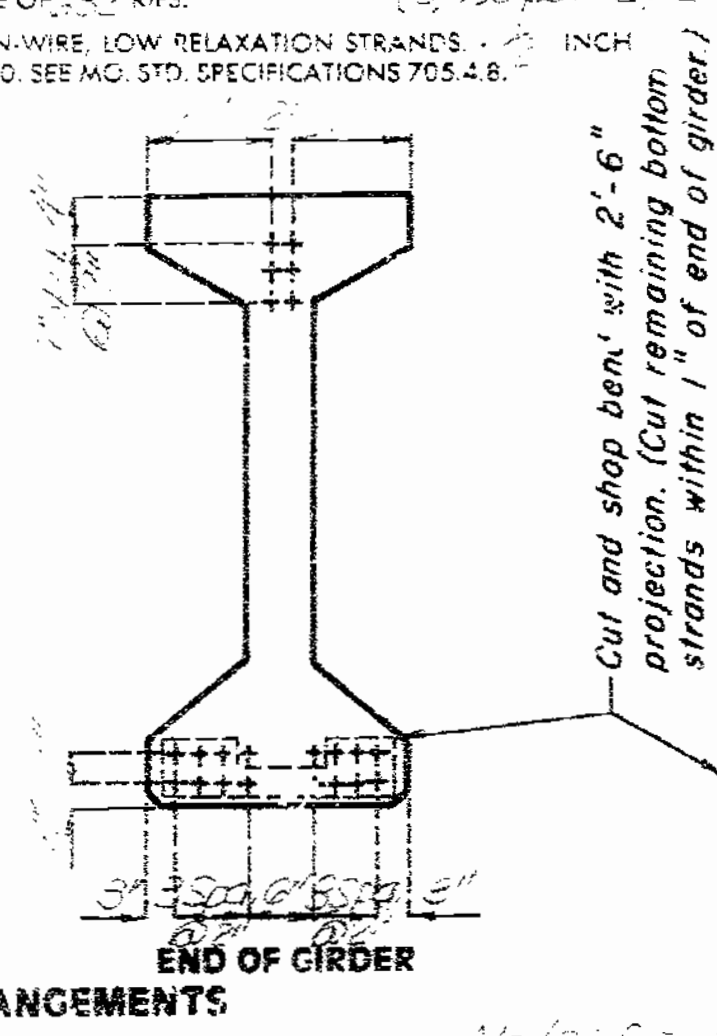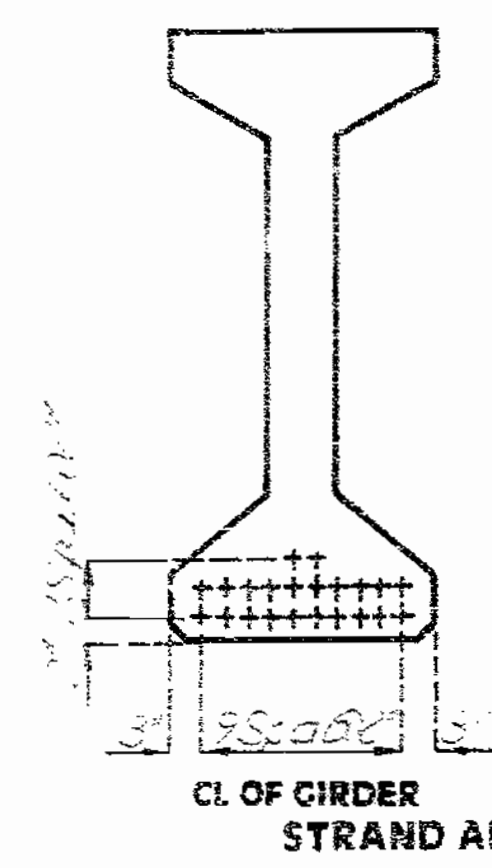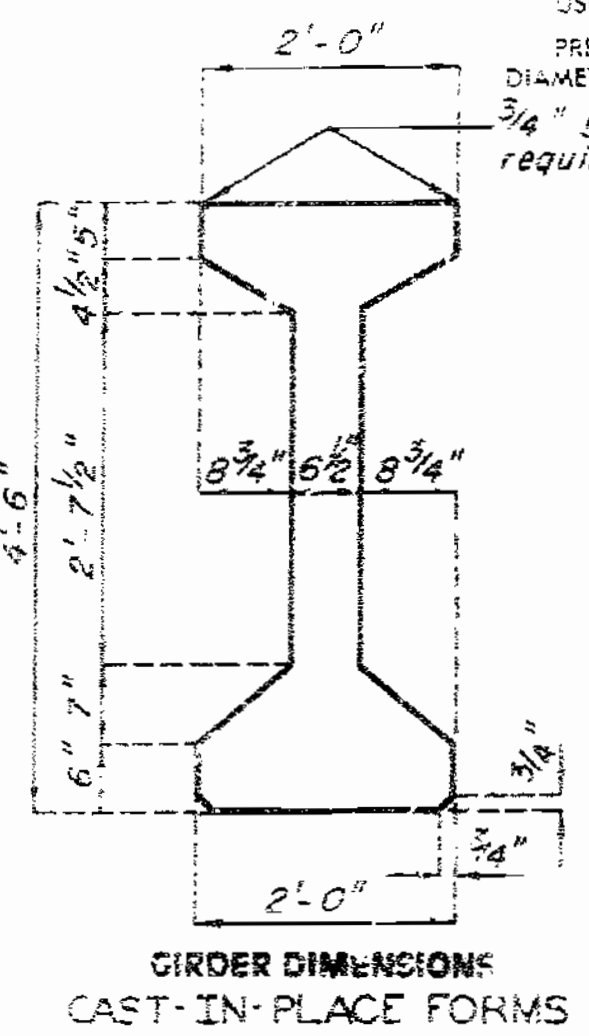


BILL OF REINFORCING STEEL - EACH GIRDER				BENDING DIAGRAMS	
NO.	SIZE & MARK	ACTUAL LENGTH	SHAPE		
4	6A1	41'-3"	20	SHAPE 10	
138	5B1	5'-11"	11	SHAPE 9	
8	6B2	5'-4"	11	SHAPE 11	
69	4C1	2'-2"	10		
138	4D1	3'-0"	9		



NOTE: ALL DIMENSIONS IN BENDING DIAGRAM ARE OUT TO OUT.  
 HOOKS AND BENDS SHALL BE IN ACCORDANCE WITH THE CRSI MANUAL OF STANDARD PRACTICE FOR DETAILING REINFORCED CONCRETE STRUCTURES STIRRUP AND THE DIMENSIONS.  
 ACTUAL LENGTHS ARE MEASURED ALONG CENTERLINE BAR TO THE NEAREST INCH.  
 MINIMUM CLEARANCE TO REINFORCING SHALL BE 1".  
 ALL REINFORCEMENT SHALL BE GRADE 60.  
 THE TWO D1 BARS MAY BE FURNISHED AS ONE BAR AT THE FABRICATOR'S OPTION.

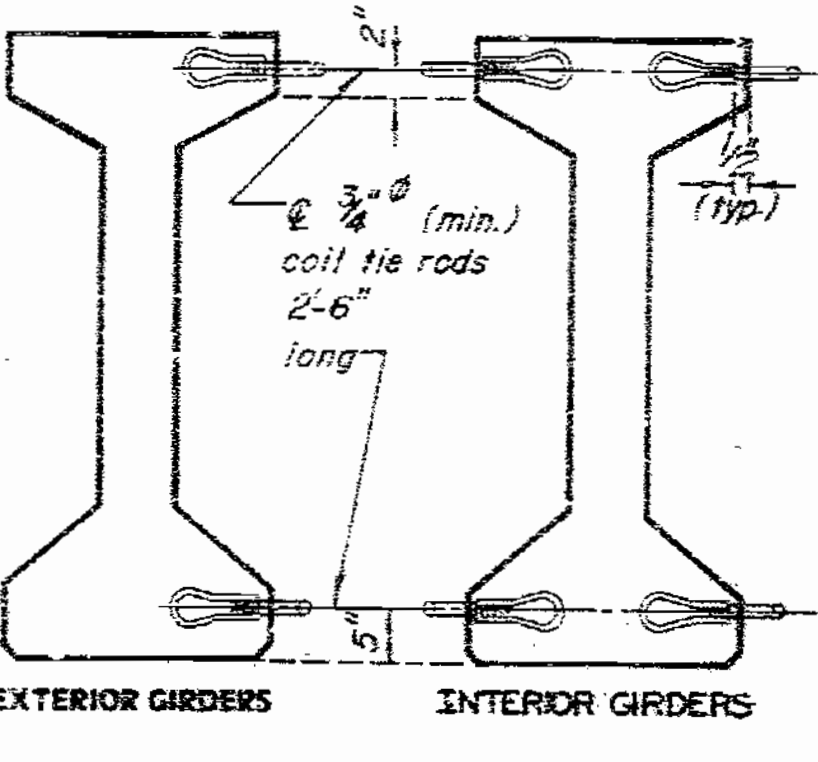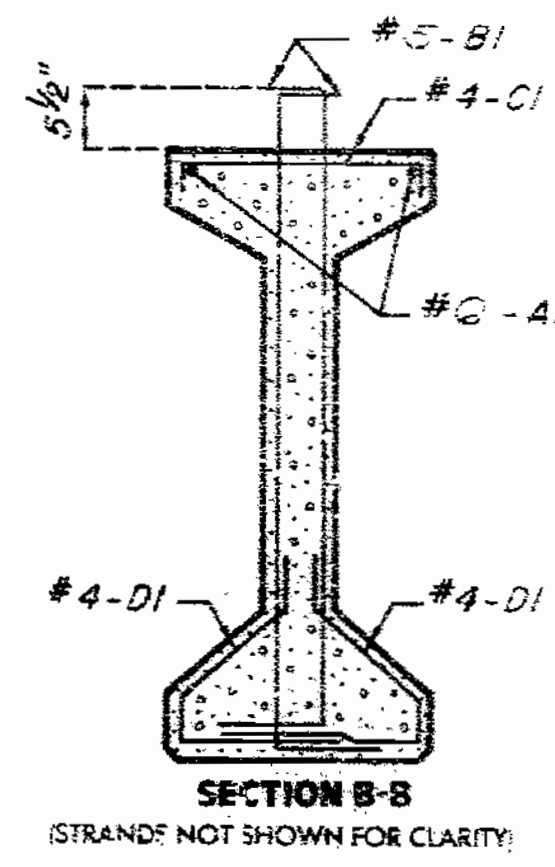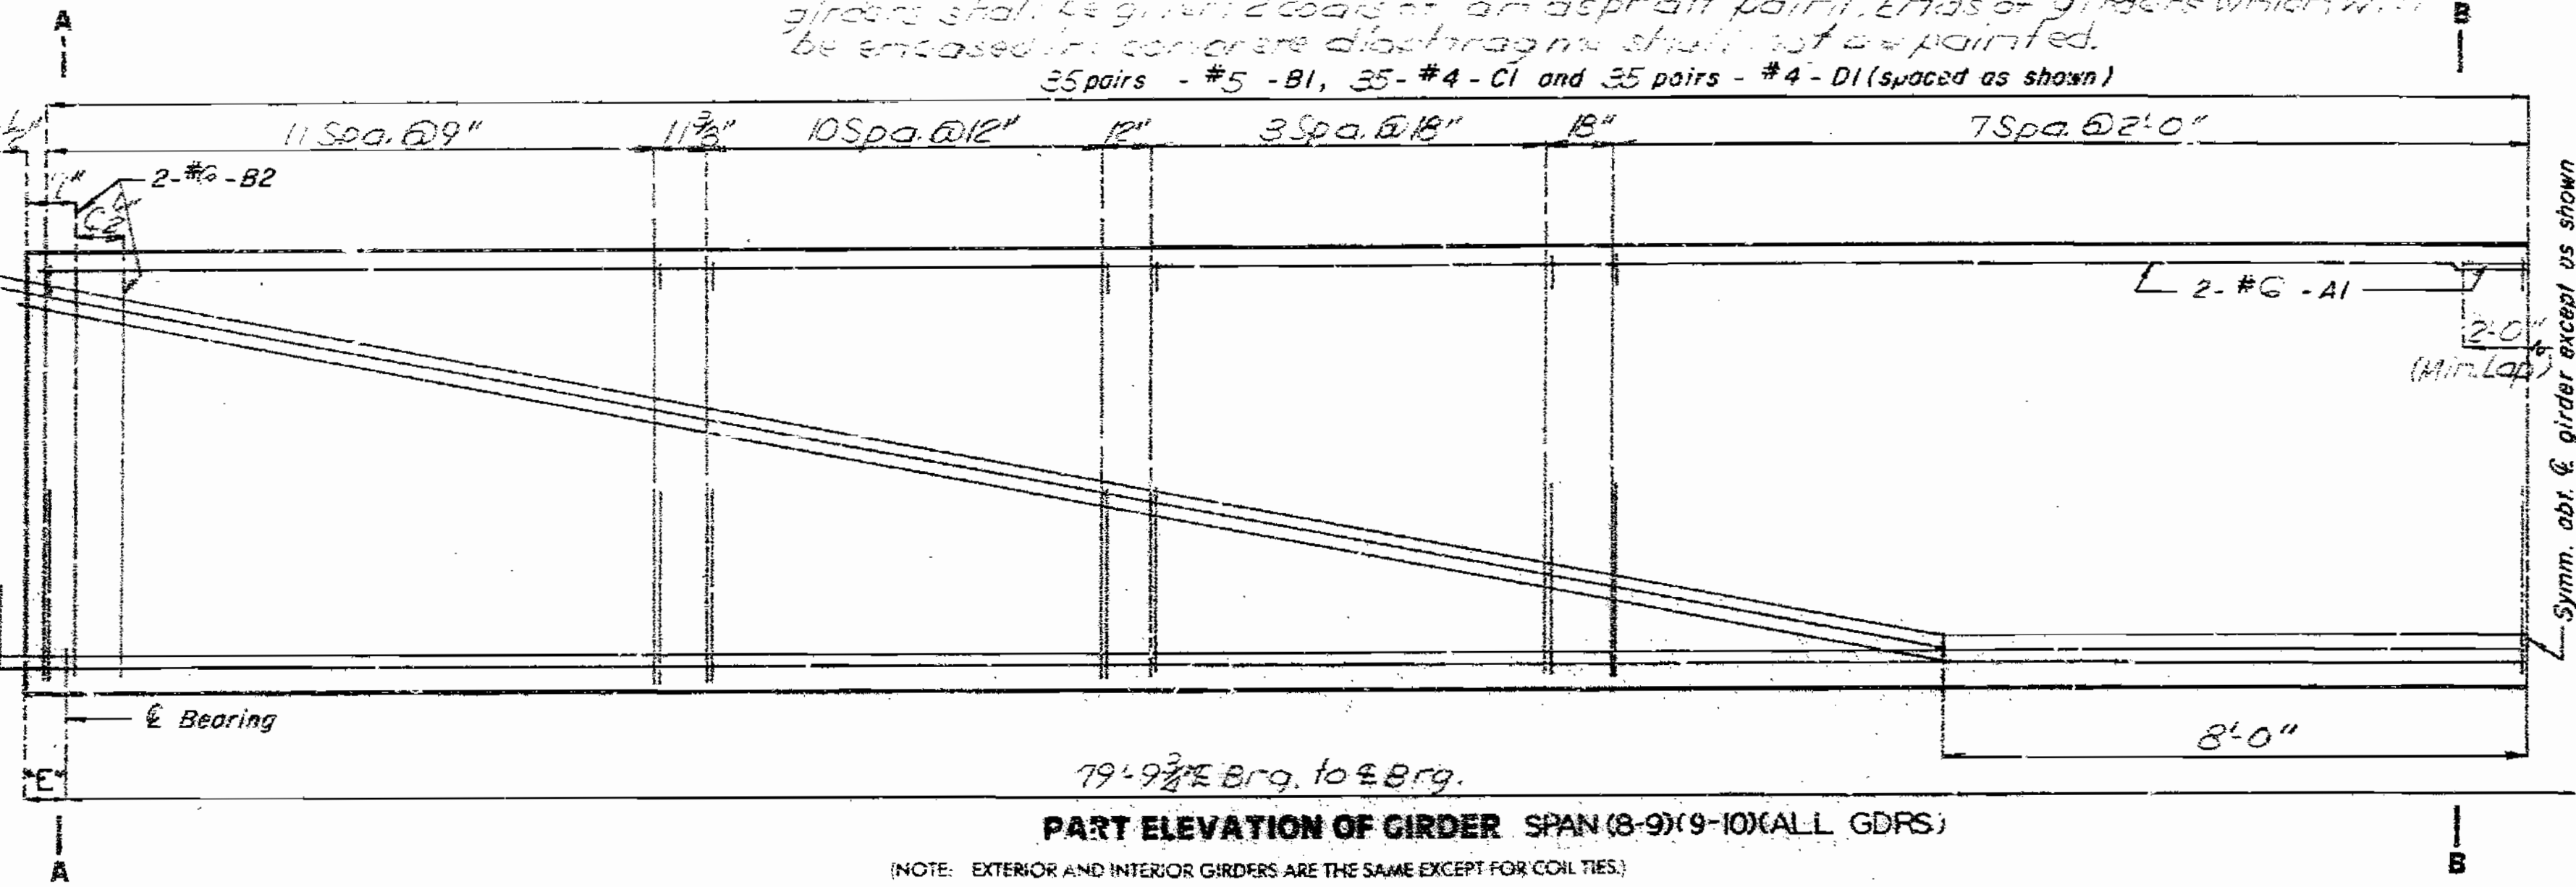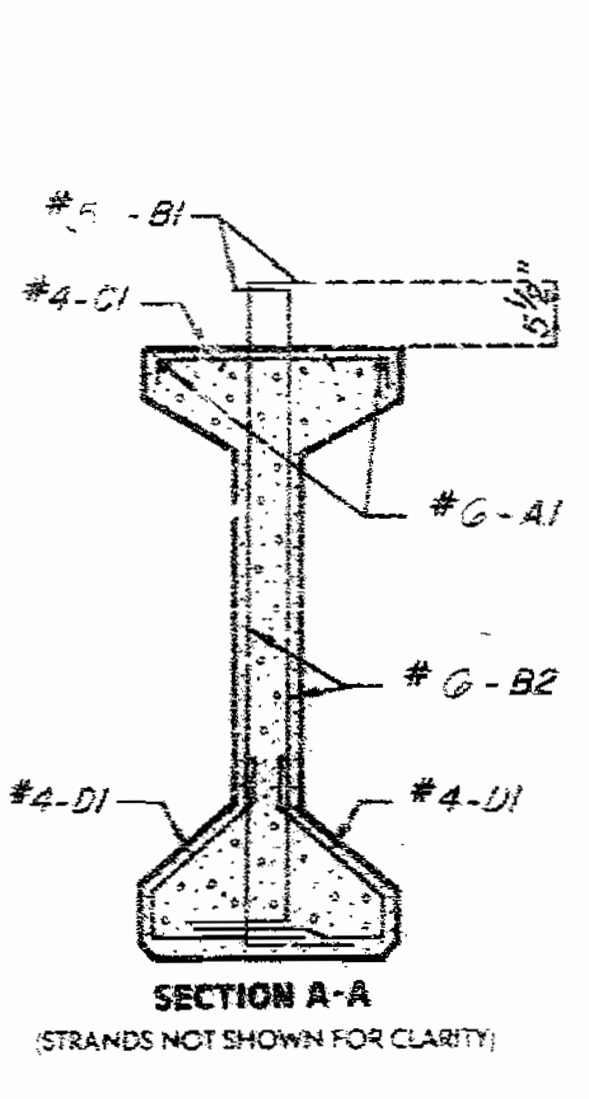

NOTE: COST OF 3/4" COIL TIE RODS PLACED IN DIAPHRAGMS IS INCLUDED IN CONTRACT UNIT PRICE FOR PRESTRESSED CONCRETE MEMBERS.  
 COIL TIES SHALL BE HELD IN PLACE IN THE FORMS BY SLOTTED WIRE SETTING STUDS PROJECTING THRU FORM. STUDS ... TO BE LEFT IN PLACE OR REPLACED WITH TEMPORARY PLUGS UNTIL GIRDERS ARE ERECTED AND THEN REPLACED BY COIL TIE RODS.

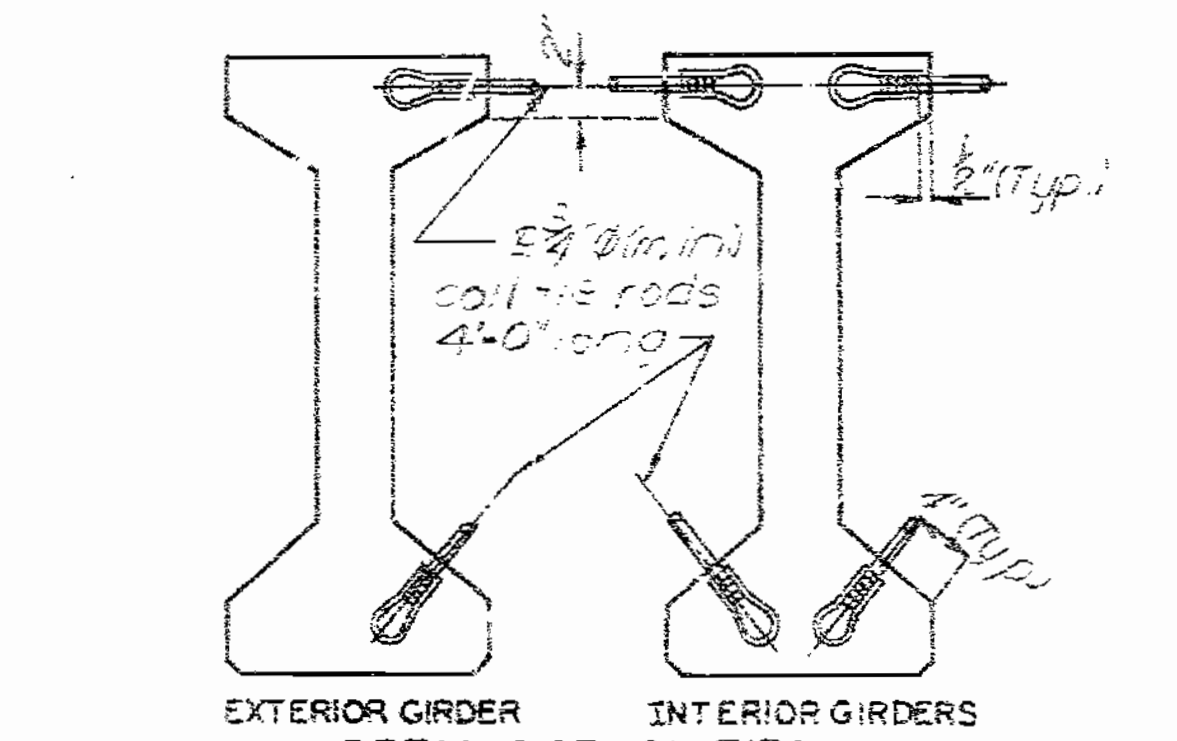

Note: For details of slotted wells to be cast in top of girder (at Int. Bl. 9 end only) see sheet No. 65.  
 For details of Int. Bl. Diaphragm see sheet No. 64.  
 For location of Int. Diaphragm and girder placement see sheet No. 25.  
 For girder camber and haunching see sheet No. 69.

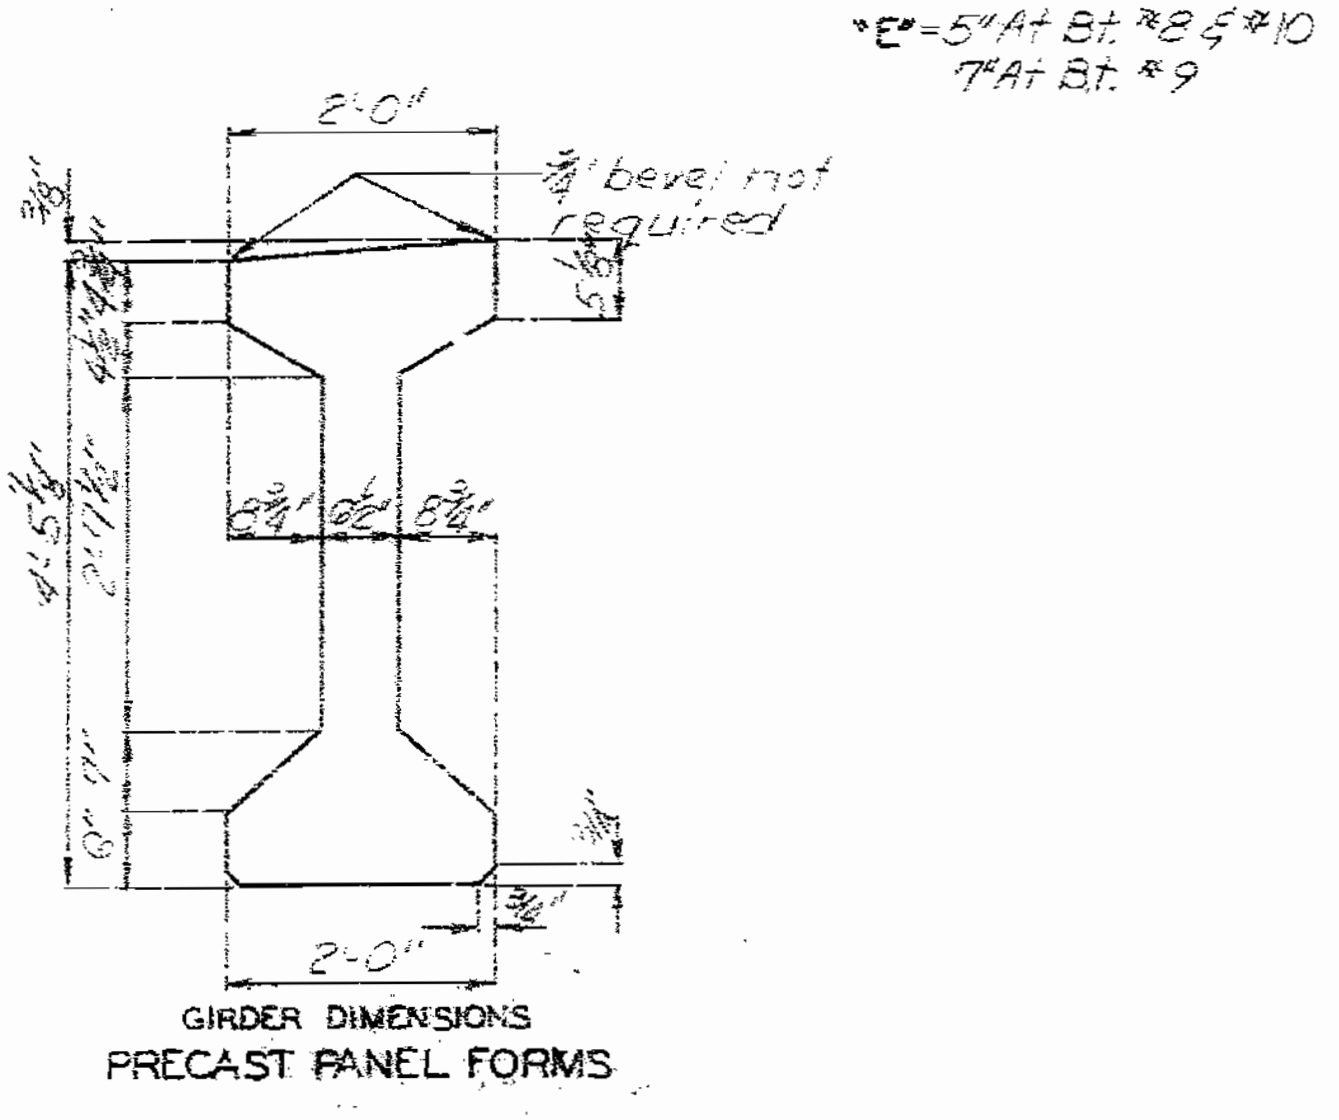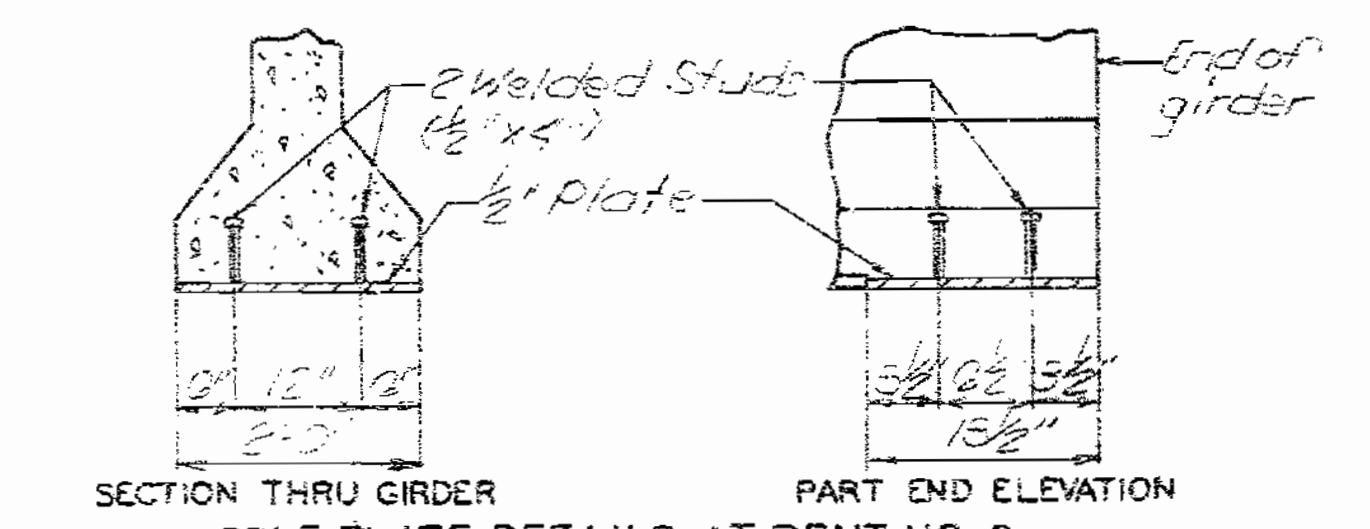

Note: Cost of furnishing and installing for plates and welded studs in sole plate shall be included in price bid for Prestressed Concrete 3 Girders per each. See Special Provisions for painting.

Note: This drawing is not to scale. Follow dimensions.





REVISED JUNE 1987  
 FEB 1974

DETAILED MAR 1988  
 CHECKED OCT 1988

Sheet No. 35 of 35

STATE	PROJ NO	SHEET NO
MO		110





**NOTE:**  
 CONCRETE FOR PRESTRESSED GIRDERS SHALL BE CLASS A1 WITH  $f_c = 6,000$  PSI.  
 (+) INDICATES PRESTRESSED STRAND.  
 USE 1/8 STRANDS WITH AN INITIAL PRESTRESS FORCE OF 5.5 KIPS.  
 PRESTRESSING TENDONS SHALL BE UNCOATED, SEVEN-WIRE, LOW RELAXATION STRANDS - 1/2 INCH DIAMETER CONFORMING TO A.A.S.H.T.O. M203, GRADE 270. SEE MO. STD. SPECIFICATIONS 705.4.8.

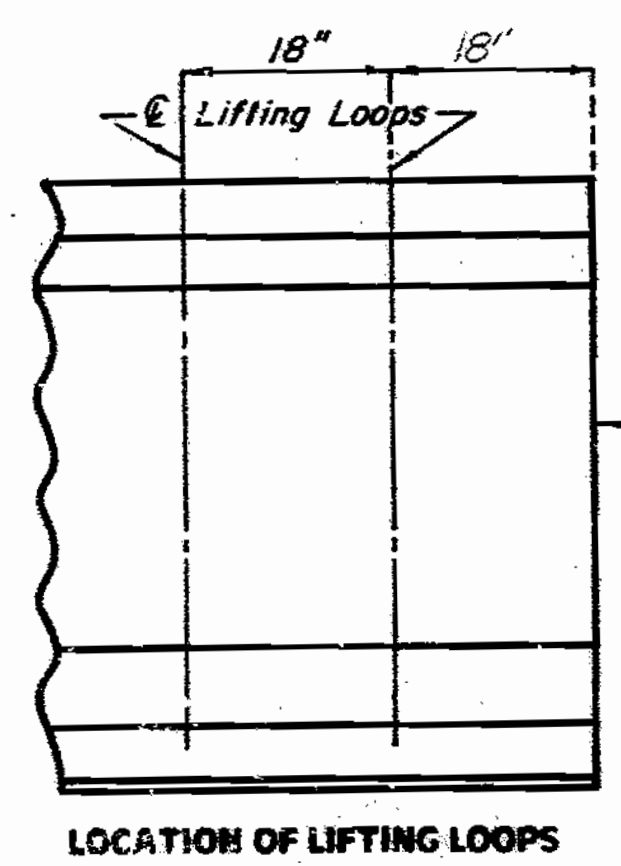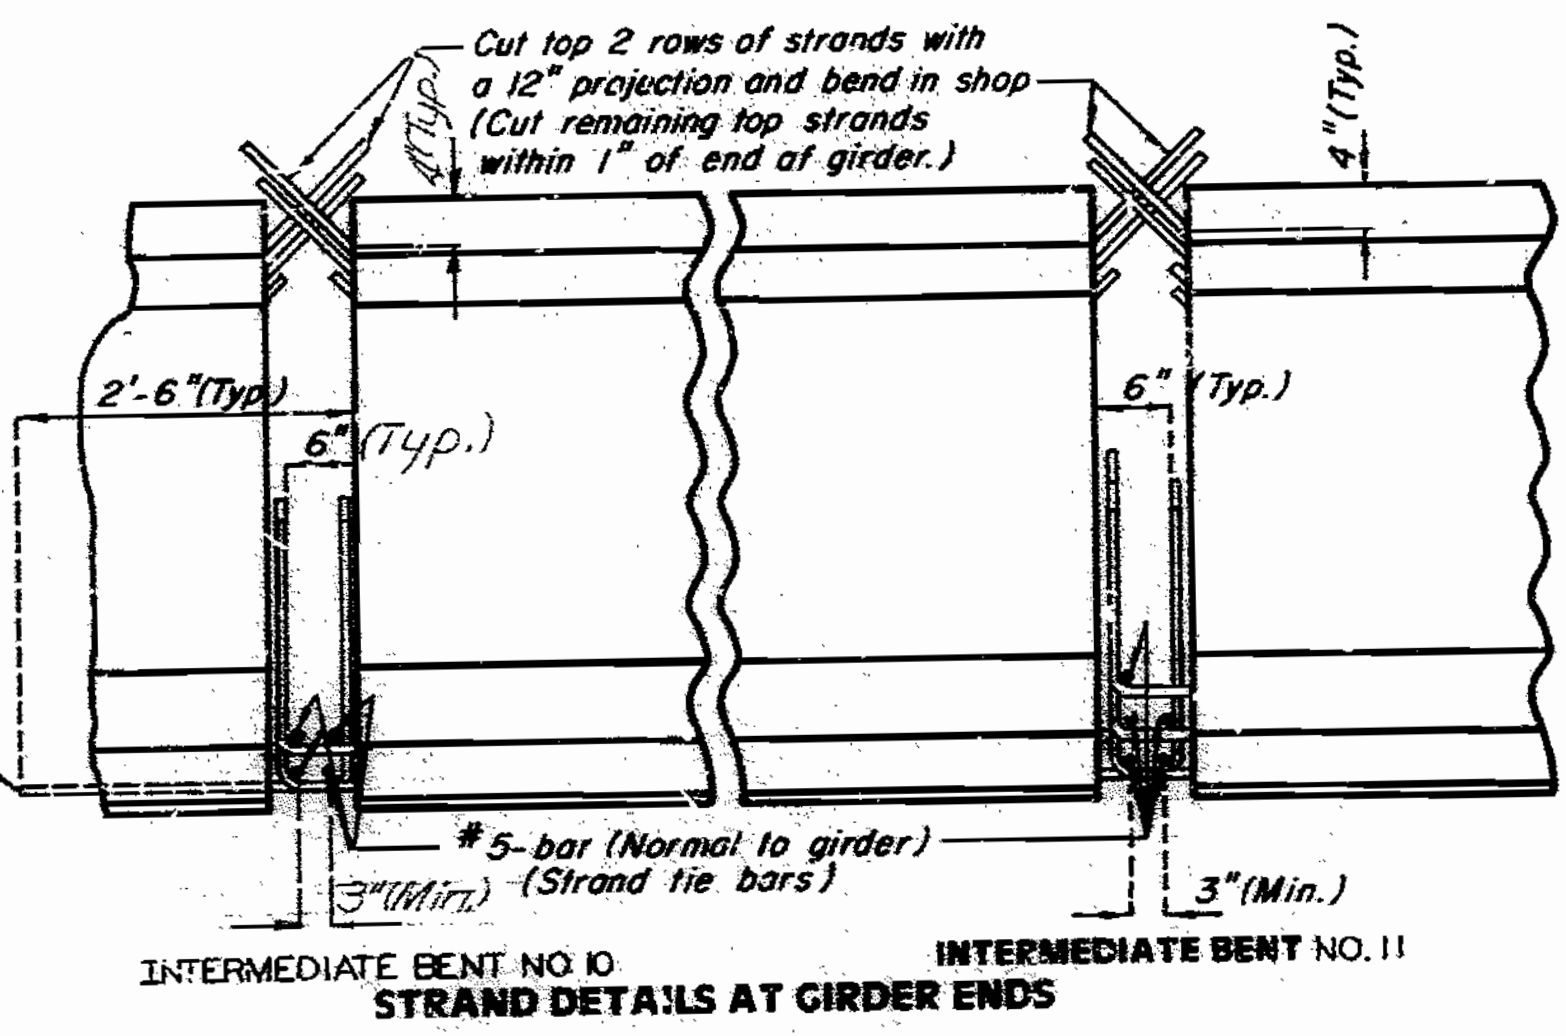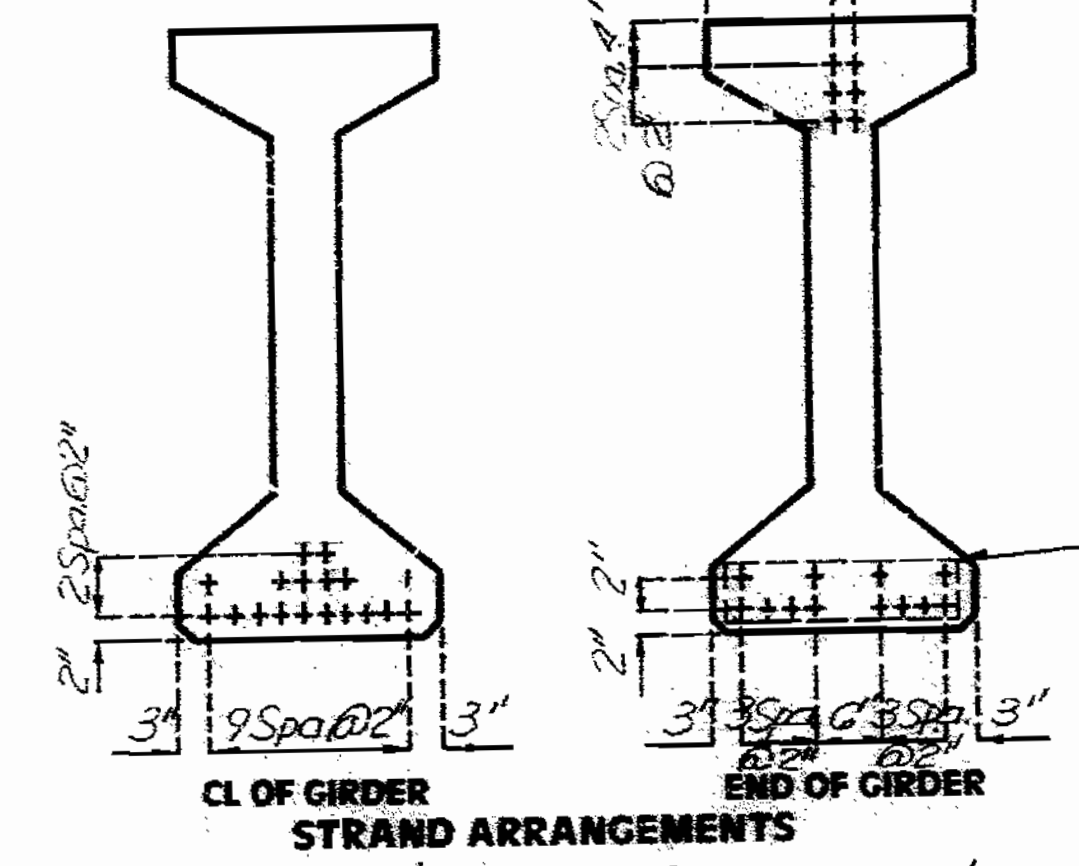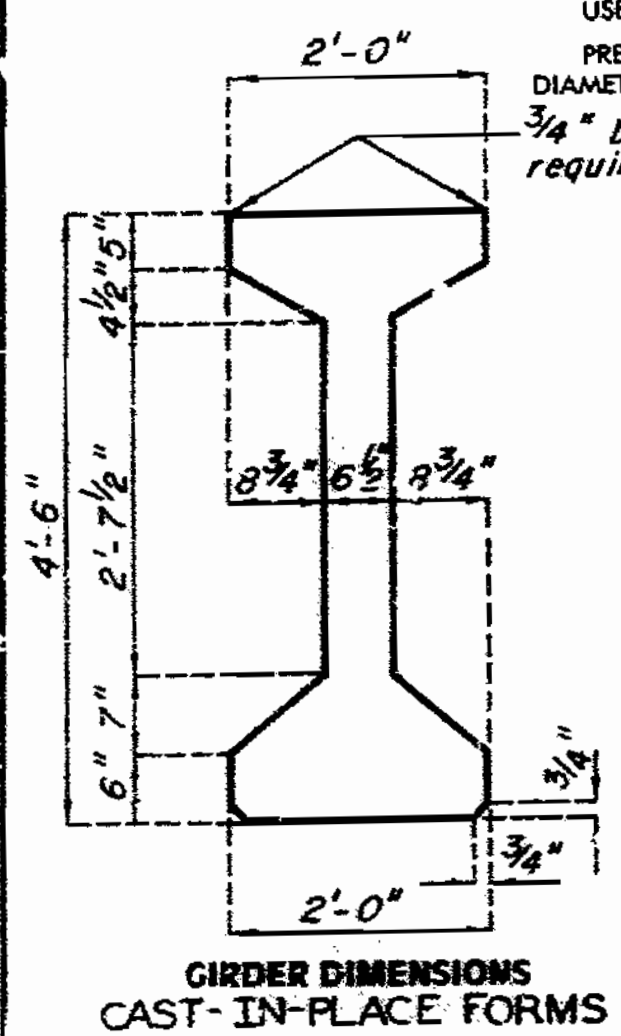

BILL OF REINFORCING STEEL - EACH GIRDER				BENDING DIAGRAMS	
NO.	SIZE & MARK	ACTUAL LENGTH	SHAPE		
4	6A1	38'-2"	20	SHAPE 9	SHAPE 10
126	5B1	5'-11"	11		
8	5B2	5'-4"	11	SHAPE 11	SHAPE 10
63	4C1	2'-2"	10		
126	4D1	3'-0"	9		

**NOTE:**  
 ALL DIMENSIONS IN BENDING DIAGRAM ARE OUT TO OUT.  
 HOOKS AND BENDS SHALL BE IN ACCORDANCE WITH THE CRSI MANUAL OF STANDARD PRACTICE FOR DETAILING REINFORCED CONCRETE STRUCTURES STIRRUP AND TIE DIMENSIONS.  
 ACTUAL LENGTHS ARE MEASURED ALONG CENTERLINE BAR TO THE NEAREST INCH.  
 MINIMUM CLEARANCE TO REINFORCING SHALL BE 1".  
 ALL REINFORCEMENT SHALL BE GRADE 60.  
 THE TWO D1 BARS MAY BE FURNISHED AS ONE BAR AT THE FABRICATOR'S OPTION.

Note: Strand release for 9,000psi concrete = 4500psi.

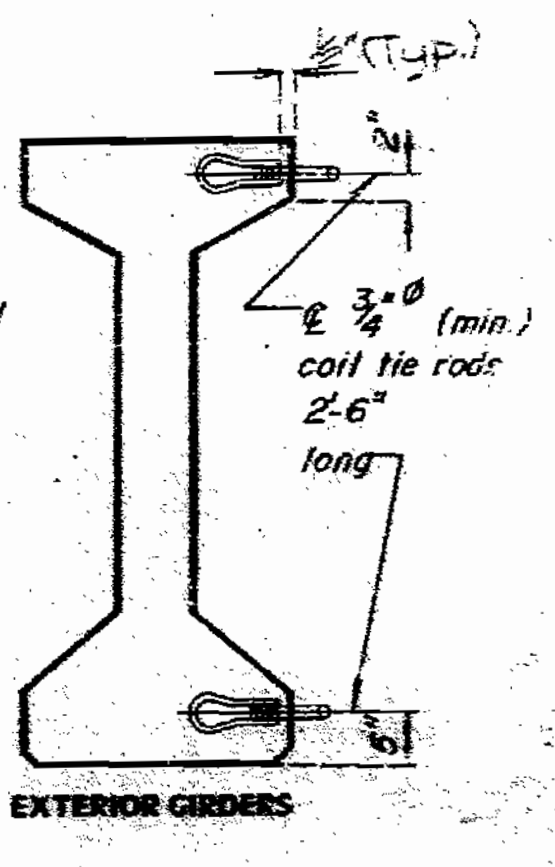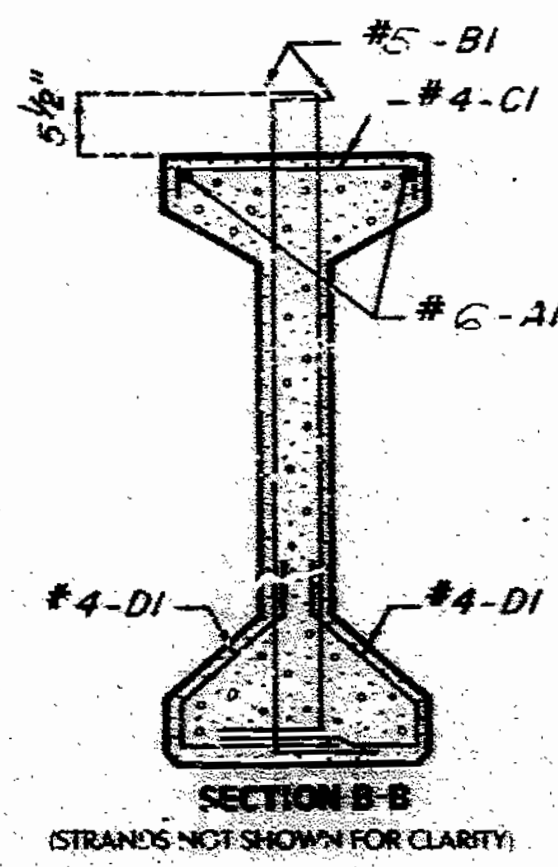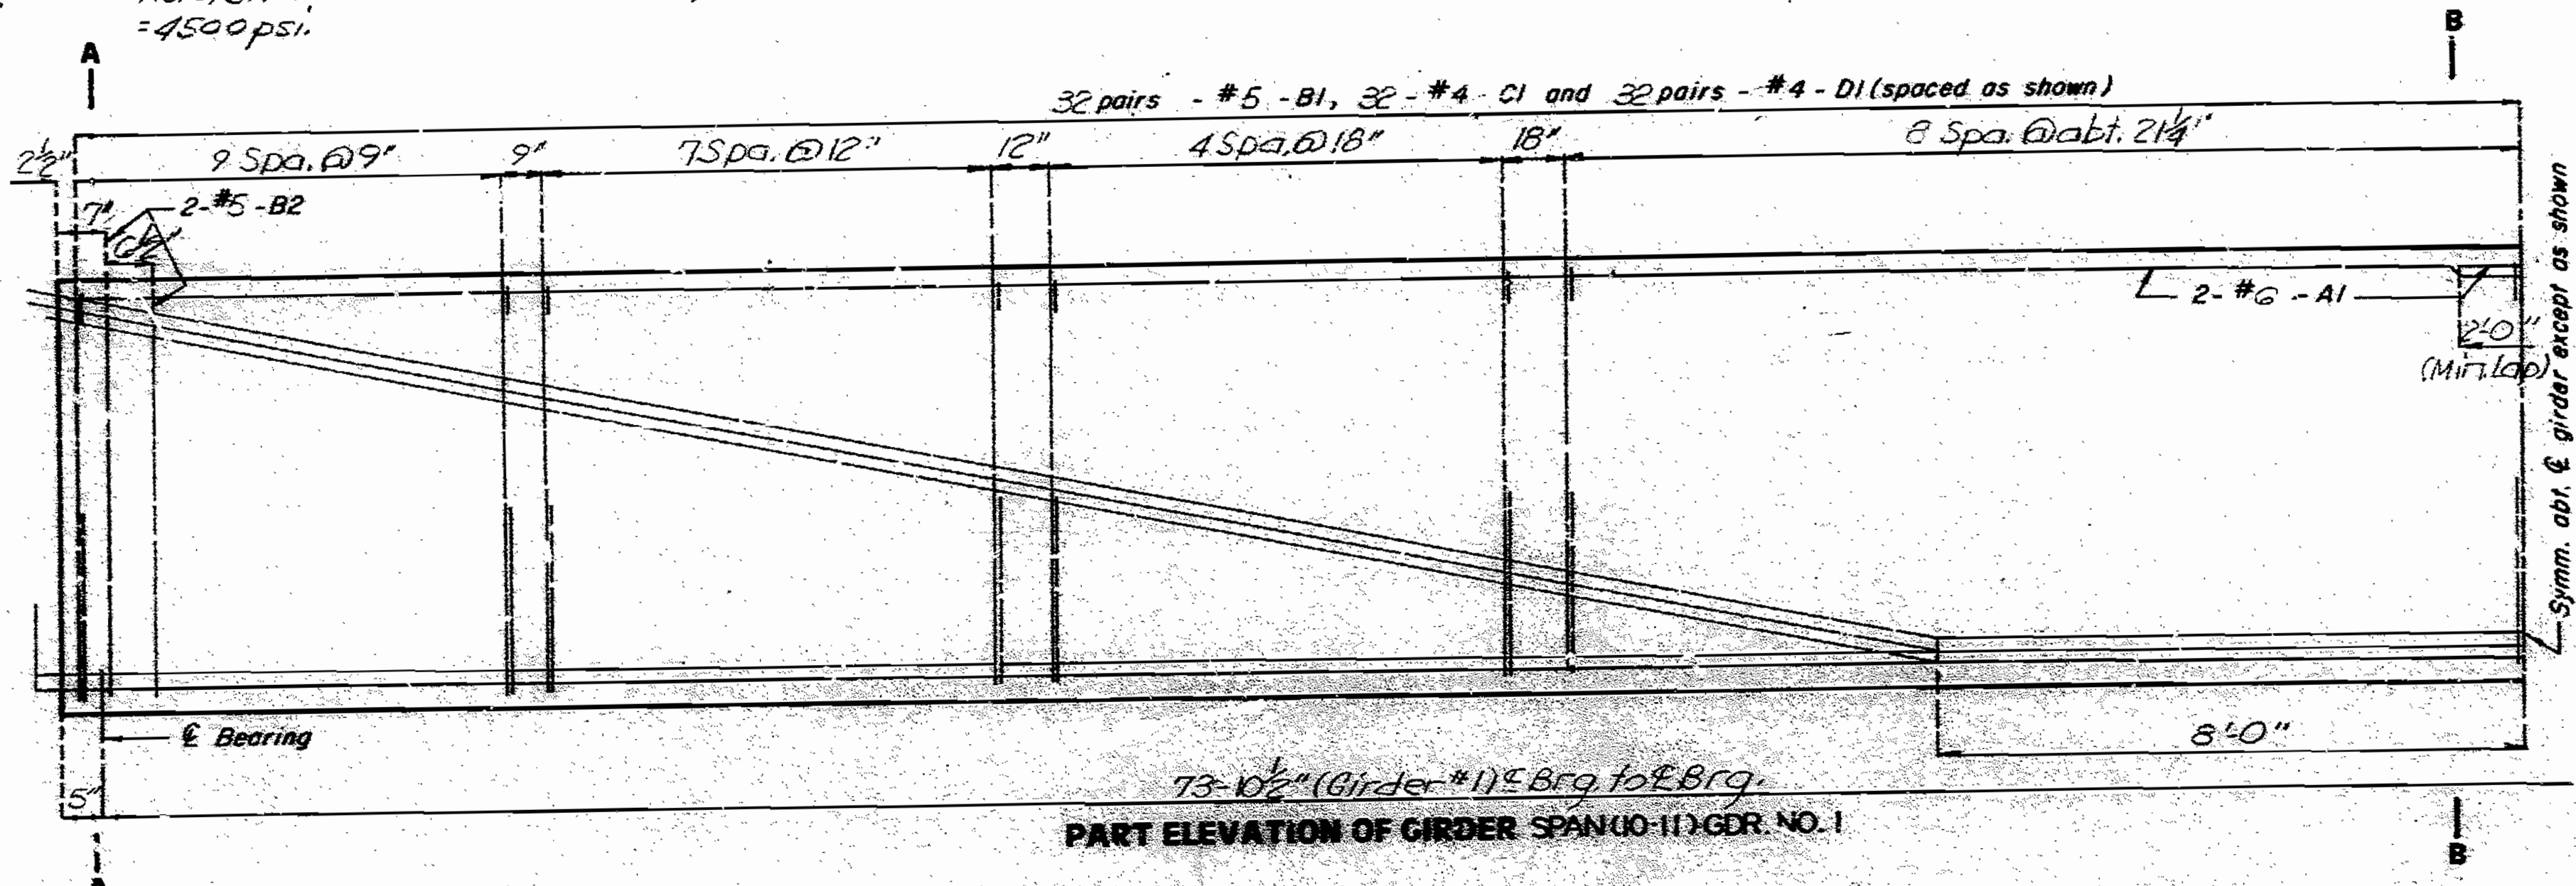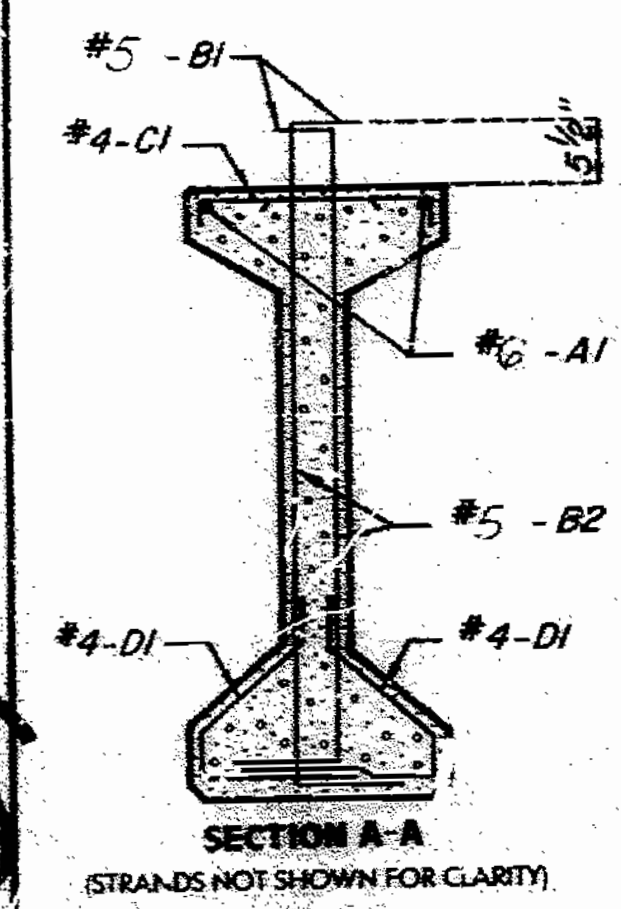


**DETAILS OF COIL TIES**

**NOTE:**  
 COST OF 3/4" COIL TIE RODS PLACED IN DIAPHRAGMS IS INCLUDED IN CONTRACT UNIT PRICE FOR PRESTRESSED CONCRETE MEMBERS.  
 COIL TIES SHALL BE HELD IN PLACE IN THE FORMS BY SLOTTED WIRE SETTING STUDS PROJECTING THRU FORMING STUDS ARE TO BE LEFT IN PLACE OR REPLACED WITH TEMPORARY PLUGS UNTIL GIRDERS ARE ERECTED AND THEN REPLACED BY COIL TIE RODS.

**NOTE:**  
 The 1/2" holes shall be cast in the web for steel intermediate diaphragms. Drilling is not allowed.

Note: For details of Int. Bt. Diaph. see sheet No. 64 & 65.  
 For location of Int. Diaph. and general girder placement, see sheet No. 25.  
 For Girder Camber and haunching see sheet No. 63

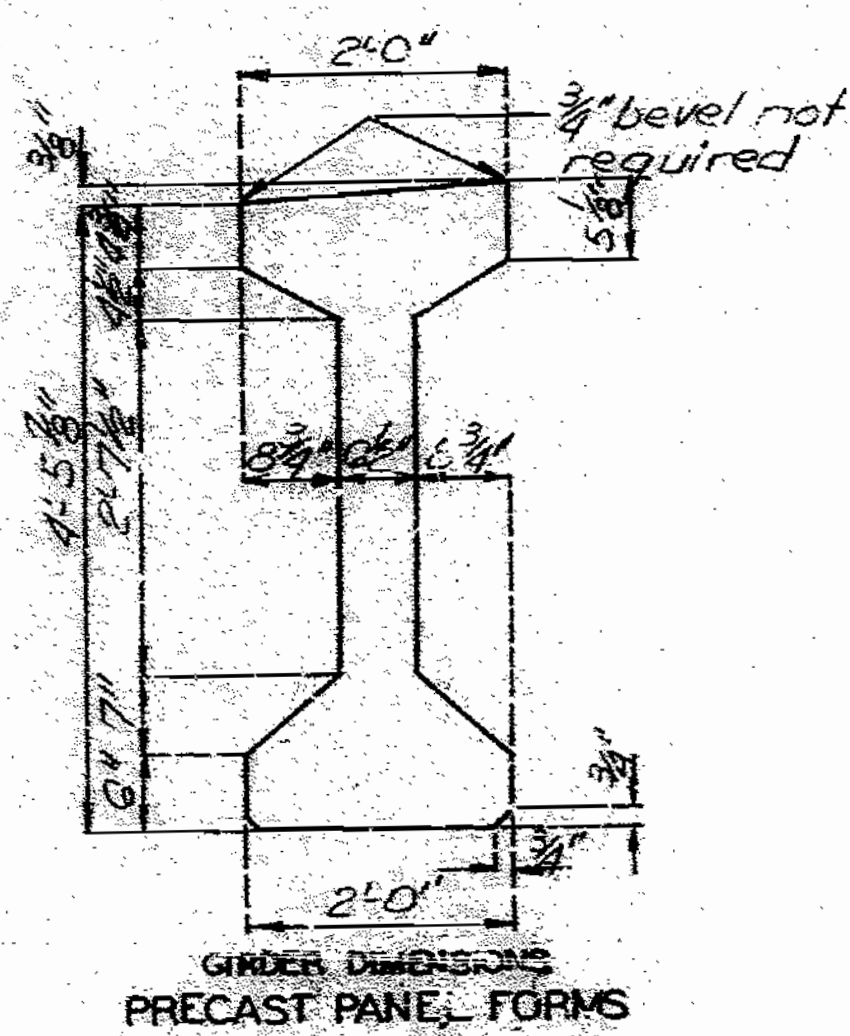

158

SPS 55.6.62 REVISED JUNE 1987  
 FEB. 1974

DETAILED MAR. 1988  
 CHECKED OCT. 1988

Note: This drawing is not to scale. Follow dimensions.


Sheet No. 36 of 38

JACKSON COUNTY


A-2745

NOTE:


CONCRETE FOR PRESTRESSED GIRDERS SHALL BE CLASS A1 WITH  $f_c = 6,000$  PSI.  
 (+) INDICATES PRESTRESSED STRAND.  
 USE 16 STRANDS WITH AN INITIAL PRESTRESS FORCE OF 495 KIPS.  
 PRESTRESSING TENDONS SHALL BE UNCOATED, SEVEN-WIRE, LOW RELAXATION STRANDS -  $\frac{1}{2}$  INCH DIAMETER CONFORMING TO A.A.S.H.T.O. M203, GRADE 270. SEE MO. STD. SPECIFICATIONS 705.4.8

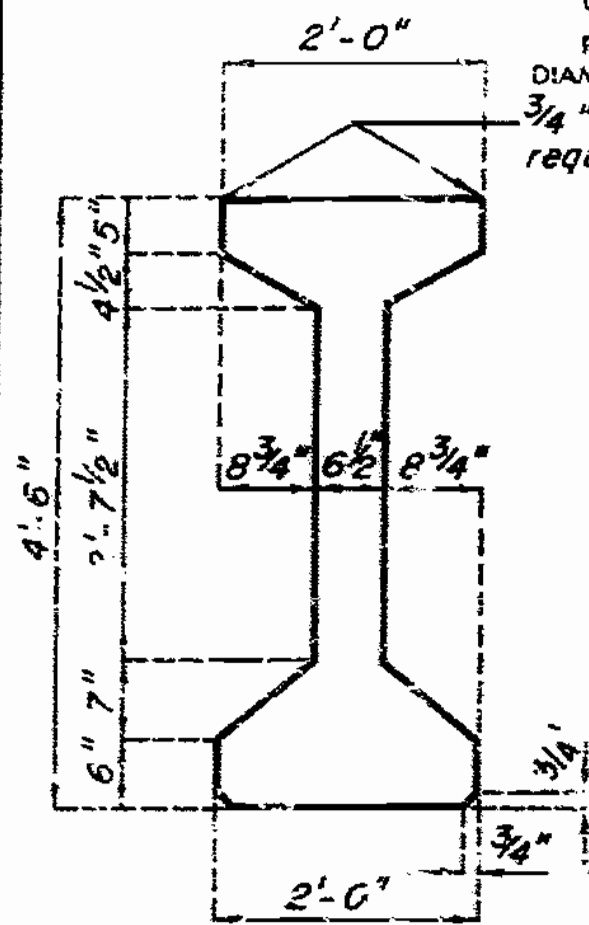


GIRDER DIMENSIONS  
CAST-IN-PLACE FORMS

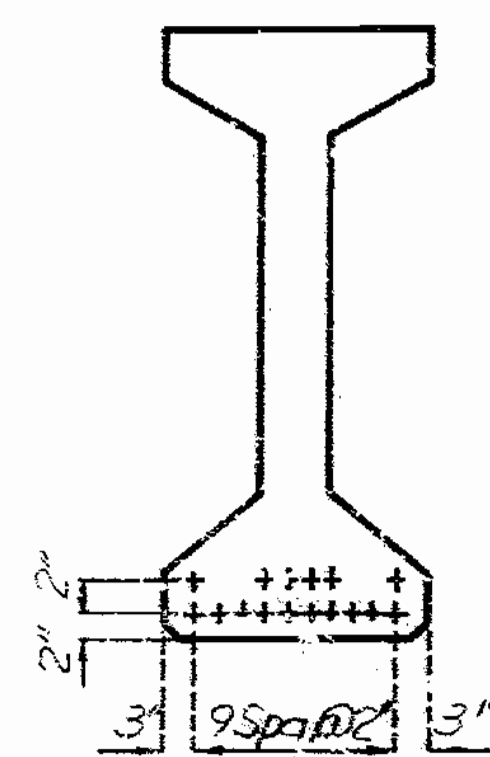


CL OF GIRDER  
STRAND ARRANGEMENTS

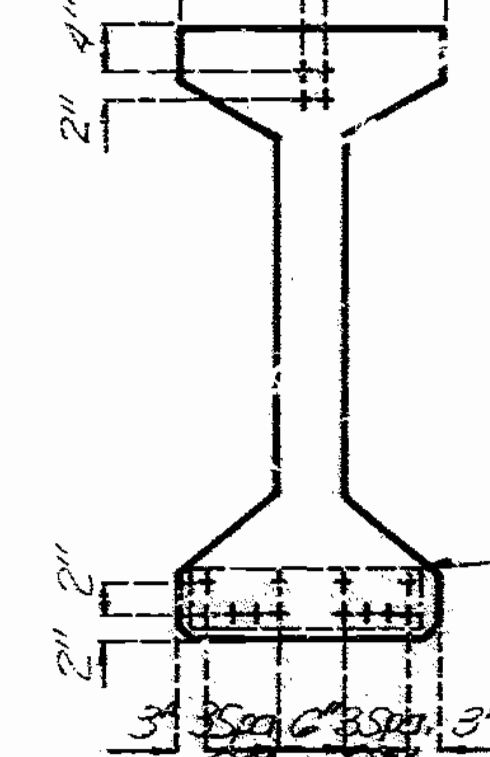

END OF GIRDER  
STRAND ARRANGEMENTS

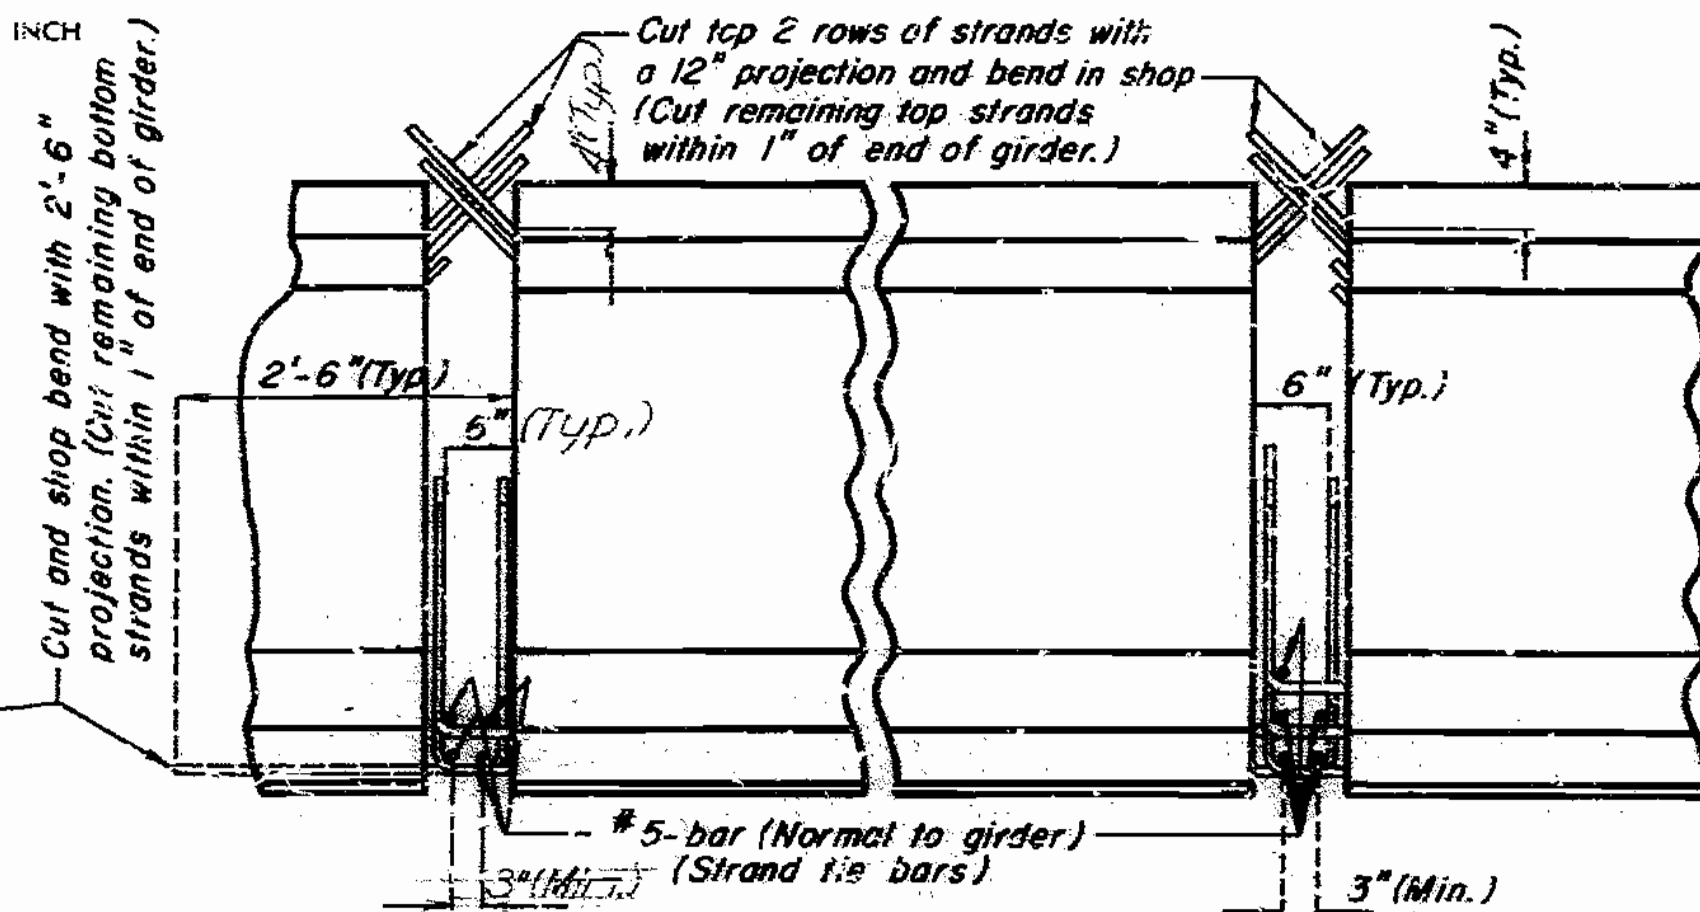


INTERMEDIATE BENT NO. 10  
STRAND DETAILS AT GIRDER ENDS

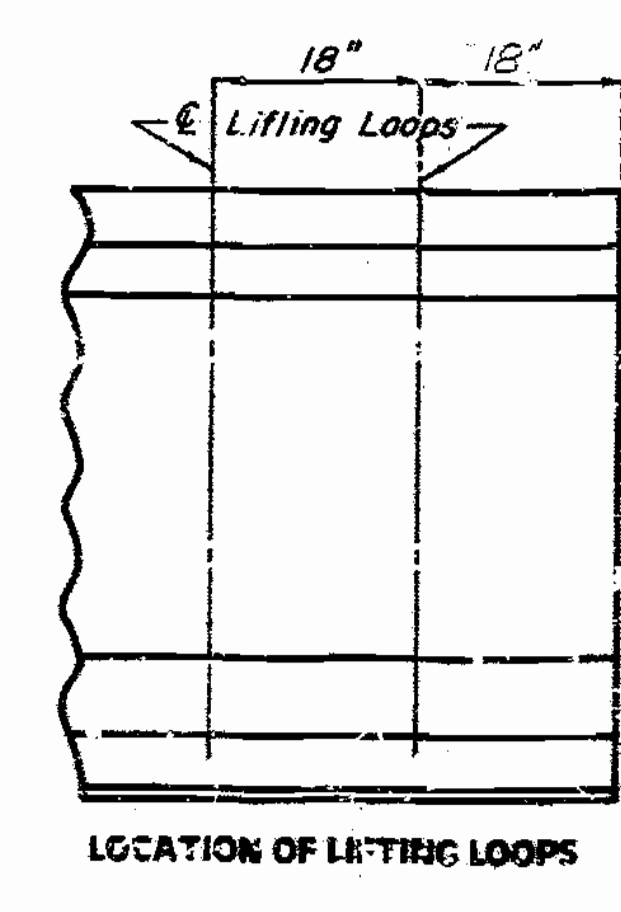


LOCATION OF LIFTING LOOPS

BILL OF REINFORCING STEEL - EACH GIRDER				
NO.	SIZE & MARK	ACTUAL LENGTH	SHAPE	BENDING DIAGRAMS
4	6A1	35'-10"	20	SHAPE 10
118	5B1	5'-11"	11	
8	5B2	5'-4"	11	SHAPE 11
139	4C1	2'-2"	10	
118	4D1	3'-0"	9	SHAPE 9
				SHAPE 20


NOTE:  
 ALL DIMENSIONS IN BENDING DIAGRAM ARE OUT TO OUT.  
 HOOKS AND BENDS SHALL BE IN ACCORDANCE WITH THE CSI MANUAL OF STANDARD PRACTICE FOR DETAILING REINFORCED CONCRETE STRUCTURES STIRRUP AND THE DIMENSIONS.  
 ACTUAL LENGTHS ARE MEASURED ALONG CENTERLINE BAR TO THE NEAREST INCH.  
 MINIMUM CLEARANCE TO REINFORCING SHALL BE 1".  
 ALL REINFORCEMENT SHALL BE GRADE 60.  
 THE TWO D1 BARS MAY BE FURNISHED AS ONE BAR AT THE FABRICATOR'S OPTION.

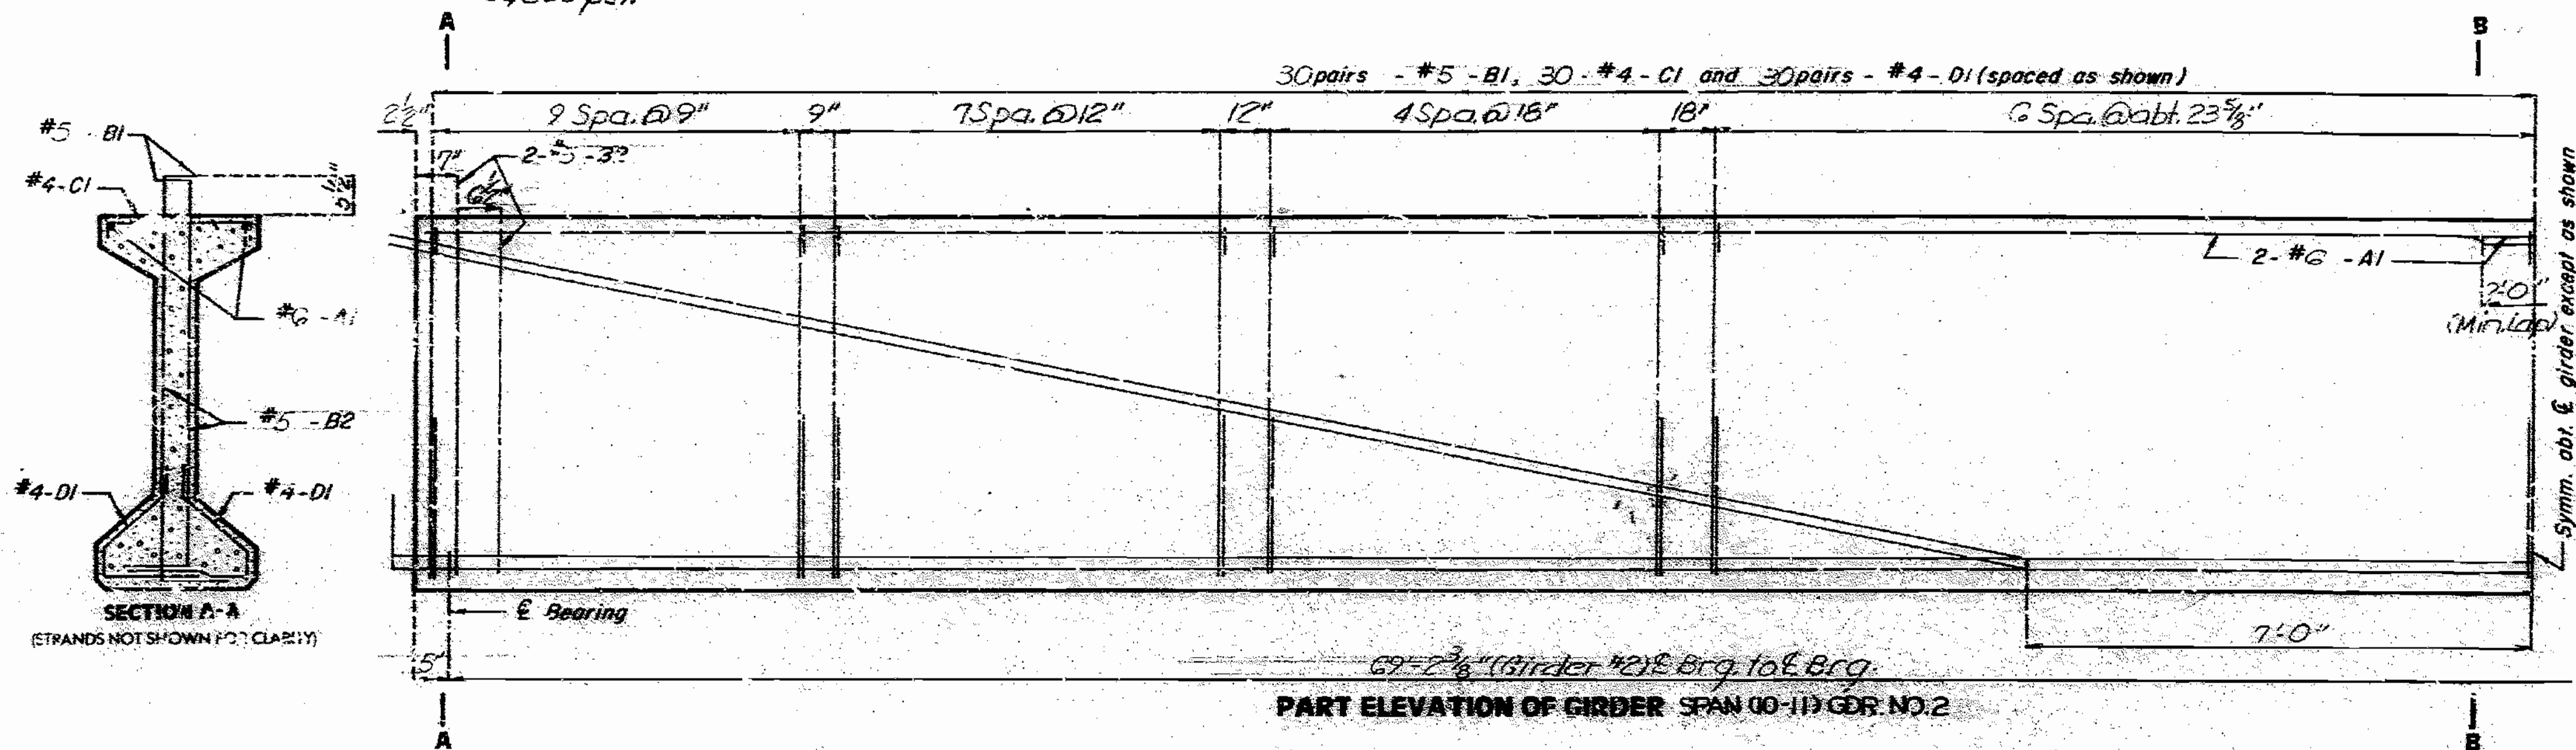


PART ELEVATION OF GIRDER SPAN (0-11) GER NO. 2

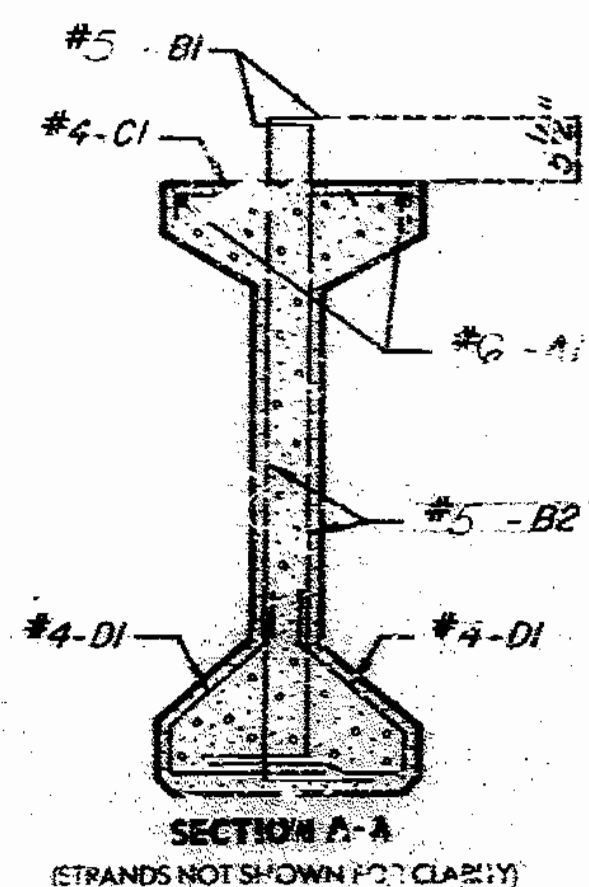

SECTION A-A  
(STRANDS NOT SHOWN FOR CLARITY)

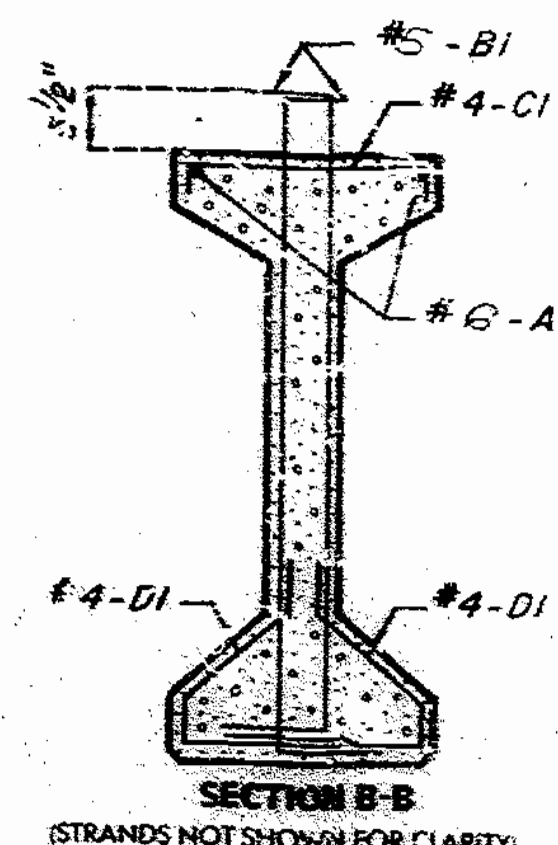


SECTION B-B  
(STRANDS NOT SHOWN FOR CLARITY)

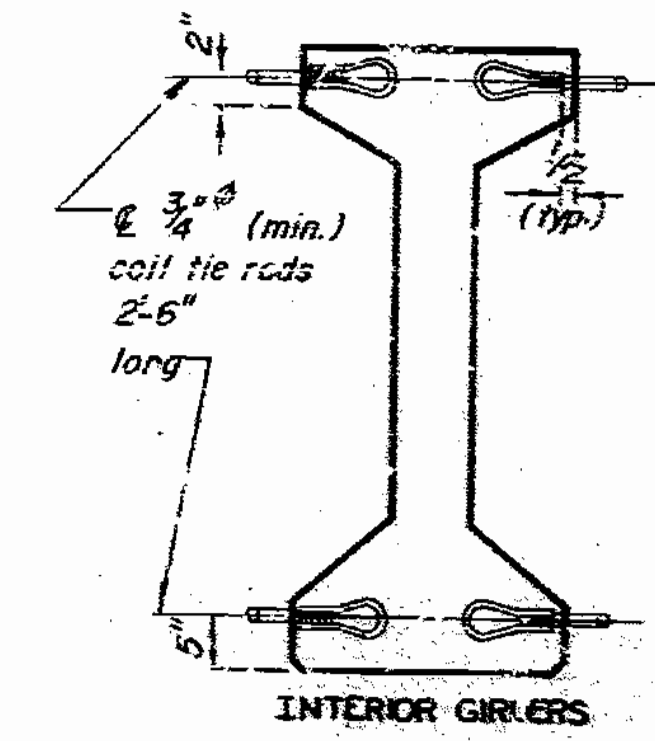

DETAILS OF COIL TIES

NOTE:  
 COST OF 3/4" COIL TIE RODS PLACED IN DIAPHRAGMS IS INCLUDED IN CONTRACT UNIT PRICE FOR PRESTRESSED CONCRETE MEMBERS.  
 COIL TIES SHALL BE HELD IN PLACE IN THE FORMS BY SLOTTED WIRE SETTING STUDS PROJECTING THRU FORMS. STUDS ARE TO BE LEFT IN PLACE OR REPLACED WITH TEMPORARY PLUGS UNTIL GIRDERS ARE ERECTED AND THEN REPLACED BY COIL TIE RODS.

NOTE:  
 The 1/2" holes shall be cast in the web for steel intermediate diaphragms. Drilling is not allowed.

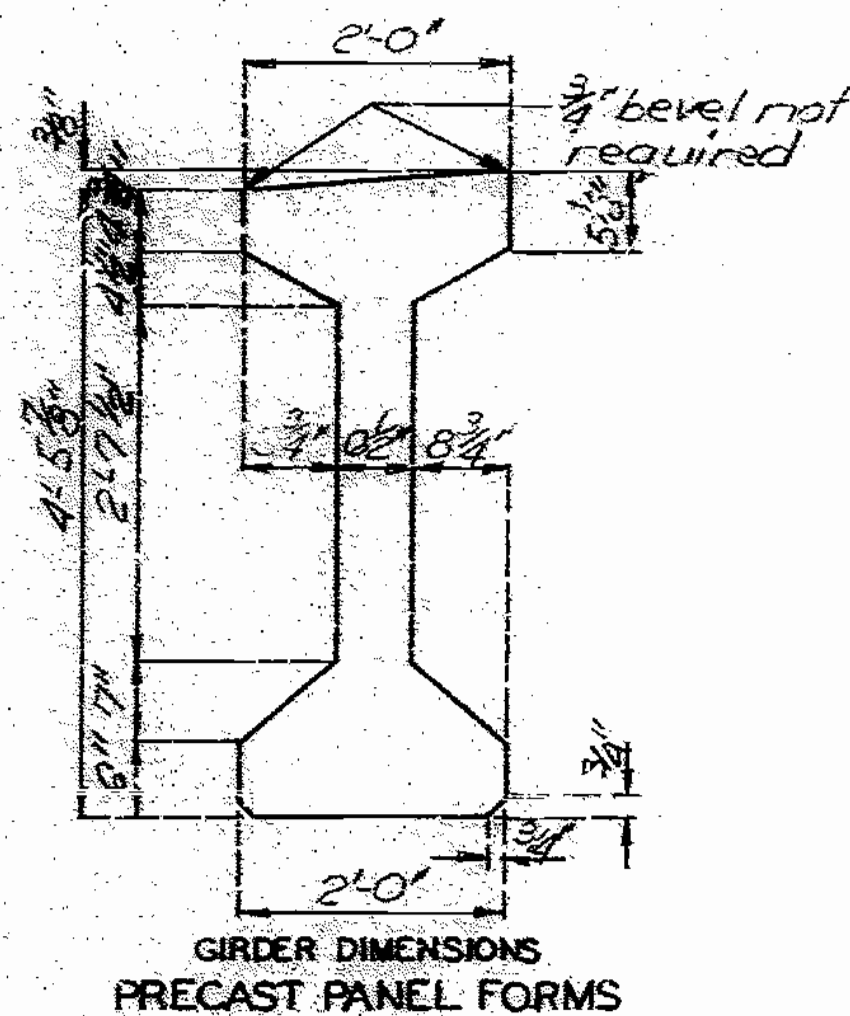

GIRDER DIMENSIONS  
PRECAST PANEL FORMS

Note: For details of Int. Bt. Diaph. see sheet No. 64 & No. 65.  
 For location of Int. Diaph. and general girder placement, see sheet No. 25.  
 For Girder Camber and Haunching see sheet No. 69.

Note: This drawing is not to scale. Follow dimensions.

Sheet No. 37 of 98

JACKSON COUNTY

A-2745

1579 130


SPS 55 C 6/4 REVISED JUNE 1987  
FEB 1974

DETAILED MAR. 1988  
CHECKED OCT. 1988




NOTE:


CONCRETE FOR PRESTRESSED GIRDERS SHALL BE CLASS A1 WITH  $f'_c = 6,000$  PSI  
 (+) INDICATES PRESTRESSED STRAND.  
 USE  $\curvearrowright$  STRANDS WITH AN INITIAL PRESTRESS FORCE OF 23% KIPS.  
 PRESTRESSING TENDONS SHALL BE UNCOATED, SEVEN-WIRE, LOW RELAXATION STRANDS.  $\frac{1}{8}$  INCH DIAMETER CONFORMING TO A.A.S.H.T.O. M203, GRADE 270. SEE MO. STD. SPECIFICATIONS 705.4 B.  
 $\frac{3}{4}$ " BEVEL NOT REQUIRED

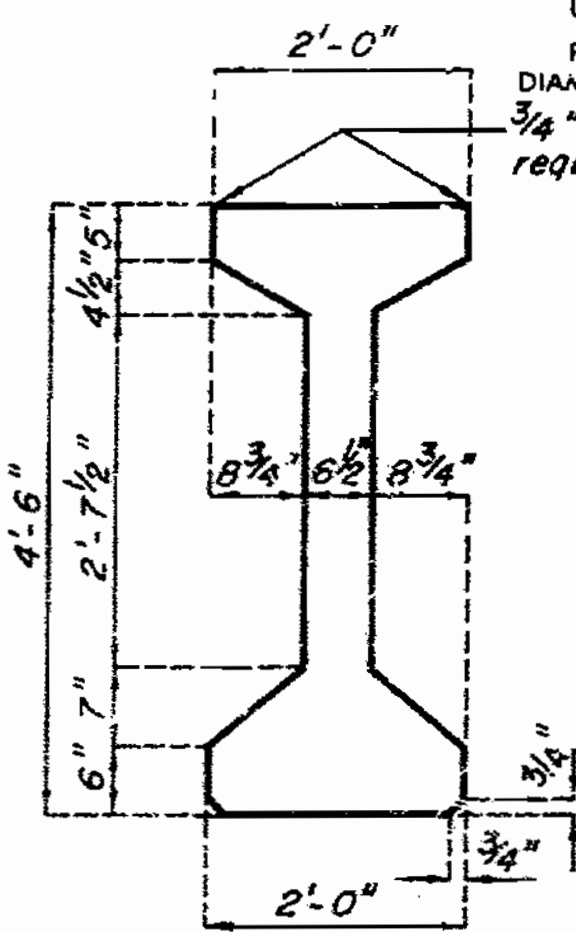


GIRDER DIMENSIONS  
CAST-IN-PLACE FORMS

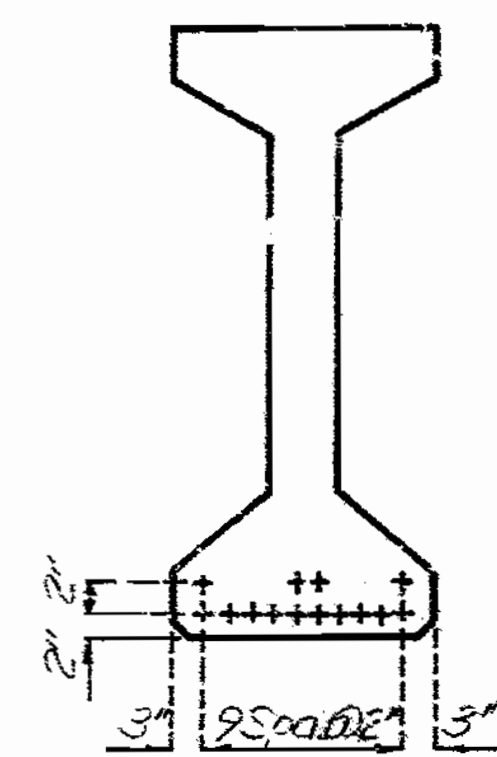


CL OF GIRDER  
STRAND ARRANGEMENTS

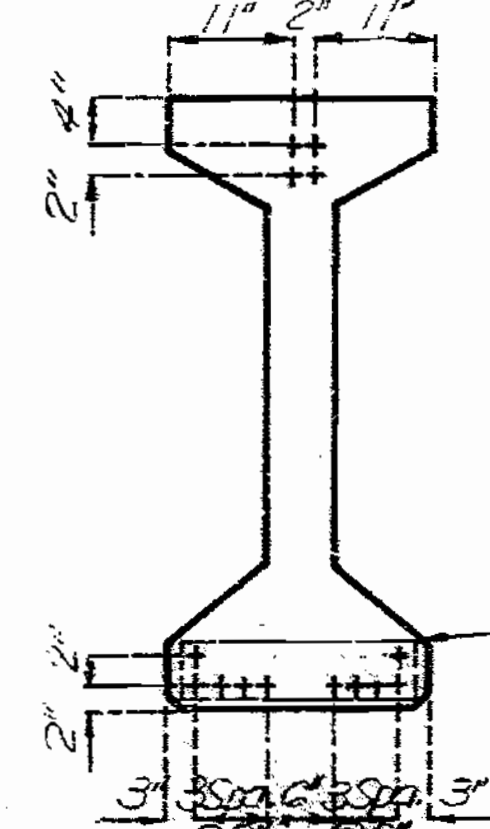

END OF GIRDER

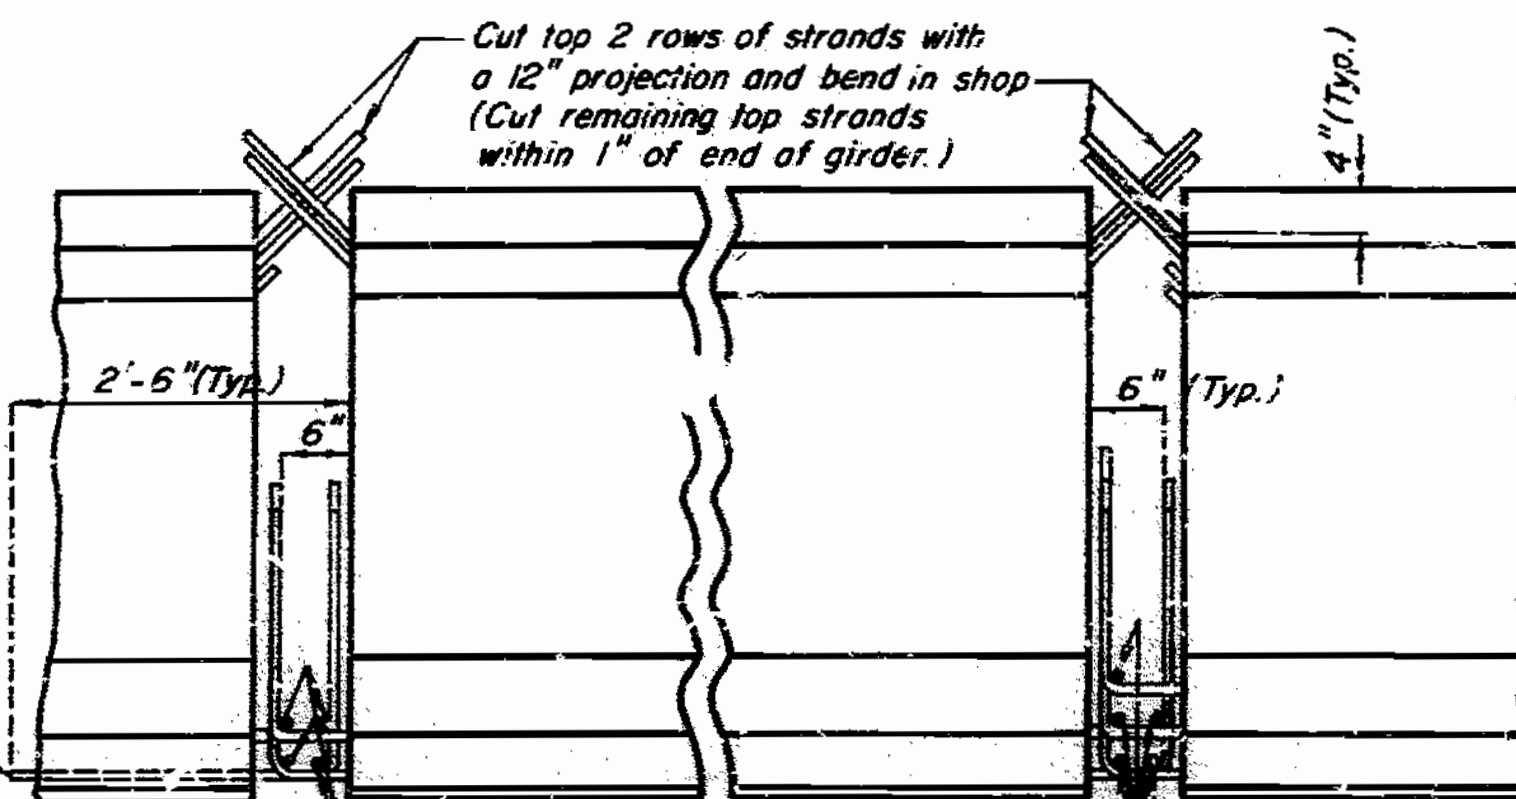

INTERMEDIATE BENT NO. 10  
INTERMEDIATE BENT NO. 11  
STRAND DETAILS AT GIRDER ENDS

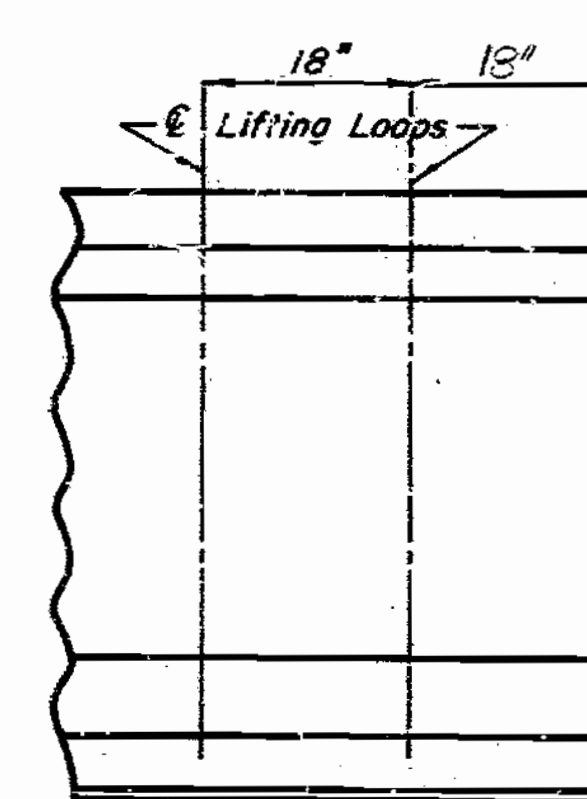


LOCATION OF LIFTING LOOPS


BILL OF REINFORCING STEEL - EACH GIRDER				BENDING DIAGRAMS	
NO.	SIZE & MARK	ACTUAL LENGTH	SHAPE		
4	GAI	①	20		
114	SBI	5'-11"	11		
4	CB2	5'-4"	11		
57	4CL	2'-2"	10		
114	4DI	3'-0"	9		

NOTE:  
 ALL DIMENSIONS IN BENDING DIAGRAM ARE OUT TO OUT.  
 HOOKS AND BENDS SHALL BE IN ACCORDANCE WITH THE CRSI MANUAL OF STANDARD PRACTICE FOR DETAILING REINFORCED CONCRETE STRUCTURES STRUJIP AND THE DIMENSIONS.  
 ACTUAL LENGTHS ARE MEASURED ALONG CENTERLINE BAR TO THE NEAREST INCH.  
 MINIMUM CLEARANCE TO REINFORCING SHALL BE 1".  
 ALL REINFORCEMENT SHALL BE GRADE 60.  
 THE TWO D1 BARS MAY BE FURNISHED AS ONE BAR AT THE FABRICATOR'S OPTION.

Note: Strand release for 6,000 psi concrete = 4500 psi.

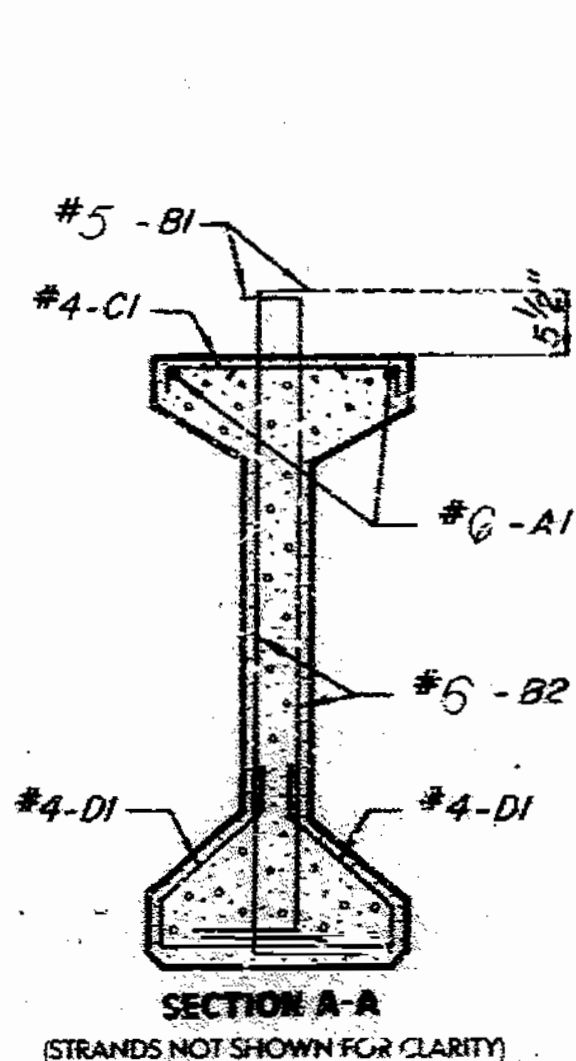


SECTION A-A  
(STRANDS NOT SHOWN FOR CLARITY)

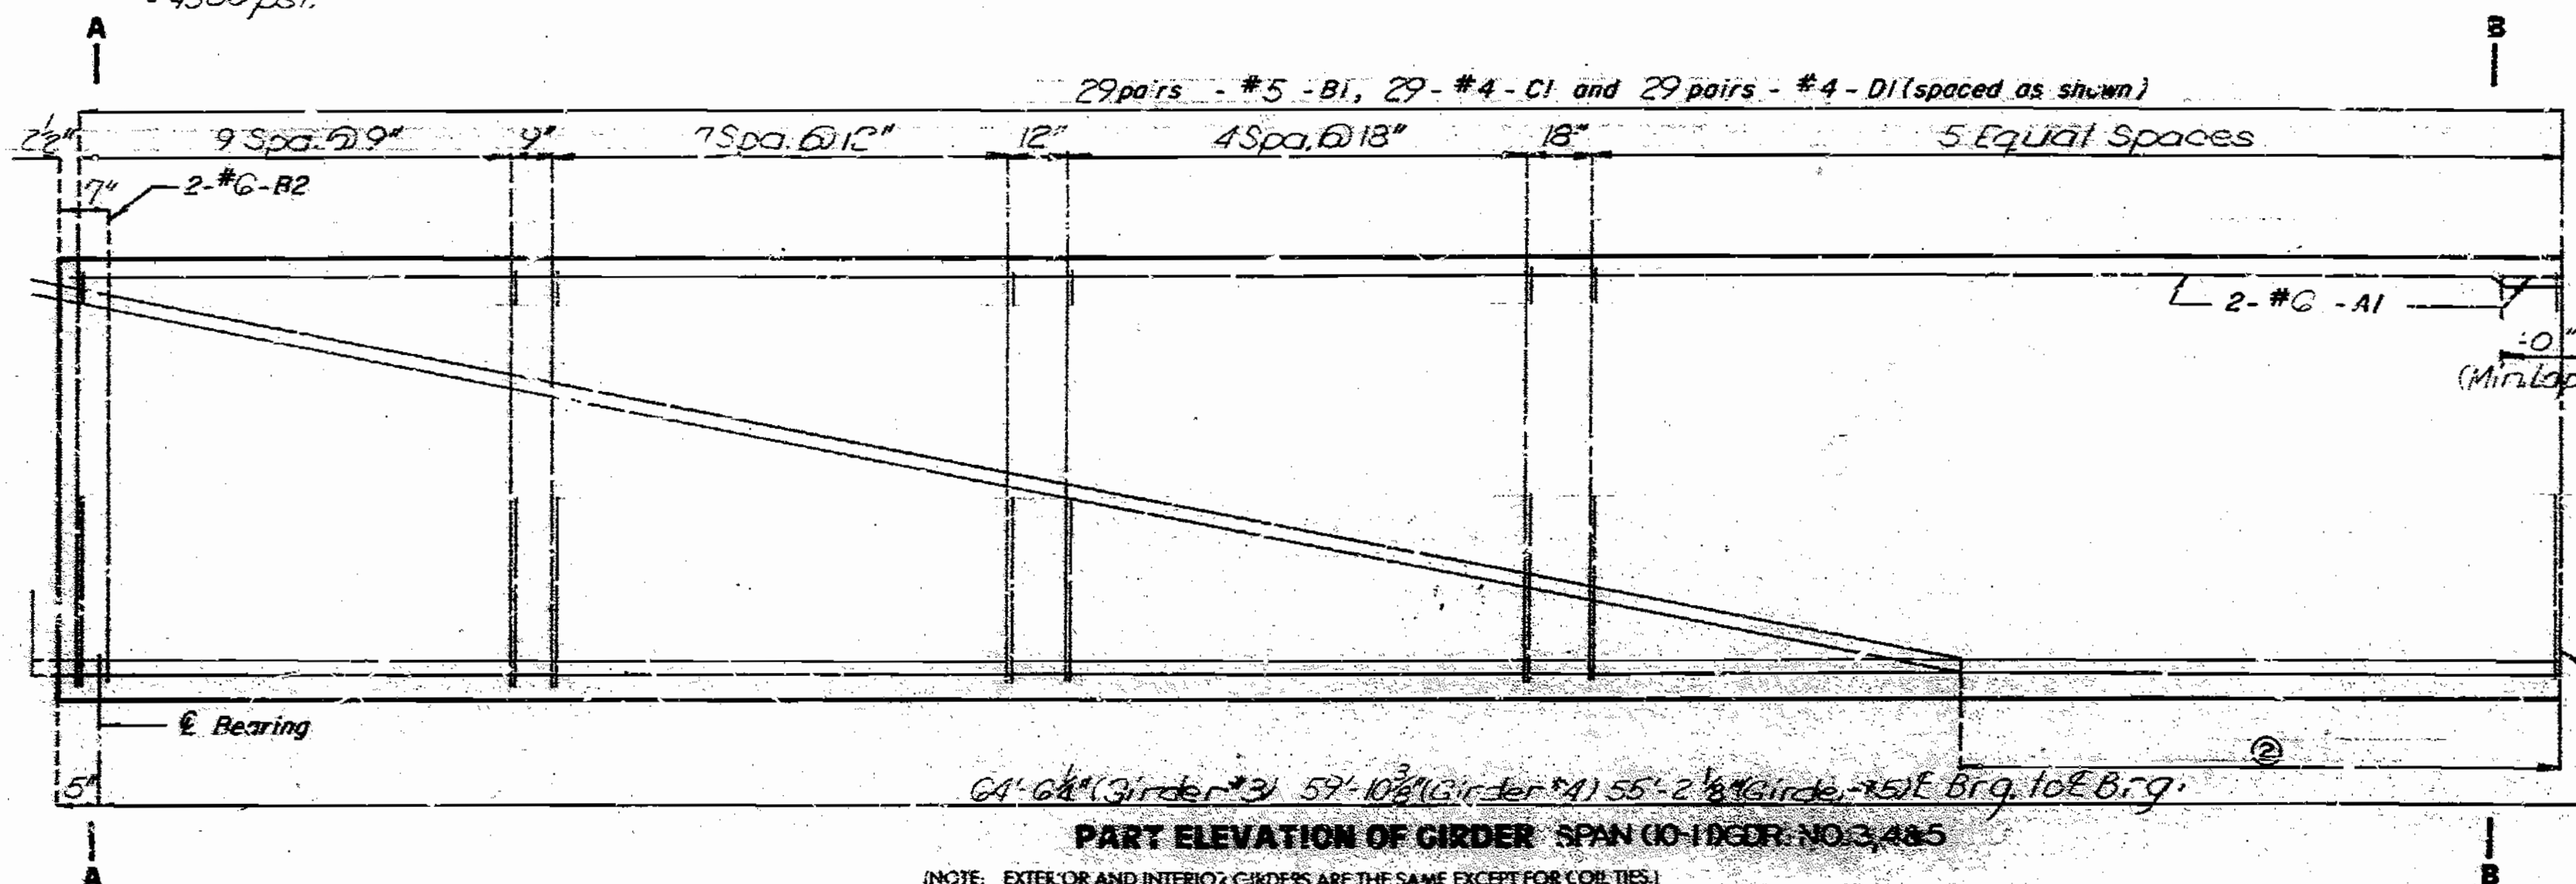

PART ELEVATION OF GIRDER SPAN 10'-10" TO 48'-5"

(NOTE: EXTERIOR AND INTERIOR GIRDERS ARE THE SAME EXCEPT FOR COIL TIES)

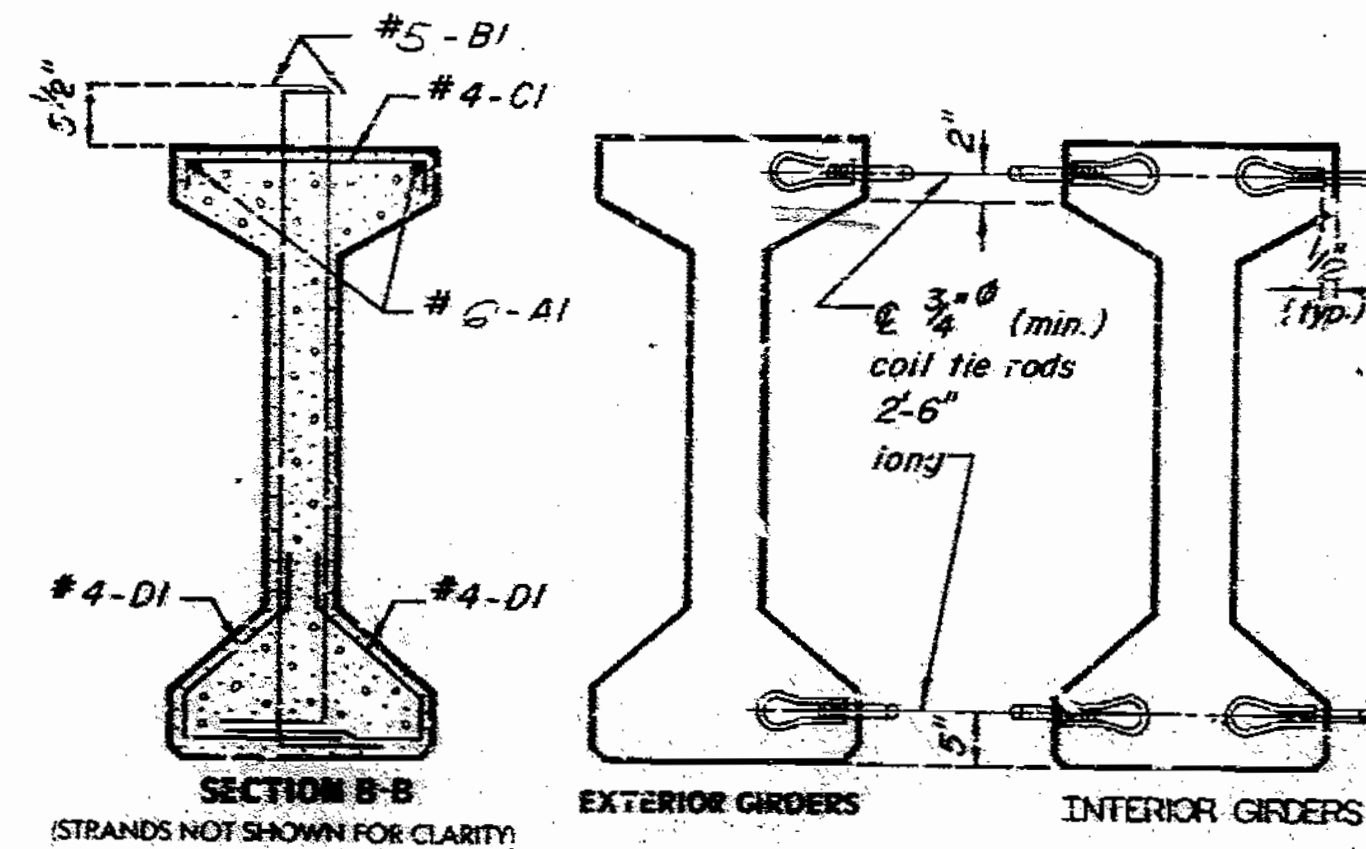


SECTION B-B  
(STRANDS NOT SHOWN FOR CLARITY)

DETAILS OF COIL TIES

NOTE:  
 COST OF 3/4" COIL TIE RODS PLACED IN DIAPHRAGMS IS INCLUDED IN CONTRACT UNIT PRICE FOR PRESTRESSED CONCRETE MEMBERS.  
 COIL TIES SHALL BE HELD IN PLACE IN THE FORMS BY SLOTTED WIRE-SETTING STUDS PROJECTING THRU FORMS. STUDS ARE TO BE LEFT IN PLACE OR REPLACED WITH TEMPORARY PLUGS UNTIL GIRDERS ARE ERECTED AND THEN REPLACED BY COIL TIE RODS.

NOTE:  
 The 1 1/2" holes shall be cast in the web for steel intermediate diaphragms. Drilling is not allowed.

Note: For details of Int. Bt. Diapht. see sheet No. 64 & No. 65.  
 For location of Int. Diapht. and general girder placement, see sheet No. 25.  
 For Girder Camber and Touching see sheet No. 69

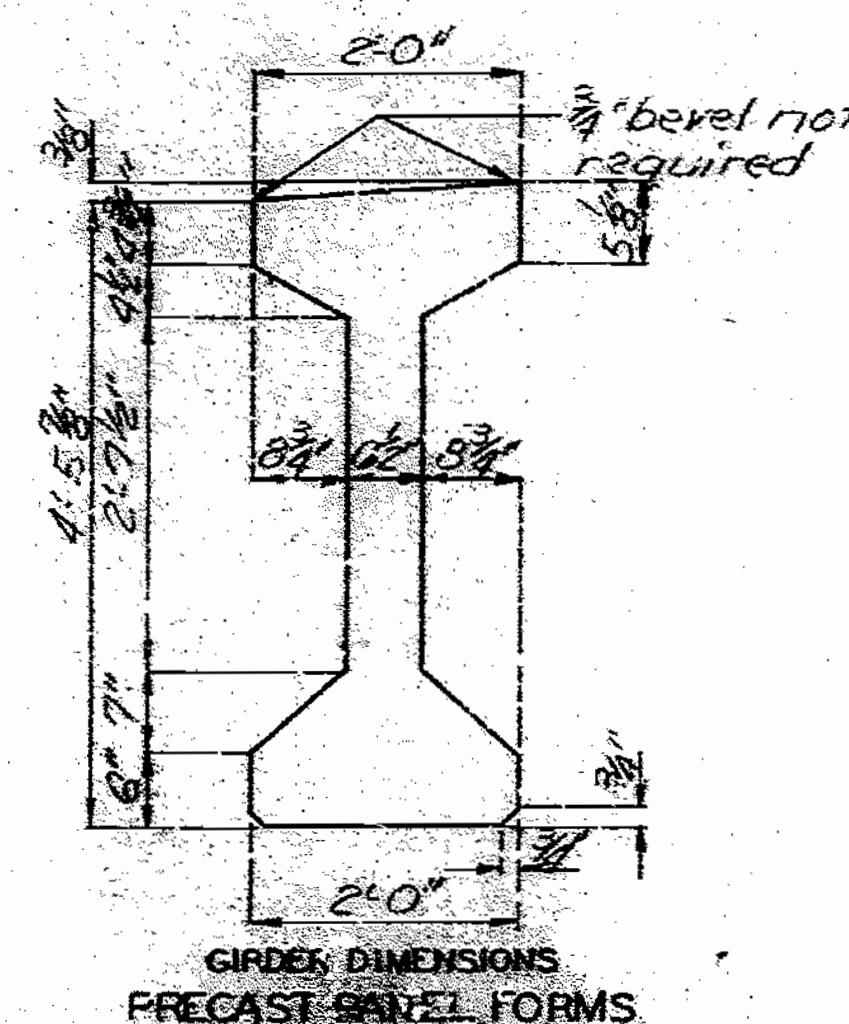

GIRDER DIMENSIONS  
PRECAST PANEL FORMS

- ① 33'-0" (Girder #3)
- 31'-2" (Girder #4)
- 28'-10" (Girder #5)
- ② 2'-6" (Girder #3)
- 2'-0" (Girder #4 & #5)

68133

SFS 55.6.6/2  
 FEB. 1974  
 REVISED  
 JUNE 1987

DETAILED MAR. 1988  
 CHECKED OCT. 1988

Note: This drawing is not to scale. Follow dimensions.

Sheet No. 38 of 98

JACKSON COUNTY

A-2745


NOTE:

CONCRETE FOR PRESTRESSING GIRDERS SHALL BE CLASS A1 WITH  $f_c = 6,000$  PSI.


(+) INDICATES PRESTRESSED STRAND.

USE 26 STRANDS WITH AN INITIAL PRESTRESS FORCE OF 806 KIPS.


PRESTRESSING TENDONS SHALL BE UNCOATED, SEVEN-WIRE, LOW RELAXATION STRANDS, 1/2 INCH DIAMETER CONFORMING TO A.A.S.H.T.O. M20.3, GRADE 270. SEE MO. STD. SPECIFICATIONS 705.4.B.

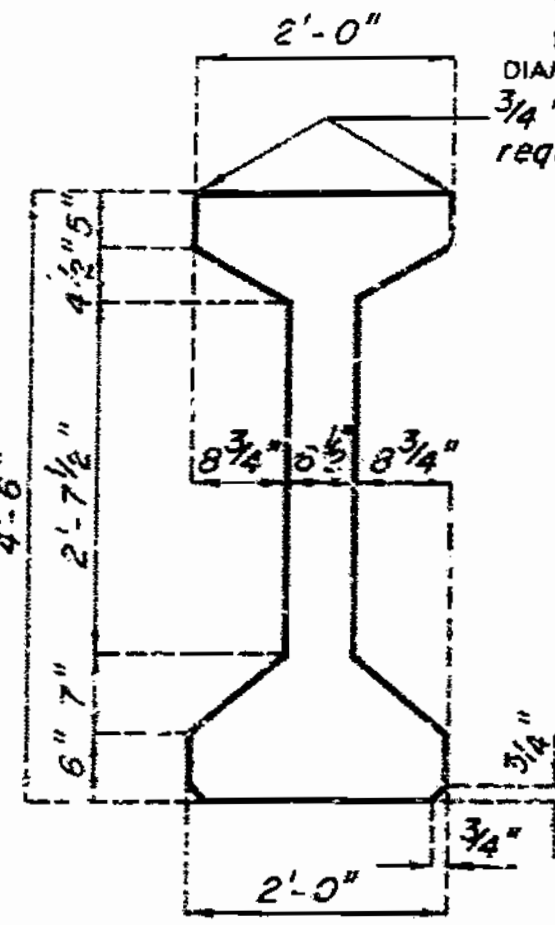

GIRDER DIMENSIONS: CAST-IN-PLACE FORMS

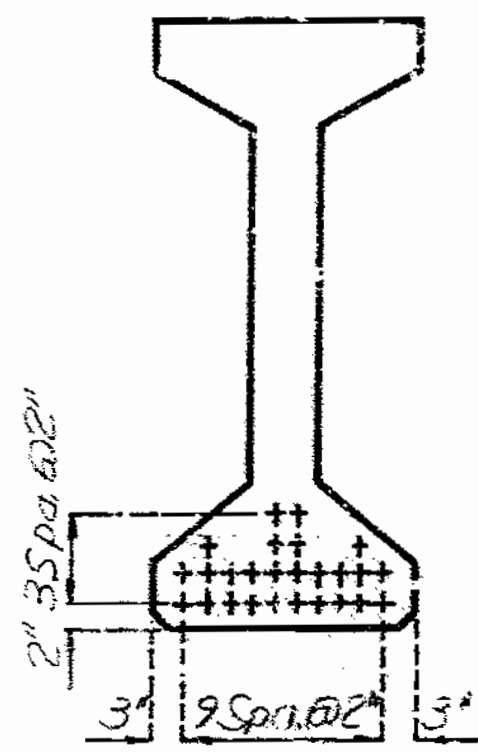


CL OF GIRDER STRAND ARRANGEMENTS

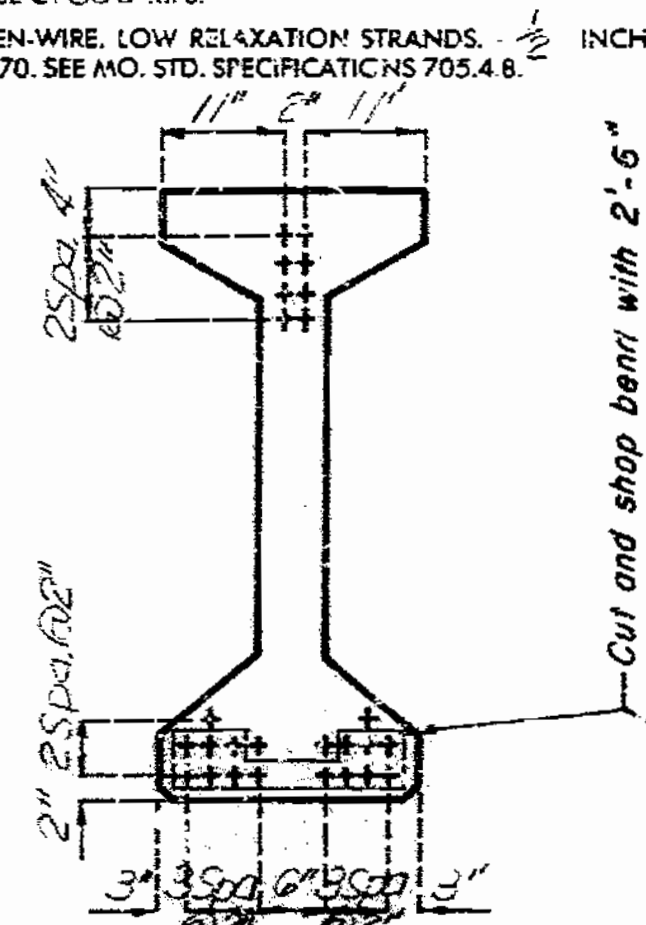


END OF GIRDER

1/2 INCH  
Cut and shop bent with 2'-6" projection. (Cut remaining bottom strands within 1' of end of girder.)

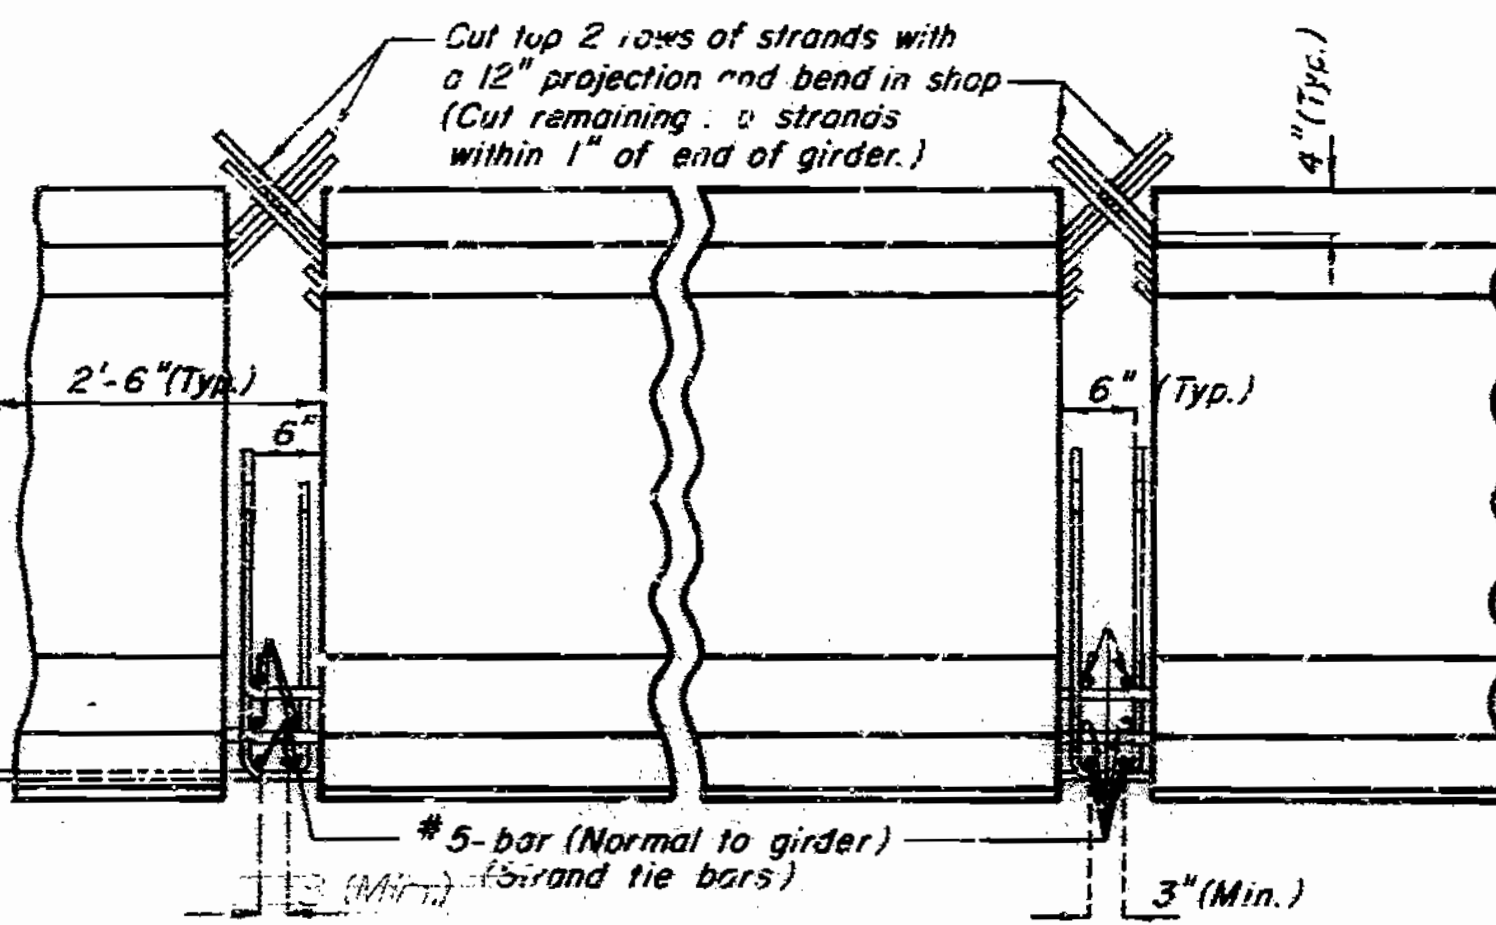

INTERMEDIATE NO. 11 STRAND DETAILS AT GIRDER ENDS INTERMEDIATE BENT NO. 12

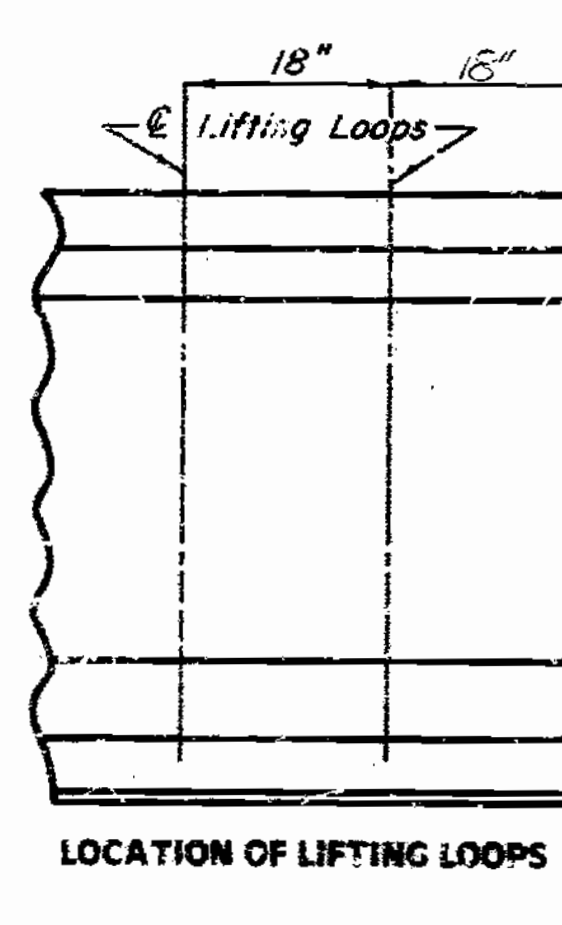


LOCATION OF LIFTING LOOPS

BILL OF REINFORCING STEEL - EACH GIRDER				BENDING DIAGRAMS	
NO.	SIZE & MARK	ACTUAL LENGTH	SHAPE		
4	6 A1	①	2G	SHAPE 10	
15B	5 B1	5'-11"	11	SHAPE 10	
8	6 B2	5'-4"	11	SHAPE 10	
7	4 C1	2'-2"	10	SHAPE 11	
15B	4 D1	3'-0"	9	SHAPE 11	

NOTE:


ALL DIMENSIONS IN BENDING DIAGRAM ARE OUT TO OUT.  
HOOKS AND BENDS SHALL BE IN ACCORDANCE WITH THE CRSI MANUAL OF STANDARD PRACTICE FOR DETAILING REINFORCED CONCRETE STRUCTURES STIRRUP AND TIE DIMENSIONS.  
ACTUAL LENGTHS ARE MEASURED ALONG CENTERLINE BAR TO THE NEAREST INCH.  
MINIMUM CLEARANCE TO REINFORCING SHALL BE 1".  
ALL REINFORCEMENT SHALL BE GRADE 60.  
THE TWO D1 BARS MAY BE FURNISHED AS ONE BAR AT THE FABRICATOR'S OPTION.

Note: Strand release for 9,000 psi concrete = 4500 psi.

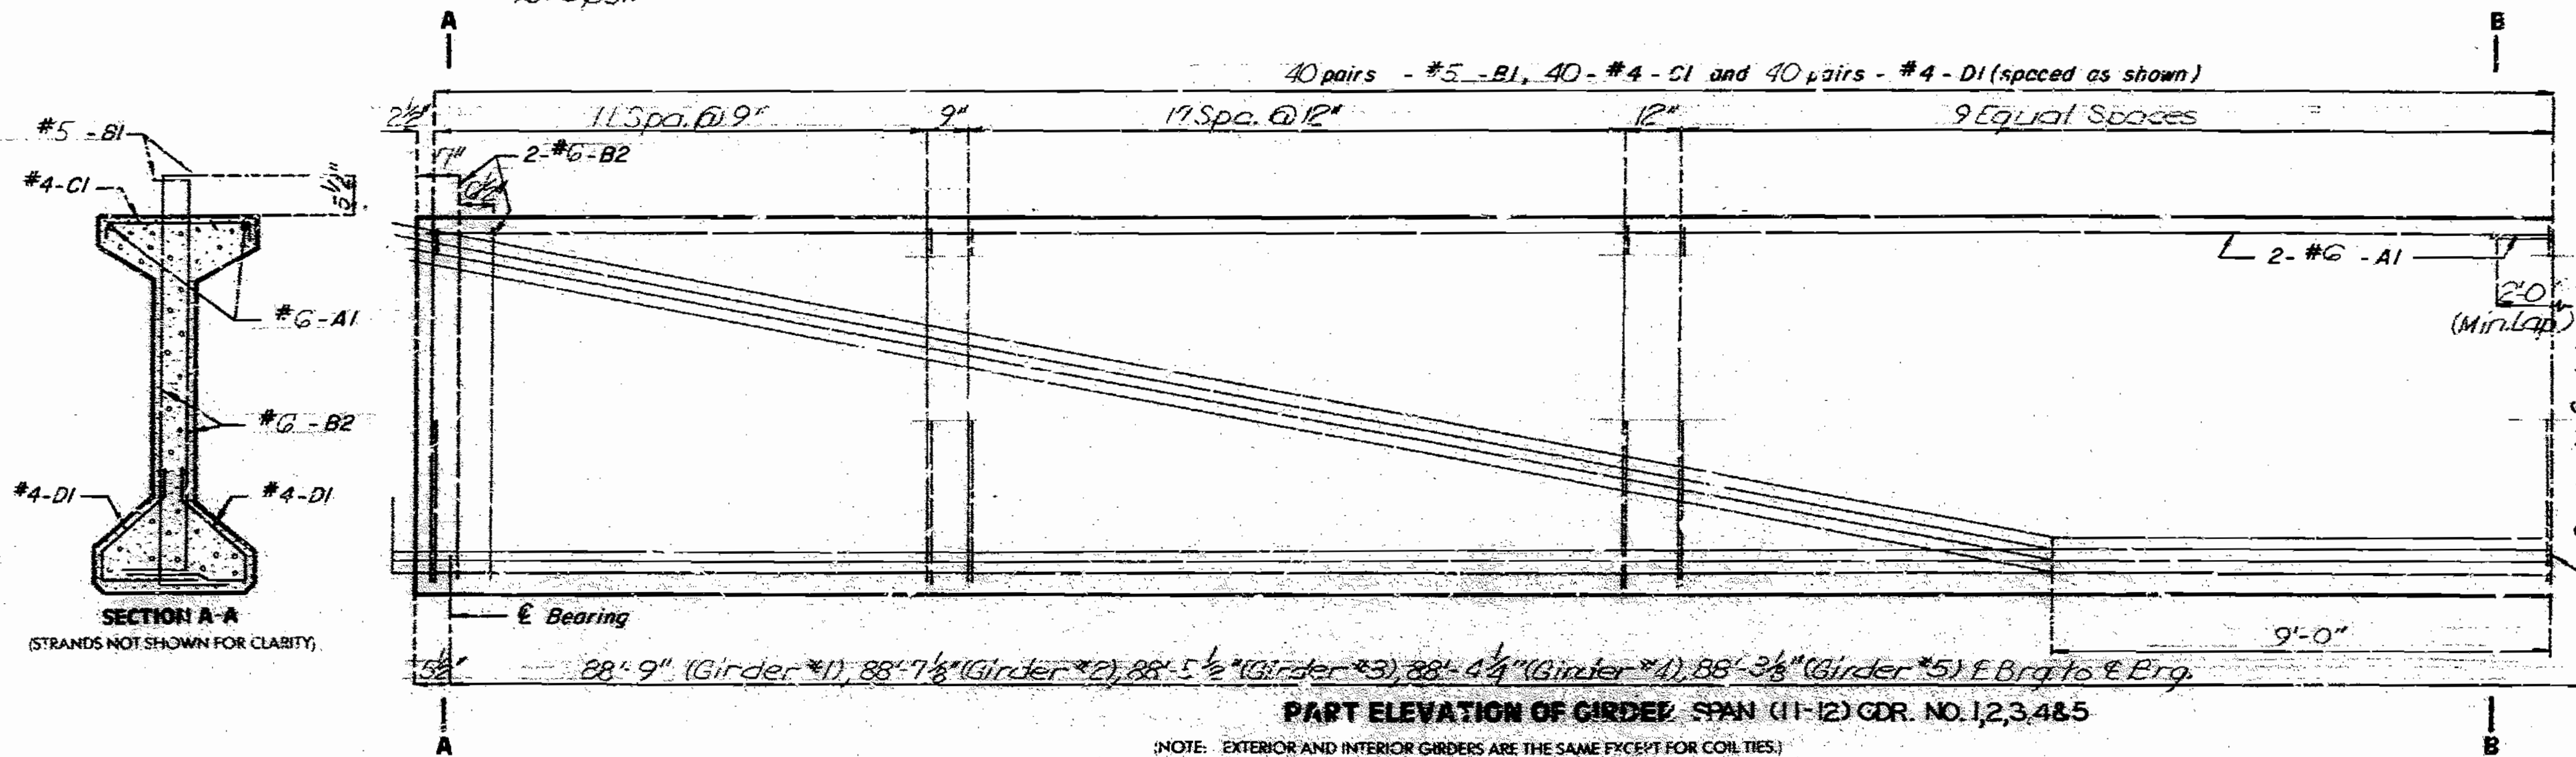


PART ELEVATION OF GIRDER, SPAN (11-12) GDR. NO. 1,2,3,4&5

(NOTE: EXTERIOR AND INTERIOR GIRDERS ARE THE SAME EXCEPT FOR COIL TIES.)

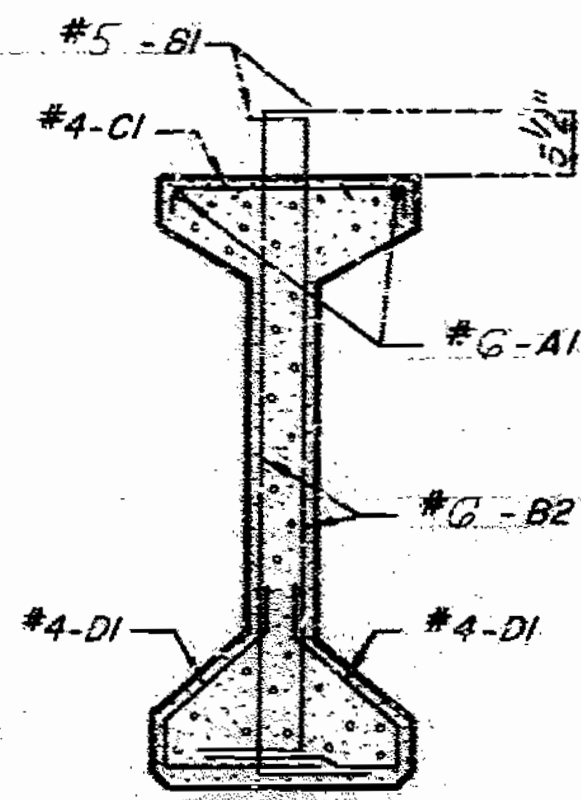

SECTION A-A (STRANDS NOT SHOWN FOR CLARITY)

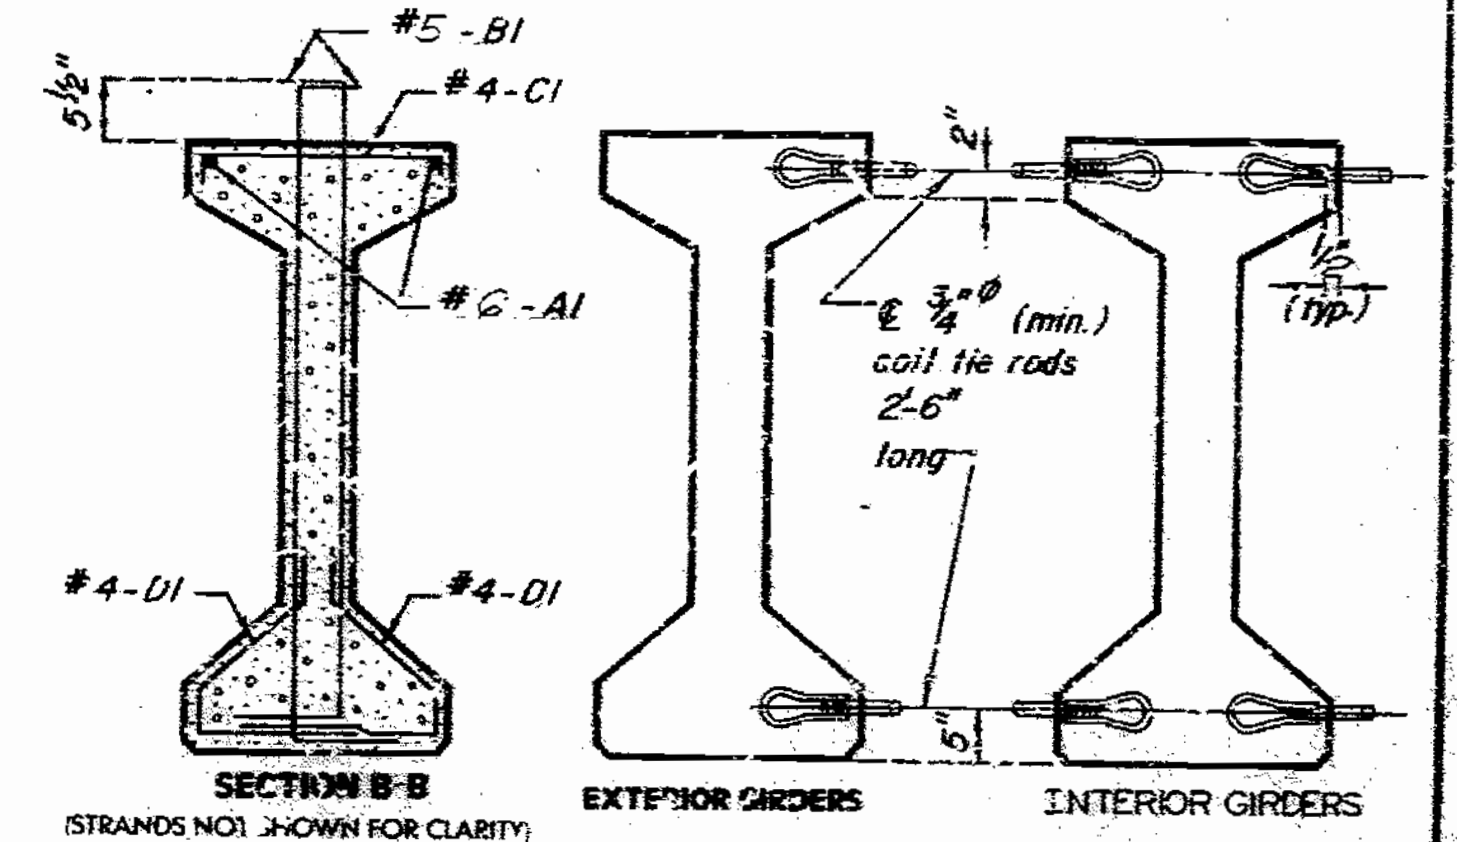

DETAILS OF COIL TIES


NOTE:

COST OF 3/4" COIL TIE RODS PLACED IN DIAPHRAGMS IS INCLUDED IN CONTRACT UNIT PRICE FOR PRESTRESSED CONCRETE MEMBERS.  
COIL TIES SHALL BE HELD IN PLACE IN THE FORMS BY SLOTTED WIRE-SETTING STUDS PROJECTING THRU FORMS. STUDS ARE TO BE LEFT IN PLACE OR REPLACED WITH TEMPORARY PLUGS UNTIL GIRDERS ARE ERECTED AND THEN REPLACED BY COIL TIE RODS.

NOTE:

The 1/2" holes shall be cast in the web for steel intermediate diaphragms. Drilling is not allowed.

Note: For details of Int. St. Diaph. see sheet No. 65.  
For location of Int. Diaph. and general girder placement, see sheet No. 25.  
For Girder Camber and haunching see sheet No. 69.

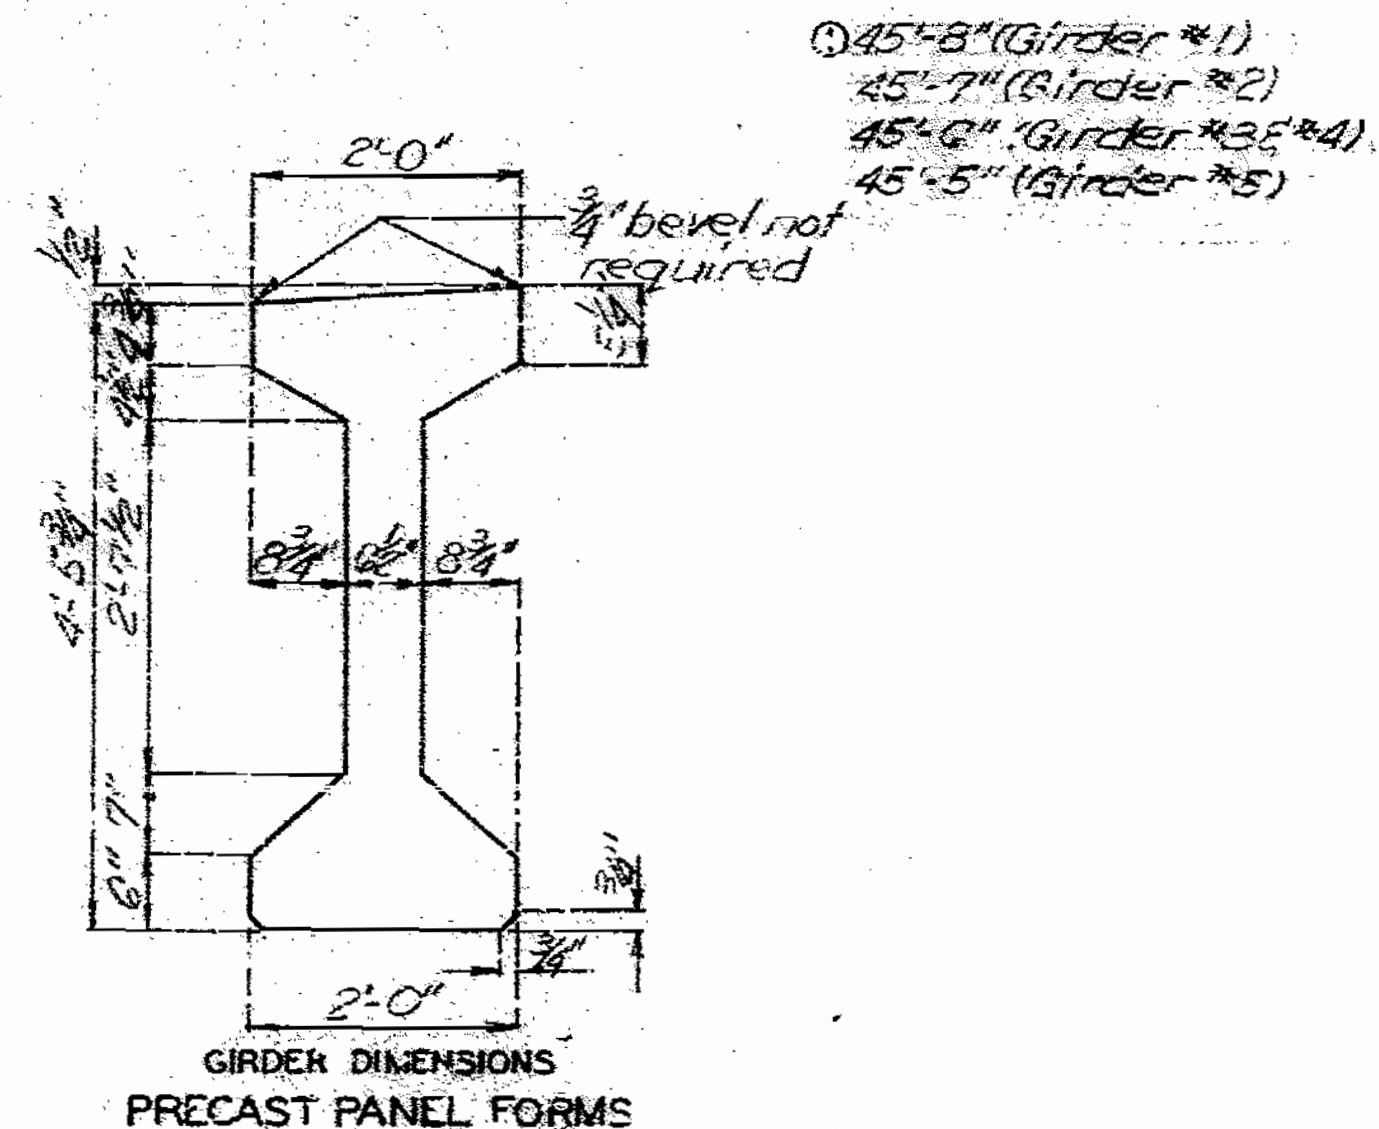

GIRDER DIMENSIONS PRECAST PANEL FORMS

164134

SPS 55.6.6 1/2  
FEB. 1974

REVISED  
JUNE 1987

DETAILED MAR. 1988  
CHECKED OCT. 1988

Note: This drawing is not to scale. Follow dimensions.


Sheet No. 39 of 93

JACKSON COUNTY


A-2745

NOTE:


CONCRETE FOR PRESTRESSED GIRDERS SHALL BE CLASS A1 WITH  $f_c = 6,000$  PSI.  
 (+) INDICATES PRESTRESSED STRAND.  
 USE 23 STRANDS WITH AN INITIAL PRESTRESS FORCE OF 808 KIPS.  
 PRESTRESSING TENDONS SHALL BE UNCOATED, SEVEN-WIRE, LOW RELAXATION STRANDS. 3/4" INCH DIAMETER CONFORMING TO A.A.S.H.T.O. M203, GRADE 270. SEE MO. STD. SPECIFICATIONS 705.4.8.

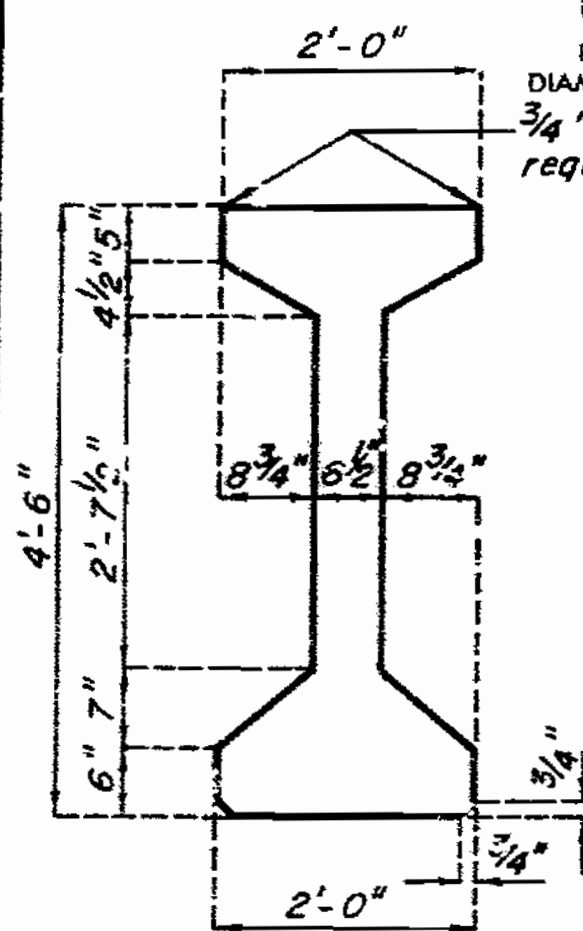


GIRDER DIMENSIONS  
CAST-IN-PLACE FORMS

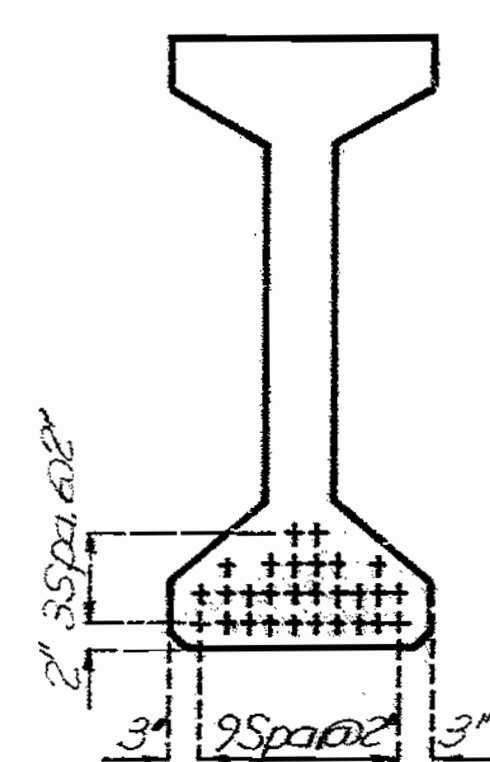


CL OF GIRDER  
STRAND ARRANGEMENTS

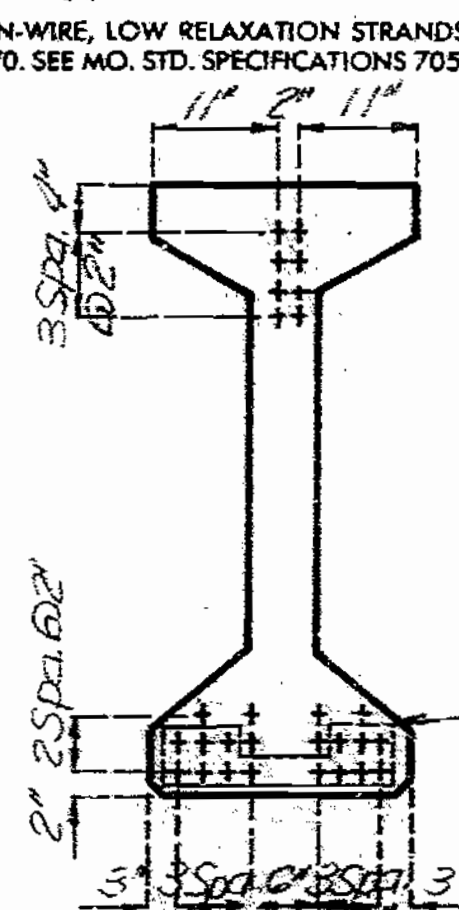

END OF GIRDER  
STRAND ARRANGEMENTS

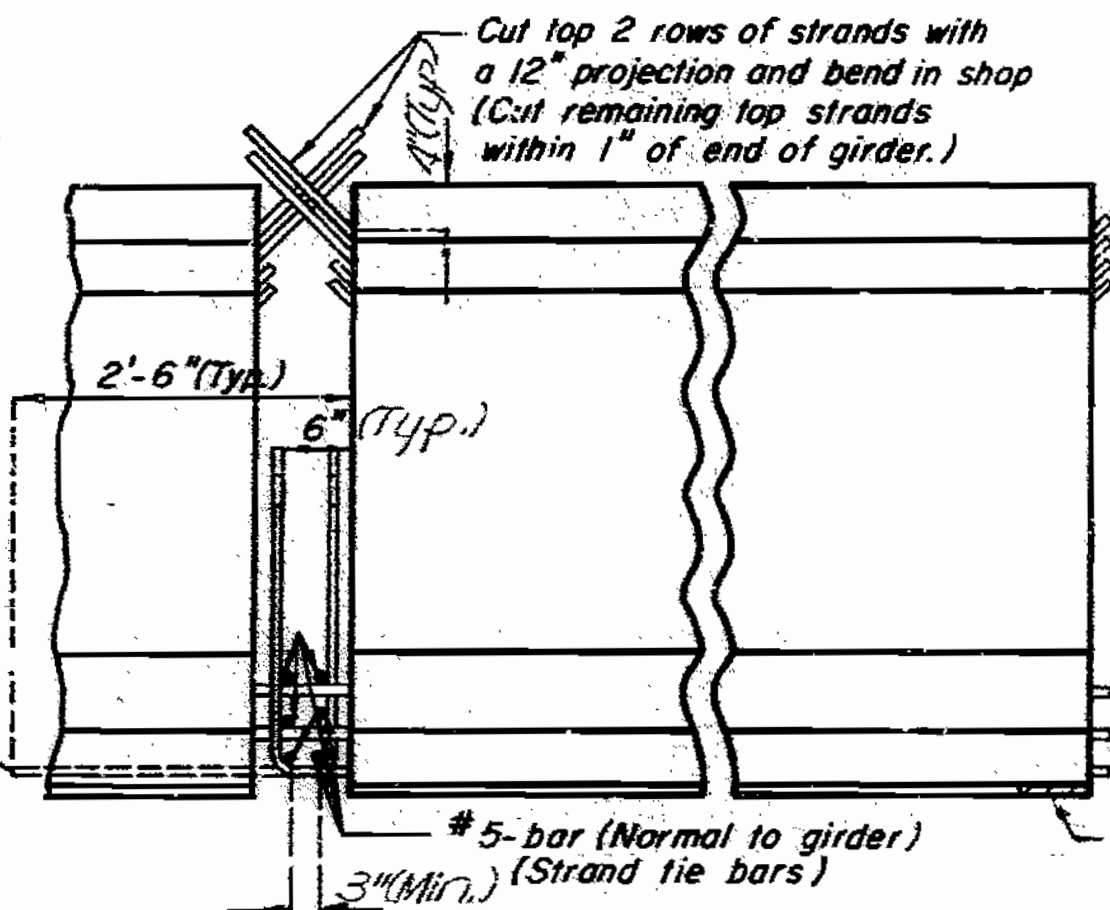

STRAND DETAILS AT GIRDER ENDS

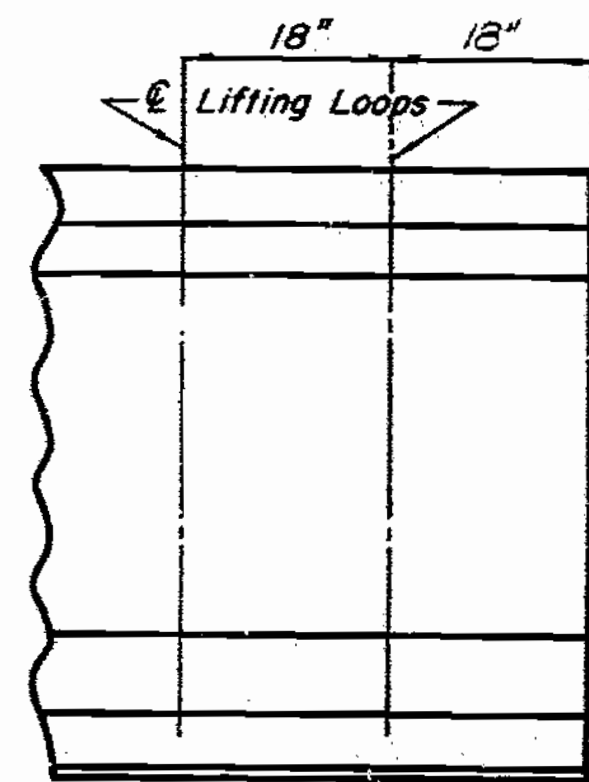


LOCATION OF LIFTING LOOPS

BILL OF REINFORCING STEEL - EACH GIRDER				BENDING DIAGRAMS	
NO.	SIZE & MARK	ACTUAL LENGTH	SHAPE		
4	G A1	①	20		
152	5 B1	5'-11"	11	SHAPE 10	
18	G B2	5'-4"	11	SHAPE 9	
79	4 C1	2'-2"	10	SHAPE 20	
158	4 D1	3'-0"	9	SHAPE 11	


NOTE:  
 ALL DIMENSIONS IN BENDING DIAGRAM ARE OUT TO OUT.  
 HOOKS AND BENDS SHALL BE IN ACCORDANCE WITH THE CRSI MANUAL OF STANDARD PRACTICE FOR DETAILING REINFORCED CONCRETE STRUCTURES STIRRUP AND TIE DIMENSIONS.  
 ACTUAL LENGTHS ARE MEASURED ALONG CENTERLINE BAR TO THE NEAREST INCH.  
 MINIMUM CLEARANCE TO REINFORCING SHALL BE 1".  
 ALL REINFORCEMENT SHALL BE GRADE 60.  
 THE TWO D1 BARS MAY BE FURNISHED AS ONE BAR AT THE FABRICATOR'S OPTION.

Note: Strand release for 4,000 psi concrete = 4,500 psi.

Note: Prestressing strands at Intermediate Bent No. 13 shall be trimmed to within 1/2 inch of concrete if exposed, or 1 inch of concrete if encased. Exposed ends of girders shall be given 2 coats of an asphalt paint. Ends of girders which will be encased in concrete diaphragms shall not be painted.  
 40 pairs - #5 - B1, 40 - #4 - C1 and 40 pairs - #4 - D1 (spaced as shown)

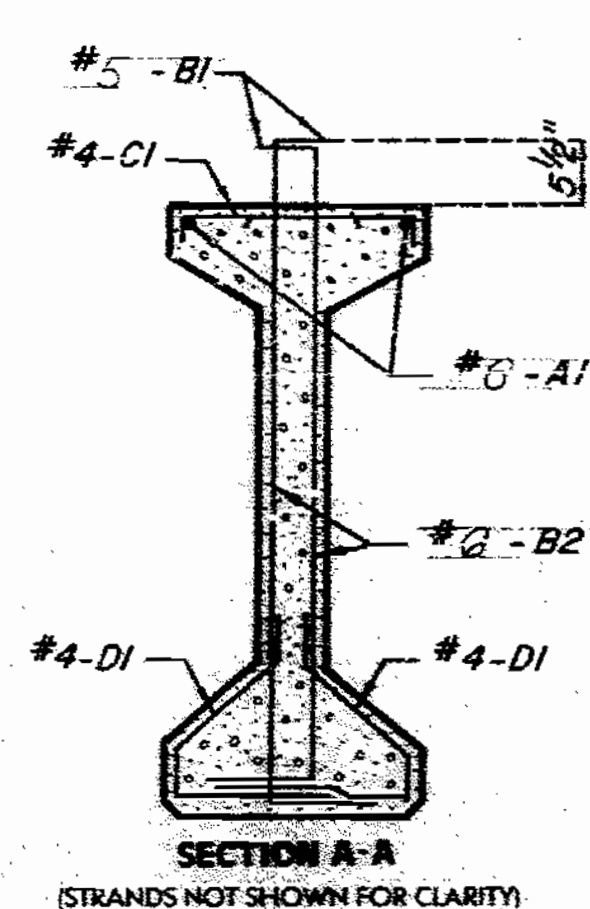


SECTION A-A  
STRANDS NOT SHOWN FOR CLARITY

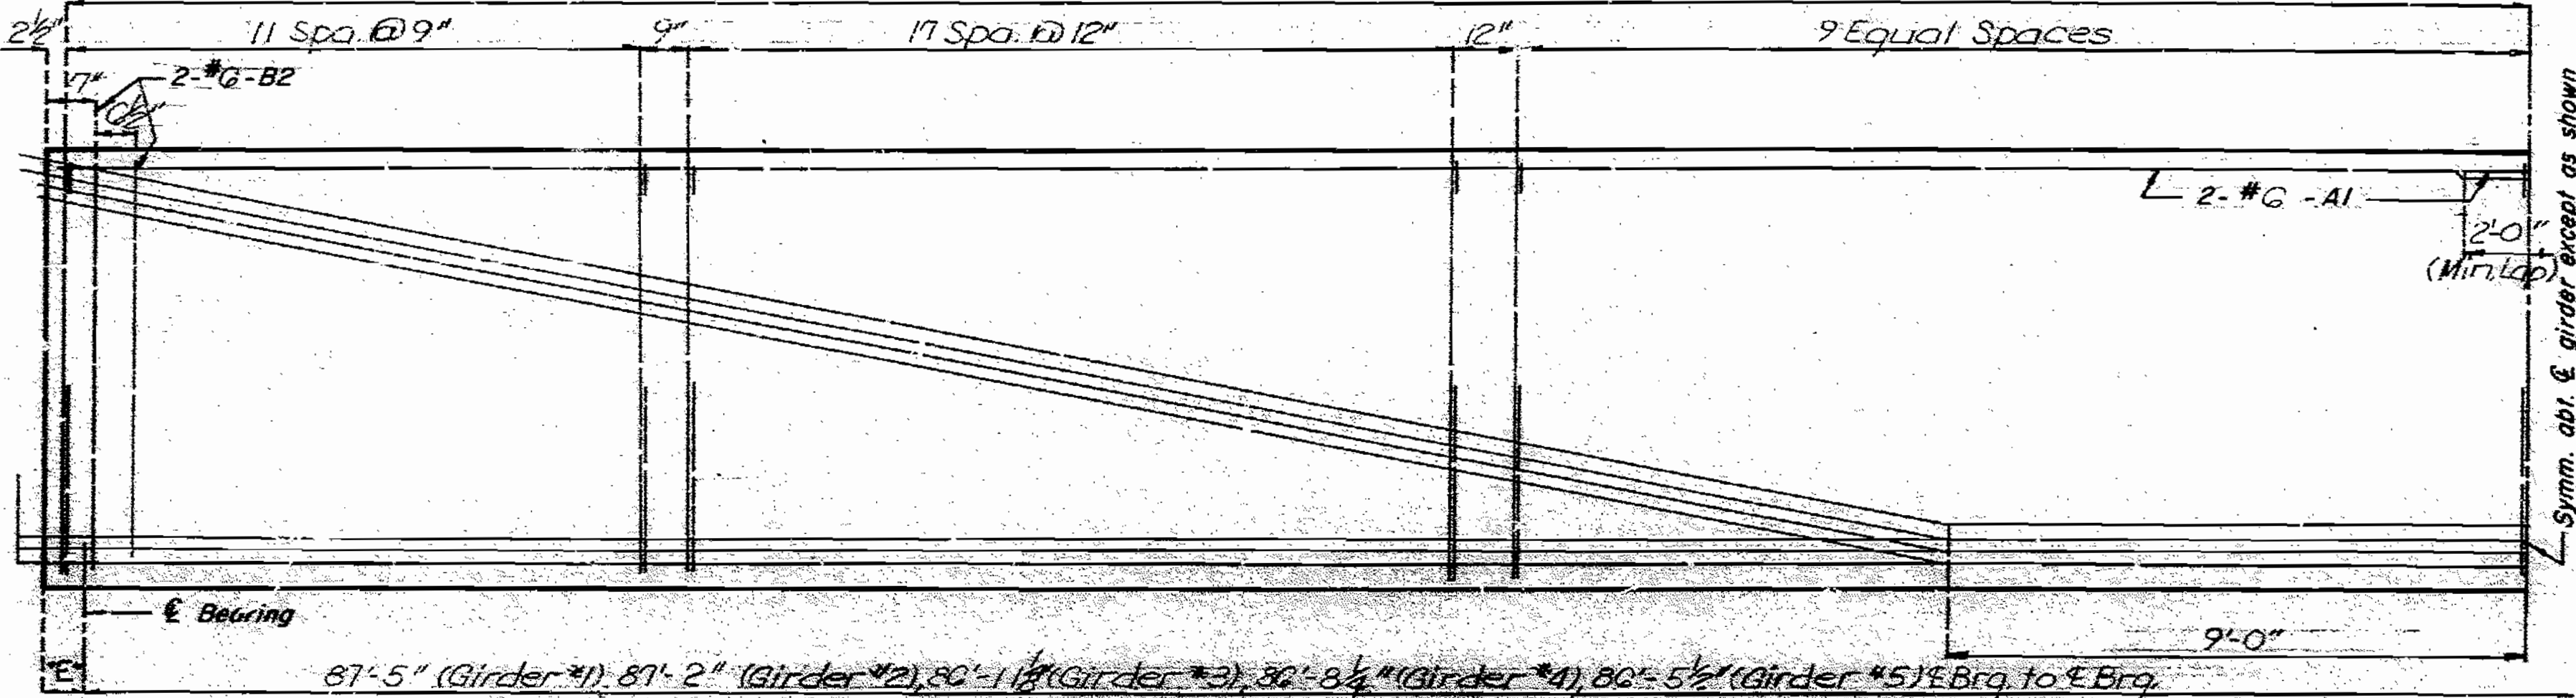


PART ELEVATION OF GIRDER SPAN (12-13)

NOTE: EXTERIOR AND INTERIOR GIRDERS ARE THE SAME EXCEPT FOR COIL TIES

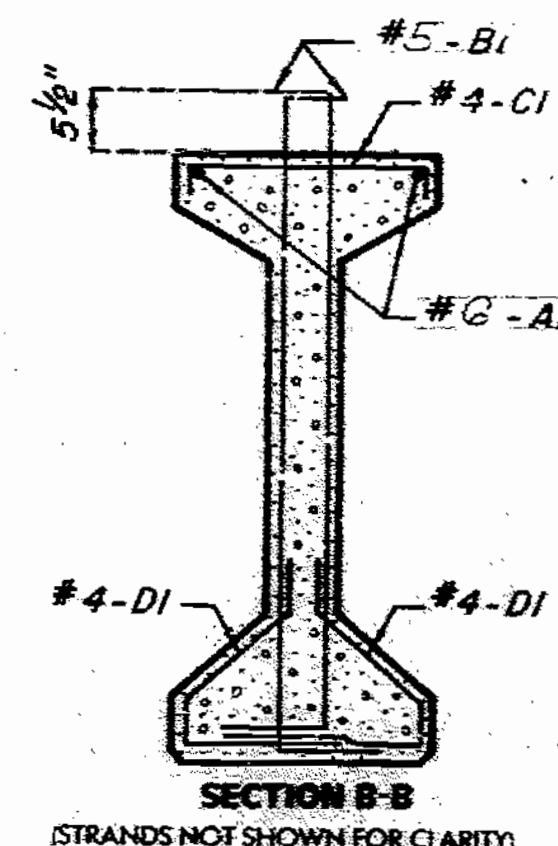


SECTION B-B  
STRANDS NOT SHOWN FOR CLARITY

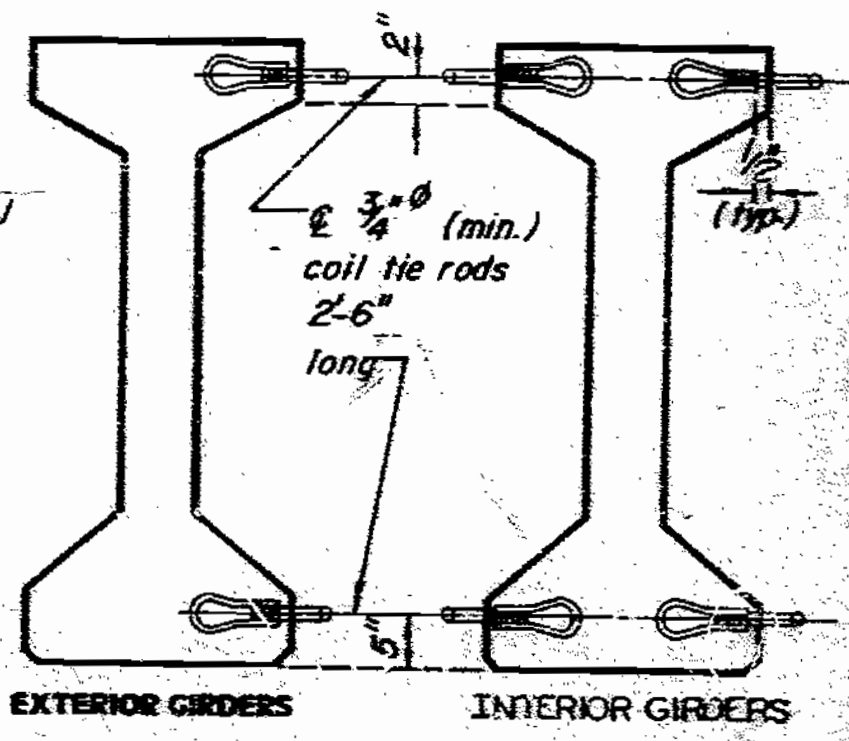

DETAILS OF COIL TIES  
AT INT. BENT NO. 12

NOTE:  
 COST OF 3/4" COIL TIE RODS PLACED IN DIAPHRAGMS IS INCLUDED IN CONTRACT UNIT PRICE FOR PRESTRESSED CONCRETE MEMBERS.  
 COIL TIES SHALL BE HELD IN PLACE IN THE FORMS BY SLOTTED WIRE-SETTING STUDS PROJECTING THRU FORMS. STUDS ARE TO BE LEFT IN PLACE OR REPLACED WITH TEMPORARY PLUGS UNTIL GIRDERS ARE ERECTED AND THEN REPLACED BY COIL TIE RODS.

NOTE:  
 The 1/2" holes shall be cast in the web for steel intermediate diaphragms. Drilling is not allowed.

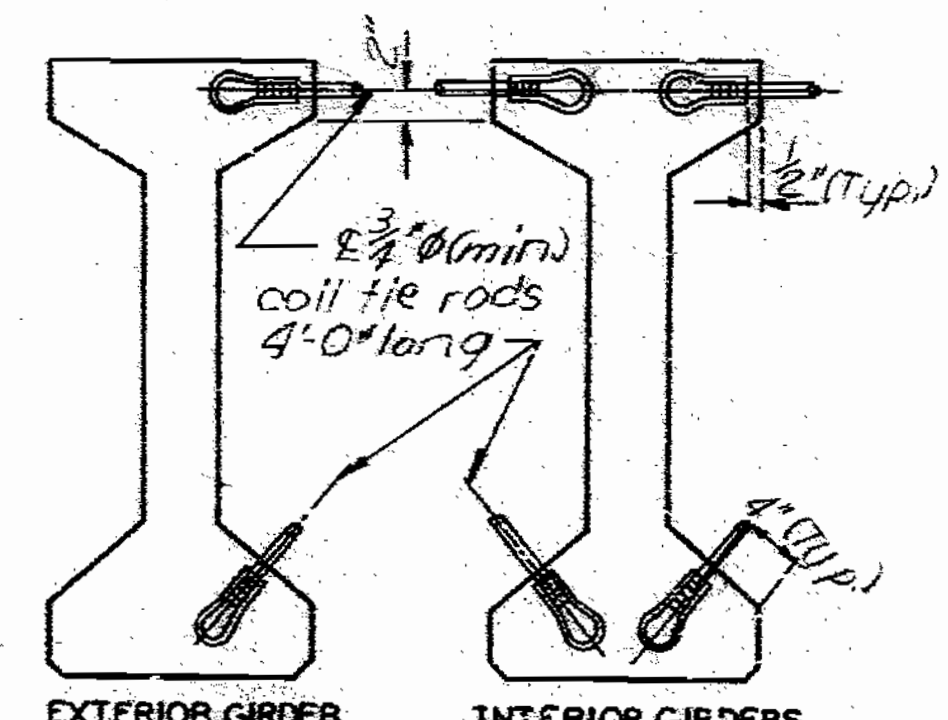


DETAILS OF COIL TIES  
AT INT. BENT NO. 13

Note: Cost of furnishing and installing 1/2" plates and welded studs in girders shall be included in price bid for Prestressed Concrete Girders per each. See Special Provisions for painting.


Note: For details of slotted wells to be cast in top of girder at Int. Bt. Bend only see sheet No. 65.  
 For details of Int. Bt. Diaph. see sheet No. 65 & No. 66.  
 For location of Int. Diaph. and general girder placement see sheet No. 26.  
 For Girder Camber and haunching see sheet No. 63.

\*E\* 5 1/2" All girders @ Bt. #12  
 = 7" All girders @ Bt. #13  
 ① 45'-2" (Girder #1)  
 45'-0" (Girder #2)  
 44'-11" (Girder #3)  
 44'-9" (Girder #4)  
 44'-8" (Girder #5)

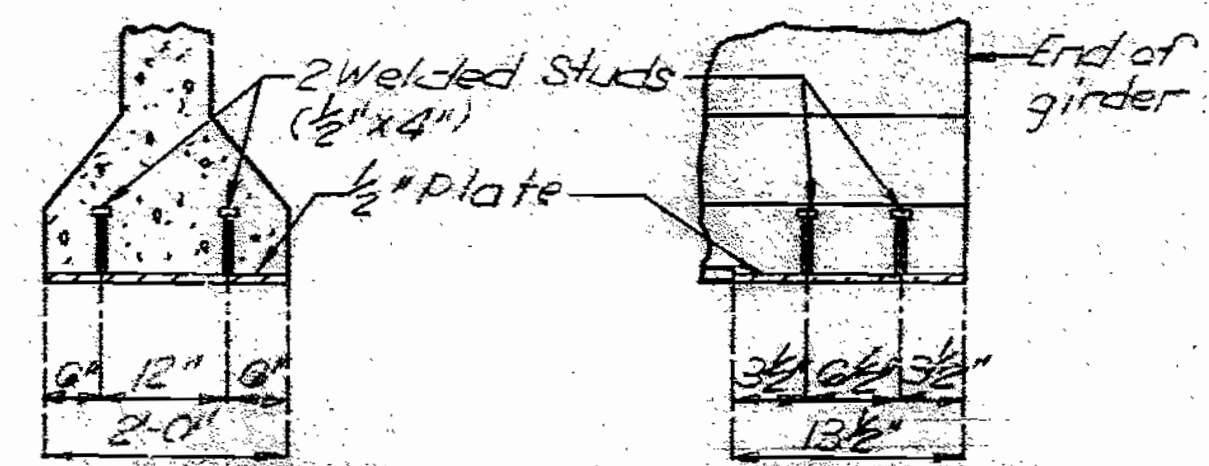

SECTION THRU GIRDER  
SOLE PLATE DETAILS AT BENT NO. 13

Note: Sole Plate to be placed at Bent No. 13 end of girder only.

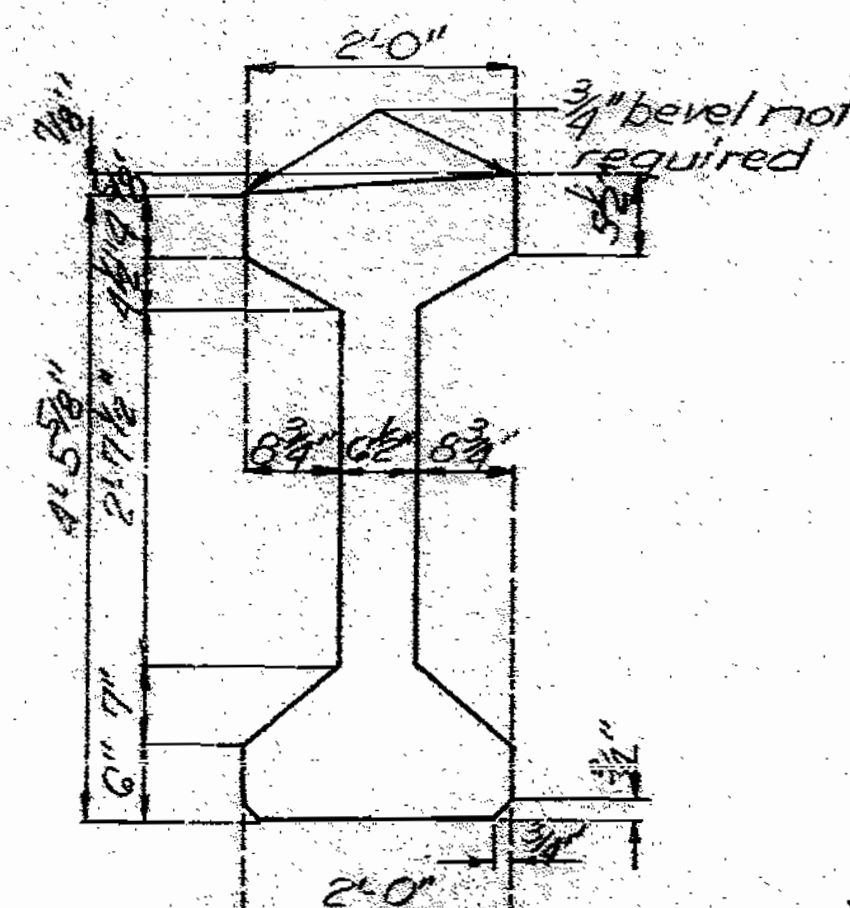

GIRDER DIMENSIONS  
PRECAST PANEL FORMS

135  
 168

SFS 65.6.6 1/2  
 FEB. 1974  
 REVISED  
 JUNE 1987



DETAILED MAR. 1988  
 CHECKED OCT. 1988

Note: This drawing is not to scale. Follow dimensions.

Sheet No. 40 of 98

STATE	PROJ NO	SHEET NO
MO		121



**NOTE:**  
 CONCRETE FOR PRESTRESSED GIRDERS SHALL BE CLASS A1 WITH  $f_c = 6,000$  PSI.  
 (-) INDICATES PRESTRESSED STRAND.  
 USE 6 STRANDS WITH AN INITIAL PRESTRESS FORCE OF 496 KIPS.  
 PRESTRESSING TENDONS SHALL BE UNCOATED, SEVEN-WIRE, LOW RELAXATION STRANDS, 1/2" INCH DIAMETER CONFORMING TO A.A.S.H.T.O. M203, GRADE 270. SEE MC. STD. SPECIFICATIONS 705.4.8.

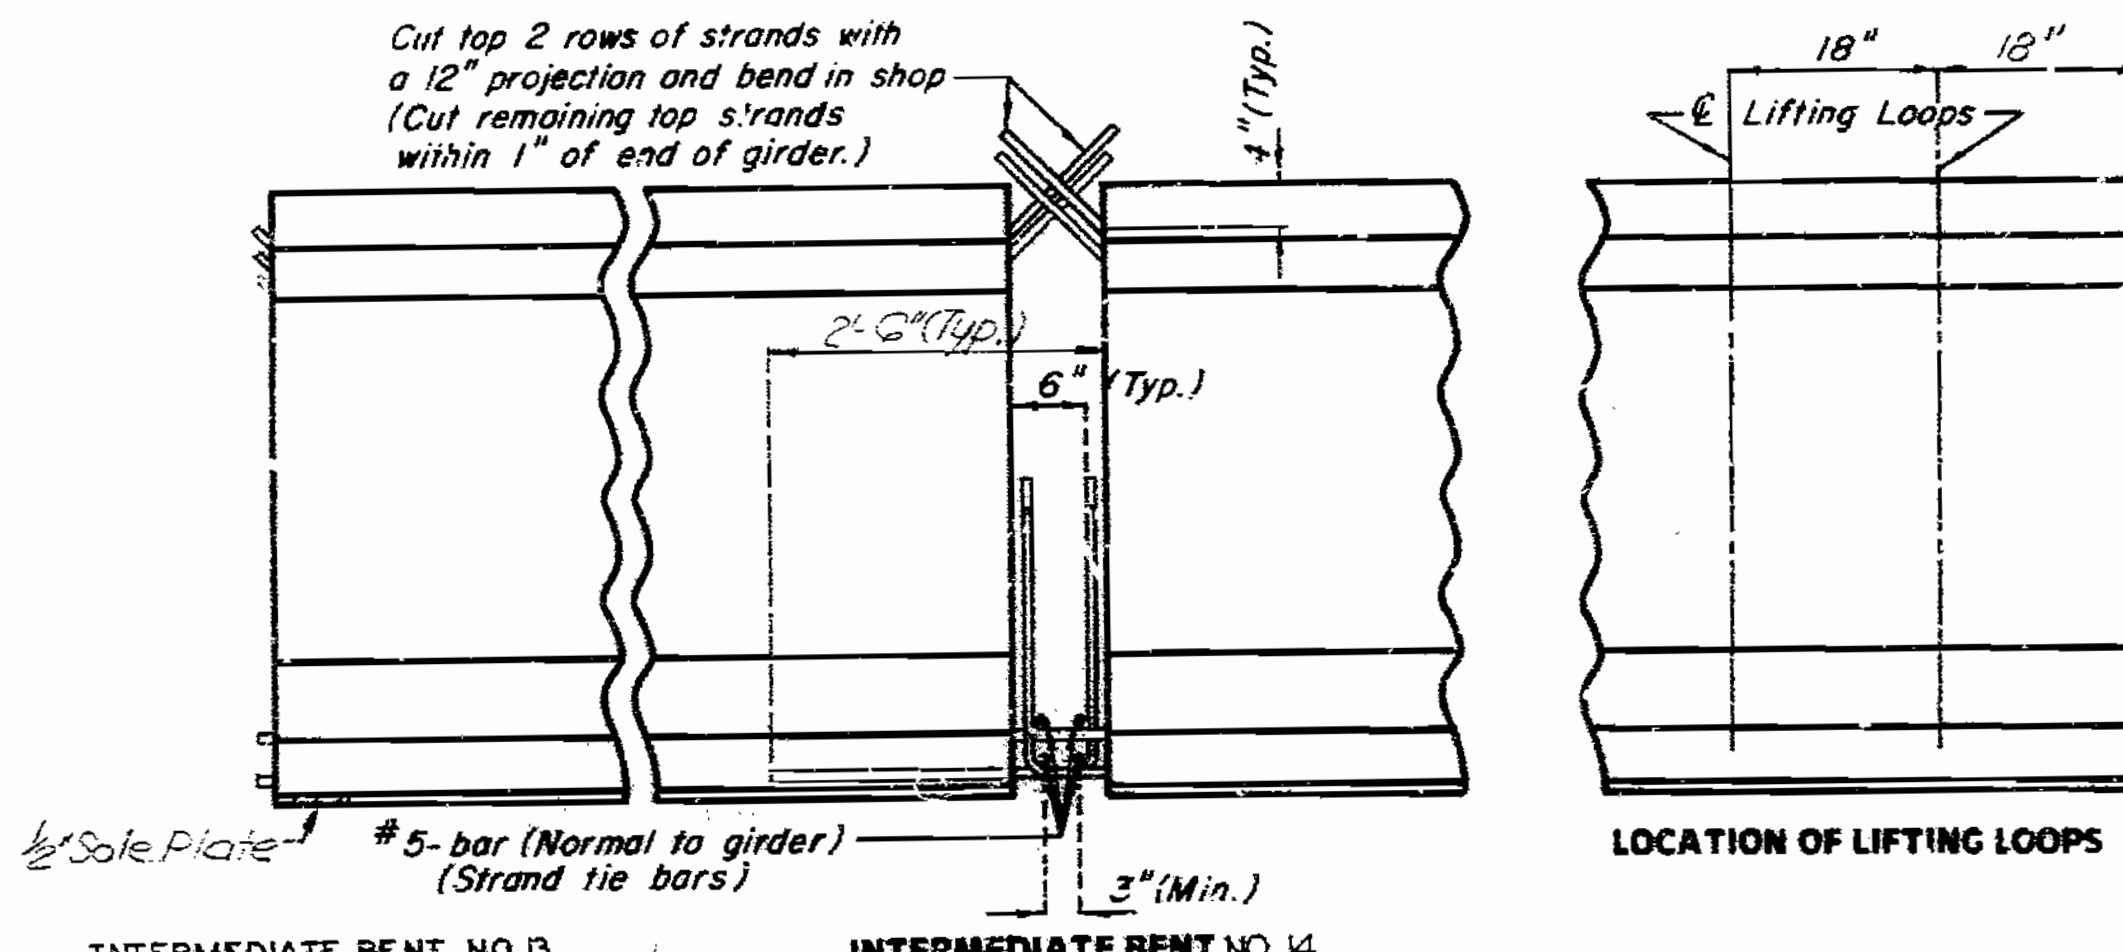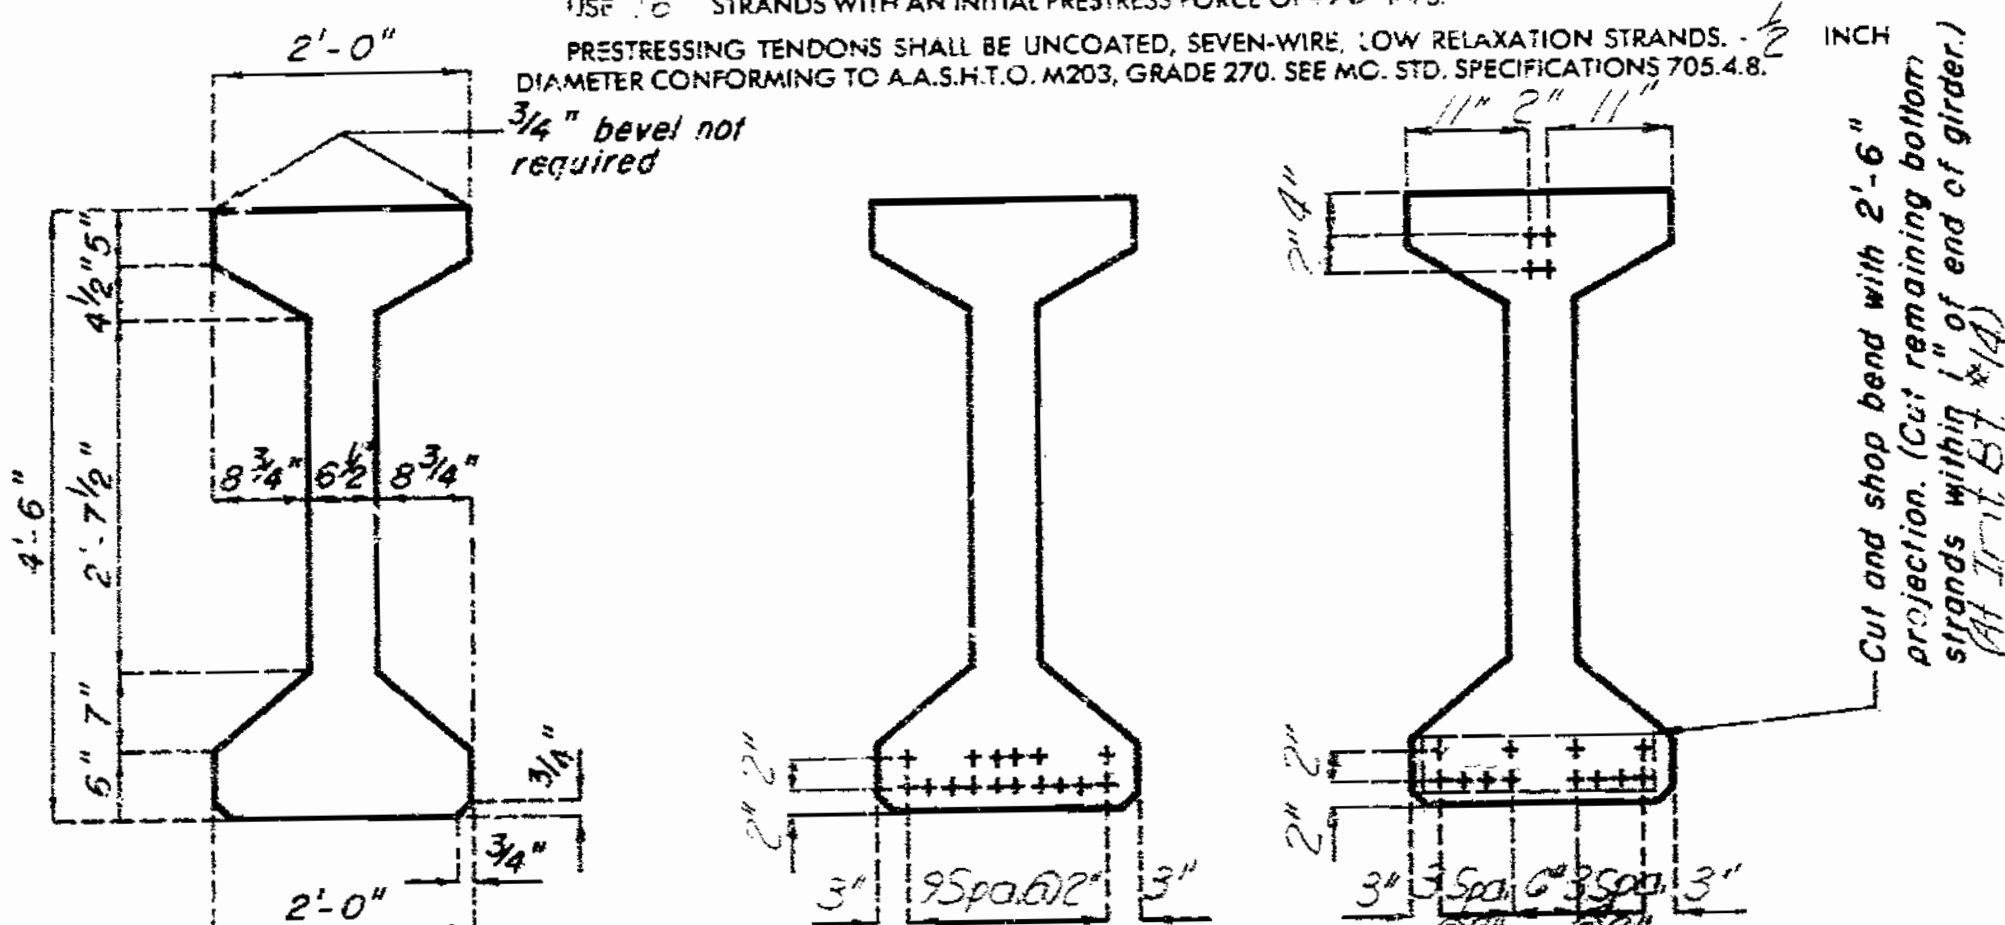

**BILL OF REINFORCING STEEL - EACH GIRDER**

NO.	SIZE & MARK	ACTUAL LENGTH	SHAPE	BENDING DIAGRAM
4	6 A1	35'-1"	20	SHAPE 10
122	5 B1	5'-11"	11	
6	5 B2	5'-4"	11	SHAPE 11
61	4 C1	2'-2"	10	
122	4 D1	3'-0"	9	



**NOTE:**  
 ALL DIMENSIONS IN BENDING DIAGRAM ARE OUT TO CUT.  
 HOOKS AND BENDS SHALL BE IN ACCORDANCE WITH THE CRSI MANUAL OF STANDARD PRACTICE FOR DETAILING REINFORCED CONCRETE STRUCTURES STIRRUP AND TIE DIMENSIONS.  
 ACTUAL LENGTHS ARE MEASURED ALONG CENTERLINE BAR TO THE NEAREST INCH.  
 MINIMUM CLEARANCE TO REINFORCING SHALL BE 1".  
 ALL REINFORCEMENT SHALL BE GRADE 60.  
 THE TWO D1 BARS MAY BE FURNISHED AS ONE BAR AT THE FABRICATOR'S OPTION.

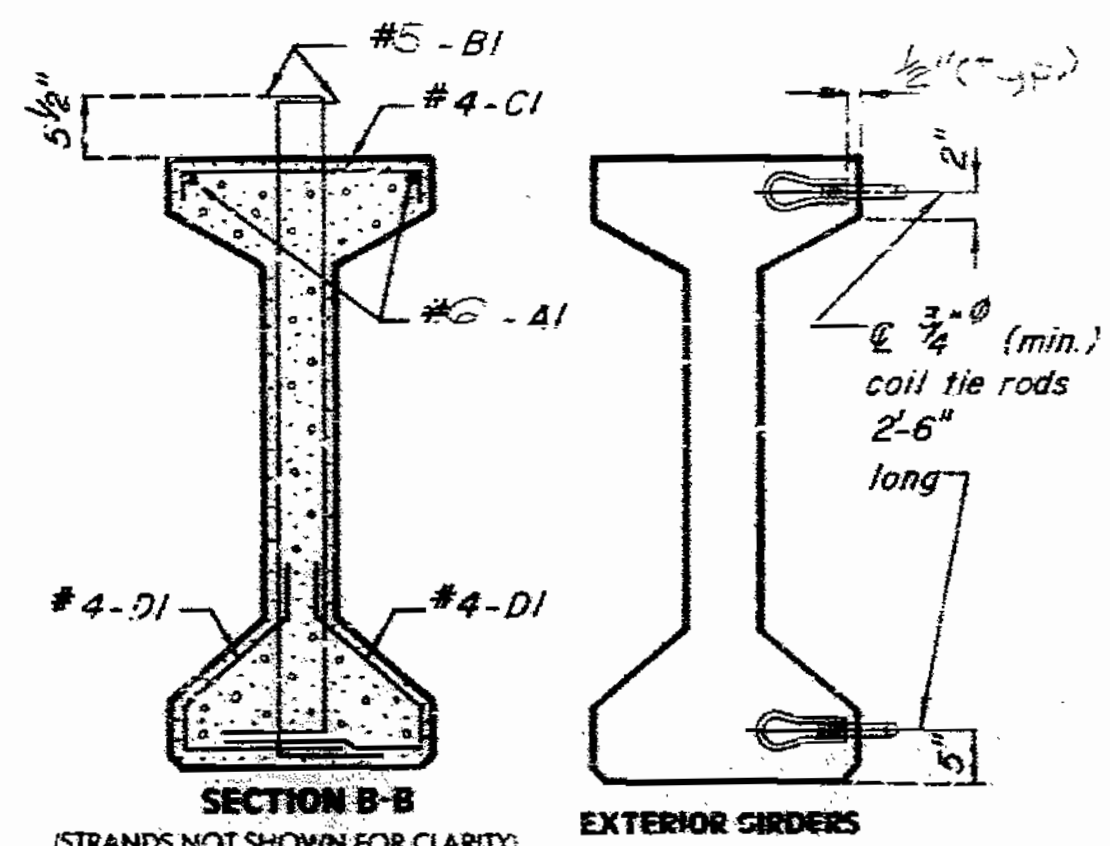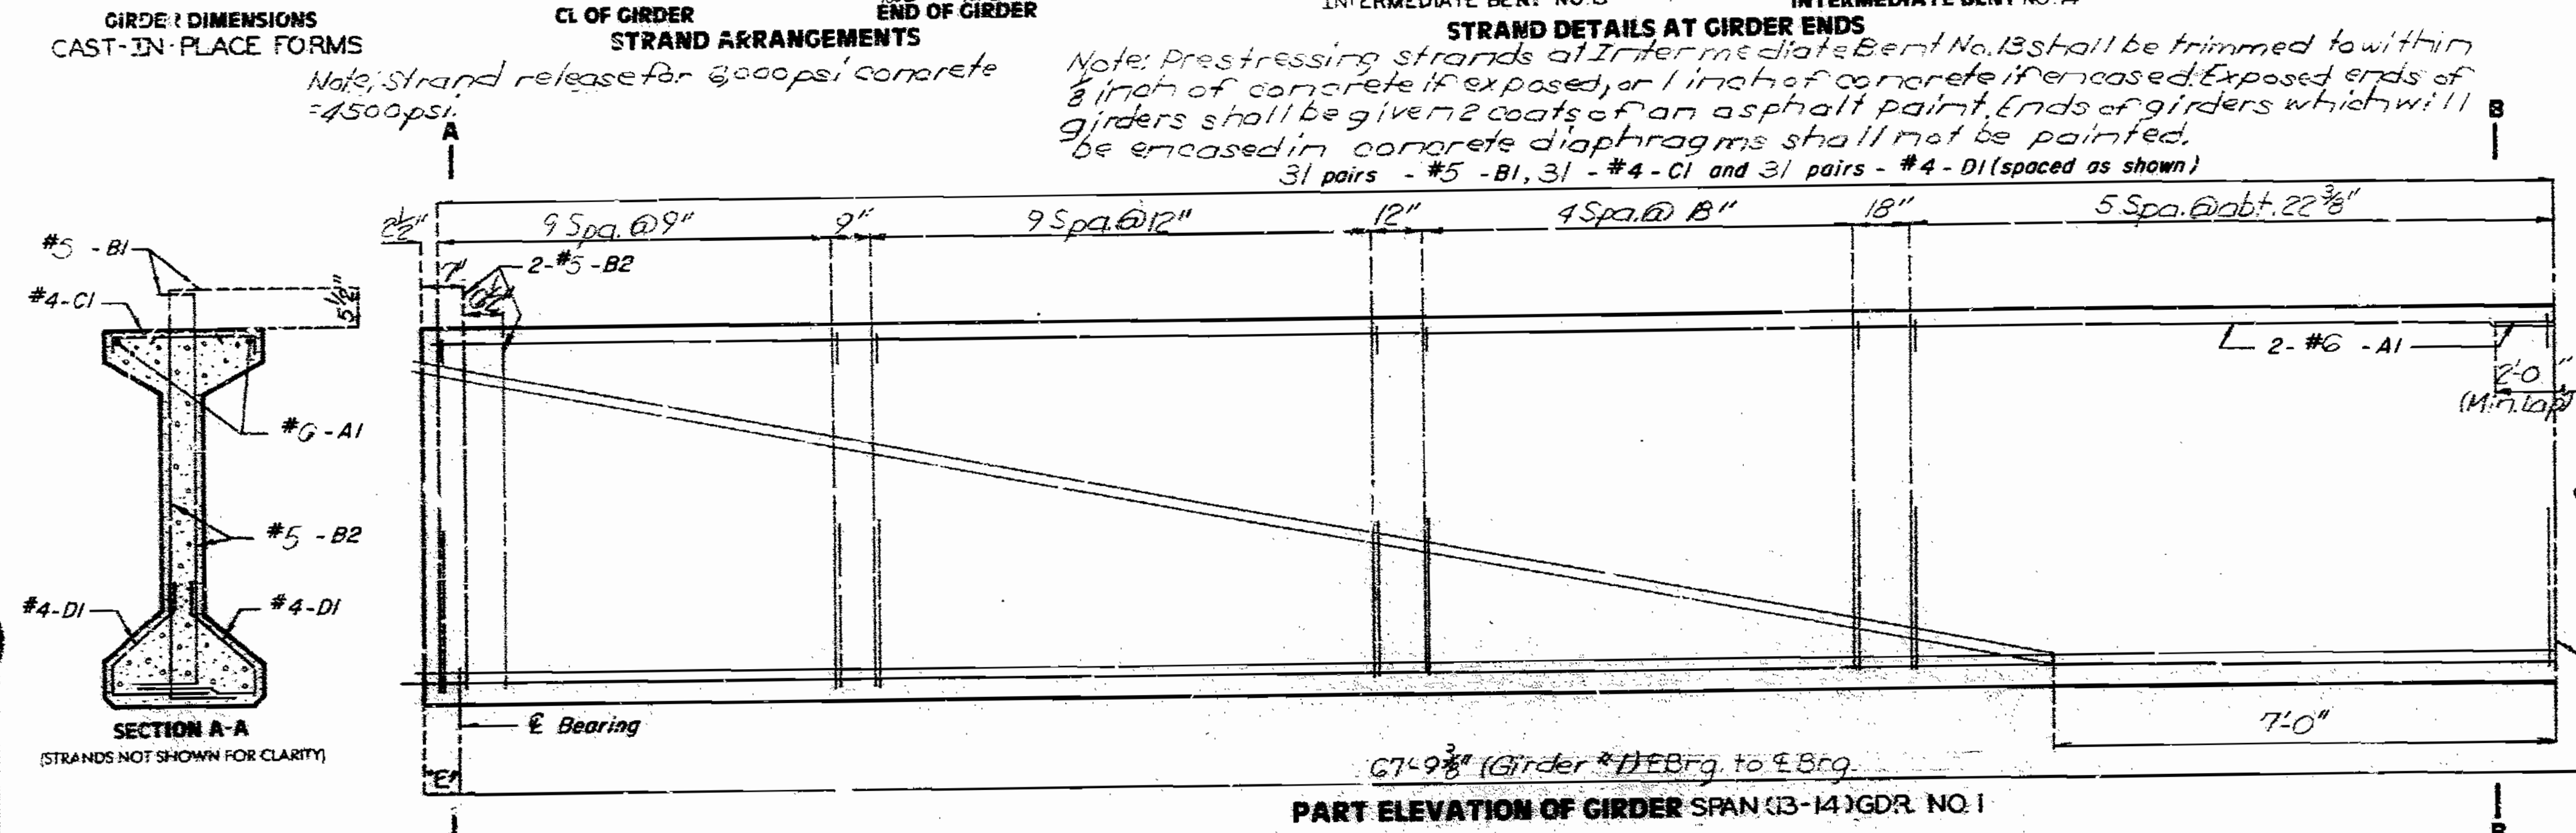


**DETAILS OF COIL TIES AT INT. BENT NO. 14**

**NOTE:**  
 COST OF 3/4" COIL TIE RODS PLACED IN DIAPHRAGMS IS INCLUDED IN CONTRACT UNIT PRICE FOR PRESTRESSED CONCRETE MEMBERS.  
 COIL TIES SHALL BE HELD IN PLACE IN THE FORMS BY SLOTTED WIRE-SETTING STUDS PROJECTING THRU FORMS. STUDS ARE TO BE LEFT IN PLACE OR REPLACED WITH TEMPORARY PLUGS UNTIL GIRDERS ARE ERECTED AND THEN REPLACED BY COIL TIE RODS.

**NOTE:**  
 The 1/2" holes shall be cast in the web for steel intermediate diaphragms. Drilling is not allowed.

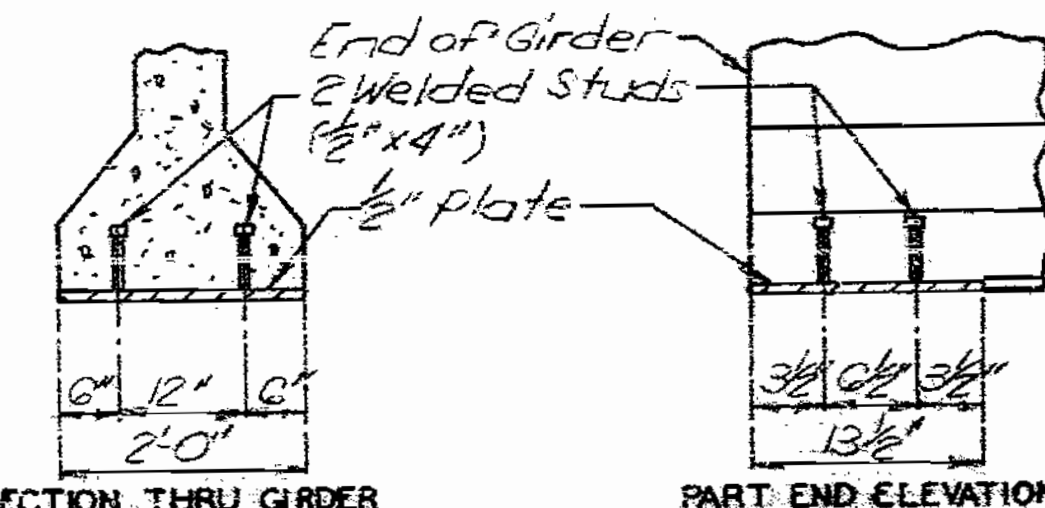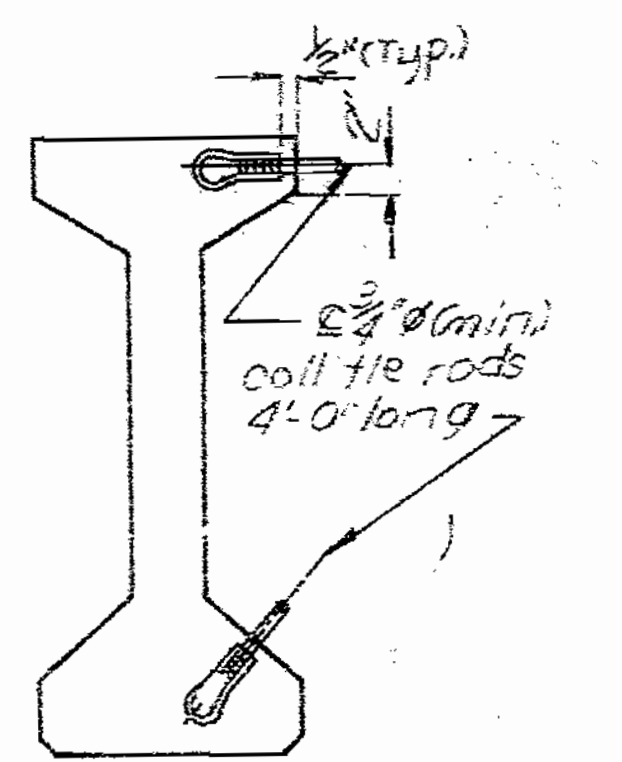

**SOLE PLATE DETAILS AT BENT NO. 13**  
 Note: Sole Plate to be placed at Bent No. 13 end of girder only.  
 Note: This drawing is not to scale. Follow dimensions.


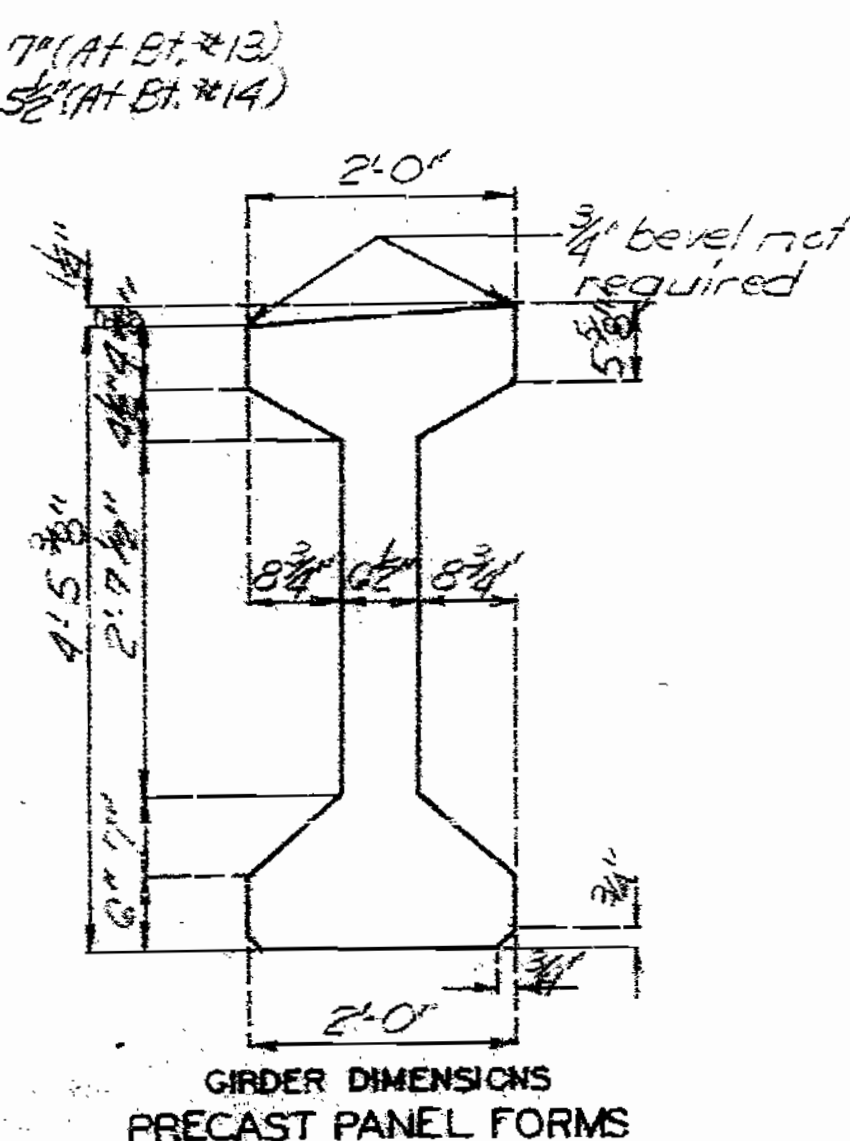


SPS 55.6.6/2 REVISED FEB. 1974  
 JUNE 1987  
 136  
 163

DETAILED MAR. 1988  
 CHECKED OCT. 1988

STATE	PROJ NO	SHEET NO
MO		122

**NOTE:**  
 CONCRETE FOR PRESTRESSED GIRDERS SHALL BE CLASS A1 WITH  $f_c = 6000$  PSI.  
 (+) INDICATES PRESTRESSED STRAND.  
 USE 18 STRANDS WITH AN INITIAL PRESTRESS FORCE OF 555 KIIPS  
 PRESTRESSING TENSIONS SHALL BE UNCOATED, SEVEN-WIRE, LOW RELAXATION STRANDS - 1/8" INCH DIAMETER CONFORMING TO A.A.S.H.T.O. M203, GRADE 270. SEE MO. STD. SPECIFICATIONS 705.4.8

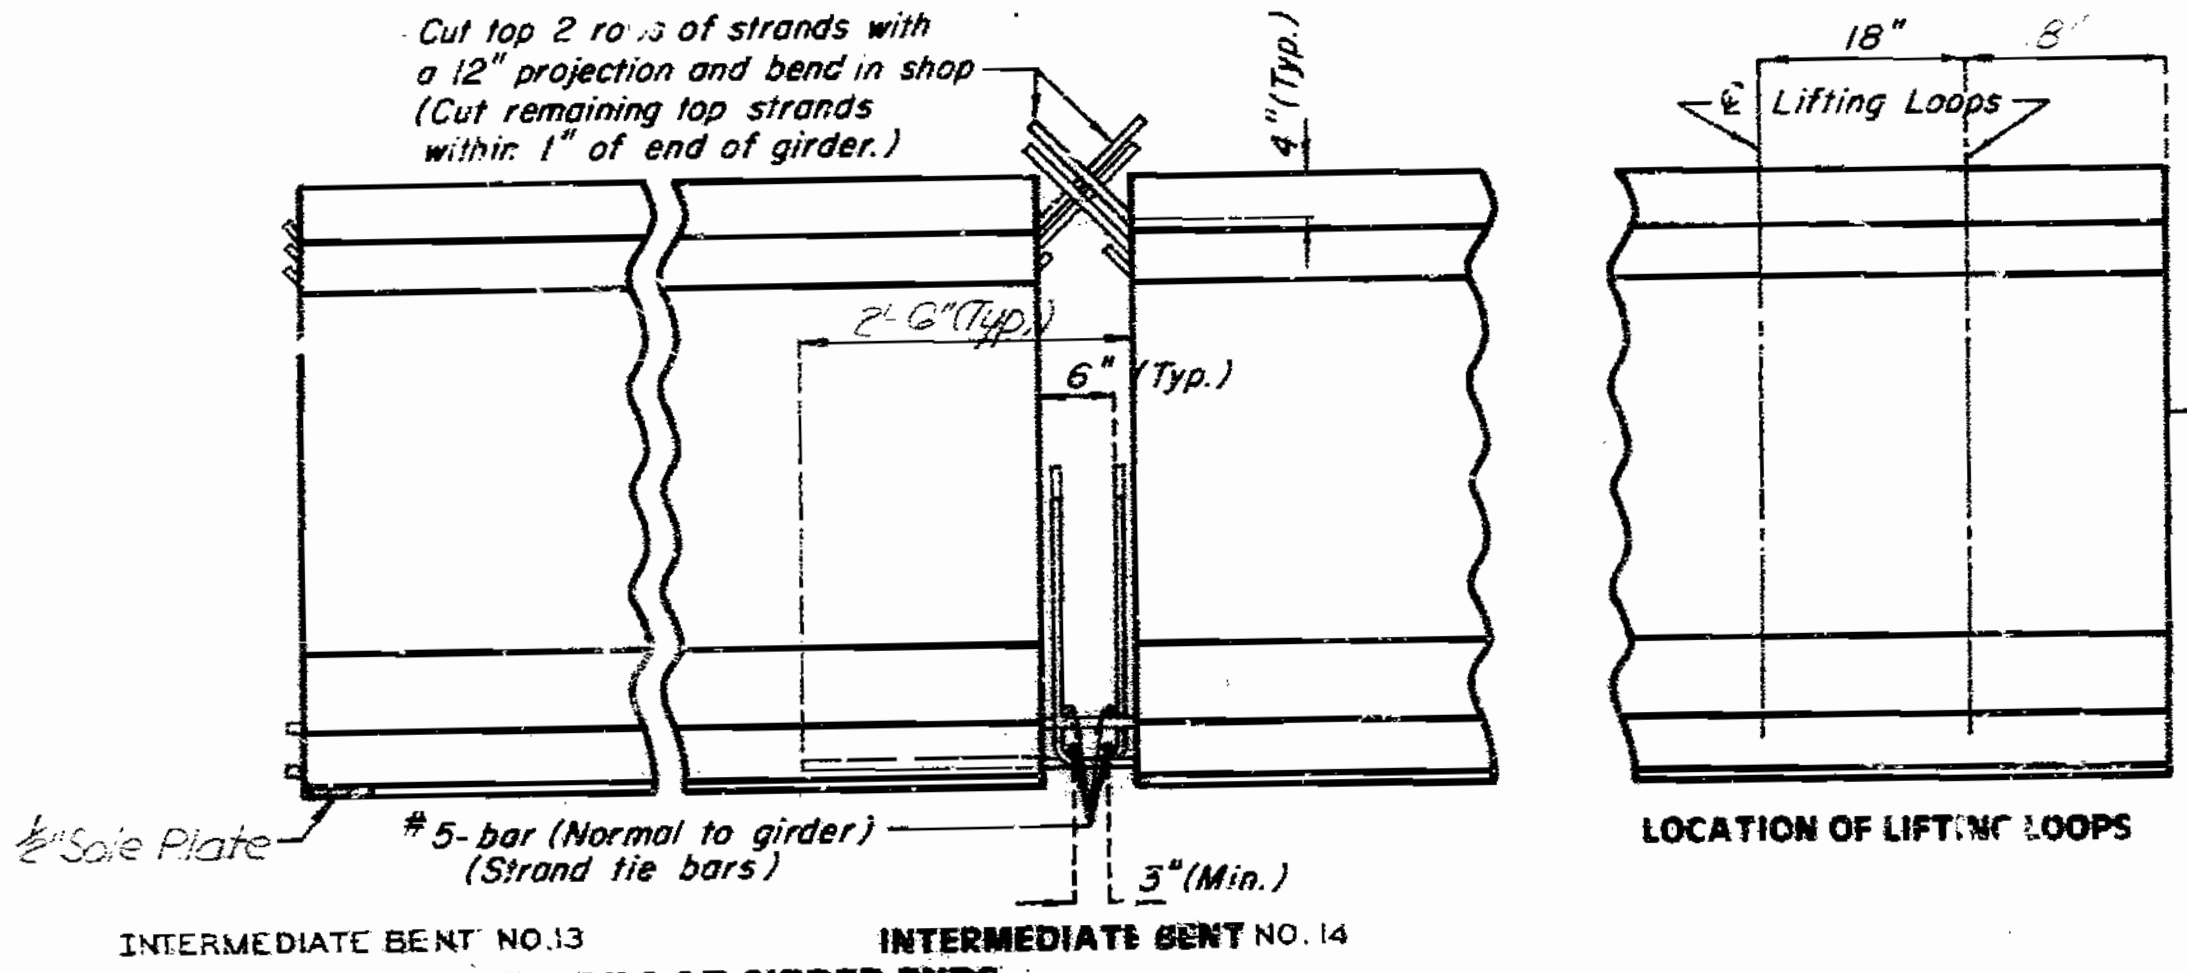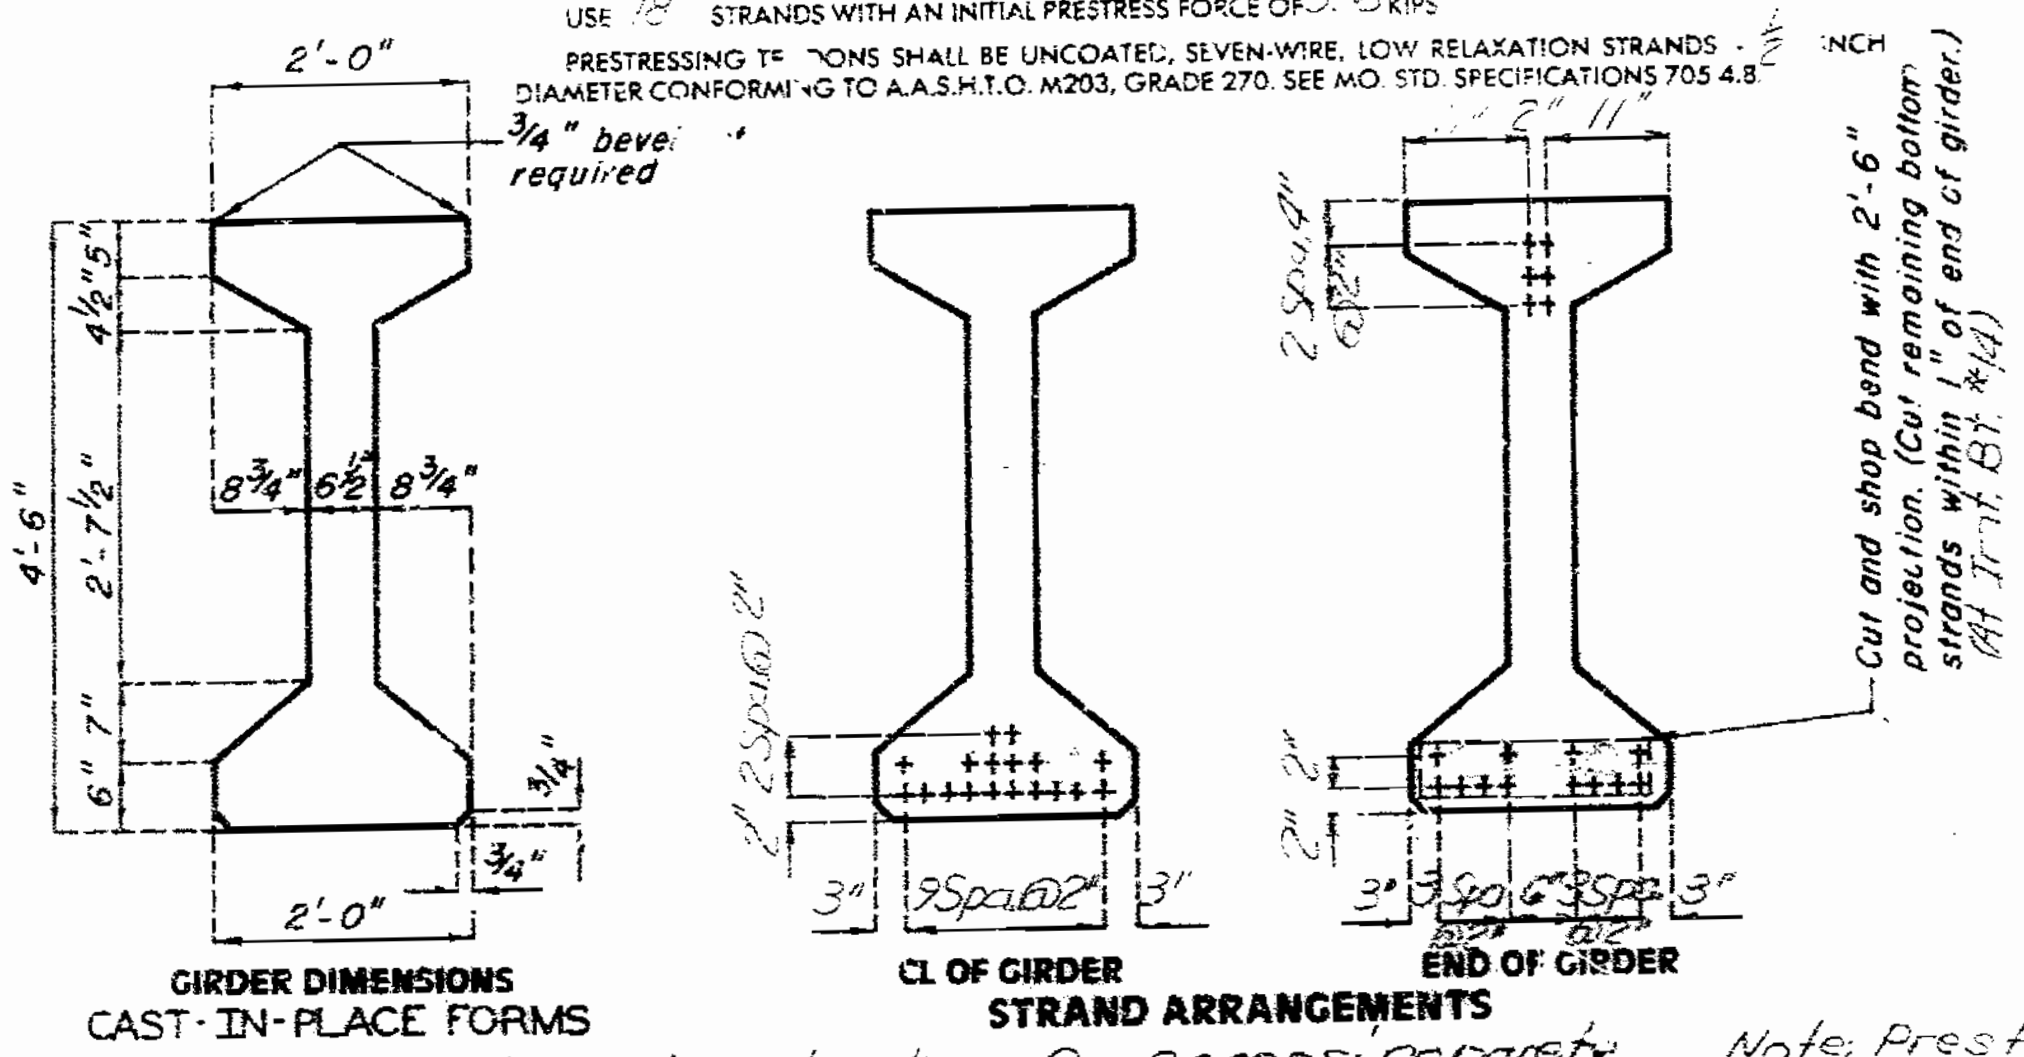


**BILL OF REINFORCING STEEL - EACH GIRDER**

NO.	SIZE & MARK	ACTUAL LENGTH	SHAPE	BENDING DIAGRAMS
4	6 A1	37'-7"	20	
130	5 B1	5'-11"	11	
8	5 B2	5'-4"	11	
65	4 C1	2'-2"	10	
130	4 D1	3'-0"	9	


**NOTE:**  
 ALL DIMENSIONS IN BENDING DIAGRAM ARE OUT TO OUT.  
 HOOKS AND BENDS SHALL BE IN ACCORDANCE WITH THE CRSI MANUAL OF STANDARD PRACTICE FOR DETAILING REINFORCED CONCRETE STRUCTURES STIRRUP AND TIE DIMENSIONS.  
 ACTUAL LENGTHS ARE MEASURED ALONG CENTERLINE BAR TO THE NEXT REST INCH.  
 MINIMUM CLEARANCE TO REINFORCING SHALL BE 1".  
 ALL REINFORCEMENT SHALL BE GRADE 60.  
 THE TWO D1 BARS MAY BE FURNISHED AS ONE BAR AT THE FABRICATOR'S OPTION.

Note: Strand release for 6,000 psi concrete = 4500 psi.

Note: Prestressing strands at Intermediate bent No. 13 shall be trimmed to within 8" of concrete if exposed, or 1" of concrete if encased. Exposed ends of girders shall be given 2 coats of an asphalt paint. Ends of girders which will be encased in concrete diaphragms shall not be painted.  
 33 pairs - #5 - B1, 33 - #4 - C1 and 33 pairs - #4 - D1 (spaced as shown)

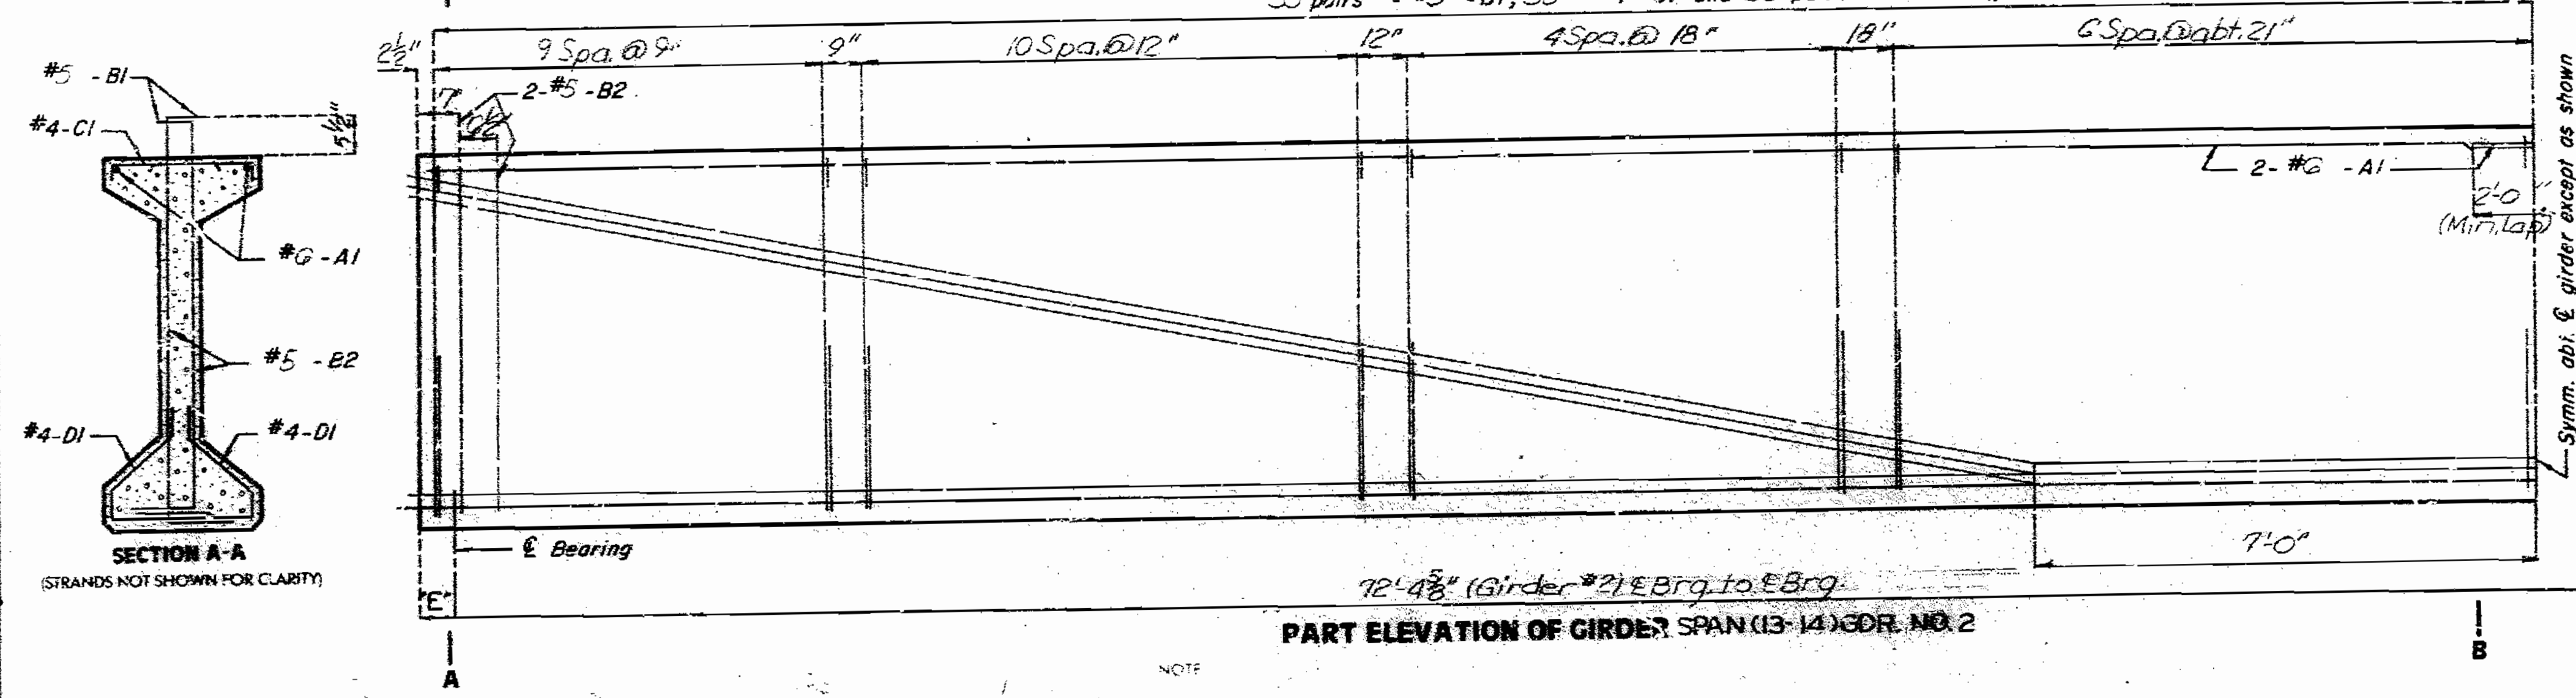


SECTION A-A  
 (STRANDS NOT SHOWN FOR CLARITY)

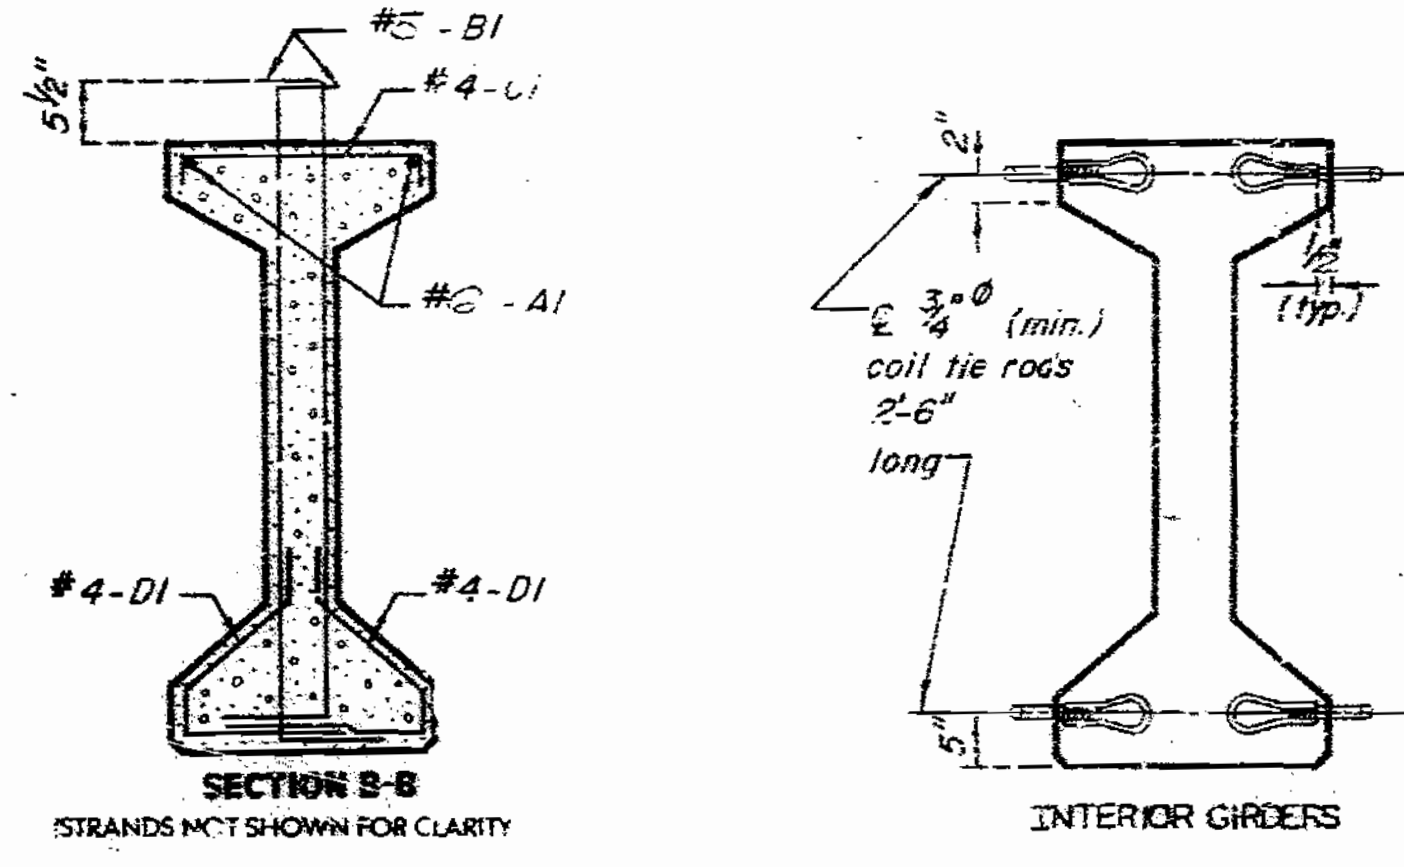

**DETAILS OF COIL TIES AT INT. BENT NO. 14**


**NOTE:**  
 COST OF 3/4" COIL TIE RODS PLACED IN DIAPHRAGMS IS INCLUDED IN CONTRACT UNIT PRICE FOR PRESTRESSED CONCRETE MEMBERS.  
 COIL TIES SHALL BE HELD IN PLACE IN THE FORMS BY SLOTTED WIRE-SETTING STUDS PROJECTING THRU FORMS. STUDS ARE TO BE LEFT IN PLACE OR REPLACED WITH TEMPORARY PLUGS UNTIL GIRDERS ARE ERECTED AND THEN REPLACED BY COIL TIE RODS.

**NOTE:**  
 The 1/2" holes shall be cast in the web for steel intermediate diaphragms. Drilling is not allowed.

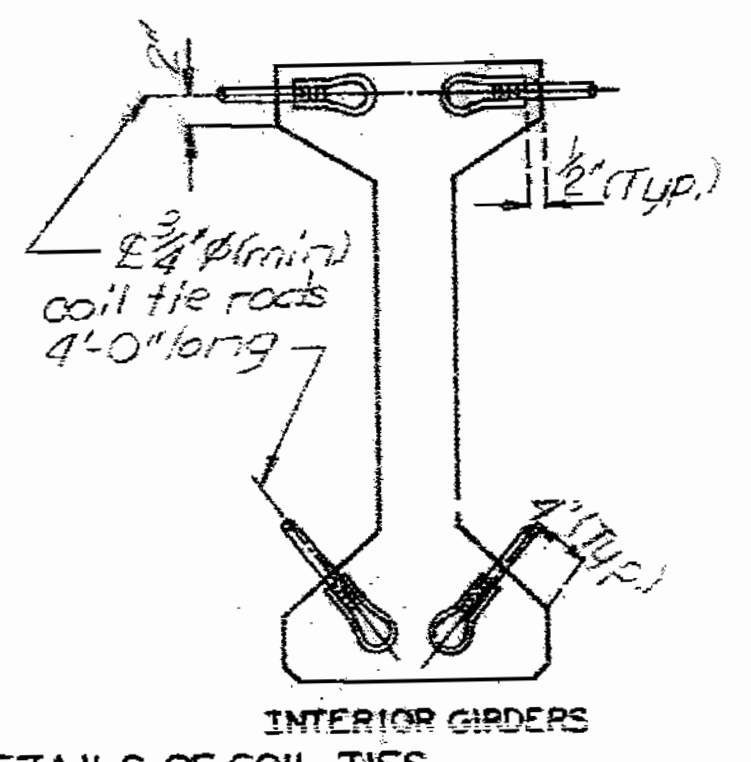


**DETAILS OF COIL TIES AT INT. BENT NO. 13**

Note: Cost of furnishing and installing for plates and welded studs in girders shall be included in price bid for Prestressed Concrete Girders per ea. of.  
 See Special Provisions for painting.

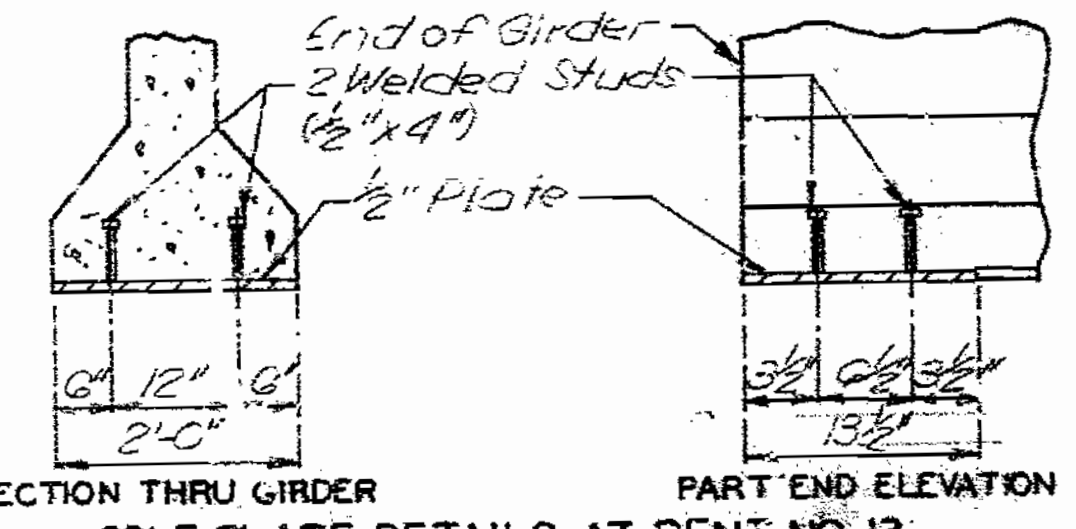

Note: Sole Plate to be placed at Bent No. 13 end of girder only.  
 Note: This drawing is not to scale. Follow dimensions.

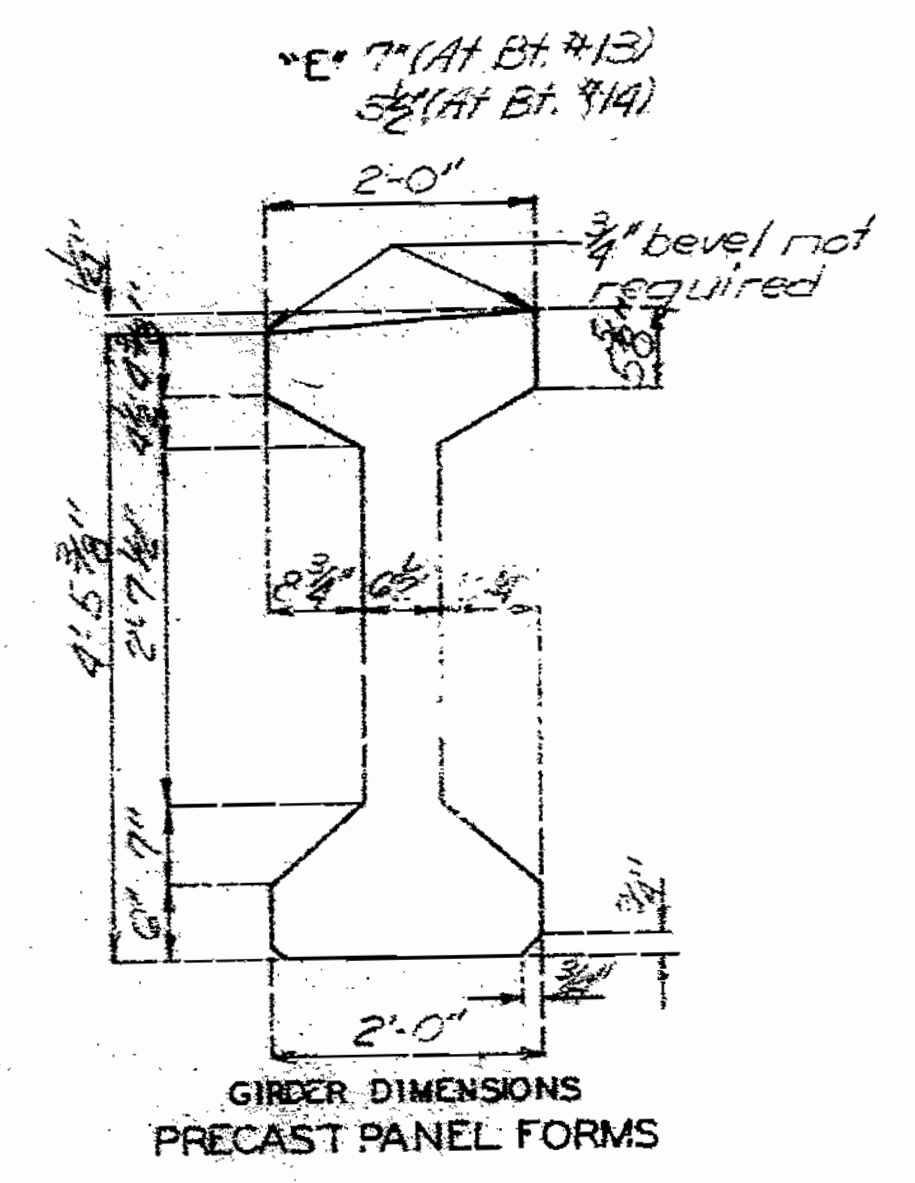

GIRDER DIMENSIONS  
 PRECAST PANEL FORMS

Sheet No. 42 of 98



764 13

SPS 55.6.6/8  
 FEB. 1974  
 REVISED  
 JUNE 1987

DETAILED MAR. 1988  
 CHECKED OCT. 1988

**NOTE:**  
 CONCRETE FOR PRESTRESSED GIRDERS SHALL BE CLASS A1 WITH  $F_c = 6,000$  PSI.  
 (+) INDICATES PRESTRESSED STRAND.  
 USE #2 STRANDS WITH AN INITIAL PRESTRESS FORCE OF 682 KIPS.  
 PRESTRESSING TENDONS SHALL BE UNCOA. ED, SEVEN-WIRE, LOW RELAXATION STRANDS - 1/2 INCH DIAMETER CONFORMING TO A.A.S.H.T.O. M203, GRADE 270. SEE MO. STD. SPECIFICATIONS 703.4.8.

STATE	PROJ NO	SHEET NO
MO		123

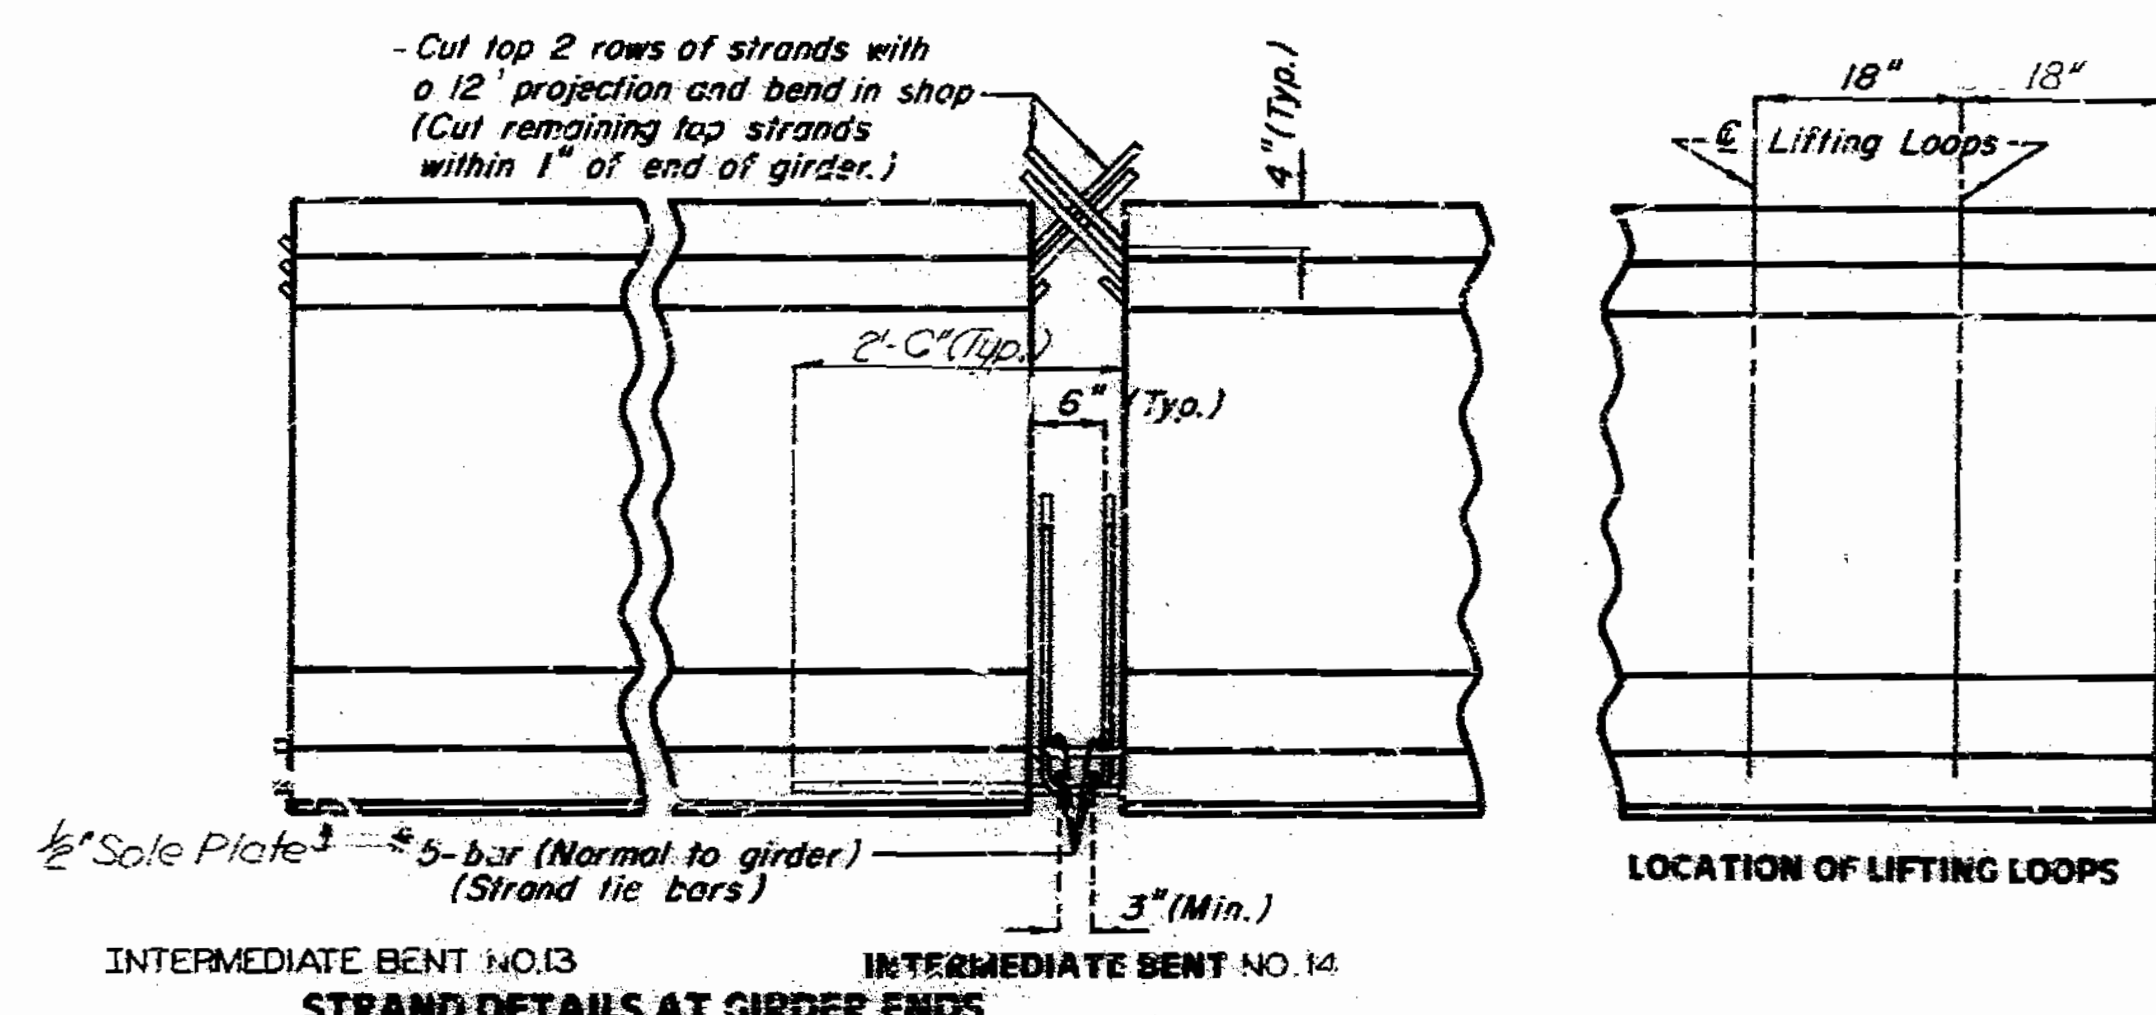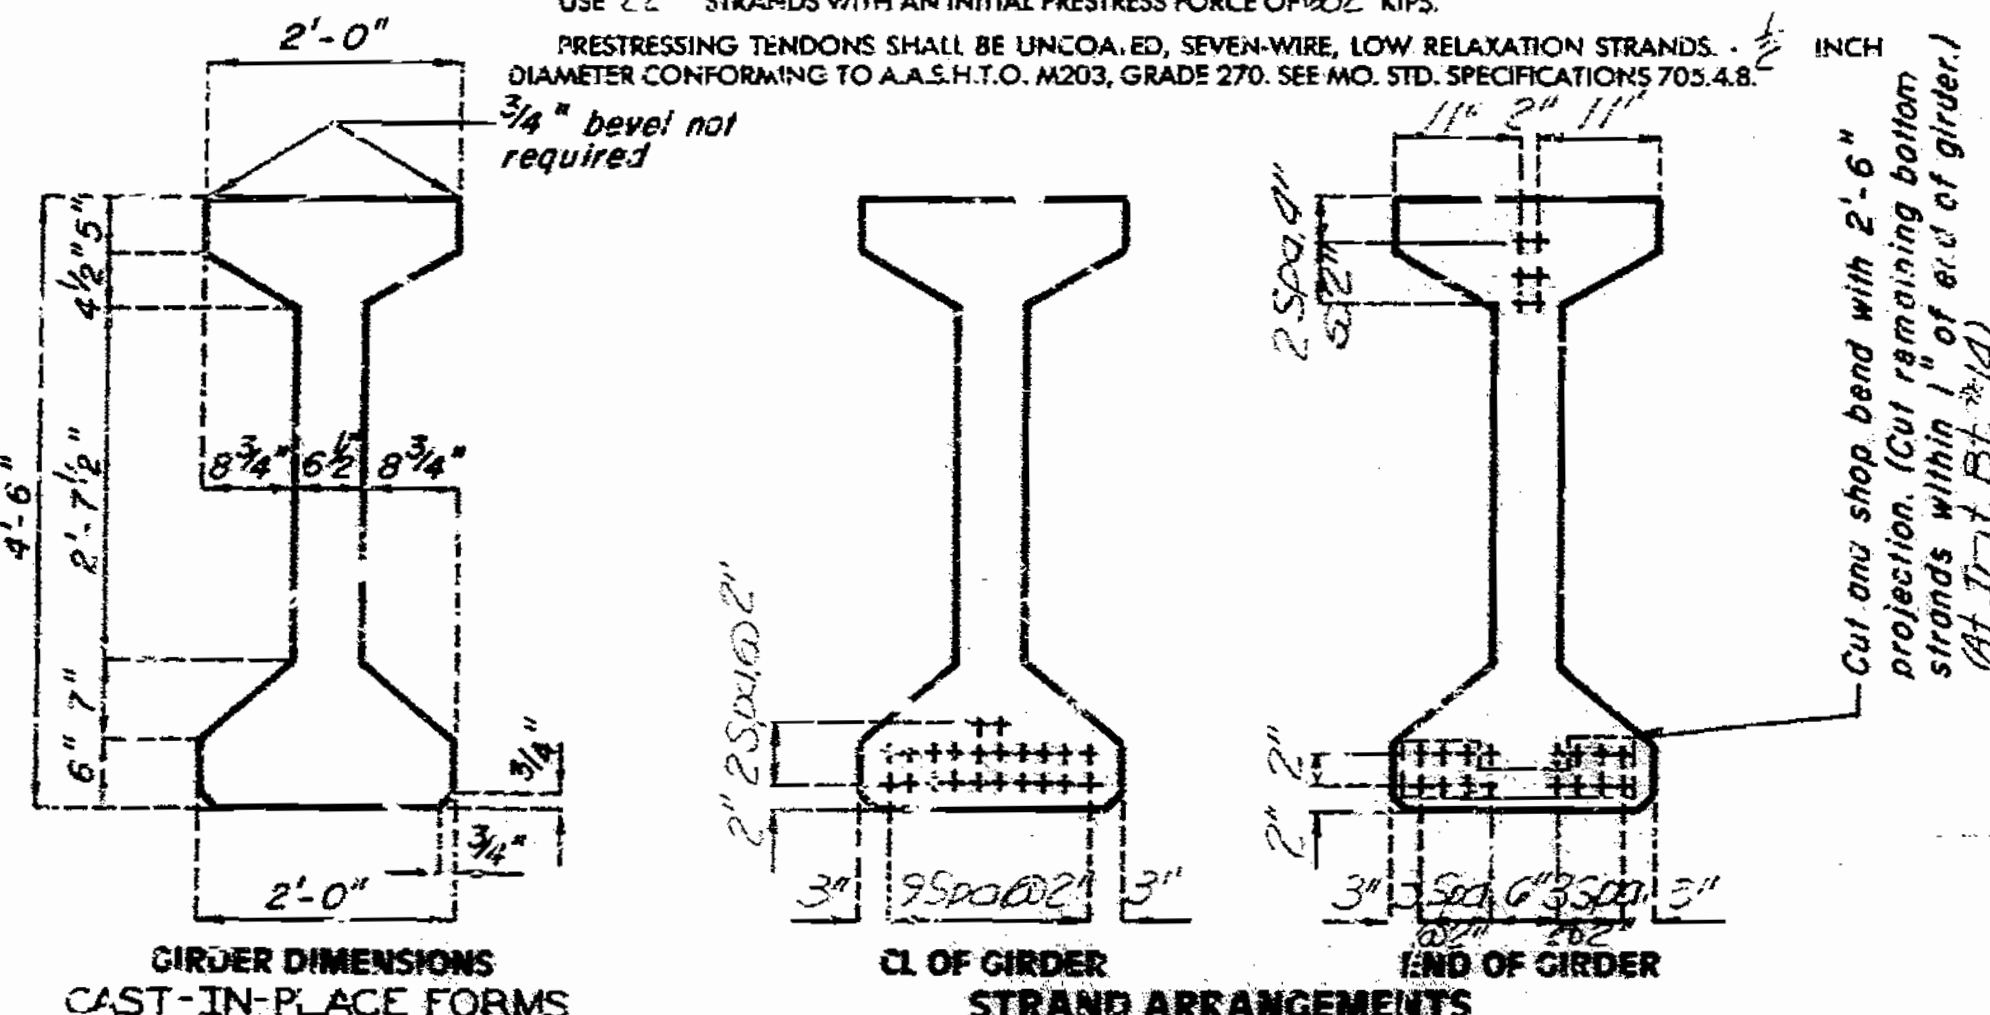





**BILL OF MATERIALS - REINFORCING STEEL - EACH GIRDER**

NO.	SIZE & MARK	ACTUAL LENGTH	SHAPE	BENDING DIAGRAMS
4	G A1	39'-11"	20	
133	S B1	5'-11"	11	
8	G B2	5'-4"	11	
29	A C1	2'-2"	10	
135	A D1	3'-0"	9	

**NOTE:**  
 ALL DIMENSIONS IN BENDING DIAGRAM ARE CUT TO OUT.  
 HOLES AND BENDS SHALL BE IN ACCORDANCE WITH THE CRSI MANUAL OF STANDARD PRACTICE FOR DETAILING REINFORCED CONCRETE STRUCTURES STEEL AND THE DIMENSIONS.  
 ACTUAL LENGTHS ARE MEASURED ALONG CENTERLINE BAR TO THE NEAREST INCH.  
 MINIMUM CLEARANCE TO REINFORCING SHALL BE 1".  
 ALL REINFORCEMENT SHALL BE GRADE 60.  
 THE TWO D1 BARS MAY BE FURNISHED AS ONE BAR AT THE FABRICATOR'S OPTION.


Note: Strand release for @4000psi concrete @5000psi.

Note: Prestressing strands at intermediate bent No. 13 shall be trimmed to within 8 inch of concrete if exposed, or 1 inch of concrete if encased. Exposed ends of girders shall be given 2 coats of an asphalt paint. Ends of girders which will be encased in concrete diaphragms shall not be painted.  
 35 pairs - #5 - B1, 35 - #4 - C1 and 35 pairs - #4 - D1 (spaced as shown)

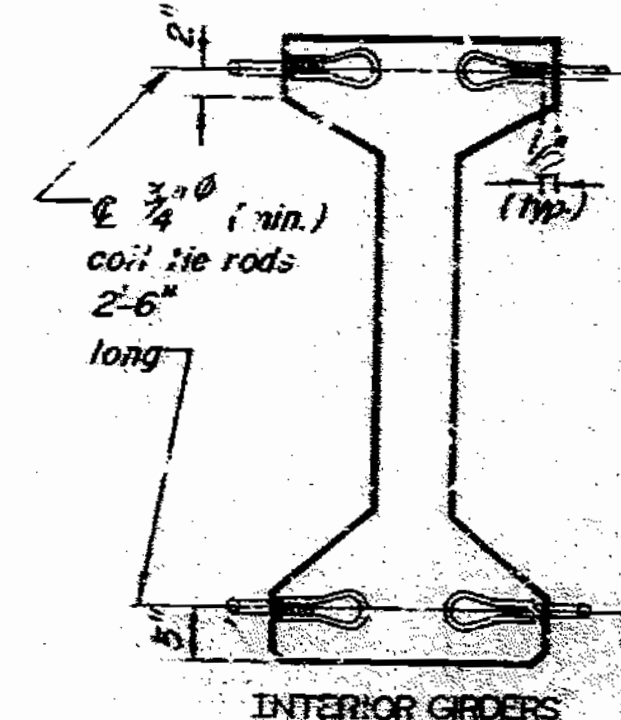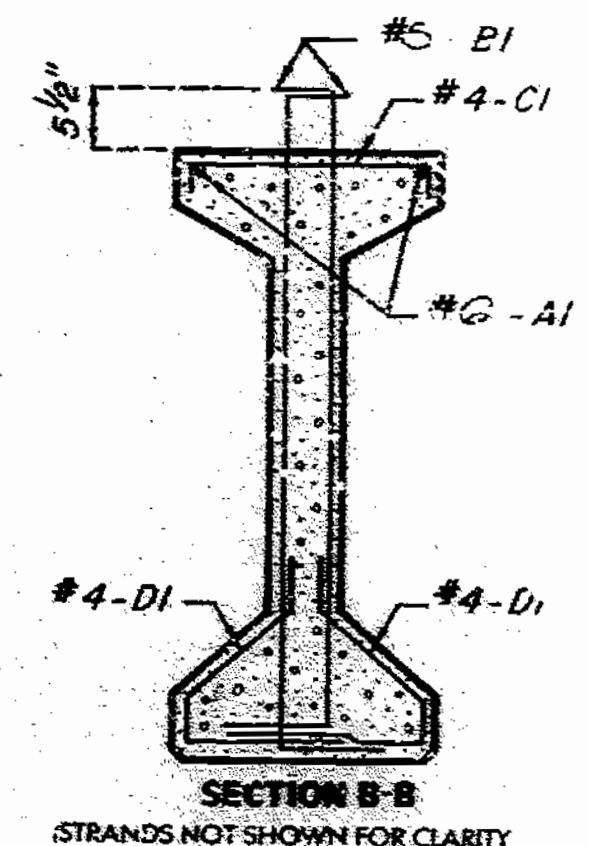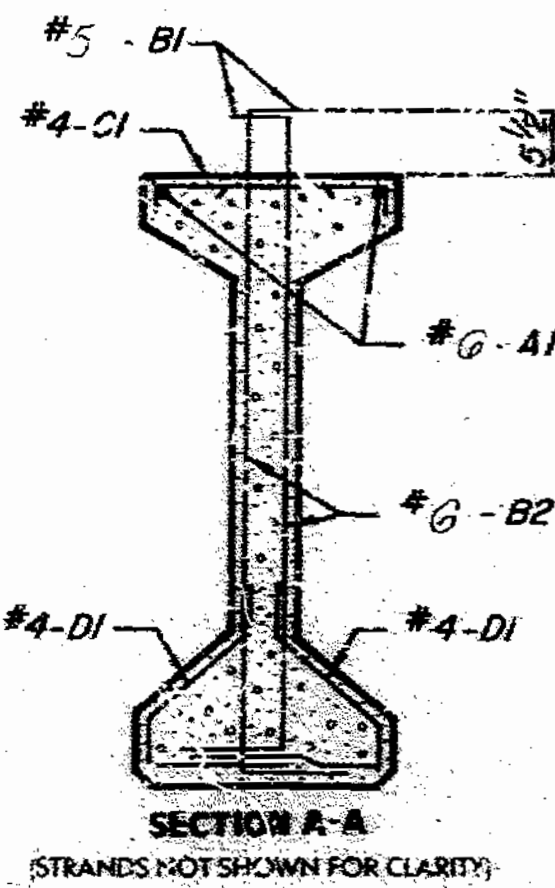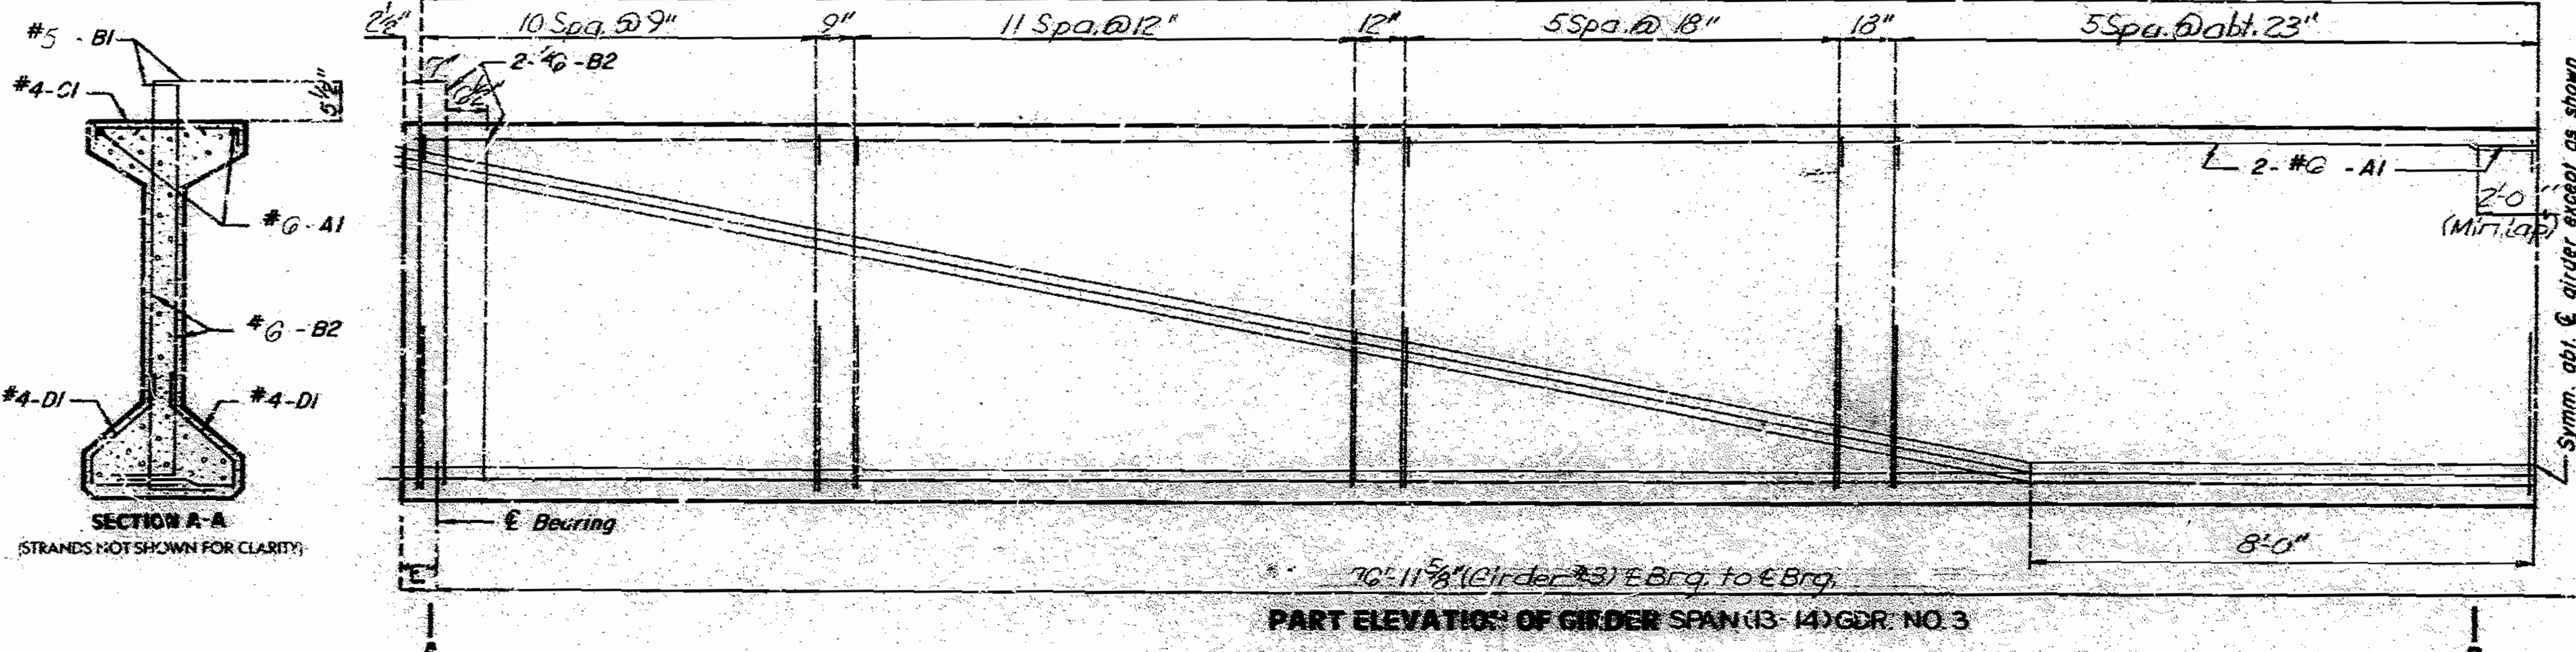


**NOTE:**  
 COST OF 3/4\"/>


COIL TIES SHALL BE HELD IN PLACE IN THE FORMS BY SLOTTED WIRE SETTING STUDS PROJECTING THRU FORMS. STUDS ARE TO BE LEFT IN PLACE OR REPLACED WITH TEMPORARY PLUGS UNTIL GIRDERS ARE ERECTED AND THEN REPLACED BY COIL TIE RODS.

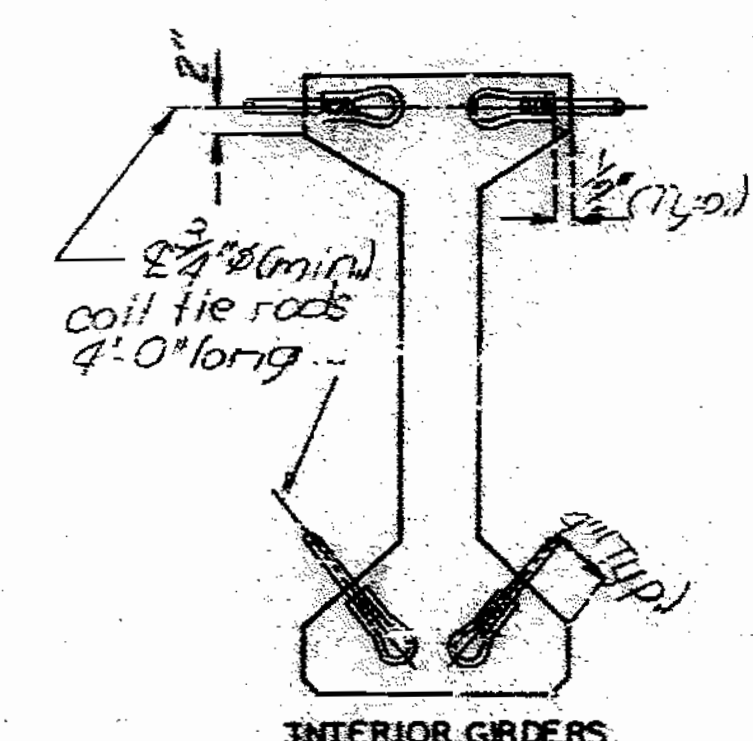

Note: For details of slotted walls to be cast in top of girder at Int. Bent No. 13 only see sheet No. 65.  
 For details of Int. Diaph. see sheet No. 66.  
 For location of Int. Diaph. and general girder placement see sheet No. 26.  
 For girder camber and haunching see sheet No. 69.

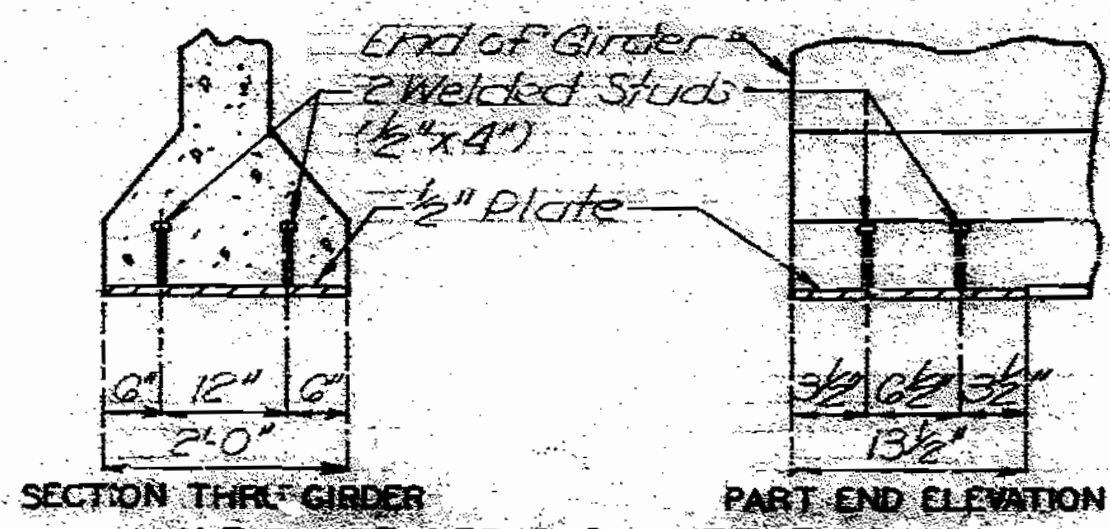

Note: Sole Plate to be placed at Bent No. 13 end of girder only.  
 Note: This drawing is not to scale. Follow dimensions.

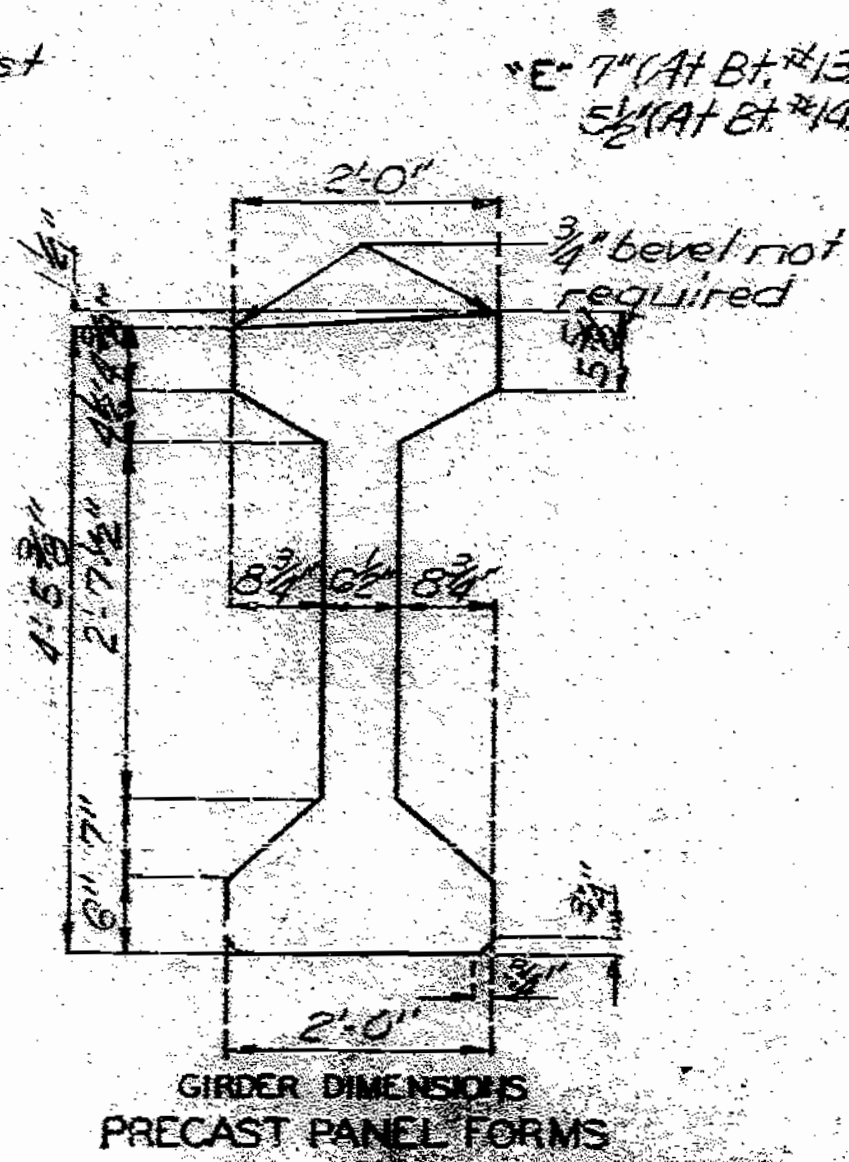



**NOTE:**  
 The 1/2\"/>

168/130

REVISIONS:  
 REVISED JUNE 1987  
 FEB. 1974  
 DETAILED MAR. 1988  
 CHECKED OCT. 1988

STATE	PROJ NO	SHEET NO
MO		131

NOTE:  
 CONCRETE FOR PRESTRESSED GIRDERS SHALL BE CLASS A1 WITH  $f_c = 6,000$  PSI.  
 (+) INDICATES PRESTRESSED STRAND.  
 USE 24 STRANDS WITH AN INITIAL PRESTRESS FORCE OF 144 KIPS.  
 PRESTRESSING TENDONS SHALL BE UNCOATED, SEVEN-WIRE, LOW RELAXATION STRANDS, 1/2 INCH DIAMETER CONFORMING TO A.S.H.T.O. #203, GRADE 270. SEE MO. S.D. SPECIFICATIONS 703.4.8.

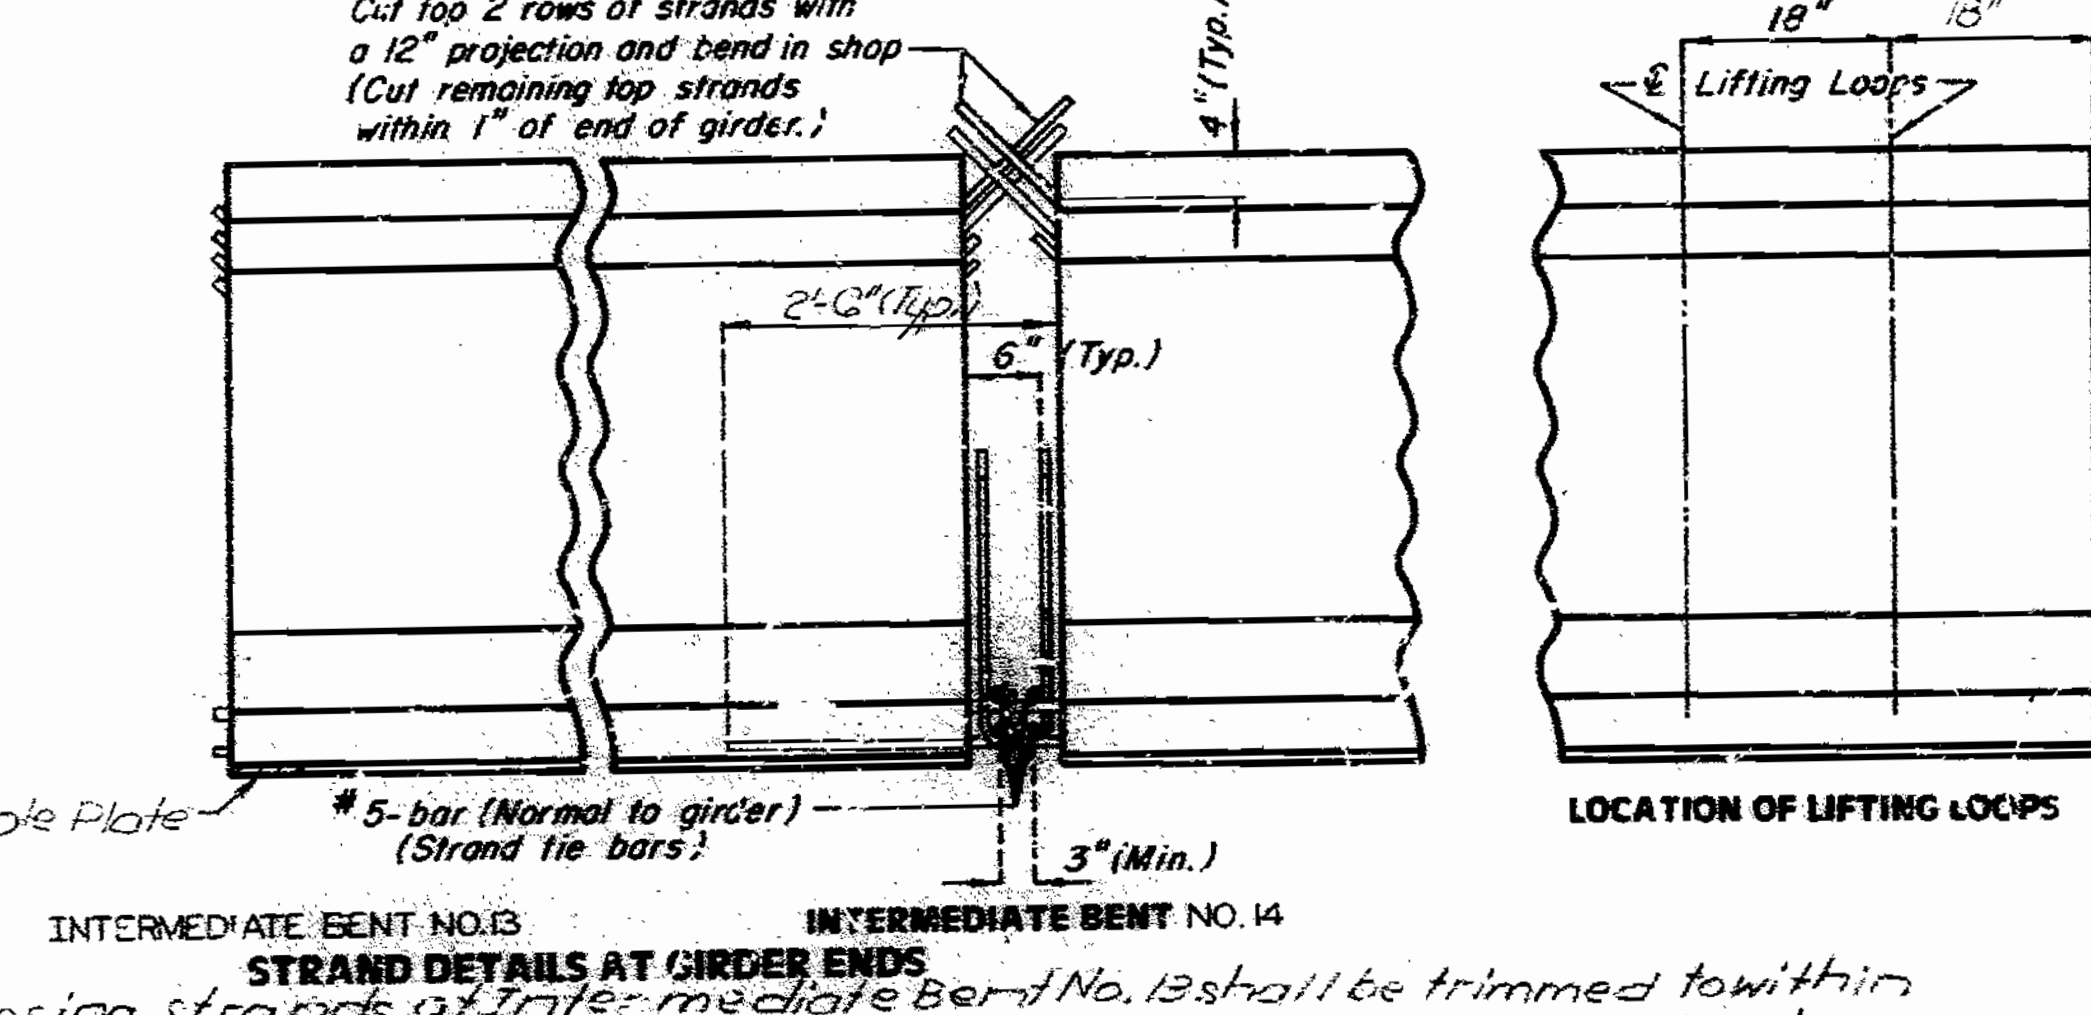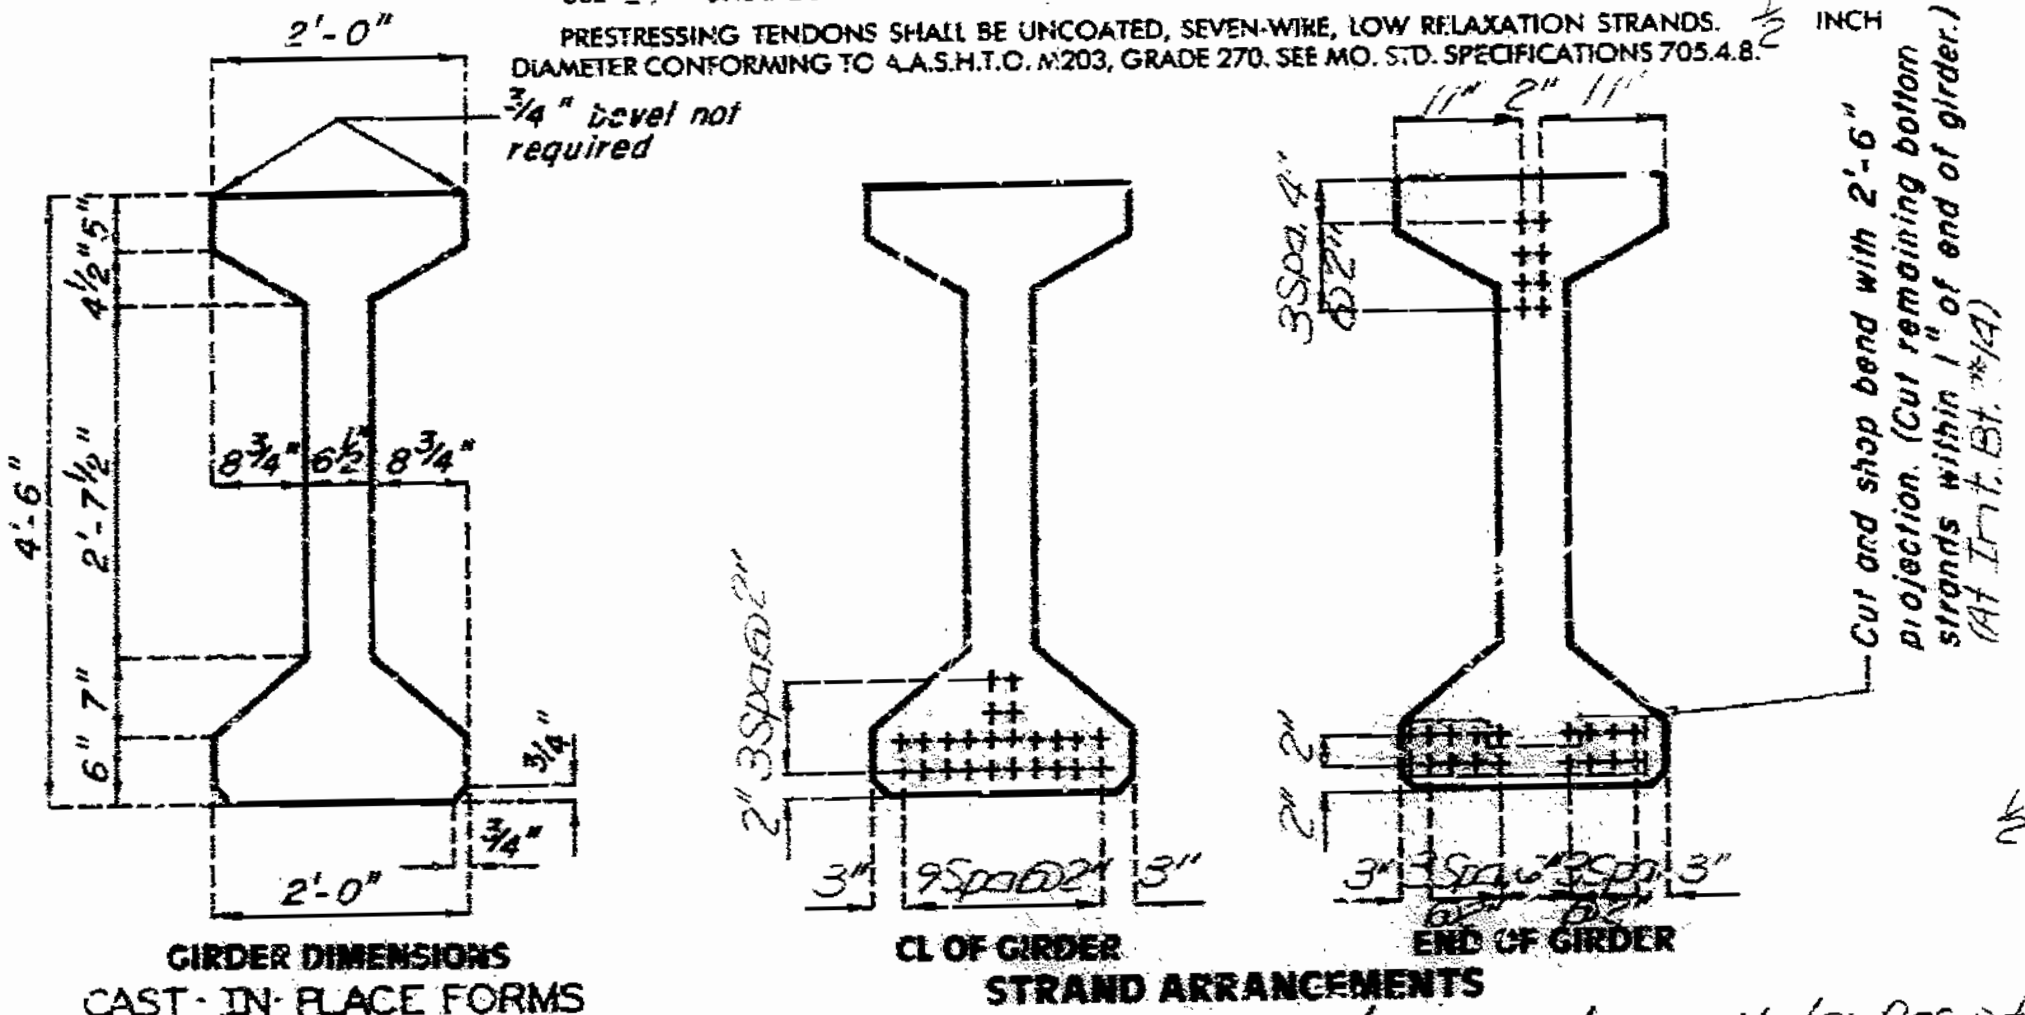



**BILL OF REINFORCING STEEL - EACH GIRDER**

NO.	SIZE & MARK	ACTUAL LENGTH	SHAPE	BENDING DIAGRAMS
4	G A1	12'-2"	20	
146	5 B1	5'-11"	11	
8	G B2	5'-4"	11	
73	4 C1	2'-2"	10	
142	4 D1	3'-0"	9	

NOTE:  
 ALL DIMENSIONS IN BENDING DIAGRAM ARE OUT TO OUT.  
 HOOKS AND BENDS SHALL BE IN ACCORDANCE WITH THE CRSI MANUAL OF STANDARD PRACTICE FOR DETAILING REINFORCED CONCRETE STRUCTURES STIRRUP AND THE DIMENSIONS.  
 ACTUAL LENGTHS ARE MEASURED ALONG CENTERLINE BAR TO THE NEAREST 1/8 INCH.  
 MINIMUM CLEARANCE TO REINFORCING SHALL BE 1".  
 ALL REINFORCEMENT SHALL BE GRADE 60.  
 THE TWO D1 BARS MAY BE FURNISHED AS ONE BAR AT THE FABRICATOR'S OPTION.

Note: Strand release for 6,000 psi concrete at 1500 psi.


STRAND DETAILS AT GIRDER ENDS  
 Note: Prestressing strands at Intermediate Bent No. 13 shall be trimmed to within 8 inch of concrete if exposed, or 1 inch of concrete if exposed. Exposed ends of girders shall be given 2 coats of an asphalt paint. Ends of girders which will be encased in concrete diaphragms shall not be painted.  
 37 pairs - #5 - B1, 37 - #4 - C1 and 37 pairs - #4 - D1 (spaced as shown)

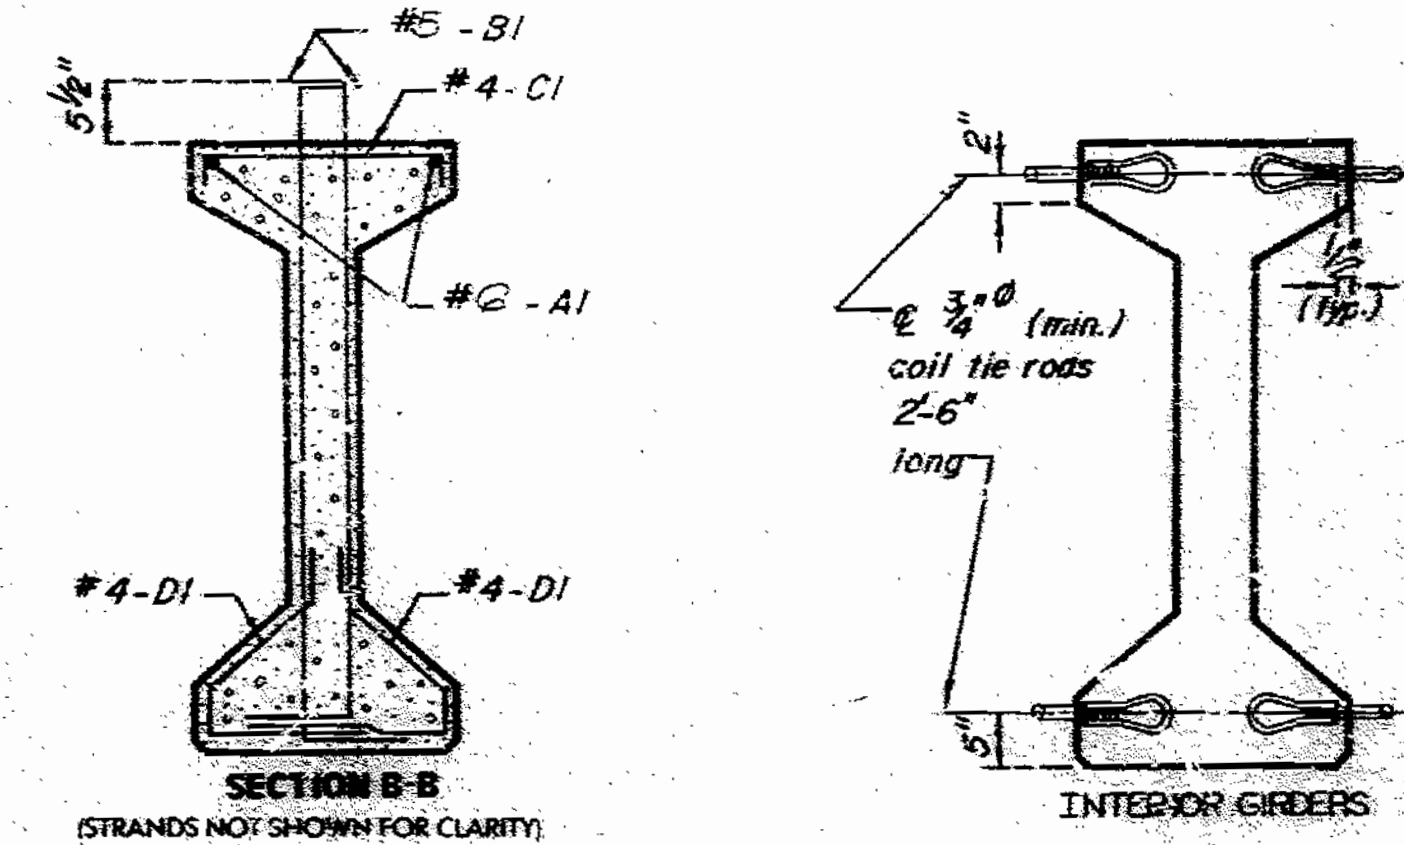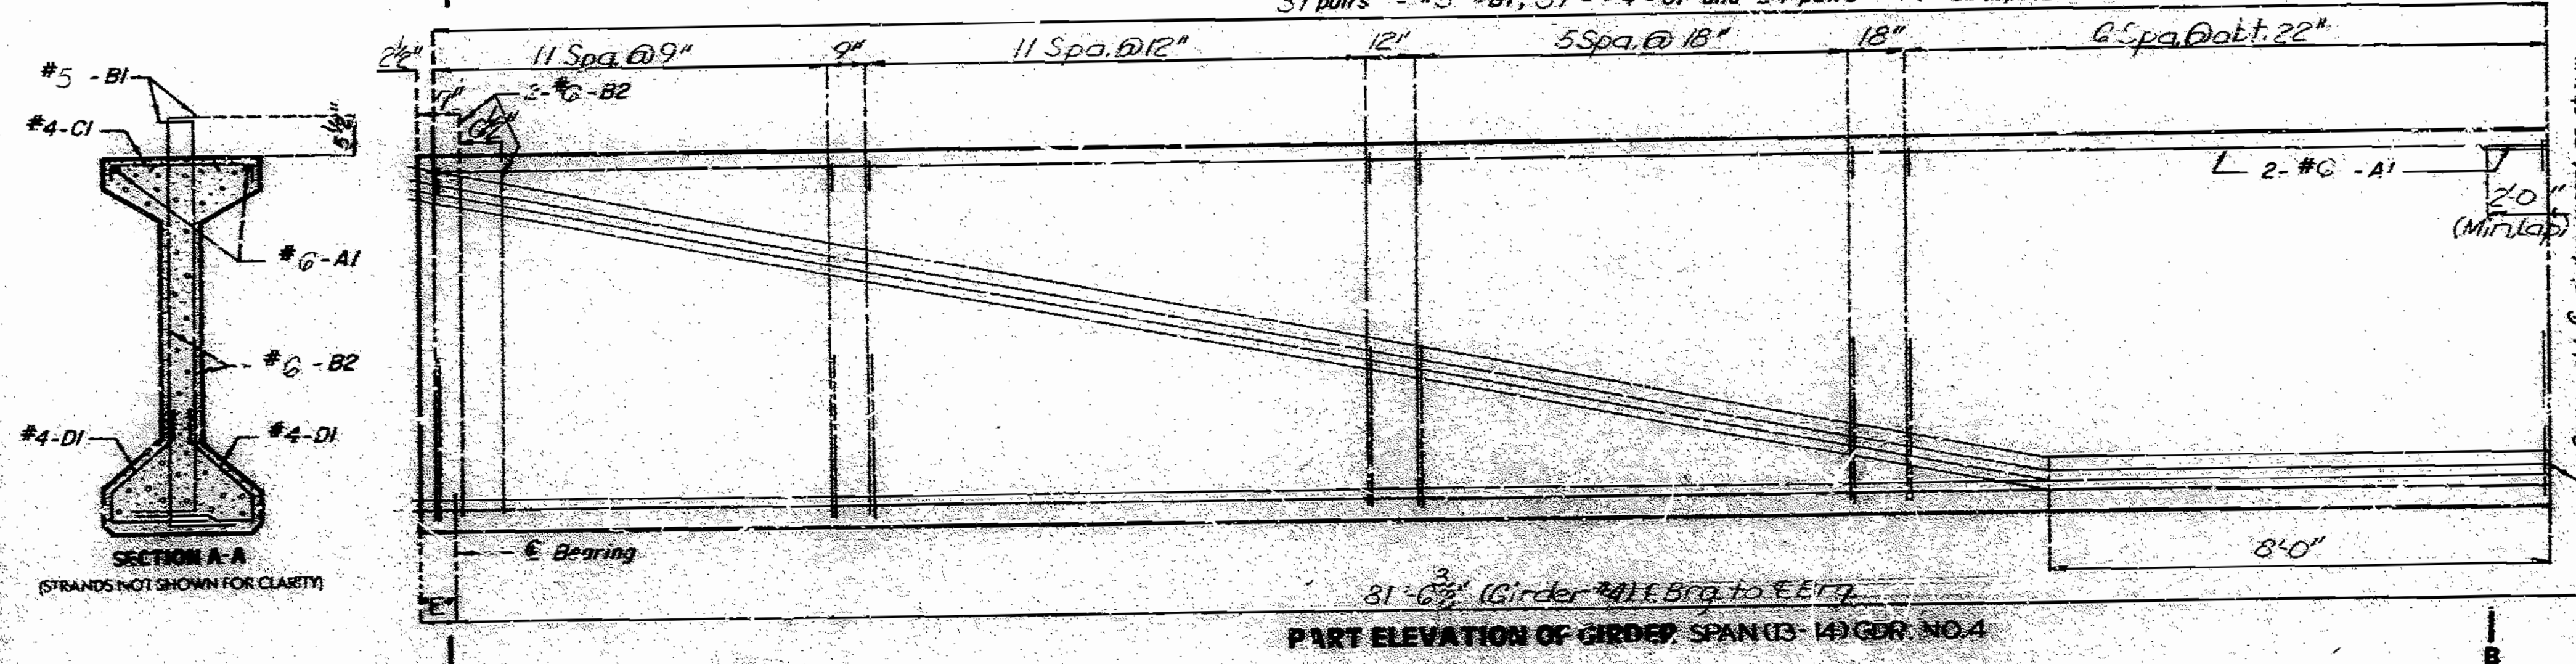

**DETAILS OF COIL TIES AT INT. BENT NO. 14**


NOTE:  
 COST OF 3/4" COIL TIE RODS PLACED IN DIAPHRAGMS IS INCLUDED IN CONTRACT UNIT PRICE FOR PRESTRESSED CONCRETE MEMBERS.  
 COIL TIES SHALL BE HELD IN PLACE IN THE FORMS BY SLOTTED WIRE SETTING STUDS PROJECTING THRU FORMS. STUDS ARE TO BE LEFT IN PLACE OR REPLACED WITH TEMPORARY PLUGS UNTIL GIRDERS ARE ERECTED AND THEN REPLACED BY COIL TIE RODS.

The 1/2" Dia. Steel Studs are to be used for steel intermediate diaphragms. Drilling is not allowed.

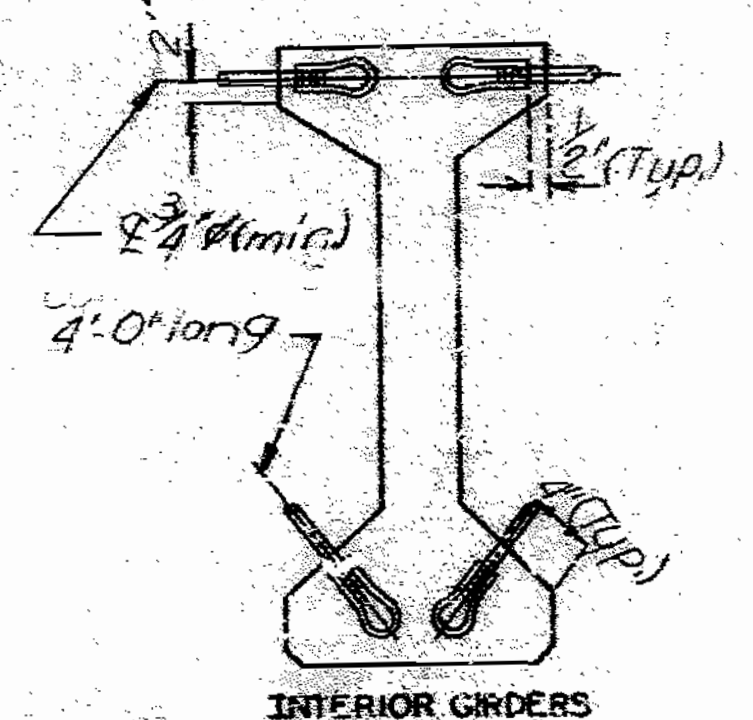


**DETAILS OF COIL TIES AT INT. BENT NO. 13**

Note: Cost of furnishing and installing plates and welded studs in girders shall be included in price bid for prestressed concrete girders per each. See Special Provisions for painting.

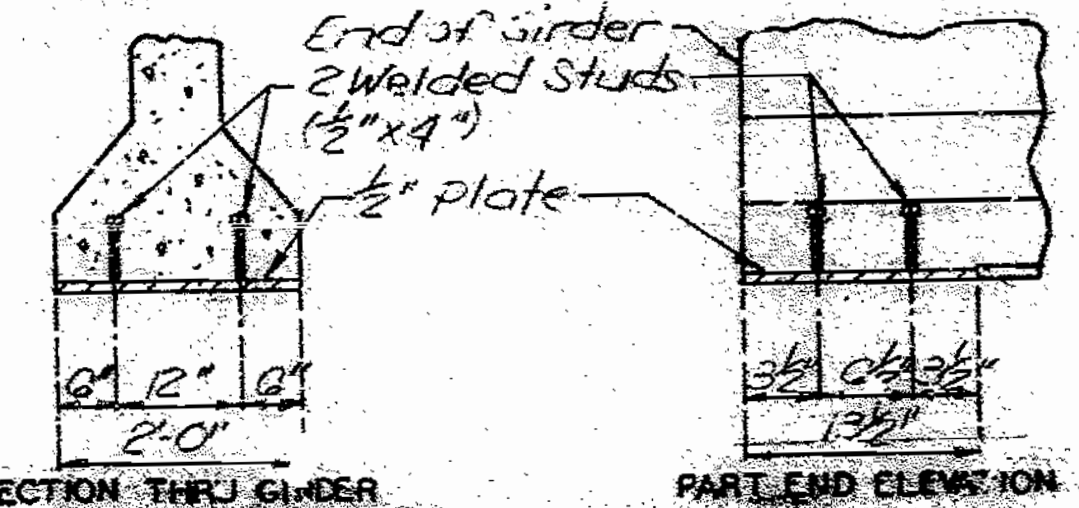

Note: Sole Plate to be placed at Bent No. 13 end of girder only.  
 Note: This drawing is not to scale. Follow dimensions.

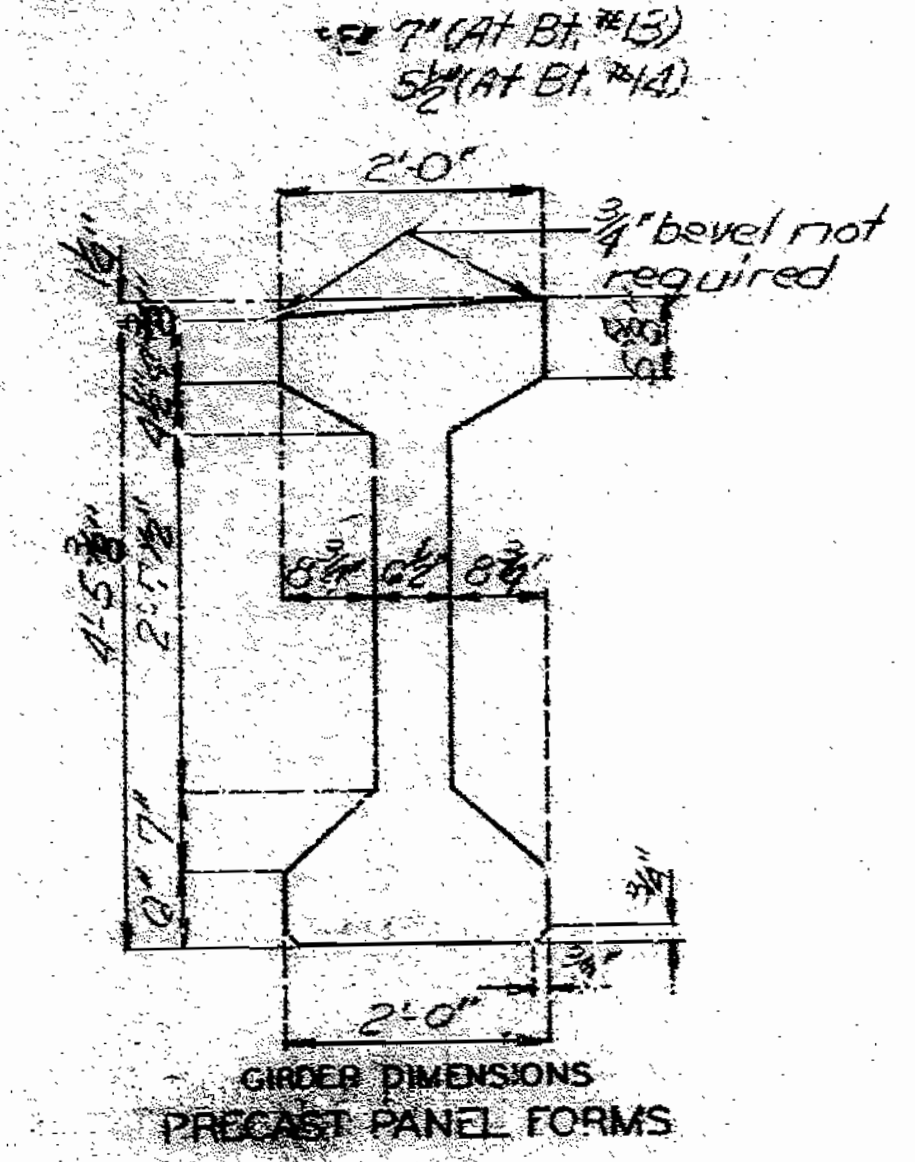

**GIRDER DIMENSIONS PRECAST PANEL FORMS**



Sheet No. 44 of 58.

165 139

SPS 55.6.6 1/2  
 FEB. 1974  
 REVISED  
 JUNE 1987  
 DETAILED MAR. 1988  
 CHECKED OCT. 1988

NOTE: CONCRETE FOR PRESTRESSED GIRDERS SHALL BE CLASS A1 WITH  $f_c = 6000$  PSI.

(+) INDICATES PRESTRESSED STRAND.  
 USE 28 STRANDS WITH AN INITIAL PRESTRESS FORCE OF 200 KIPS.  
 PRESTRESSING TENDONS SHALL BE UNCOATED, SEVEN-WIRE, LOW RELAXATION STRA-DS. - 1/2 INCH DIAMETER CONFORMING TO A.A.S.H.T.O. M203, GRADE 270. SEE MO. STD. SPECIFICATIONS 705.4.8.

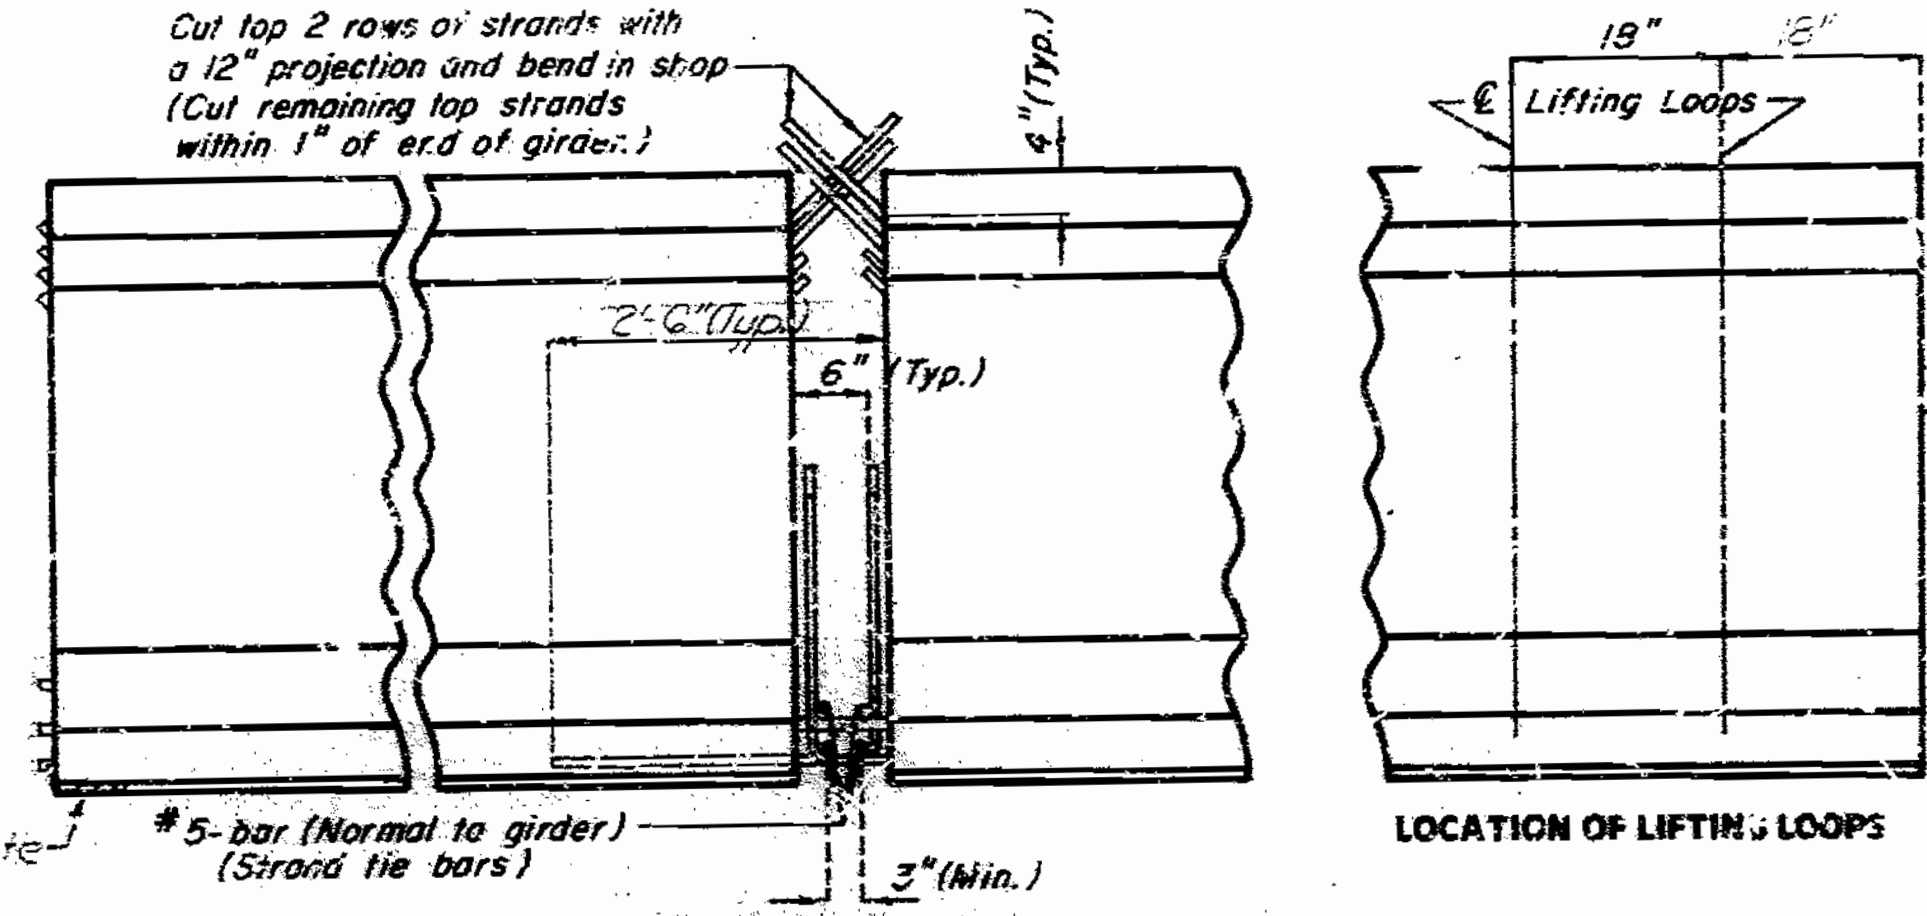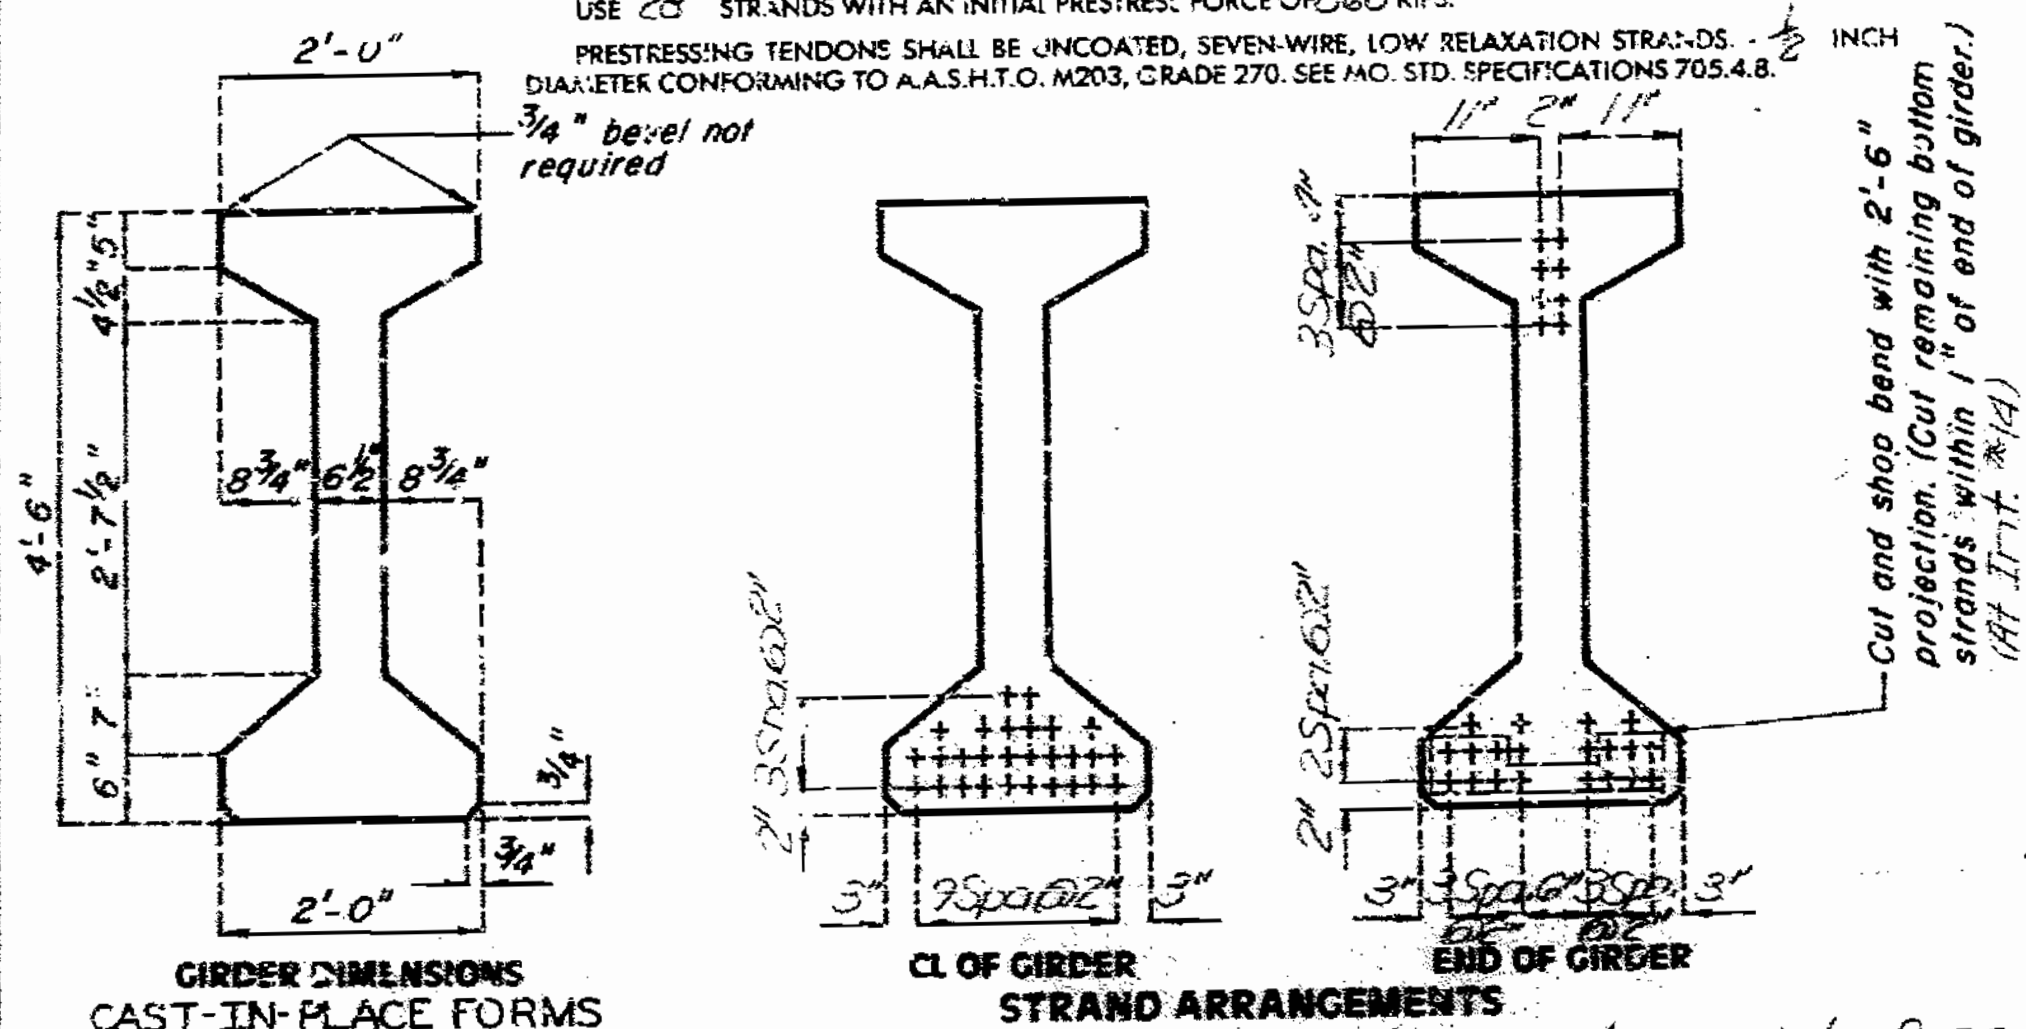


BILL OF REINFORCING STEEL - EACH GIRDER

NO.	SIZE & MARK	ACTUAL LENGTH	SHAPE	BENDING DIAGRAMS
9	6A1	44'-7 1/2"	20	
15A	5B1	5'-11"	11	
3	6B2	5'-4"	11	
77	4C1	2'-2"	10	
15A	4D1	3'-0"	9	


NOTE:  
 ALL DIMENSIONS IN BENDING DIAGRAM ARE OUT TO OUT.  
 HOOKS AND BENDS SHALL BE IN ACCORDANCE WITH THE CRS MANUAL OF STANDARD PRACTICE FOR DETAILING REINFORCED CONCRETE STRUCTURES STIRRUP AND TIE DIMENSIONS.  
 ACTUAL LENGTHS ARE MEASURED ALONG CENTERLINE BAR TO THE NEAREST INCH.  
 MINIMUM CLEARANCE TO REINFORCING SHALL BE 1".  
 ALL REINFORCEMENT SHALL BE GRADE 60.  
 THE TWO D1 BARS MAY BE FURNISHED AS ONE BAR AT THE FABRICATOR'S OPTION.

Note: Strand release per Gypsum concrete = 4500 psi.

STRAND DETAILS AT GIRDER ENDS  
 Note: Prestressing strands at Intermediate Bent No. 13 shall be trimmed to within 8 inches of concrete if exposed, or 1 inch of concrete if encased. Exposed ends of girders shall be given 2 coats of an asphalt paint. Ends of girders which will be encased in concrete diaphragms shall not be painted.  
 39 pairs - #5 - B1, 39 - #4 - C1 and 39 pairs - #4 - D1 (spaced as shown)

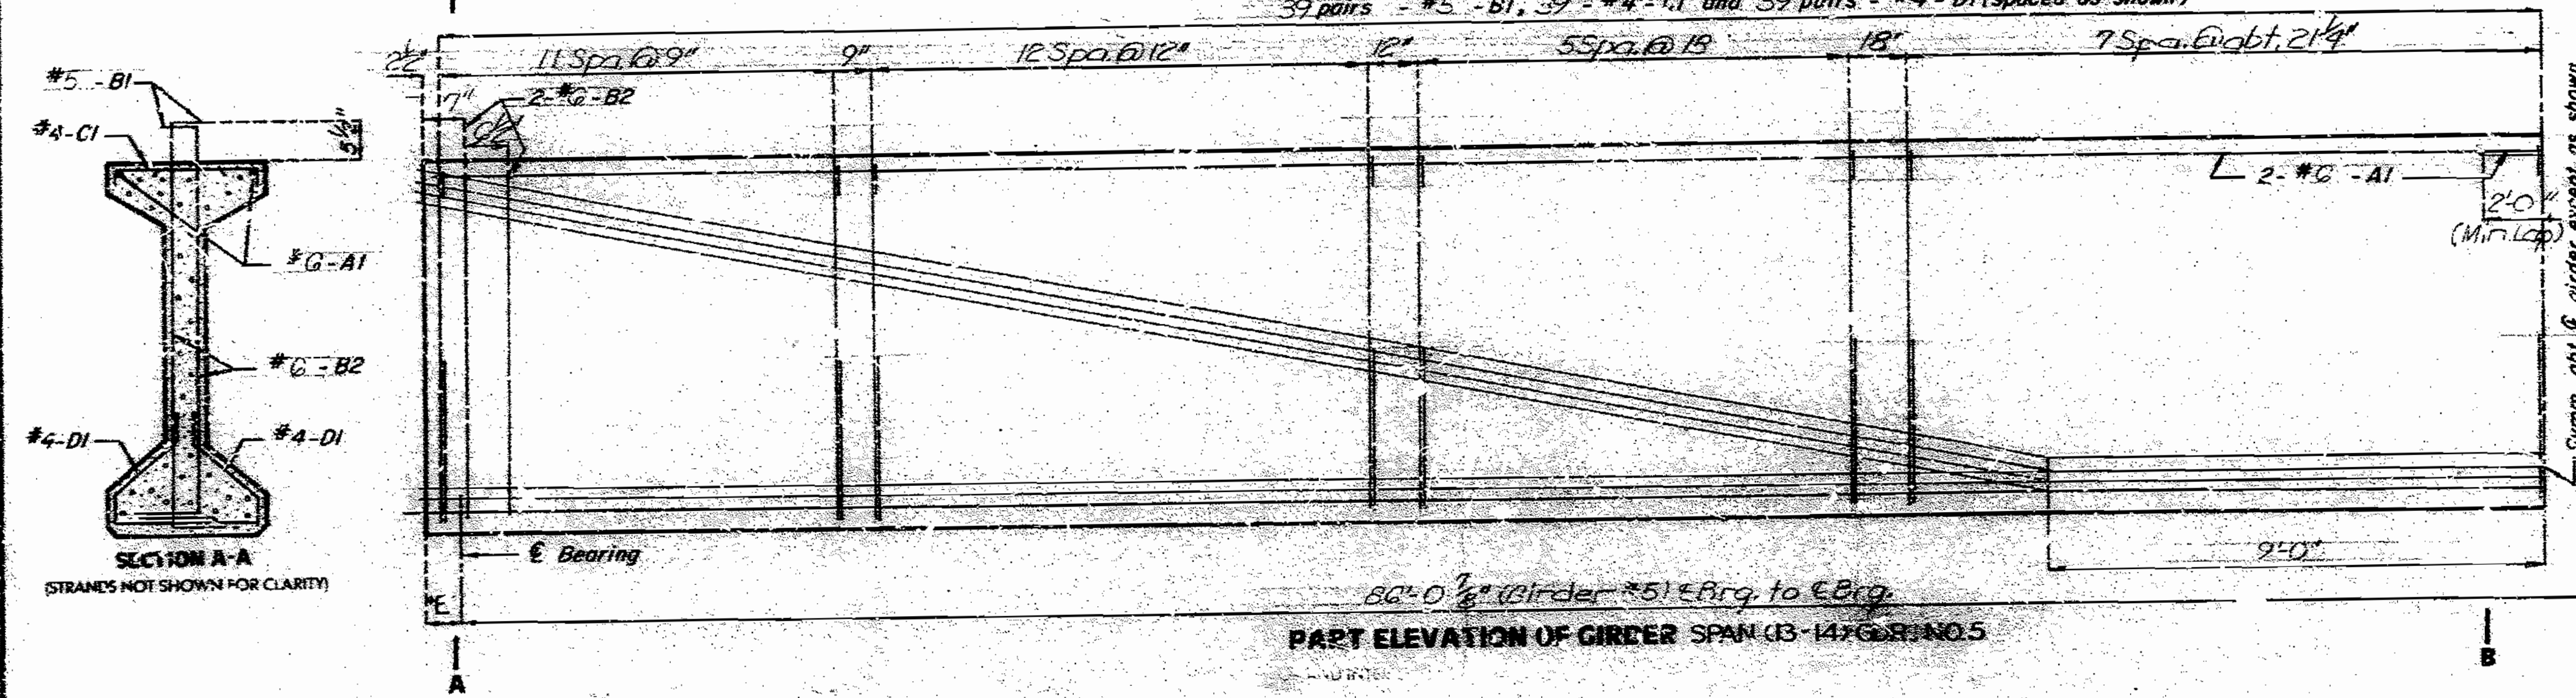


157 140

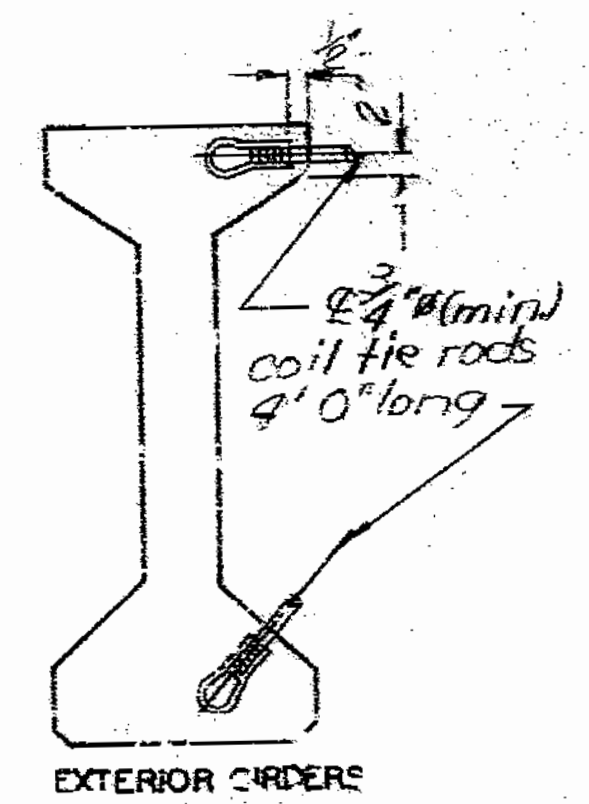

DETAILS OF COIL TIES AT INT. BENT NO. 13


Note: Cost of furnishing and installing 1/2" plates and welded studs in girders shall be included in price bid for prestressed concrete girders, per each. See special provisions for painting.

Note: For details of slotted walls to be cast in top of girder (at Int. Bent only) see sheet No. 65.  
 For details of Int. Diaph. see sheet No. 66.  
 For location of Int. Diaph. and general girder placement, see sheet No. 20.  
 For girder carrier and haunching see sheet No. 69.

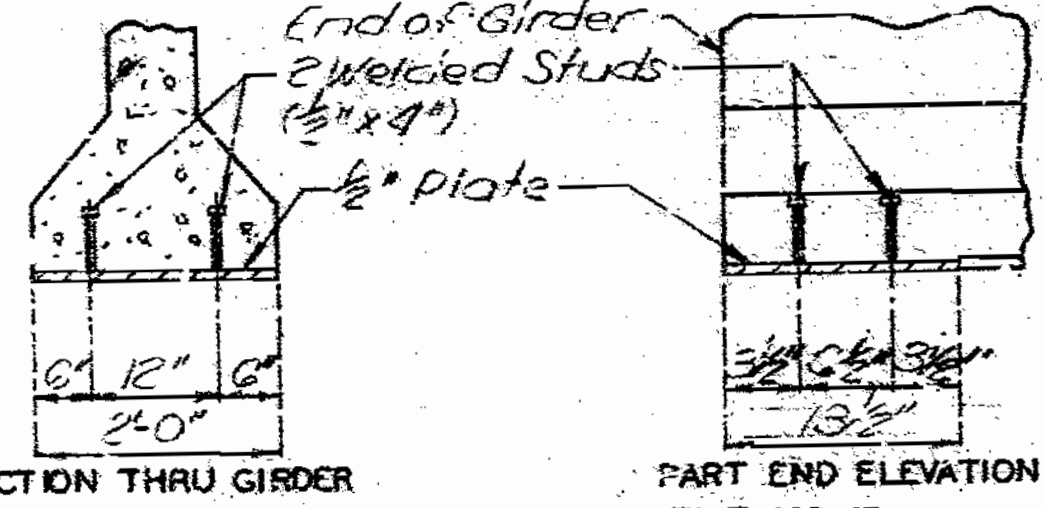


SECTION THRU GIRDER SOLE PLATE DETAILS AT BENT NO. 13

Note: Sole Plate to be placed at Bent No. 13 end of girder only.  
 Note: This drawing is not to scale. Follow dimensions.

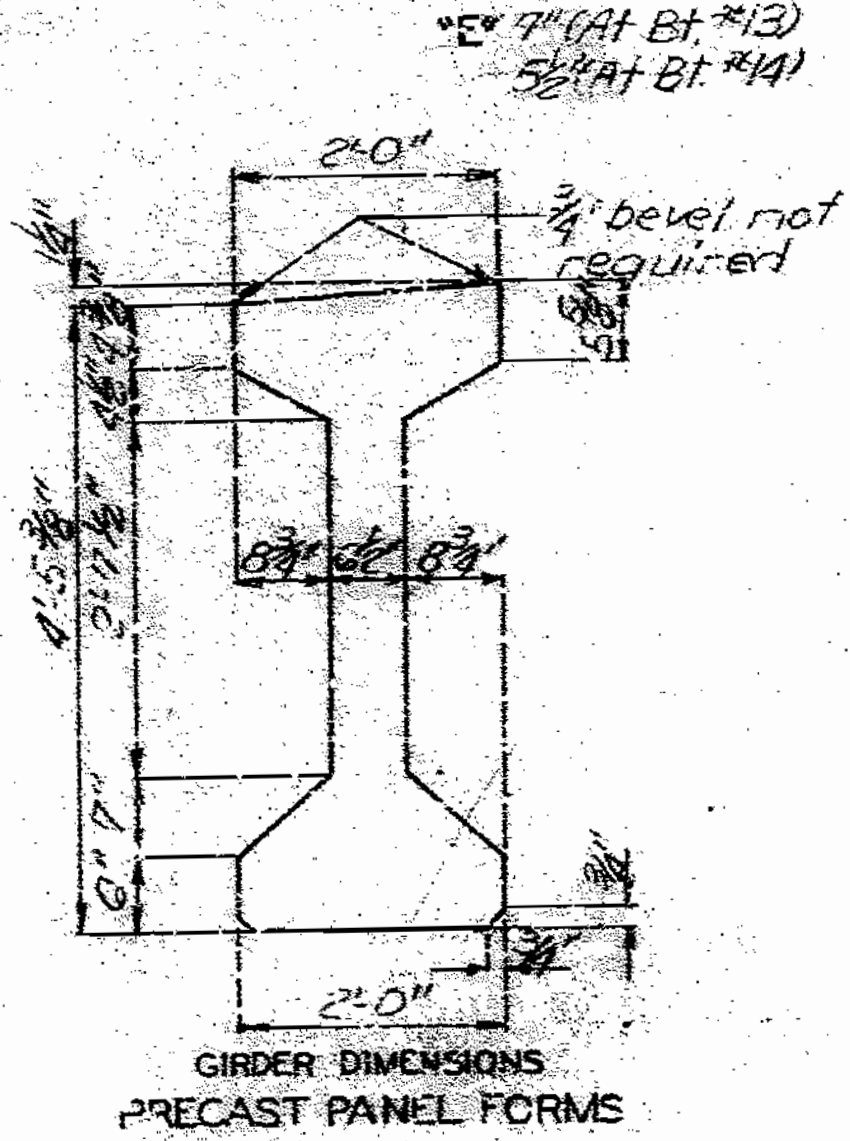

GIRDER DIMENSIONS PRECAST PANEL FORMS

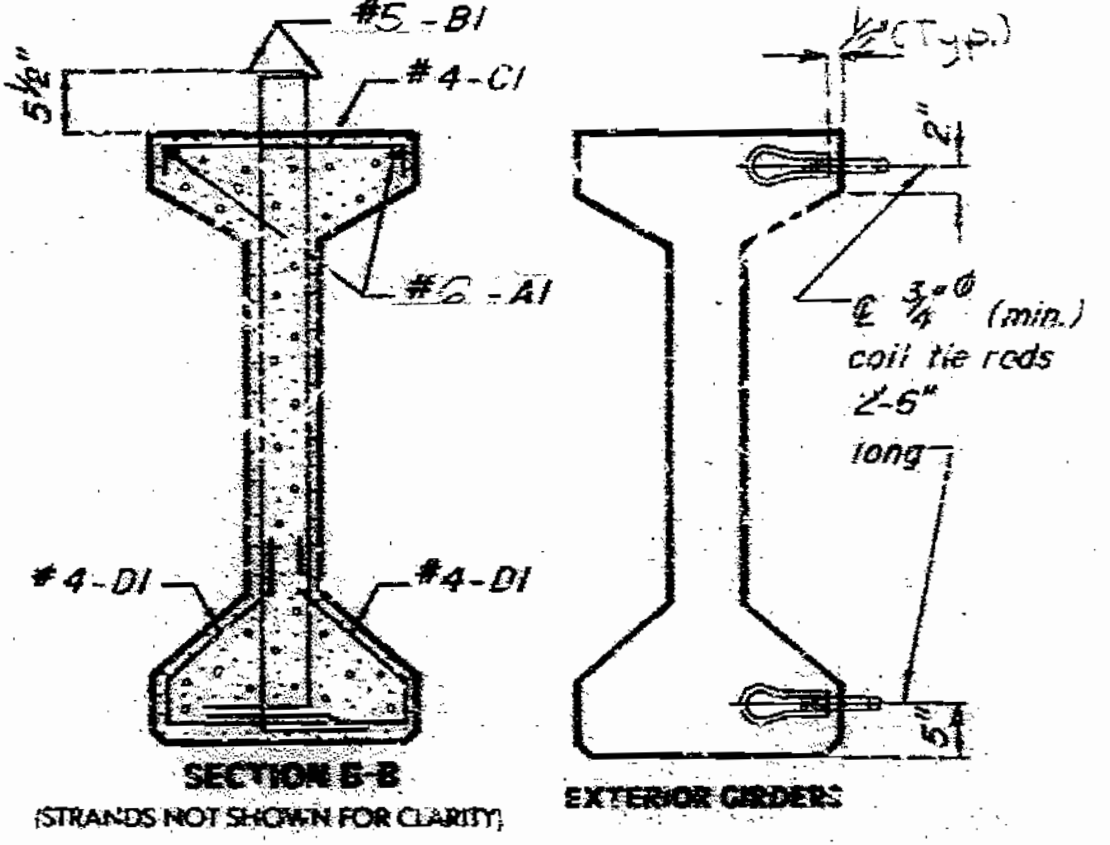

DETAILS OF COIL TIES AT INT. BENT NO. 14

NOTE:  
 COST OF 3/4" COIL TIE RODS PLACED IN DIAPHRAGMS IS INCLUDED IN CONTRACT UNIT PRICE FOR PRESTRESSED CONCRETE GIRDERS.  
 COIL TIES SHALL BE HELD IN PLACE IN THE FORMS BY SLOTTED WIRE SETTING STUDS PROJECTING THRU FORMS. STUDS ARE TO BE LEFT IN PLACE OR REPLACED WITH TEMPORARY PLUGS UNTIL GIRDERS ARE ERECTED AND THEN REPLACED BY COIL TIE RODS.

NOTE:  
 The 1/2" holes shall be cast in the web for steel intermediate diaphragms. Drilling is not allowed.


REVISED JUN 1987  
 FEB 1974  
 SWS 5658

DATE: MAR 1988  
 CHECKED: OCT 1988





**NOTE:**  
 CONCRETE FOR PRESTRESSED GIRDERS SHALL BE CLASS A1 WITH  $f_c = 6000$  PSI.  
 (+) INDICATES PRESTRESSED STRAND.  
 USE 16 STRANDS WITH AN INITIAL PRESTRESS FORCE OF 498 KIPS.  
 PRESTRESSING TENDONS SHALL BE UNCOATED, SEVEN-WIRE, LOW RELAXATION STRANDS. 1/2 INCH DIAMETER CONFORMING TO A.A.S.H.T.O. M203, GRADE 270. SEE MO. STD. SPECIFICATIONS 705.4.2.  
 3/4" bevel not required

STATE	PROJ. NO.	SHEET NO.
MO		120

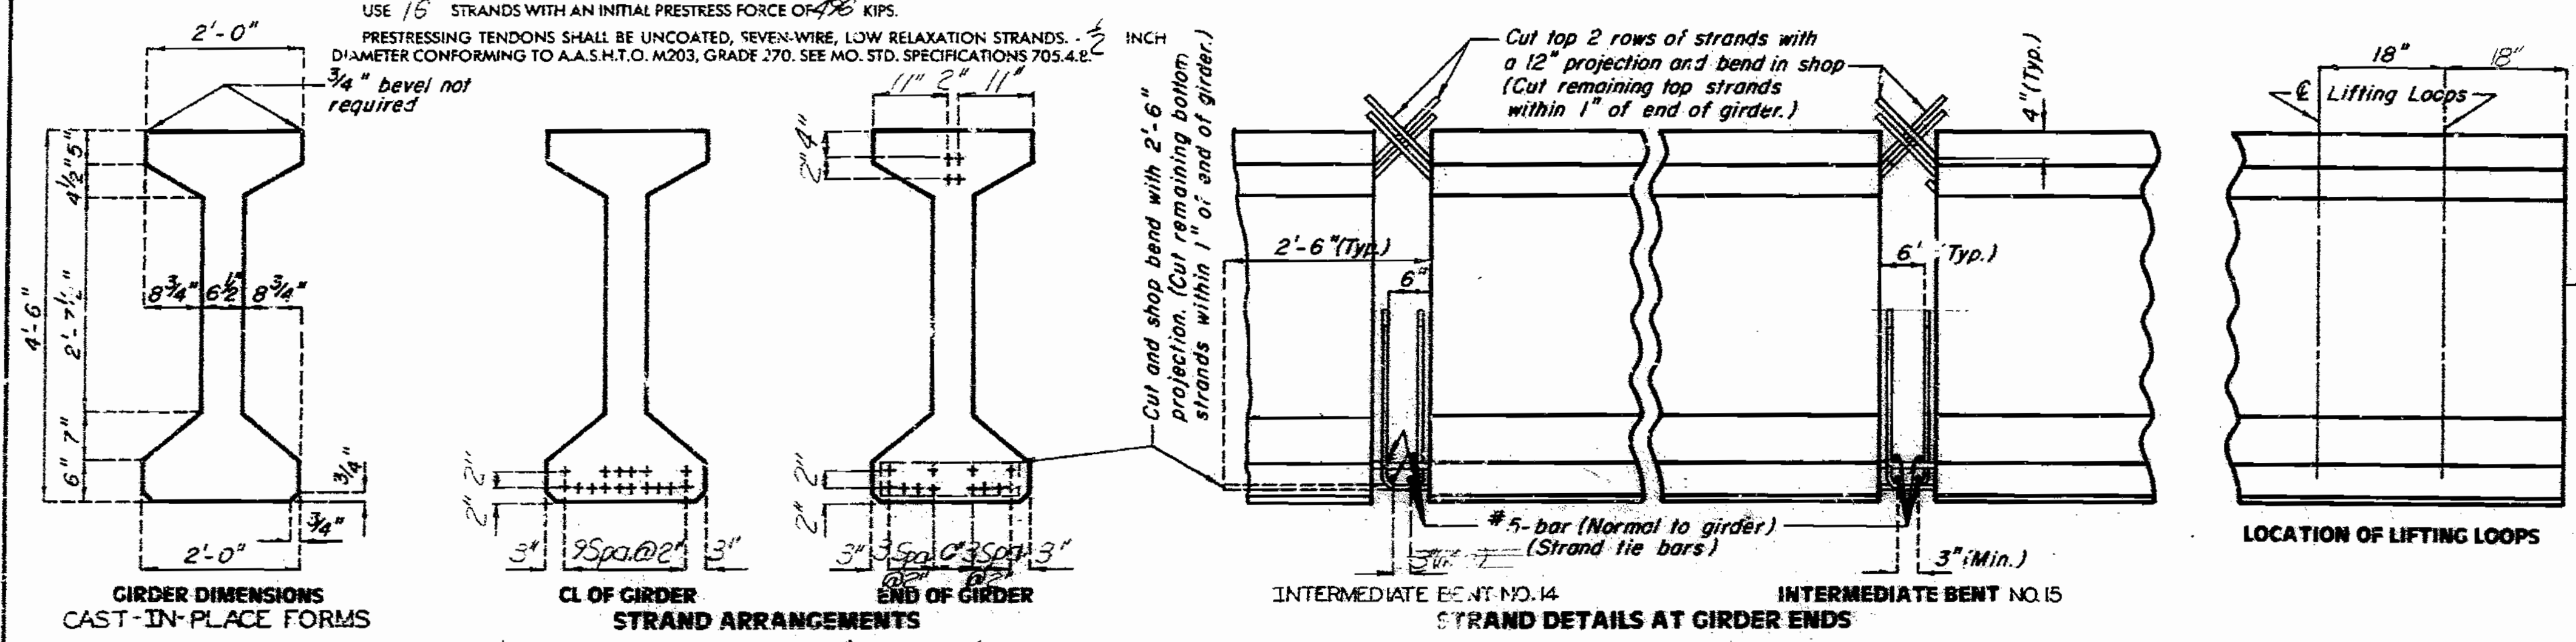

**NOTE:**  
 ALL DIMENSIONS IN BENDING DIAGRAM ARE OUT TO OUT.  
 HOOKS AND BENDS SHALL BE IN ACCORDANCE WITH THE CRSI MANUAL OF STANDARD PRACTICE FOR DETAILING REINFORCED CONCRETE STRUCTURES STRIPPED AND TIE DIMENSIONS.  
 ACTUAL LENGTHS ARE MEASURED ALONG CENTERLINE BAR TO THE NEAREST INCH.  
 MINIMUM CLEARANCE TO REINFORCING SHALL BE 1".  
 ALL REINFORCEMENT SHALL BE GRADE 60.  
 THE TWO D1 BARS MAY BE FURNISHED AS ONE BAR AT THE FABRICATOR'S OPTION.

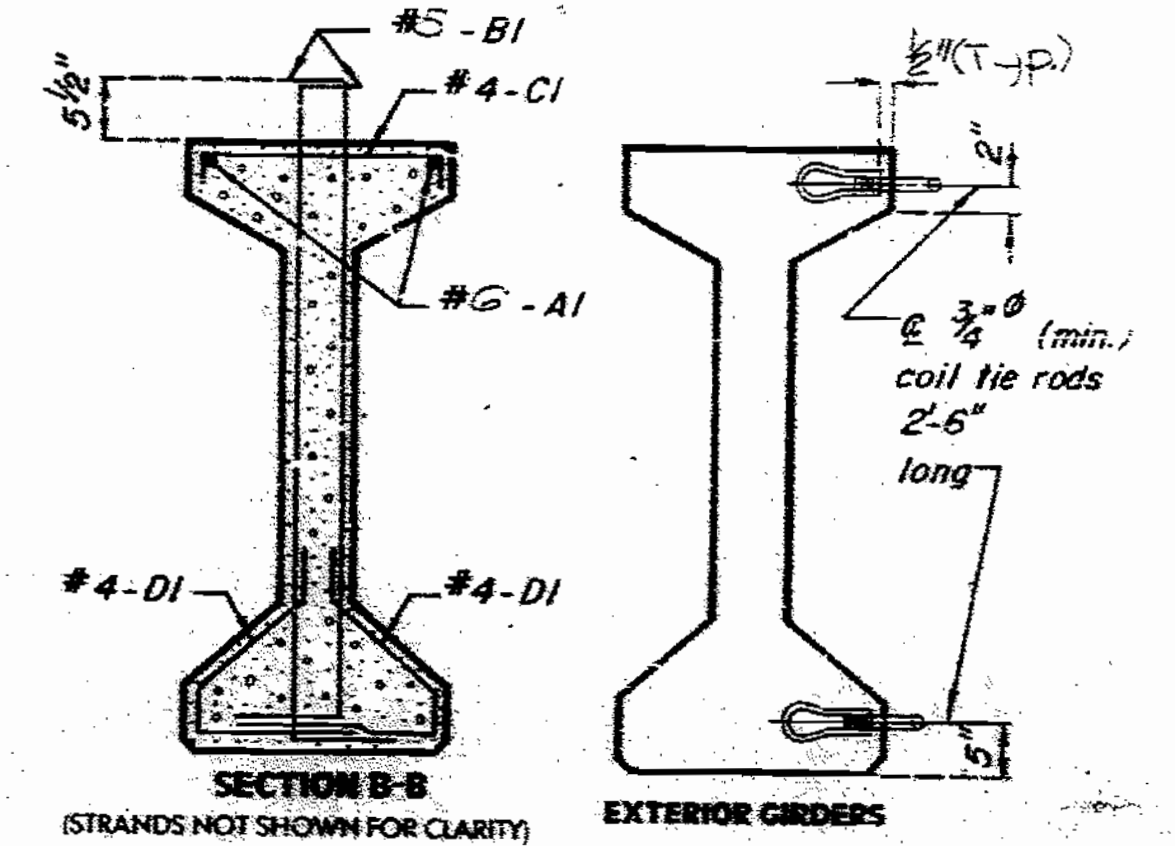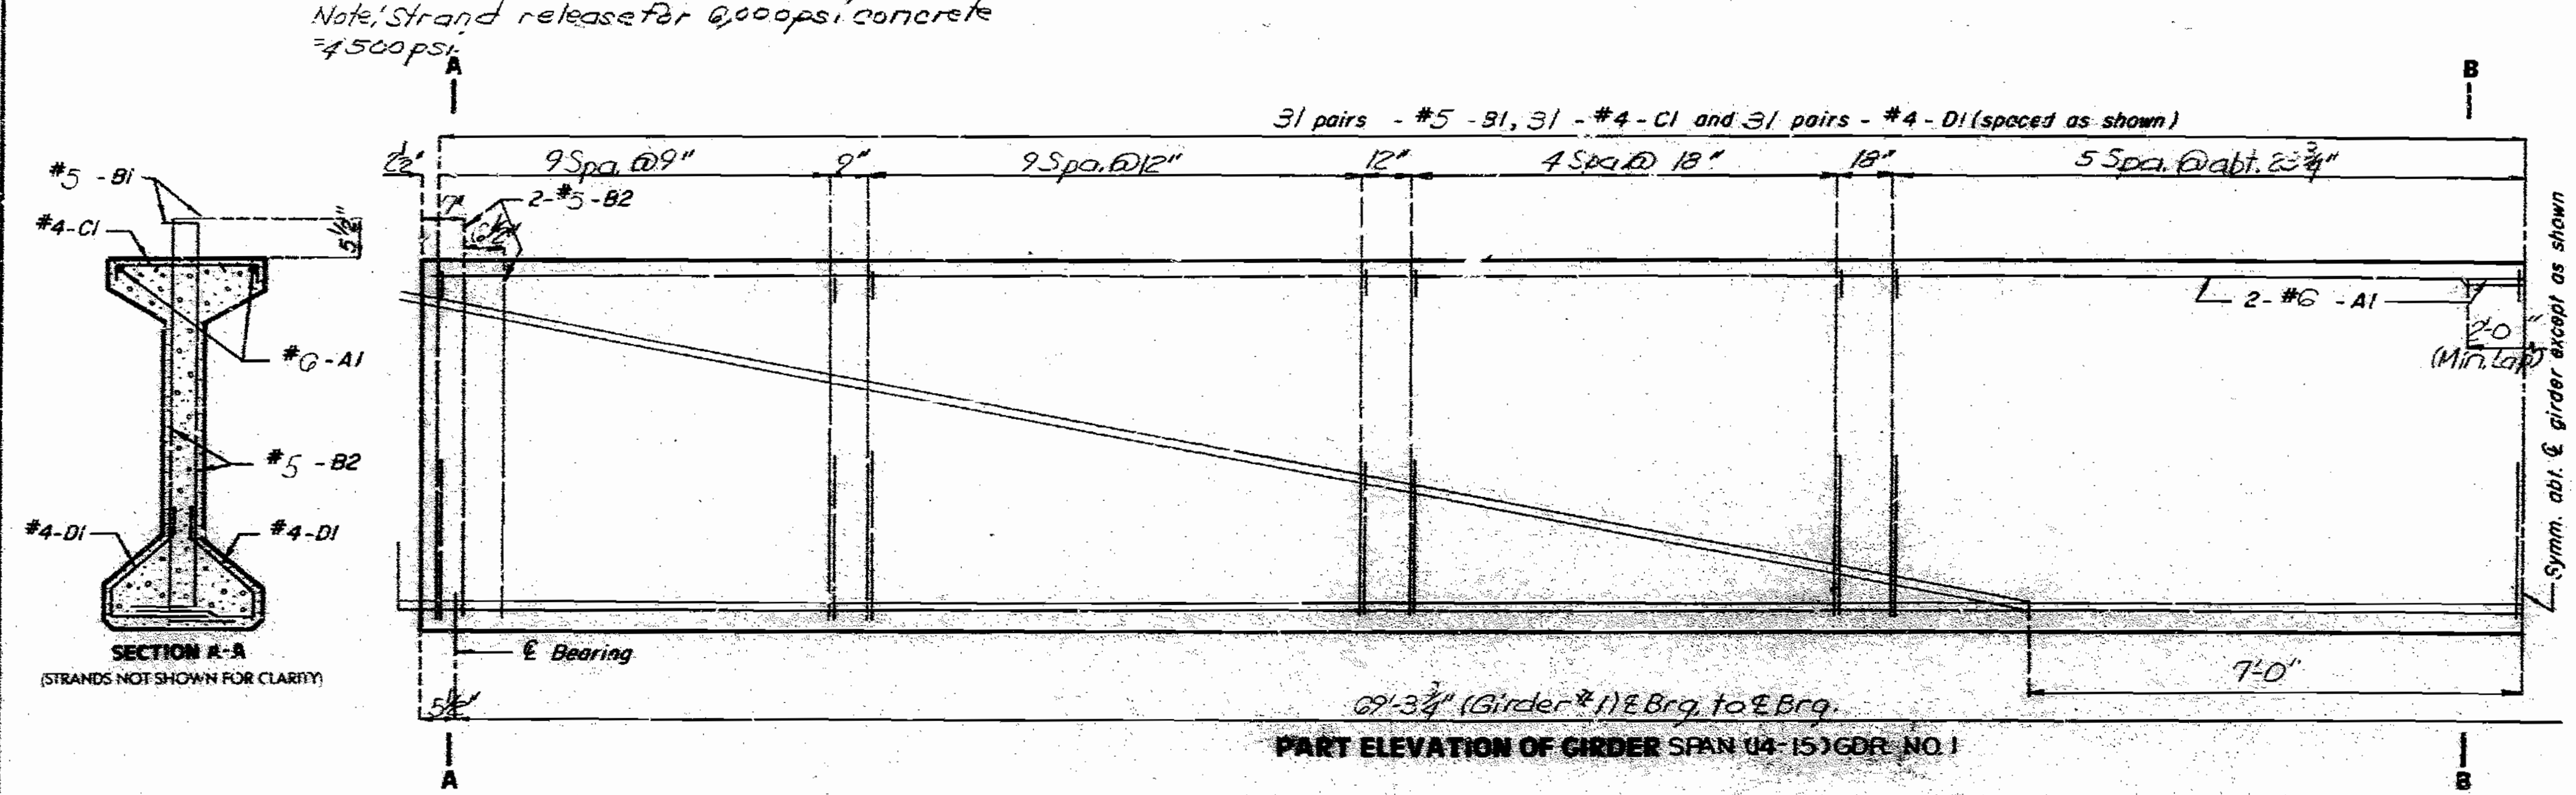


**DETAILS OF COIL TIES**

**NOTE:**  
 COST OF 3/4" COIL TIE RODS PLACED IN DIAPHRAGMS IS INCLUDED IN CONTRACT UNIT PRICE FOR PRESTRESSED CONCRETE MEMBERS.  
 COIL TIES SHALL BE HELD IN PLACE IN THE FORMS BY SLOTTED WIRE SETTING STUDS PROJECTING THRU FORMS. STUDS ARE TO BE LEFT IN PLACE OR REPLACED WITH TEMPORARY PLUGS UNTIL GIRDERS ARE ERECTED AND THEN REPLACED BY COIL TIE RODS.

**NOTE:**  
 The 1/2" holes shall be cast in the web for steel intermediate diaphragms. Drilling is not allowed.

Note: For details of Int. Bt. Diaph. see sheet No. 66 & 146?  
 For location of Int. Diaph. and general girder placement see sheet No. 20.  
 For Girder Camber and haunching see sheet No. 69.

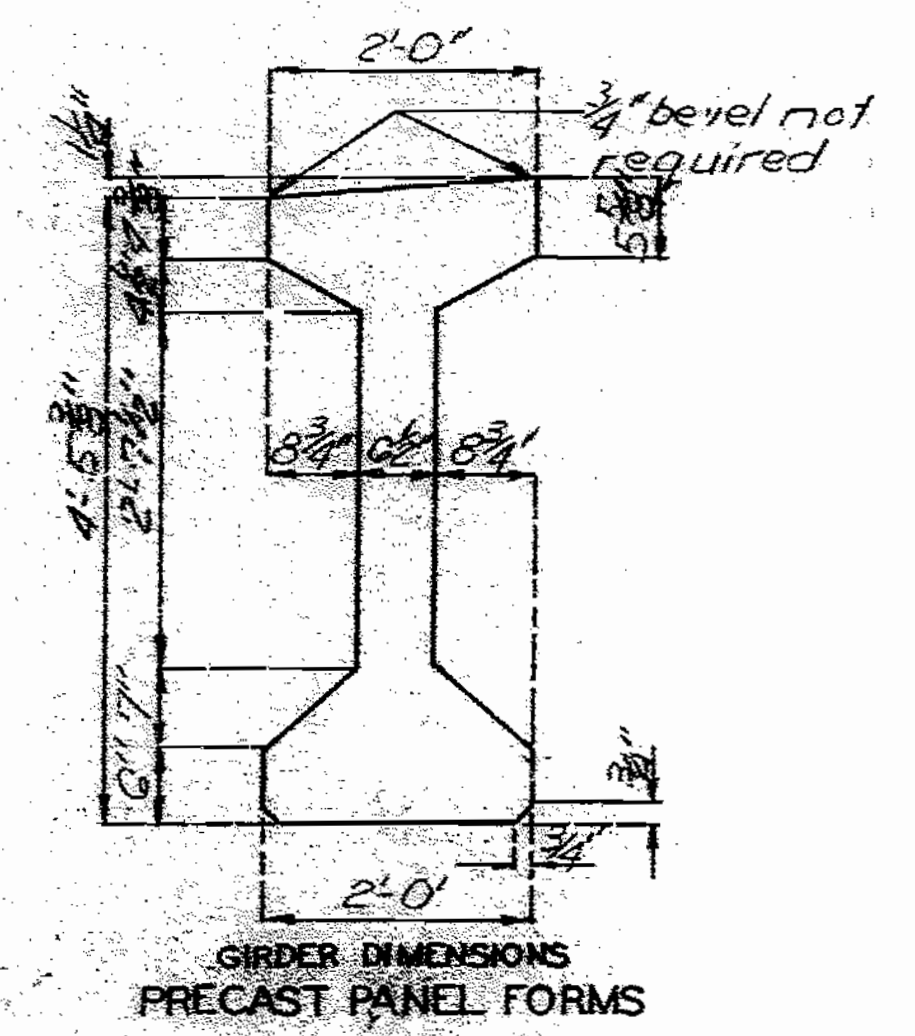

168 144

SPS 53.6.6/2 REVISED FEB 1974 JUNE 1987

DETAILED APR. 1988  
 CHECKED OCT. 1988

Note: This drawing is not to scale. Follow dimensions.

Sheet No. 46 of 98


JACKSON COUNTY

A-2745


STATE	PROJ NO	SHEET NO
MO		127

NOTE:


CONCRETE FOR PRESTRESSED GIRDERS SHALL BE CLASS A1 WITH  $f_c = 6000$  PSI.  
 (+) INDICATES PRESTRESSED STRAND.  
 USE 18 STRANDS WITH AN INITIAL PRESTRESS FORCE OF 558 KIPS.  
 PRESTRESSING TENDONS SHALL BE UNCOATED, SEVEN-WIRE, LOW RELAXATION STRANDS OF  
 DIAMETER CONFORMING TO A.A.S.H.T.O. M203, GRADE 270. SEE MO STD. SPECIFICATIONS 705.4.8.

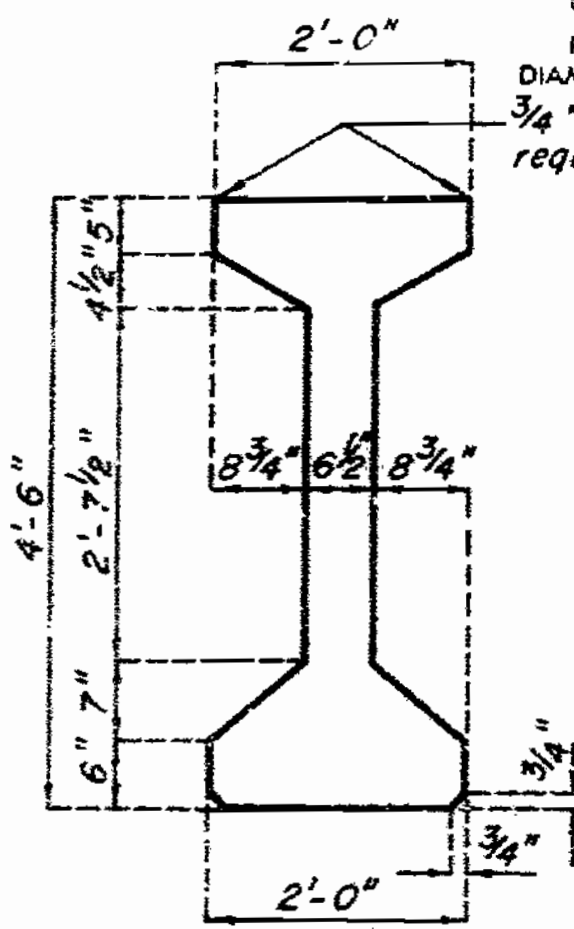


GIRDER DIMENSIONS  
CAST-IN-PLACE FORMS

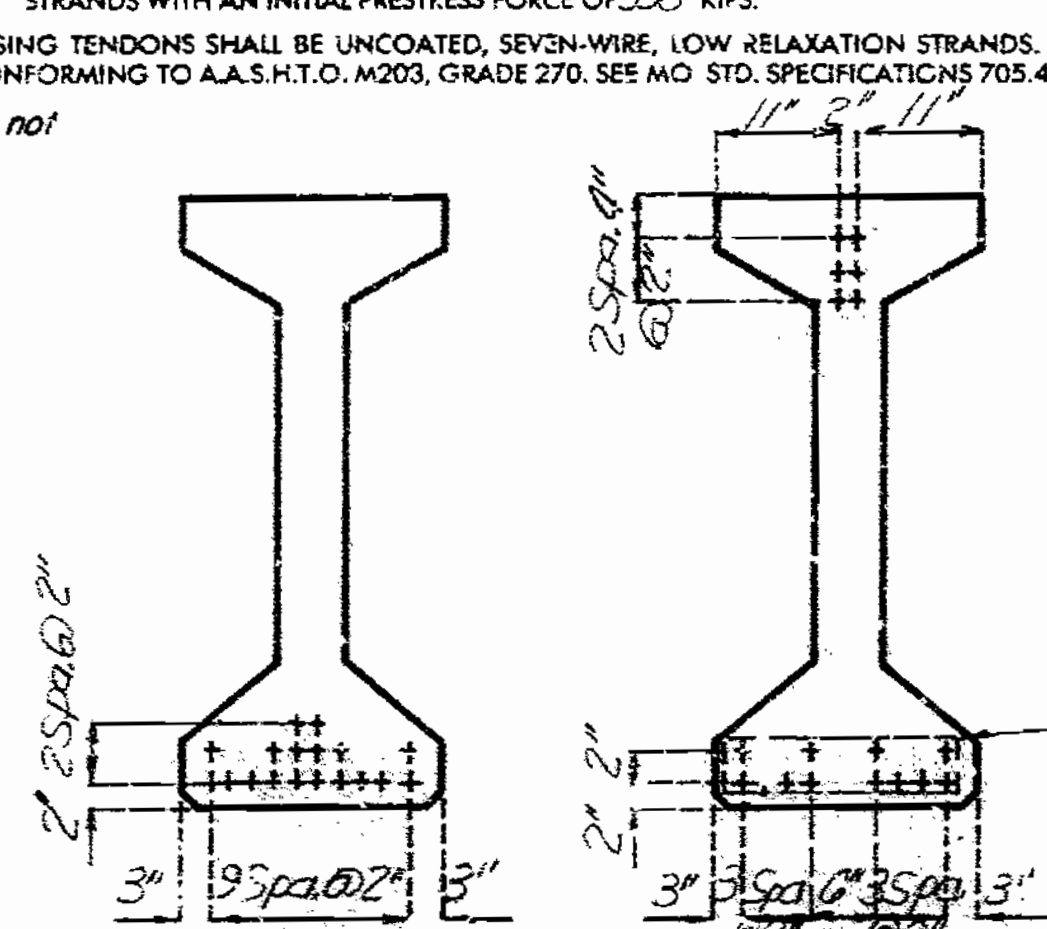

CL OF GIRDER  
STRAND ARRANGEMENTS  
END OF GIRDER

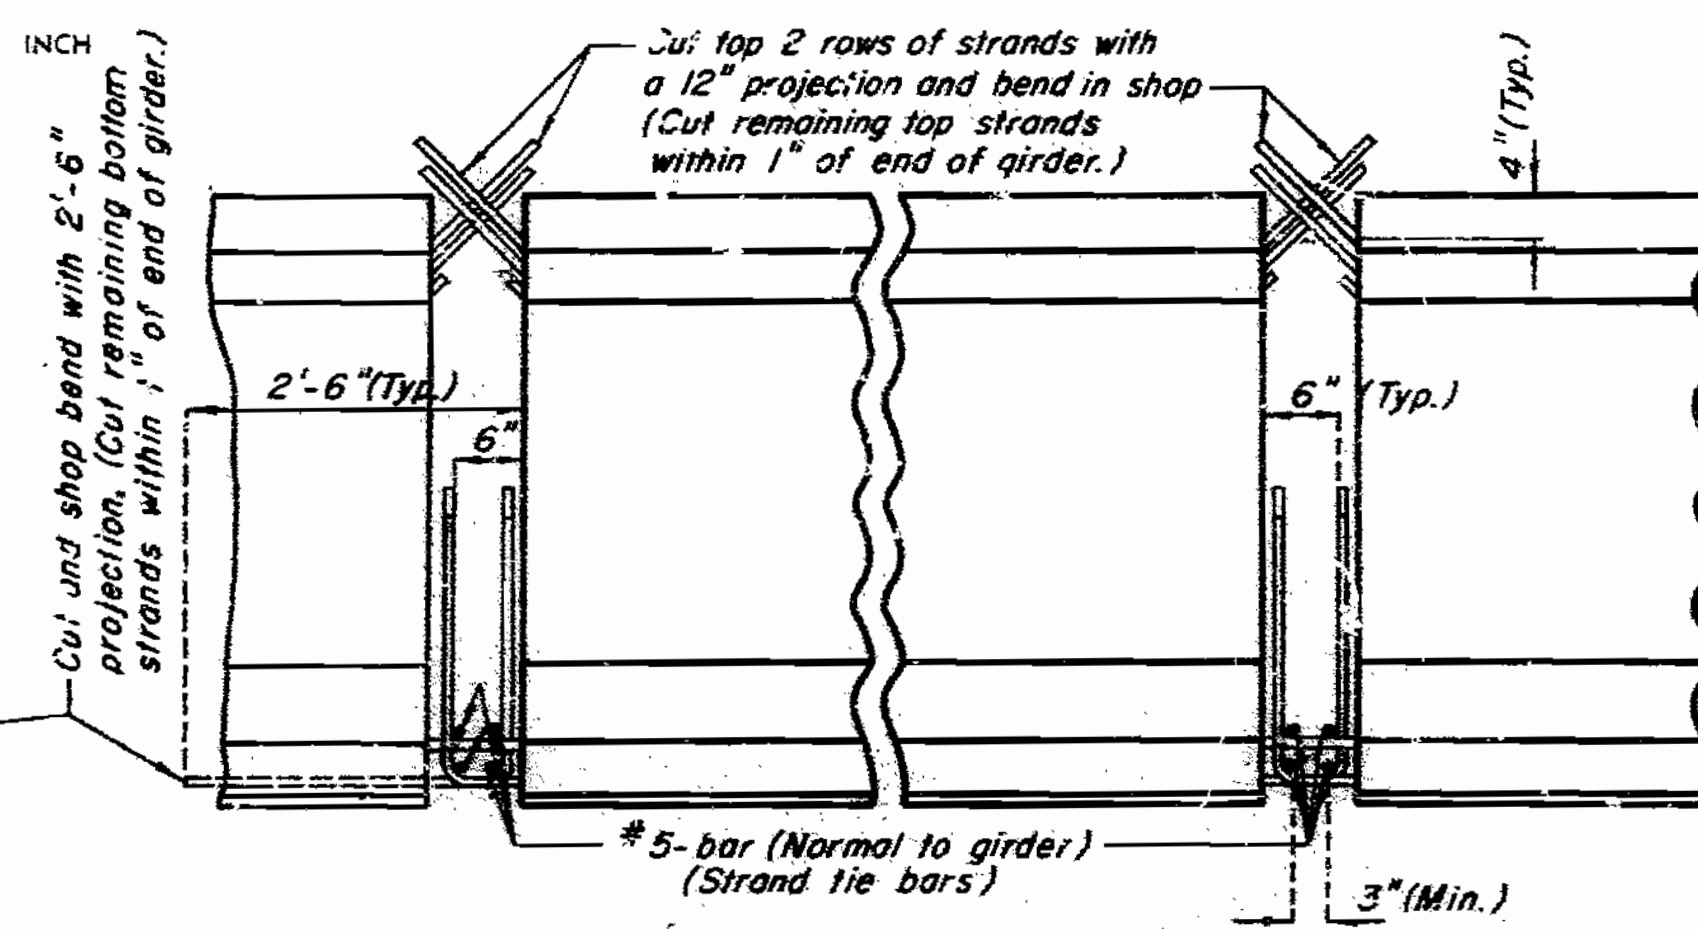

INTERMEDIATE BENT NO. 14  
STRAND DETAILS AT GIRDER ENDS  
INTERMEDIATE BENT NO. 15

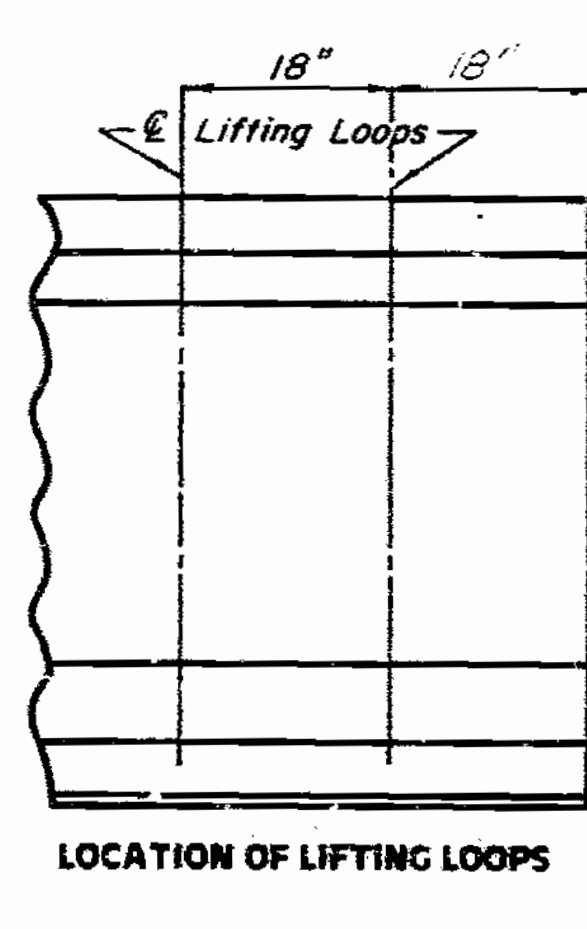


LOCATION OF LIFTING LOOPS

BILL OF REINFORCING STEEL - EACH GIRDER				BENDING DIAGRAMS	
NO.	SIZE & MARK	ACTUAL LENGTH	SHAPE		
4	6 A1	33'-3"	20	SHAPE 10	SHAPE 11
130	5 B1	5'-11"	11		
8	5 B2	5'-4"	11	SHAPE 9	SHAPE 11
25	4 C1	2'-2"	10		
130	4 D1	3'-0"	9		


NOTE:

ALL DIMENSIONS IN BENDING DIAGRAM ARE OUT TO OUT.  
 HOOKS AND BENDS SHALL BE IN ACCORDANCE WITH THE CRS; MANUAL OF STANDARD PRACTICE FOR DETAILING REINFORCED CONCRETE STRUCTURES STIRRUP AND TIE DIMENSIONS.  
 ACTUAL LENGTHS ARE MEASURED ALONG CENTERLINE BAR TO THE NEAREST INCH.  
 MINIMUM CLEARANCE TO REINFORCING SHALL BE 1".  
 ALL REINFORCEMENT SHALL BE GRADE 60.  
 THE TWO D1 BARS MAY BE FURNISHED AS ONE BAR AT THE FABRICATOR'S OPTION.


Note: strand release for 6000psi concrete = 4500 psi.

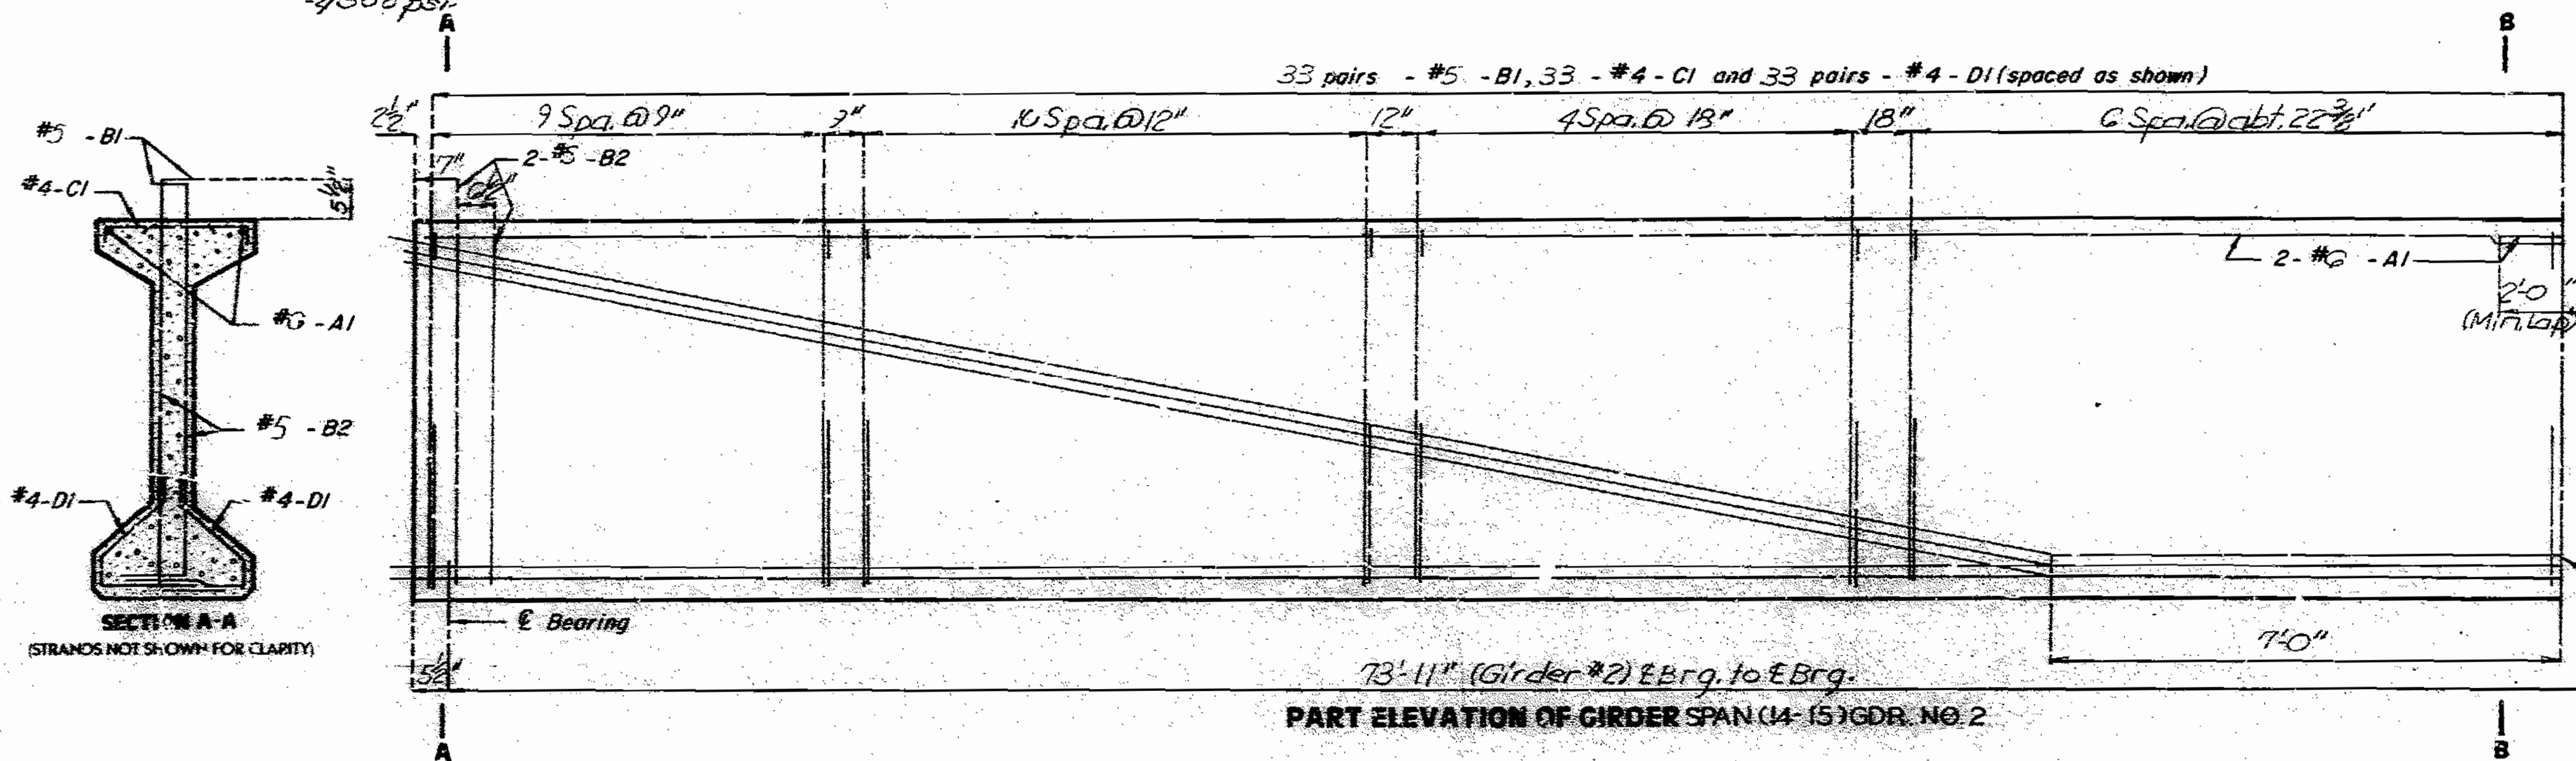

PART ELEVATION OF GIRDER SPAN (4-15) GDR. NO. 2

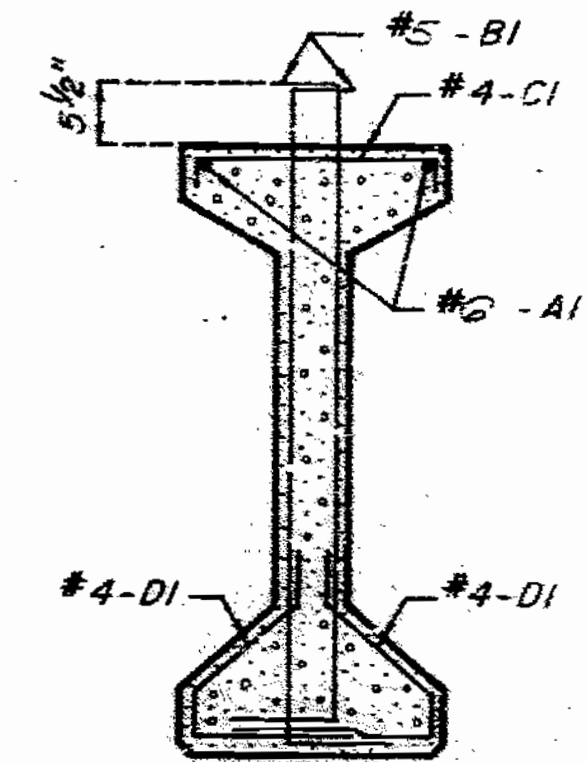

SECTION A-A  
STRANDS NOT SHOWN FOR CLARITY

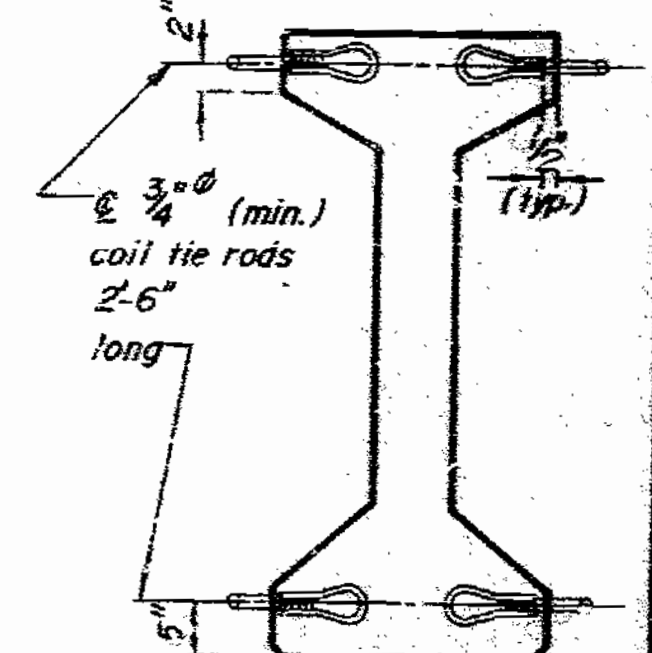

DETAILS OF COIL TIES


NOTE:

COST OF 3/4" COIL TIE RODS PLACED IN DIAPHRAGMS IS INCLUDED IN CONTRACT UNIT PRICE FOR PRESTRESSED CONCRETE MEMBERS.  
 COIL TIES SHALL BE HELD IN PLACE IN THE FORMS BY SLOTTED WIRE-SETTING STUDS PROJECTING THRU FORMS. STUDS ARE TO BE LEFT IN PLACE OR REPLACED WITH TEMPORARY PLUGS UNTIL GIRDERS ARE ERECTED AND THEN REPLACED BY COIL TIE RODS.

NOTE:

The 1/2" holes shall be cast in the web for steel intermediate diaphragms. Drilling is not allowed.

Note: for details of Int. Bt. Diaph. see sheet No. 66 & No. 67.  
 for location of Int. Diaph. and general girder placement, see sheet No. 26.  
 for Girder Camber and haunching see sheet No. 69.

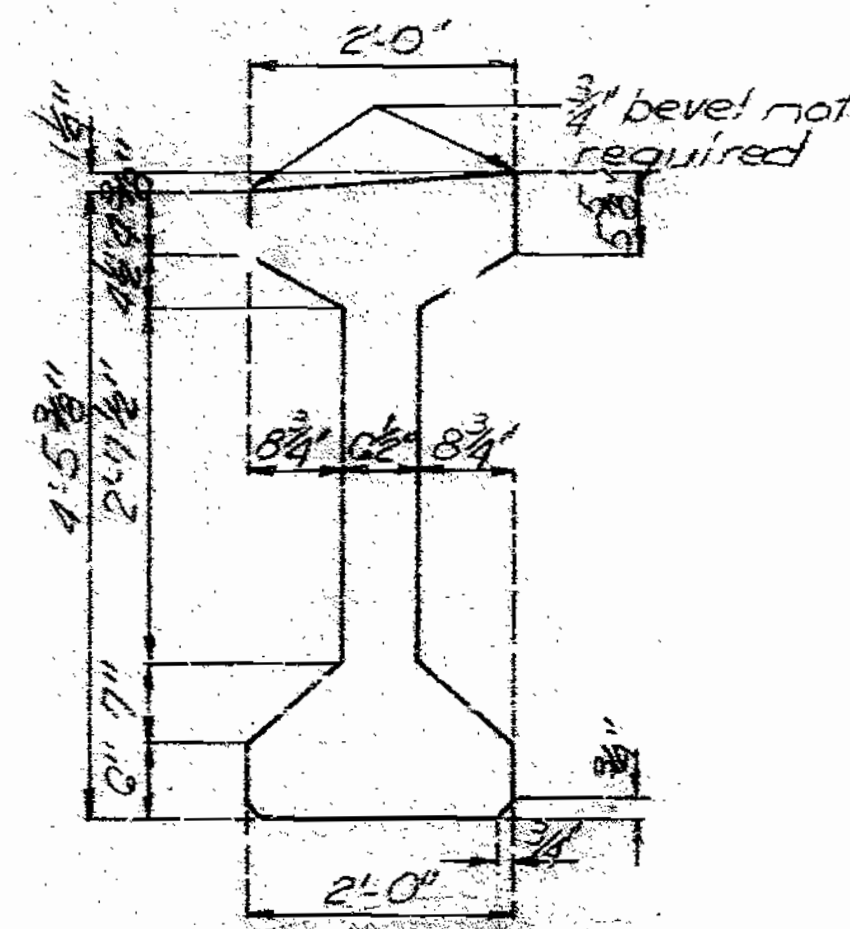

GIRDER DIMENSIONS  
PRECAST PANEL FORMS

768-148

SPS 55.6.6 1/2  
REVISED  
FEB. 1974  
JUNE 1987

DETAILED APR. 1988  
 CHECKED OCT. 1988

Note: This drawing is not to scale. Follow dimensions.


Sheet No. 47 of 93

JACKSON COUNTY


A-2745

NOTE:


CONCRETE FOR PRESTRESSED GIRDERS SHALL BE CLASS A1 WITH  $f_c = 6,000$  PSI.  
 (+) INDICATES PRESTRESSED STRAND.  
 USE 20 STRANDS WITH AN INITIAL PRESTRESS FORCE OF 620 KIPS  
 PRESTRESSING TENDONS SHALL BE UNCOATED, SPIN-WIRE, LOW RELAXATION STRANDS - 1/2 INCH DIAMETER CONFORMING TO A.A.S.H.T.O. M203, GRADE 270. SEE M.C. STD. SPECIFICATIONS 705.4.8.  
 3/4" bevel not required

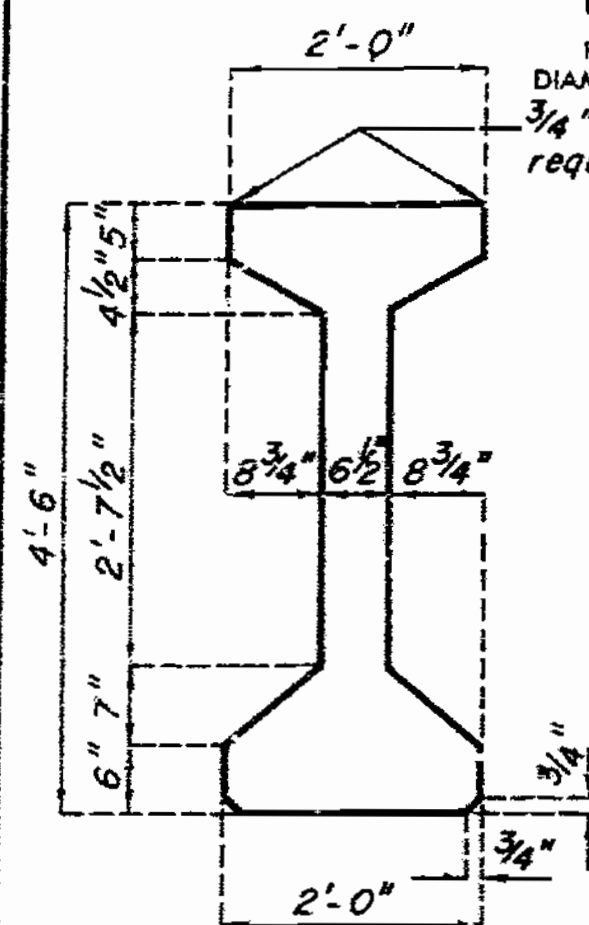

GIRDER DIMENSIONS  
CAST-IN-PLACE FORMS

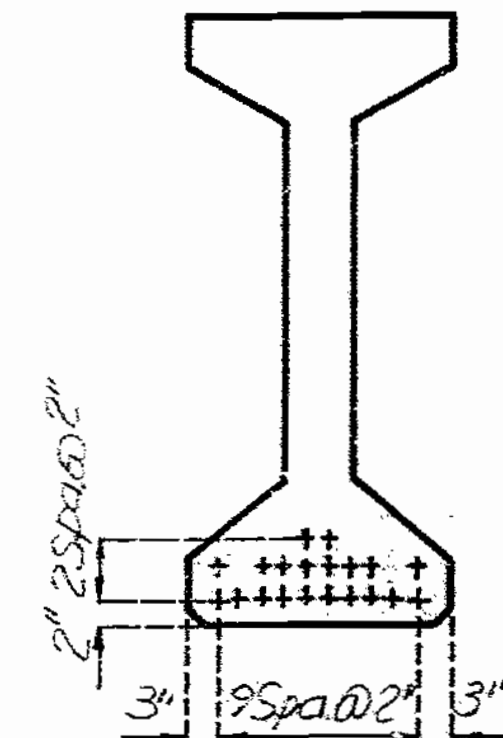


CL OF GIRDER  
STRAND ARRANGEMENTS

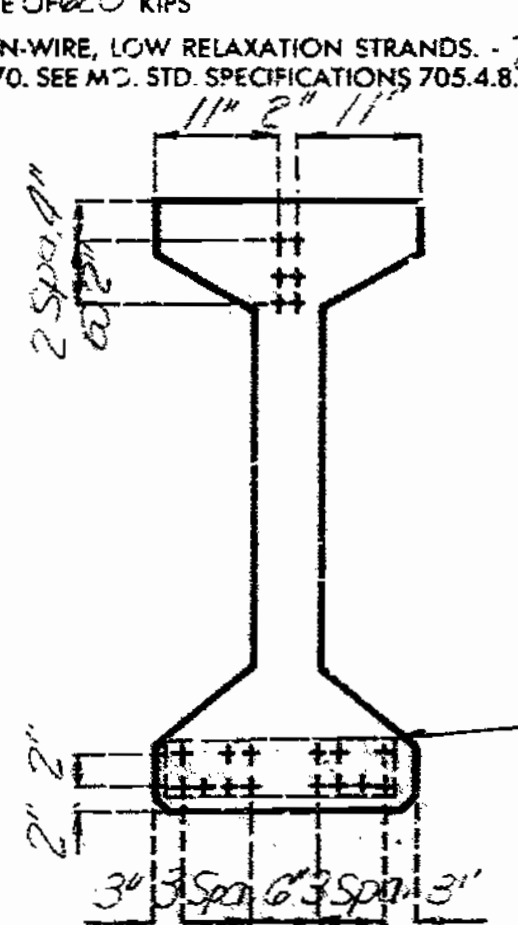


END OF GIRDER

Cut and shop bend with 2'-6" projection. (Cut remaining bottom strands within 1' of end of girder.)

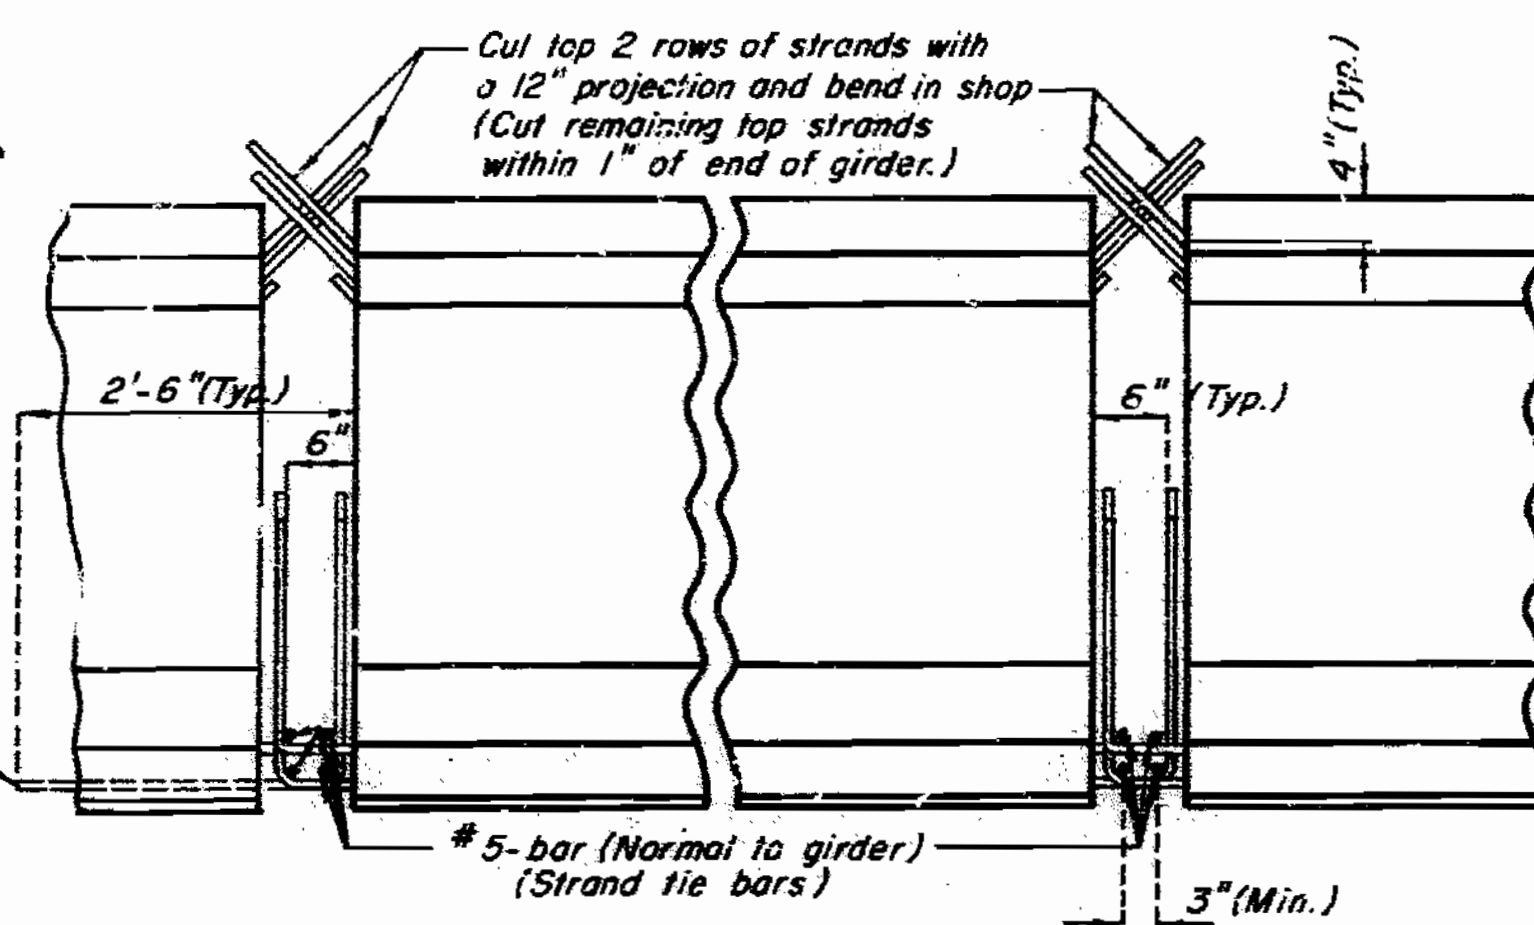

INTERMEDIATE BENT NO. 14  
INTERMEDIATE BENT NO. 15  
STRAND DETAILS AT GIRDER ENDS

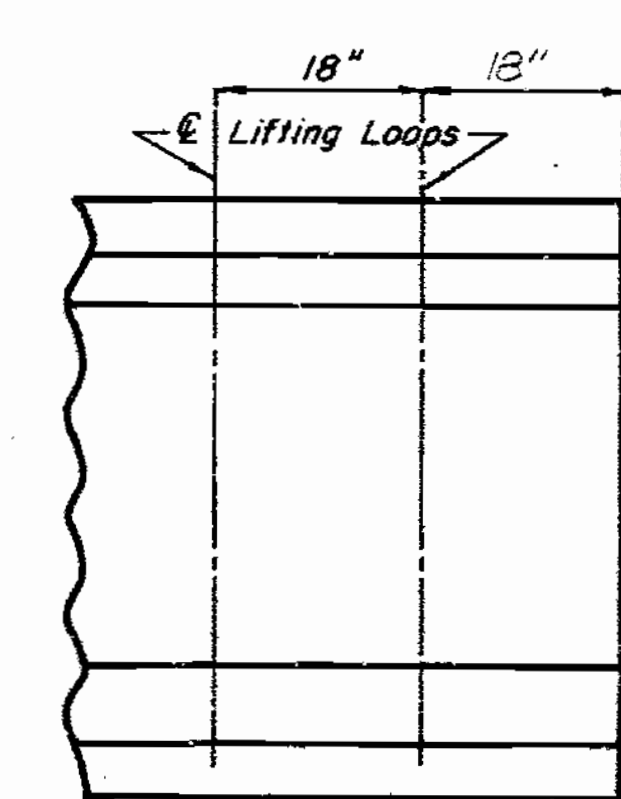


LOCATION OF LIFTING LOOPS


BILL OF REINFORCING STEEL - EACH GIRDER				BENDING DIAGRAMS	
NO.	SIZE & MARK	ACTUAL LENGTH	SHAPE		
4	G A1	40'-8"	20	SHAPE 10	SHAPE 11
138	S B1	5'-11"	11		
8	G B2	5'-4"	11	SHAPE 9	SHAPE 20
67	4 C1	2'-2"	10		
138	4 D1	3'-0"	9		

NOTE:  
 ALL DIMENSIONS IN BENDING DIAGRAM ARE OUT TO OUT.  
 HOOKS AND BENDS SHALL BE IN ACCORDANCE WITH THE CIP MANUAL OF STANDARD PRACTICE FOR DETAILING REINFORCED CONCRETE STRUCTURES STIRRUP AND THE DIMENSIONS.  
 ACTUAL LENGTHS ARE MEASURED ALONG CENTERLINE BAR TO THE NEAREST INCH.  
 MINIMUM CLEARANCE TO REINFORCING SHALL BE 1".  
 ALL REINFORCEMENT SHALL BE GRADE 60.  
 THE TWO D1 BARS MAY BE FURNISHED AS ONE BAR AT THE FABRICATOR'S OPTION.


Note: Strand release for 4,000 psi concrete  
 = 4,500 psi.

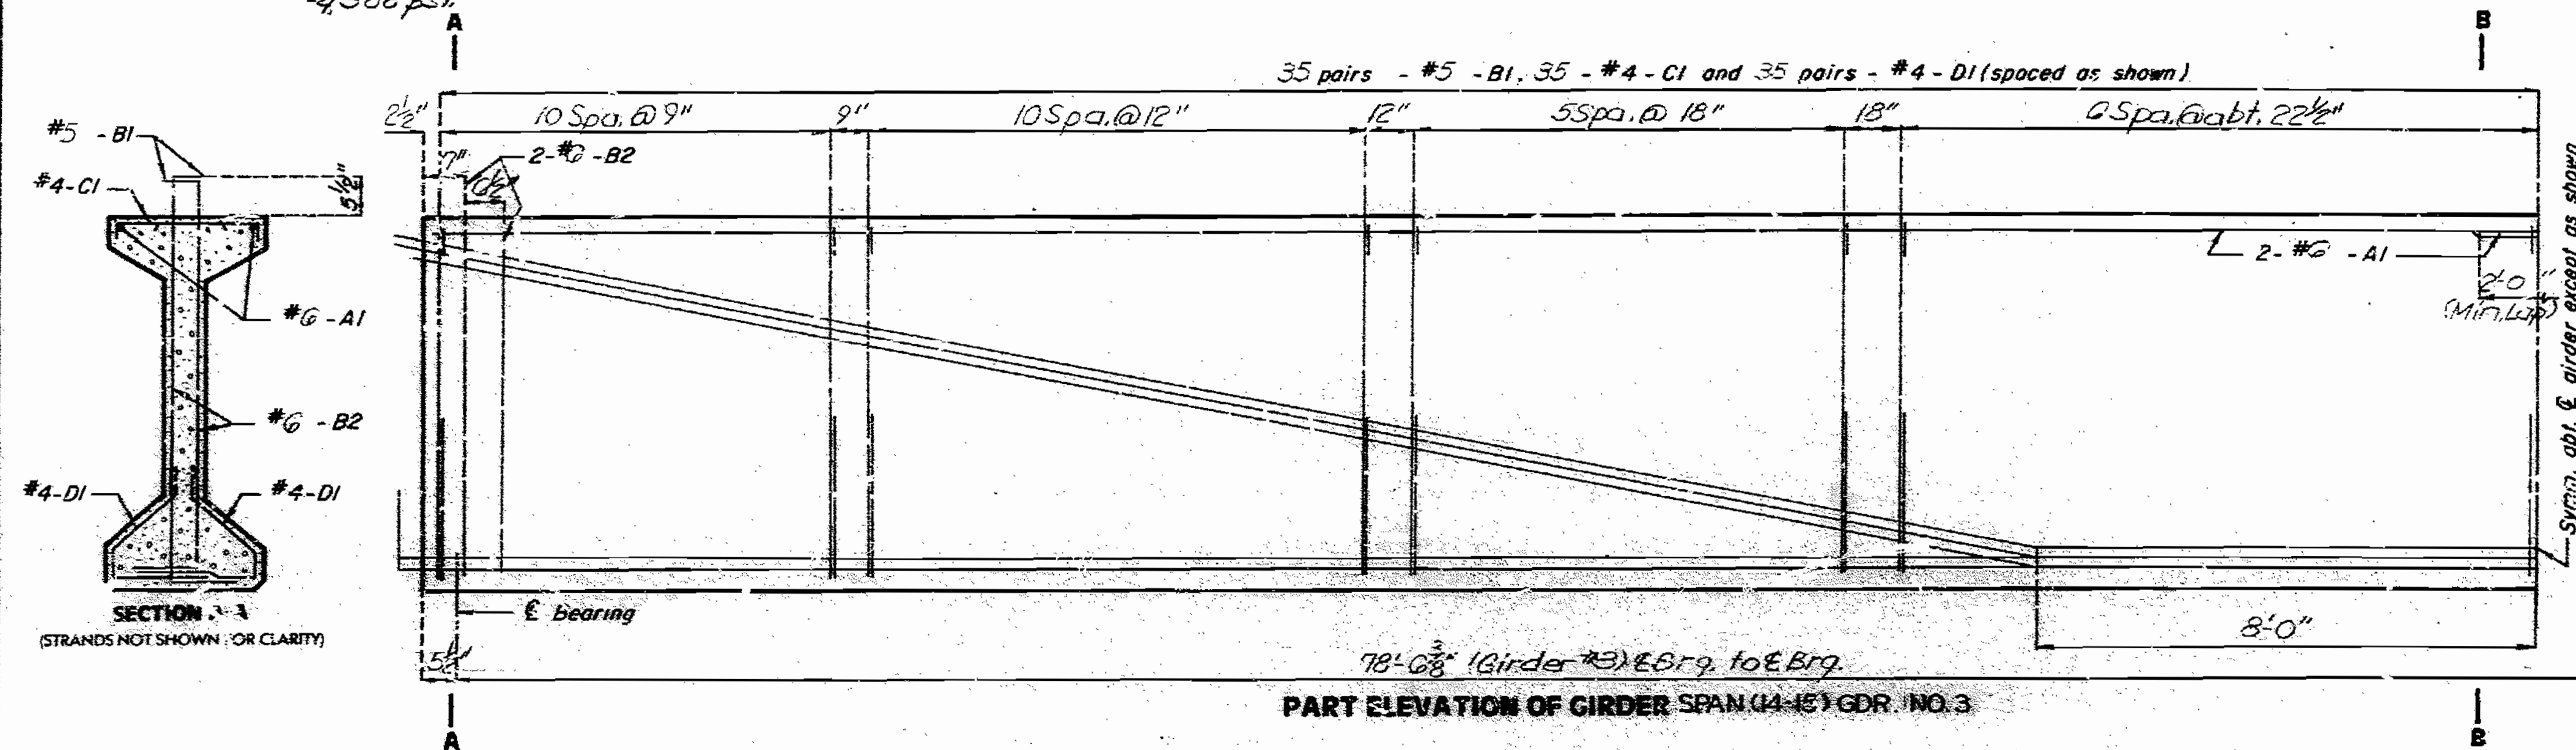


PART ELEVATION OF GIRDER SPAN (14-15) GDR. NO. 3

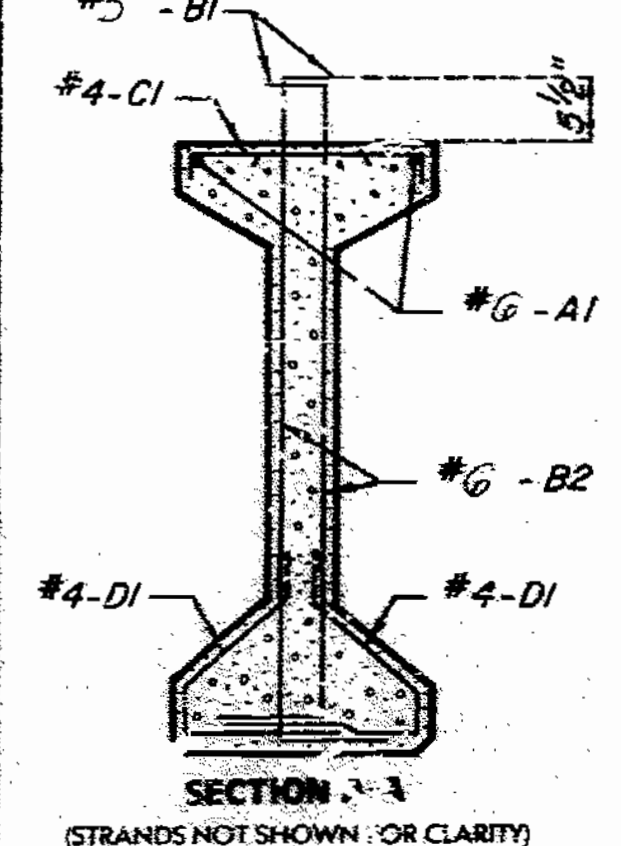

SECTION A-A  
(STRANDS NOT SHOWN FOR CLARITY)

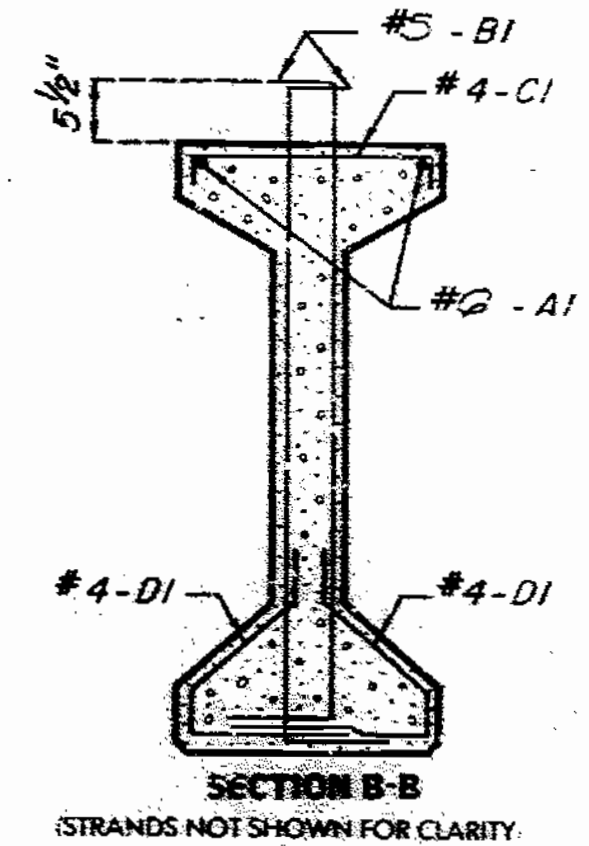


SECTION B-B  
(STRANDS NOT SHOWN FOR CLARITY)

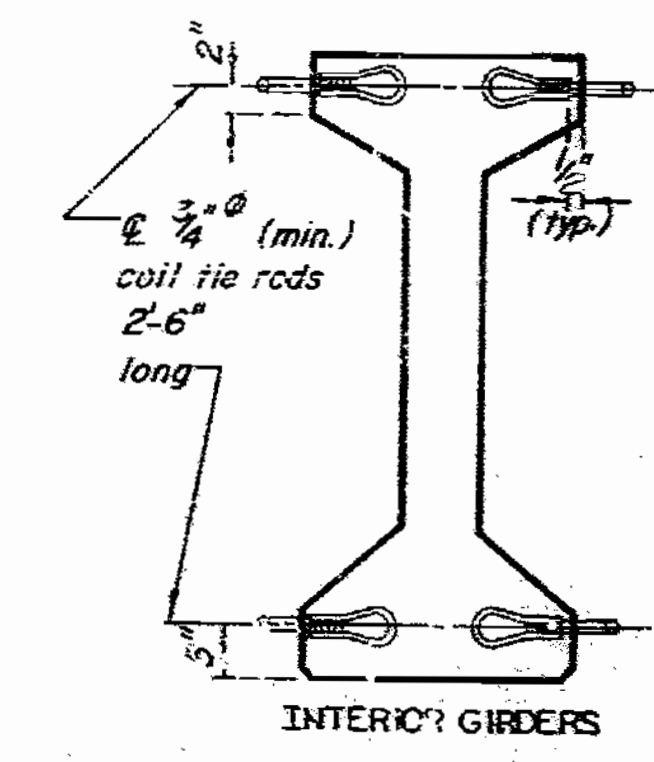

DETAILS OF COIL TIES

NOTE:  
 COST OF 3/4" COIL TIE RODS PLACED IN DIAPHRAGMS IS INCLUDED IN CONTRACT UNIT PRICE FOR PRESTRESSED CONCRETE MEMBERS.  
 COIL TIES SHALL BE HELD IN PLACE IN THE FORMS BY SLOTTED WIRE-SETTING STUDS PROJECTING THRU FORMS. STUDS ARE TO BE LEFT IN PLACE OR REPLACED WITH TEMPORARY PLUGS UNTIL GIRDERS ARE ERECTED AND THEN REPLACED BY COIL TIE RODS.  
 NOTE:  
 The 1/2" holes shall be cast in the web for steel intermediate diaphragms. Drilling is not allowed.

Note: For details of Int. St. Diaph. see sheet No. 66 & No. 67.  
 For location of Int. Diaph. and general girder placement, see sheet No. 26.  
 For girder camber and launching see sheet No. 63.

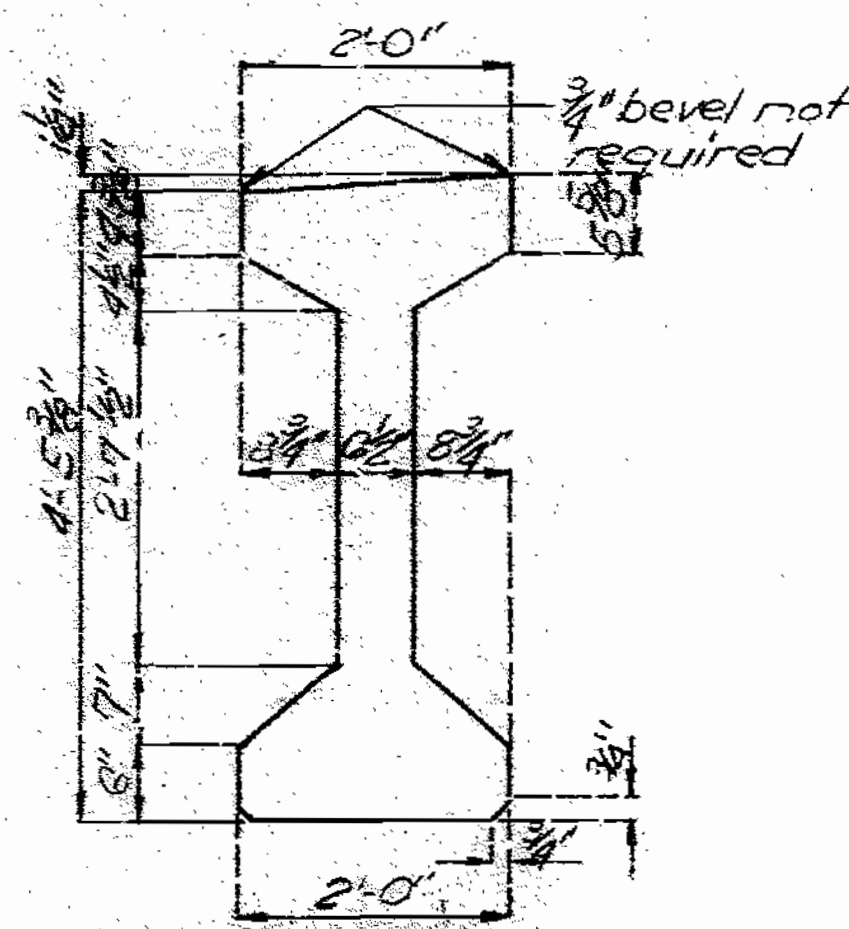

GIRDER DIMENSIONS  
PRECAST PANEL FORMS

Handwritten notes and signatures on the left side of the drawing.

SPS 55.6.6 1/2  
 FEB. 1974  
 REVISED  
 JUN. 1987

DETAILED APR. 1988  
 CHECKED OCT. 1988

Note: This drawing is not to scale. Follow dimensions.


Sheet No. 48 of 98

JACKSON COUNTY

A-2745



STATE	PROJ. NO.	SHEET NO.
MO		129

**NOTE:**  
 CONCRETE FOR PRESTRESSED GIRDERS SHALL BE CLASS A1 WITH  $P_c = 6,000$  PSI.  
 (+) INDICATES PRESTRESSED STRAND.  
 USE 22 STRANDS WITH AN INITIAL PRESTRESS FORCE OF 682 KIPS.  
 PRESTRESSING TENDONS SHALL BE UNCOATED, SEVEN-WIRE, LOW RELAXATION STRANDS. - 1/2 INCH DIAMETER CONFORMING TO A.A.S.H.T.O. M203, GRADE 270. SEE MO. STD. SPECIFICATIONS 705.4.8.  
 3/4" bevel not required

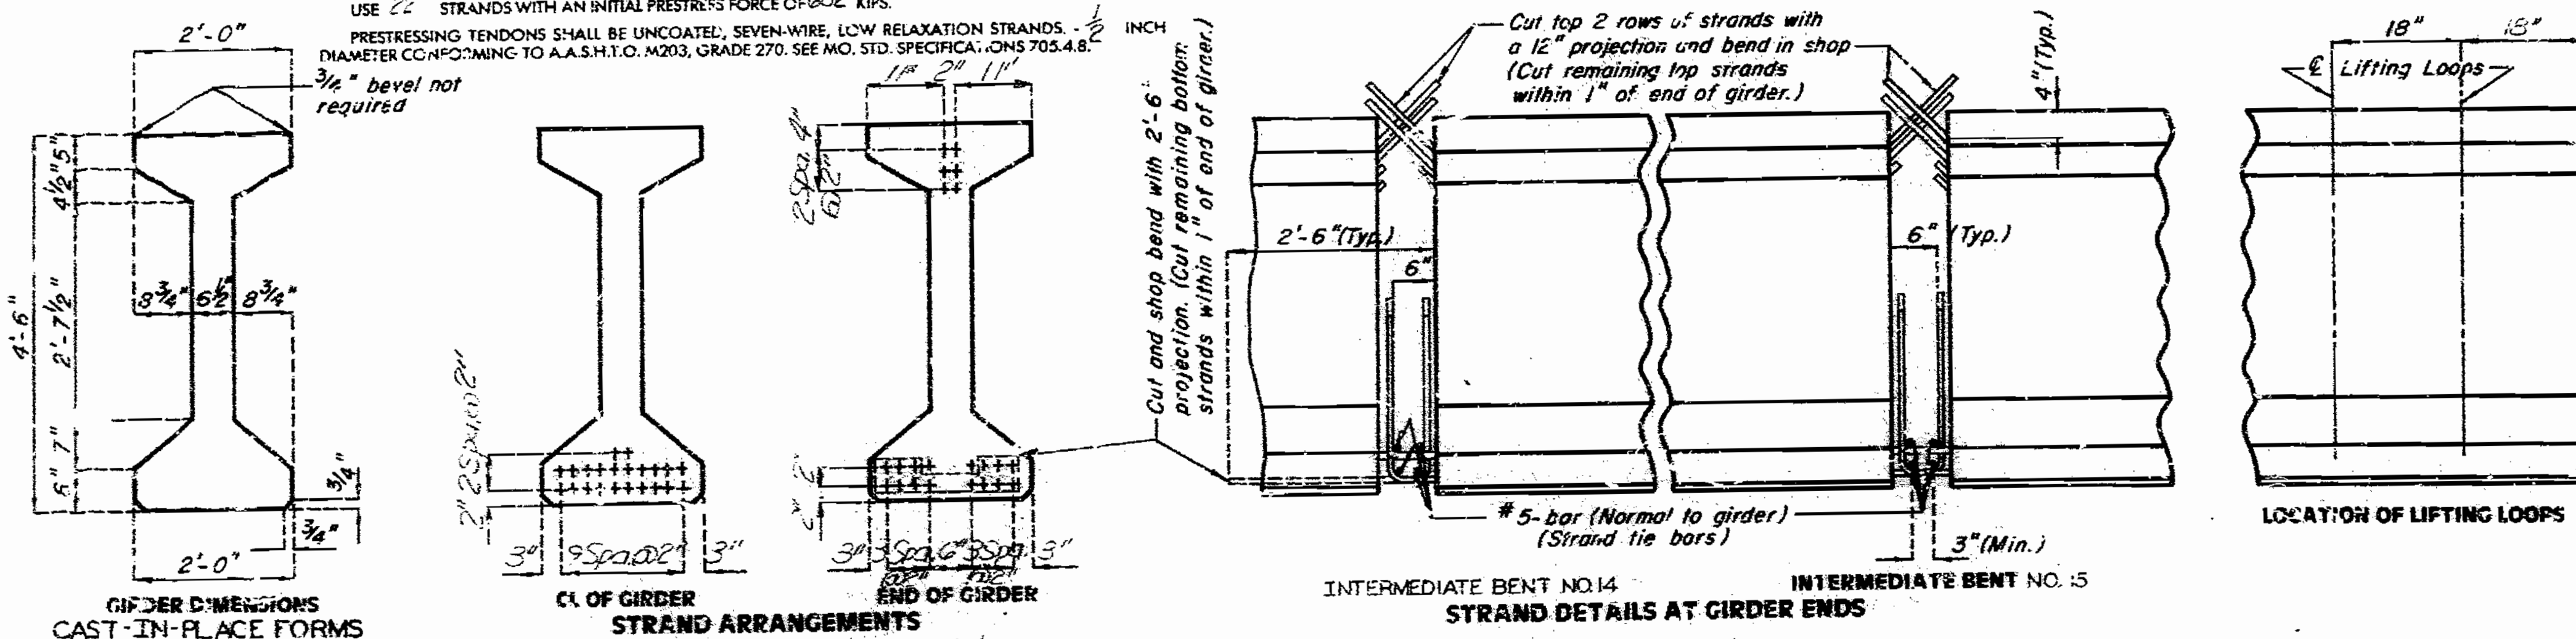

BILL OF REINFORCING STEEL - EACH GIRDER				BENDING DIAGRAMS	
NO.	SIZE & MARK.	ACTUAL LENGTH	SHAPE		
4	6A1	42'-11"	20	SHAPE 10	SHAPE 11
4G	5B1	5'-11"	11		
8	6B2	5'-4"	11	SHAPE 9	SHAPE 11
73	4C1	2'-2"	10		
4G	4D1	3'-0"	9		


**NOTE:**  
 ALL DIMENSIONS IN BENDING DIAGRAM ARE OUT TO OUT.  
 HOOKS AND BENDS SHALL BE IN ACCORDANCE WITH THE CRS. MANUAL OF STANDARD PRACTICE FOR DETAILING REINFORCED CONCRETE STRUCTURES STIRRUP AND THE DIMENSIONS.  
 ACTUAL LENGTHS ARE MEASURED ALONG CENTERLINE BAR TO THE NEAREST INCH.  
 MINIMUM CLEARANCE TO REINFORCING SHALL BE 1".  
 ALL REINFORCEMENT SHALL BE GRADE 60.  
 THE TWO D1 BARS MAY BE FURNISHED AS ONE BAR AT THE FABRICATOR'S OPTION.

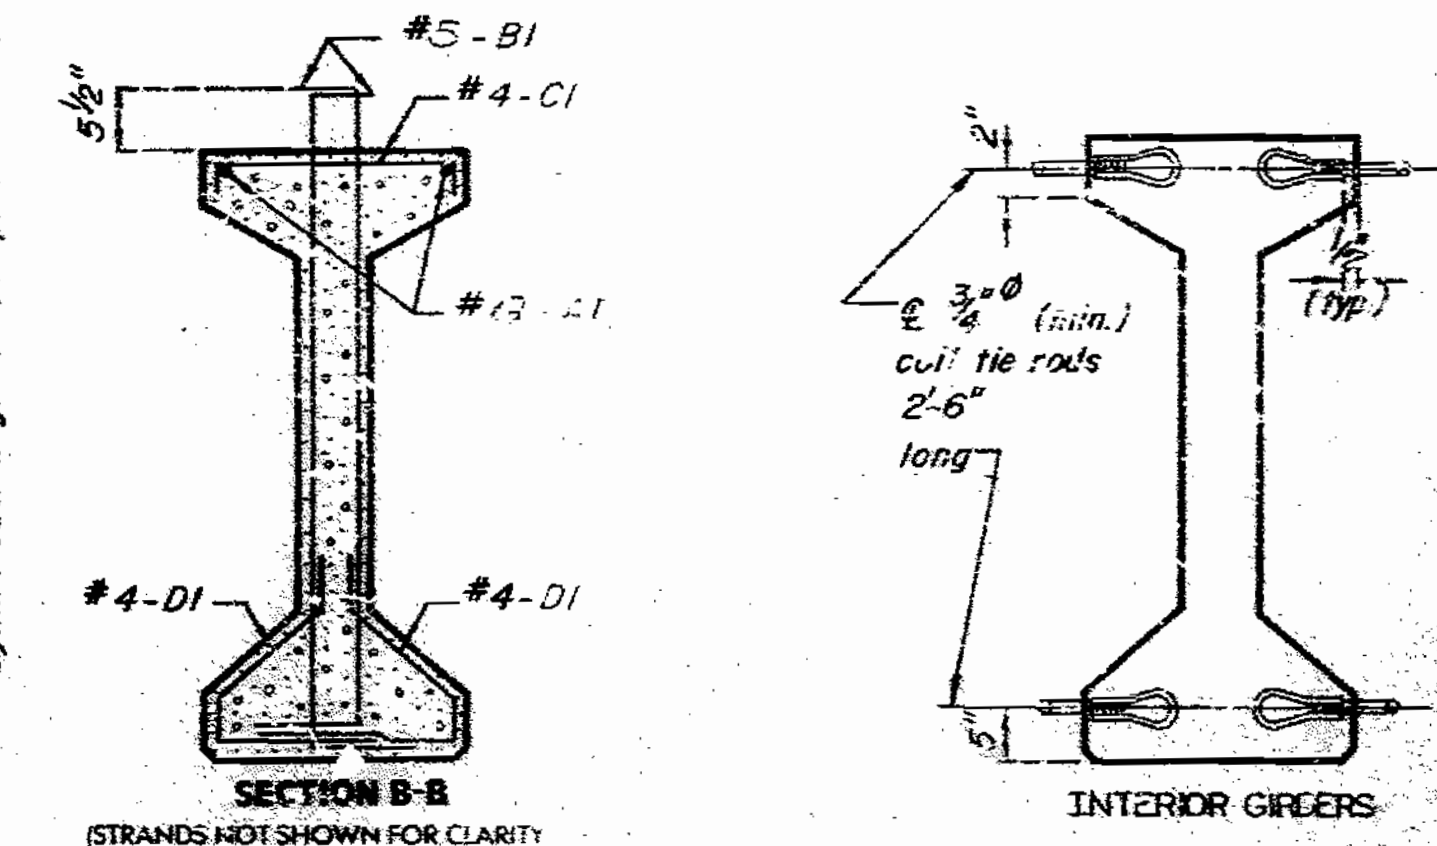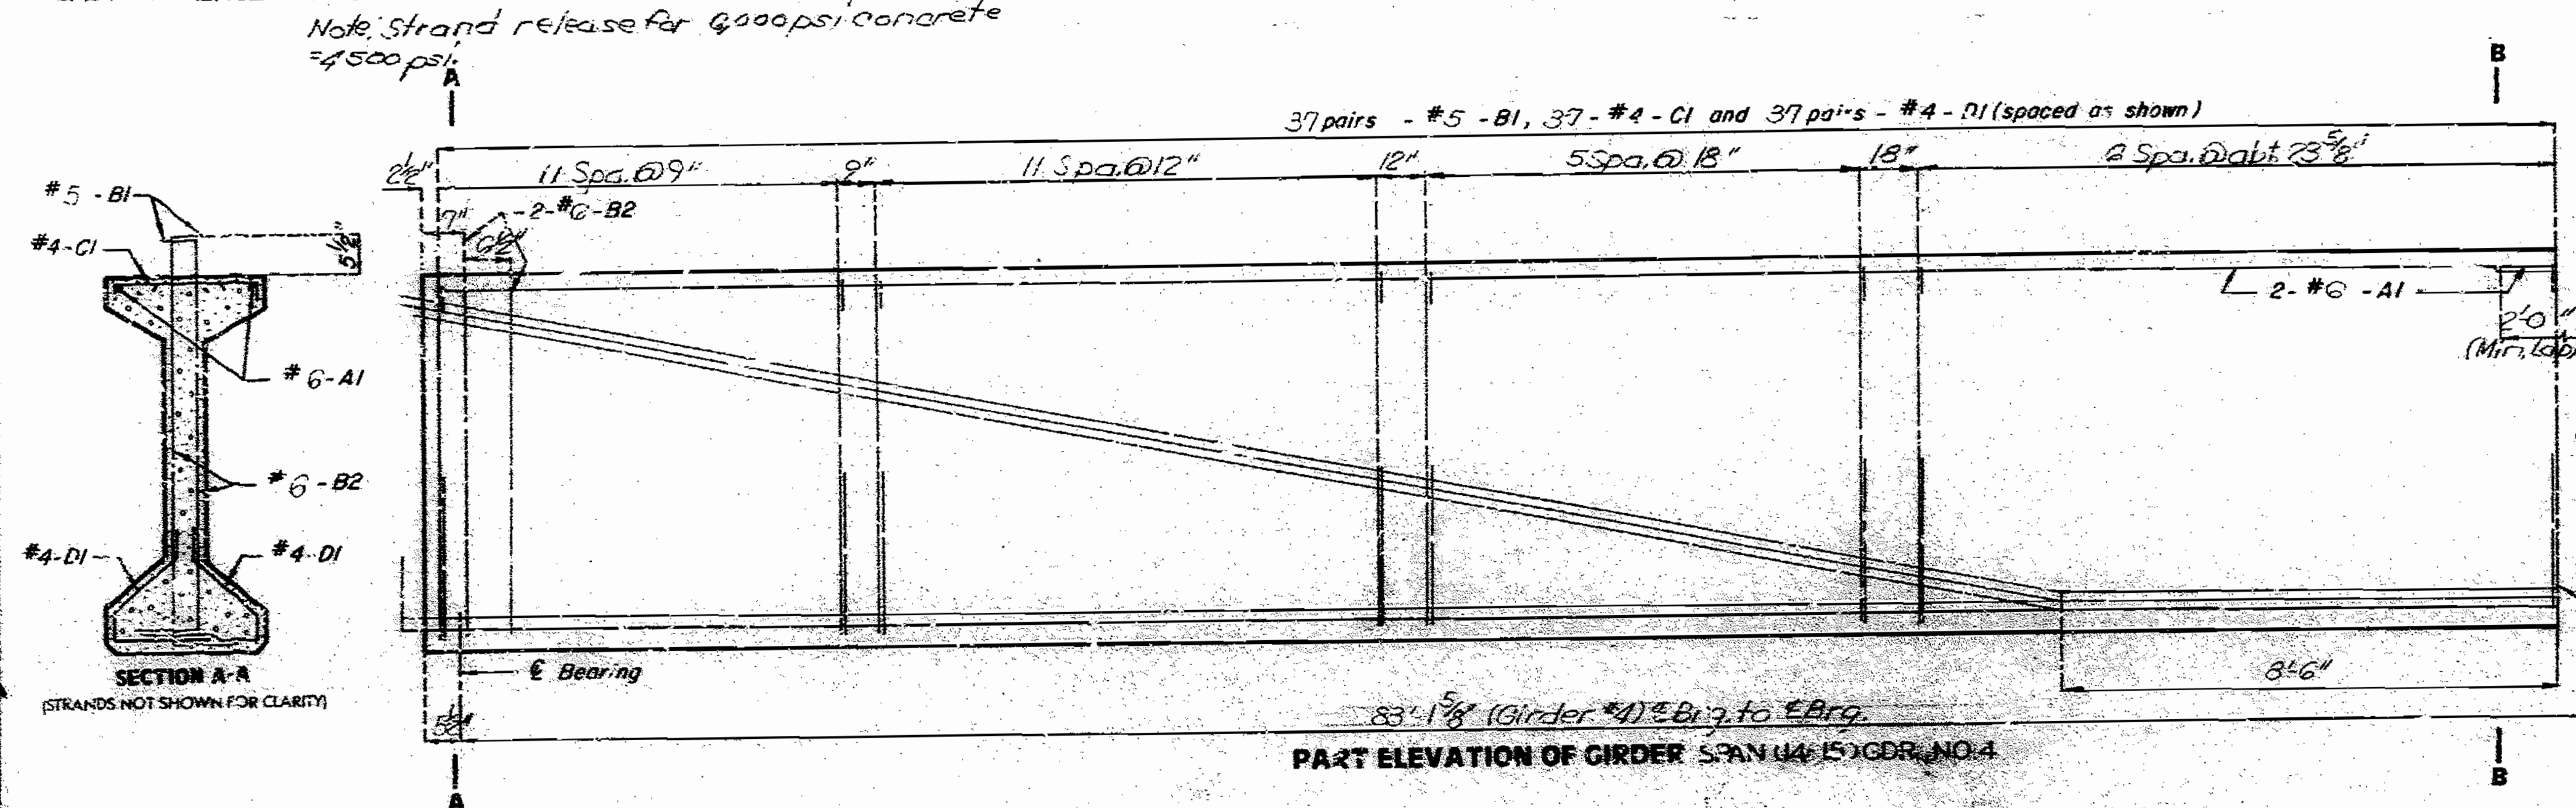

**DETAILS OF COIL TIES**

**NOTE:**  
 COST OF 3/4" COIL TIE RODS PLACED IN DIAPHRAGMS IS INCLUDED IN CONTRACT UNIT PRICE FOR PRESTRESSED CONCRETE MEMBERS.  
 COIL TIES SHALL BE HELD IN PLACE IN THE FORMS BY SLOTTED WIRE-SETTING STUDS PROLACTING THRU FORMS. STUDS ARE TO BE LEFT IN PLACE OR REPLACED WITH TEMPORARY PLUGS UNTIL GIRDERS ARE ERECTED AND THEN REPLACED BY COIL TIE RODS.  
**NOTE:**  
 The 1/2" holes shall be cast in the web for steel intermediate diaphragms. Drilling is not allowed.

Note: For details of Int. St. Diaph. see sheet No. 66 & No. 67.  
 For location of Int. Diaph. and general girder placement see sheet No. 26.  
 For girder camber and haunching see sheet No. 69.

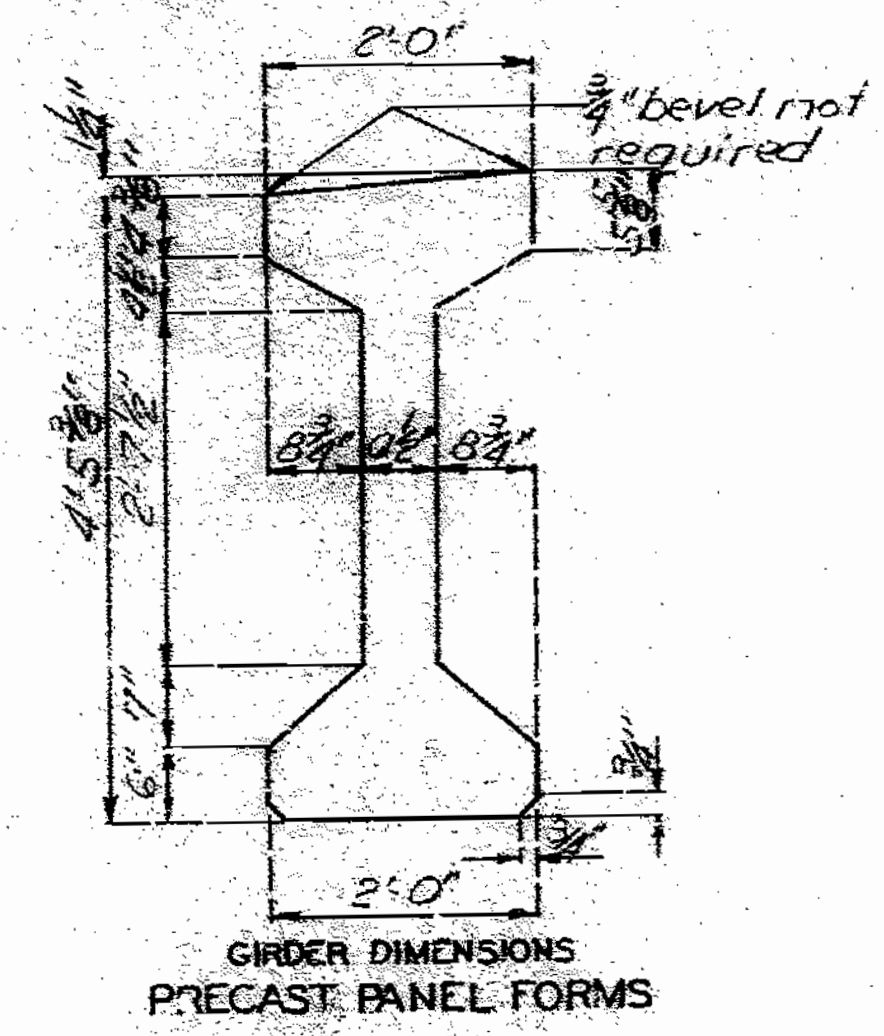



177144

SPS 55.6.6 1/2  
 FEB. 1974  
 REVISED  
 JUNE 1981  
 DETAILED APR. 1988  
 CHECKED OCT. 1988

Note: This drawing is not to scale. Follow dimensions.



CONCRETE FOR PRESTRESSED GIRDERS SHALL BE CLASS A1 WITH  $f_c = 6,000$  PSI.  
 (+) INDICATES PRESTRESSED STRAND.  
 USE 26 STRANDS WITH AN INITIAL PRESTRESS FORCE OF 306 KIPS.  
 PRESTRESSING TENDONS SHALL BE UNCOATED, SEVEN-WIRE, LOW RELAXATION STRANDS - 1/2 INCH DIAMETER CONFORMING TO A.A.S.H.T.O. M203, GRADE 270. SEE MC STD. SPECIFICATION 15 705 4.8.

STATE	PROJ. NO.	SHEET NO.
MO		130

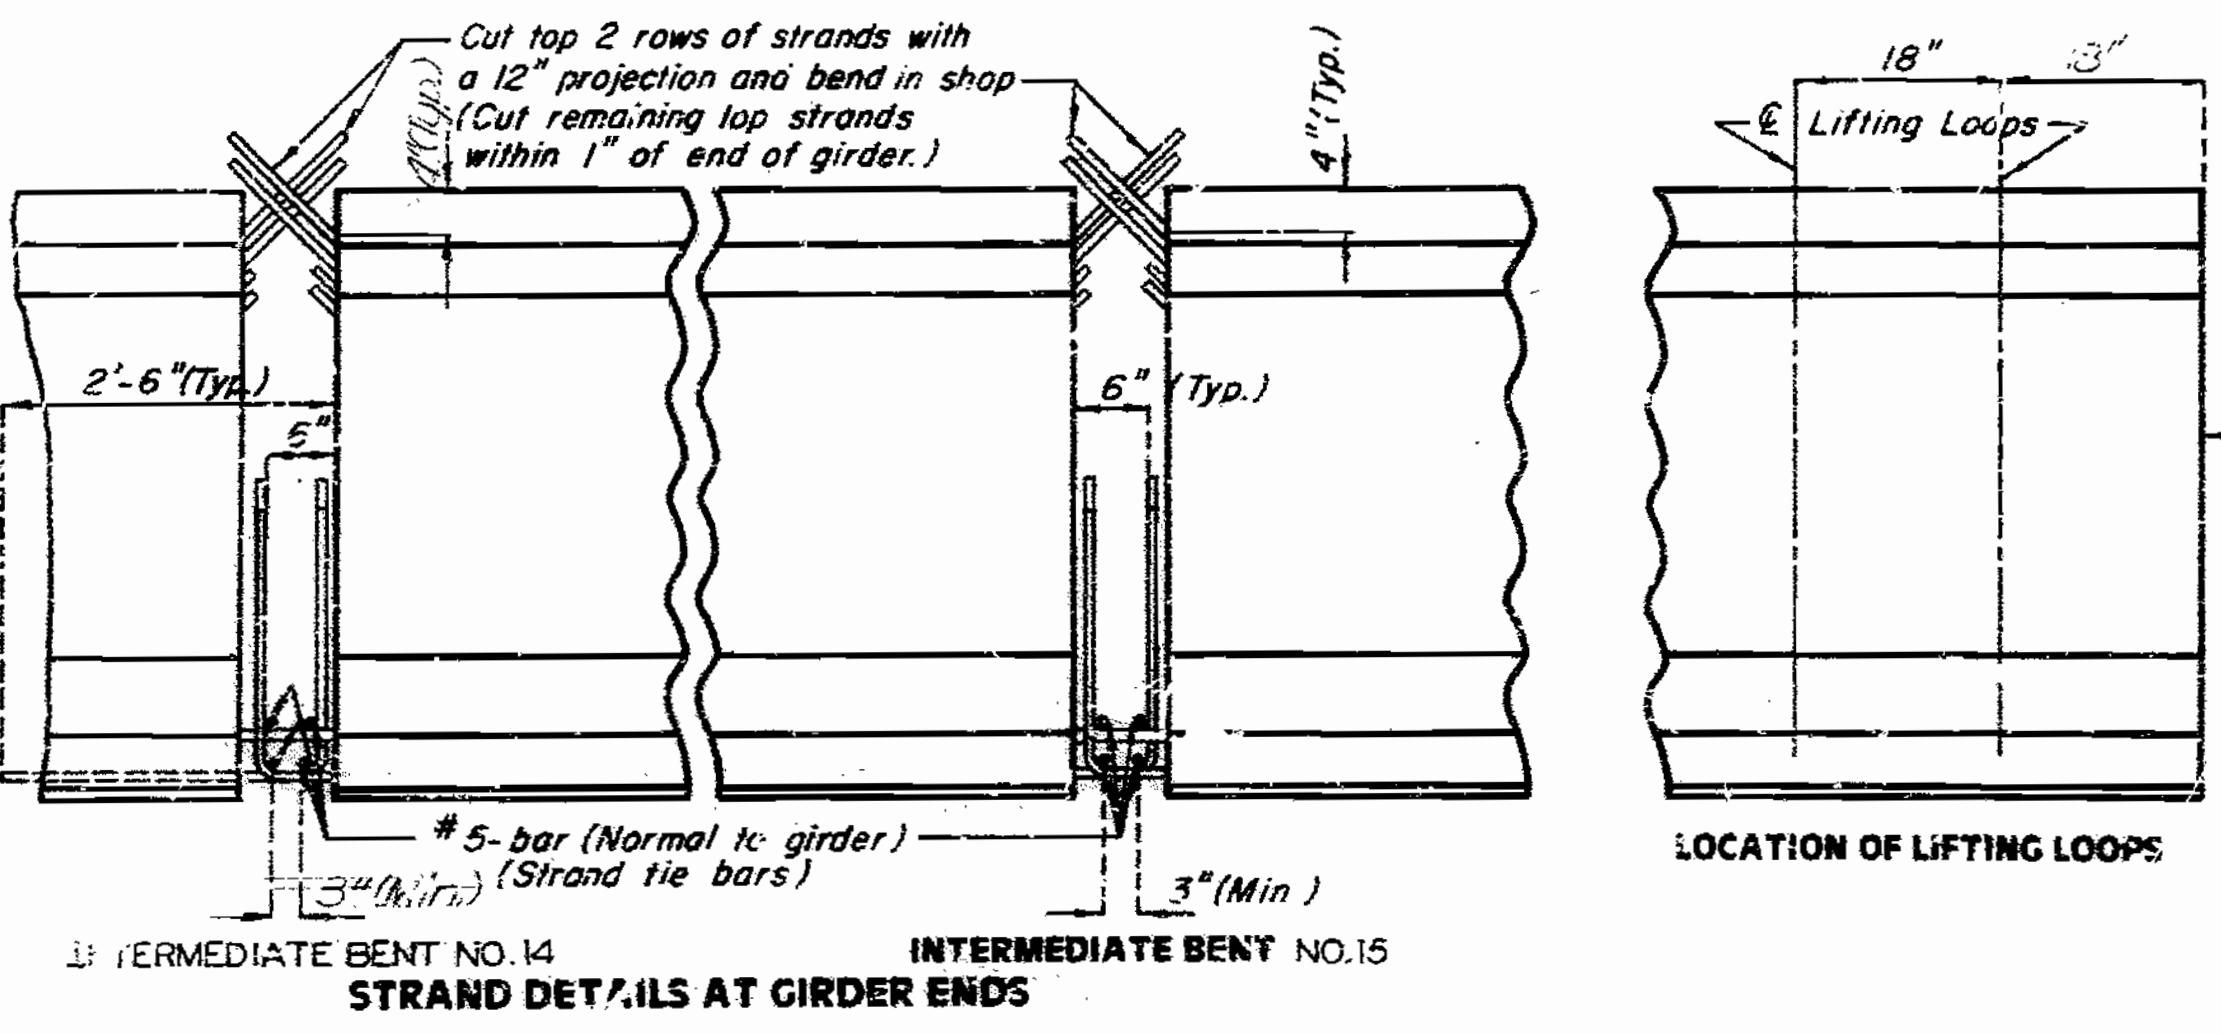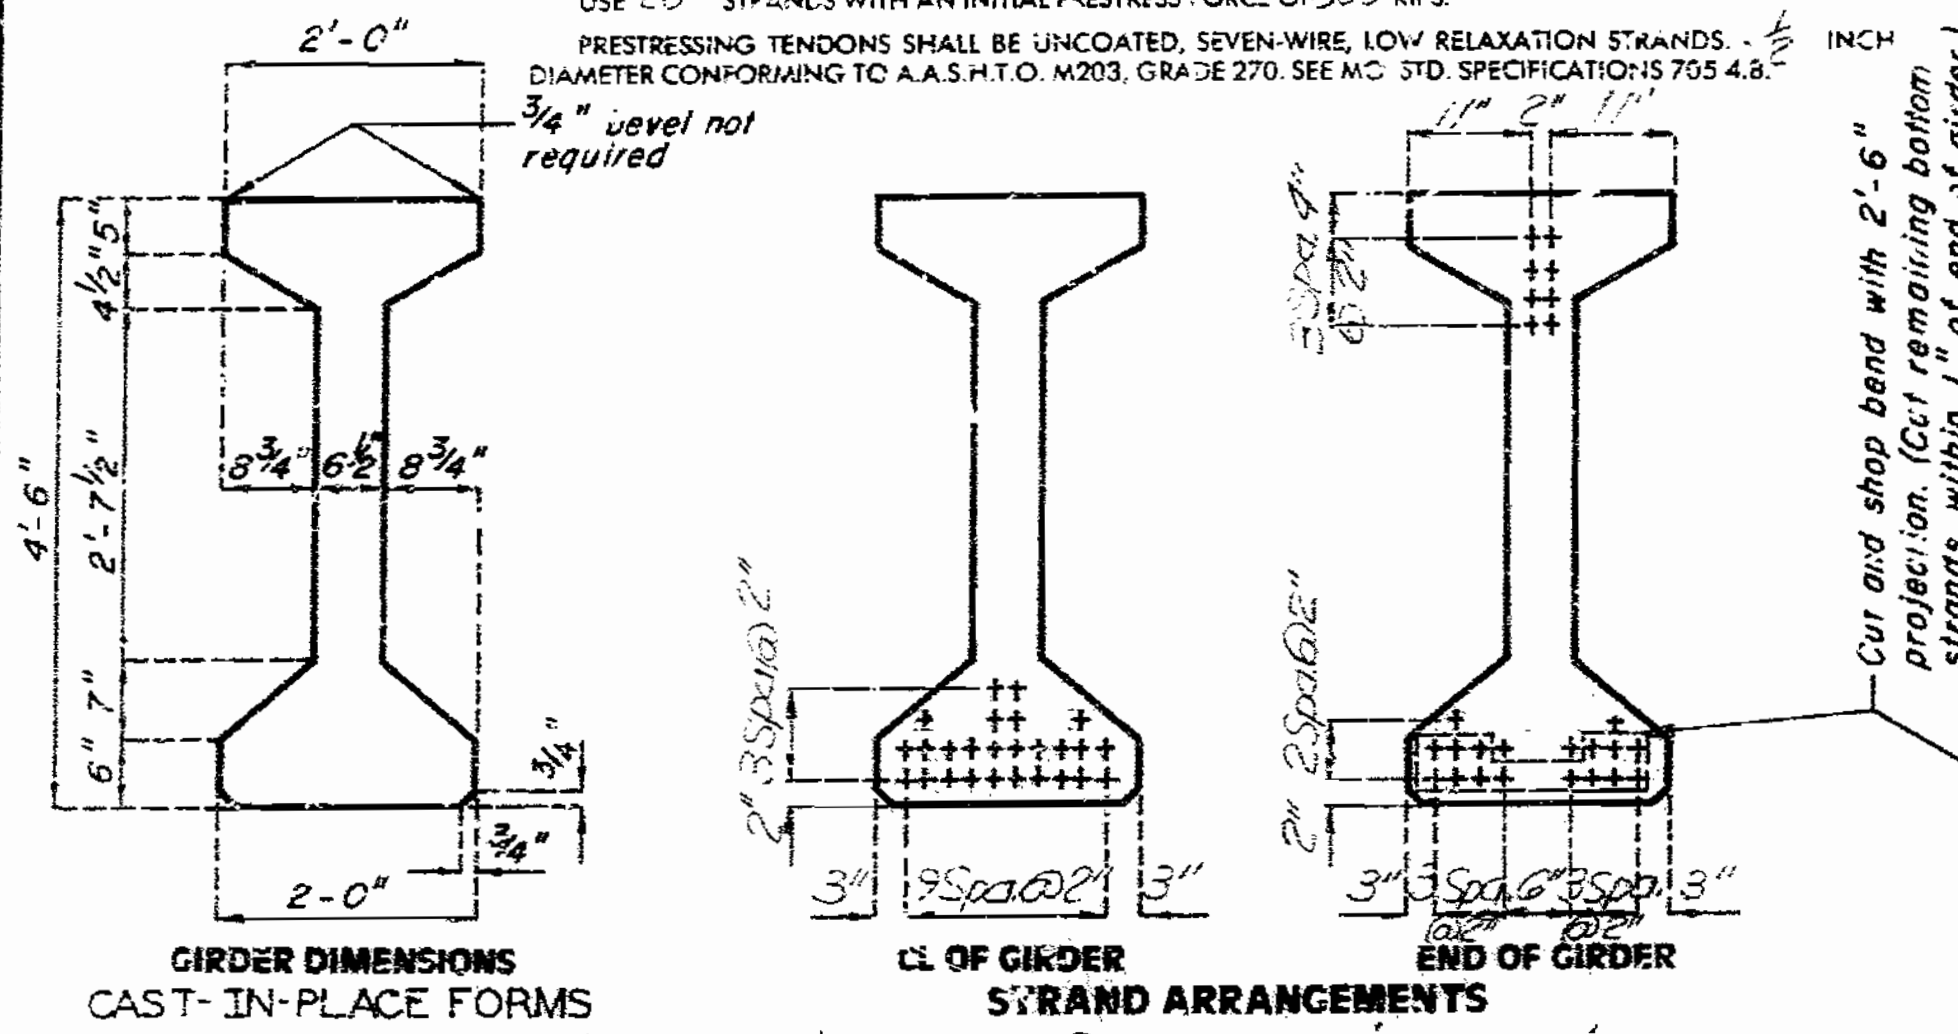


BILL OF REINFORCING STEEL - EACH GIRDER				BENDING DIAGRAMS	
NO.	SIZE & MARK	ACTUAL LENGTH	SHAPE		
4	6 A1	45'-2"	20	SHAPE 10	
158	5 B1	5'-11"	11	SHAPE 9	
8	6 B2	5'-4"	11	SHAPE 11	
79	4 C1	2'-2"	10		
138	4 D1	3'-0"	9		

**NOTE:**  
 ALL DIMENSIONS IN BENDING DIAGRAM ARE OUT TO OUT.  
 HOOKS AND BENDS SHALL BE IN ACCORDANCE WITH THE CRSI MANUAL OF STANDARD PRACTICE FOR DETAILING REINFORCED CONCRETE STRUCTURES STIRRUP AND TIE DIMENSIONS.  
 ACTUAL LENGTHS ARE MEASURED ALONG CENTERLINE BAR TO THE NEAREST INCH.  
 MINIMUM CLEARANCE TO REINFORCING SHALL BE 1".  
 ALL REINFORCEMENT SHALL BE GRADE 60.  
 THE TWO D1 BARS MAY BE FURNISHED AS ONE BAR AT THE FABRICATOR'S OPTION.

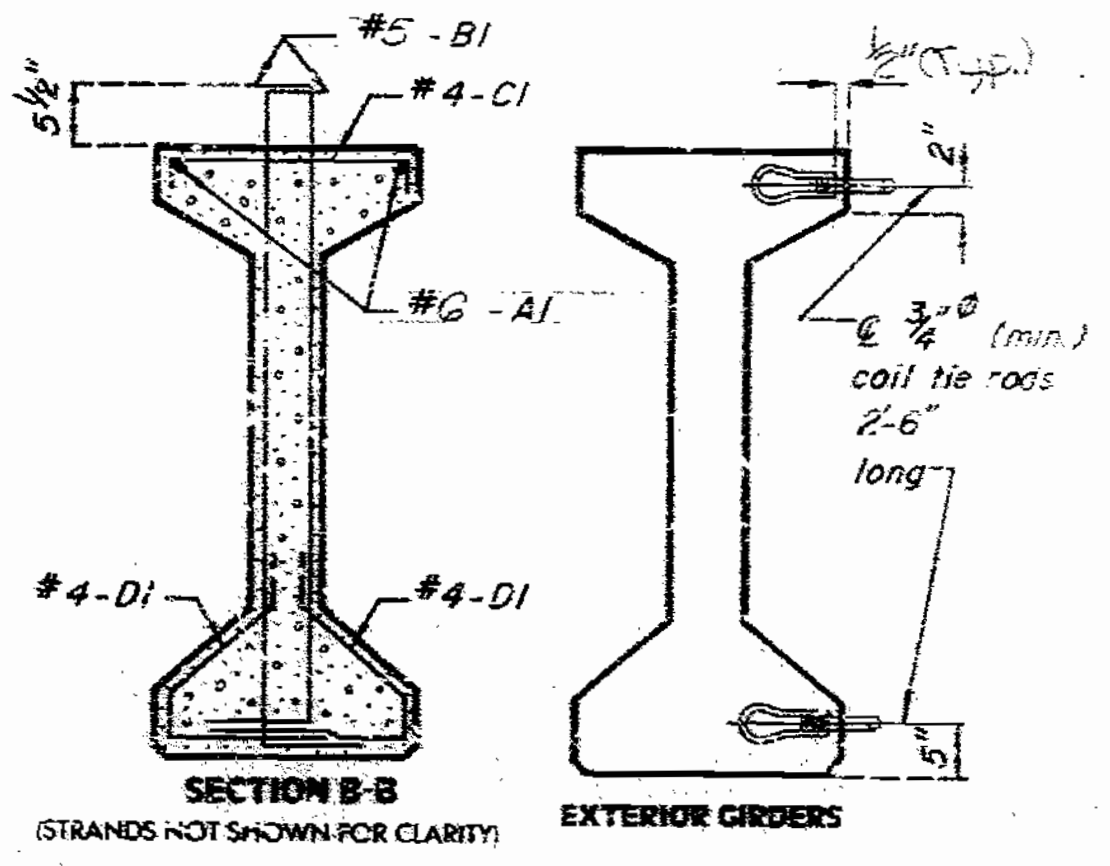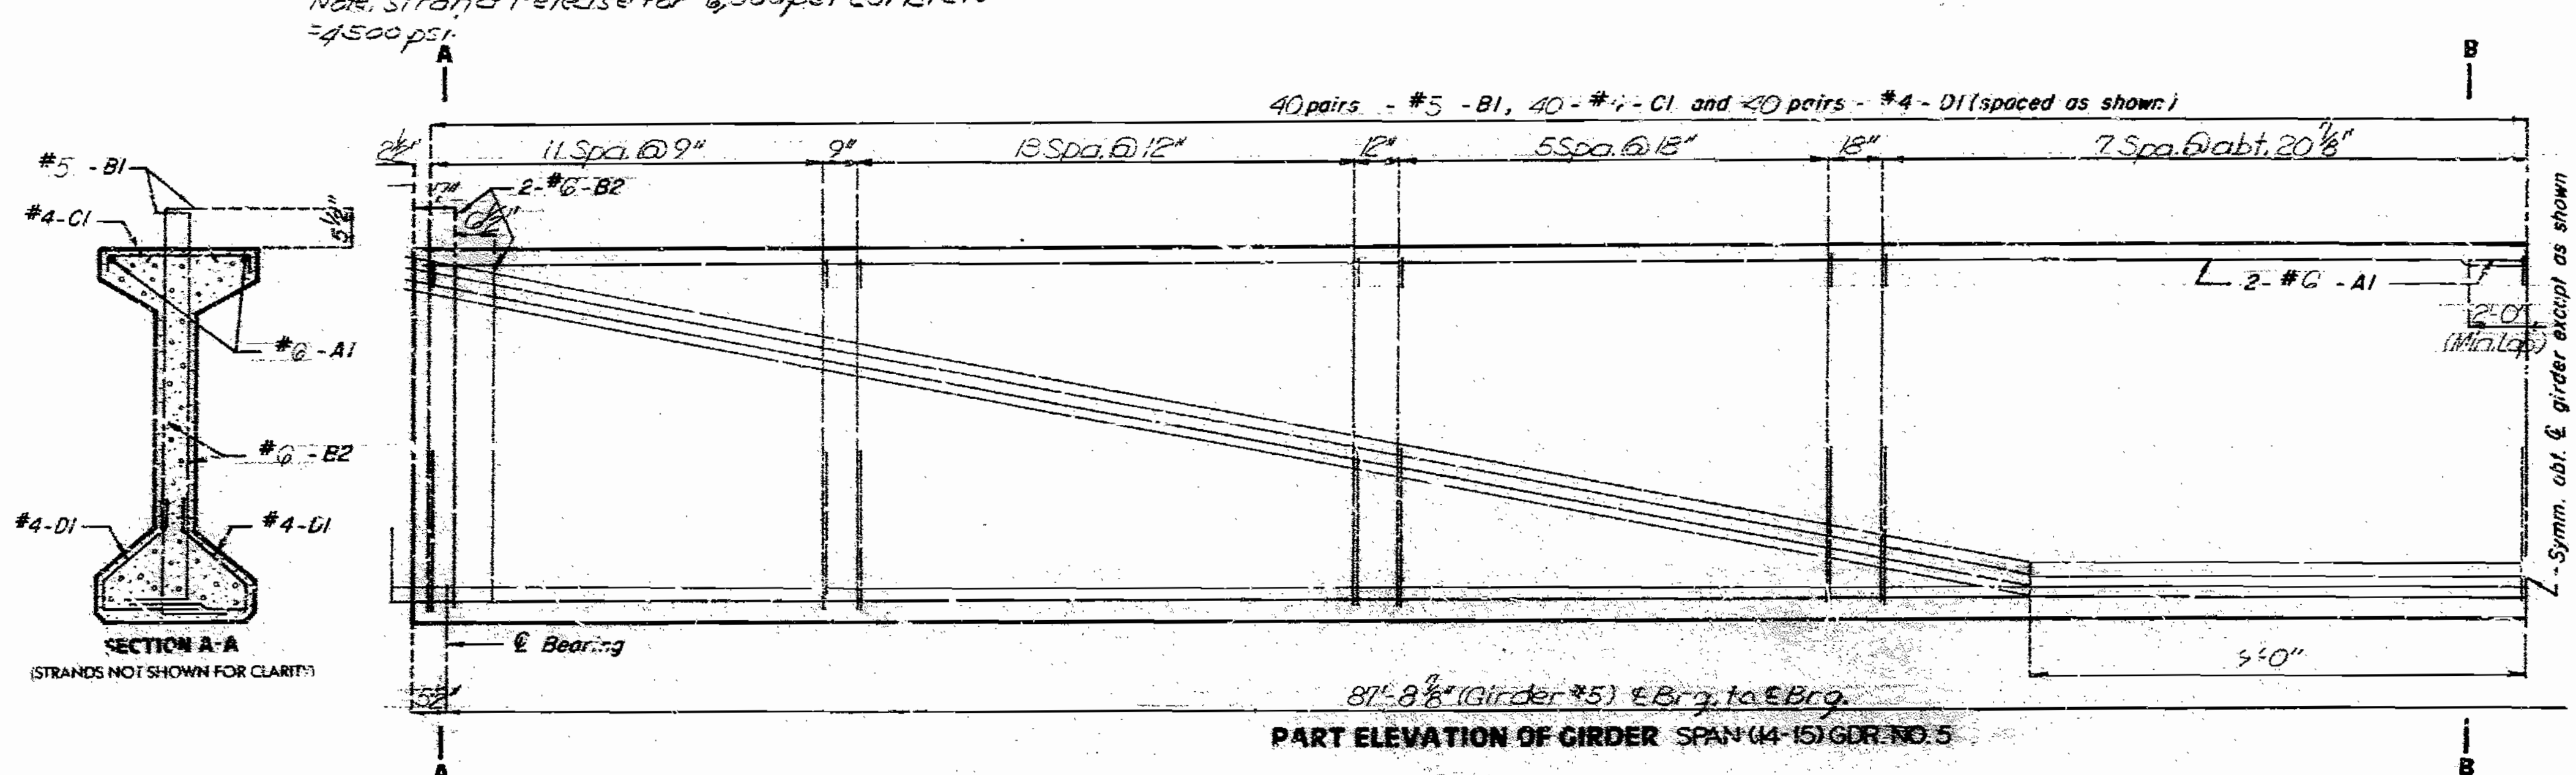

Note: For details of Int. Bt. Diaph. see sheet No. 66 & No. 67.  
 For location of Int. Diaph. and general girder placement see sheet No. 68.  
 For girder camber and haunching see sheet No. 69.

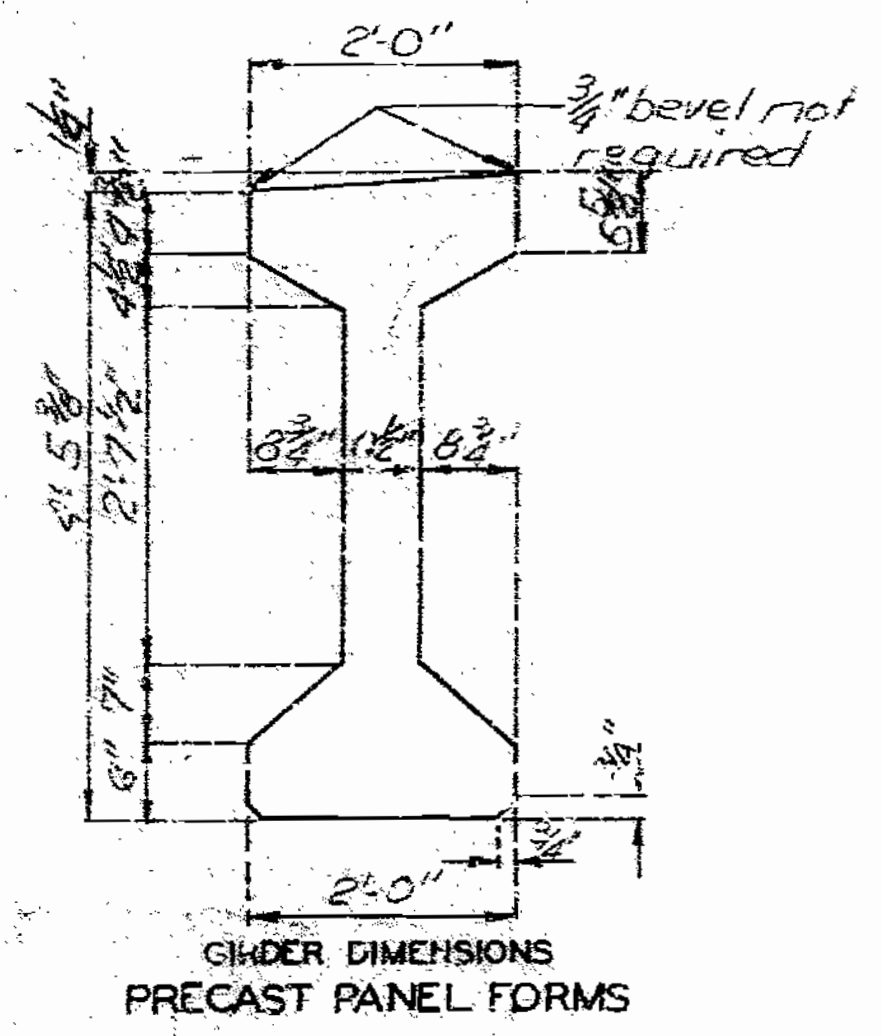

**NOTE:**  
 COST OF 3/4" COIL TIE RODS PLACED IN DIAPHRAGMS IS INCLUDED IN CONTRACT UNIT PRICE FOR PRESTRESSED CONCRETE MEMBERS.  
 COIL TIES SHALL BE HELD IN PLACE IN THE FORMS BY SLOTTED WIRE-SETTING STUDS PROJECTING THRU FORMS. STUDS ARE TO BE LEFT IN PLACE OR REPLACED WITH TEMPORARY PLUGS UNTIL GIRDERS ARE ERECTED AND THEN REPLACED BY COIL TIE RODS.

**NOTE:**  
 The 1/2" bevel shall be on the web for steel intermediate diaphragms. Drilling is not allowed.

177145

SPS 55.6.6/2 REVISED JUNE 1987  
 FEB. 1974  
 DETAILED MAR. 1988  
 CHECKED OCT. 1988






Note: This drawing is not to scale. Follow dimensions.

Sheet No. 50 of 98



NOTE:  
 CONCRETE FOR PRESTRESSED GIRDERS SHALL BE CLASS A1 WITH  $f_c = 6,000$  PSI.  
 (+) INDICATES PRESTRESSED STRAND.  
 USE 24 STRANDS WITH AN INITIAL PRESTRESS FORCE OF 744 KIPS.  
 PRESTRESSING TENDONS SHALL BE UNCOATED, SEVEN-WIRE, LOW RELAXATION STRANDS, 1/2 INCH DIAMETER CONFORMING TO A.A.S.H.T.O. M203, GRADE 270. SEE MO. STD. SPECIFICATIONS 705.4.8.





STATE	PROJ NO	SHEET NO
MO		132

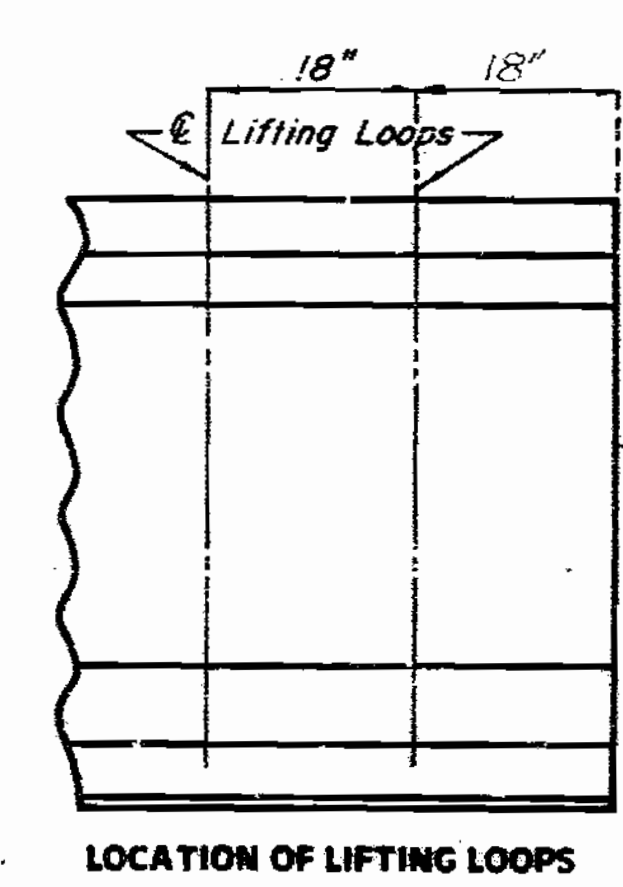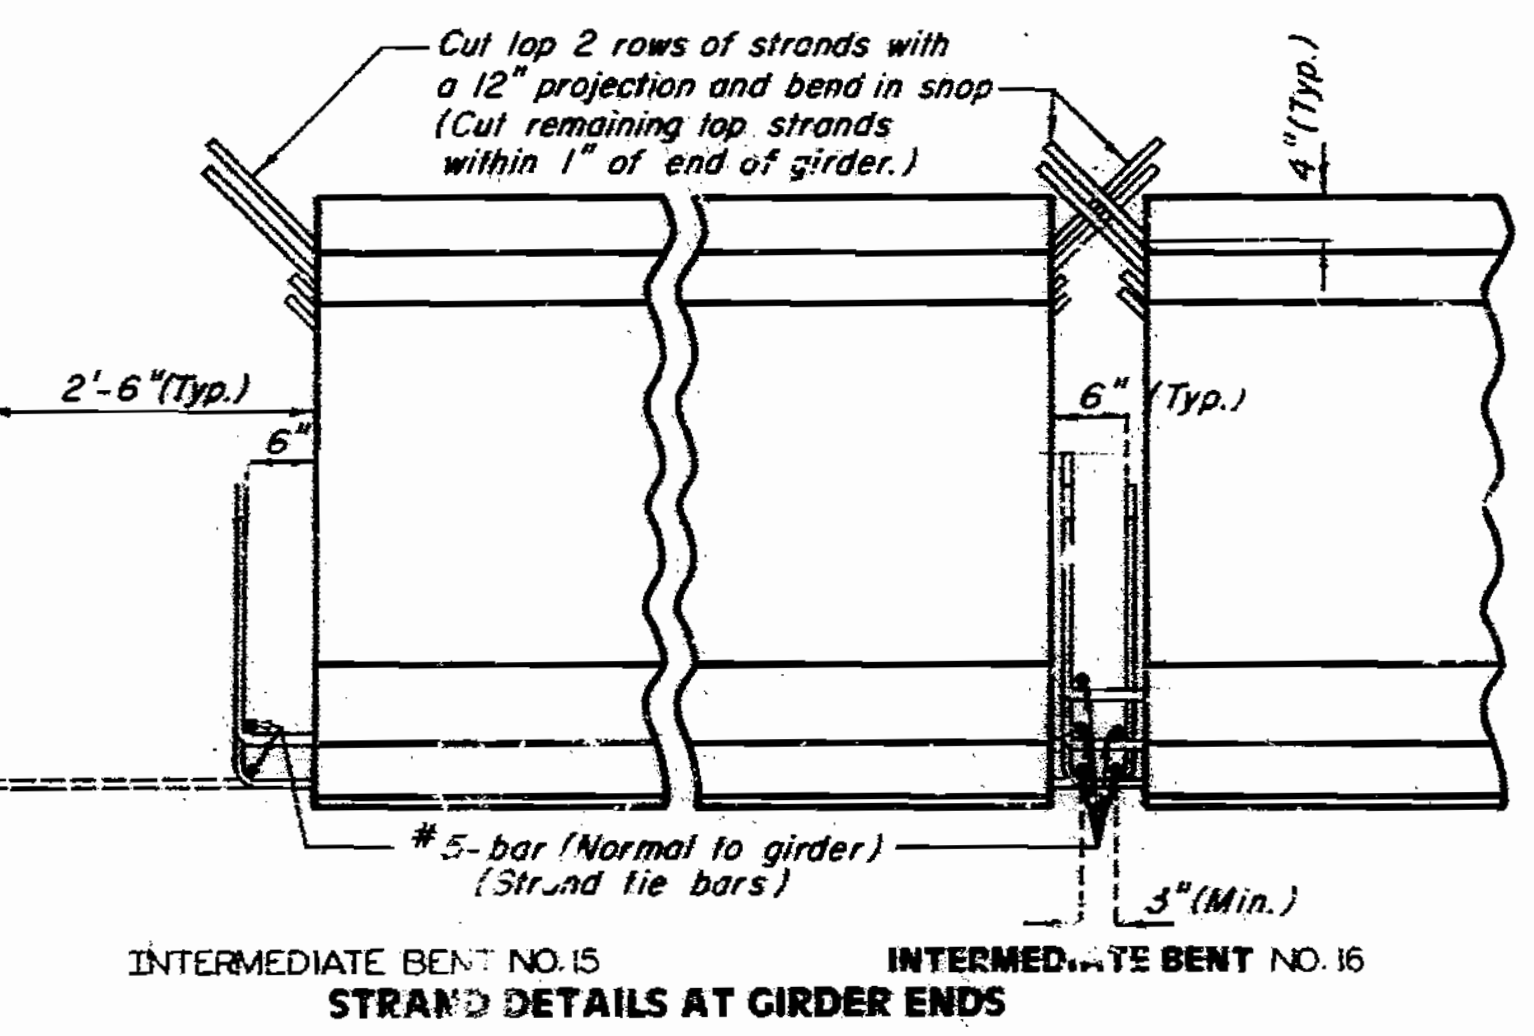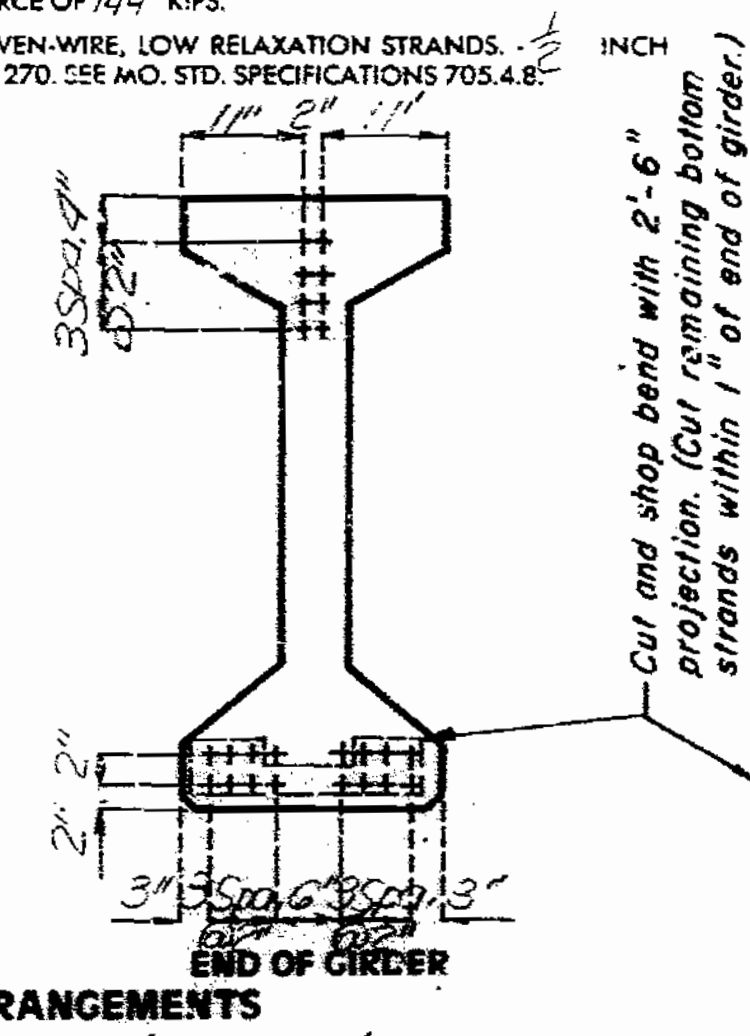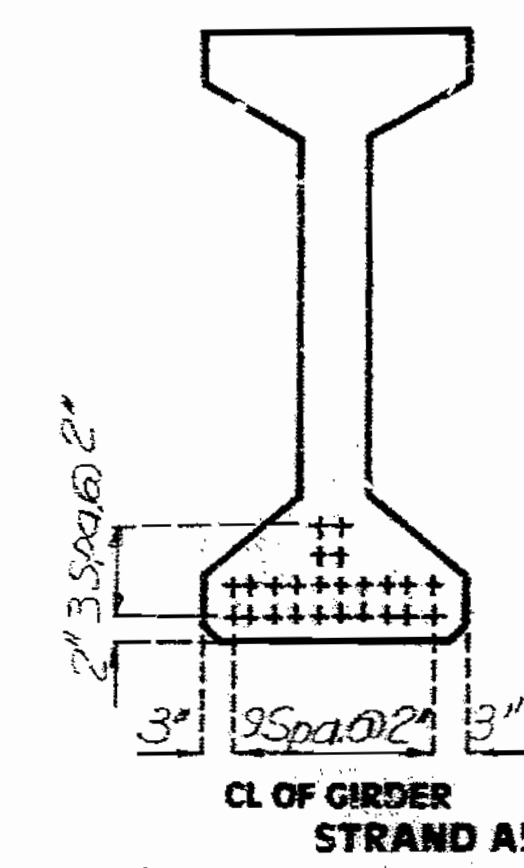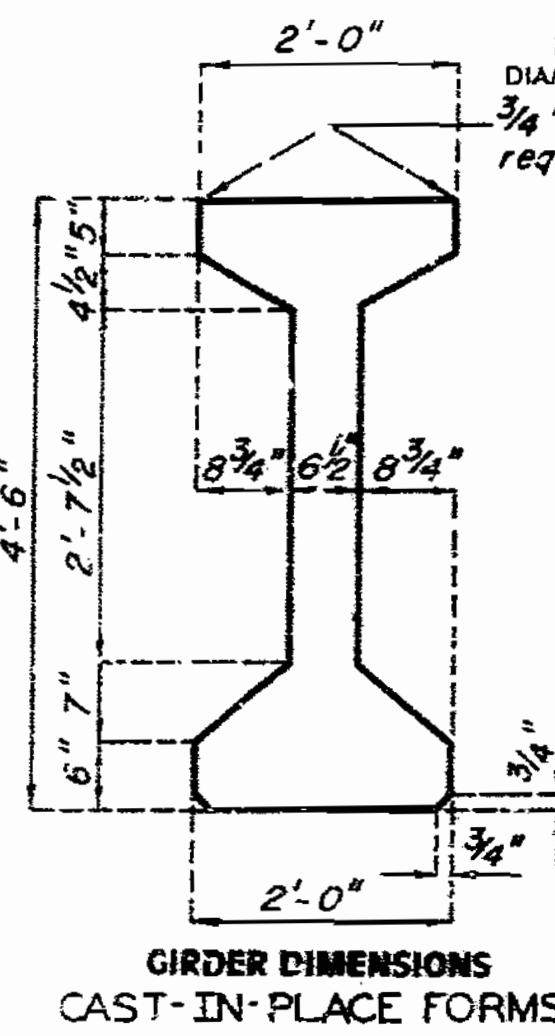

BILL OF REINFORCING STEEL - EACH GIRDER				BENDING DIAGRAMS	
NO.	SIZE & MARK	ACTUAL LENGTH	SHAPE		
4	G A1	①	20	SHAPE 9	
142	5 B1	5'-11"	11	SHAPE 10	
8	G B2	5'-4"	11	SHAPE 11	
71	4 C1	2'-2"	10	SHAPE 9	
142	4 D1	3'-0"	9	SHAPE 20	


NOTE:  
 ALL DIMENSIONS IN BENDING DIAGRAM ARE OUT TO OUT.  
 HOOKS AND BENDS SHALL BE IN ACCORDANCE WITH THE CRSI MANUAL OF STANDARD PRACTICE FOR DETAILING REINFORCED CONCRETE STRUCTURES STIRRUP AND THE DIMENSIONS.  
 ACTUAL LENGTHS ARE MEASURED ALONG CENTERLINE BAR TO THE NEAREST INCH.  
 MINIMUM CLEARANCE TO REINFORCING SHALL BE 1".  
 ALL REINFORCEMENT SHALL BE GRADE 60.  
 THE TWO D1 BARS MAY BE FURNISHED AS ONE BAR AT THE FABRICATOR'S OPTION.

Note: Strand release for 6,000psi concrete = 4500 psi.

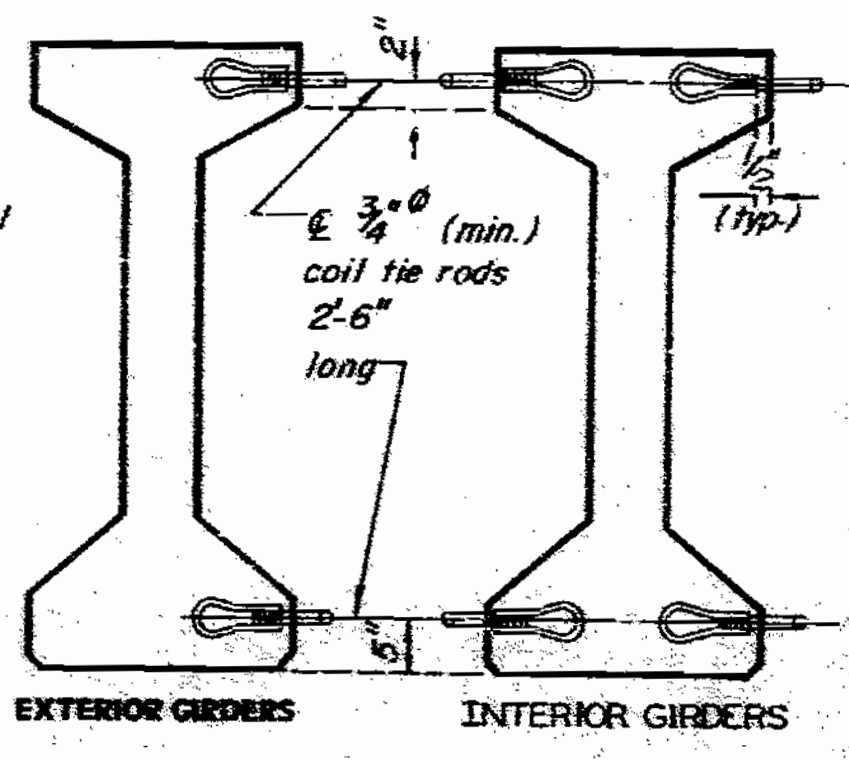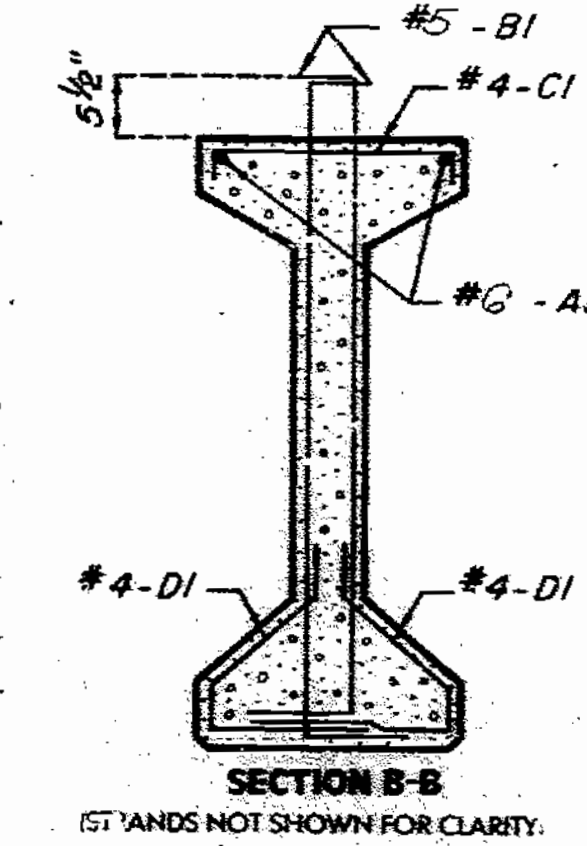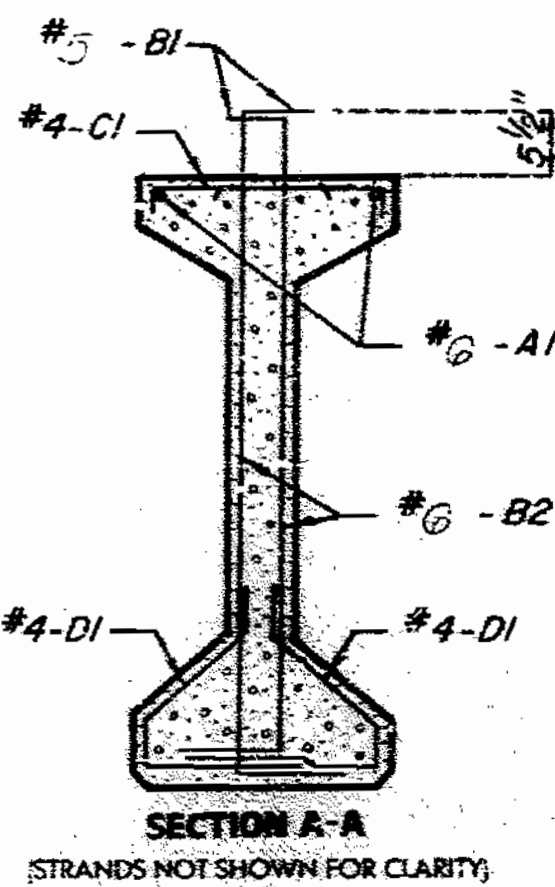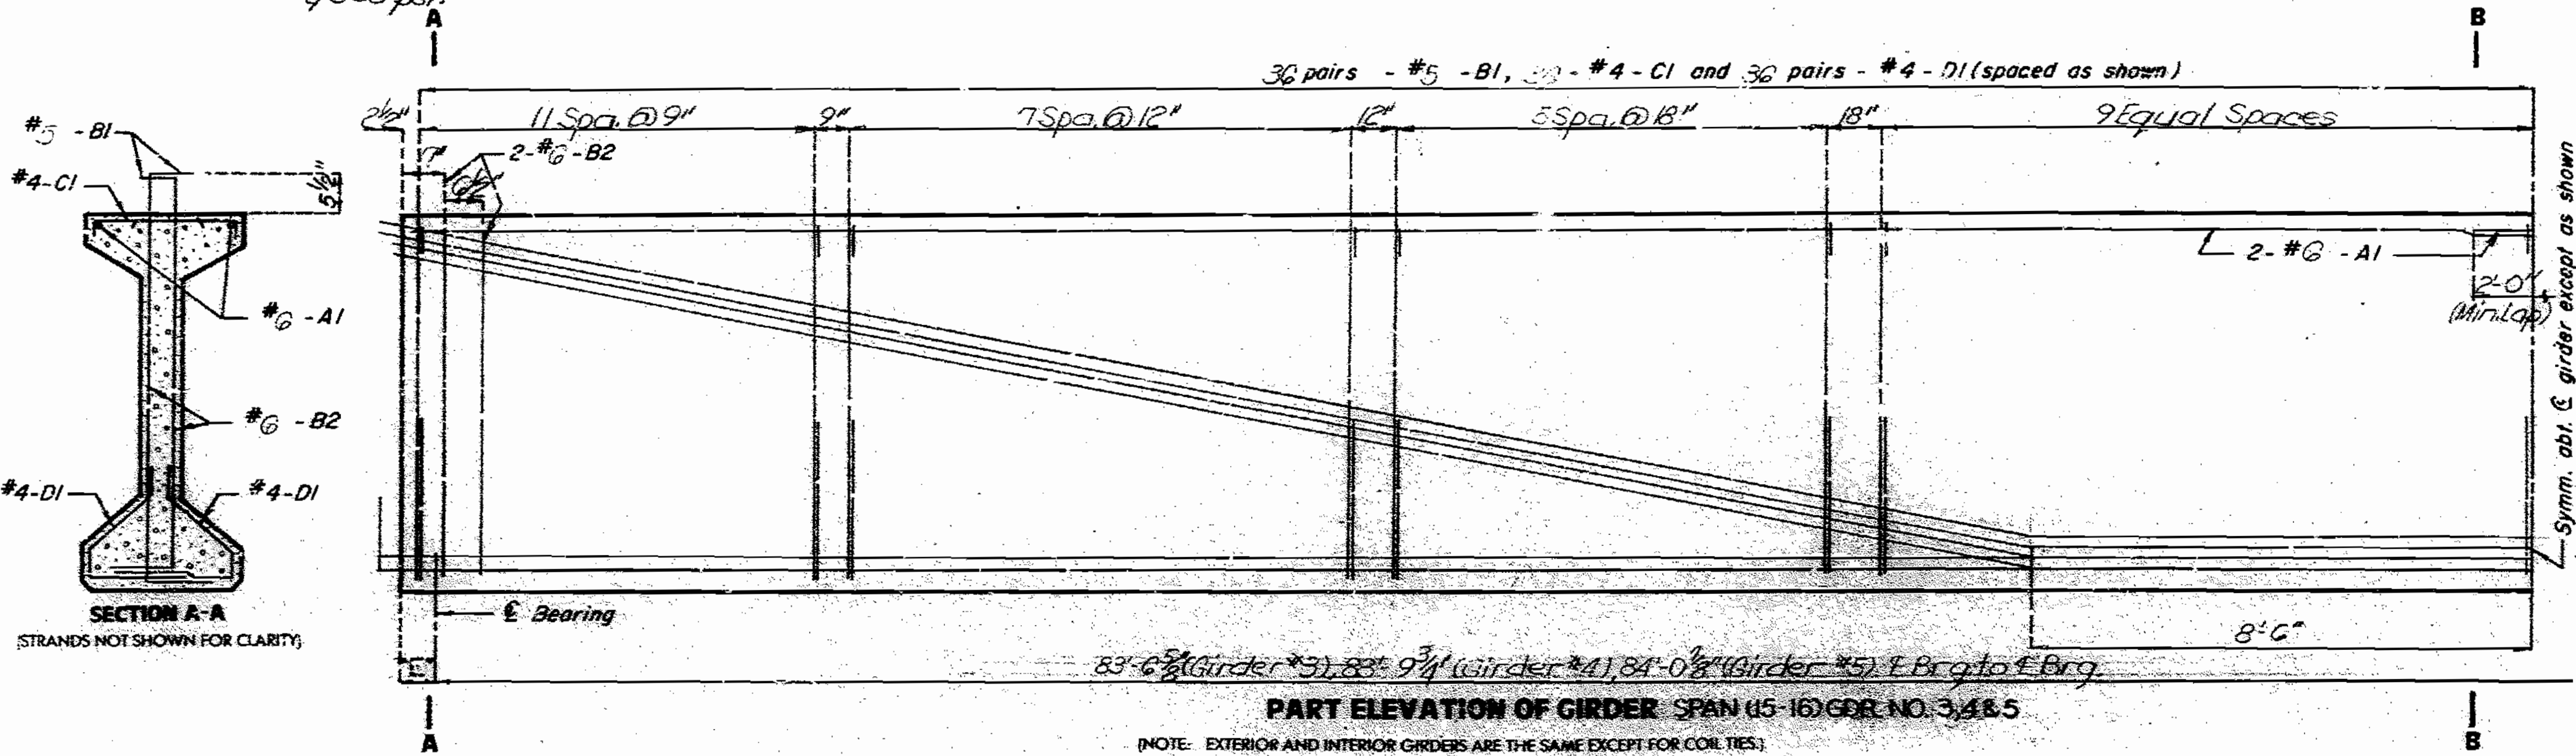

NOTE:  
 COST OF 3/4" COIL TIE RODS PLACED IN DIAPHRAGMS IS INCLUDED IN CONTRACT UNIT PRICE FOR PRESTRESSED CONCRETE MEMBERS.  
 COIL TIES SHALL BE HELD IN PLACE IN THE FORMS BY SLOTTED WIRE-SETTING STUDS PROJECTING THRU FORMS. STUDS ARE TO BE LEFT IN PLACE OR REPLACED WITH TEMPORARY PLUGS UNTIL GIRDERS ARE ERECTED AND THEN REPLACED BY COIL TIE RODS.  
 NOTE:  
 The 1/2" holes shall be cast in the web for steel intermediate diaphragms. Drilling is not allowed.

Note: For details of Int. Bt. Diaph. see sheet No. 67.  
 For location of Int. Diaph. and general girder placement, see sheet No. 26.  
 For Girder Camber and haunching see sheet No. 69.

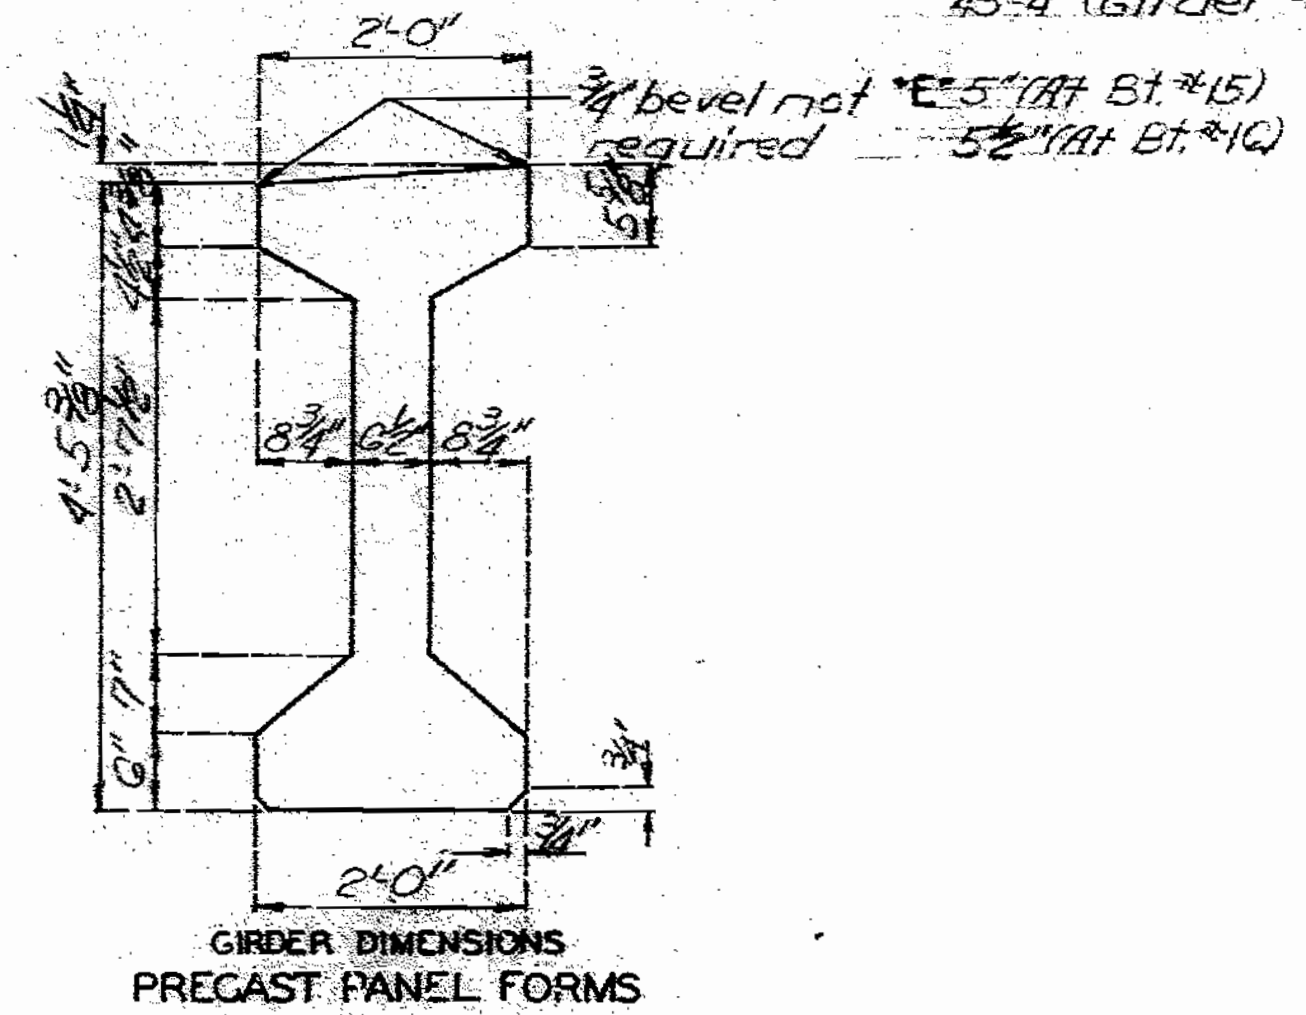

774 147  
 SPS 55.6.6 1/2  
 FEB. 1974  
 REVISED  
 JUNE 1987

DETAILED APR. 1988  
 CHECKED OCT. 1988

Note: This drawing is not to scale. Follow dimensions.

Sheet No. 52 of 98


JACKSON COUNTY

A-2745

NOTE:

CONCRETE FOR PRESTRESSED GIRDERS SHALL BE CLASS A1 WITH  $f_c = 6,000$  PSI.  
 (+) INDICATES PRESTRESSED STRAND.  
 USE 24 STRANDS WITH AN INITIAL PRESTRESS FORCE OF 744 KIPS.  
 PRESTRESSING TENDONS SHALL BE UNCOATED, SEVEN-WIRE, LOW RELAXATION STRANDS - 2 INCH DIAMETER CONFORMING TO A.A.S.H.T.O. M203, GRADE 270. SEE MO. STD. SPECIFICATIONS 705.4.8.

STATE	PROJ. NO.	SHEET NO.
MO.		133

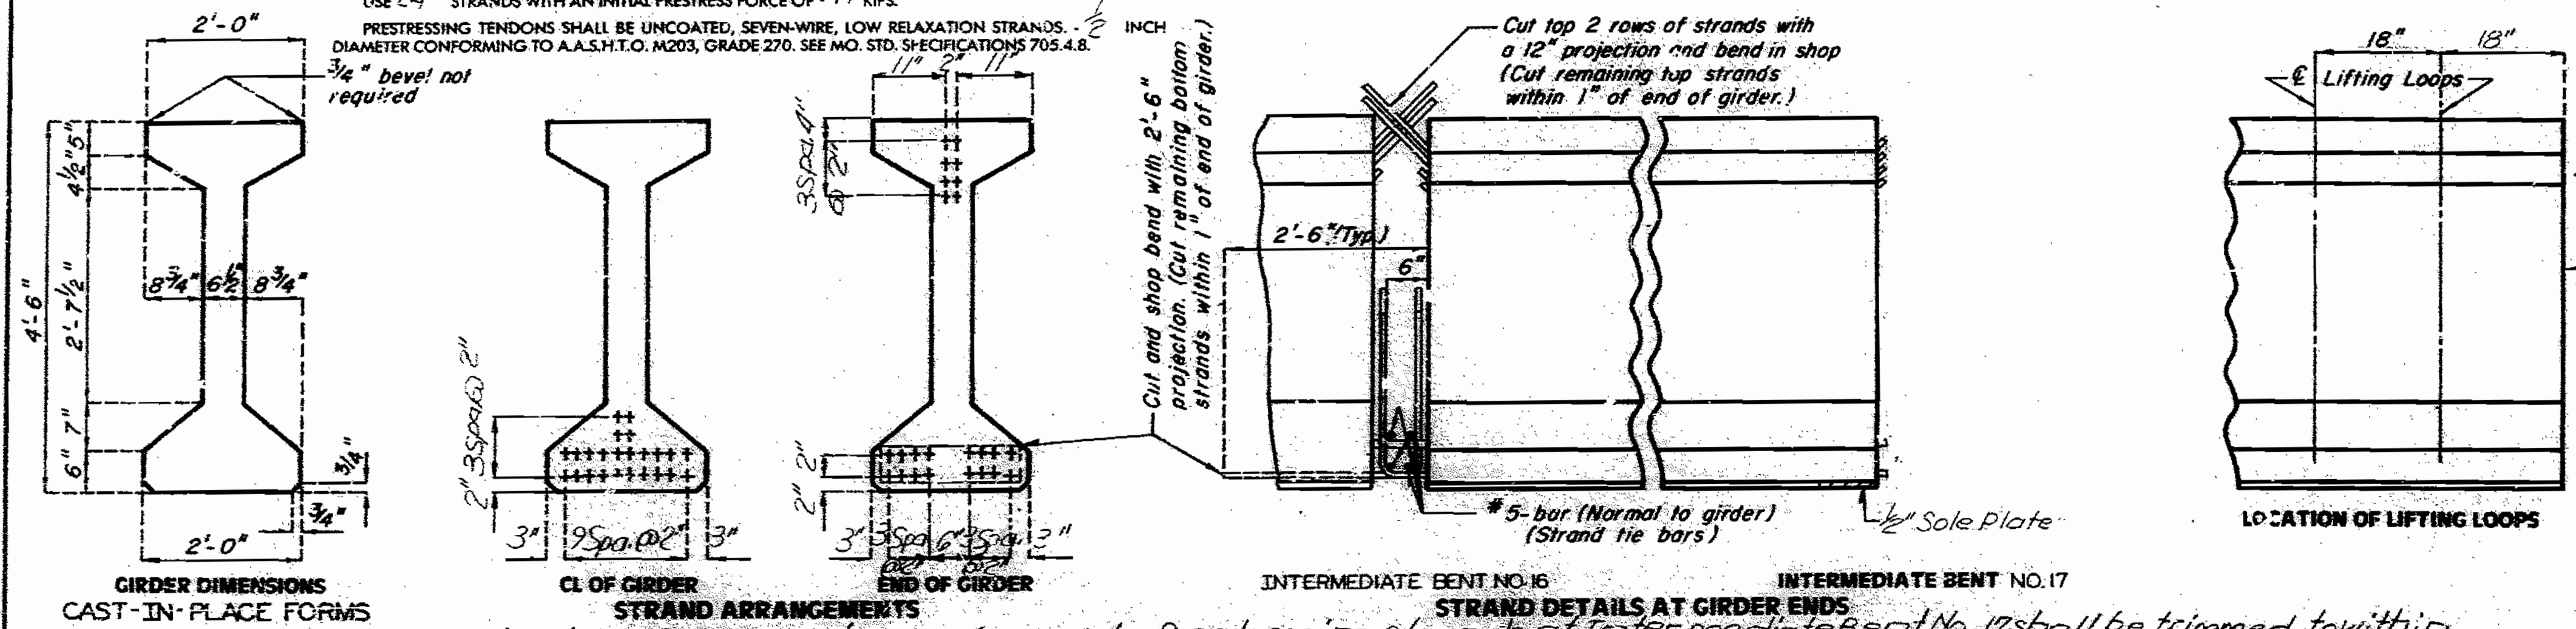



**BILL OF REINFORCING STEEL - EACH GIRDER**

NO.	SIZE & MARK	ACTUAL LENGTH	SHAPE	BENDING DIAGRAMS
4	G A1	①	20	
150	5 B1	5'-11"	11	
8	G B2	5'-4"	11	
75	4 C1	2'-2"	10	
150	4 D1	3'-0"	9	

**NOTE:**  
 ALL DIMENSIONS IN BENDING DIAGRAM ARE OUT TO OUT.  
 HOOKS AND BENDS SHALL BE IN ACCORDANCE WITH THE CRSI MANUAL OF STANDARD PRACTICE FOR DETAILING REINFORCED CONCRETE STRUCTURES STEELWORK AND THE DIMENSIONS.  
 ACTUAL LENGTHS ARE MEASURED ALONG CENTERLINE BAR TO THE NEAREST INCH.  
 MINIMUM CLEARANCE TO REINFORCING SHALL BE 1".  
 ALL REINFORCEMENT SHALL BE GRADE 60.  
 THE TWO D1 BARS MAY BE FURNISHED AS ONE BAR AT THE FABRICATOR'S OPTION.

Note: strand release for 6000 psi concrete = 4500 psi


Note: Prestressing strands at Intermediate Bent No. 17 shall be trimmed to within 3/8 inch of concrete if exposed, or 1 inch of concrete if encased. Exposed ends of girders shall be given 2 coats of an asphalt paint. Ends of girders which will be encased in concrete diaphragms shall not be painted.  
 38 pairs - #5 - B1, 38 - #4 - C1 and 38 pairs - #4 - D1 (spaced as shown)

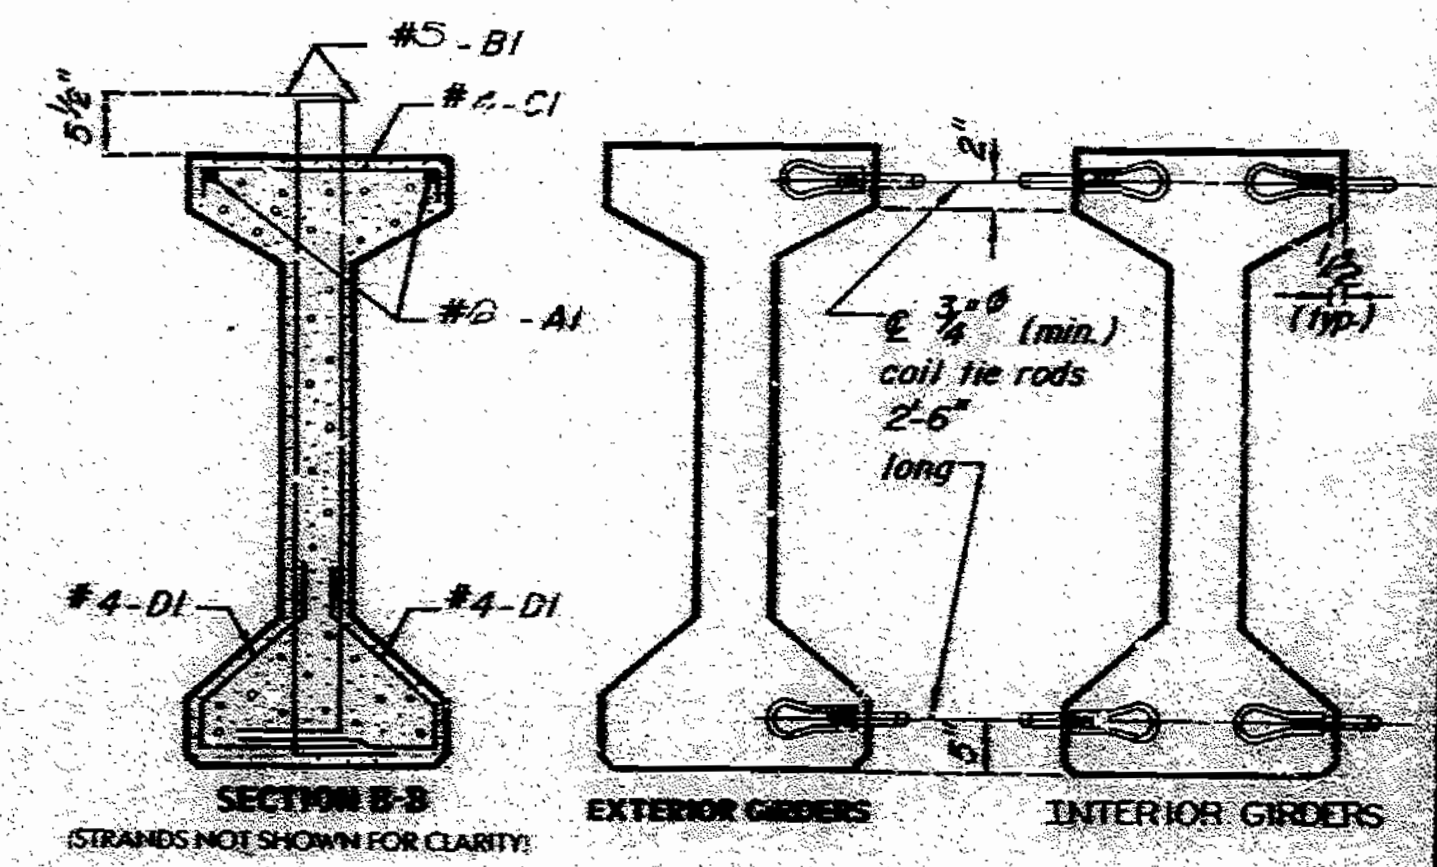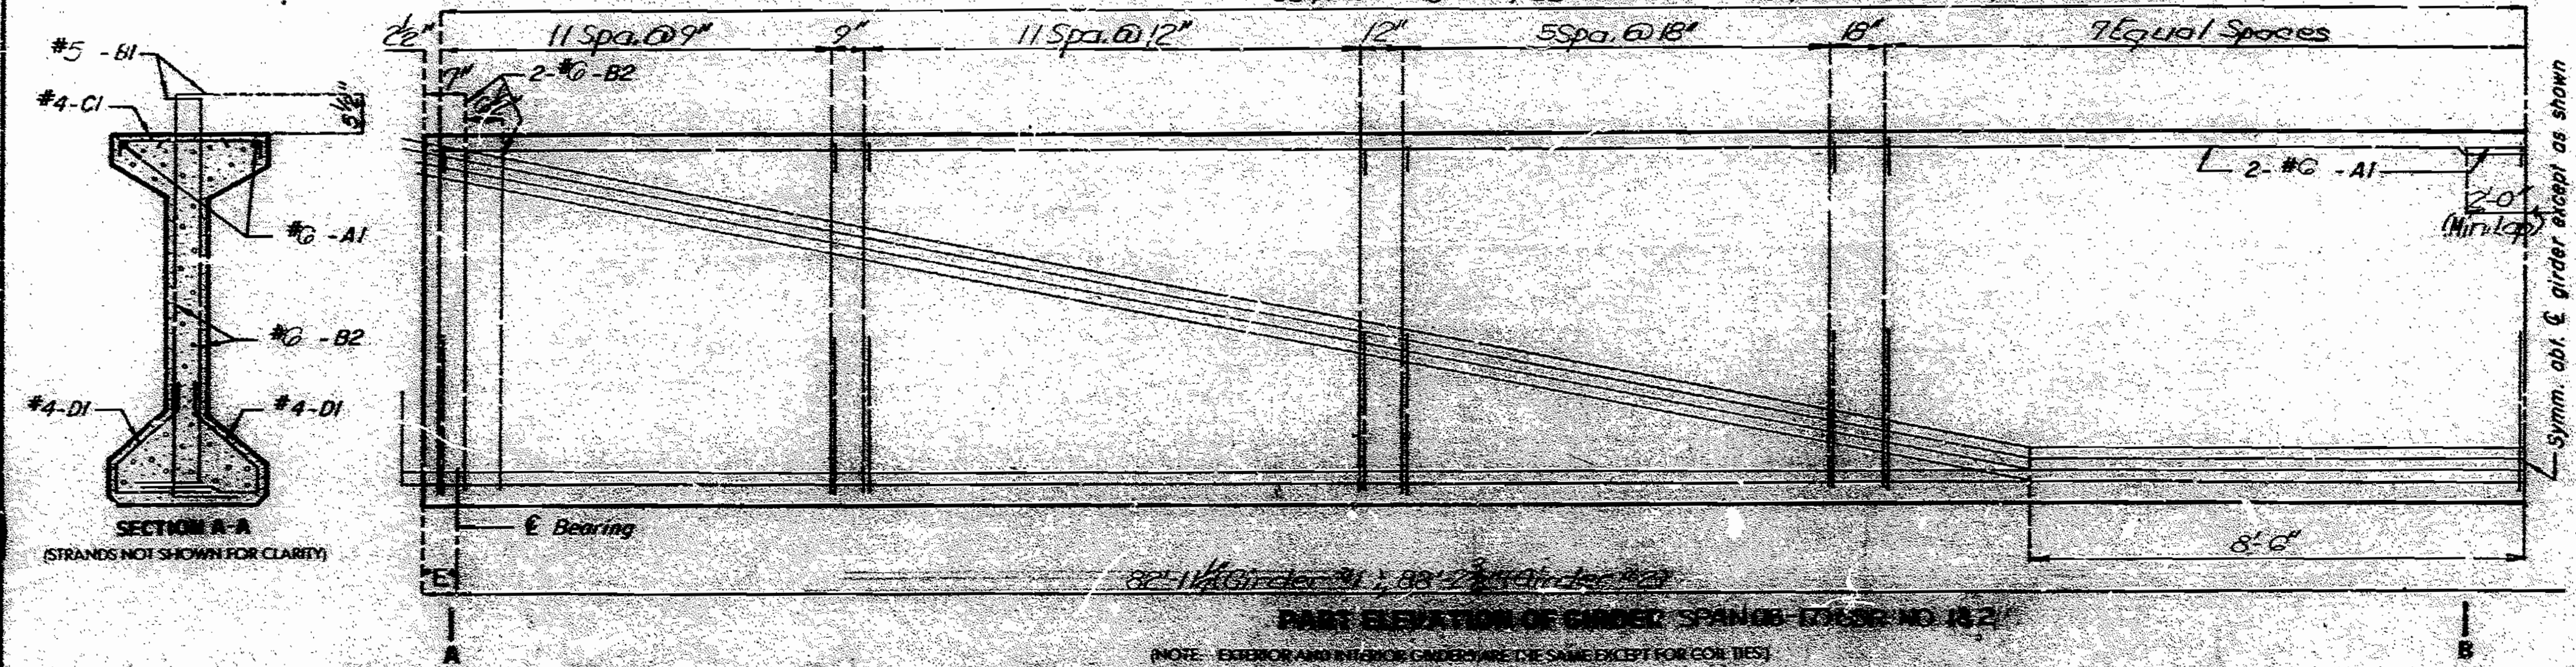

**DETAILS OF COIL TIES AT INT. BENT NO. 16**


**NOTE:**  
 COST OF 3/8" COIL TIE RODS PLACED IN DIAPHRAGMS IS INCLUDED IN CONTRACT UNIT PRICE FOR PRESTRESSED CONCRETE MEMBERS.  
 COIL TIES SHALL BE HELD IN PLACE IN THE FORMS BY SLOTTED WIRE SETTING STUDS PROJECTING THRU FORMS. STUDS ARE TO BE LEFT IN PLACE OR REPLACED WITH TEMPORARY PLUGS UNTIL GIRDERS ARE ERECTED AND THEN REPLACED BY COIL TIE RODS.

**NOTE:**  
 The 1/2" holes shall be cast in the web for steel intermediate diaphragms. Drilling is not allowed.

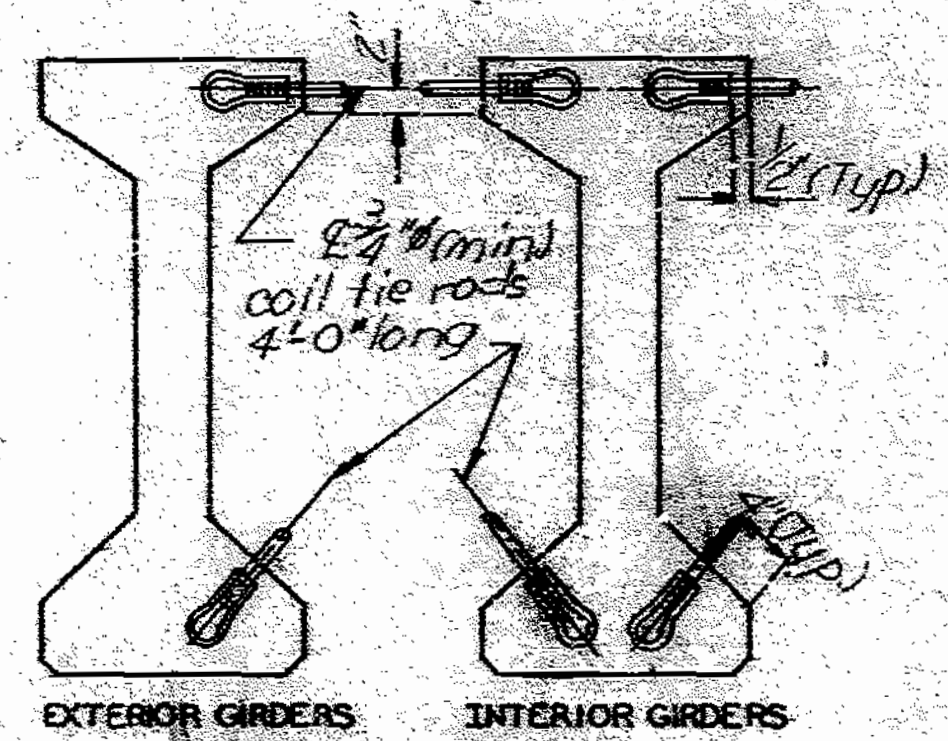


Note: for details of slotted wells to be cast in top of girder at Int. Bt. 17 end only see sheet No. 26.  
 For details of Int. Bt. Diaphr. see sheet No. 67.  
 For location of Int. Diaphr. and general girder placement see sheet No. 69.  
 For Girder Camber and haunching see sheet No. 69.

#5 - B1 (Girder #1, #2) #4 - B1 #10  
 #4 - C1 (Girder #1, #2) #4 - B1 #17  
 #4 - D1 (Girder #1)  
 #4 - D1 (Girder #2)

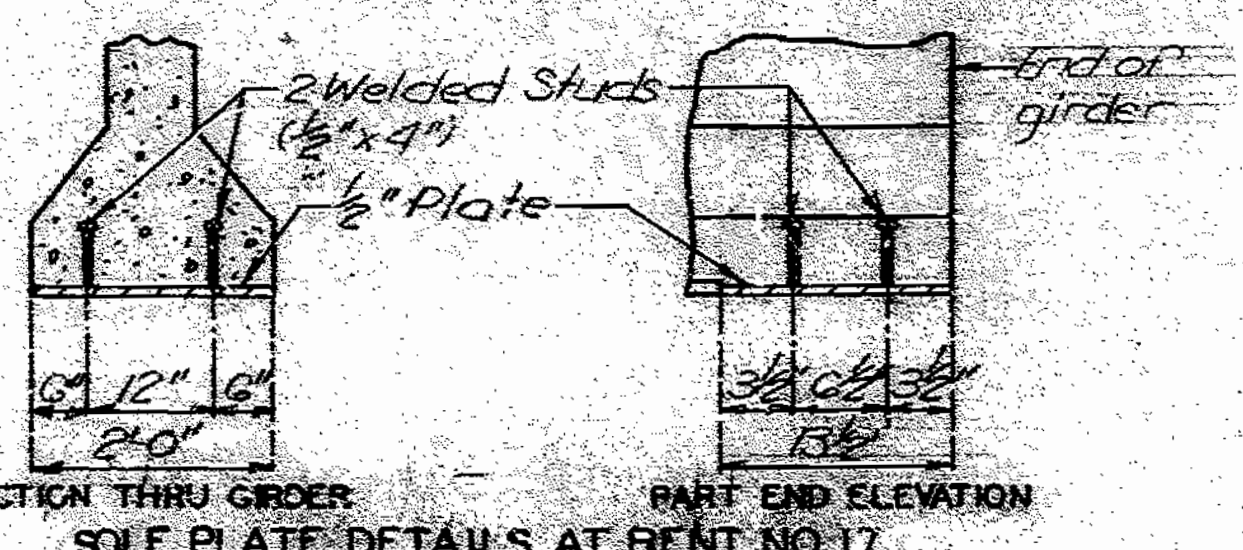

Note: Sole Plate to be placed at Bent No. 17 end of girder only.

Note: This drawing is not to scale. Follow dimensions.

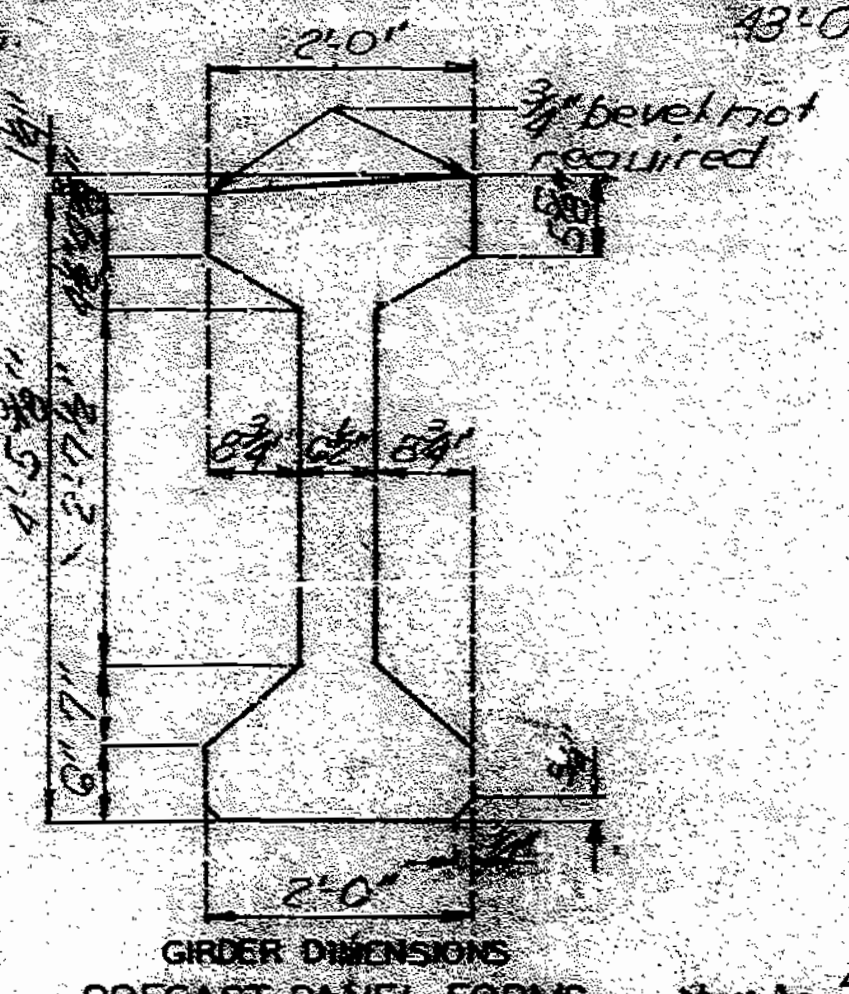

175 140


SPS 55.6.6 1/2 (REVISED) JUN 1987  
 FEB. 1974

DETAILED APR. 1988  
 CHECKED OCT. 1988



**NOTE:**  
 CONCRETE FOR PRESTRESSED GIRDERS SHALL BE CLASS 'A' WITH  $f_c = 5000$  PSI.  
 (+) INDICATES PRESTRESSED STRAND.  
 USE #2 STRANDS WITH AN INITIAL PRESTRESS FORCE OF 300 KIPS.  
 PRESTRESSING TENDONS SHALL BE UNCOATED, SEVEN-WIRE, LOW RELAXATION STRANDS, 1/2 INCH DIAMETER CONFORMING TO A.A.S.H.T.O. M203, GRADE 270. SEE MO. STD. SPECIFICATIONS 705.4.8.



STATE	PROJ. NO.	SHEET NO.
MO		134

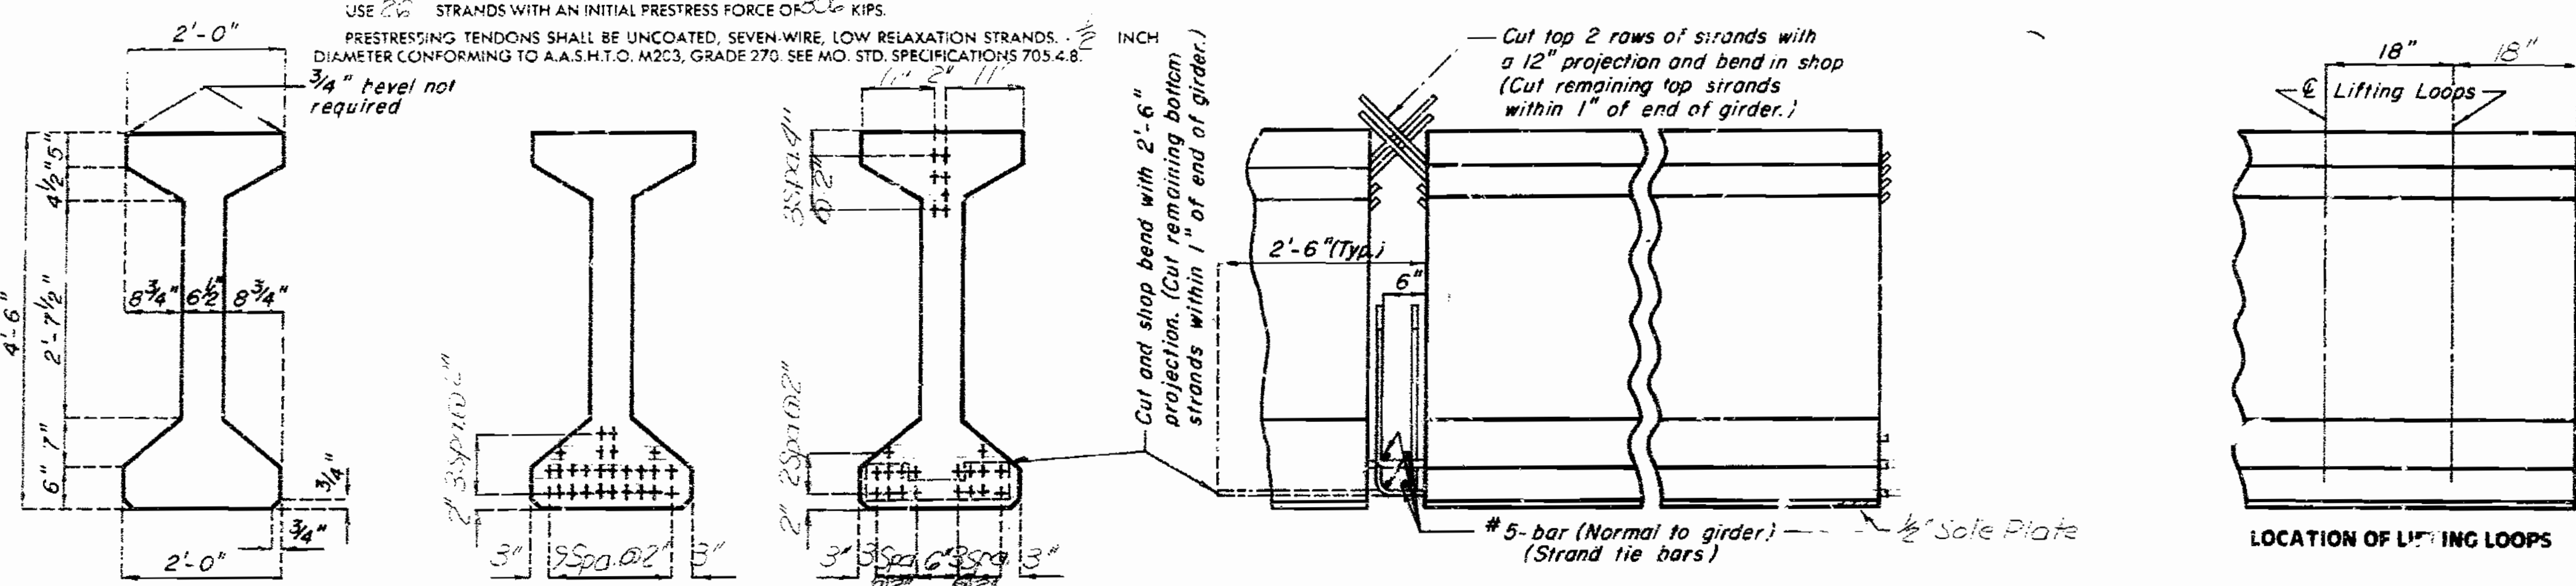




**SCHEDULE OF REINFORCING STEEL - EACH GIRDER**

NO.	SIZE & MARK	ACTUAL LENGTH	SHAPE	BENDING DIAGRAMS
4	#6 A1	①	20	SHAPE 10
150	#5 B1	5'-11"	11	
8	#6 B2	5'-4"	11	SHAPE 11
75	#4 C1	2'-2"	10	
150	#4 D1	3'-0"	9	

**NOTE:**  
 ALL DIMENSIONS IN BENDING DIAGRAM ARE OUT TO OUT.  
 HOOKS AND BENDS SHALL BE IN ACCORDANCE WITH THE CRSI MANUAL OF STANDARD PRACTICE FOR DETAILING REINFORCED CONCRETE STRUCTURES STIRRUP AND TIE DIMENSIONS.  
 ACTUAL LENGTHS ARE MEASURED ALONG CENTERLINE BAR TO THE NEAREST INCH.  
 MINIMUM CLEARANCE TO REINFORCING SHALL BE 1".  
 ALL REINFORCEMENT SHALL BE GRADE 60.  
 THE TWO D1 BARS MAY BE FURNISHED AS ONE BAR AT THE FABRICATOR'S OPTION.

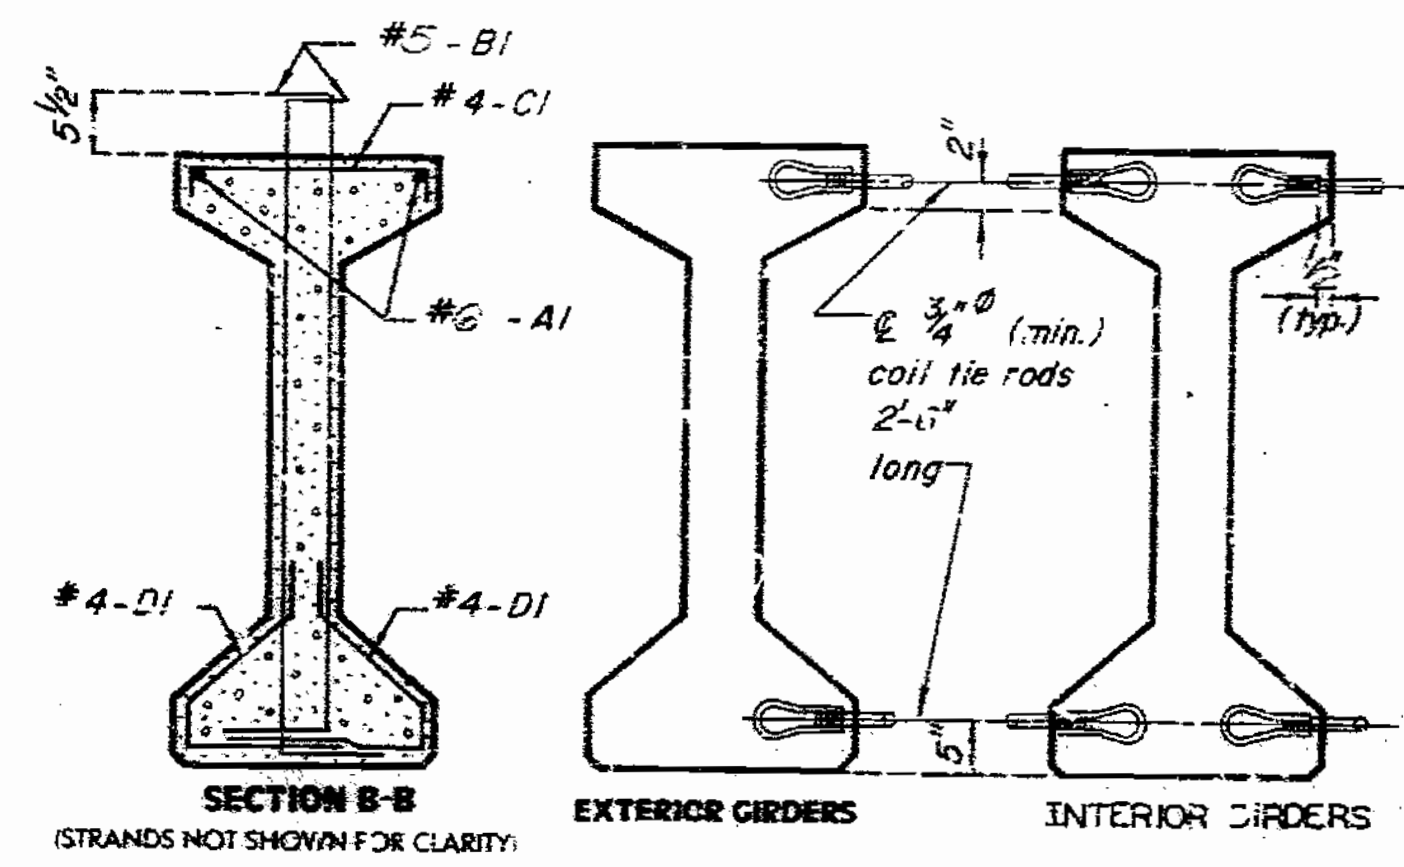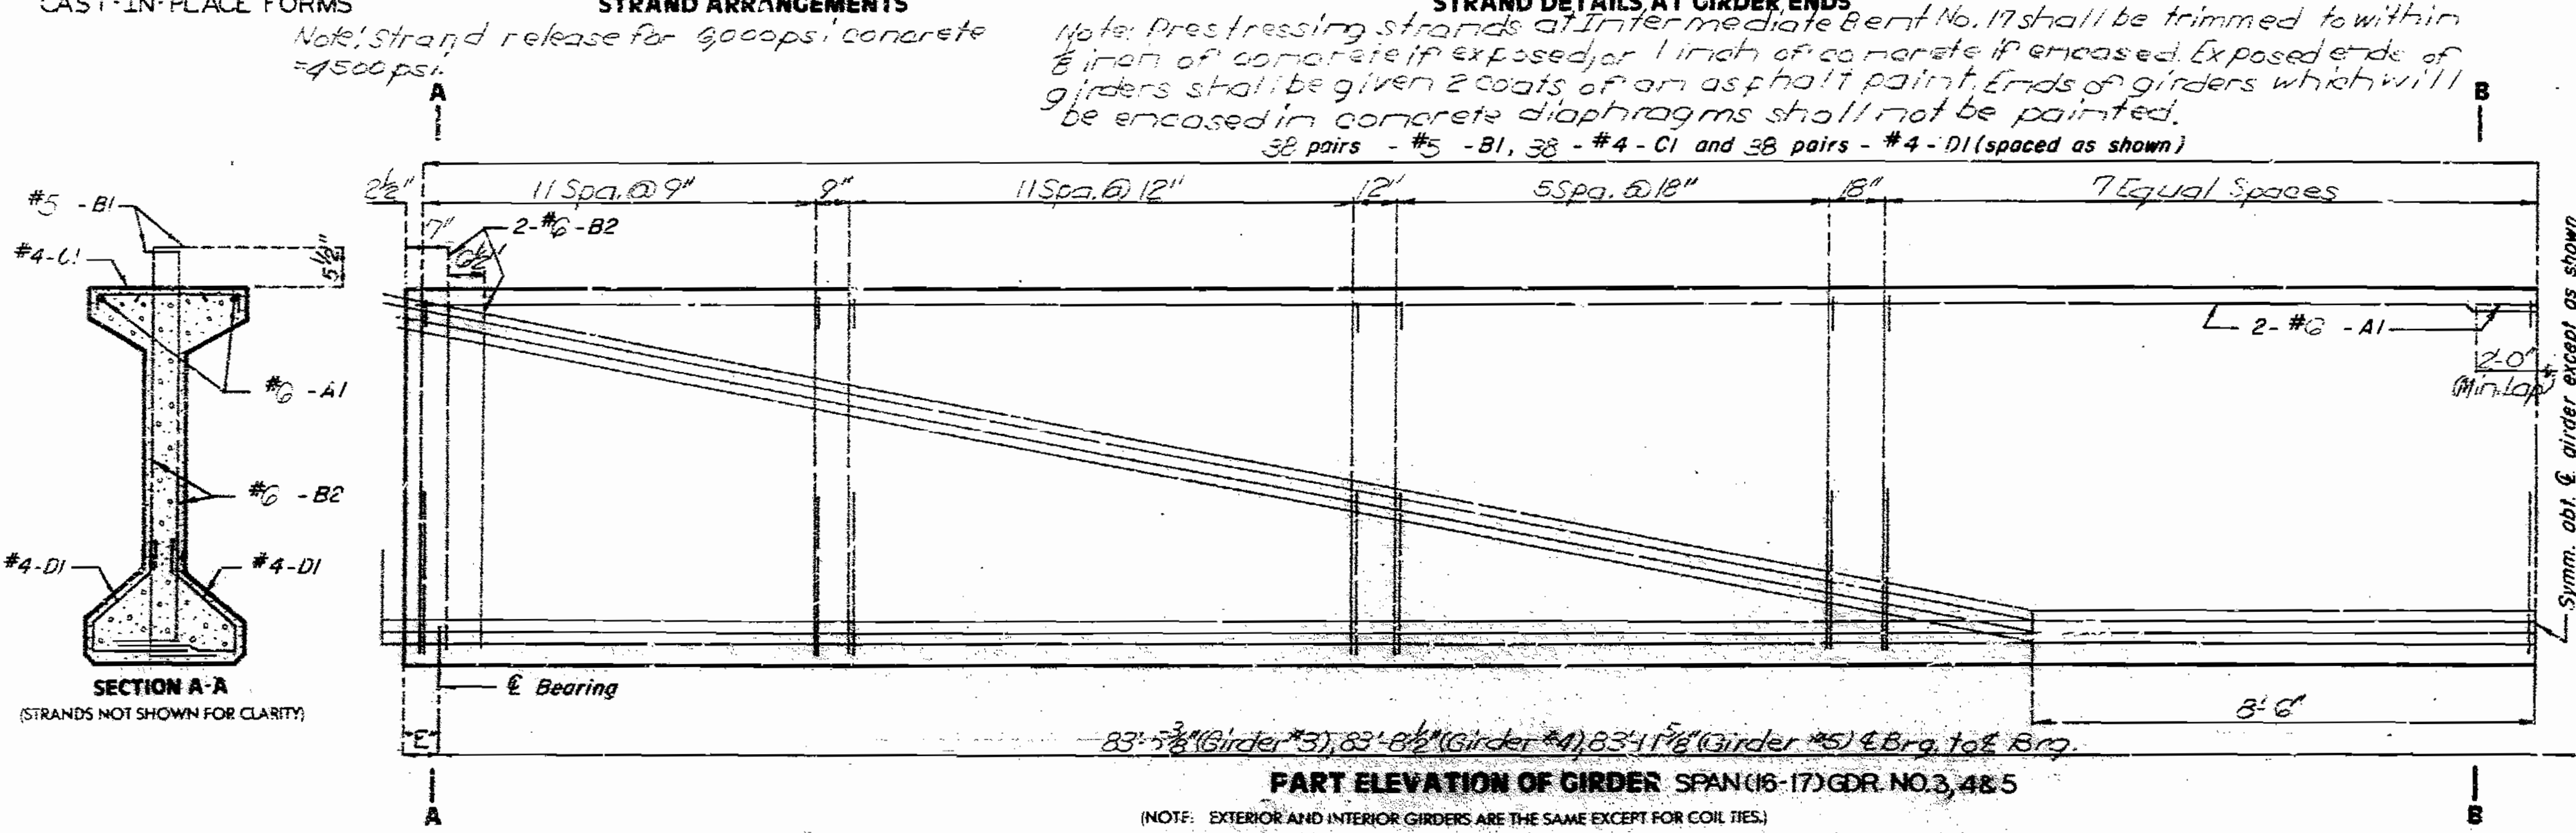

**NOTE:**  
 COST OF 3/4" COIL TIE RODS PLACED IN DIAPHRAGMS IS INCLUDED IN CONTRACT UNIT PRICE FOR PRESTRESSED CONCRETE MEMBERS.  
 COIL TIES SHALL BE HELD IN PLACE IN THE FORMS BY SLOTTED WIRE-SETTING STUDS PROJECTING THRU FORMS. STUDS ARE TO BE LEFT IN PLACE OR REPLACED WITH TEMPORARY PLUGS UNTIL GIRDERS ARE ERECTED AND THEN REPLACED BY COIL TIE RODS.  
**NOTE:**  
 The 1/2" holes shall be cast in the web for steel intermediate diaphragms. Drilling is not allowed.

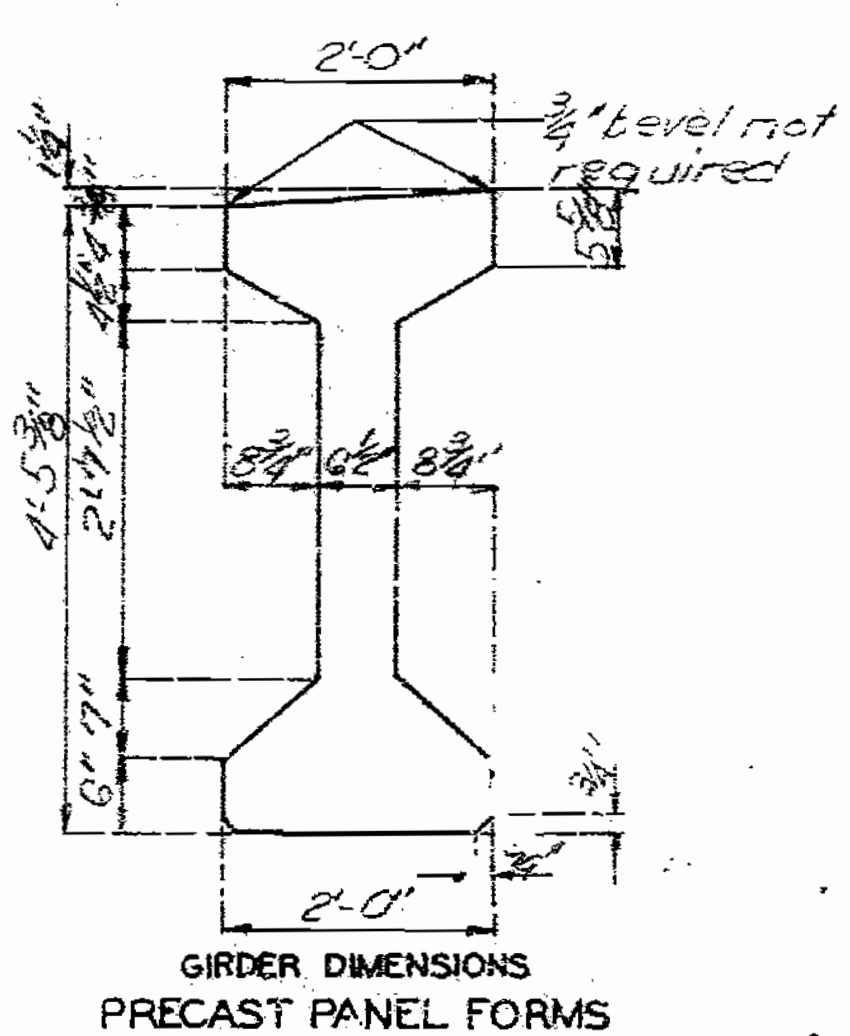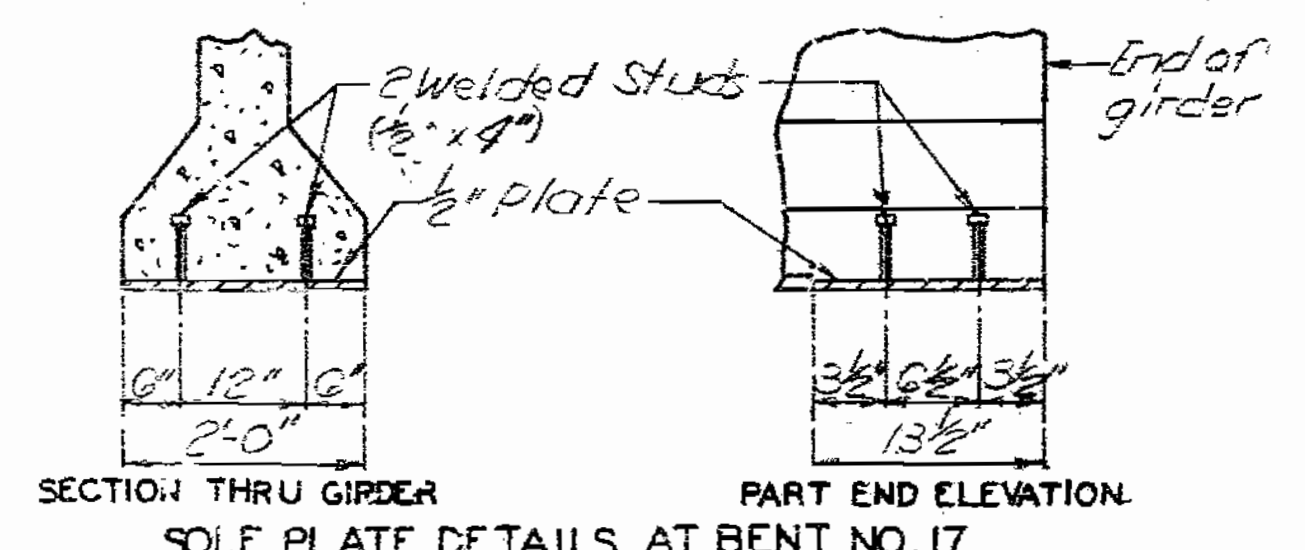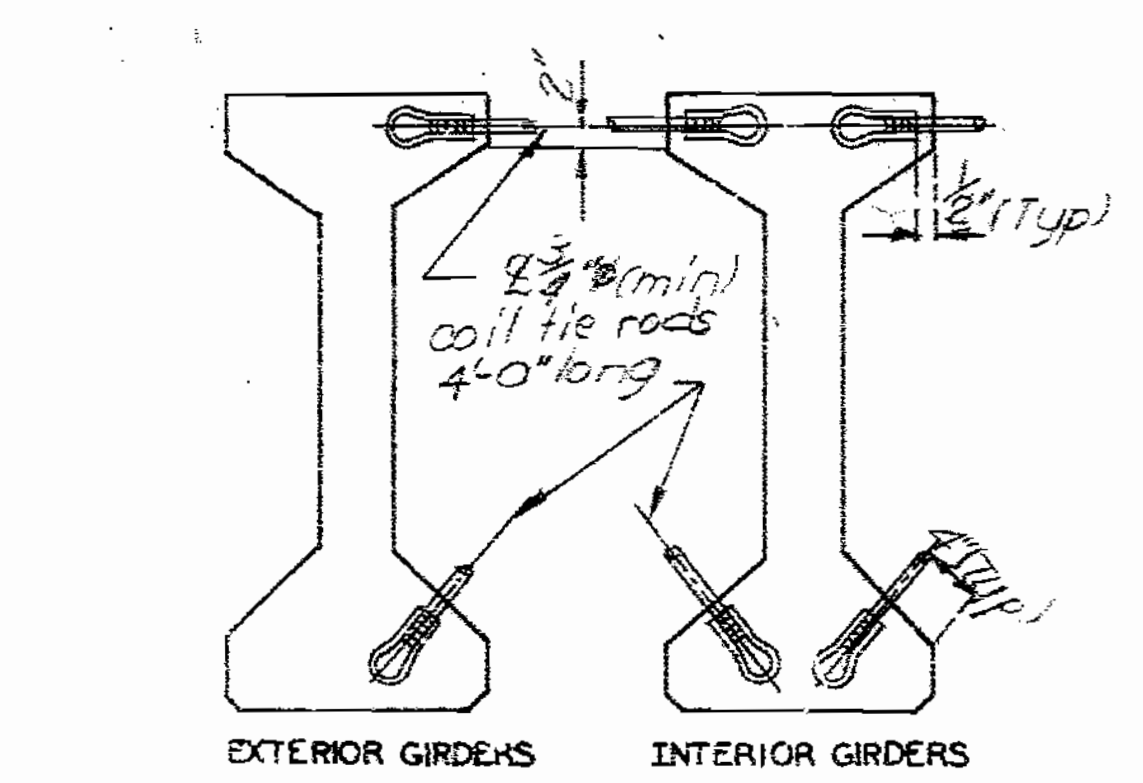


**Note:** For details of slotted wells to be cast in top of girder at Int. Bt. (Excl. on 14) see sheet No. 86.  
 For details of Int. Bt. Diaph. see sheet No. 67.  
 For location of Int. Diaph. and general girder placement see sheet No. 26.  
 For Girder Camber and haunching see sheet No. 69.

**Note:** Sole plate to be placed at Bent No. 17 end of girder only.  
**Note:** This drawing is not to scale. Follow dimensions.

176189

REVISOR: JUNE 1987  
 SPS 55.6.6.2  
 FEB 1974  
 DETAILED APR. 1988  
 CHECKED OCT. 1988


STATE	PROJ NO	SHEET NO
MO		135

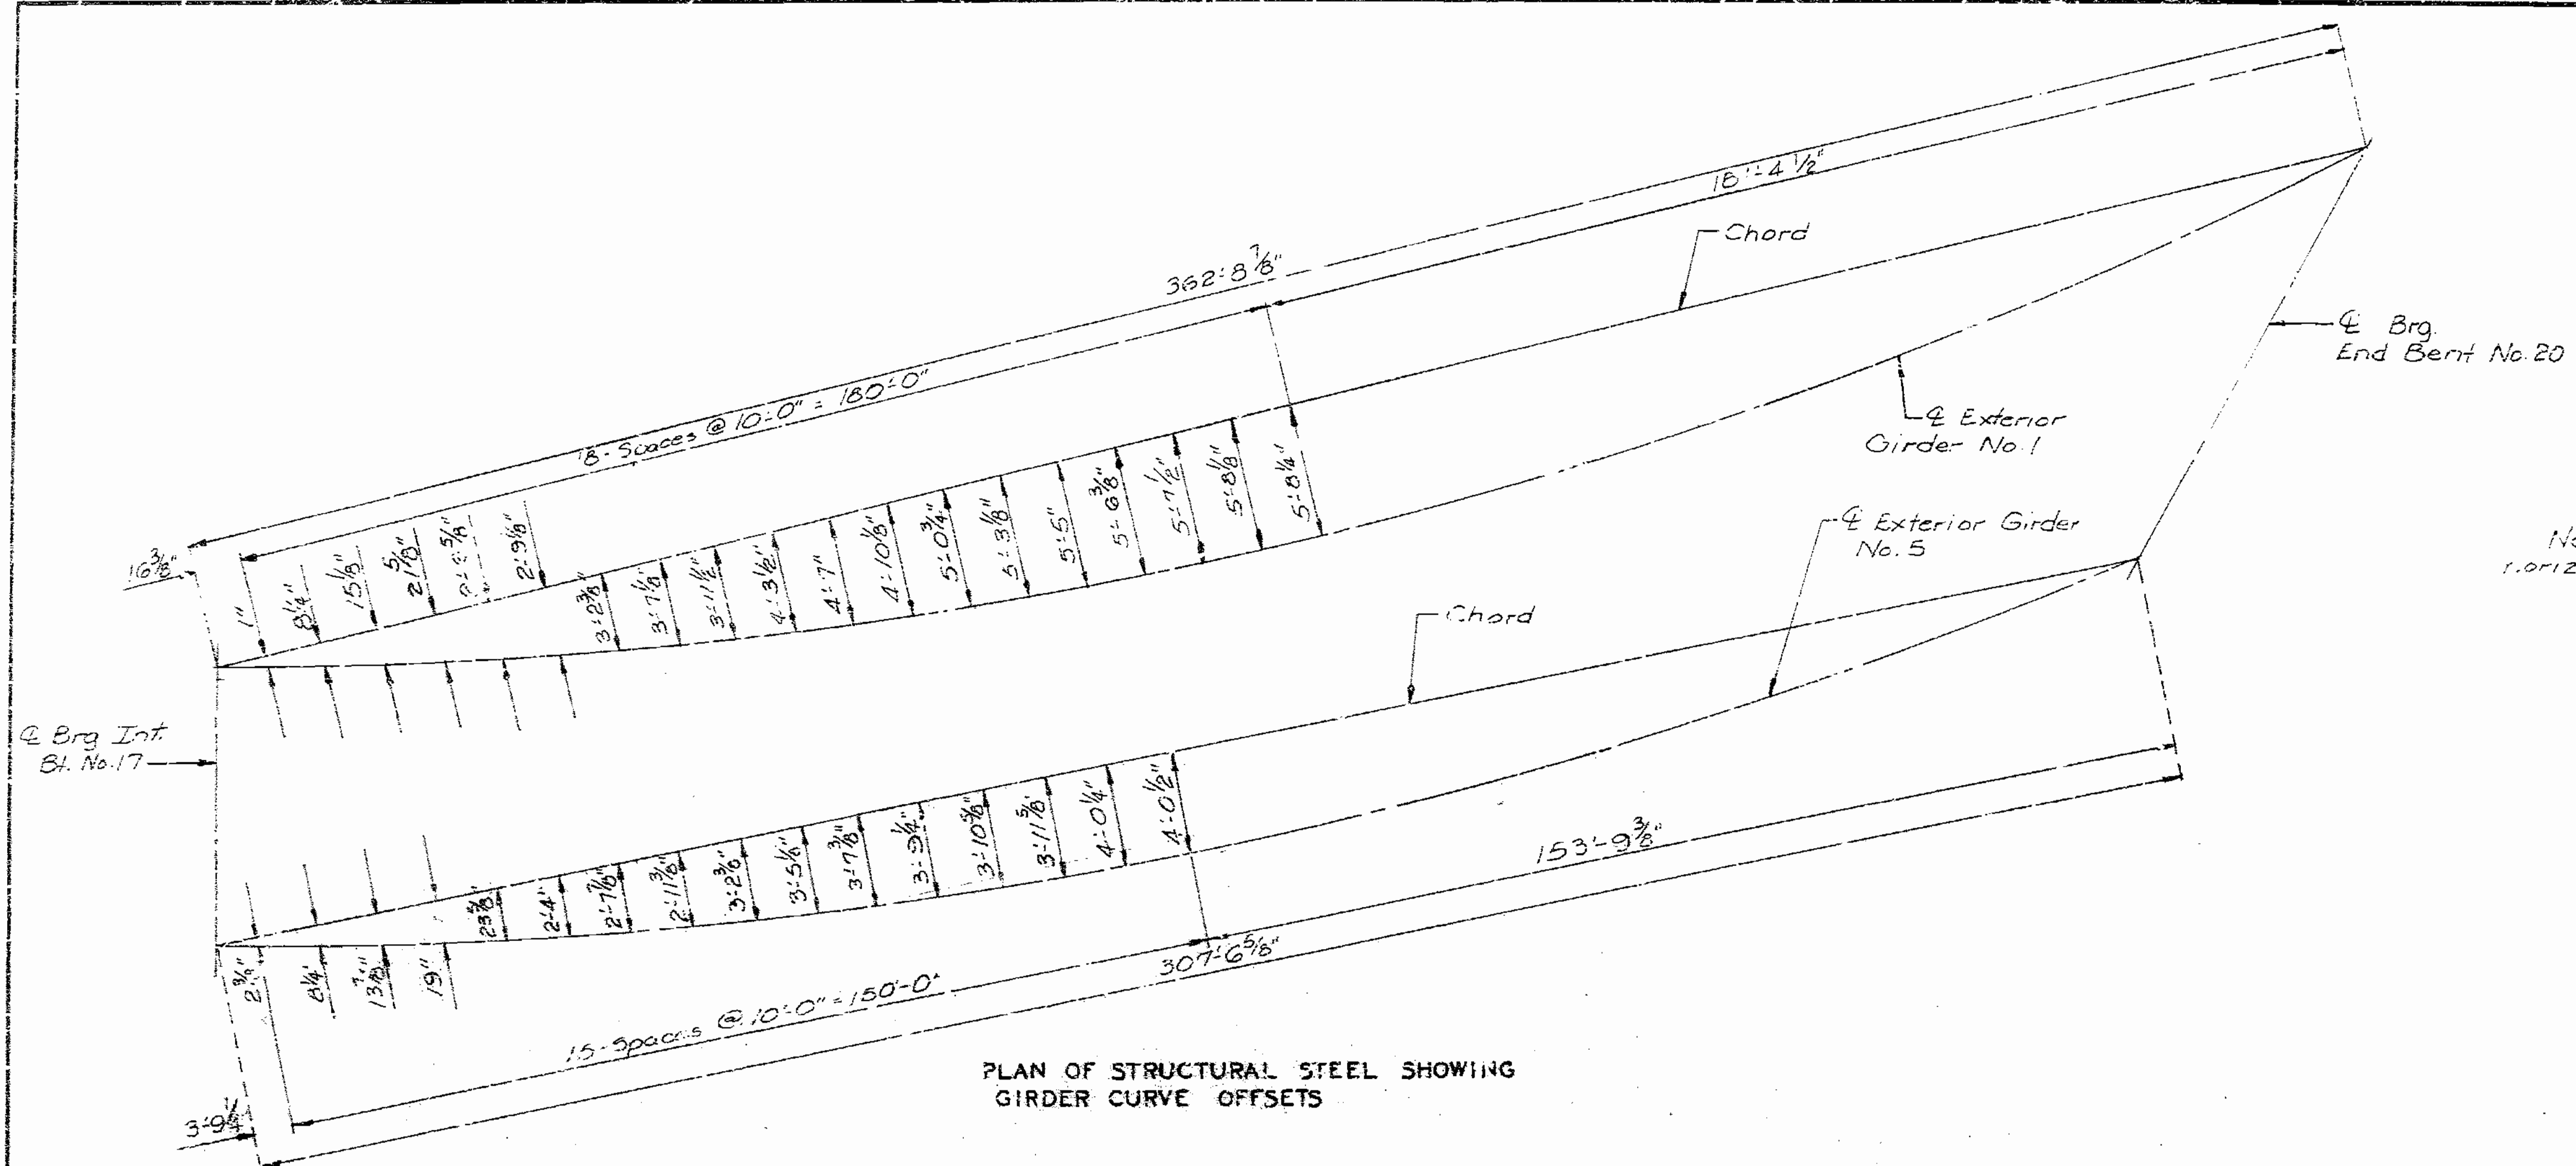

PLAN OF STRUCTURAL STEEL SHOWING GIRDER CURVE OFFSETS

Note: Dimensions shown are horizontal.

777150

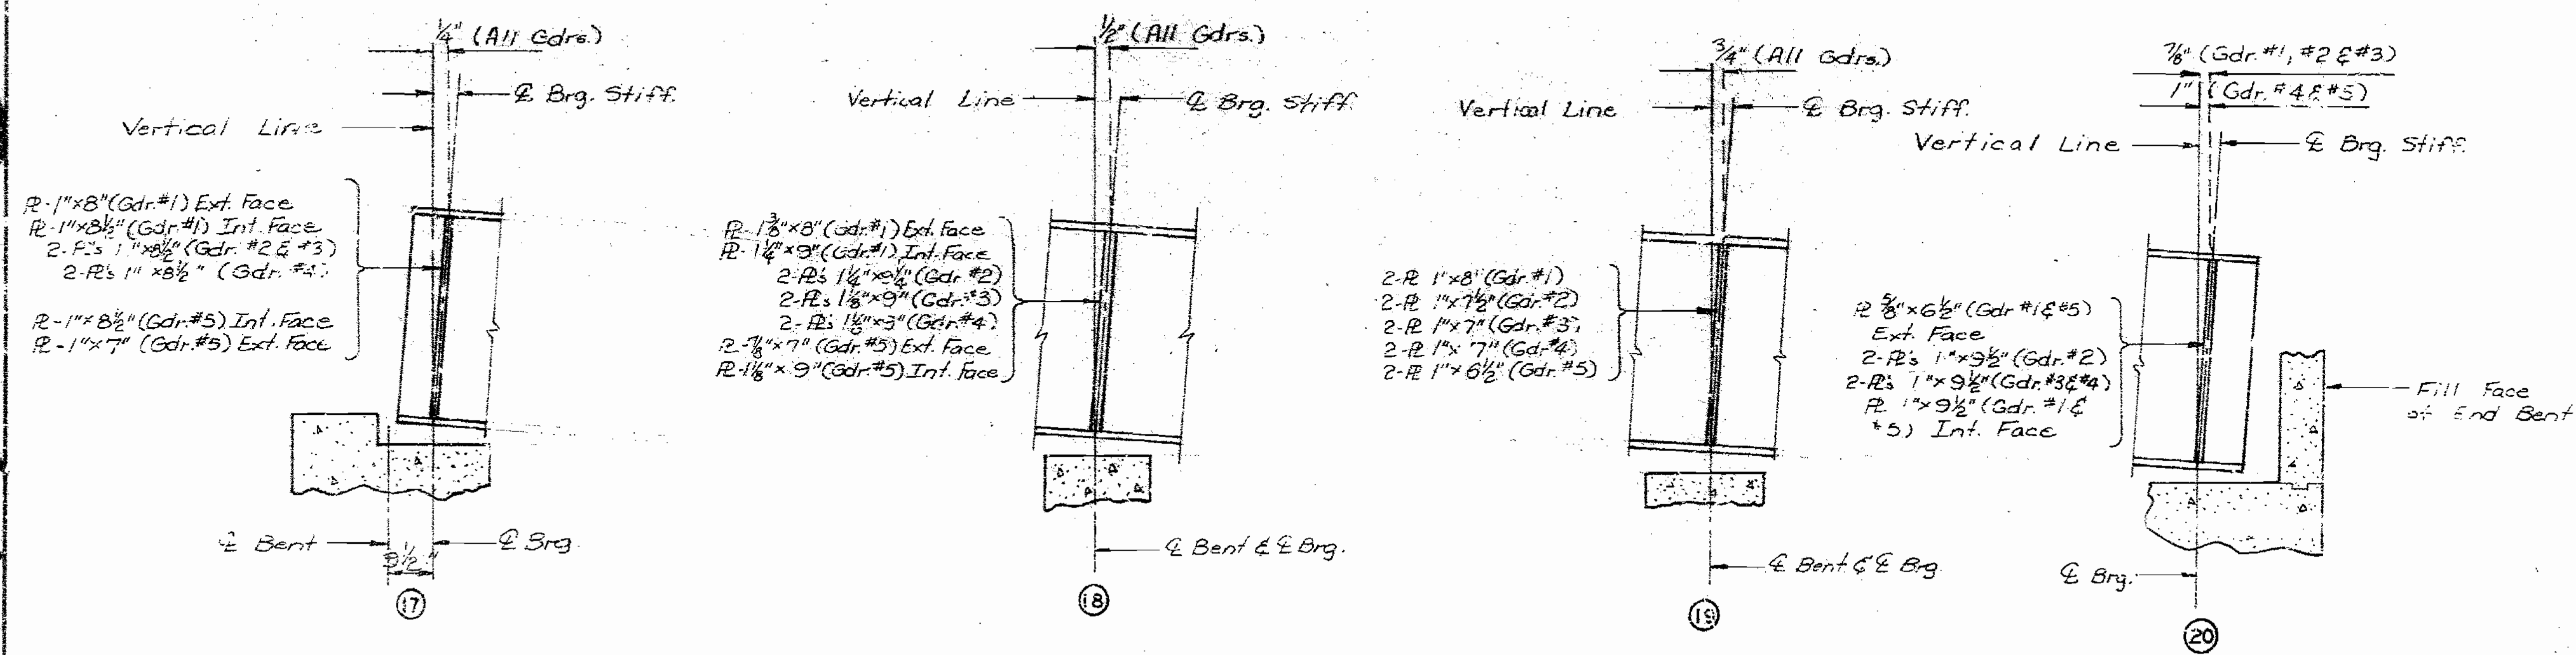

PART LONGITUDINAL SECTION

DESIGNED July 1988  
CHECKED Feb. 1989



Note: This drawing is not to scale. Follow dimensions.

Sheet No. 55 of 98

JACKSON COUNTY

A-2745

STATE	PROJ. NO.	SHEET
MO.		136

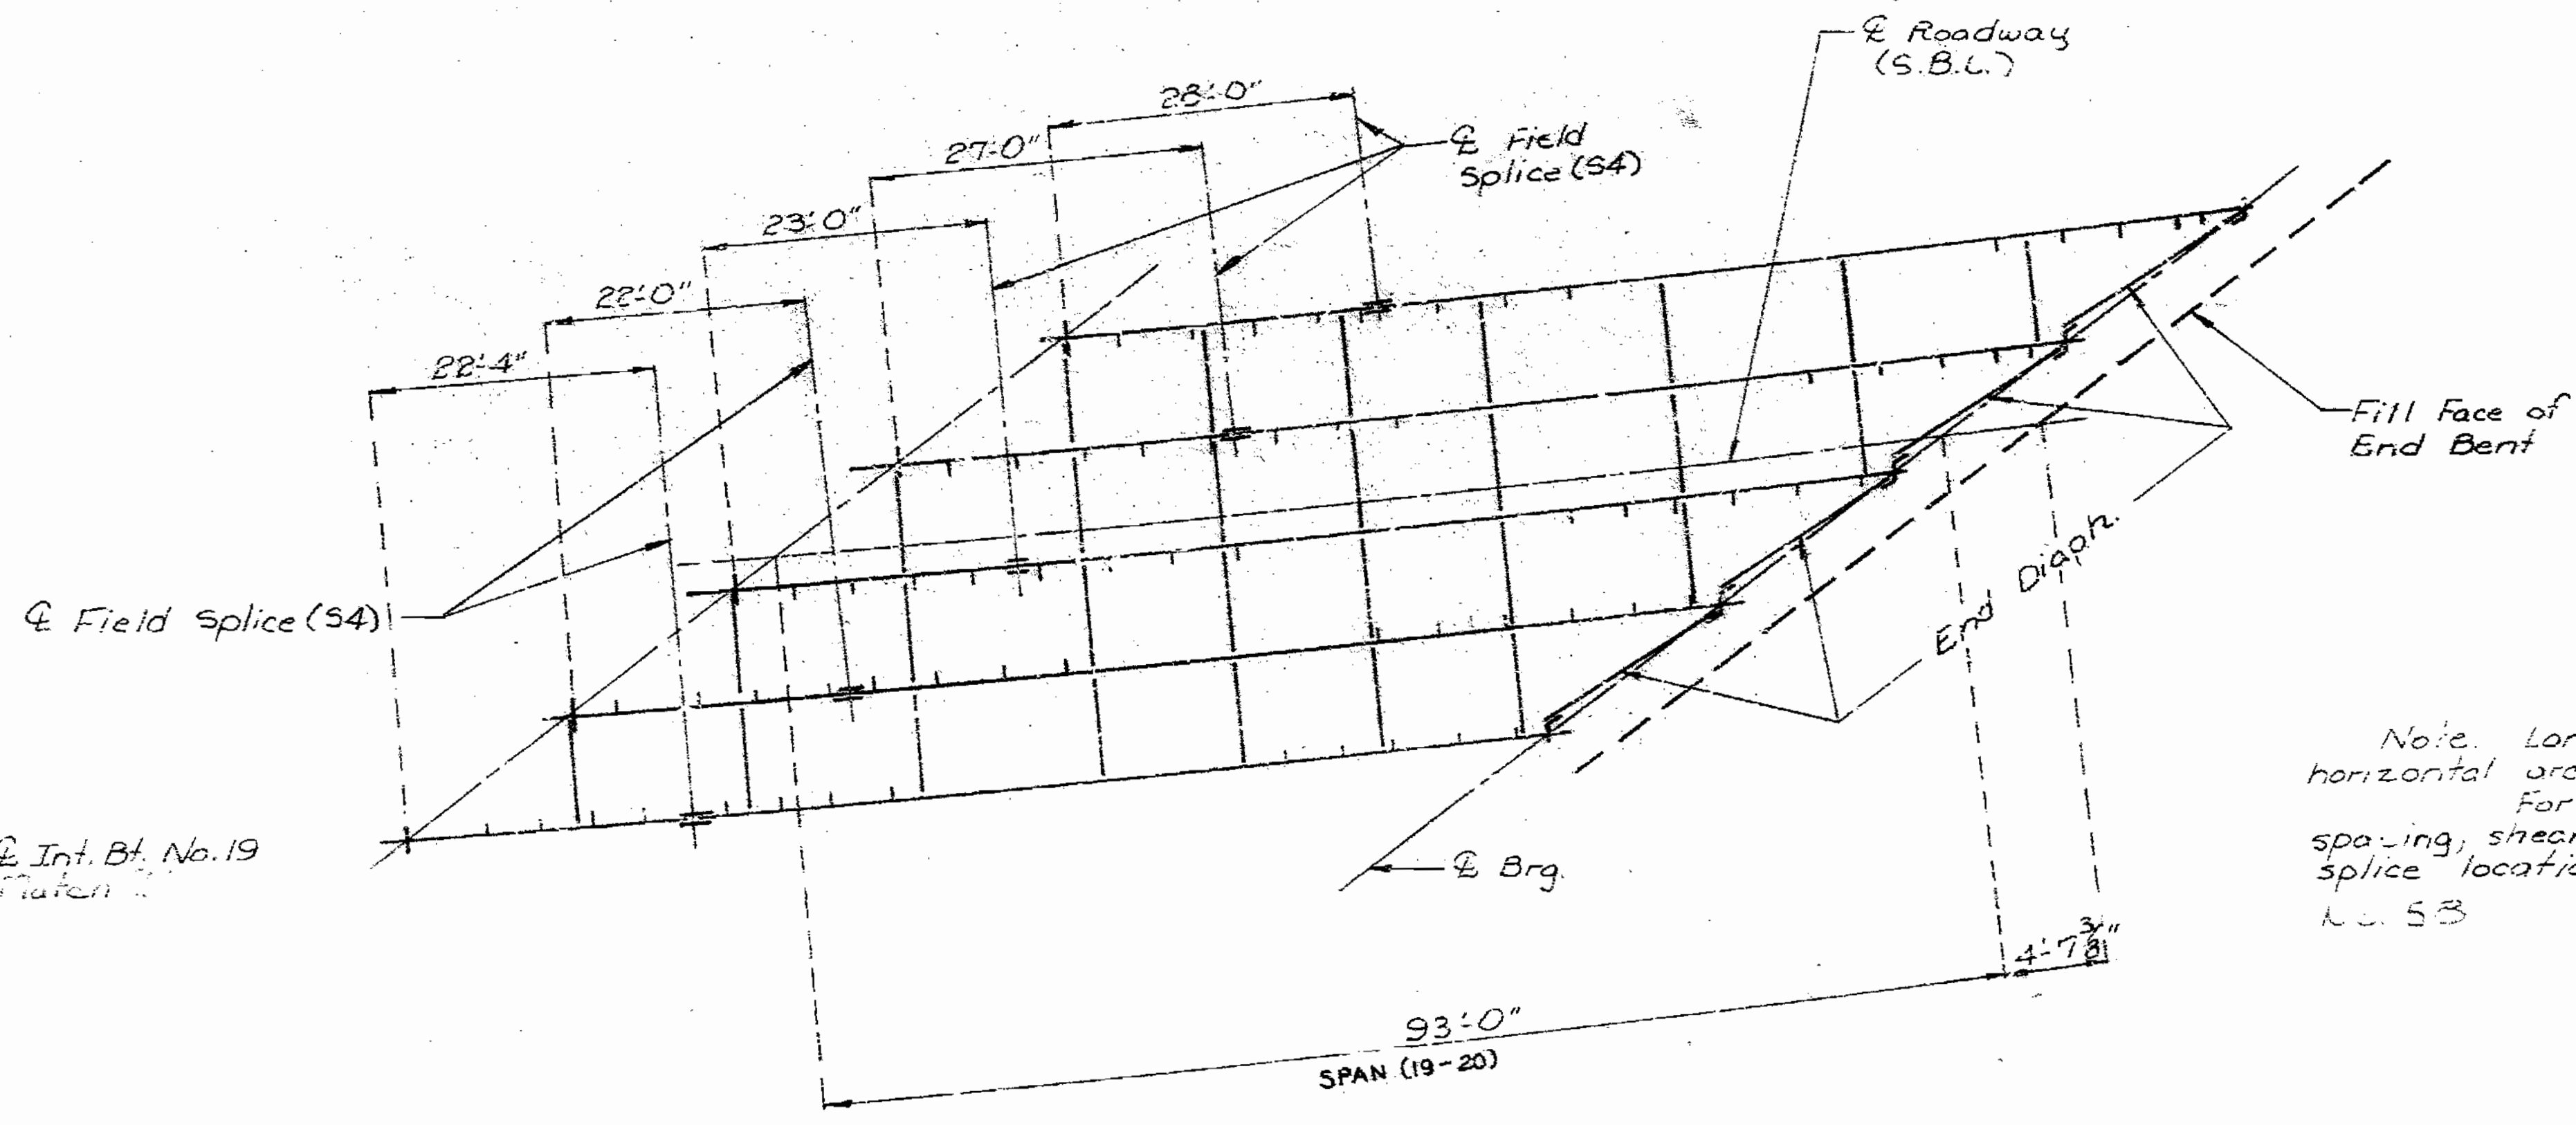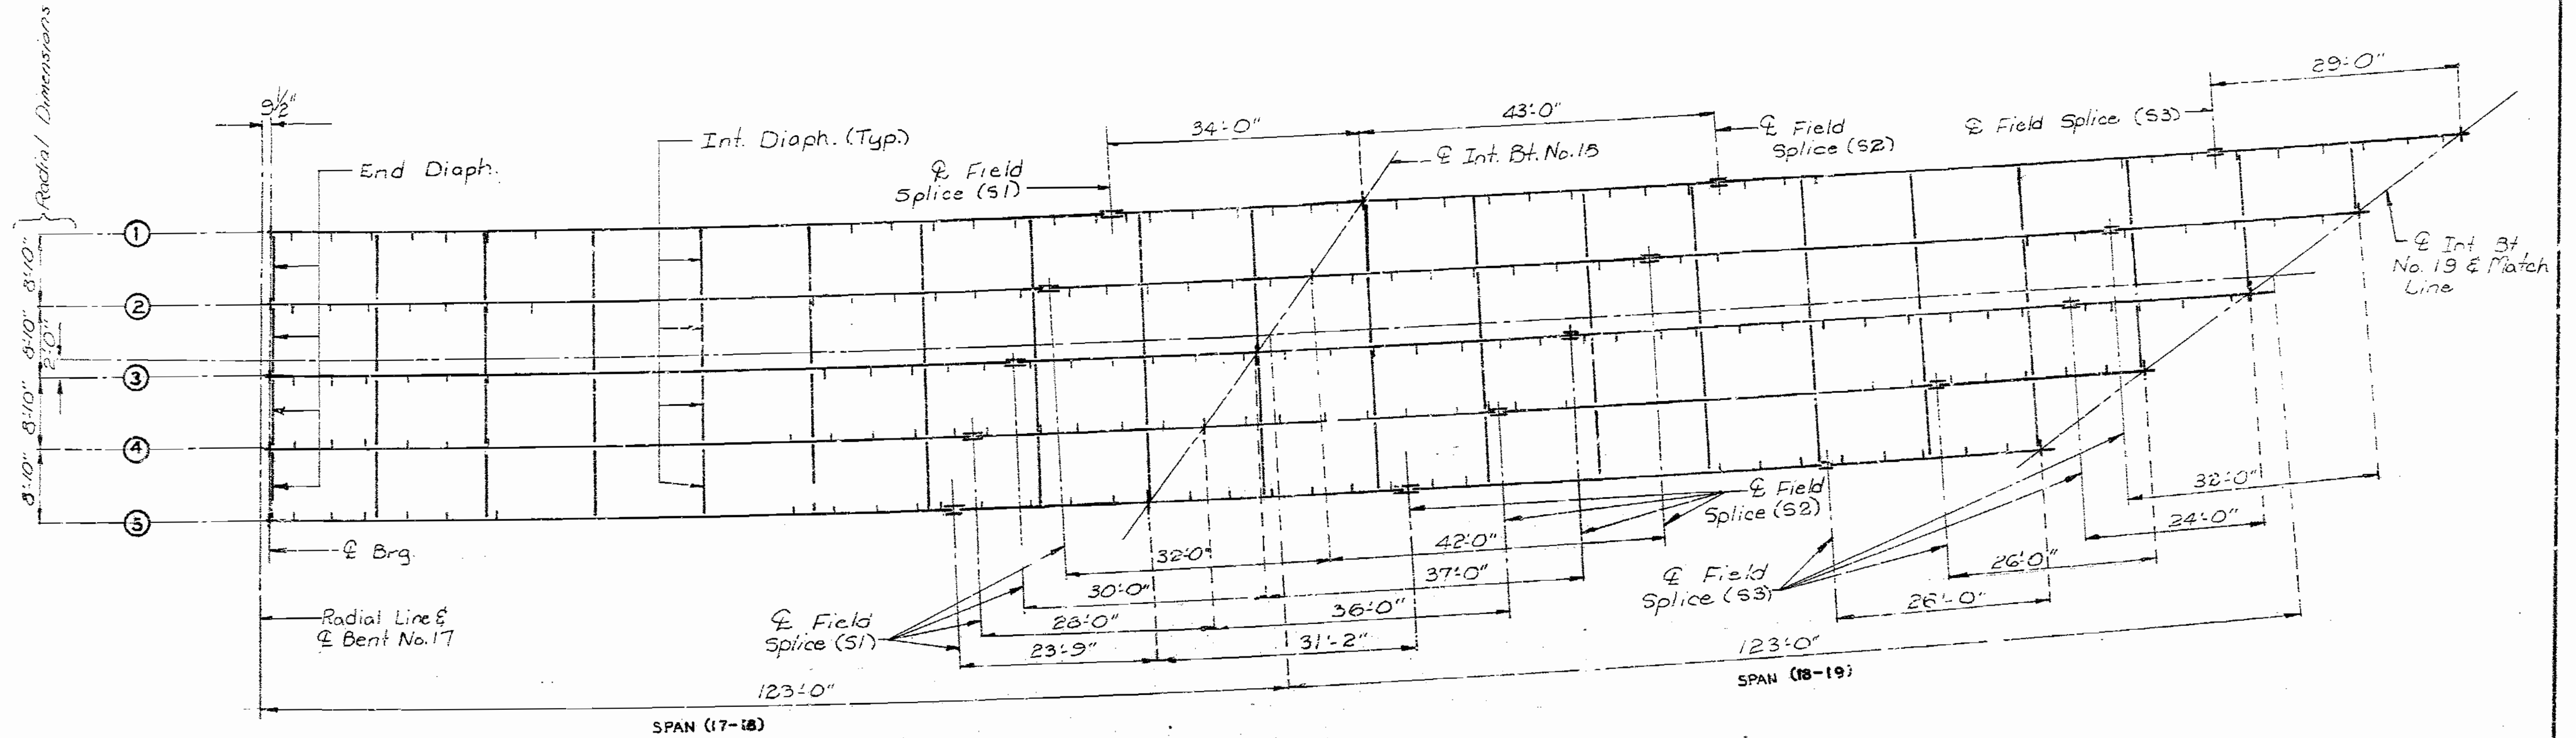

Note: Longitudinal dimensions are horizontal and dimensions.  
 For diaph. spacing, web stiff spacing, shear connector spacing and splice locations see sheet No. 57 & No. 53

151871

PLAN OF STRUCTURAL STEEL

DETAILED July 1988  
 CHECKED Feb. 1989

Note: This drawing is not to scale. Follow dimensions.

Sheet No. 56 of 93


STATE	PROJ. NO.	SHEET NO.
MO.		137

GIRDER NO. 1		134'-5 1/2"		
" " 2		127'-10 1/2"		
" " 3		121'-3 3/8"		
" " 4		114'-9"		
" " 5		108'-2 1/2"		
GIRDER NO. 1	7"	99'-10 1/2"	34'-0"	43'-0"
" " 2	7"	95'-3 1/2"	32'-0"	42'-0"
" " 3	7"	90'-8 5/8"	30'-0"	37'-0"
" " 4	7"	86'-2"	28'-0"	36'-0"
" " 5	7"	83'-10 1/2"	23'-9"	31'-2"

Notes:  
 Plate girders shall be fabricated to conform with Camber Diagram shown on sheet No. 69.  
 Transverse web stiffeners shall be oriented as shown in plan of structural steel.  
 Intermediate web stiffener plate and diaphragm spacings may vary from plan dimensions by a maximum of 3" for diaphragm to connect to intermediate web stiffener plate.  
 Fabricated structural steel shall be A36 except as noted.  
 Longitudinal dimensions are horizontal arc dimensions along centerline of girder.  
 \*\*\* Indicates Flange Plate subject to notch toughness requirements.  
 For details of earthquake restrainers, see sheet No. 61 & 62.  
 All web plates shall be subject to notch toughness requirements.  
 Heat curving of girders in spans (17-18) will not be allowed while in a horizontal position.

GIRDER NO. 1		74- Shear Connector Units (Spaced as shown)				
" " 2		71- " " " " " "				
" " 3		68- " " " " " "				
" " 4		65- " " " " " "				
" " 5		64- " " " " " "				
GIRDER NO. 1	16 1/2"	65- Spaces @ 18" (3 per Unit)	19'-18" *	30'-0"	39'-0"	* 18"
" " 2	16"	62- Spaces @ 18" (3 per Unit)	18'-13" *	28'-0"	38'-0"	* 18"
" " 3	15 5/8"	59- Spaces @ 18" (3 per Unit)	18'-18" *	26'-0"	33'-0"	* 18"
" " 4	15 1/4"	56- Spaces @ 18" (3 per Unit)	17'-18" *	24'-0"	32'-0"	* 18"
" " 5	10 3/8"	55- Spaces @ 18" (3 per Unit)	13'-18" *	19'-9"	27'-2"	* 18"

\* 3-Spaces @ 10" (3 per Unit)

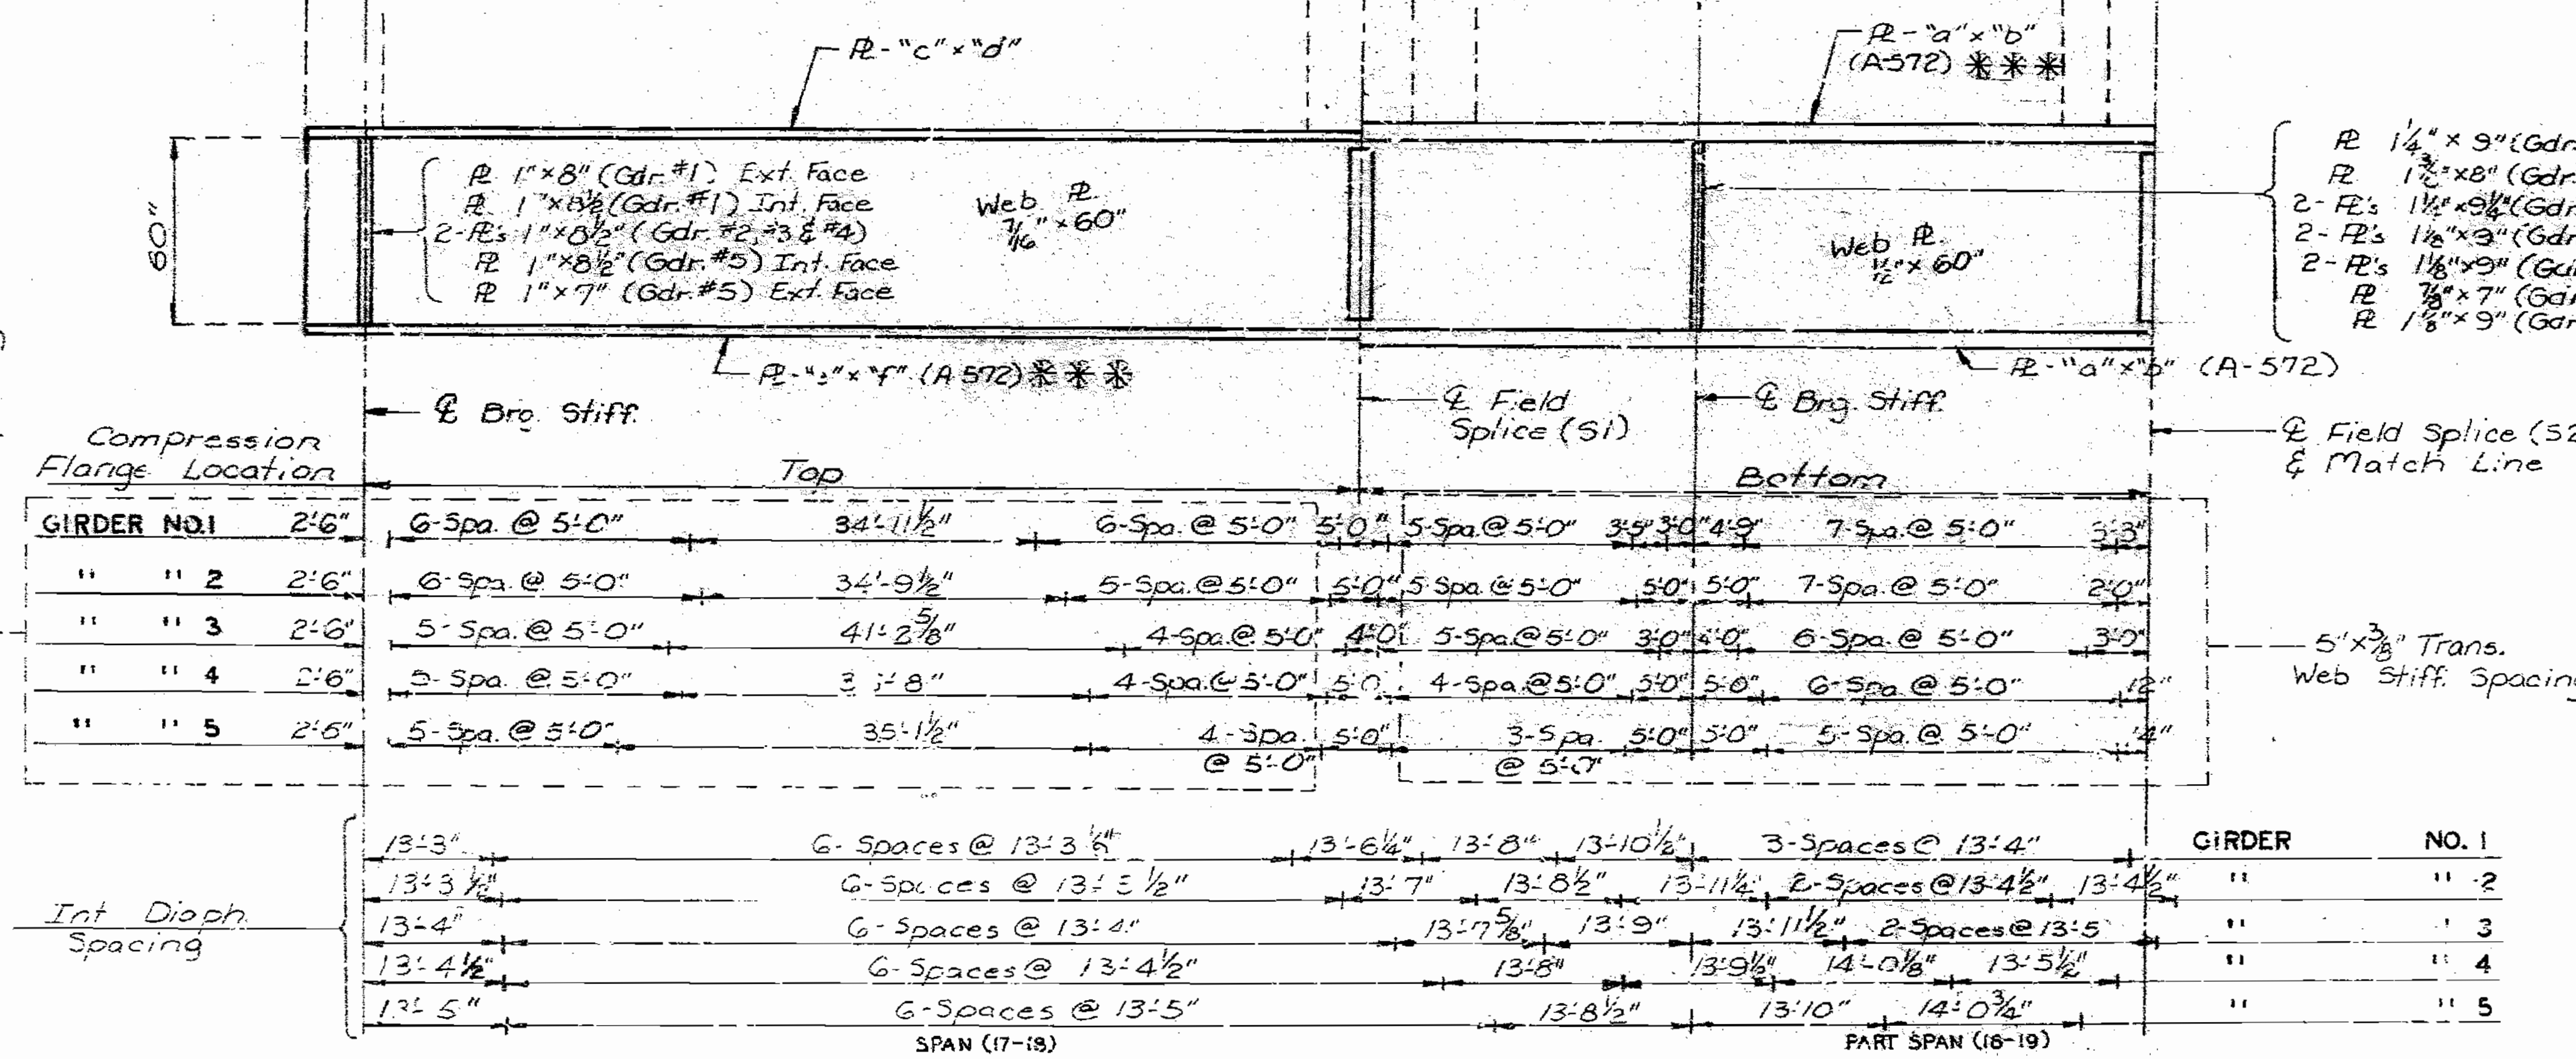

LOCATION	"a"	"b"
Girder No. 5	19'	7"
Girder No. 4	13'	1 1/2"
Girder No. 3	19'	1 3/8"
Girder No. 2	20'	1 1/2"
Girder No. 1	20'	1 1/2"
Girder No. 4 & 5	10'	3"
Girder No. 3	11'	3"
Girder No. 2	11'	1"
Girder No. 1	12'	1"
	"e"	"f"
Girder No. 5	14'	1 1/2"
Girder No. 4	16'	1 1/2"
Girder No. 3	17'	1 1/2"
Girder No. 1 & 2	17'	1 1/2"



PART ELEVATION OF GIRDER

DATE: July 1988  
 CHECKED: Feb 1989

Note: This drawing is not to scale. Follow dimensions.  $\Delta$  Revised 12-1-84




SEE FINAL PLANS  
 Sheet No. 57 of 98

STATE	PROJ NO	SHEET NO
MO		138

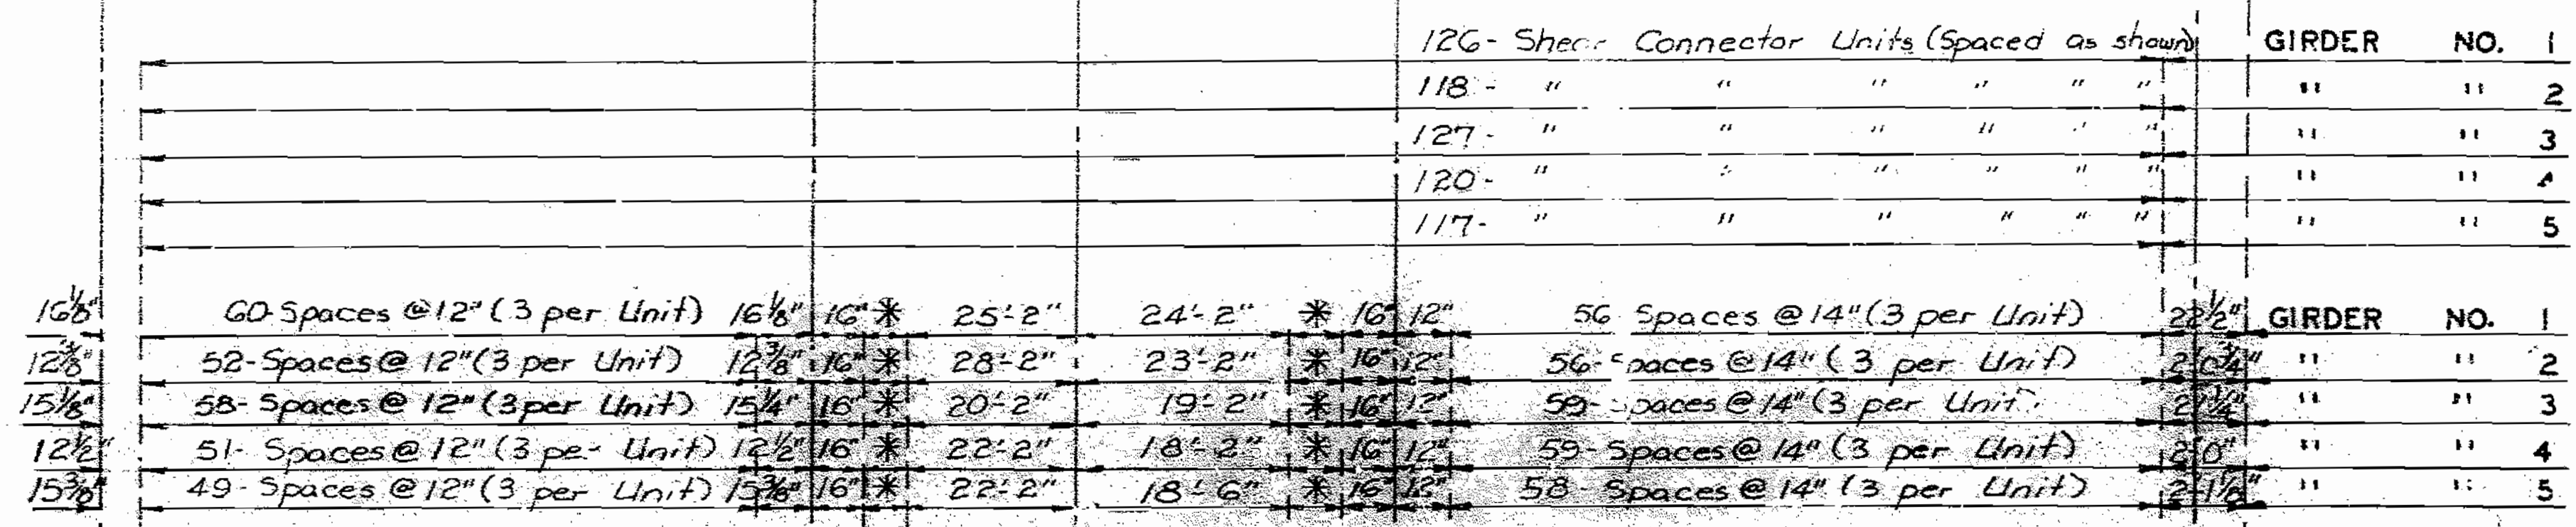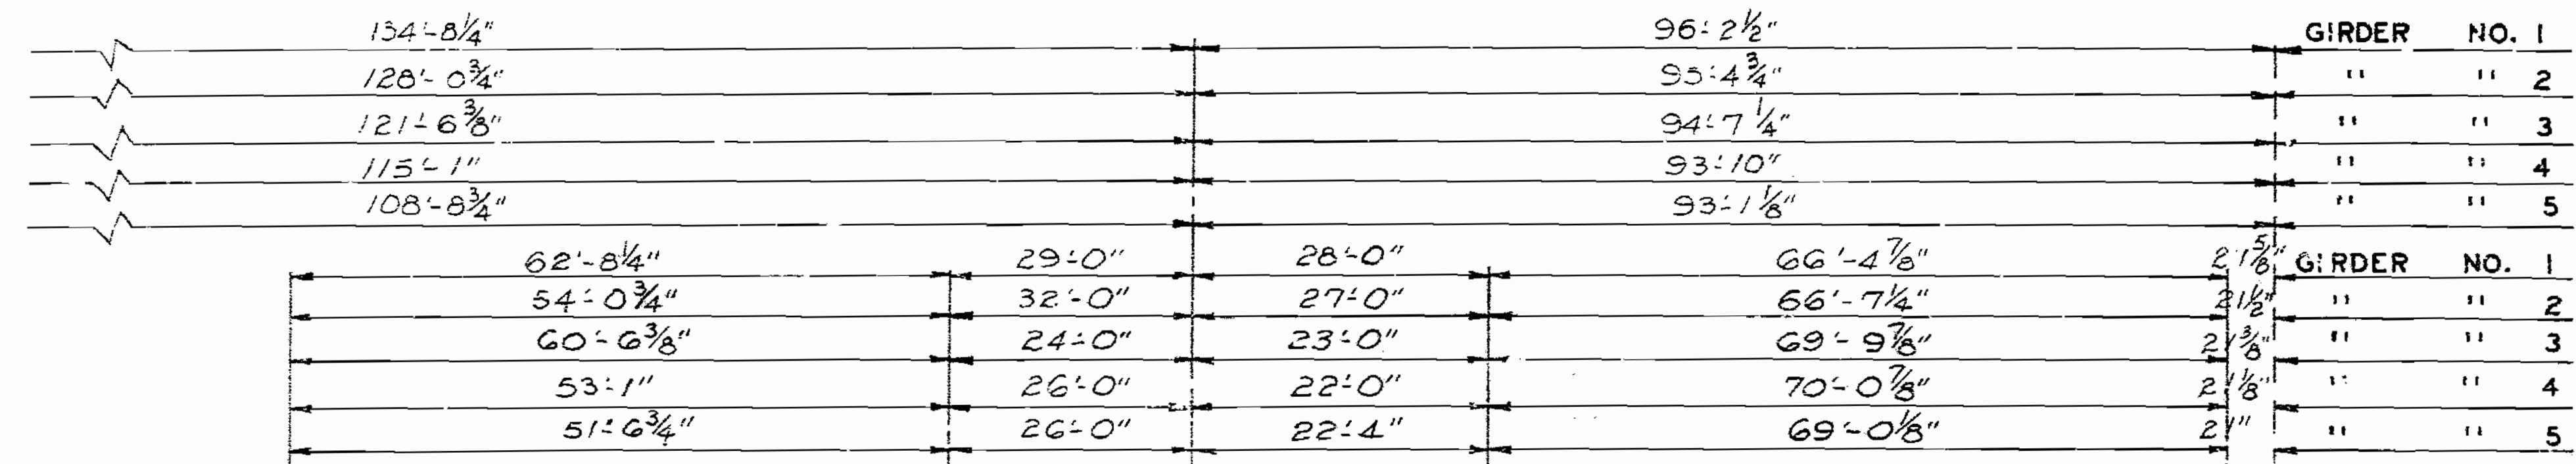

\* 3-spaces @ 10" (3 per Unit)

Note: For notes see sheet No. 57.

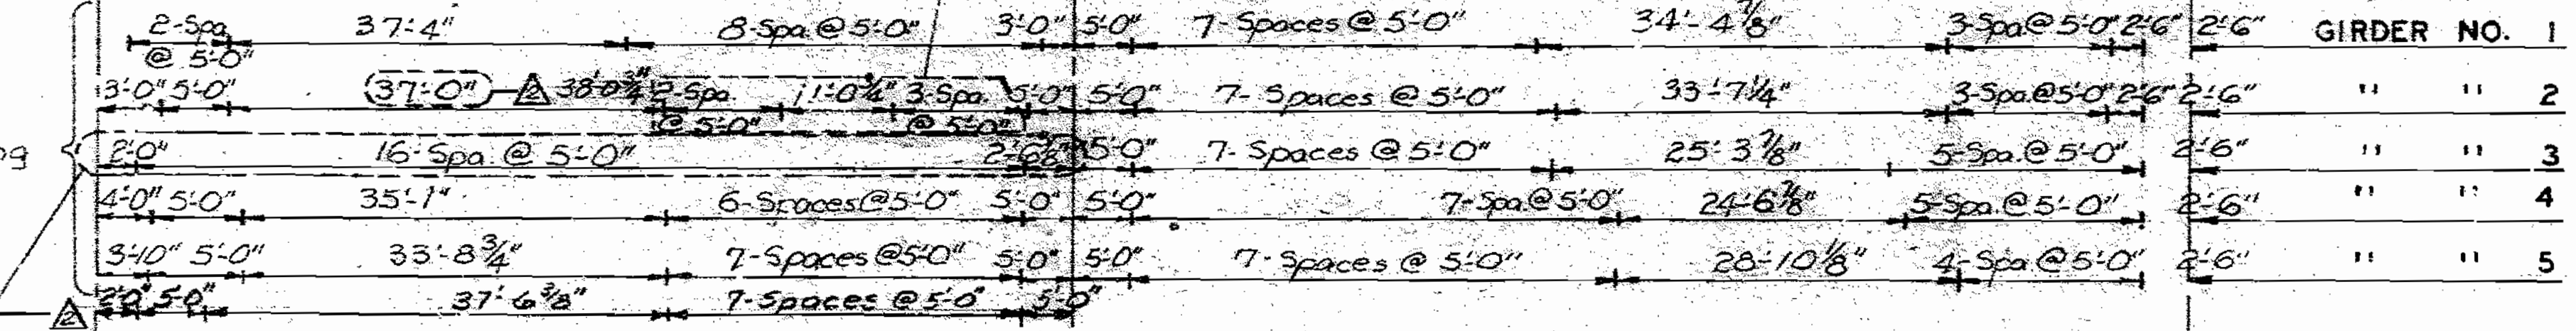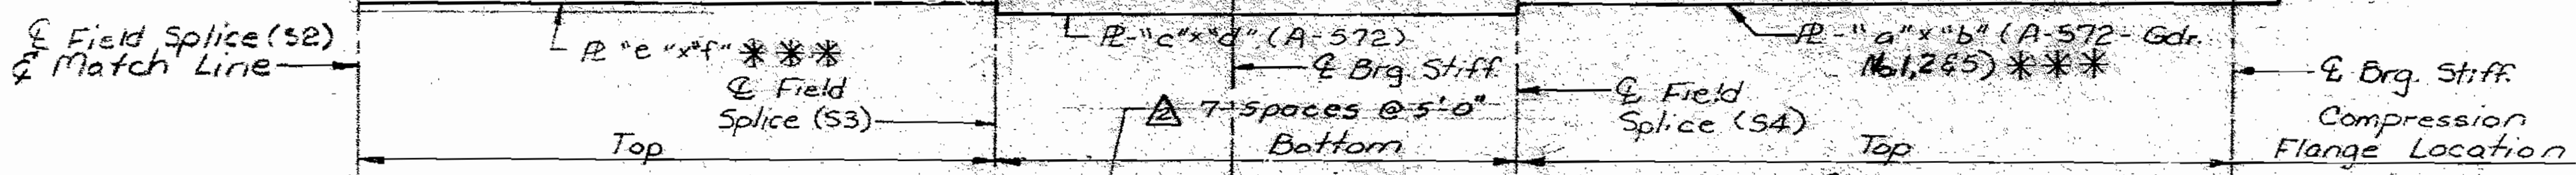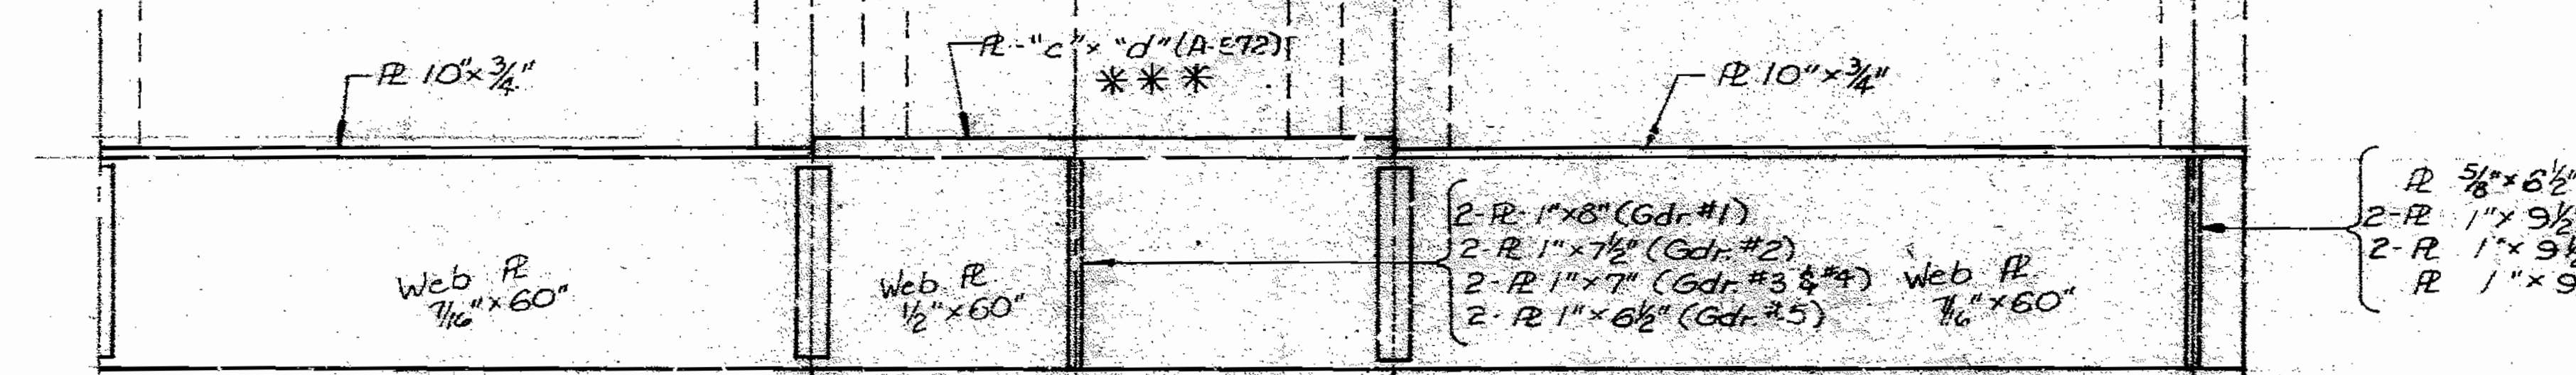

GIRDER NO. 1	13'-3 7/8"	13'-4"	13'-2 1/4"	13'-5 1/4"	13'-7 3/8"	13'-9 3/8"	13'-11 1/8"	2-Spa @ 11'-1 3/4"	11'-2 3/8"	14'-5 1/8"	14'-7 3/8"	14'-10 1/4"	17'-0 3/4"
" " 2	2-Spaces @ 13'-4 1/4"		13'-2 3/4"	13'-5 3/4"	13'-7 1/8"	13'-10 1/4"	14'-0 3/8"	2-Spa @ 11'-1 3/4"	11'-2 3/4"	14'-5 3/8"	14'-8 1/8"	14'-10 3/4"	2'-0 1/8"
" " 3	3-Spaces @ 13'-5"		13'-3 1/4"	13'-6 1/4"	13'-8 3/8"	13'-10 5/8"	14'-0 7/8"	2-Spa @ 11'-2 1/8"	11'-3 1/4"	14'-6 1/8"	14'-8 5/8"	2'-0 1/8"	
" " 4	3-Spaces @ 13'-5 1/2"		13'-3 3/8"	13'-6 3/4"	13'-8 1/2"	13'-11 1/8"	14'-1 1/8"	2-Spa @ 11'-2 1/8"	11'-3 3/8"	14'-6 3/8"	14'-8 3/8"	2'-0"	
" " 5	4-Spaces @ 13'-6"		13'-4"	13'-7 1/8"	13'-9 3/8"	13'-11 1/8"	14'-1 1/8"	2-Spa @ 11'-3"	11'-4"	14'-6 3/8"	14'-8 3/8"	2'-0 1/8"	

LOCATION	"a"	"b"
Girder No. 1 & 2	14"	1"
Girder No. 3	15"	1 1/8"
Girder No. 4	15"	1"
Girder No. 5	14"	3/4"
	"c"	"d"
Girder No. 1	17"	1 1/8"
Girder No. 2	16"	1 1/8"
Girder No. 3	15"	1 1/8"
Girder No. 4	15"	1"
Girder No. 5	15"	1"
	"e"	"f"
Girder No. 1	17"	1 1/4"
Girder No. 2	16"	1 1/8"
Girder No. 3	15"	1 1/8"
Girder No. 4	14"	1 1/8"
Girder No. 5	14"	1"


PART ELEVATION OF GIRDER

DETAILED July 1988  
CHECKED Feb. 1983

Revised 1-24-90  
Note: This drawing is not to scale. Follow dimensions. Revised 12-1-89

Sheet No. 58 of 98


STATE	PROJ. NO.	SHEET NO.
MO		139

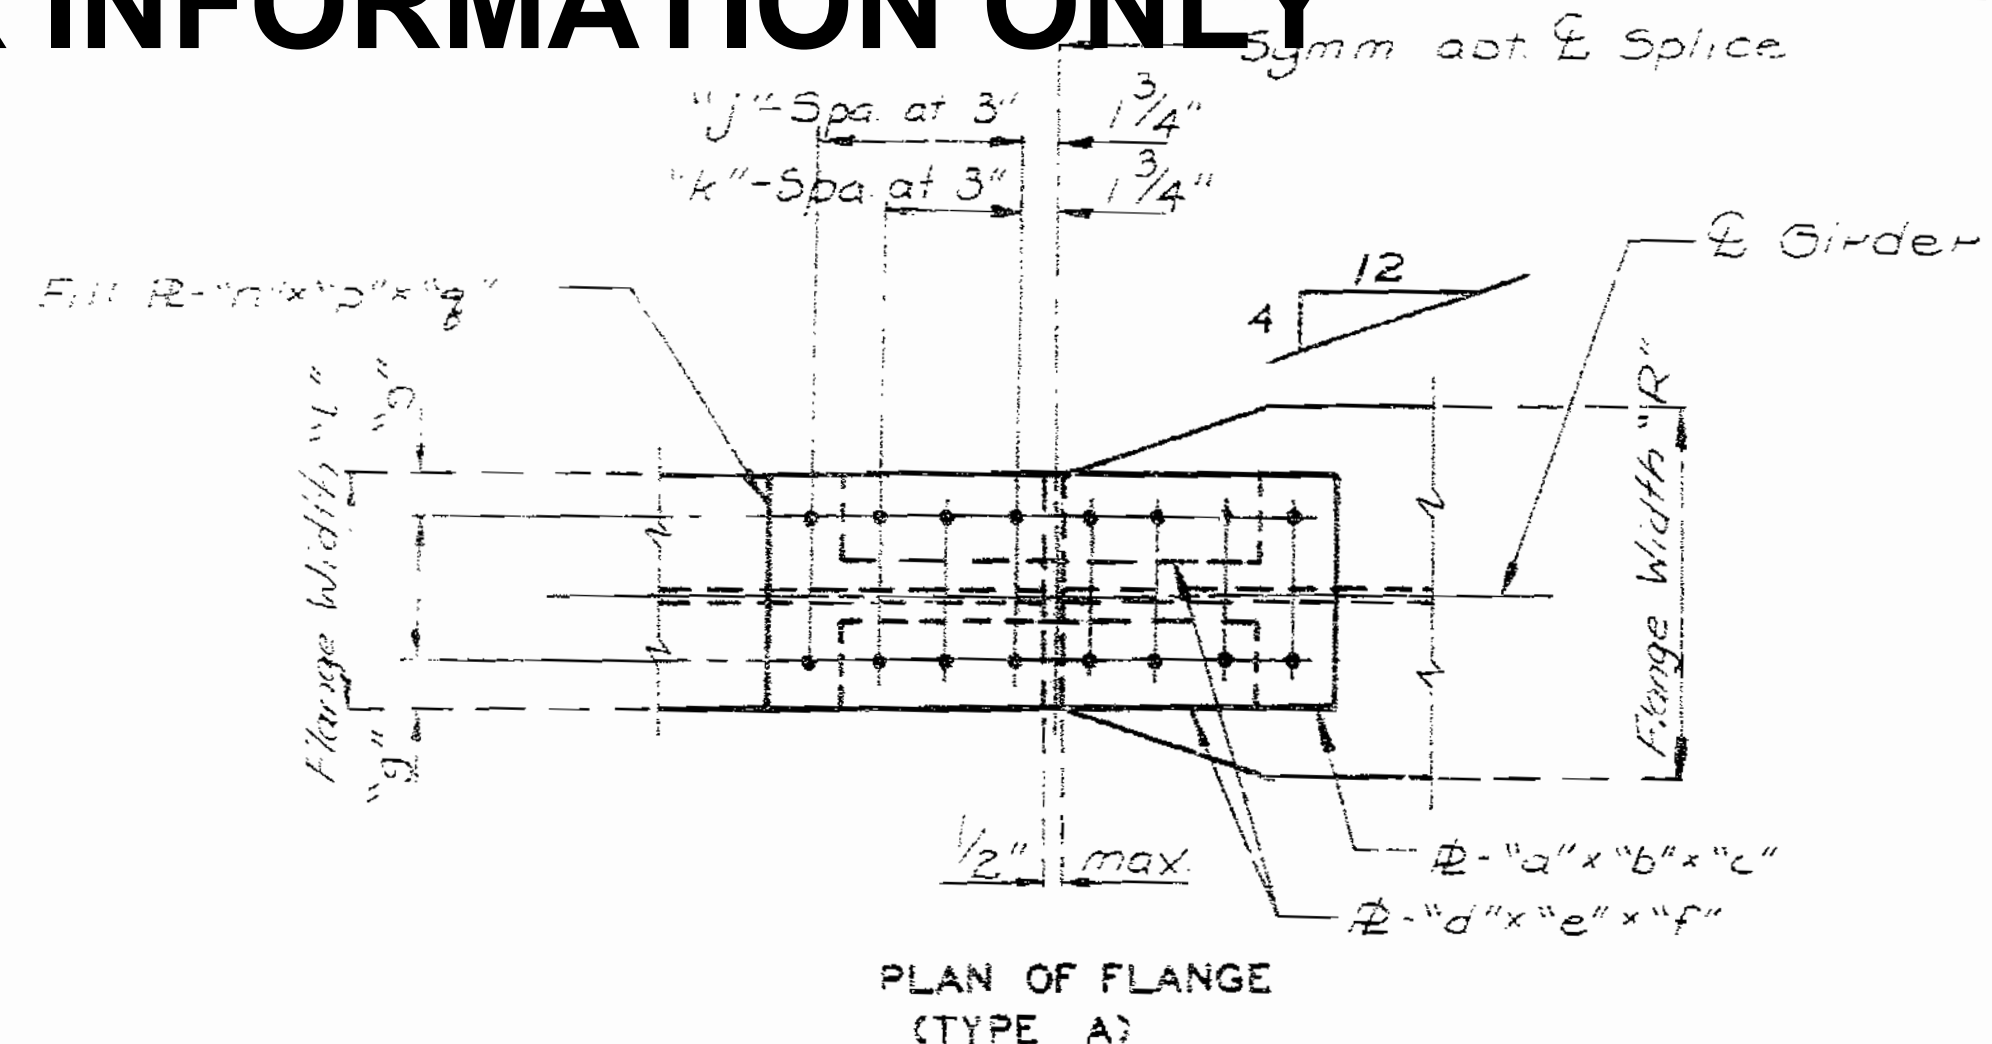

PLAN OF FLANGE (TYPE A)

TABLE OF DIMENSIONS (TYPE A SPLICE)

Splice No.	Girder No.	Location	"a"	"b"	"c"	"d"	"e"	"f"	"g"	"j"	"k"	"n"	"p"	"q"	Flange Width "L"	Flange Width "R"
S1&S2	5	Top	10"	3/8"	18 1/2"	4"	1/2"	18 1/2"	2"	2	2	10"	1/4"	9"	10"	19"
S3&S4	4	Top	10"	3/8"	18 1/2"	4"	1/2"	18 1/2"	2"	2	2	10"	1/4"	9"	10"	15"
S3&S4	5	Top	10"	3/8"	18 1/2"	4"	1/2"	18 1/2"	2"	2	2	10"	1/4"	9"	10"	15"
S1&S2	4	Top	10"	3/8"	18 1/2"	4"	1/2"	18 1/2"	2"	2	2	10"	1/4"	9"	10"	19"
S2	3	Top	10"	3/8"	18 1/2"	4"	1/2"	18 1/2"	2"	2	2	10"	5/8"	9"	10"	19"
S3&S4	3	Top	10"	3/8"	18 1/2"	4"	1/2"	18 1/2"	2"	2	2	10"	3/8"	9"	10"	15"
S2	2	Top	10"	3/8"	18 1/2"	4"	1/2"	18 1/2"	2"	2	2	10"	3/4"	9"	10"	20"
S3&S4	2	Top	10"	3/8"	18 1/2"	4"	1/2"	18 1/2"	2"	2	2	10"	3/8"	9"	10"	16"
S2	1	Top	10"	3/8"	18 1/2"	4"	1/2"	18 1/2"	2"	2	2	10"	1"	9"	10"	20"
S3&S4	1	Top	10"	3/8"	18 1/2"	4"	1/2"	18 1/2"	2"	2	2	10"	3/8"	9"	10"	17"
S1	2	Top	11"	5/8"	2-0 1/2"	4 1/2"	5/8"	2-0 1/2"	2 1/4"	3	3	11"	1/2"	12"	11"	20"
S1	1	Top	12"	1/2"	2-0 1/2"	5"	5/8"	2-0 1/2"	2 1/4"	4	3	12"	3/4"	15"	12"	20"
S1	3	Top	11"	3/8"	18 1/2"	4 1/2"	1/2"	18 1/2"	2 1/4"	2	2	11"	5/8"	9"	11"	19"

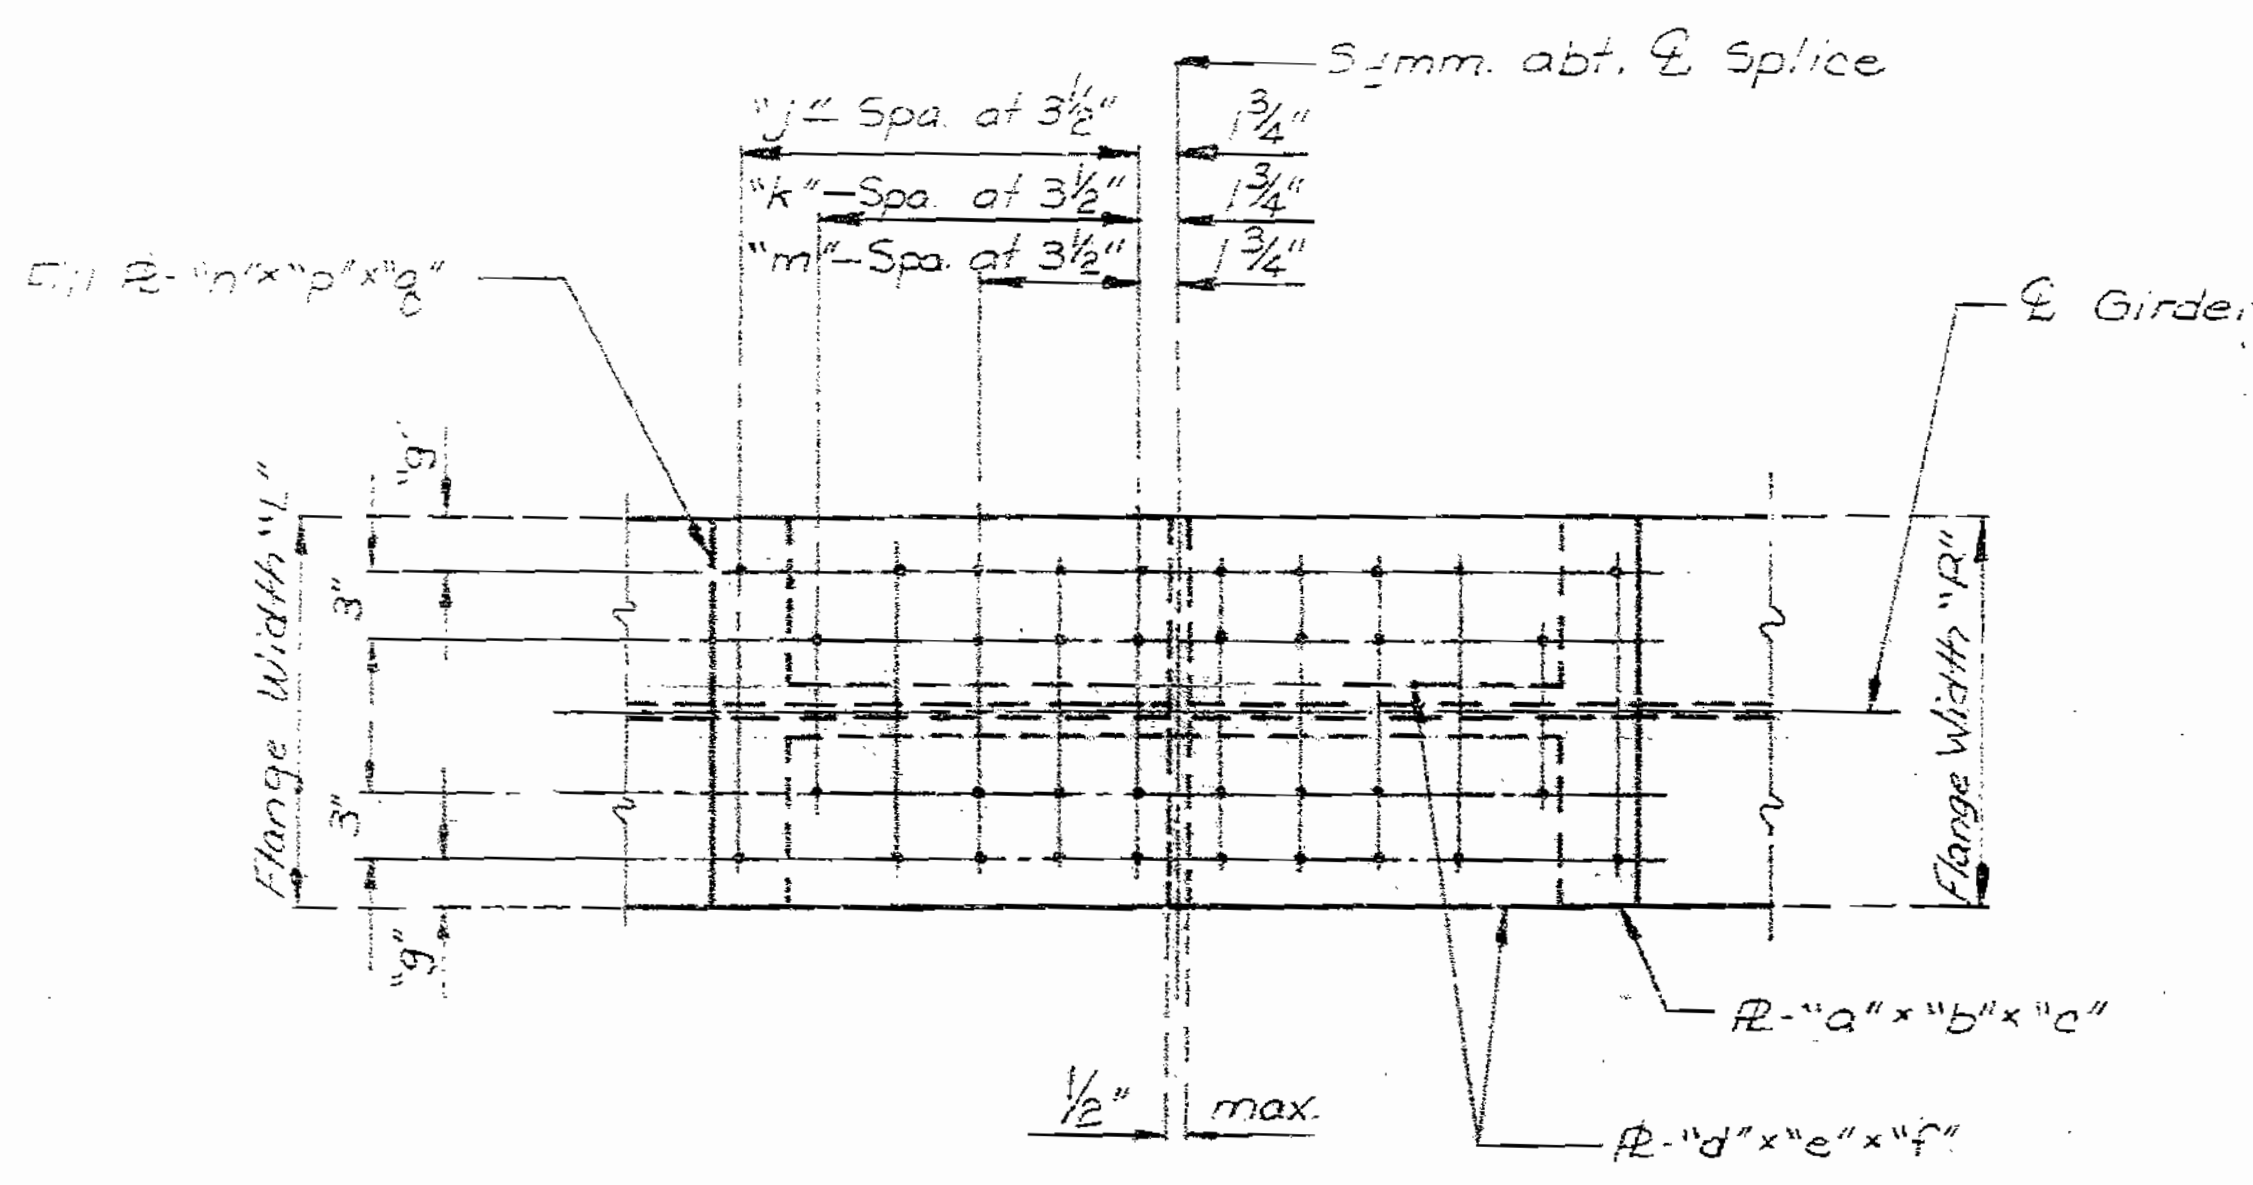

PLAN OF FLANGE (TYPE B)

TABLE OF DIMENSIONS

Splice No.	Girder No.	Location	"a"	"b"	"c"	"d"	"e"	"f"	"g"	"j"	"k"	"m"	"n"	"p"	"q"	Flange Width "L"	Flange Width "R"	Type Splice
S2	5	Bot.	14"	5/8"	20 1/2"	6"	3/4"	20 1/2"	1 1/2"	2	2	1	-	-	-	14"	19"	C
S3	5	Bot.	14"	5/8"	20 1/2"	6"	3/4"	20 1/2"	1 1/2"	2	2	1	-	-	-	14"	15"	B
S4	5	Bot.	14"	1/2"	20 1/2"	6"	1/2"	20 1/2"	1 1/2"	2	2	1	14"	1/4"	10"	14"	15"	B
S1	5	Bot.	14"	1"	2-10 1/2"	6"	1 1/8"	2-3 1/2"	1 1/2"	4	3	2	14"	1/8"	17"	14"	19"	C
S1	4	Bot.	16"	1"	3-5 1/2"	7"	1"	2-10 1/2"	2"	5	4	3	16"	1/8"	20"	16"	19"	C
S2	4	Bot.	14"	3/4"	2-3 1/2"	6"	3/4"	20 1/2"	1 1/2"	3	2	1	14"	1/8"	13 1/2"	14"	19"	C
S3	4	Bot.	14"	3/4"	2-3 1/2"	6"	3/4"	20 1/2"	1 1/2"	3	2	1	14"	1/8"	13 1/2"	14"	15"	B
S4	4	Bot.	15"	5/8"	2-3 1/2"	6 1/2"	3/4"	2-3 1/2"	1 3/4"	3	3	1	-	-	-	15"	15"	B
S1	3	Bot.	17"	1"	4-0 1/2"	7 1/2"	1 1/8"	3-5 1/2"	2 1/4"	6	5	3	17"	1/8"	20"	17"	19"	B
S2	3	Bot.	15"	3/4"	2-3 1/2"	6 1/2"	3/4"	2-3 1/2"	1 3/4"	3	3	2	15"	1/4"	13 1/2"	15"	19"	C
S3&S4	3	Bot.	15"	5/8"	2-3 1/2"	6 1/2"	3/4"	2-3 1/2"	1 3/4"	3	3	2	-	-	-	15"	15"	B
S1	2	Bot.	17"	1 1/8"	4-0 1/2"	7 1/2"	1 1/2"	3-5 1/2"	2 1/4"	6	5	4	17"	1/8"	2-0"	17"	20"	C
S2	2	Bot.	16"	3/4"	2-3 1/2"	7"	3/4"	2-3 1/2"	2"	3	3	2	16"	3/8"	13 1/2"	16"	20"	C
S3	2	Bot.	16"	3/4"	2-3 1/2"	7"	3/4"	2-3 1/2"	2"	3	3	2	-	-	-	16"	16"	B
S4	2	Bot.	14"	5/8"	20 1/2"	6"	3/4"	20 1/2"	1 1/2"	2	2	1	14"	1/8"	10"	14"	16"	B
S1	1	Bot.	17"	1 1/8"	4-0 1/2"	7 1/2"	1 1/4"	3-5 1/2"	2 1/4"	6	5	4	17"	3/8"	2-0"	17"	20"	C
S2	1	Bot.	17"	3/4"	2-10 1/2"	7 1/2"	1/8"	2-10 1/2"	2 1/4"	4	4	2	17"	1/2"	17"	17"	20"	C
S3	1	Bot.	17"	3/4"	2-10 1/2"	7 1/2"	3/4"	2-3 1/2"	2 1/4"	4	3	2	17"	1/2"	17"	17"	17"	B
S4	1	Bot.	14"	7/8"	2-10 1/2"	6"	1"	2-3 1/2"	1 1/2"	4	3	2	14"	1/8"	17"	14"	17"	C

See Sheet #59A For Revised Splices

108/154

DETAILED June 1988  
CHECKED Feb. 1988

DETAILS OF FIELD FLANGE SPLICES

Note: This drawing is not to scale. Follow dimensions. Revised 12-1-89

SEE FINISH...  
Sheet No. 59 of 68

JACKSON COUNTY

A-2745

STATE	PROJ. NO.	SHEET NO.
MO.		

TABLE OF DIMENSIONS (TYPE A SPLICES)

SPLICE NO.	GIRDER NO.	LOCATION	"a"	"b"	"c"	"d"	"e"	"f"	"g"	"j"	"k"	"n"	"p"	"q"	FLANGE WIDTH "L"	FLANGE WIDTH "R"
S1	1	TOP	12"	1 1/2"	2'-6 1/2"	5"	5/8"	2'-0 1/2"	2 1/2"	4	3	12"	3/4"	15'	12"	20"
S1	2	TOP	11"	5/8"	2'-0 1/2"	4 1/2"	5/8"	2'-0 1/2"	2 1/2"	3	3	11"	1/2"	12"	11"	20"
S1	3	TOP	11"	5/8"	2'-0 1/2"	4 1/2"	5/8"	2'-0 1/2"	2 1/2"	3	3	11"	3/8"	12"	11"	19"
S1	4	TOP	10"	5/8"	2'-0 1/2"	4"	1/2"	18 1/2"	2"	4	3	10"	1/4"	12"	10"	19"
S1	5	TOP	10"	5/8"	2'-0 1/2"	4"	1/2"	18 1/2"	2"	4	3	—	—	—	10"	19"
S2	1	TOP	10"	3/8"	18 1/2"	4"	1/2"	18 1/2"	2"	2	2	10"	1"	9"	10"	20"
S2	2	TOP	10"	3/8"	18 1/2"	4"	1/2"	18 1/2"	2"	2	2	10"	3/4"	9"	10"	20"
S2	3	TOP	10"	3/8"	18 1/2"	4"	1/2"	18 1/2"	2"	2	2	10"	3/8"	9"	10"	19"
S2	4	TOP	10"	3/8"	18 1/2"	4"	1/2"	18 1/2"	2"	2	2	10"	1/2"	9"	10"	19"
S2	5	TOP	10"	3/8"	18 1/2"	4"	1/2"	18 1/2"	2"	2	2	10"	1/4"	9"	10"	19"
S3 & S4	1	TOP	10"	3/8"	18 1/2"	4"	1/2"	18 1/2"	2"	2	2	10"	3/8"	9"	10"	17"
S3 & S4	2	TOP	10"	3/8"	18 1/2"	4"	1/2"	18 1/2"	2"	2	2	10"	3/8"	9"	10"	16"
S3 & S4	3	TOP	10"	3/8"	18 1/2"	4"	1/2"	18 1/2"	2"	2	2	10"	3/8"	9"	10"	15"
S3 & S4	4	TOP	10"	3/8"	18 1/2"	4"	1/2"	18 1/2"	2"	2	2	10"	1/4"	9"	10"	15"
S3 & S4	5	TOP	10"	3/8"	18 1/2"	4"	1/2"	18 1/2"	2"	2	2	10"	1/4"	9"	10"	15"

TABLE OF DIMENSIONS

SPLICE NO.	GIRDER NO.	LOCATION	"a"	"b"	"c"	"d"	"e"	"f"	"g"	"j"	"k"	"n"	"p"	"q"	FLANGE WIDTH "L"	FLANGE WIDTH "R"	TYPE SPLICE	
S1	1	BOTT.	17"	1 1/8"	4'-0 1/2"	7 1/2"	1 1/4"	3'-5 1/2"	2 1/4"	6	5	4	17"	3/4"	2'-0"	17"	20"	C
S1	2	BOTT.	17"	1 1/8"	4'-0 1/2"	7 1/2"	1 1/4"	3'-0 1/2"	2 1/4"	6	5	4	17"	1/8"	2'-0"	17"	20"	C
S1	3	BOTT.	17"	1"	4'-0 1/2"	7 1/2"	1 1/8"	3'-5 1/2"	2 1/4"	6	5	3	17"	1/8"	2'-0"	17"	19"	B
S1	4	BOTT.	16"	1 1/8"	4'-0 1/2"	7"	1 1/8"	3'-5 1/2"	2"	6	5	3	—	—	—	16"	19"	C
S1	5	BOTT.	14"	1 1/8"	3'-5 1/2"	6"	1 1/8"	2'-10 1/2"	1 1/2"	5	4	2	14"	1/2"	20 1/2"	14"	19"	C
S2	1	BOTT.	17"	3/4"	2'-10 1/2"	7 1/2"	7/8"	2'-10 1/2"	2 1/4"	4	4	2	17"	1/2"	17"	17"	20"	C
S2	2	BOTT.	16"	3/4"	2'-10 1/2"	7"	7/8"	2'-3 1/2"	2"	4	3	2	16"	1/4"	17"	16"	20"	C
S2	3	BOTT.	15"	7/8"	2'-10 1/2"	6 1/2"	7/8"	2'-3 1/2"	1 3/4"	4	3	2	15"	1/8"	17"	15"	19"	C
S2	4	BOTT.	14"	7/8"	2'-3 1/2"	6"	7/8"	2'-3 1/2"	1 1/2"	3	3	2	—	—	—	14"	19"	C
S2	5	BOTT.	14"	5/8"	20 1/2"	6"	3/4"	20 1/2"	1 1/2"	2	2	1	—	—	—	14"	19"	C
S3	1	BOTT.	17"	3/4"	2'-10 1/2"	7 1/2"	3/4"	2'-3 1/2"	2 1/4"	4	3	2	17"	1/8"	17"	17"	17"	B
S3	2	BOTT.	16"	3/4"	2'-10 1/2"	7"	7/8"	2'-3 1/2"	2"	4	3	2	16"	1/8"	17"	16"	16"	B
S3 & S4	3	BOTT.	15"	7/8"	2'-10 1/2"	6 1/2"	7/8"	2'-3 1/2"	1 3/4"	4	3	2	15"	1/8"	17"	15"	15"	B
S3	4	BOTT.	14"	7/8"	2'-3 1/2"	6"	7/8"	2'-3 1/2"	1 1/2"	3	3	2	14"	1/4"	13 1/2"	14"	15"	B
S3	5	BOTT.	14"	5/8"	20 1/2"	6"	3/4"	20 1/2"	1 1/2"	2	2	1	—	—	—	14"	15"	B
S4	1	BOTT.	14"	7/8"	2'-0 1/2"	6"	1"	2'-3 1/2"	1 1/2"	4	3	2	14"	1/8"	17"	14"	17"	C
S4	2	BOTT.	14"	5/8"	20 1/2"	6"	3/4"	20 1/2"	1 1/2"	2	2	1	14"	1/8"	10"	14"	16"	B
S4	4	BOTT.	15"	5/8"	2'-3 1/2"	6 1/2"	3/4"	2'-3 1/2"	1 1/2"	3	3	1	—	—	—	15"	15"	B
S4	5	BOTT.	14"	7/8"	2'-10 1/2"	6"	1"	2'-3 1/2"	1 1/2"	4	3	2	—	—	—	14"	15"	B

155

DETAILED DEC 19 89  
CHECKED DEC 19 89

NOTE: THIS DRAWING IS NOT TO SCALE. FOLLOW DIMENSIONS.  $\Delta$  ADD 12/1/89


SEE FINAL PLANS  
SHEET NO. 59A OF 89

JACKSON

COUNTY

A-2745

STATE	PROJ. NO.	SHEET NO.
MO.		140

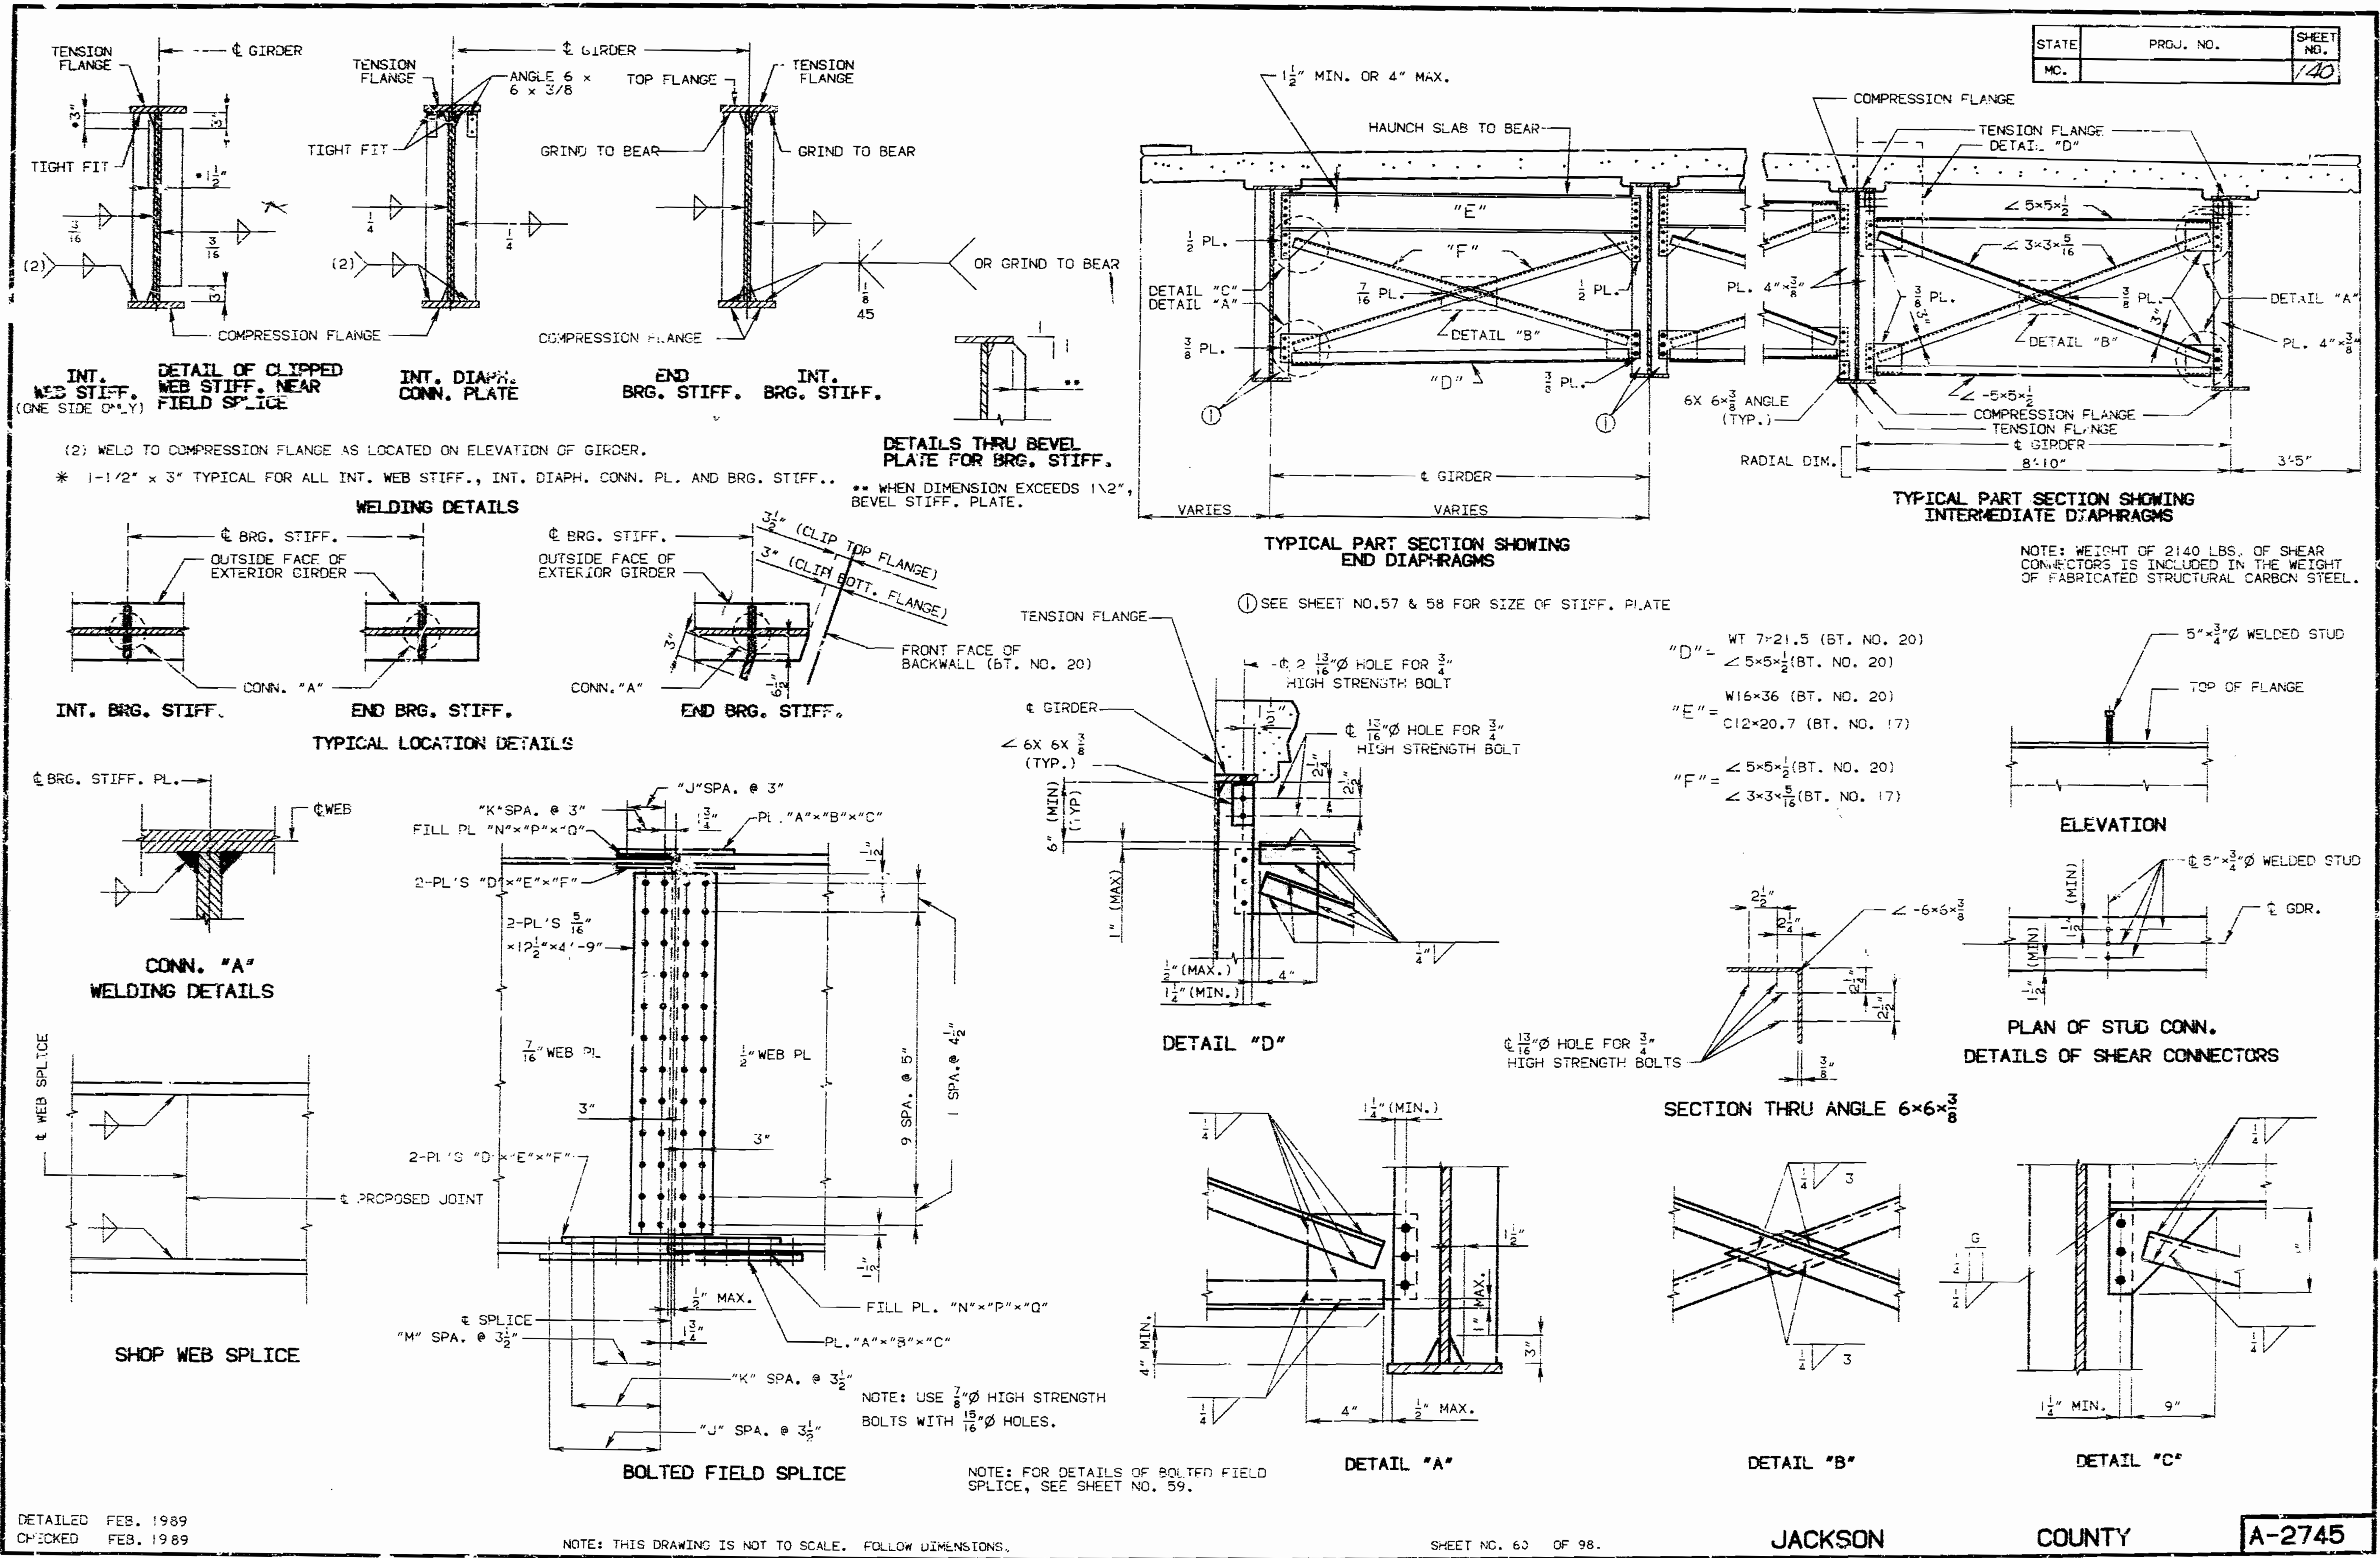

150  
 100

DETAILED FEB. 1989  
 CHECKED FEB. 1989

NOTE: THIS DRAWING IS NOT TO SCALE. FOLLOW DIMENSIONS.

SHEET NO. 63 OF 98.


JACKSON

COUNTY


A-2745




STATE	PROJ. NO.	SHEET NO.
MO.		141

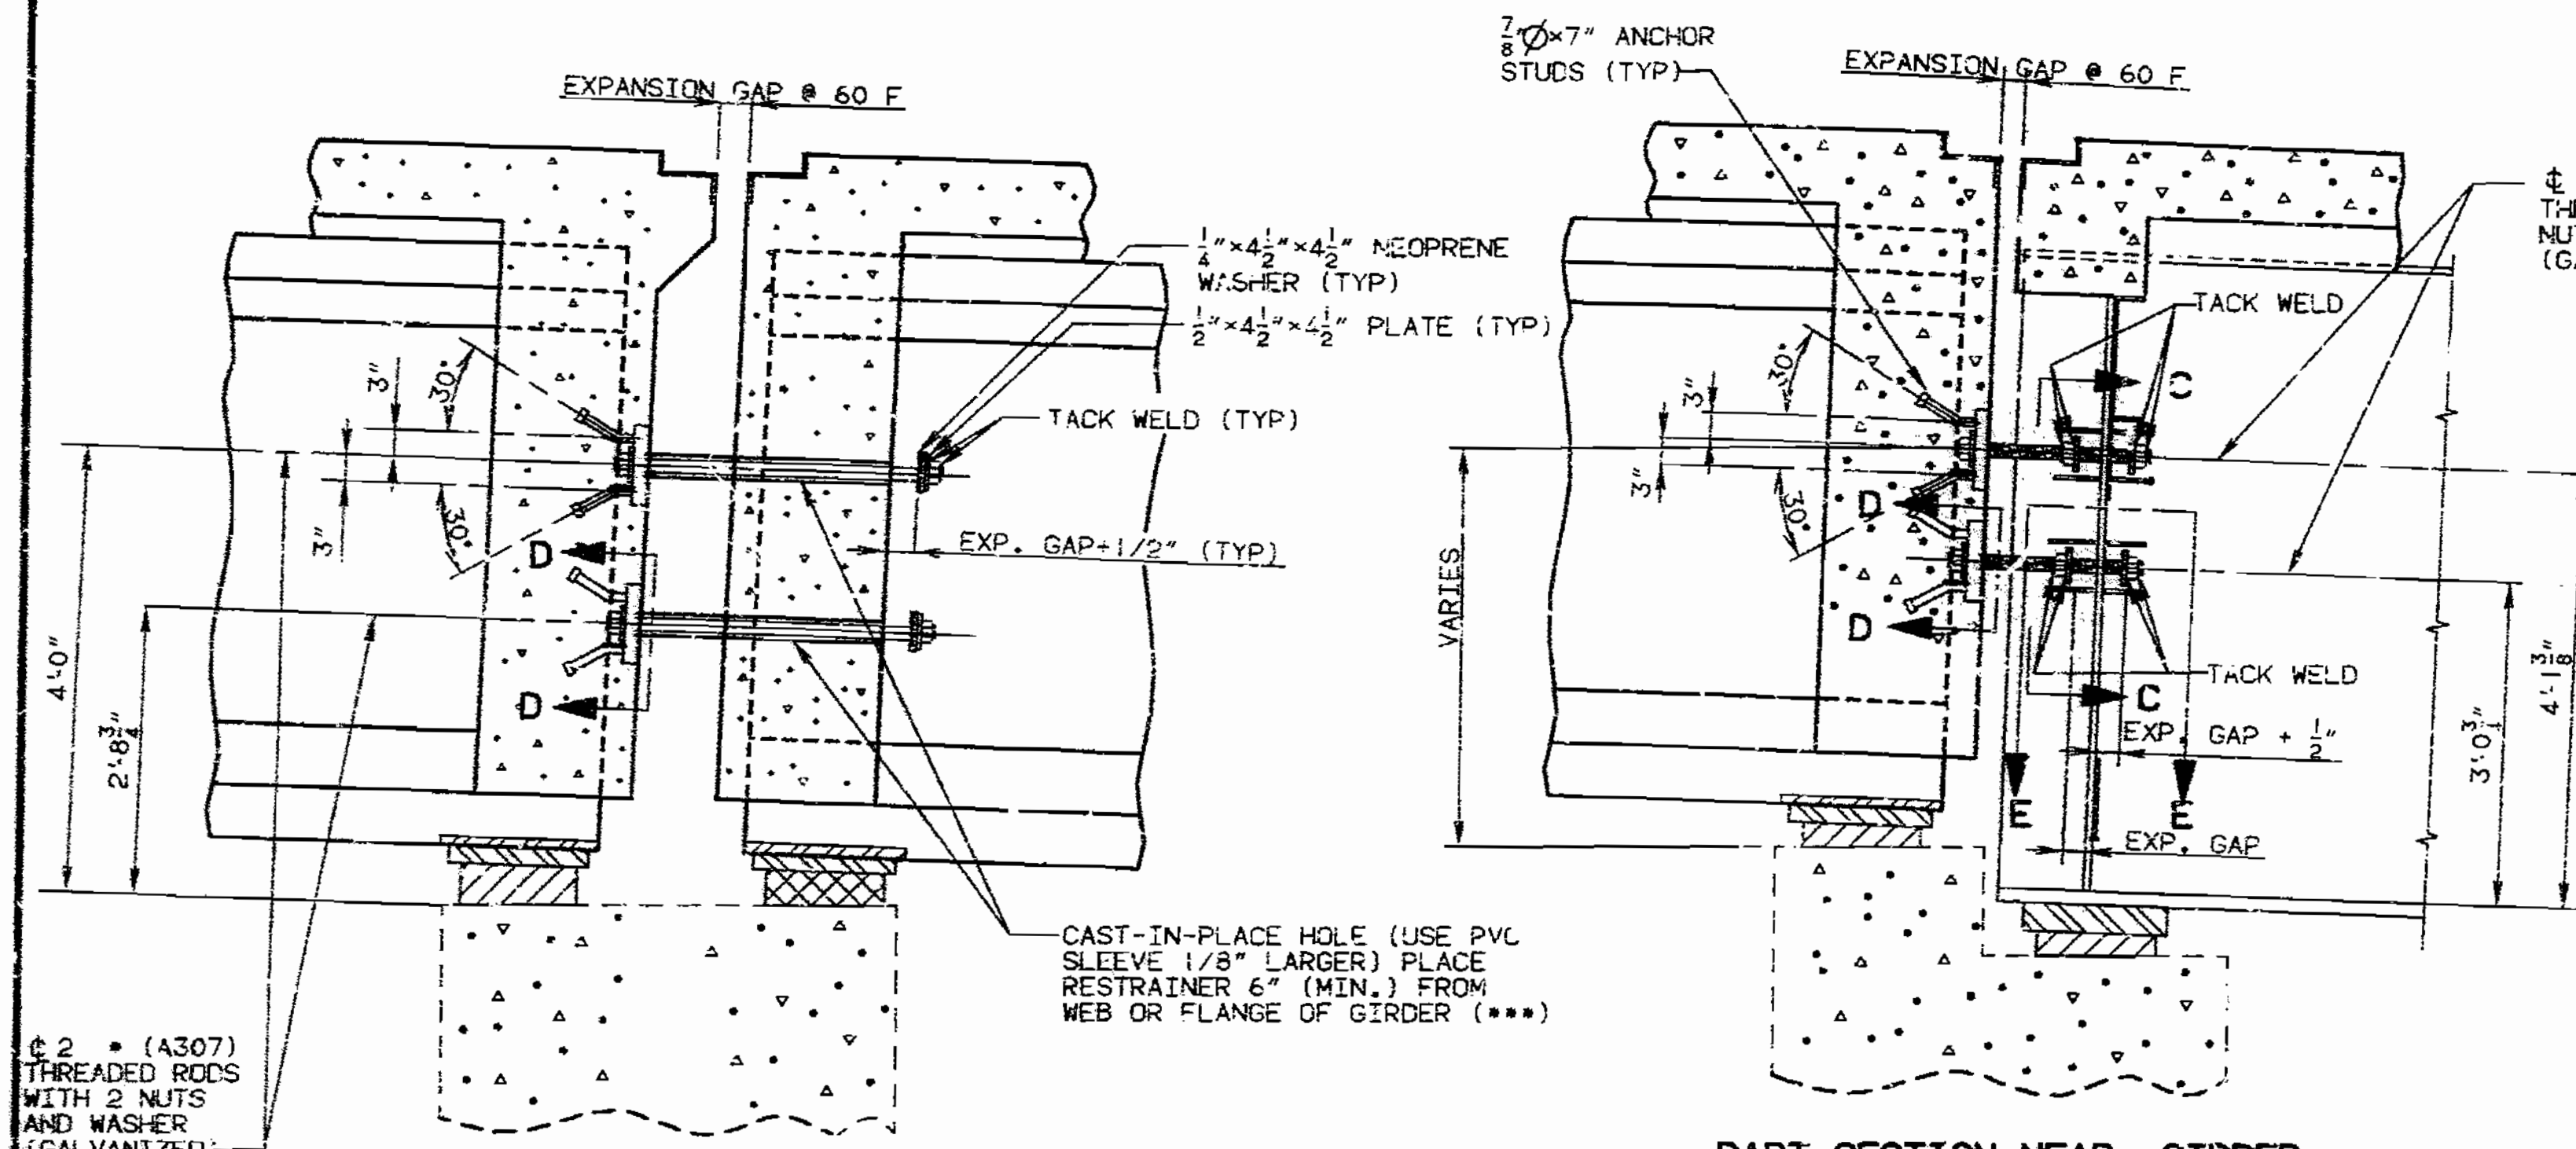

PART SECTION NEAR GIRDER AT INT. BENT NO. 4, 9 & 13.

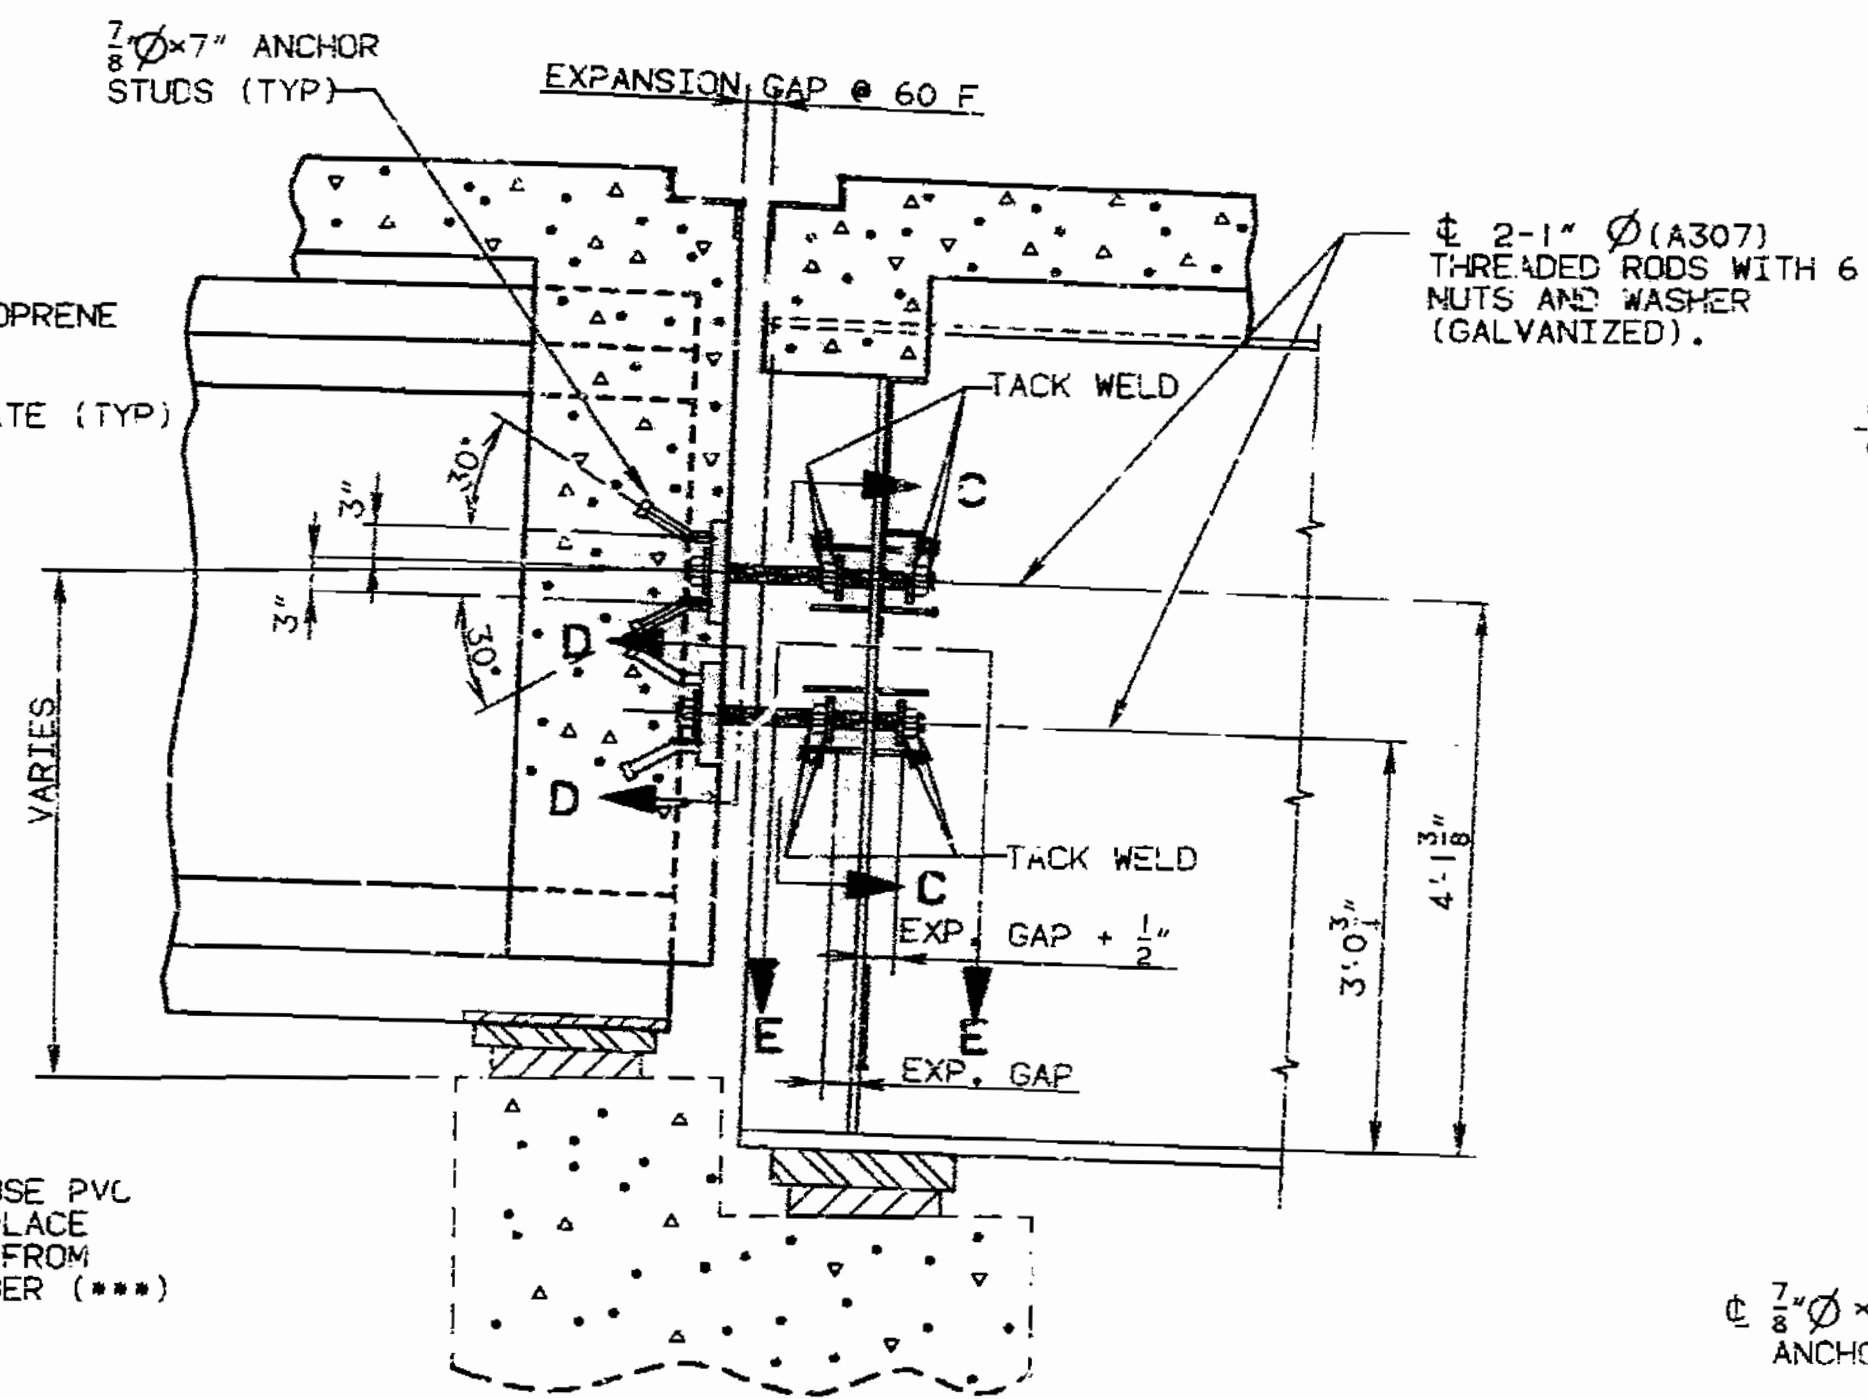


PART SECTION NEAR GIRDER AT INT. BENT NO. 17.

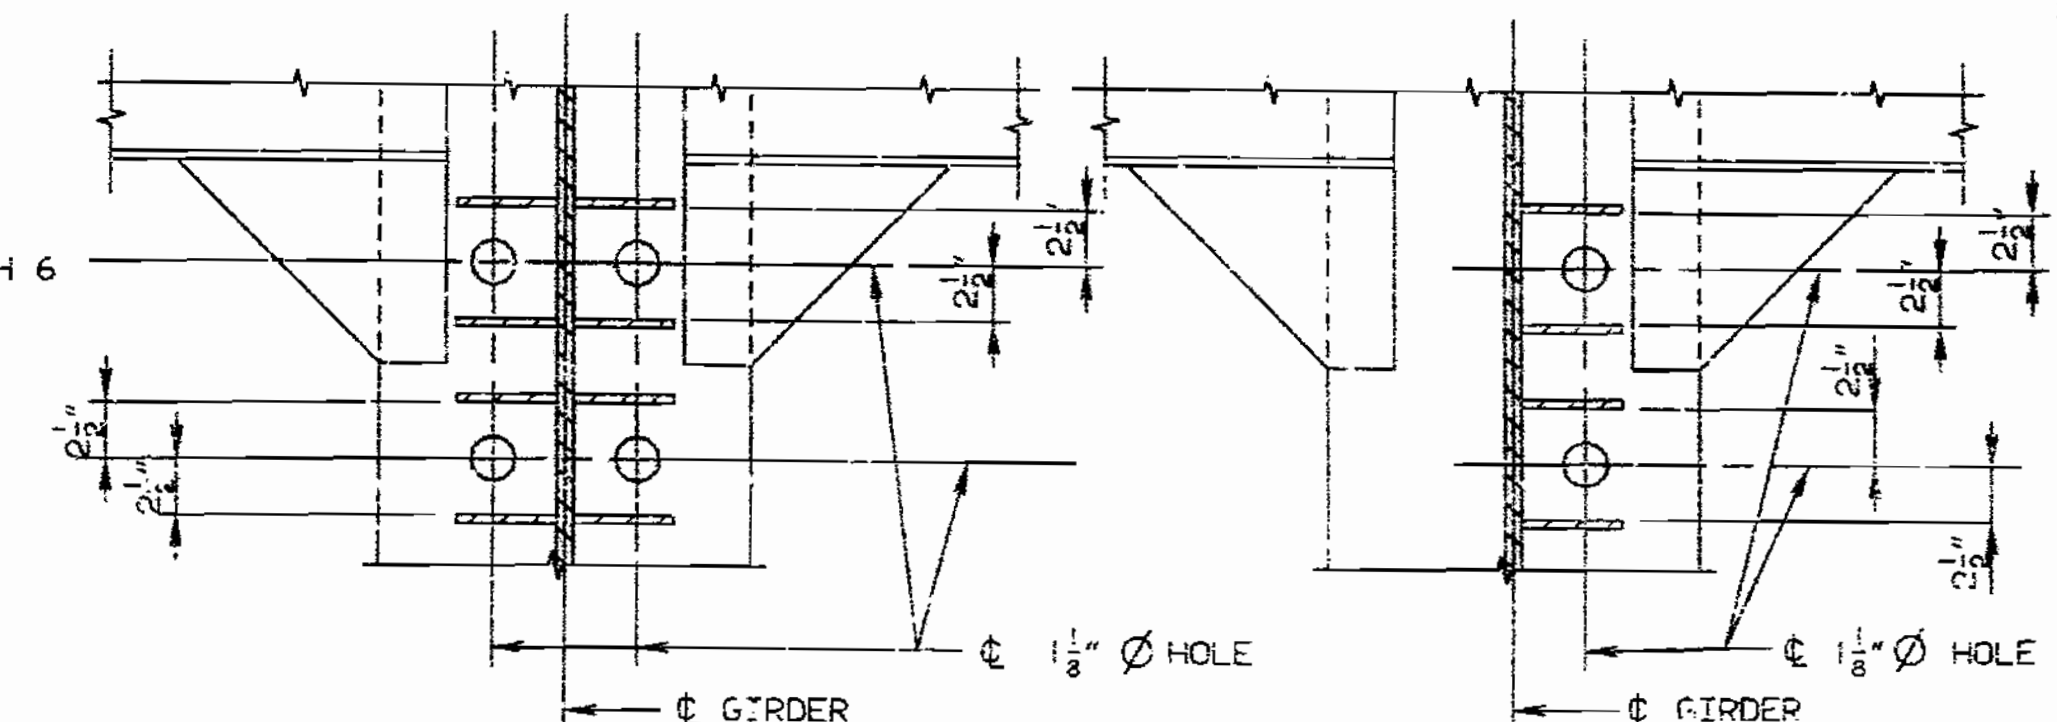


SECTION C-C (INT. GIRDERS)

SECTION C-C (EXT. GIRDERS)

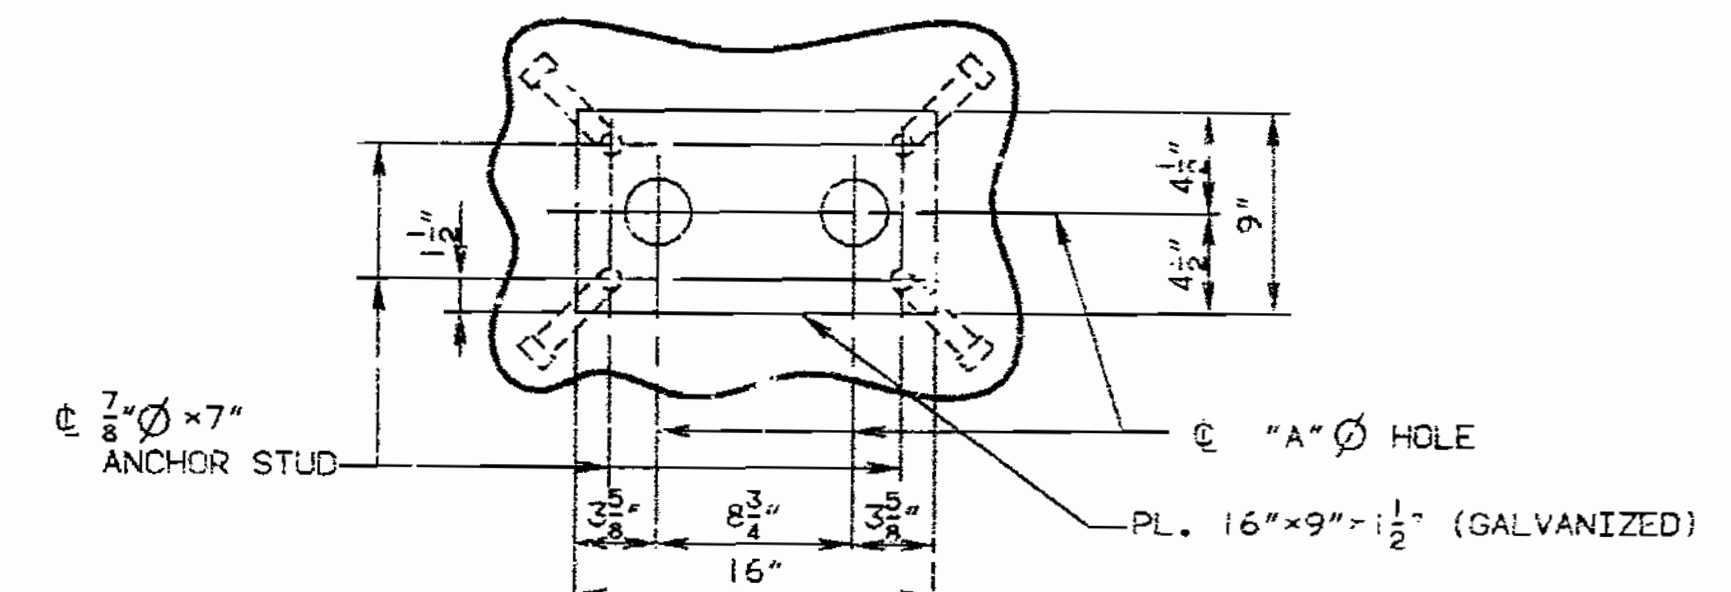

SECTION D-D (INT. GIRDERS)

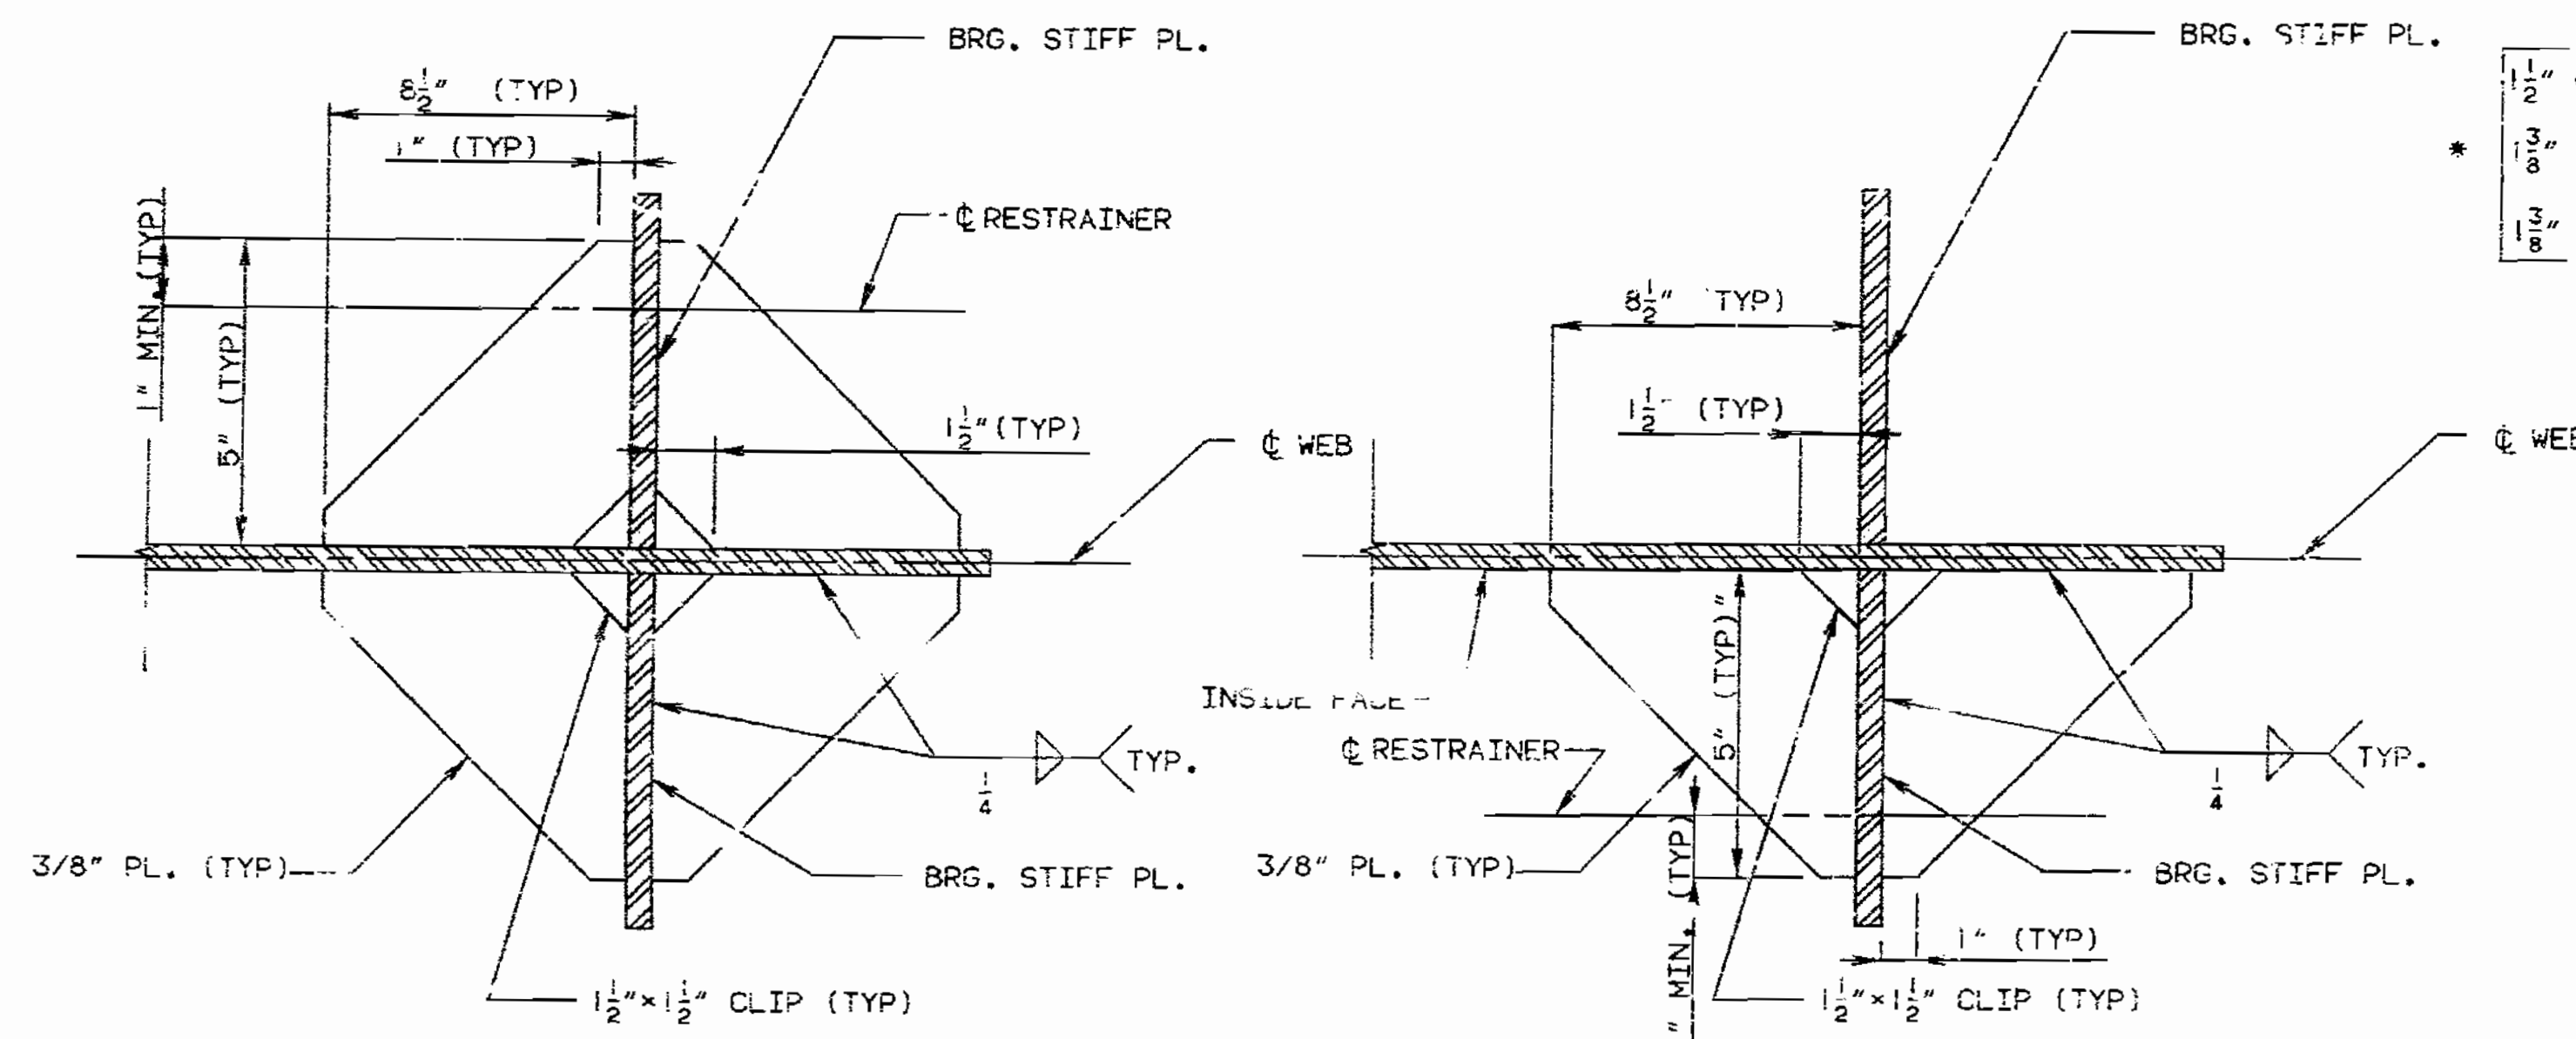


SECTION E-E (INT. GIRDERS)

SECTION E-E (EXT. GIRDERS)

- \* 1 1/2" Ø BENT NO. 4
- \* 3/8" Ø BENT NO. 9
- \* 1 3/8" Ø BENT NO. 13

NOTE: WEIGHT OF THREADED RODS, NUTS, WASHERS AND PLATES IS INCLUDED IN FABRICATED STRUCTURAL CARBON STEEL (PLATE GIRDER) GALVANIZING TO BE DONE IN ACCORDANCE TO ASTM A123.

"A" BT.#4 = 5/8"  
BT.#9 & #13 = 1 1/2"  
BT.#19 = 1 1/8"

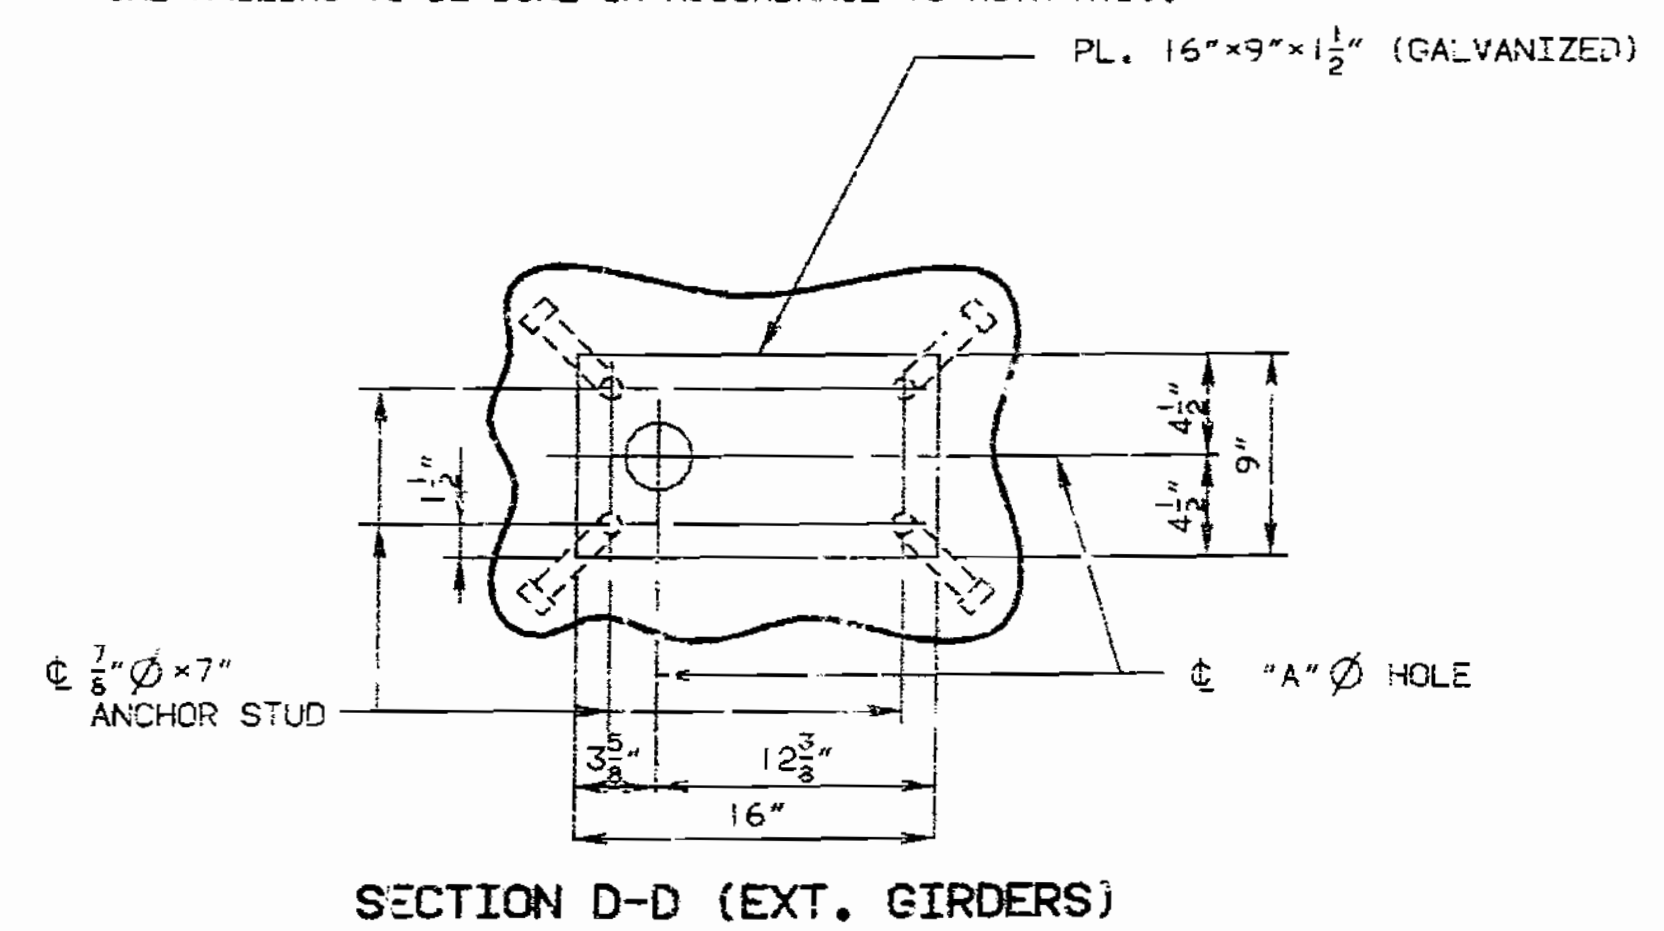

SECTION D-D (EXT. GIRDERS)

DETAILS OF EARTHQUAKE RESTRAINERS AT BENTS NO. 4, 9, 13 & 17

DETAILED AUG. 1988  
CHECKED FEB 1989

NOTE: THIS DRAWING IS NOT TO SCALE. FOLLOW DIMENSIONS.


SEE FINAL PLANS  
SHEET NO. 06-F 00-98.

JACKSON COUNTY

A-2745


183137

STATE	PROJ. NO.	SHEET NO.
MO.		42

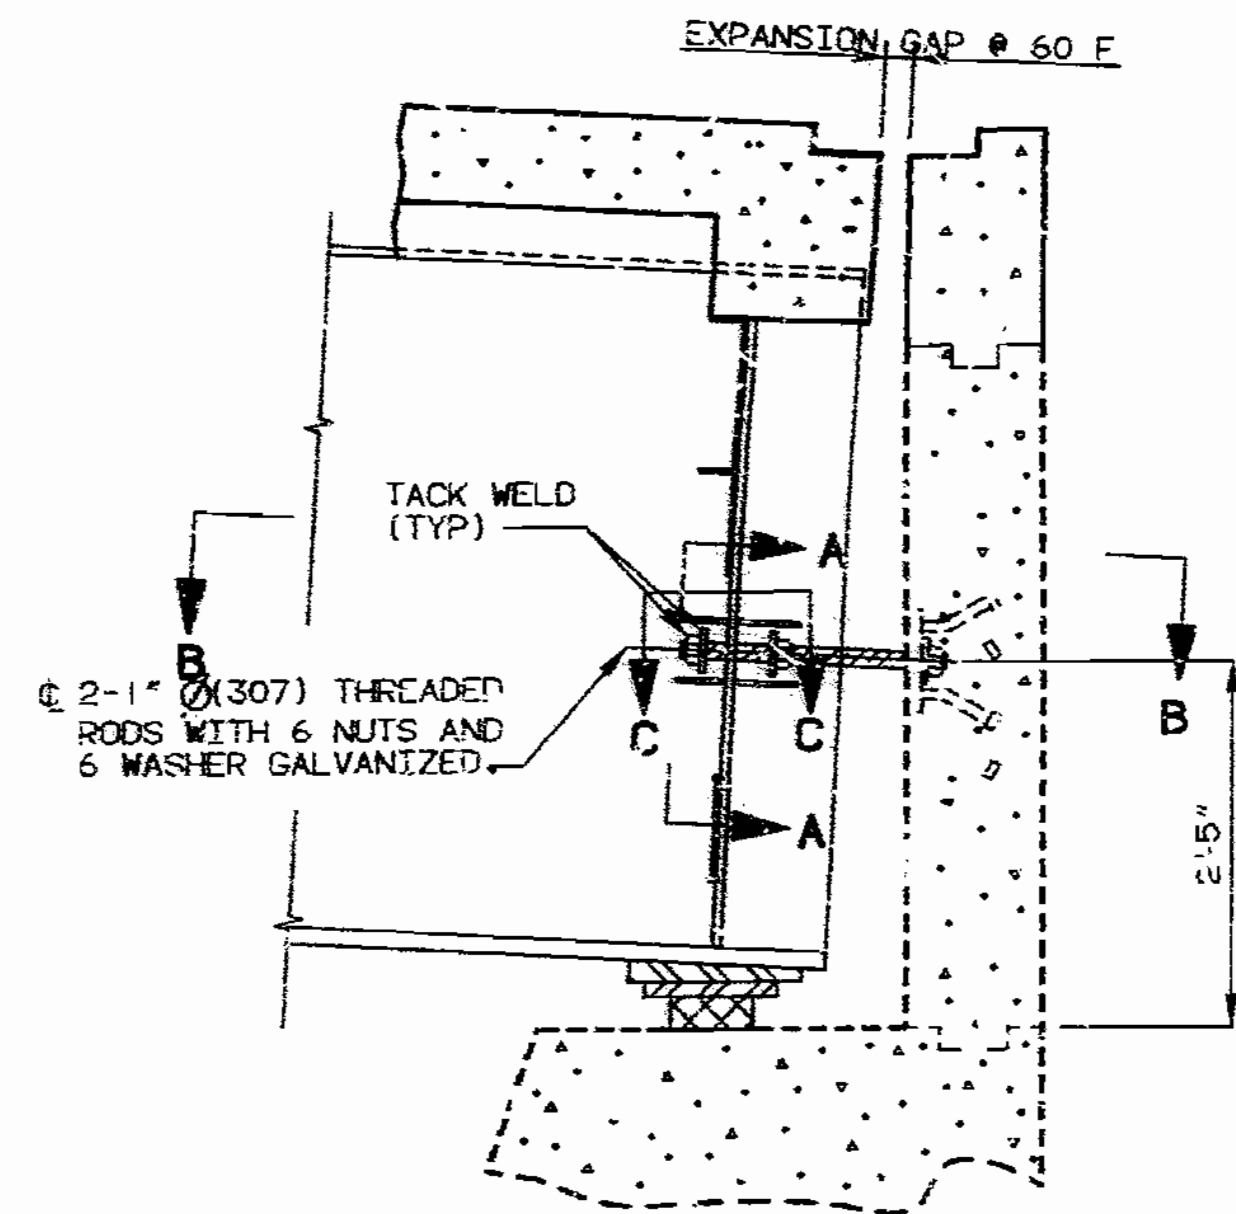


PART SECTION AT END BENT NO. 20


- ① EXPANSION GAP AT 60° F.
- ② EXPANSION GAP AT 60° F. + 1/2"

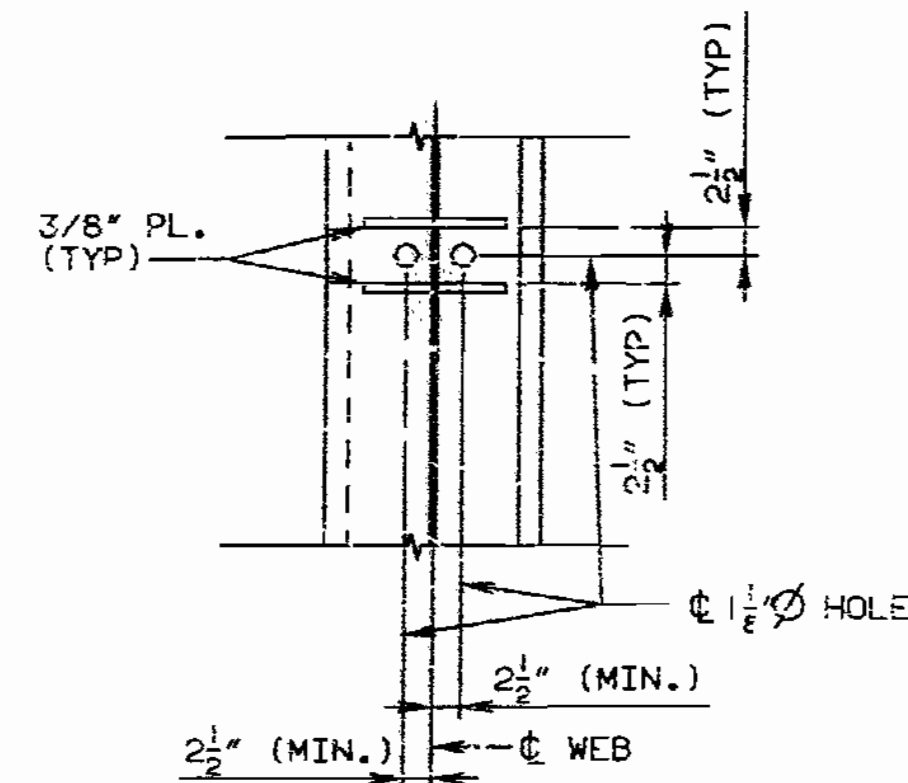

PART SECTION A-A (INT. GIRDERS)

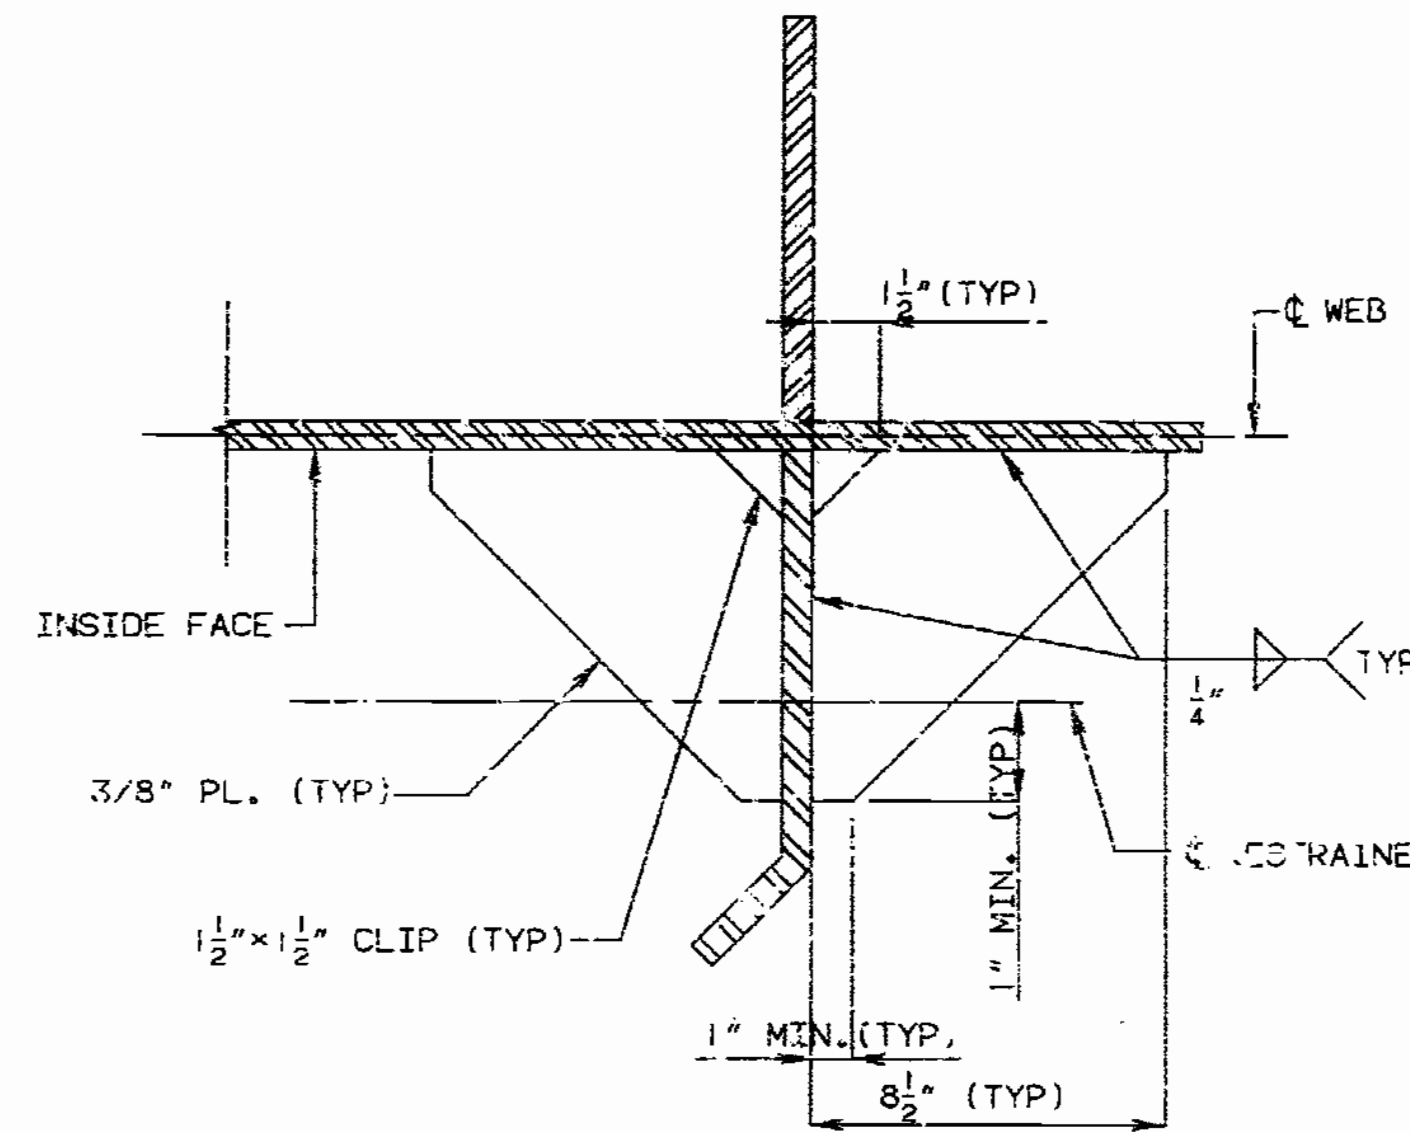


SECTION C-C (EXT. GIRDERS)

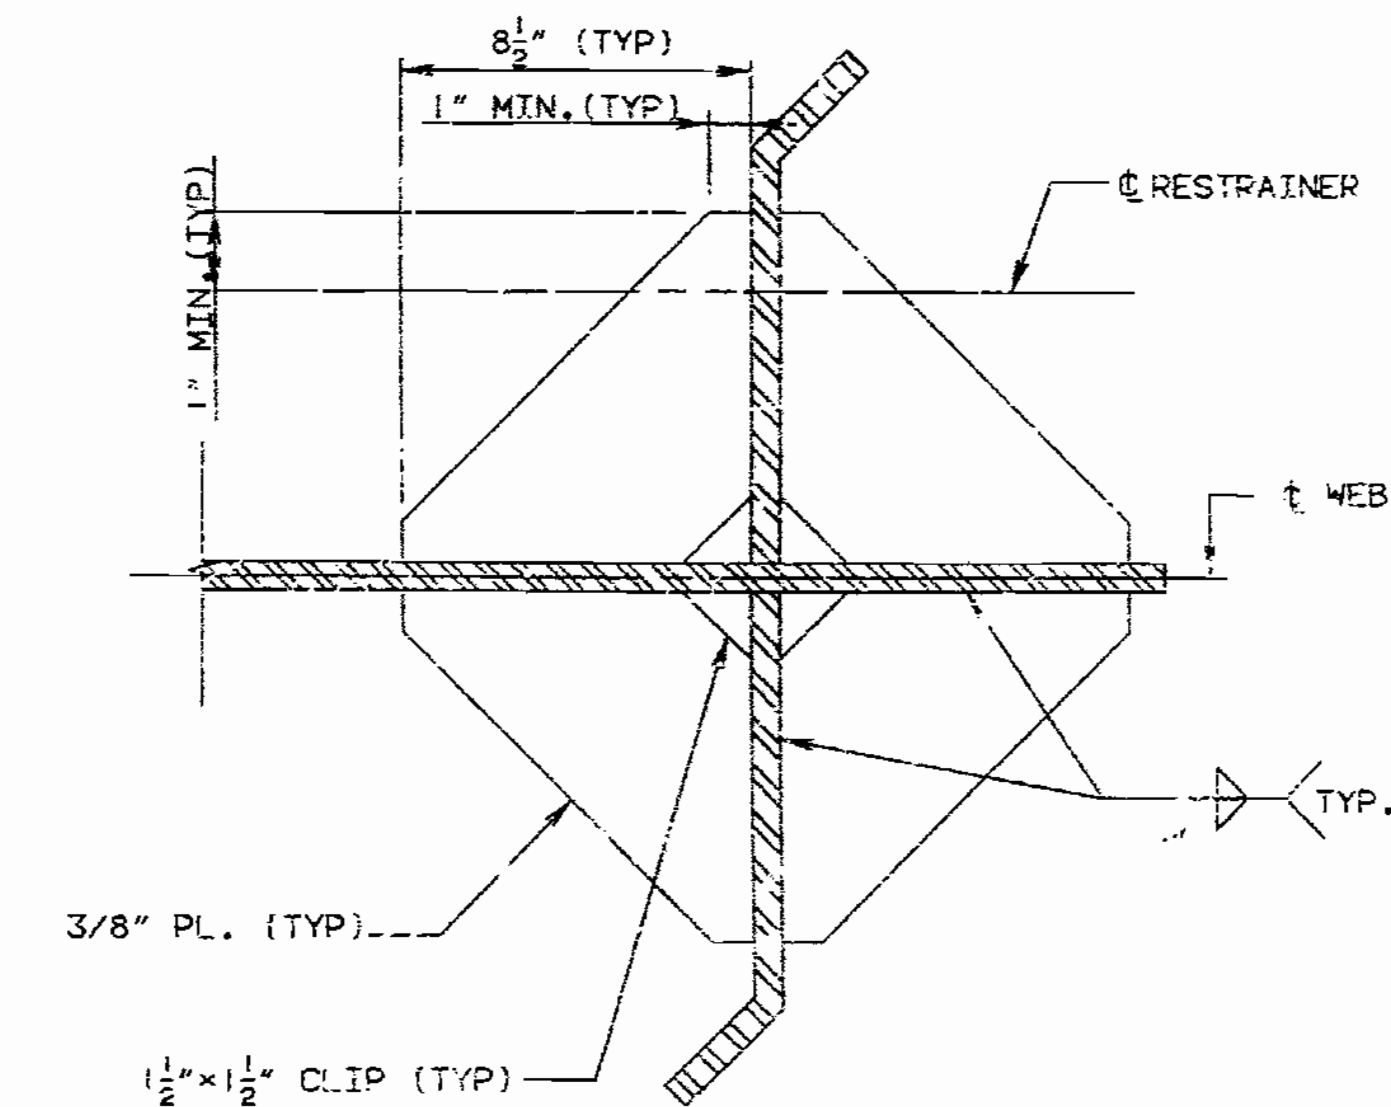


SECTION C-C (INT. GIRDERS)


NOTE: WEIGHT OF THREADED RODS, NUTS, WASHERS AND PLATES IS INCLUDED IN FABRICATED STRUCTURAL CARBON STEEL (PLATE GIRDER) GALVANIZING TO BE DONE IN ACCORDANCE TO AS/M A123.

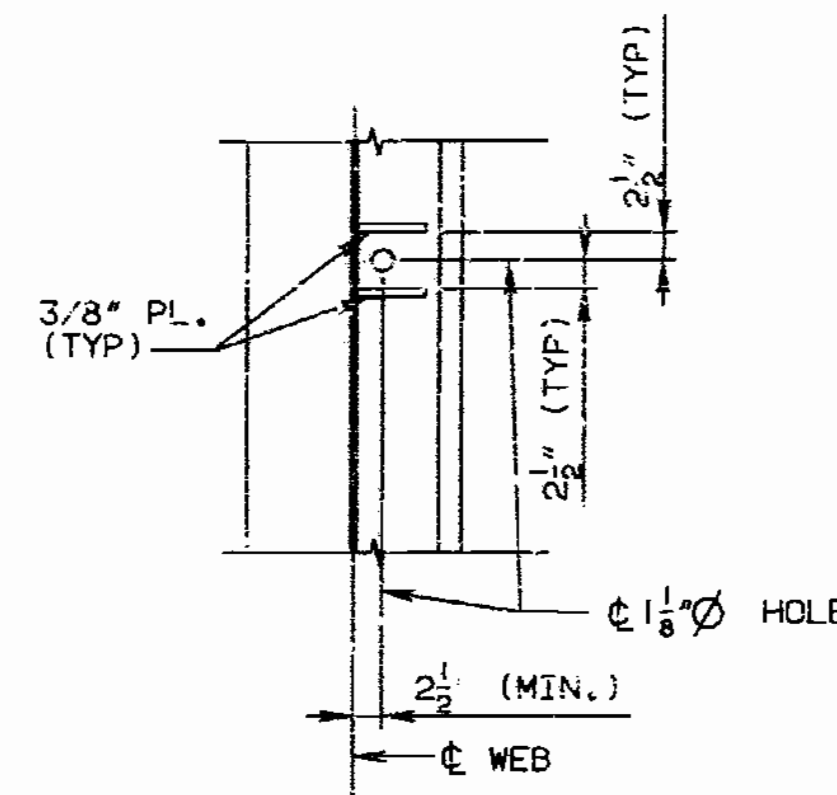

PART SECTION A-A (EXT. GIRDERS)

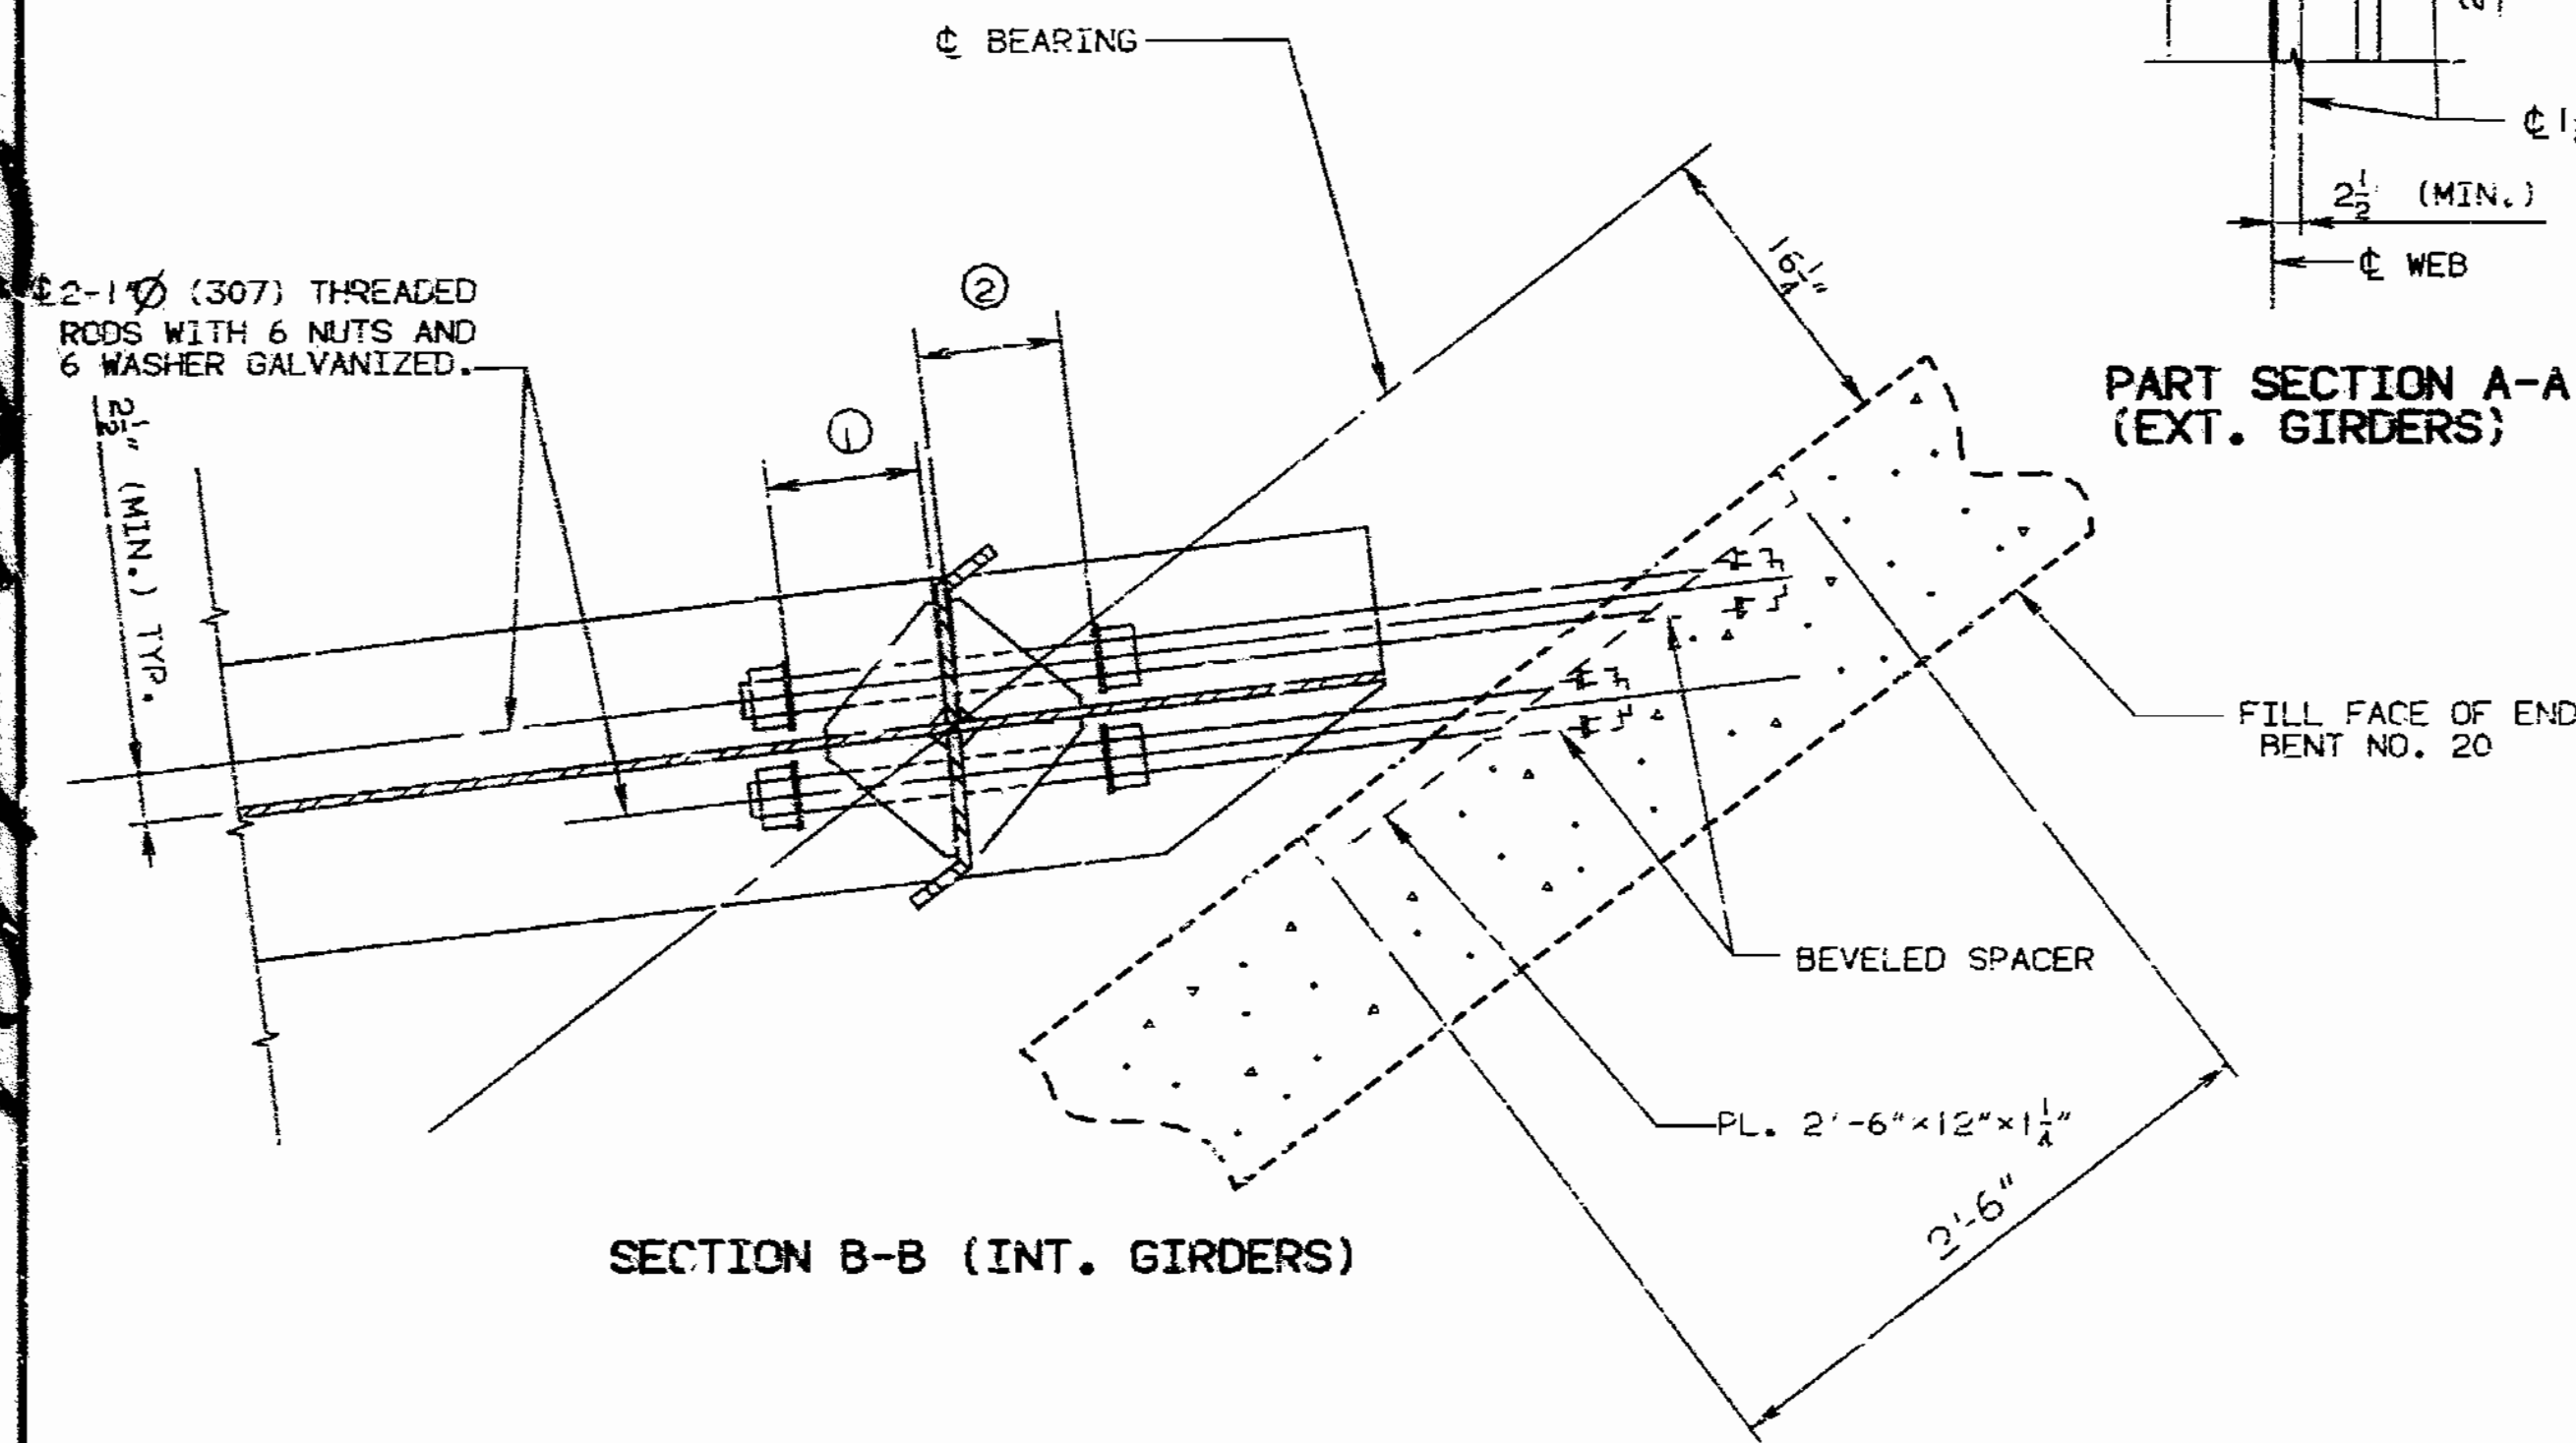

SECTION B-B (INT. GIRDERS)

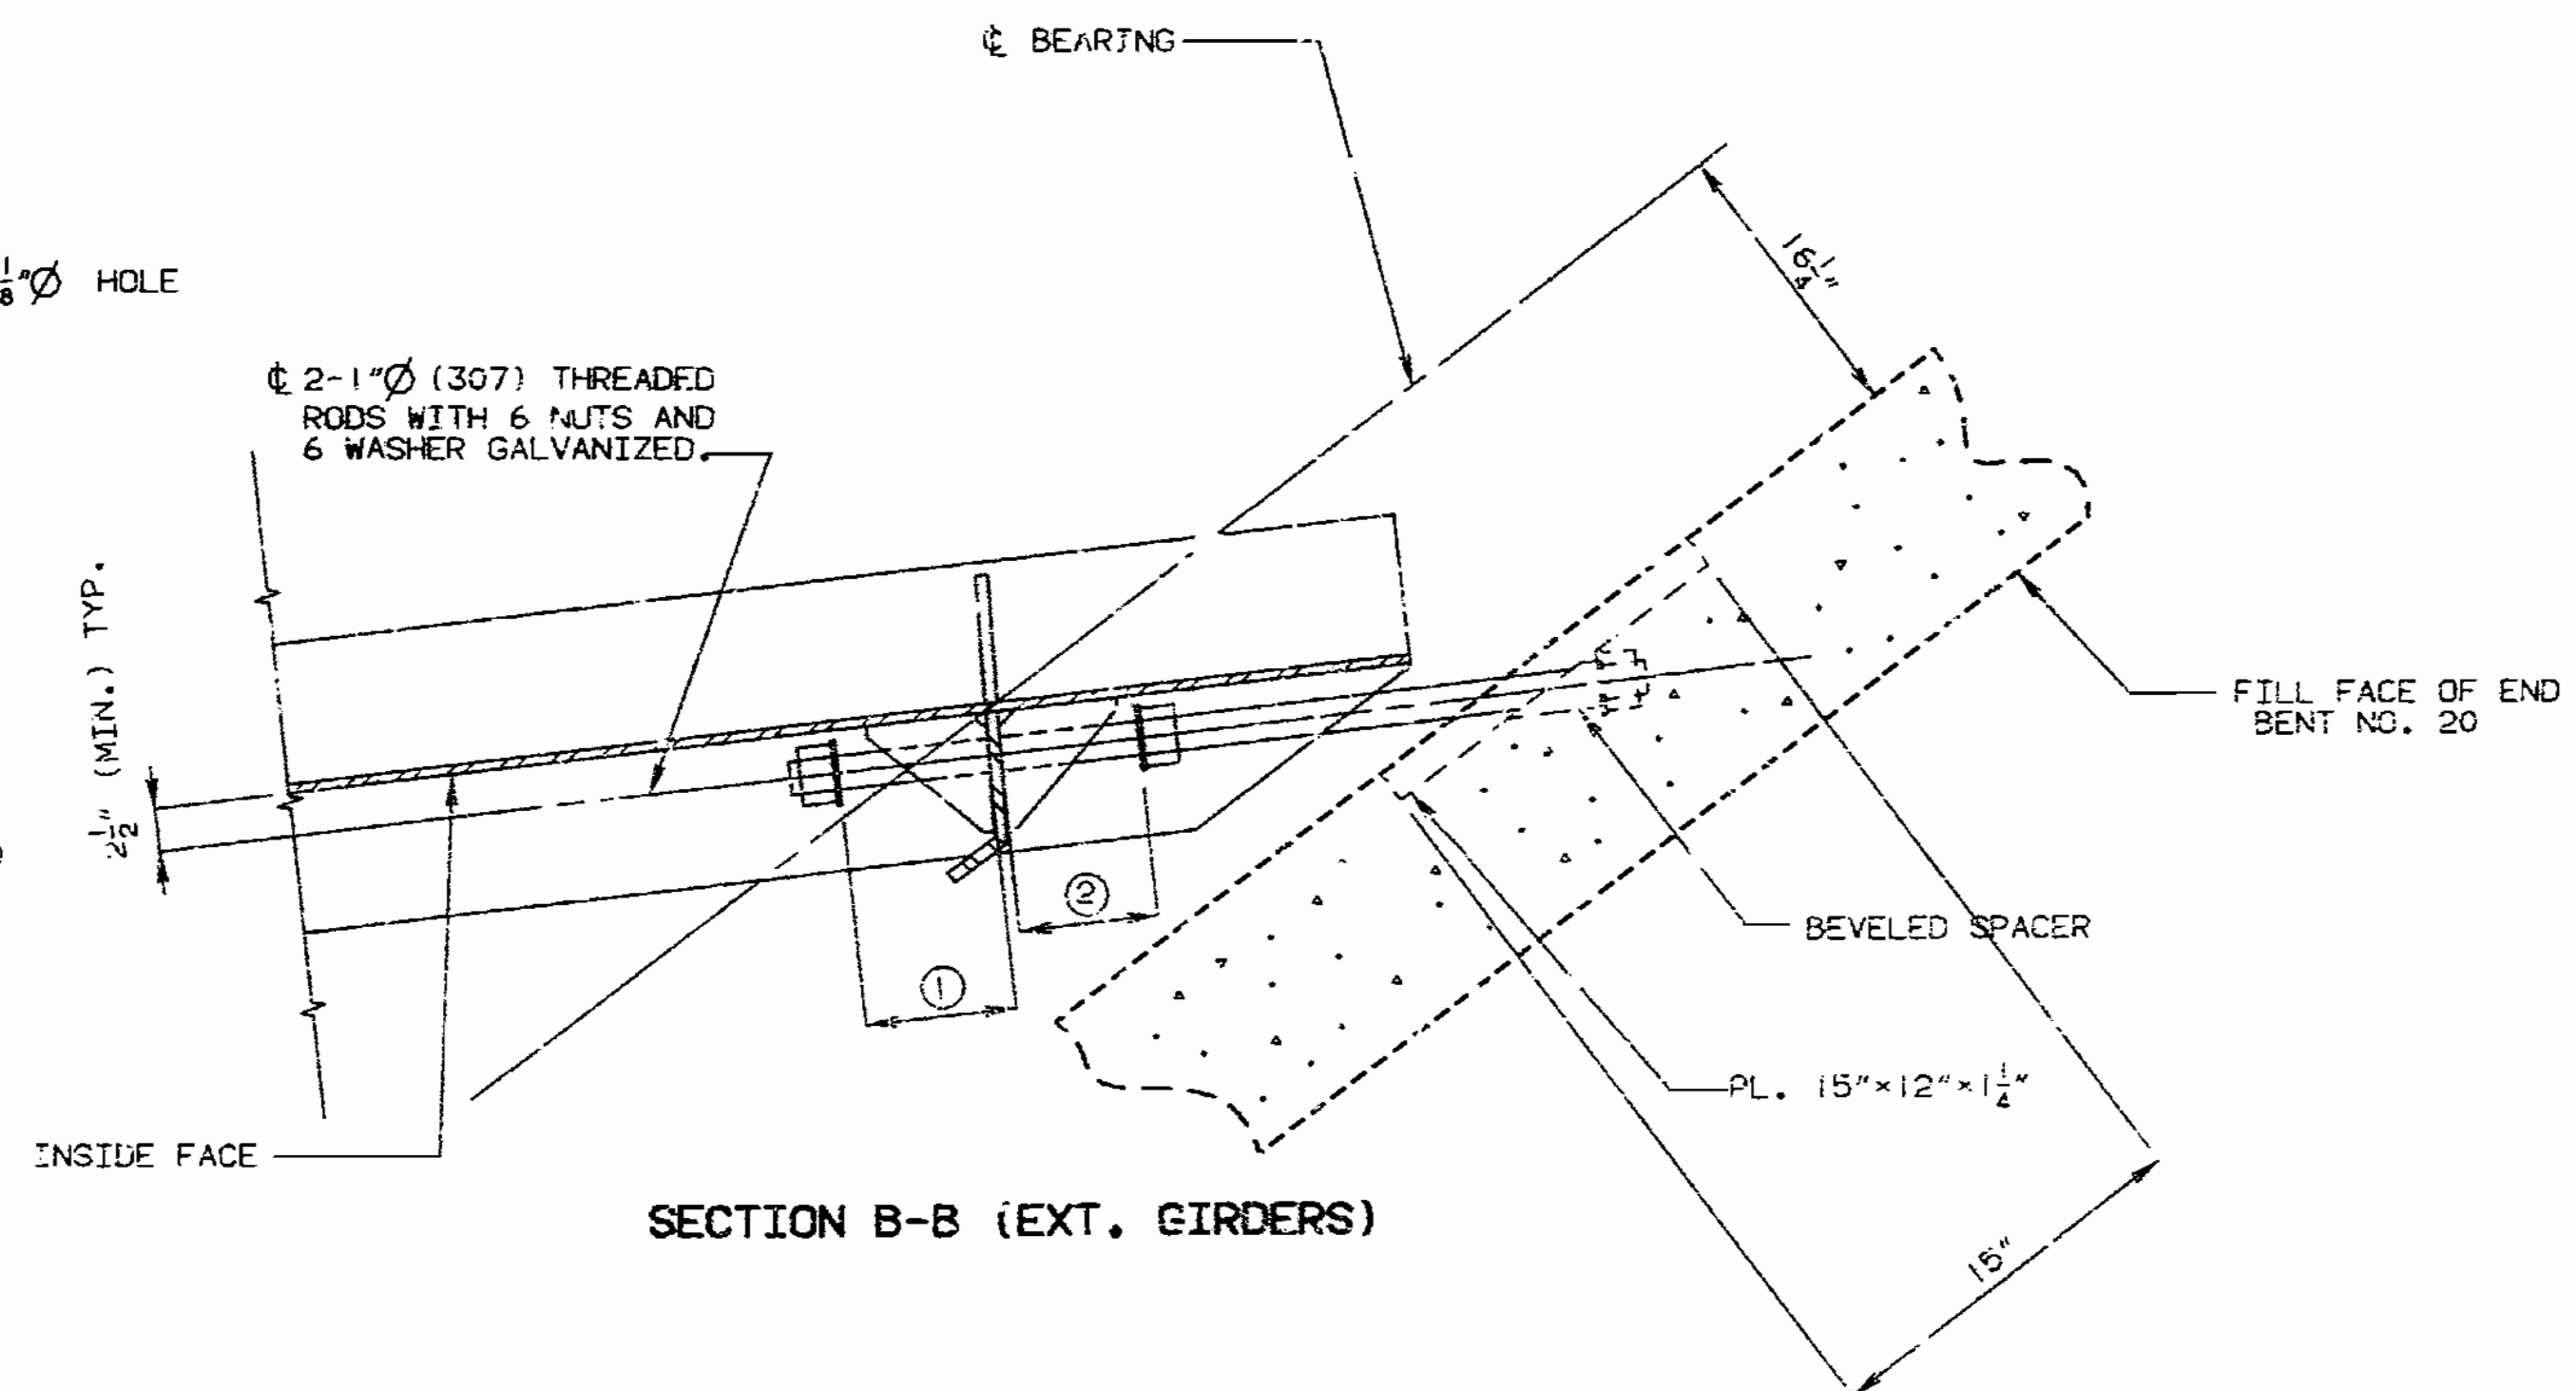

SECTION B-B (EXT. GIRDERS)

DETAILS OF EARTHQUAKE RESTRAINERS AT BENT NO. 20

DETAILED JULY 1988  
CHECKED FEB. 1989

NOTE: THIS DRAWING IS NOT TO SCALE. FOLLOW DIMENSIONS.

SHEET NO. 62 OF 98.

JACKSON COUNTY


A-2745

158







STATE	PROJ. NO.	SHEET NO.
MO.		145

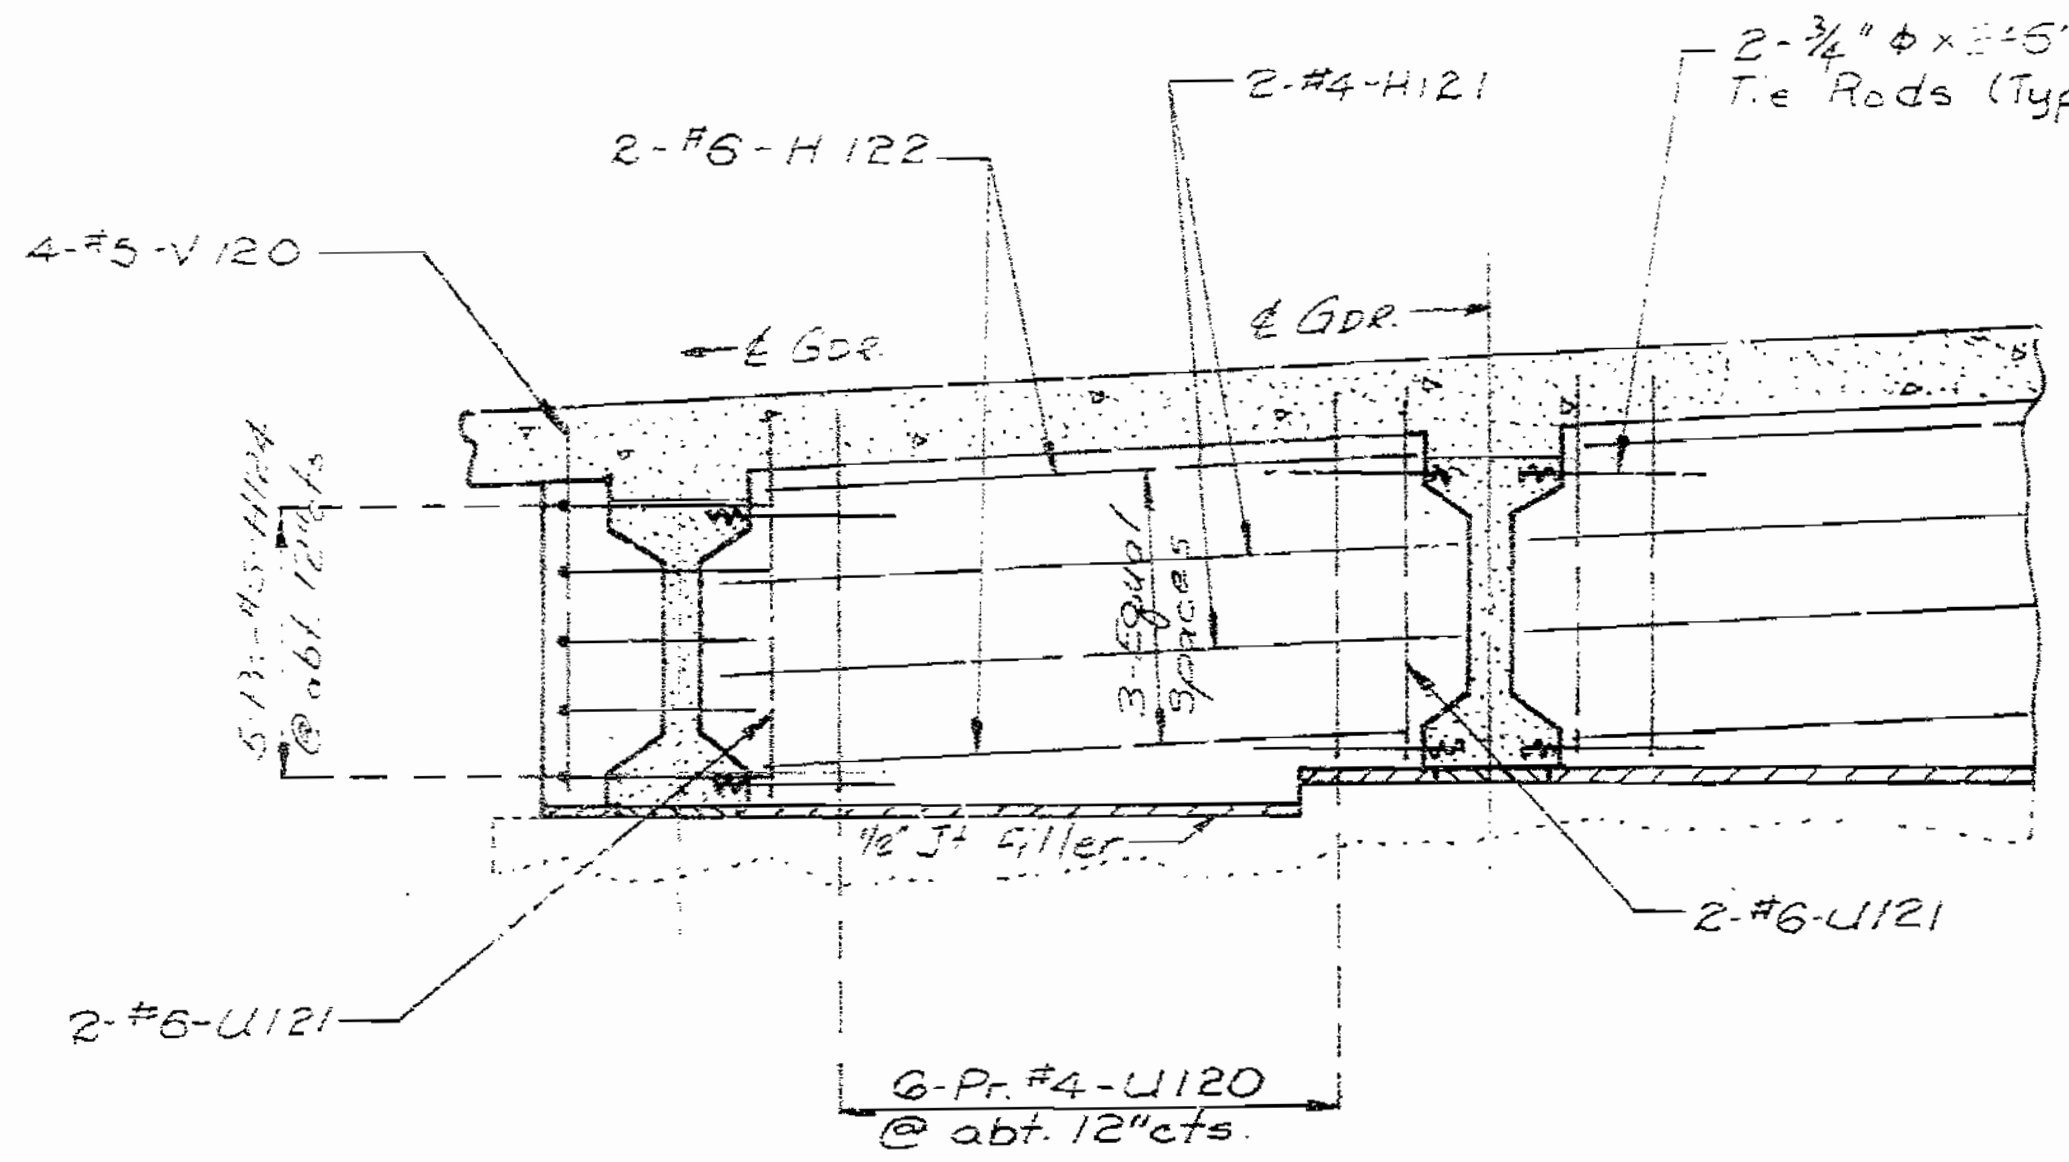


PART ELEV. AT INT. BT. NO. 12

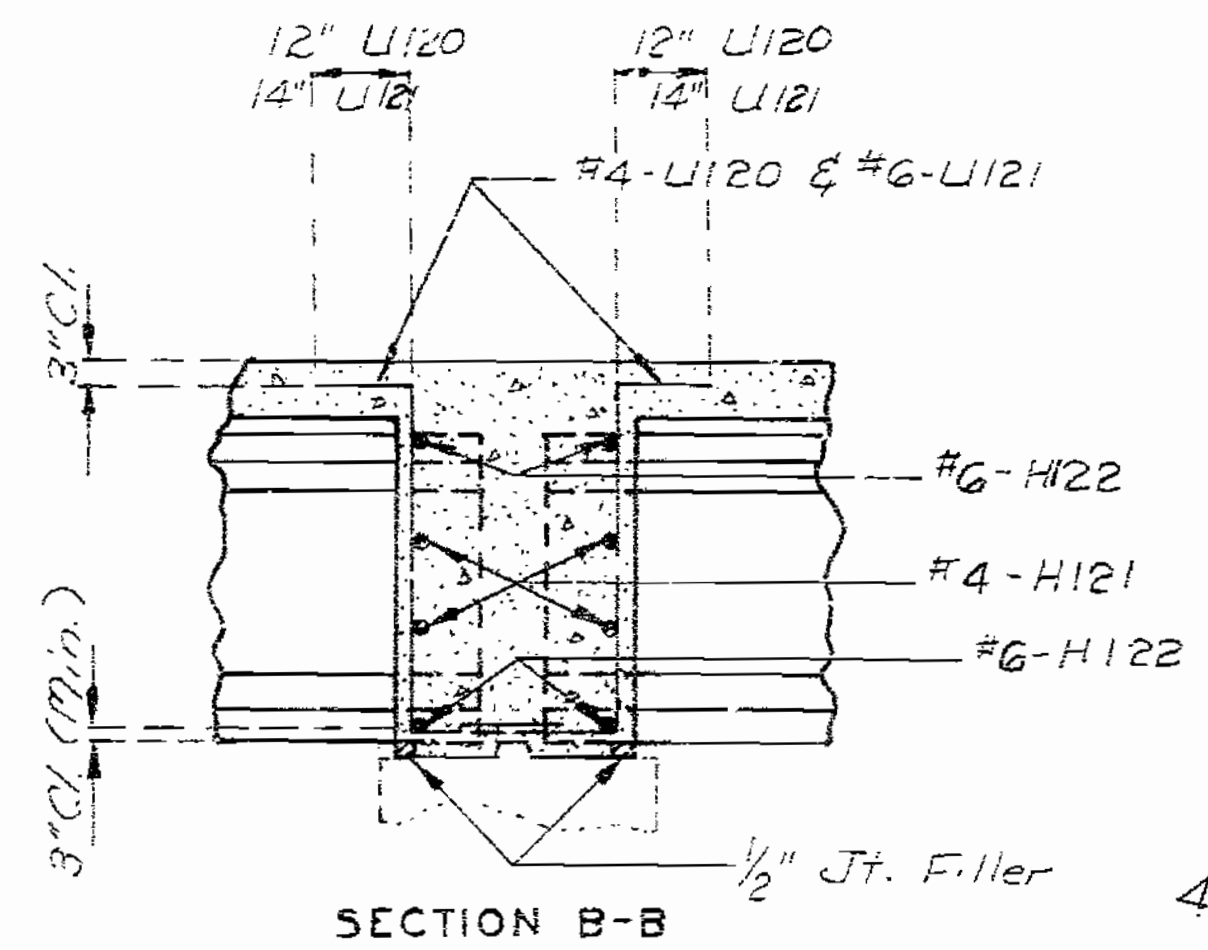


SECTION B-B

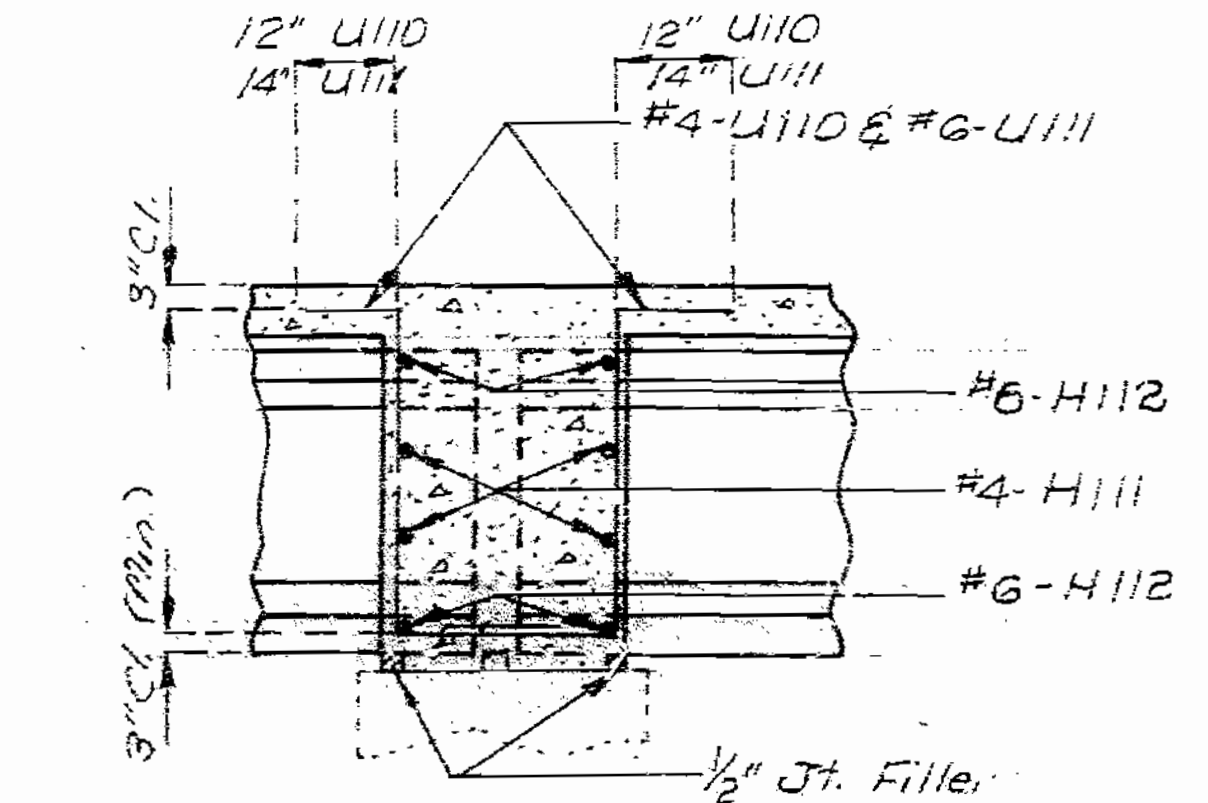


SECTION A-A

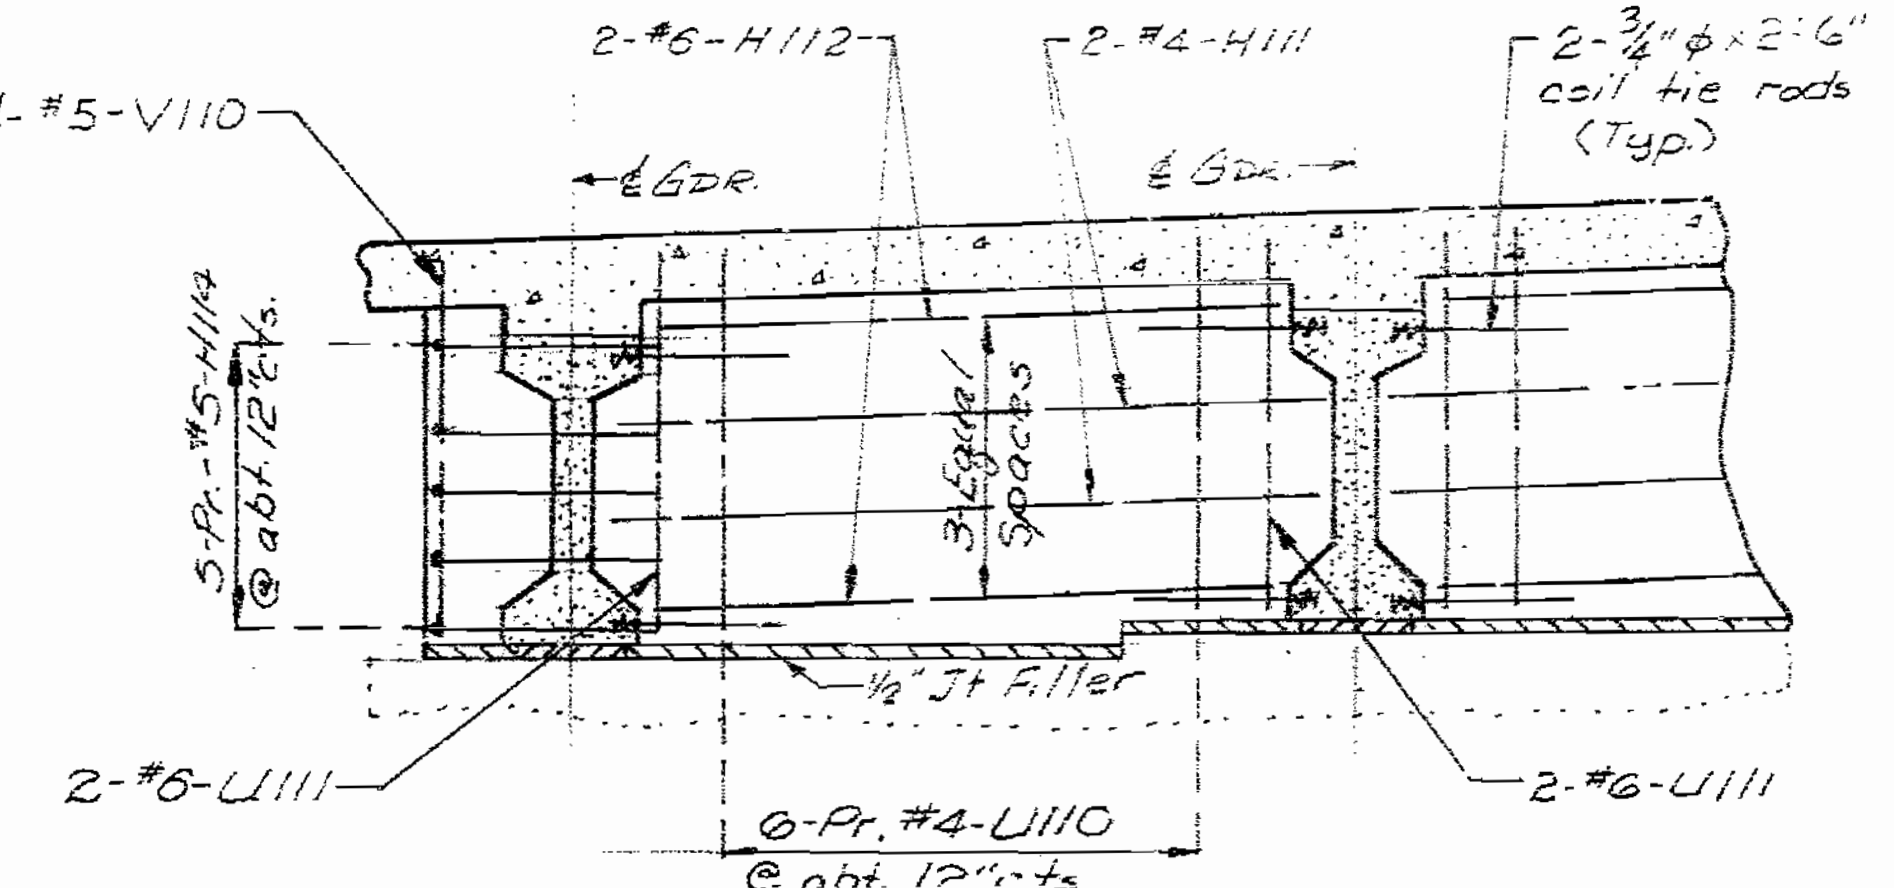

PART ELEV. AT INT. BT. NO. 11

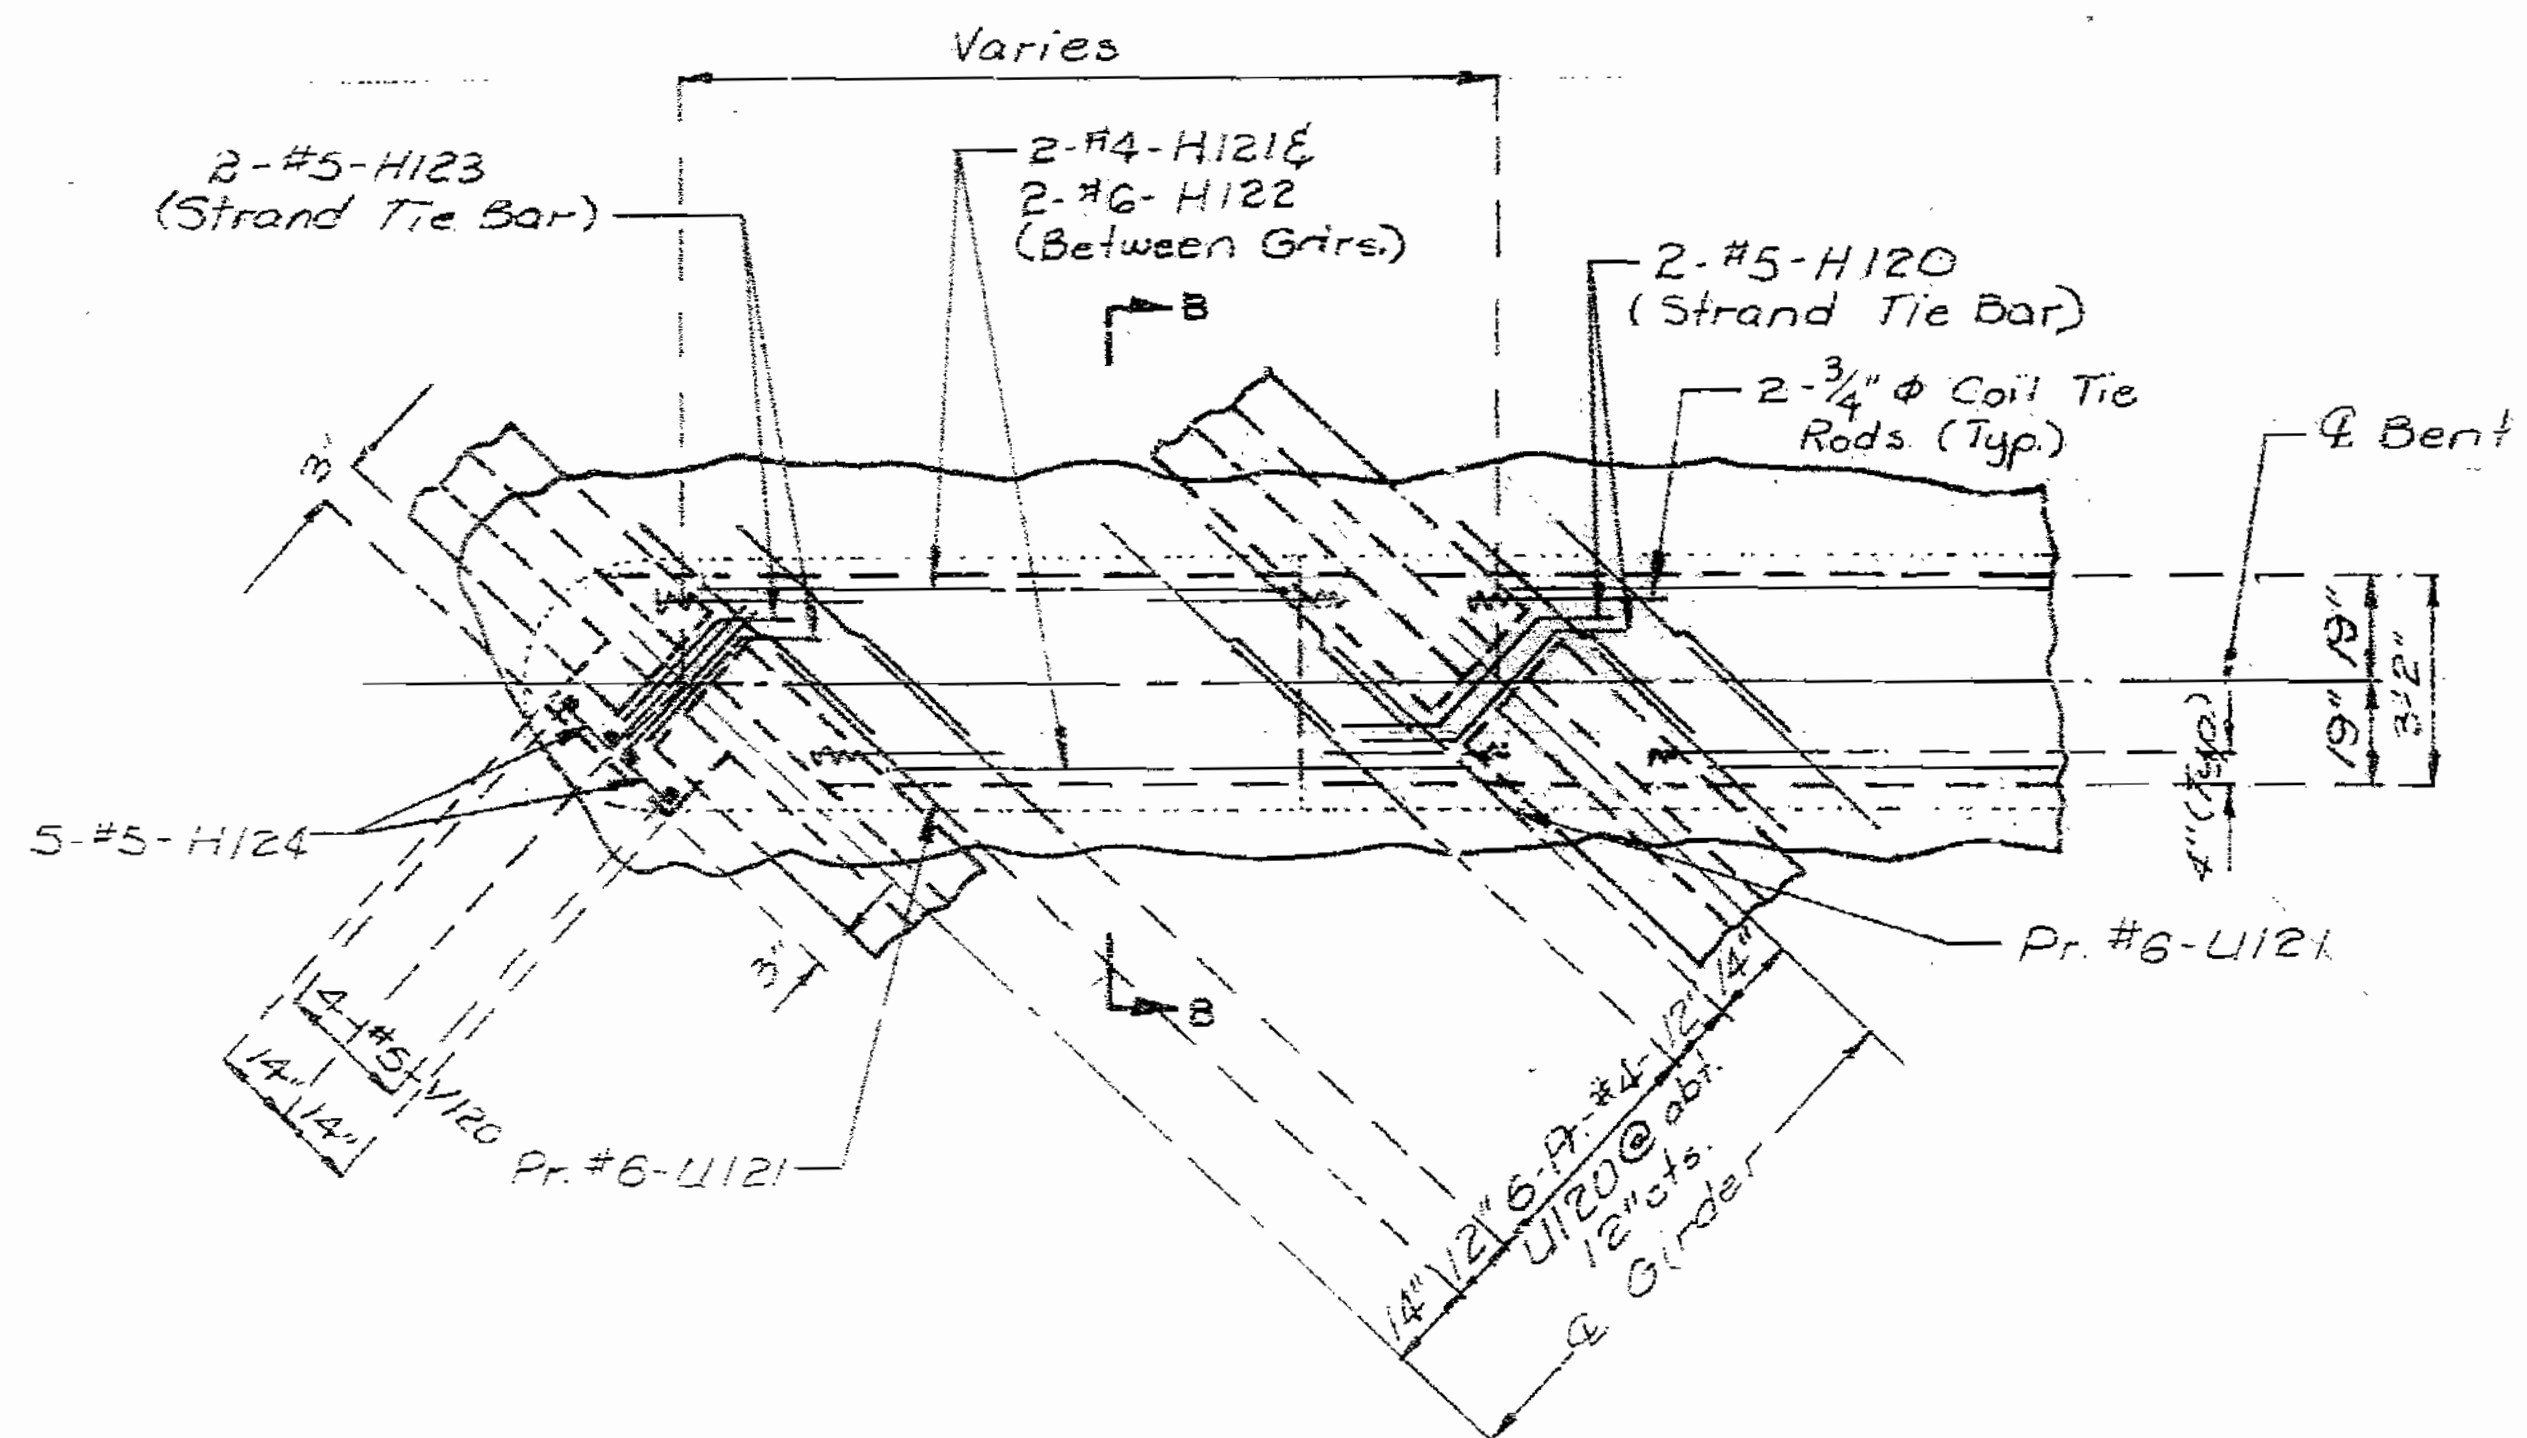

PART PLAN AT INT. BT. NO. 12

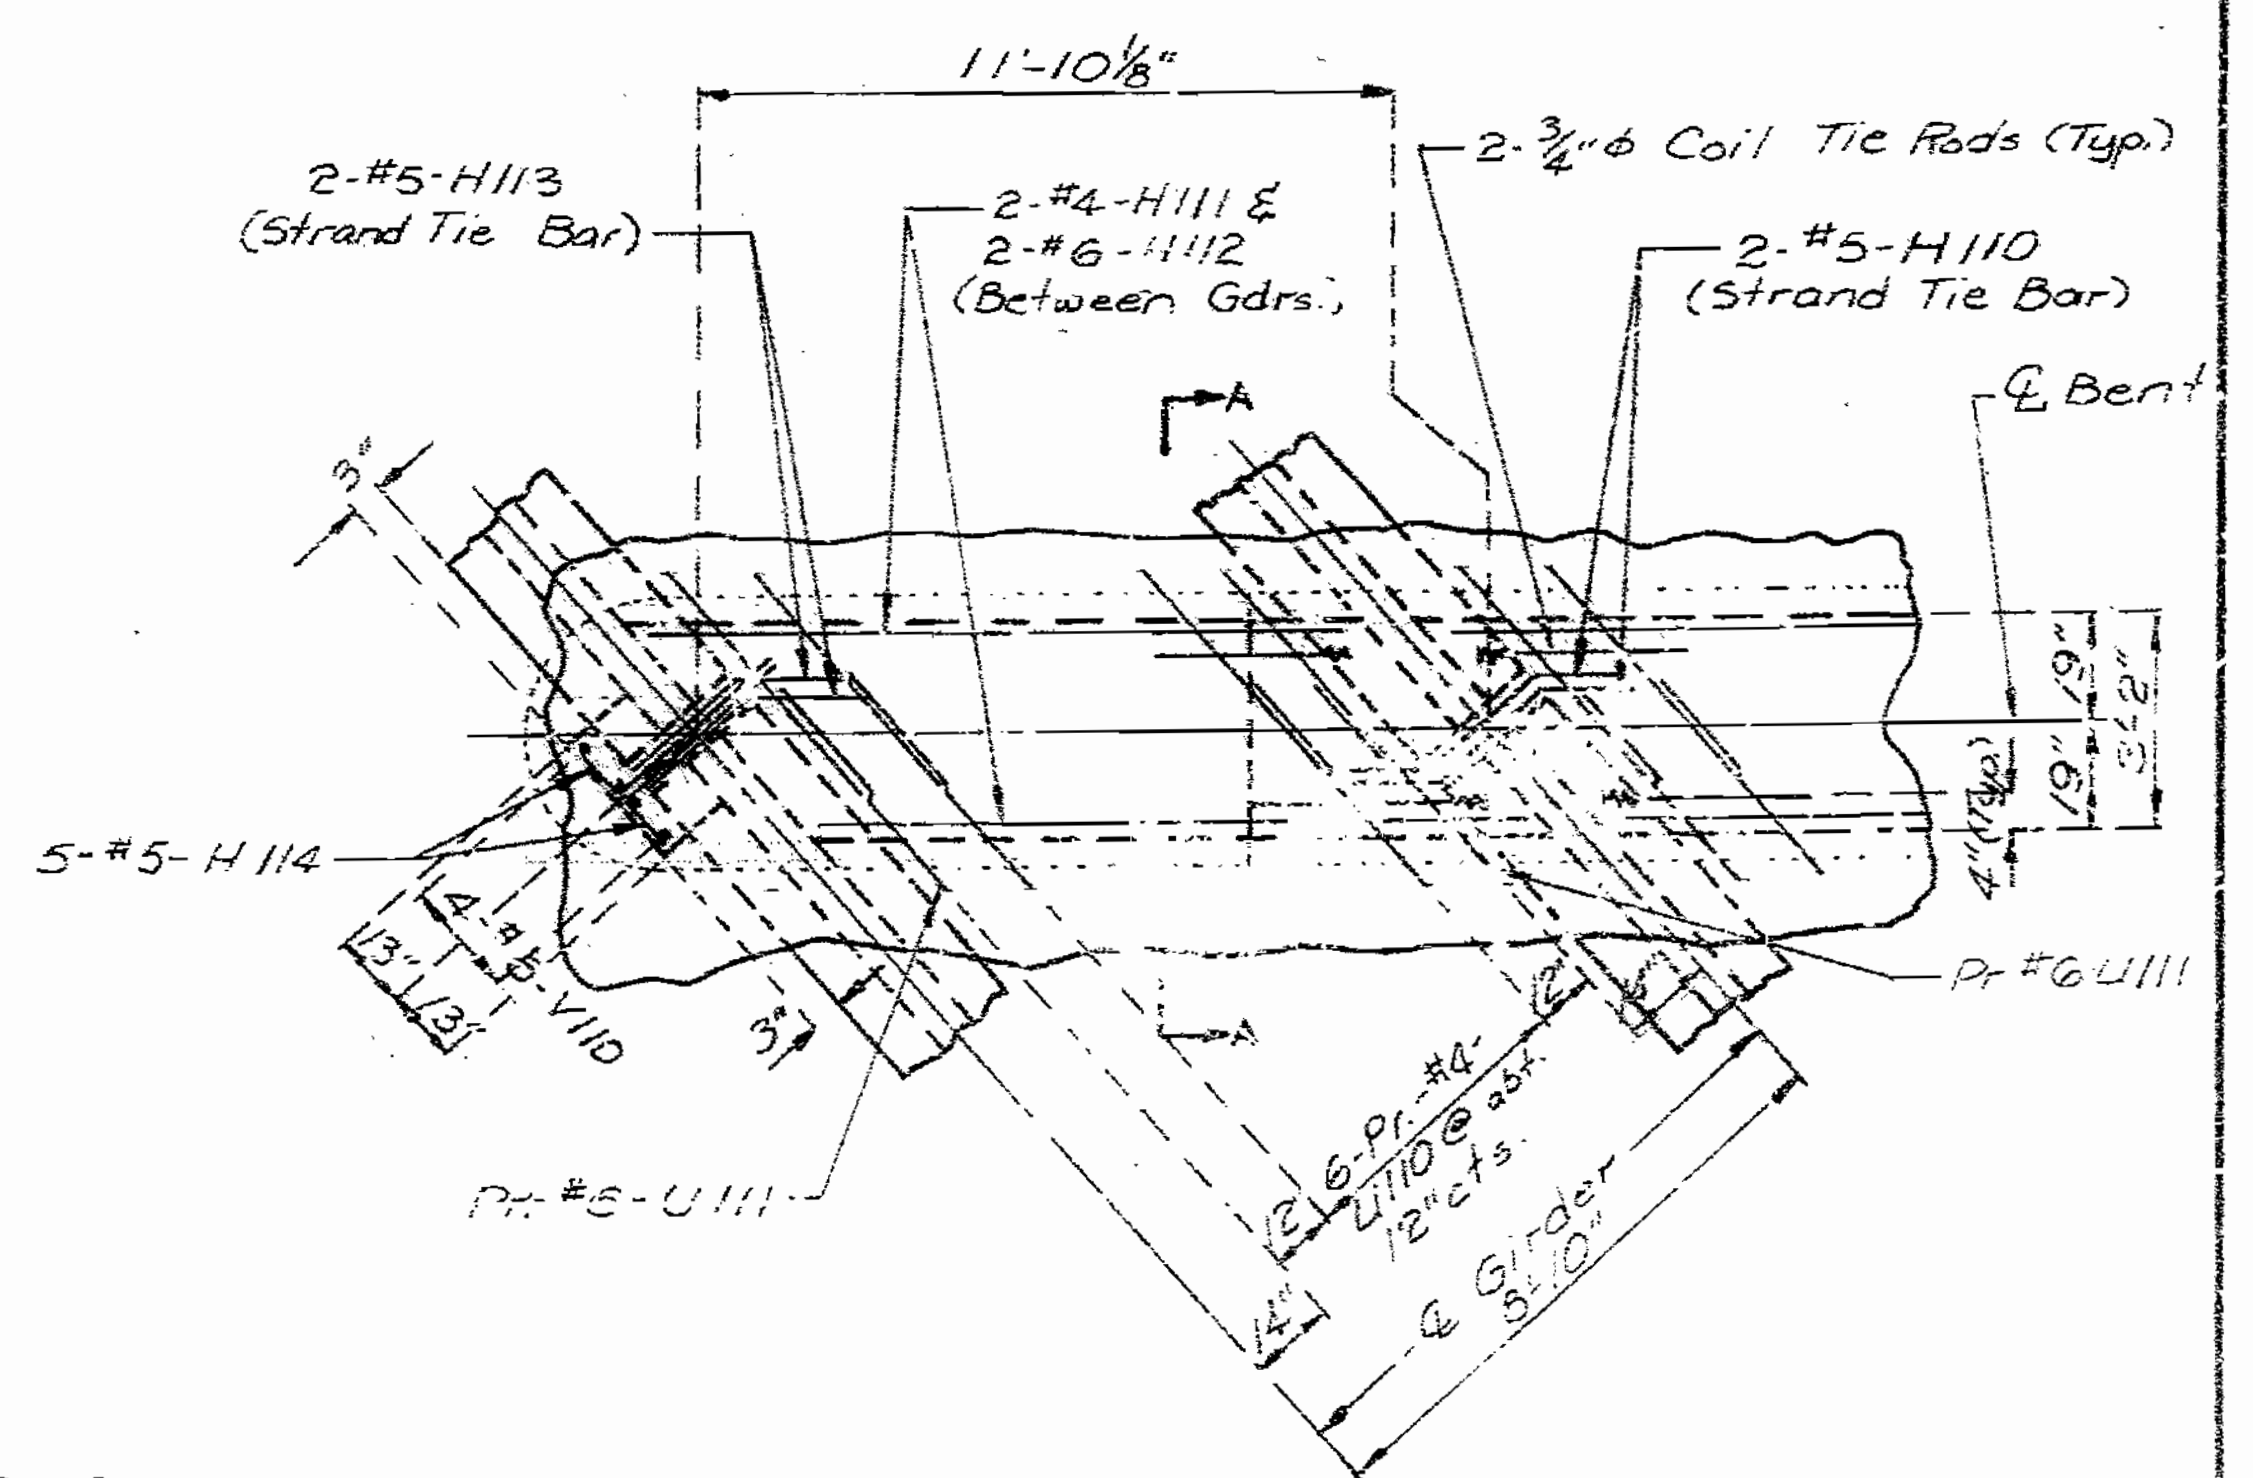

PART PLAN AT INT. BT. NO. 11

DETAILS OF INTERMEDIATE BENT DIAPHRAGMS

DESIGNED Sep 1989  
CHECKED Feb 1989

Note: This drawing is not to scale. Follow dimensions.








Sheet No. 65 of 98

JACKSON COUNTY

A-2745

1076

STATE	PROJECT NO.	SHEET NO.
MO.		146

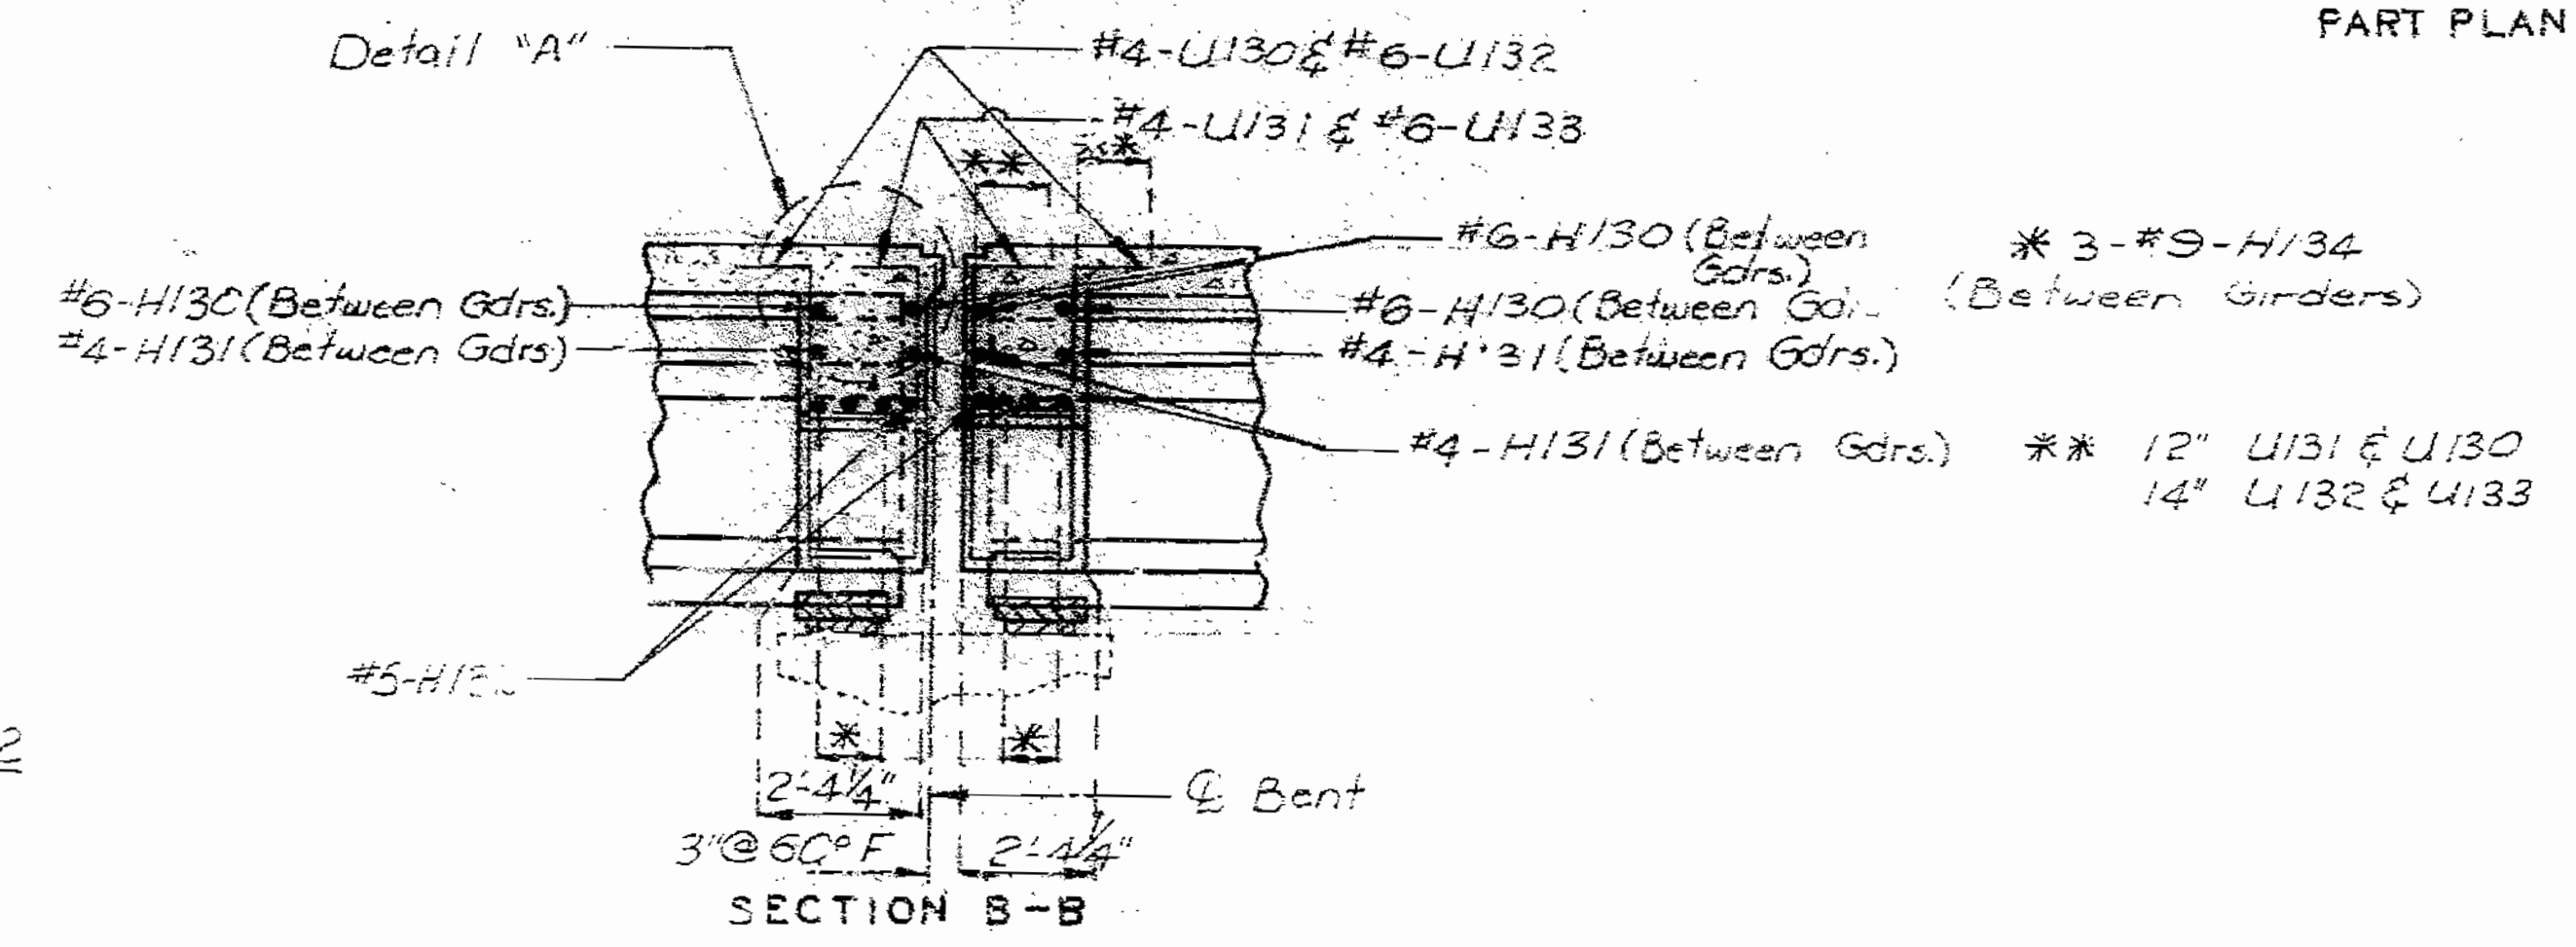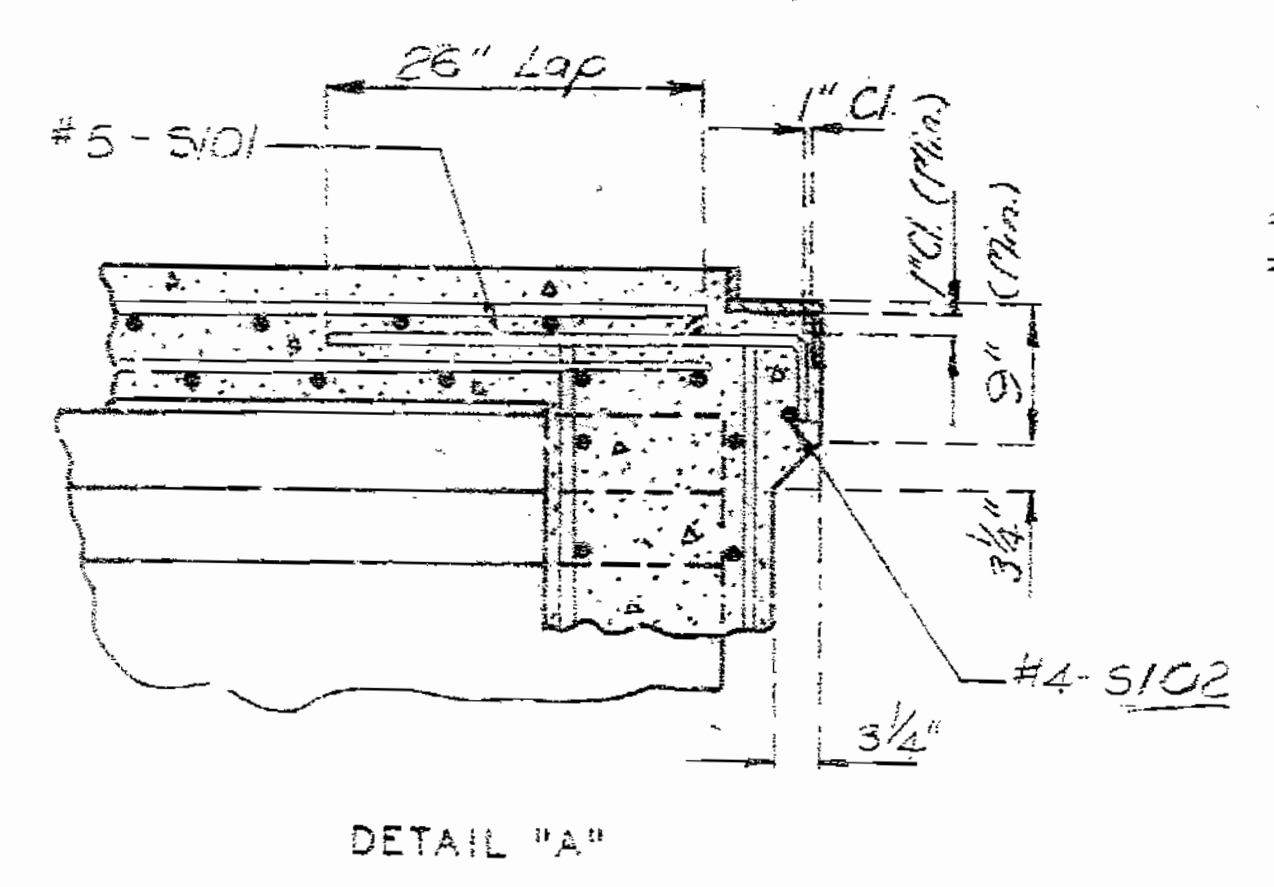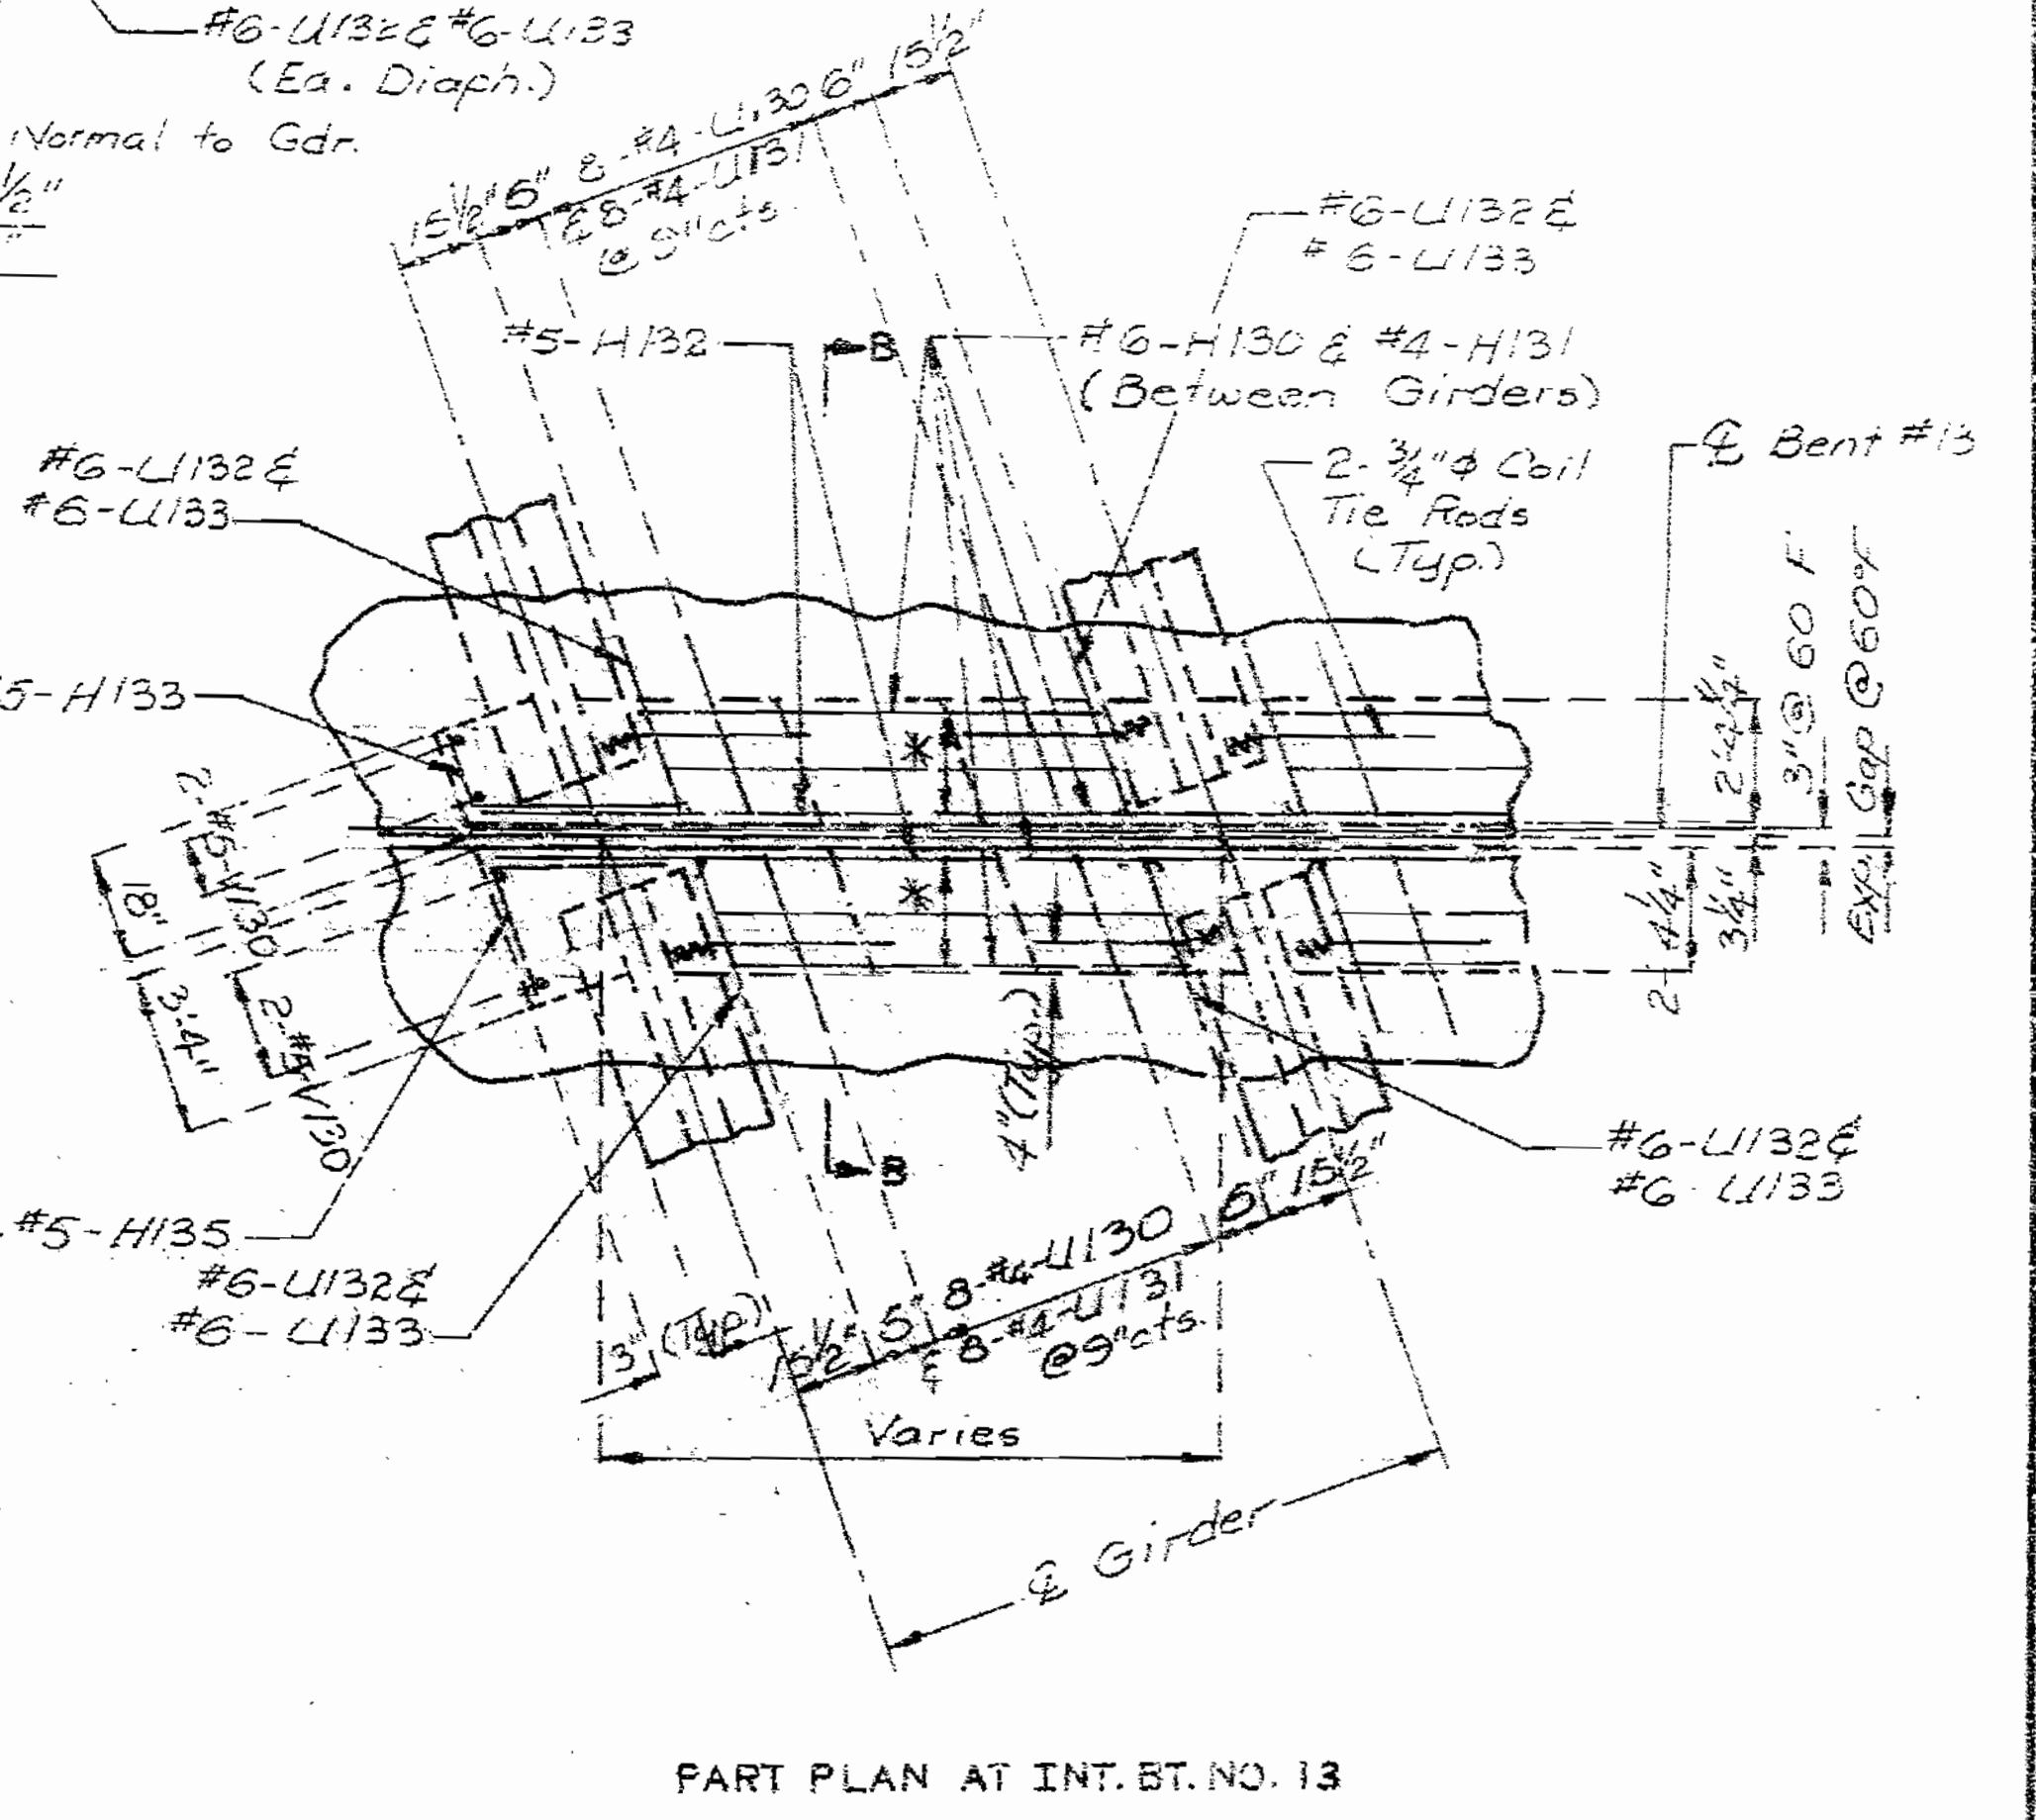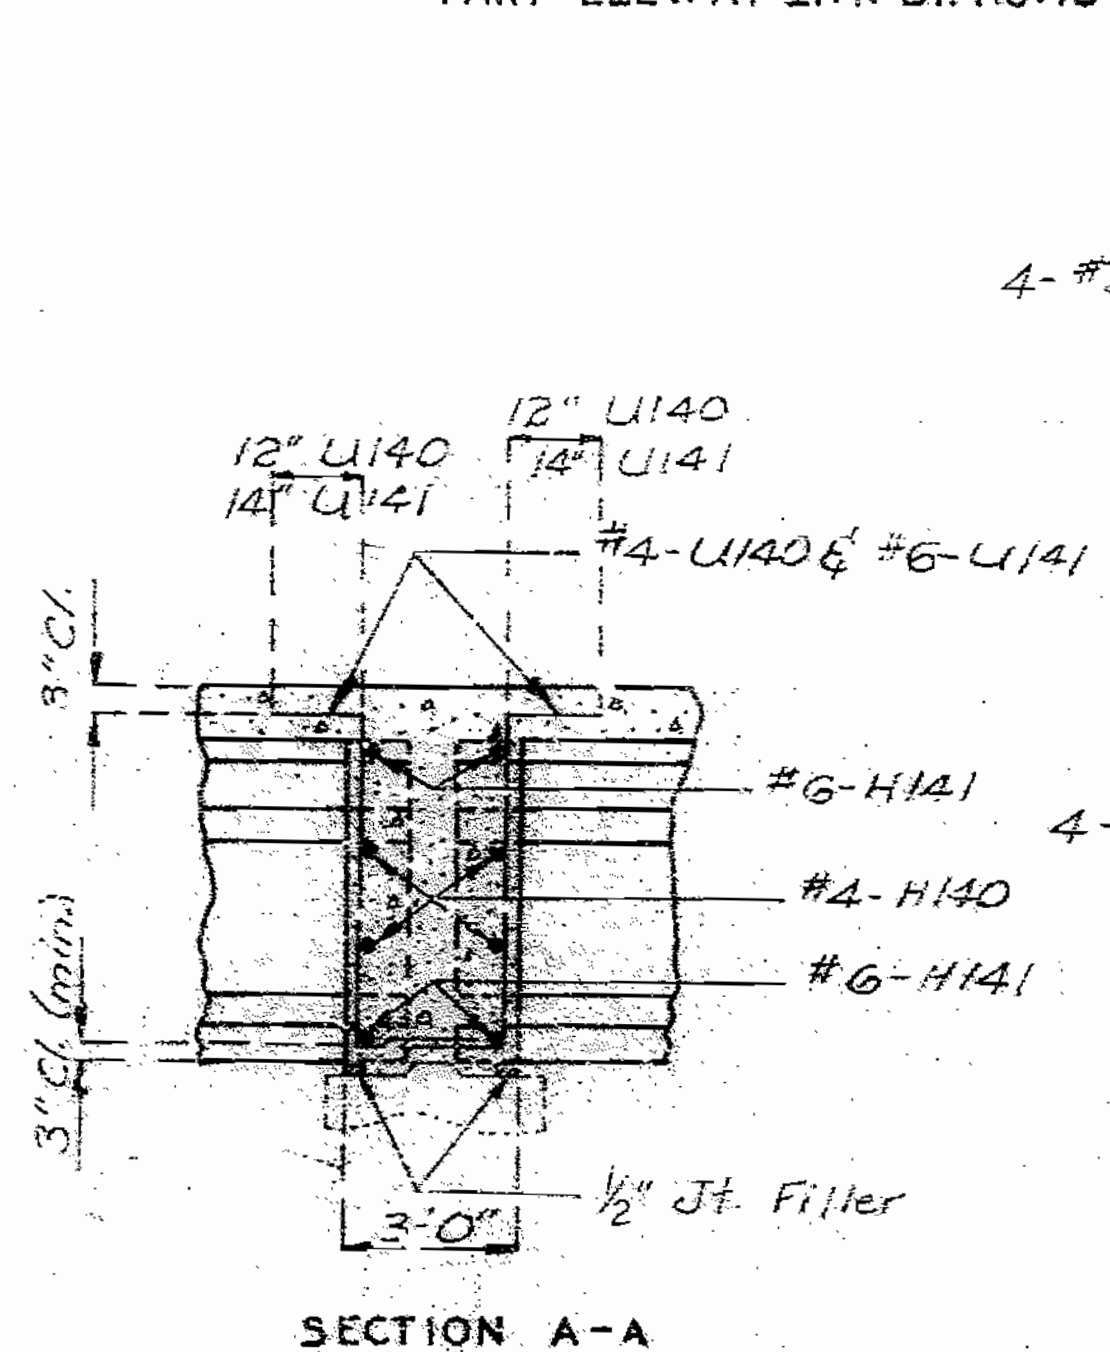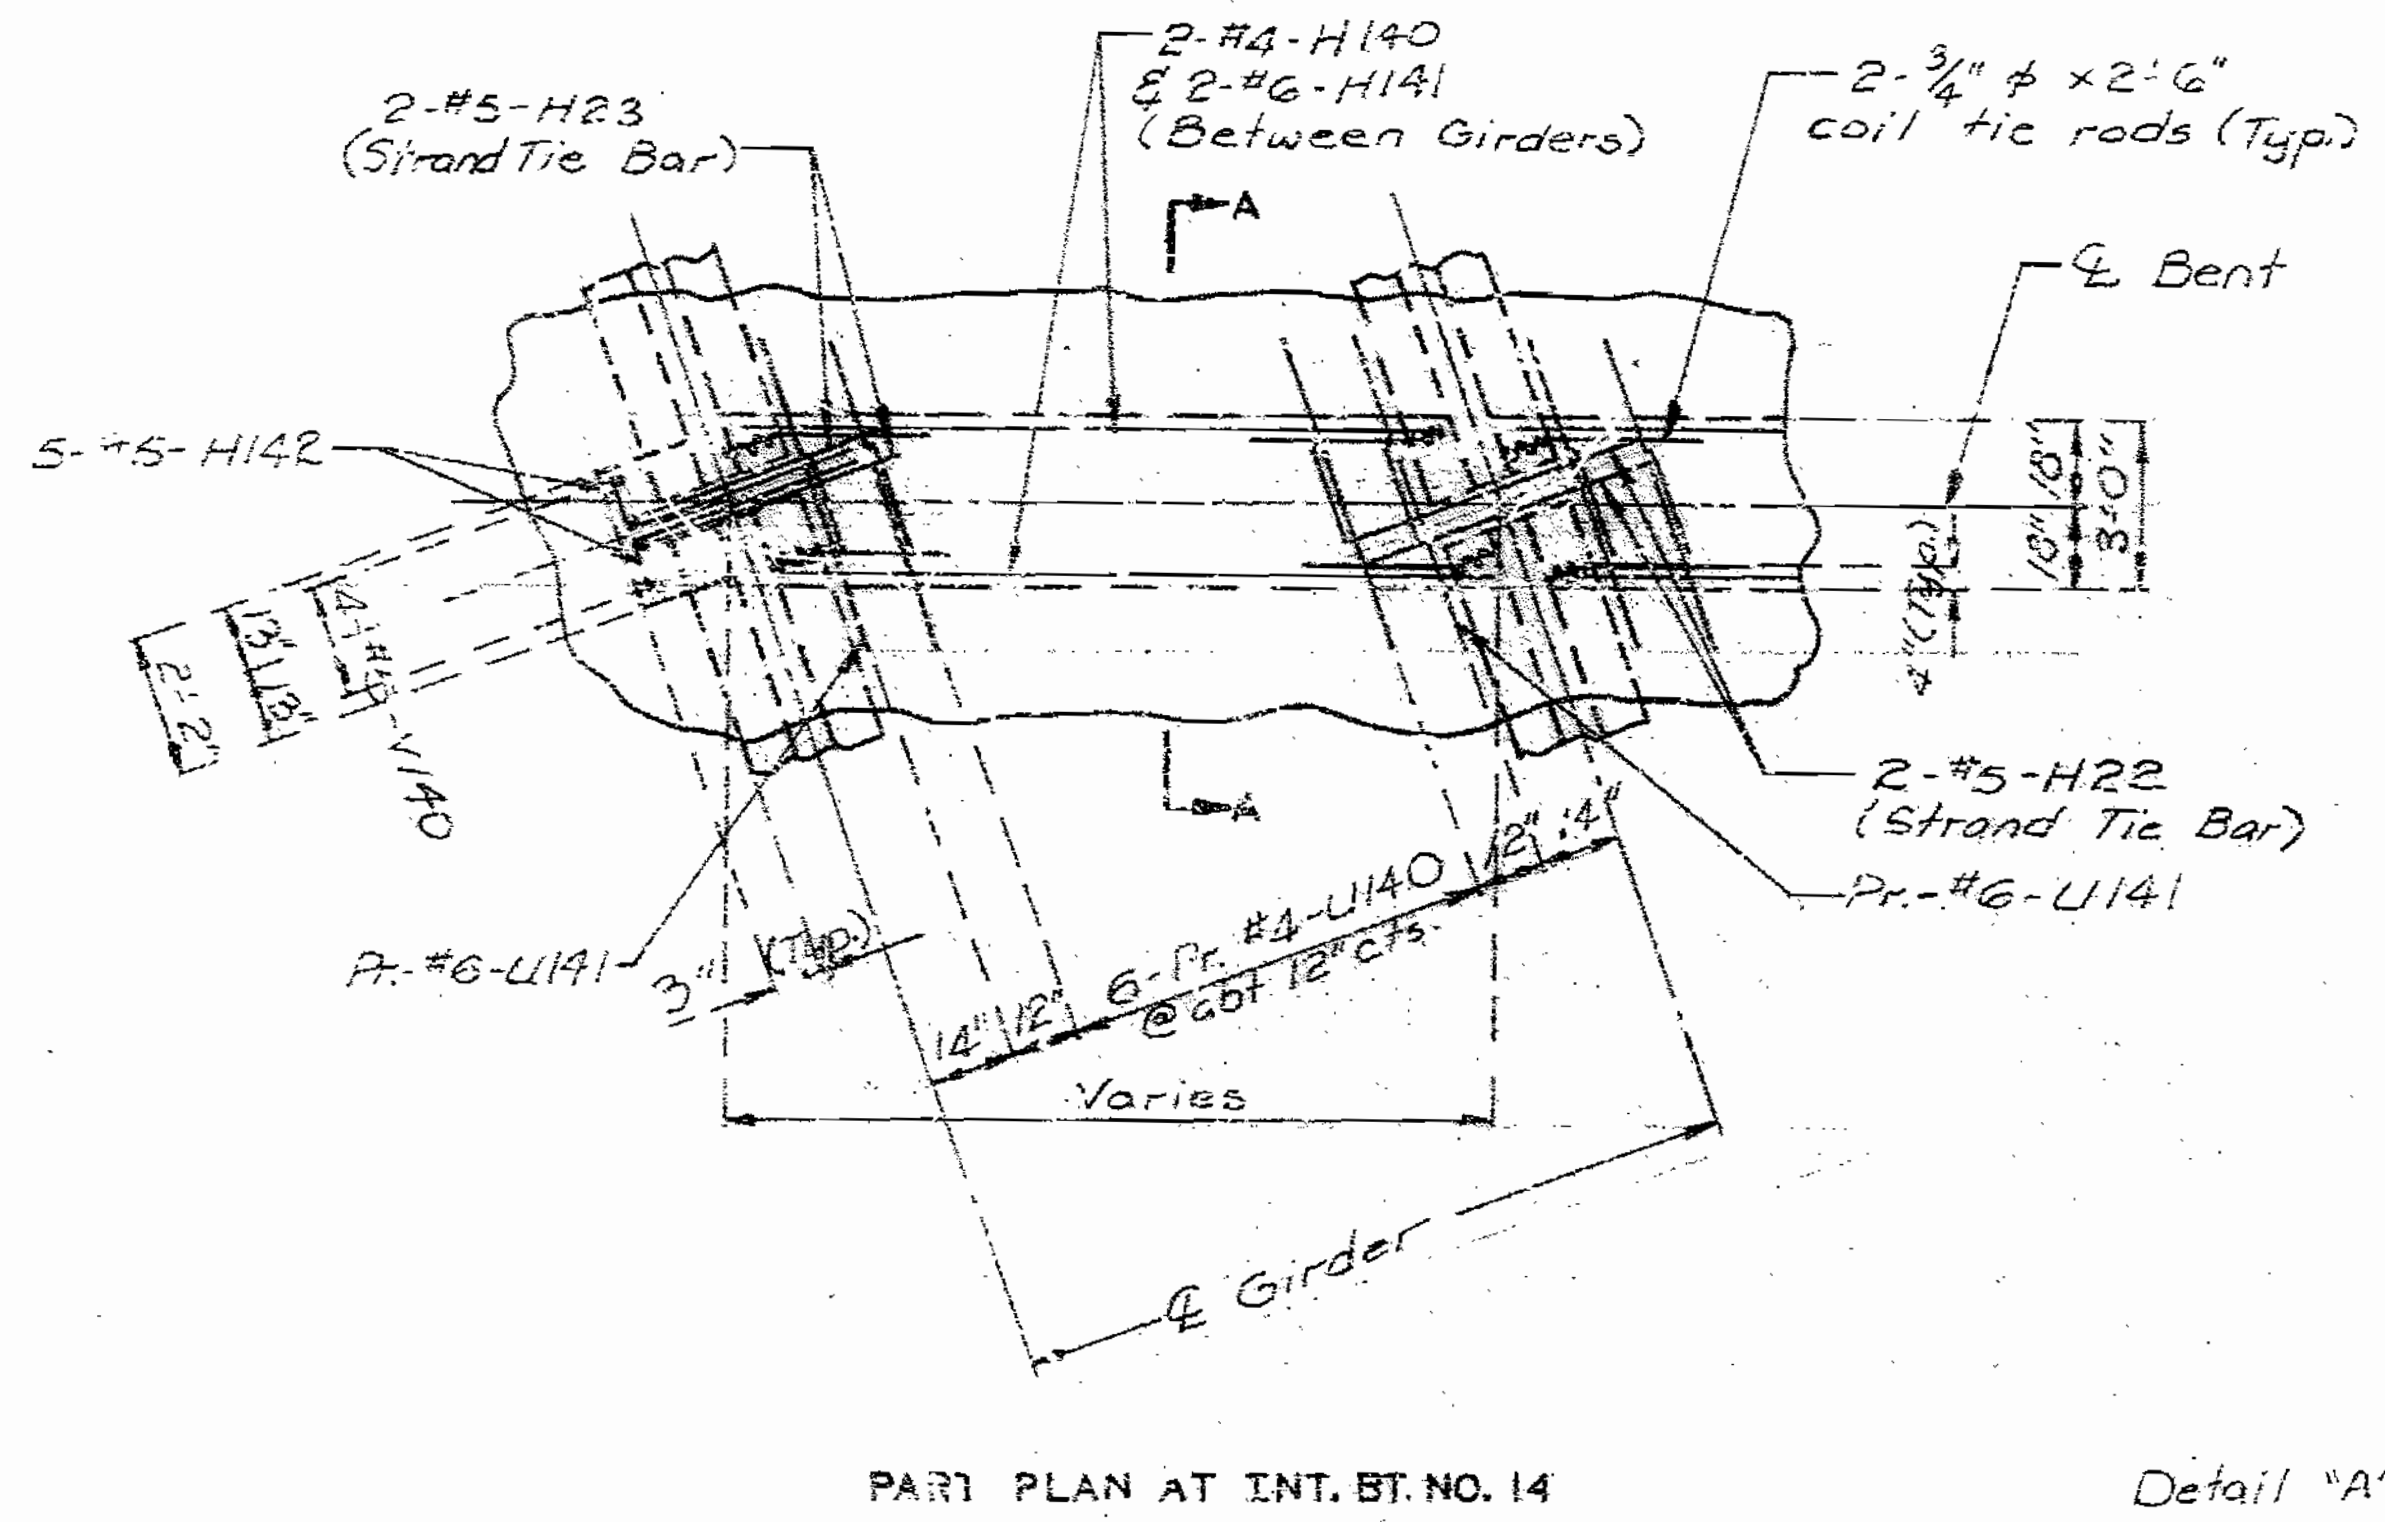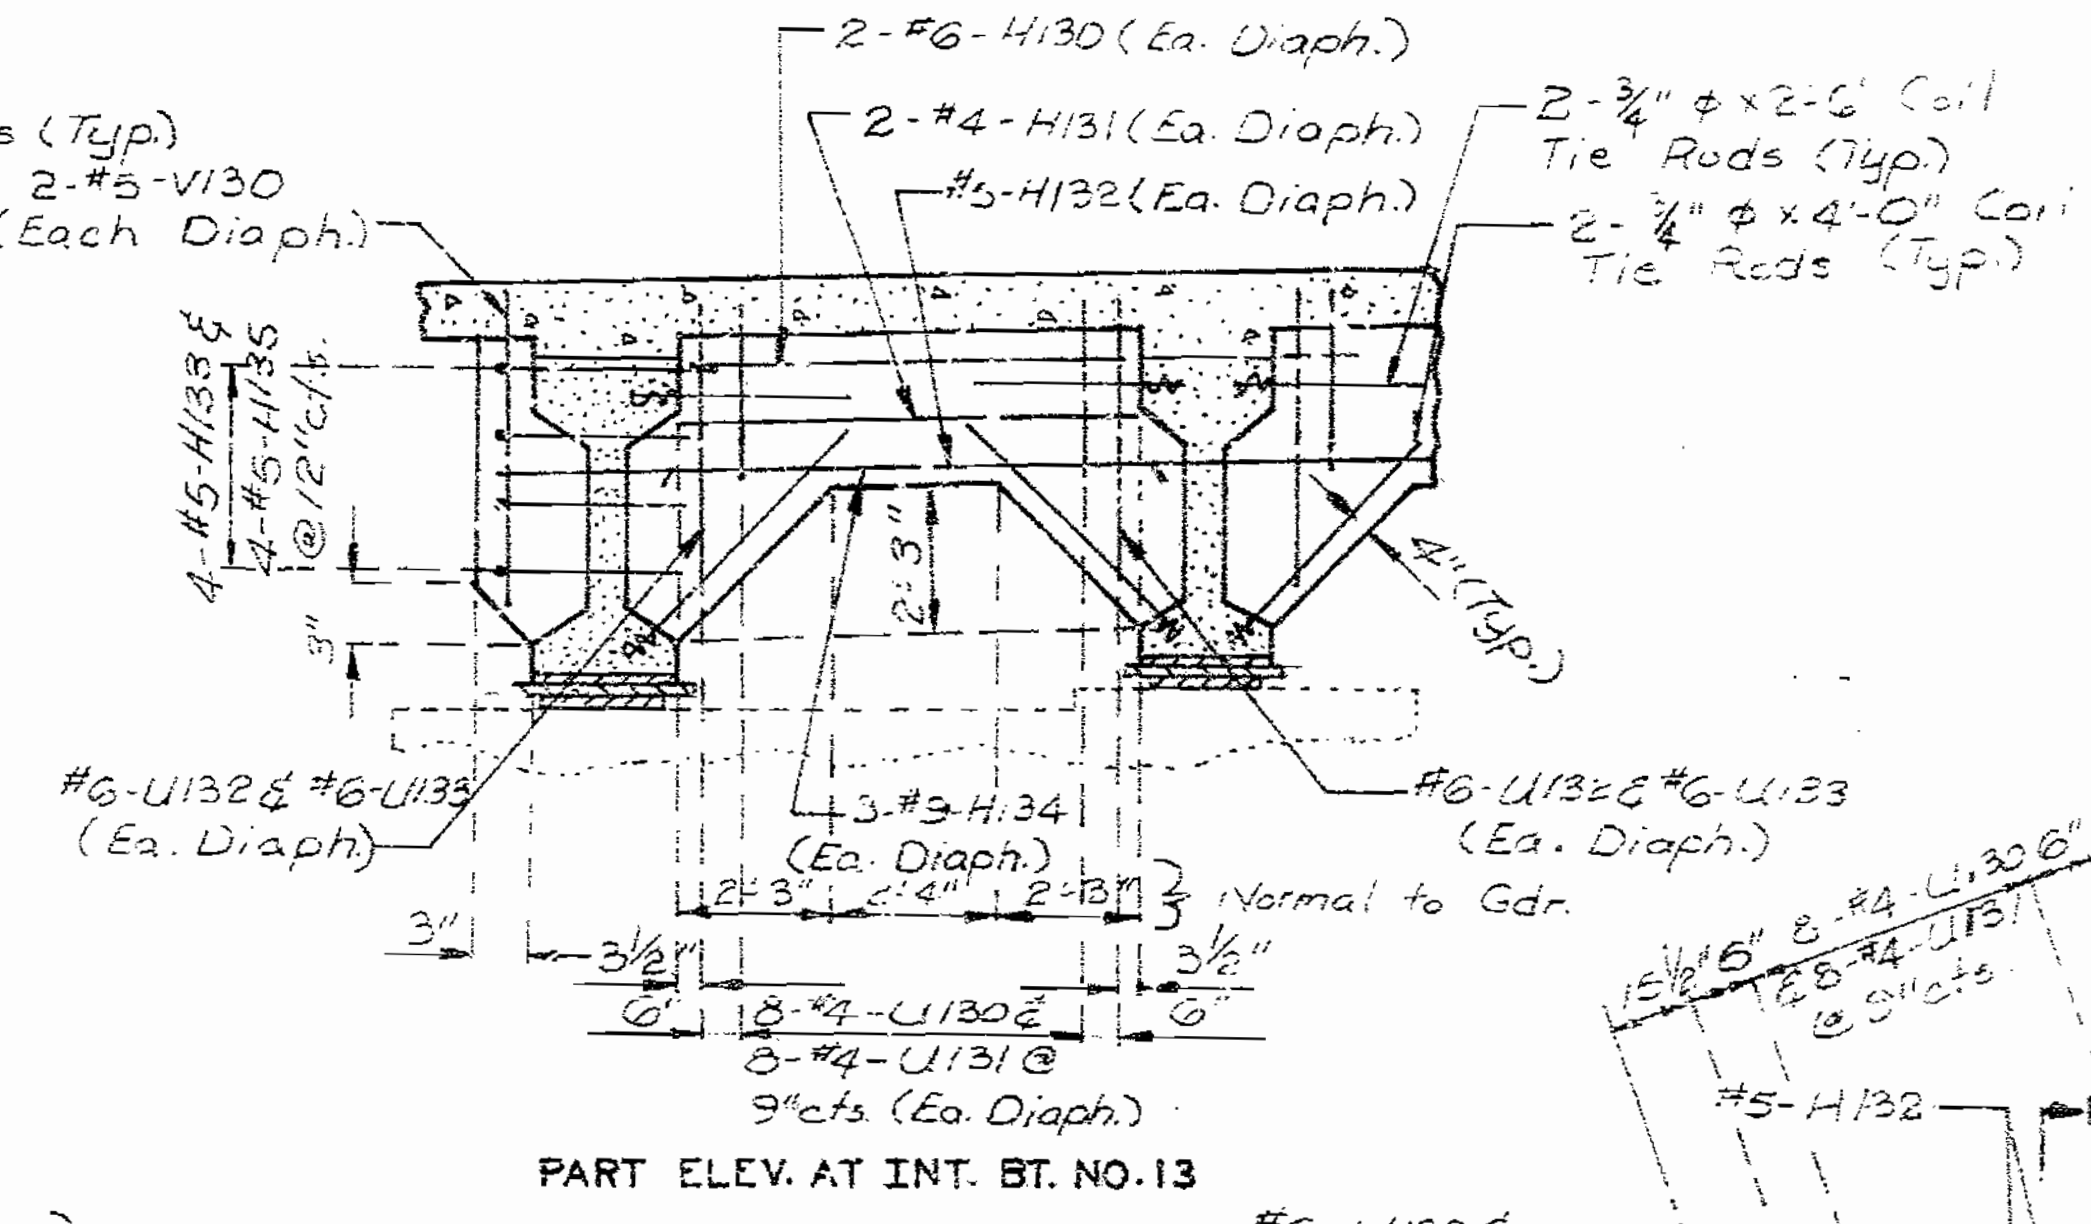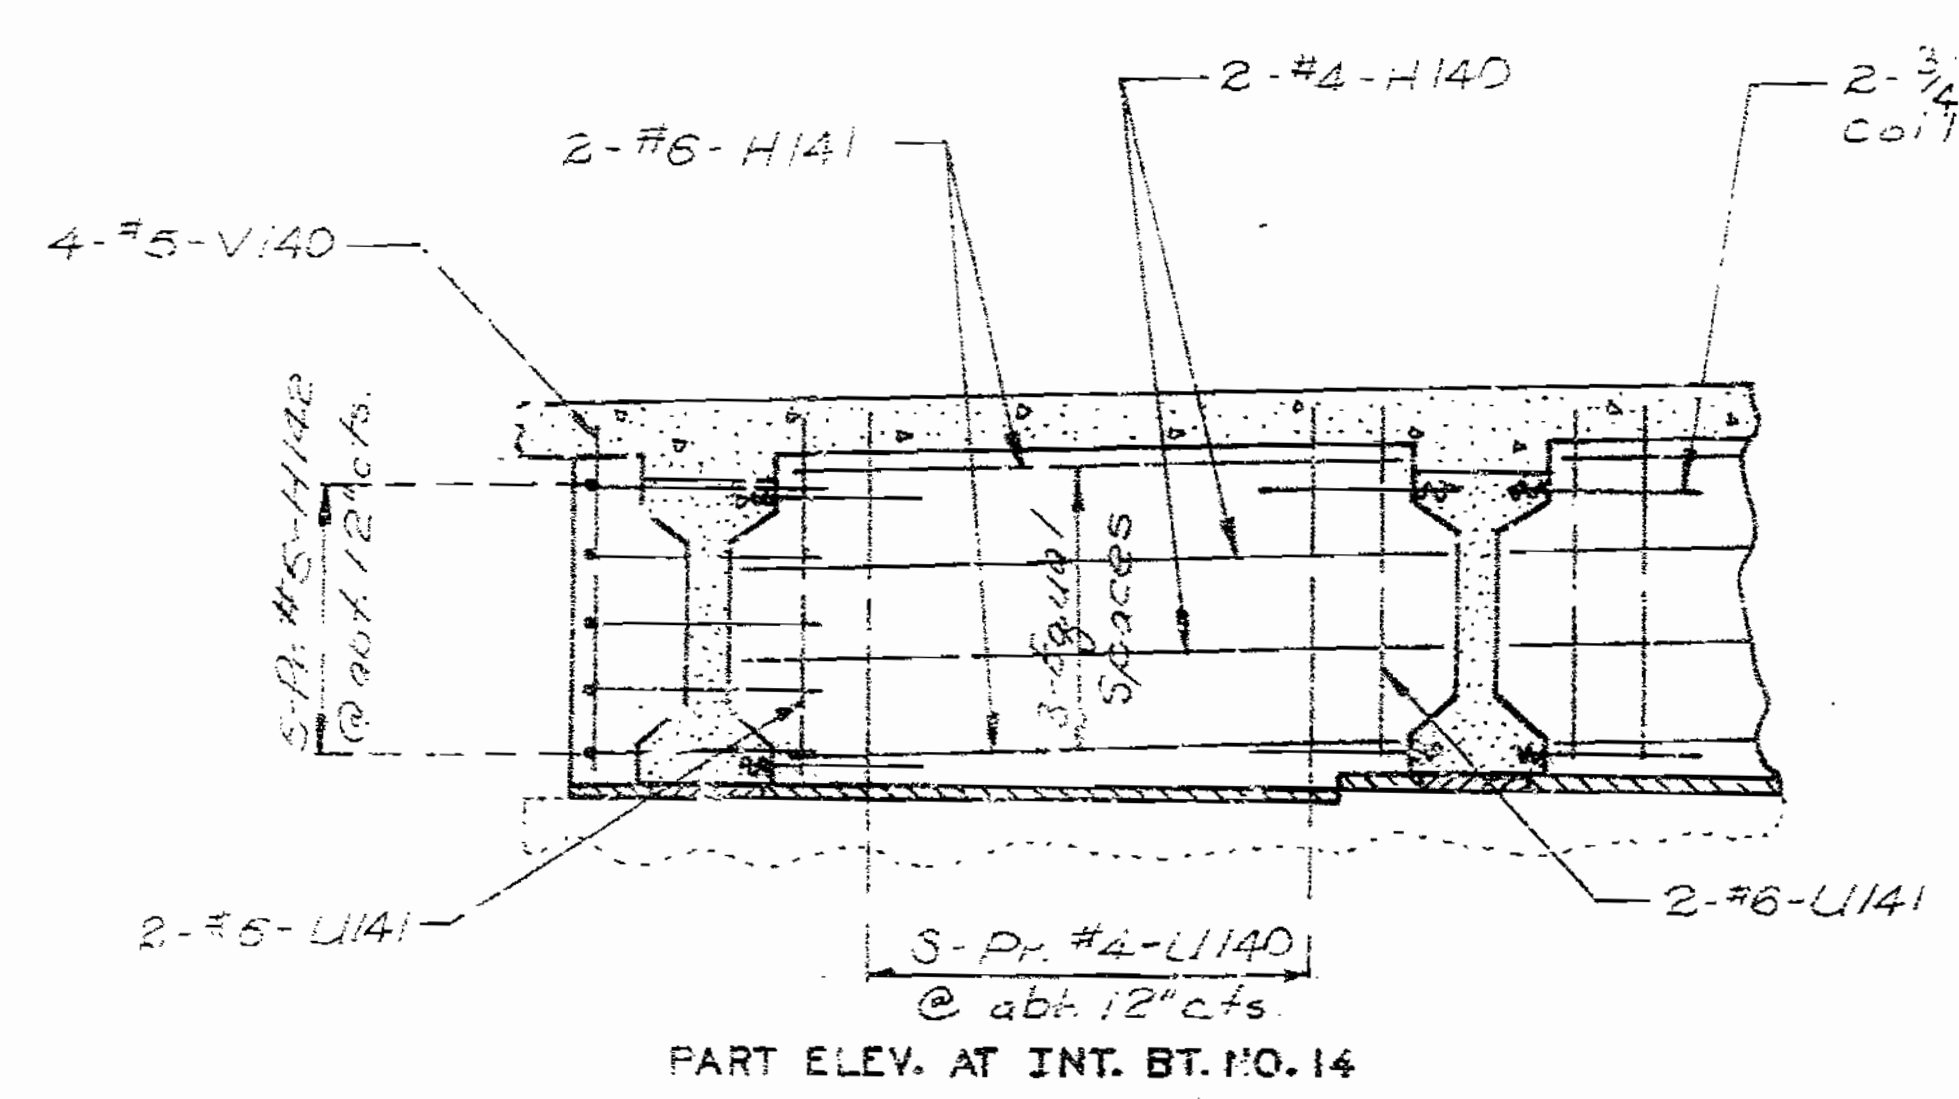

Note: For details of slab reinforcement near Bent No.13, see sheet No.77 & No.78.

DETAILS OF INTERMEDIATE BENT DIAPHRAGMS

DETAILED Sept. 1966  
CHECKED Feb. 1969

Note: This drawing is not to scale. Follow dimensions.







Sheet No. 66 of 98

JACKSON COUNTY

A-2745

15862

STATE	PROJ. NO.	SHEET NO.
MO		155

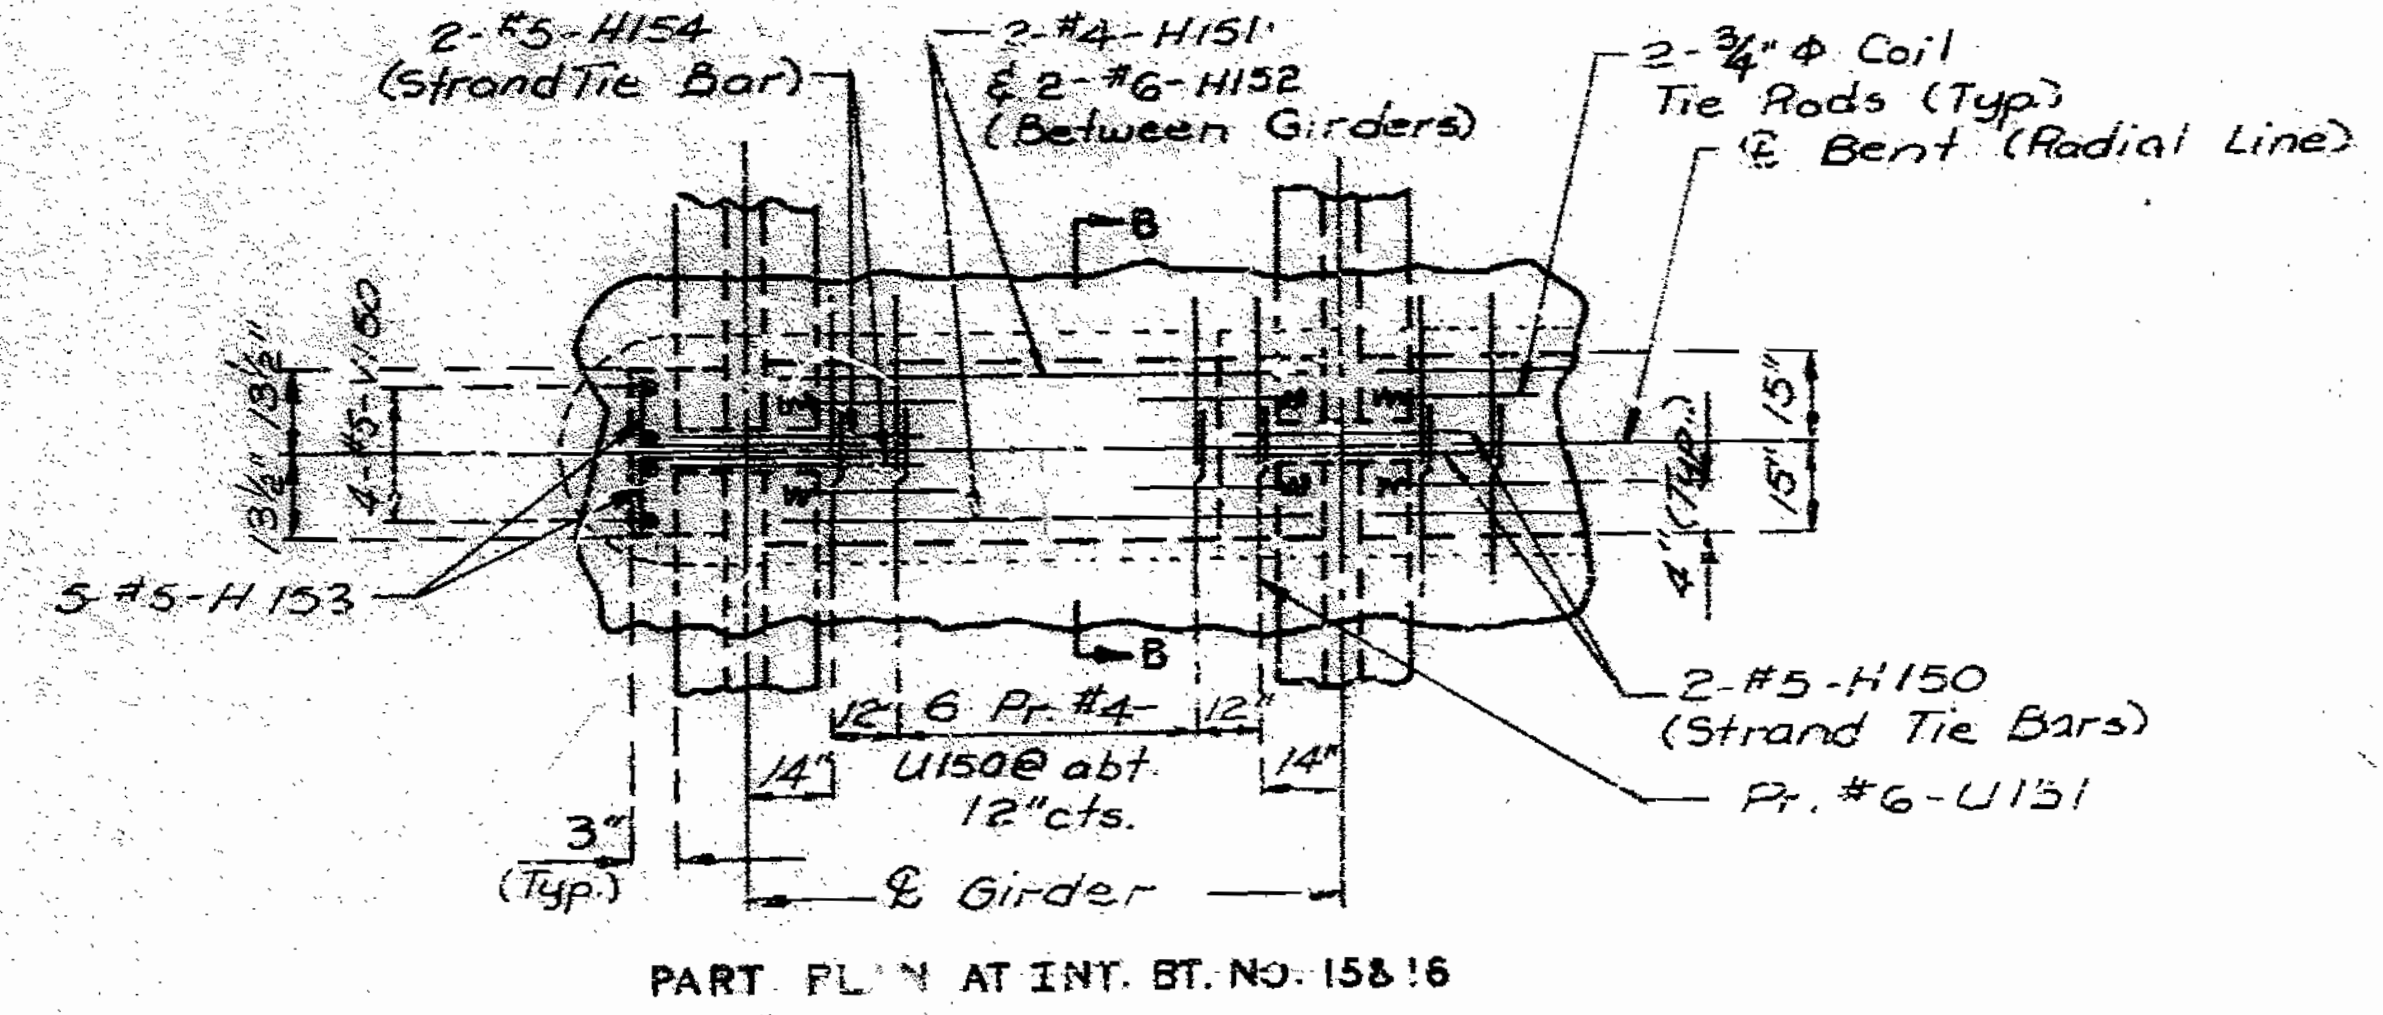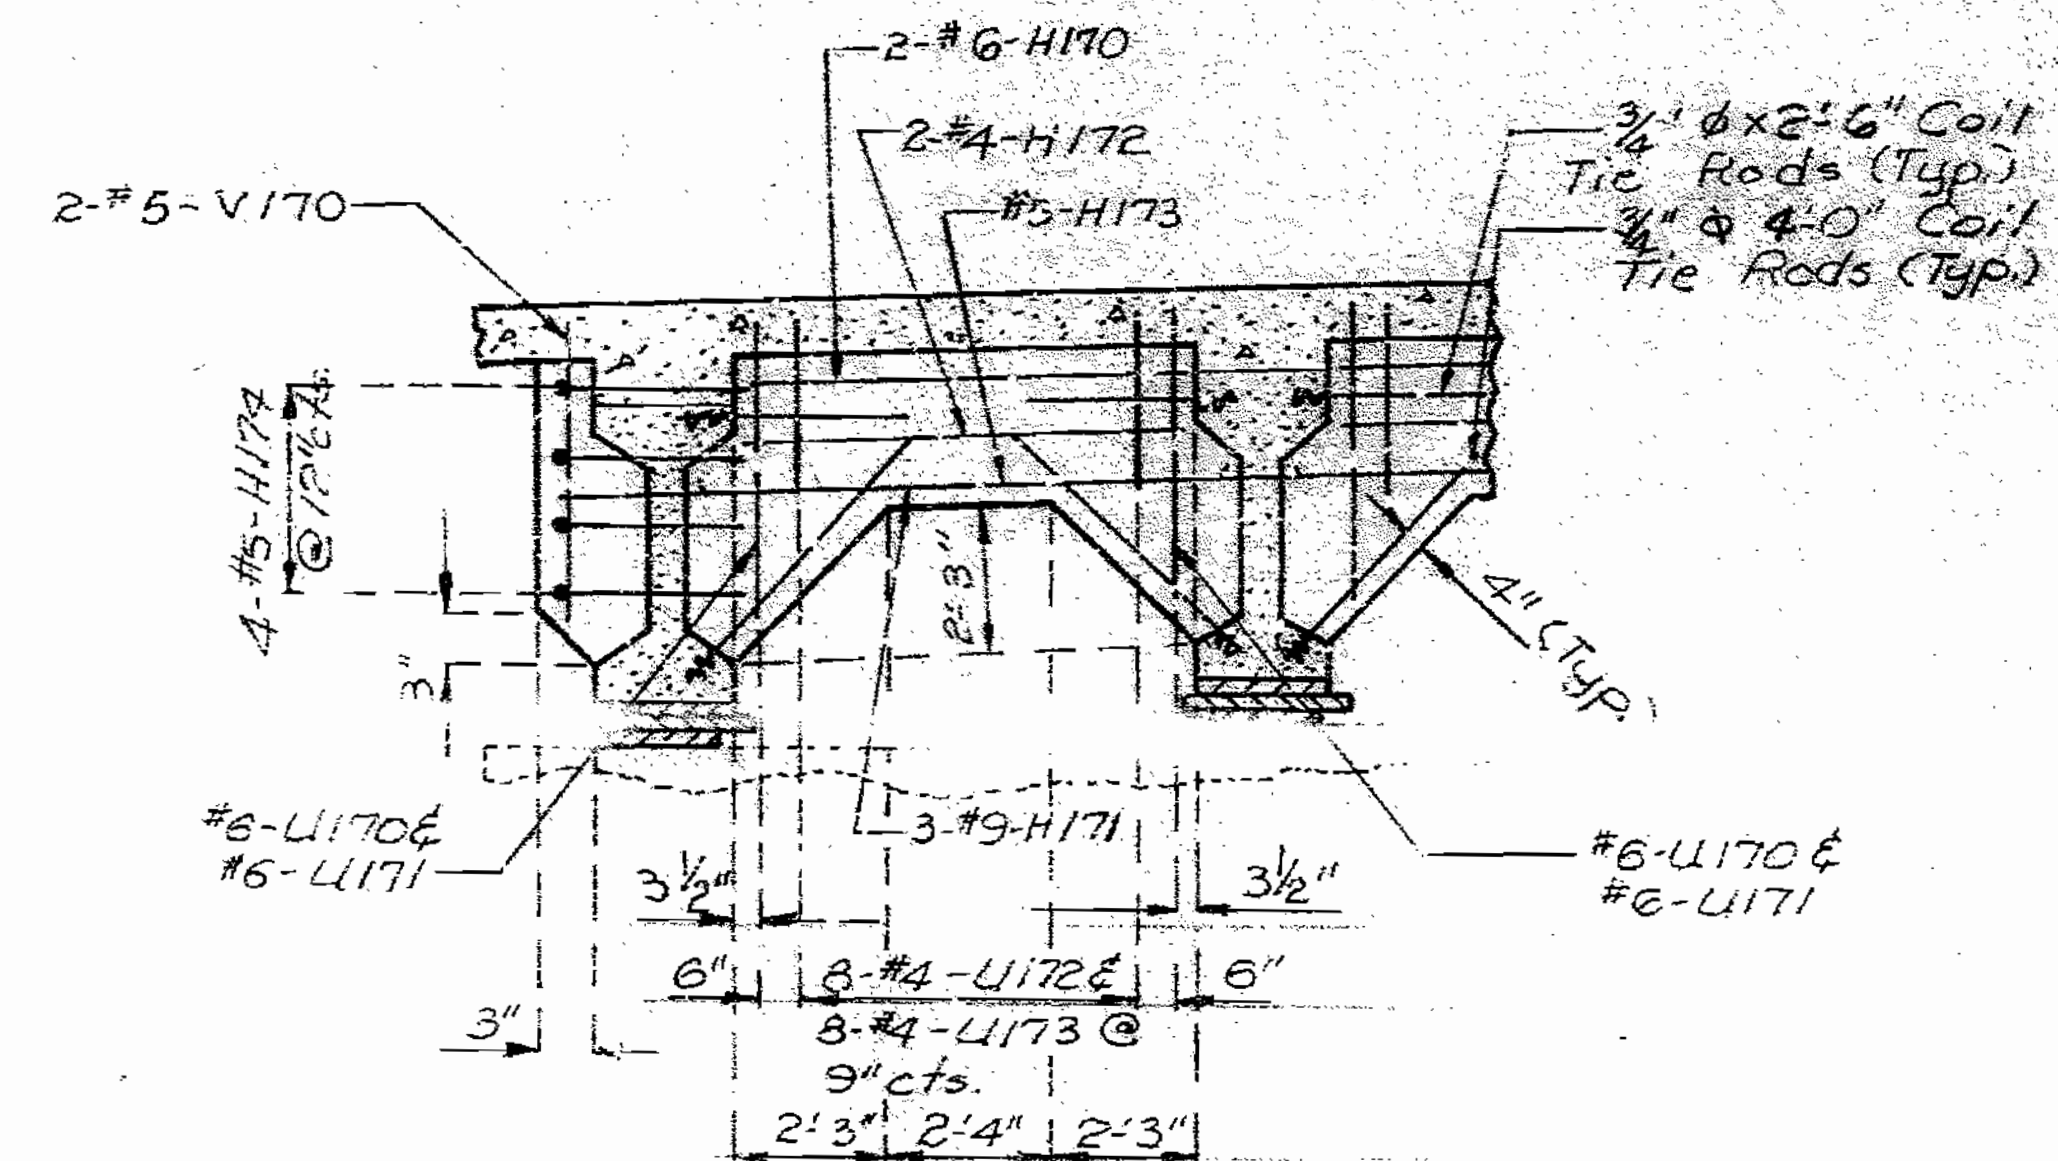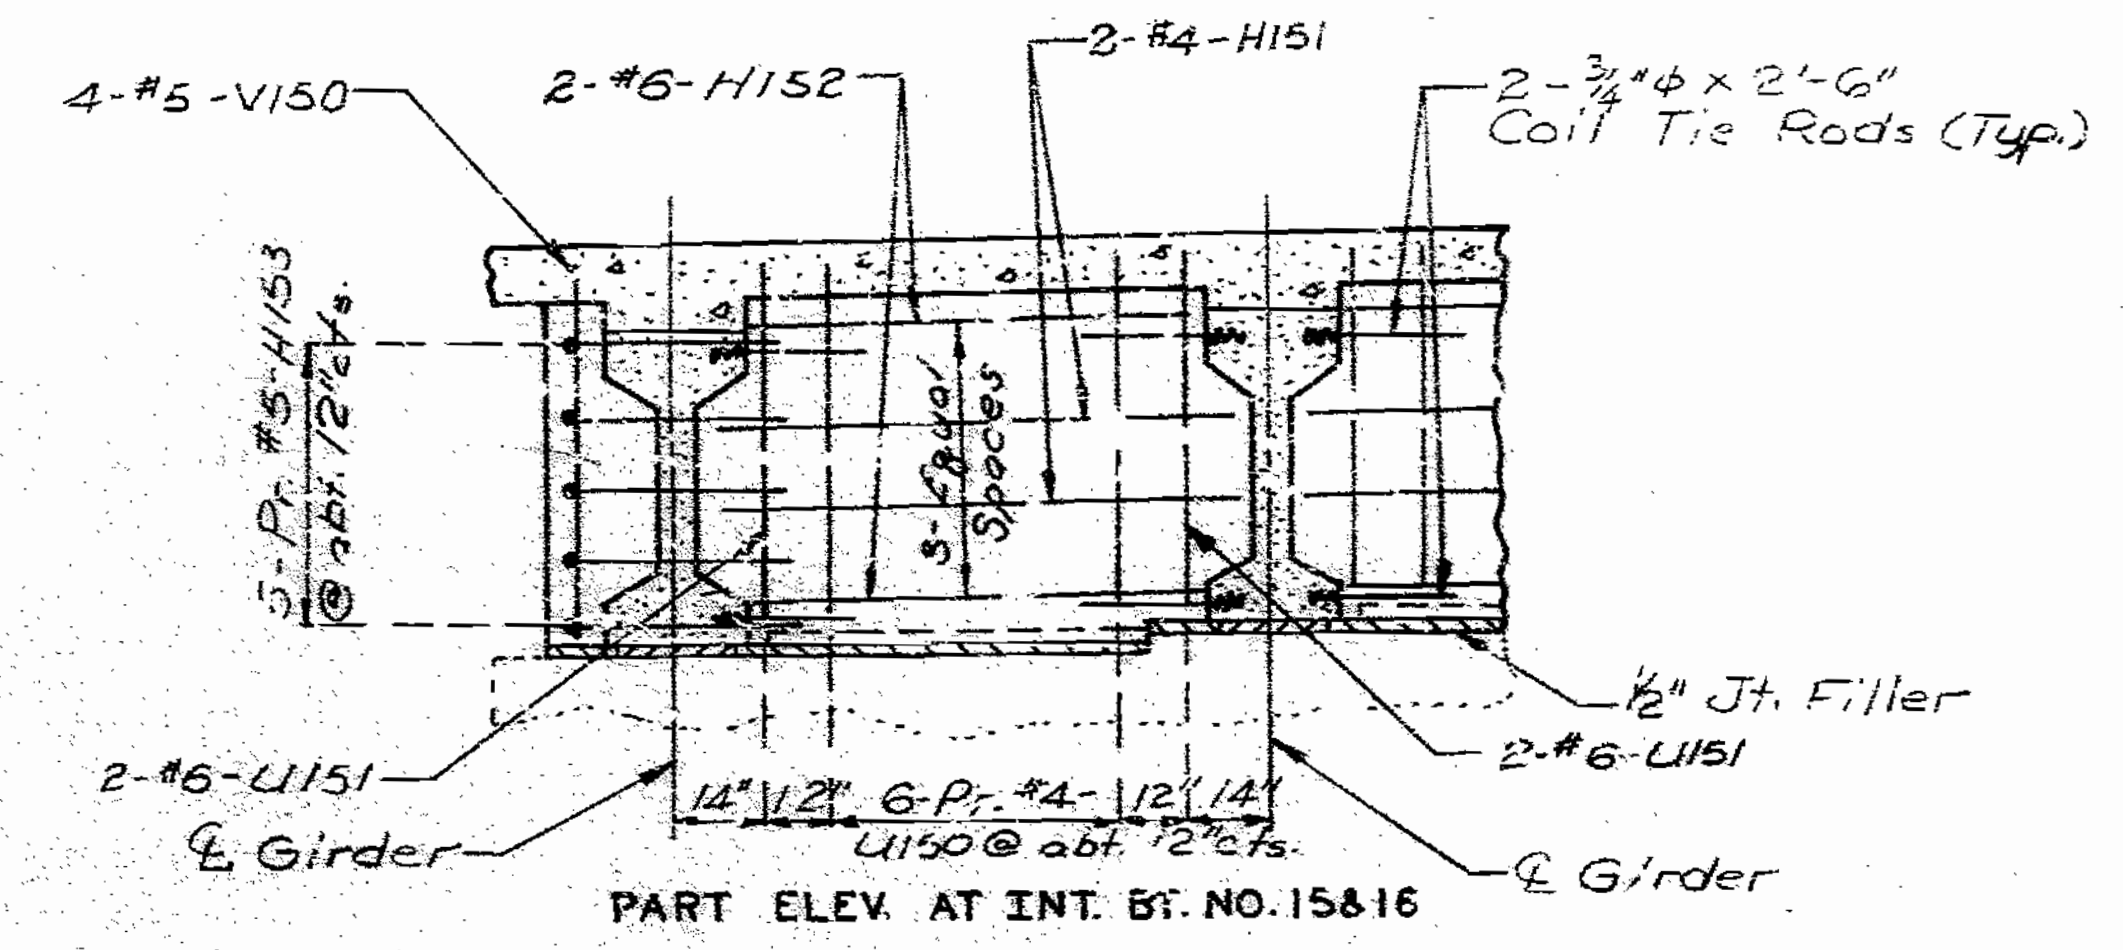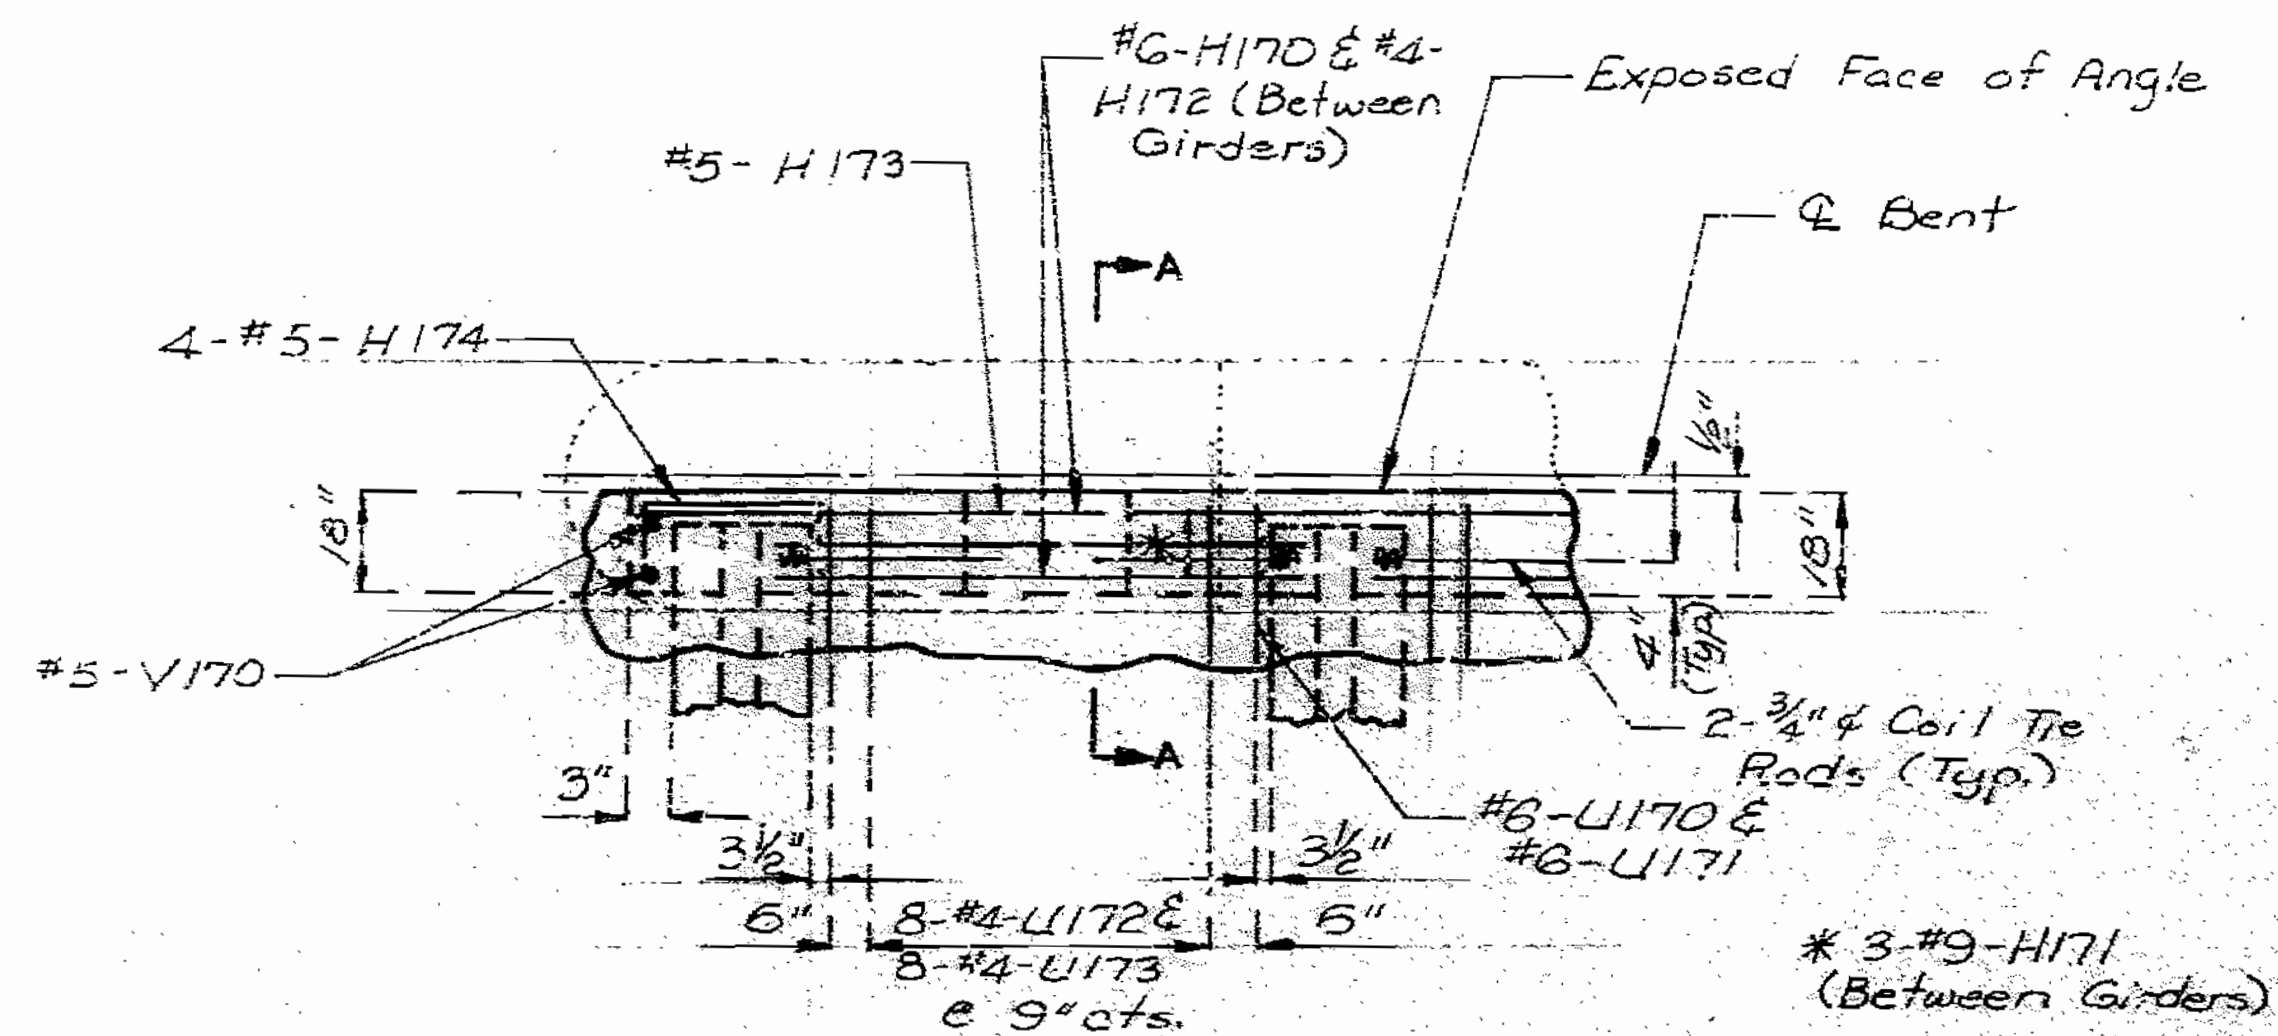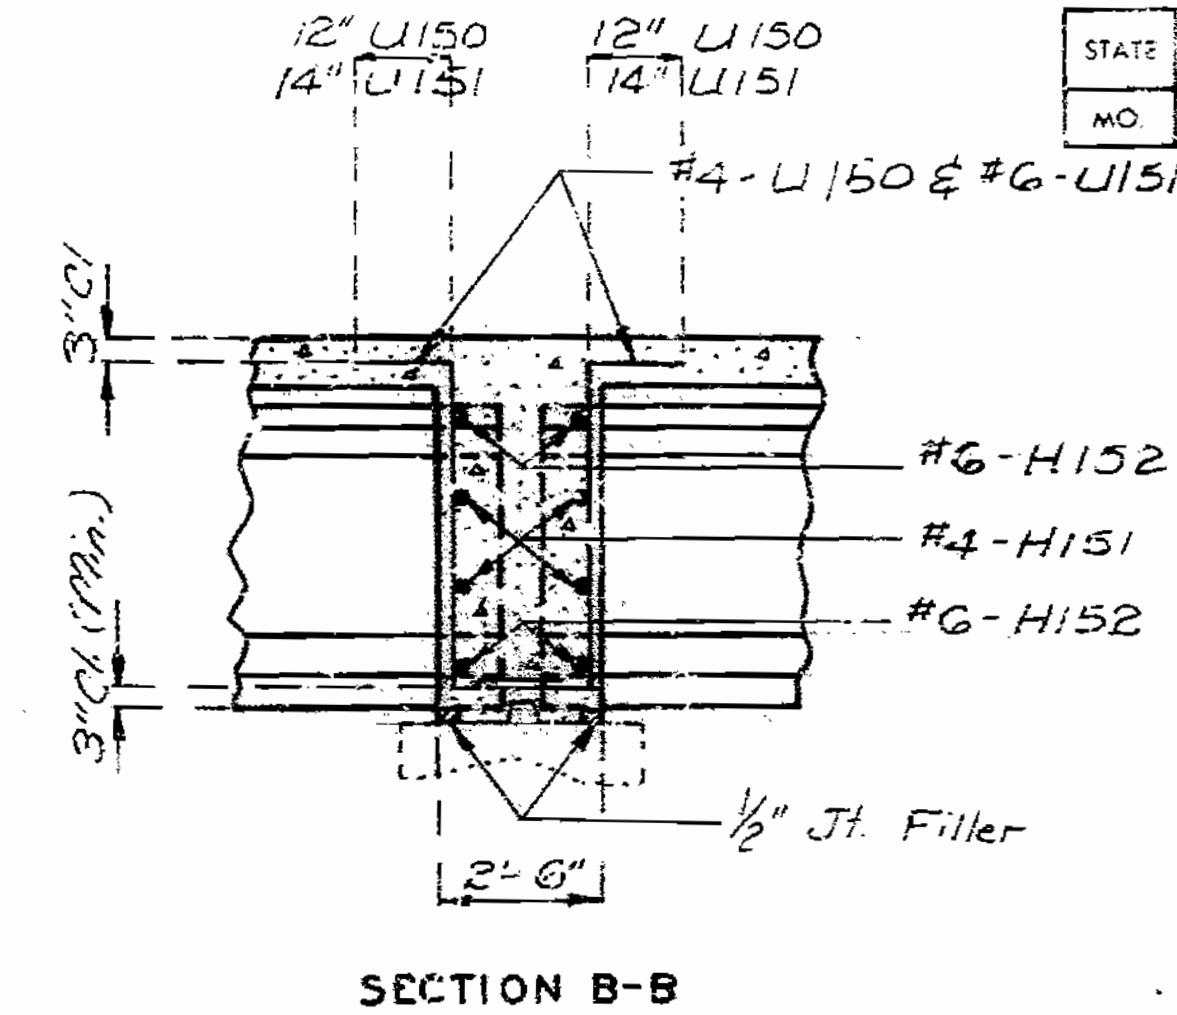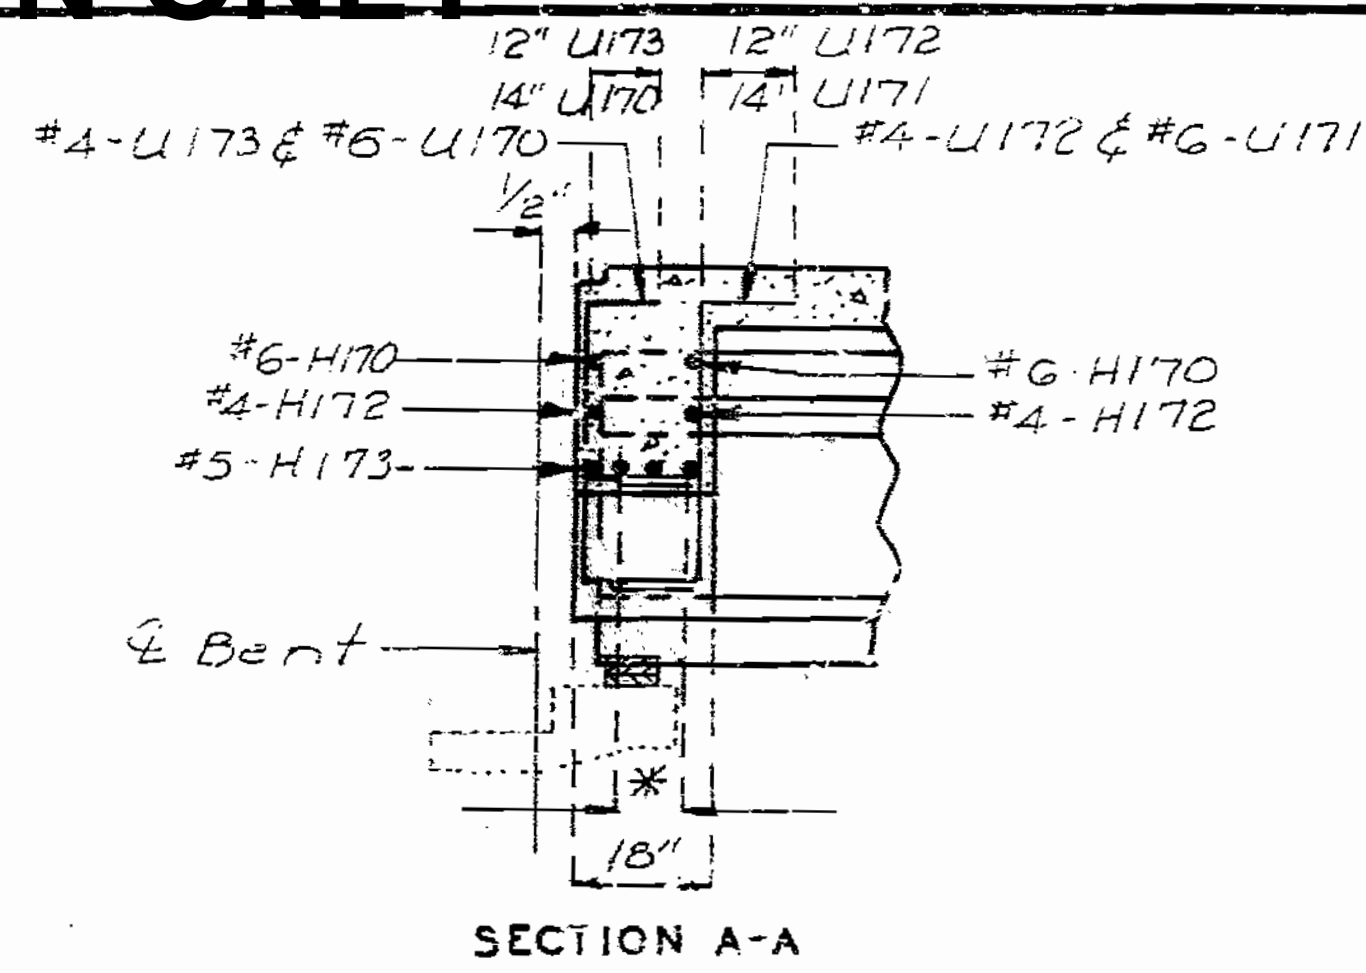

DETAILS OF INTERMEDIATE BENT DIAPHRAGMS

DETAILED Sept. 1988  
CHECKED Feb. 1989

Note: This drawing is not to scale. Follow dimensions





Sheet No. 67 of 38

JACKSON COUNTY

A-2745


1582/63

STATE	PROJ. NO.	SHEET NO.
MO.		148

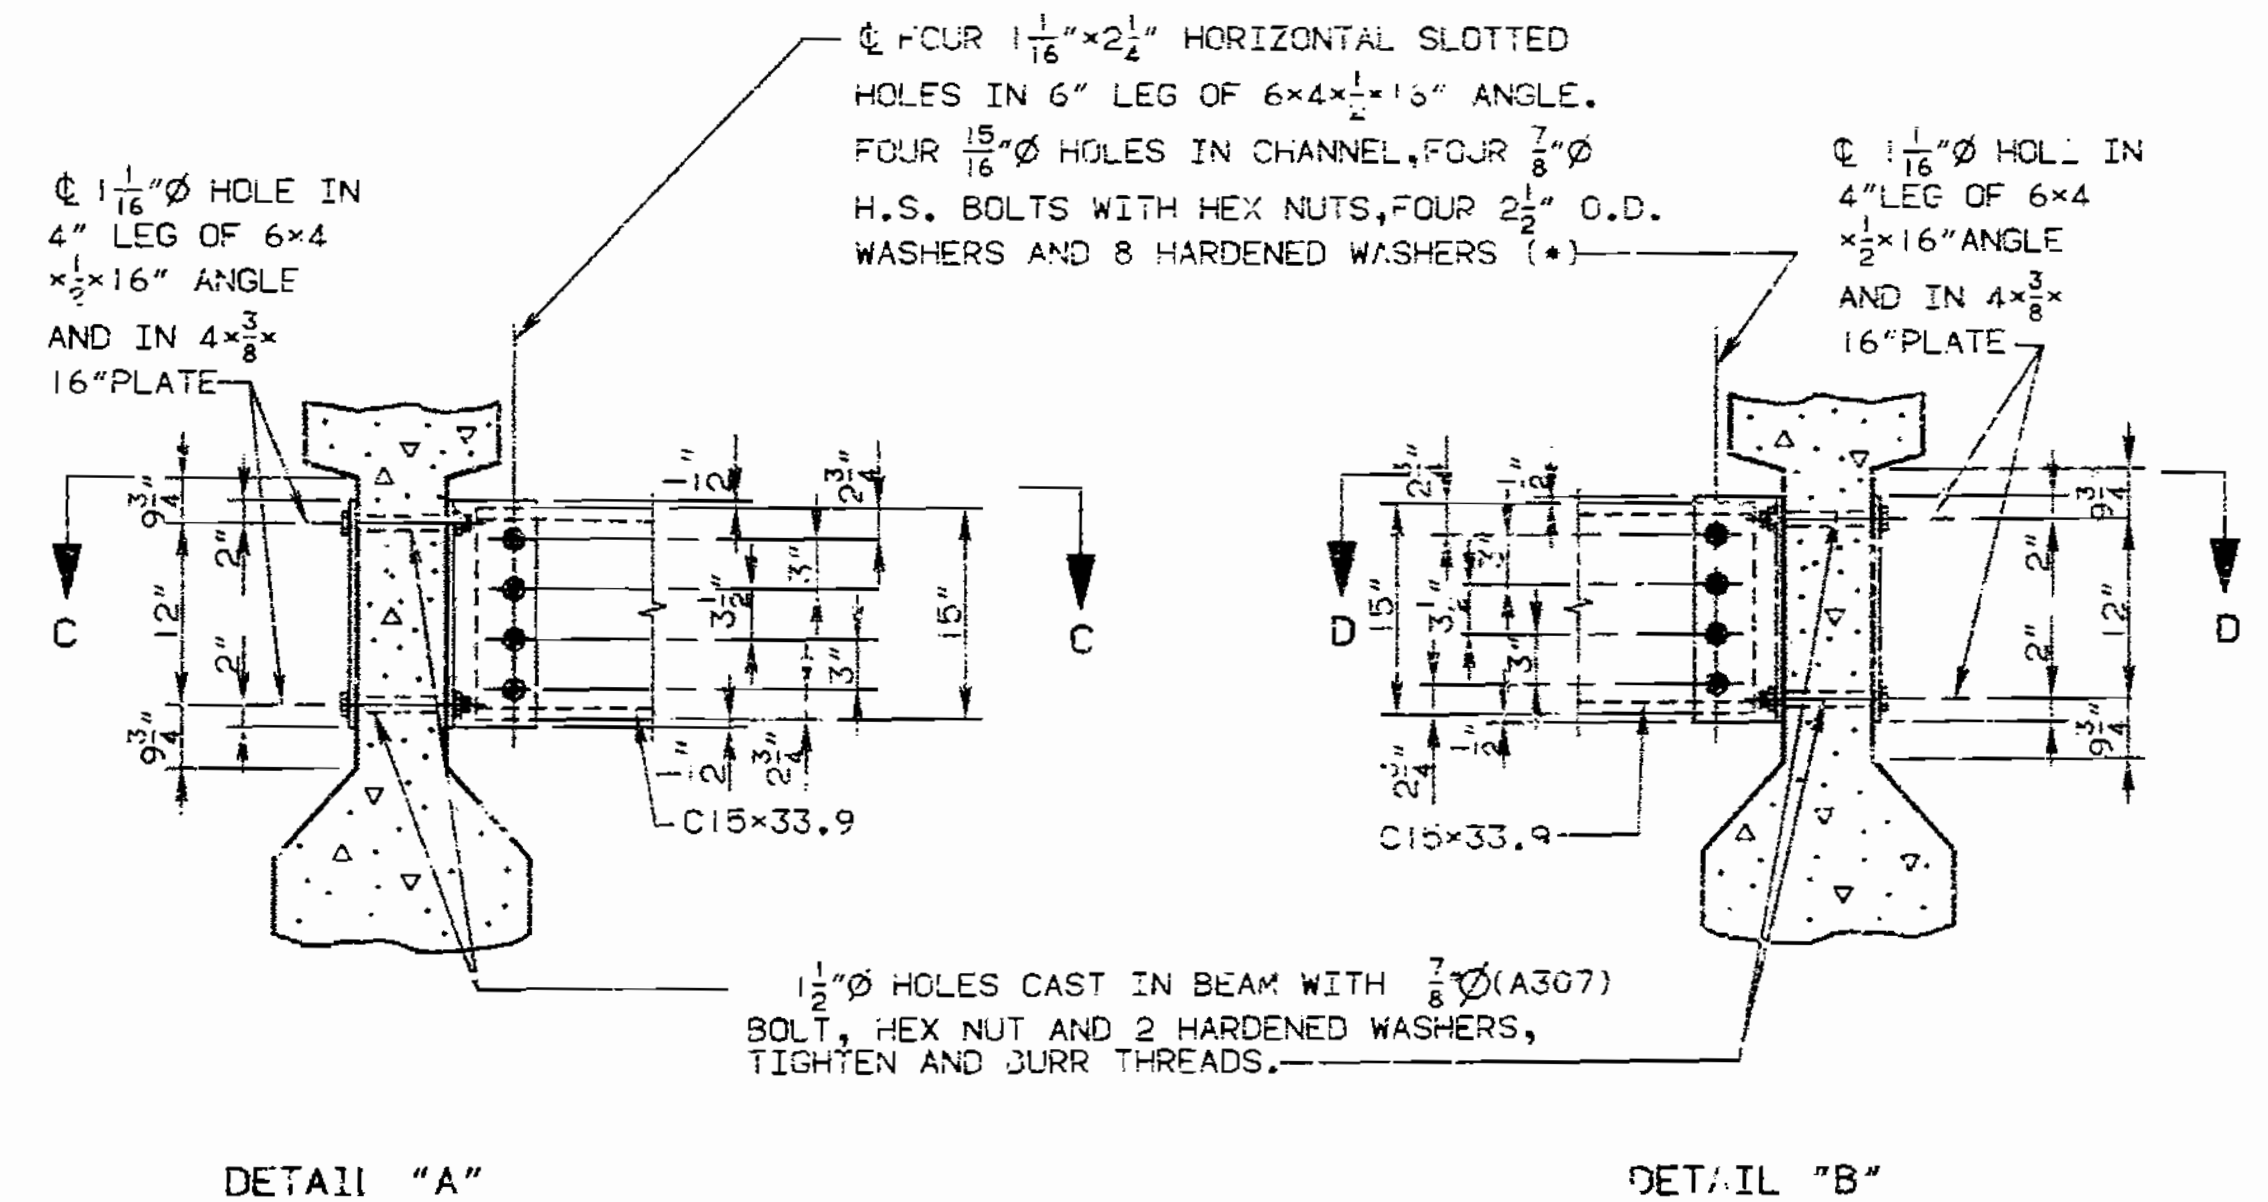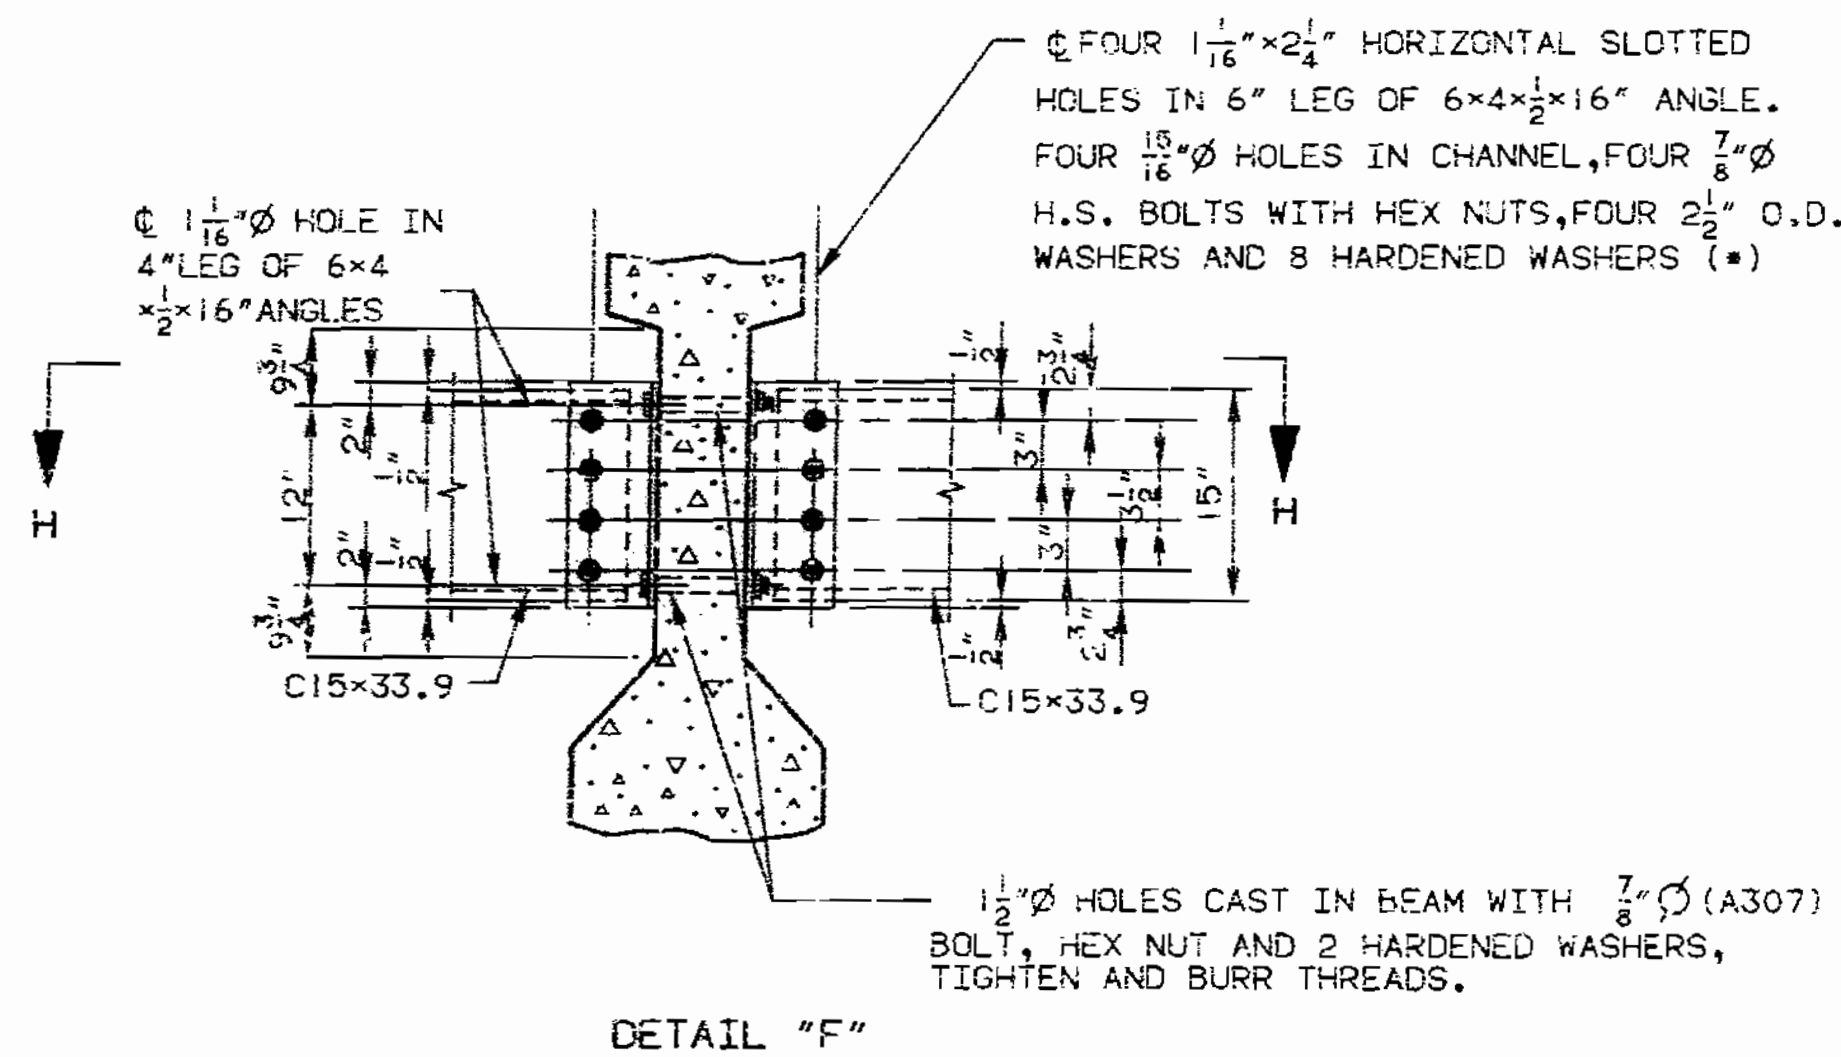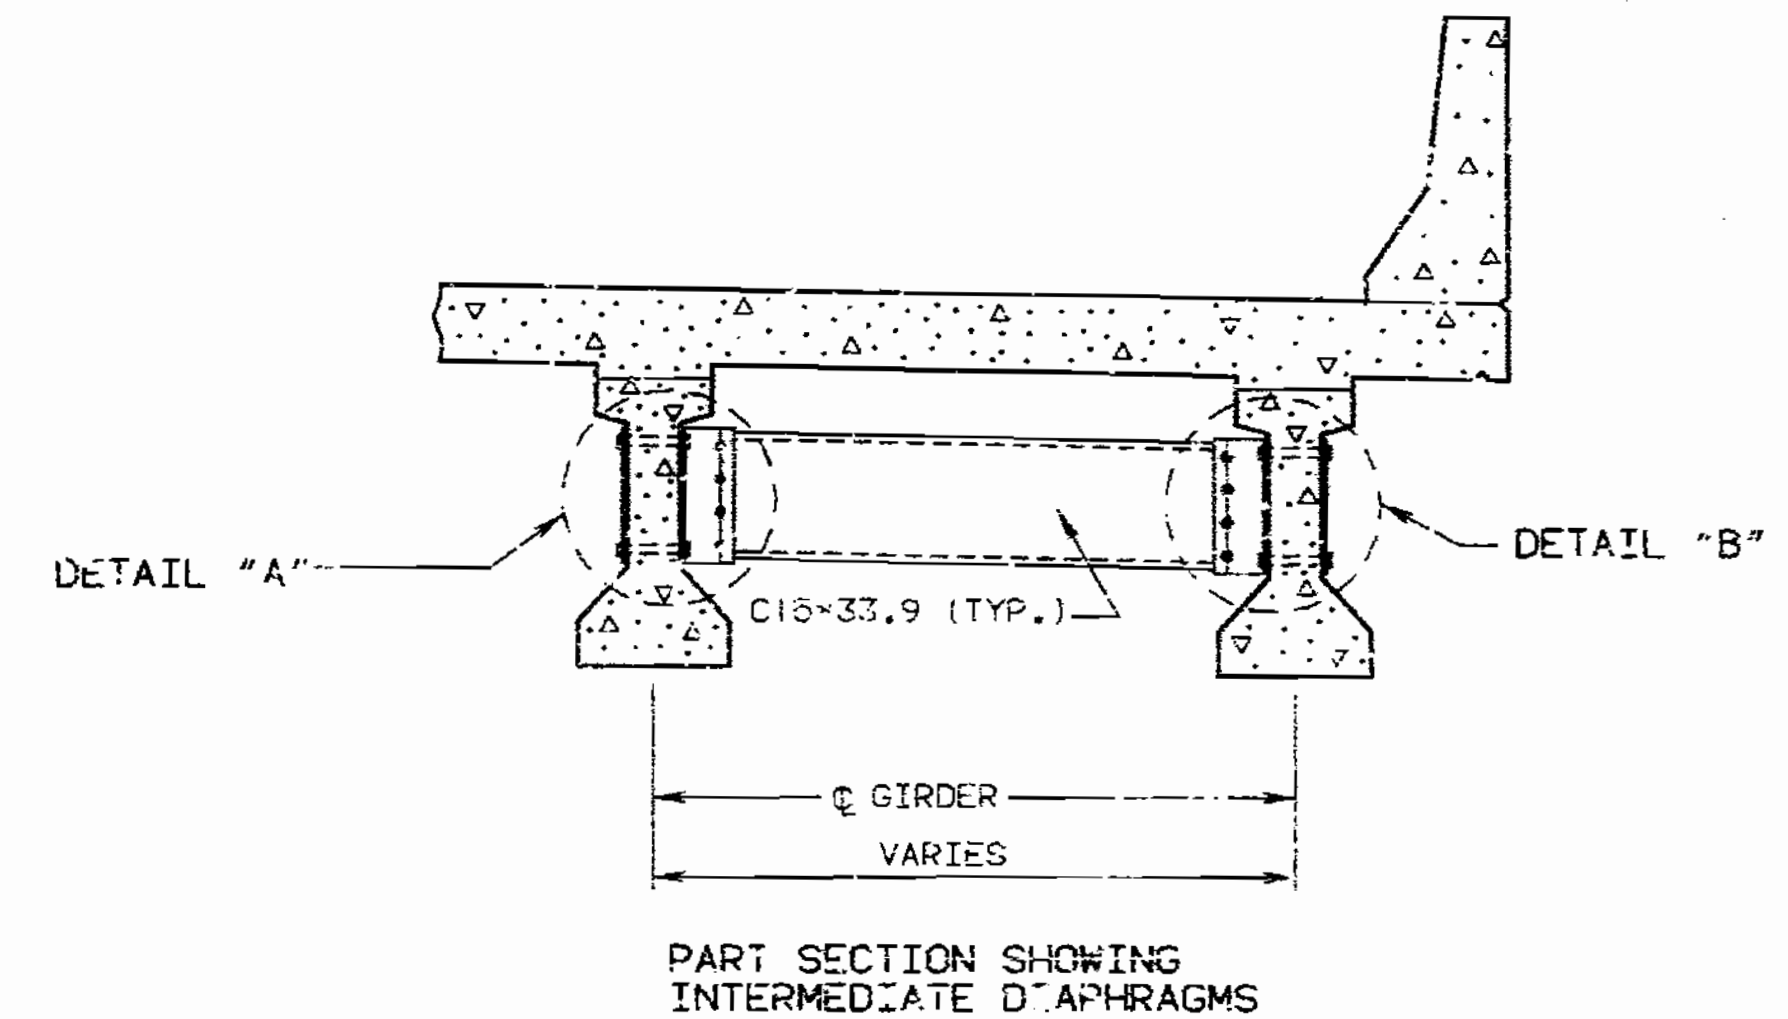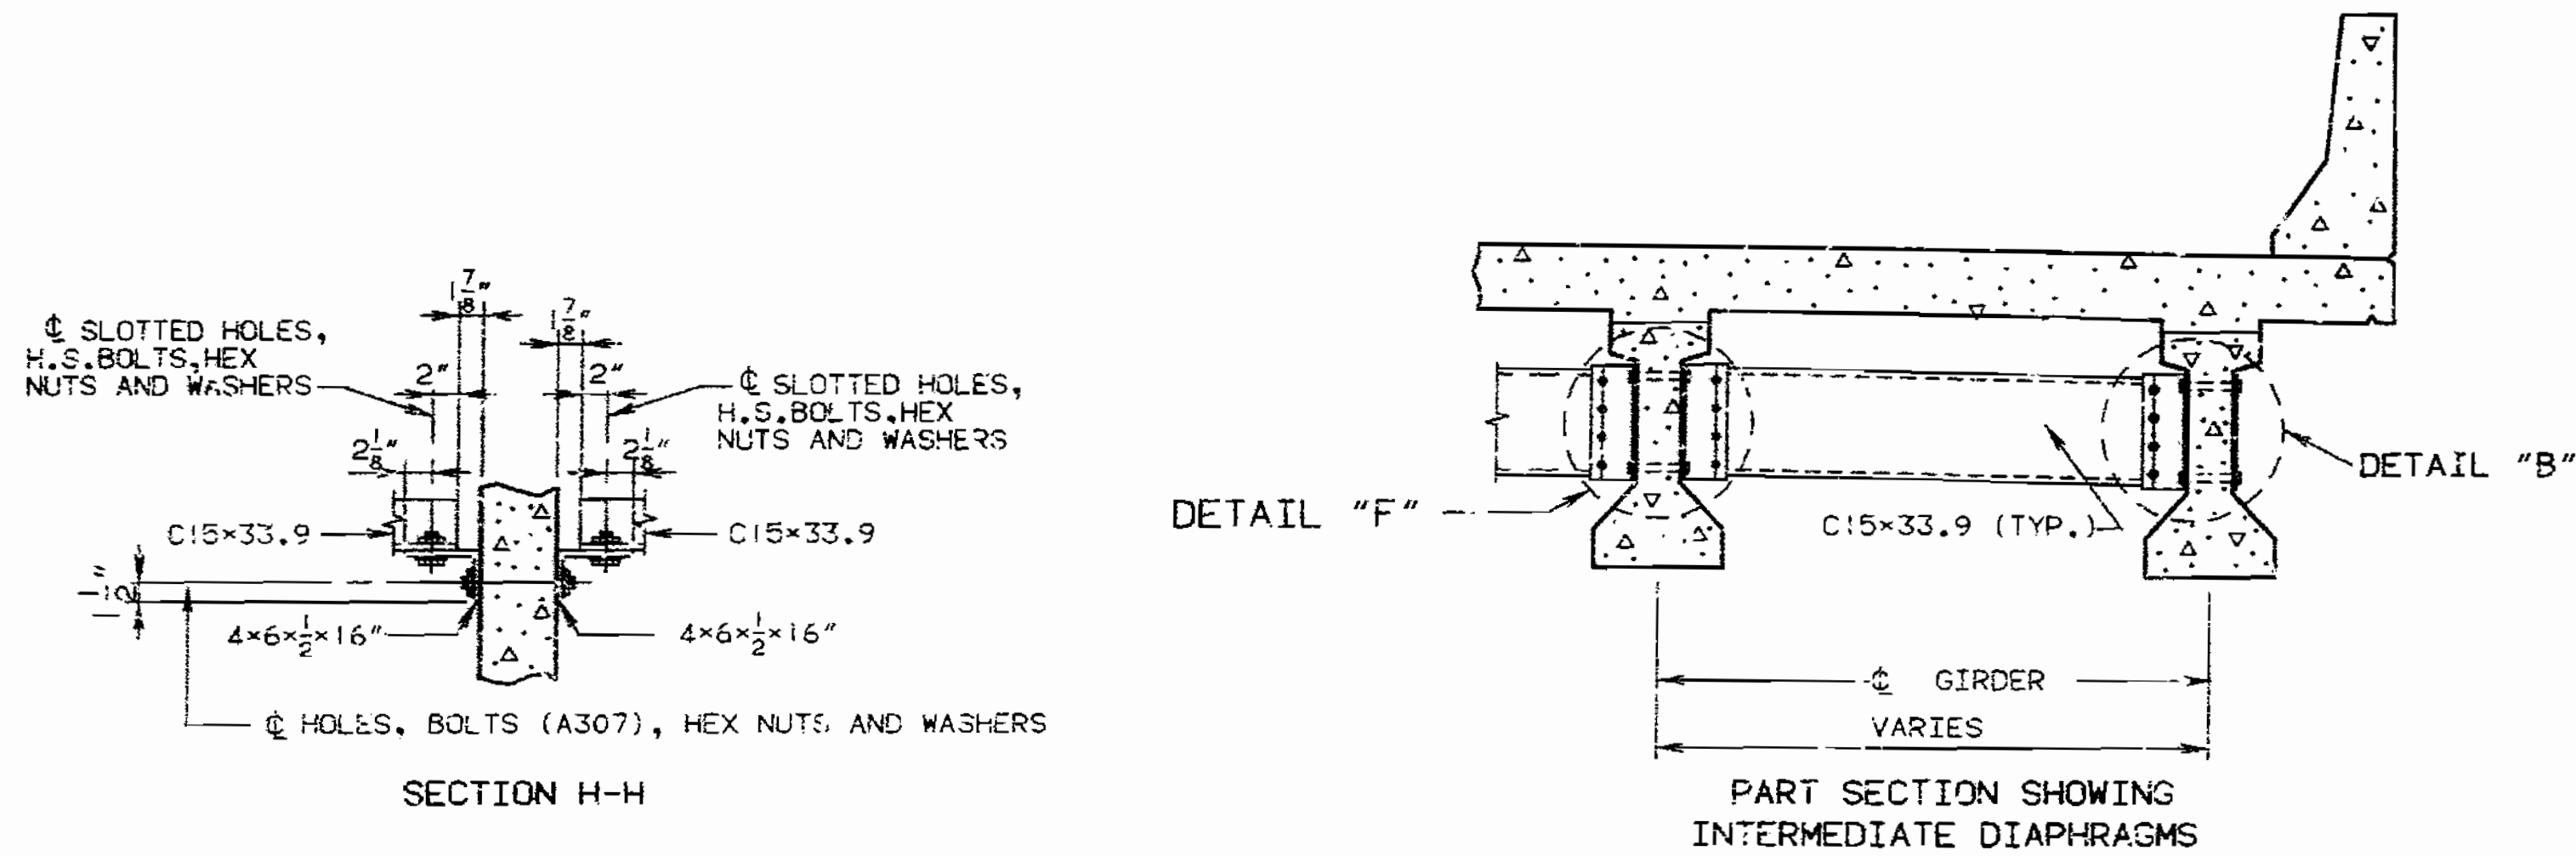

STEEL DIAPHRAGM NOTES:

- (\*) IN LIEU OF 2 1/2" O.D. WASHERS, CONTRACTOR MAY SUBSTITUTE A 3/16" (MIN. THICKNESS) PLATE WITH FOUR 15/16" HOLES AND 1 HARDENED WASHER PER BOLT.
- ALL H.S. BOLTS MAY BE TENSIONED / TURN-OF-NUT-METHOD.
- ALL DIAPHRAGMS MATERIALS INCLUDING BOLTS, NUTS AND WASHERS SHALL BE GALVANIZED.
- FABRICATED STRUCTURAL STEEL SHALL BE A36 EXCEPT AS NOTED.
- PAYMENT FOR FURNISHING AND INSTALLING STEEL INTERMEDIATE DIAPHRAGMS SHALL BE INCLUDED IN CONTRACT UNIT PRICE FOR PRESTRESSED CONCRETE I-GIRDERS.
- SHOP DRAWINGS WILL BE REQUIRED FOR STEEL INTERMEDIATE DIAPHRAGMS AND ANGLE CONNECTIONS.

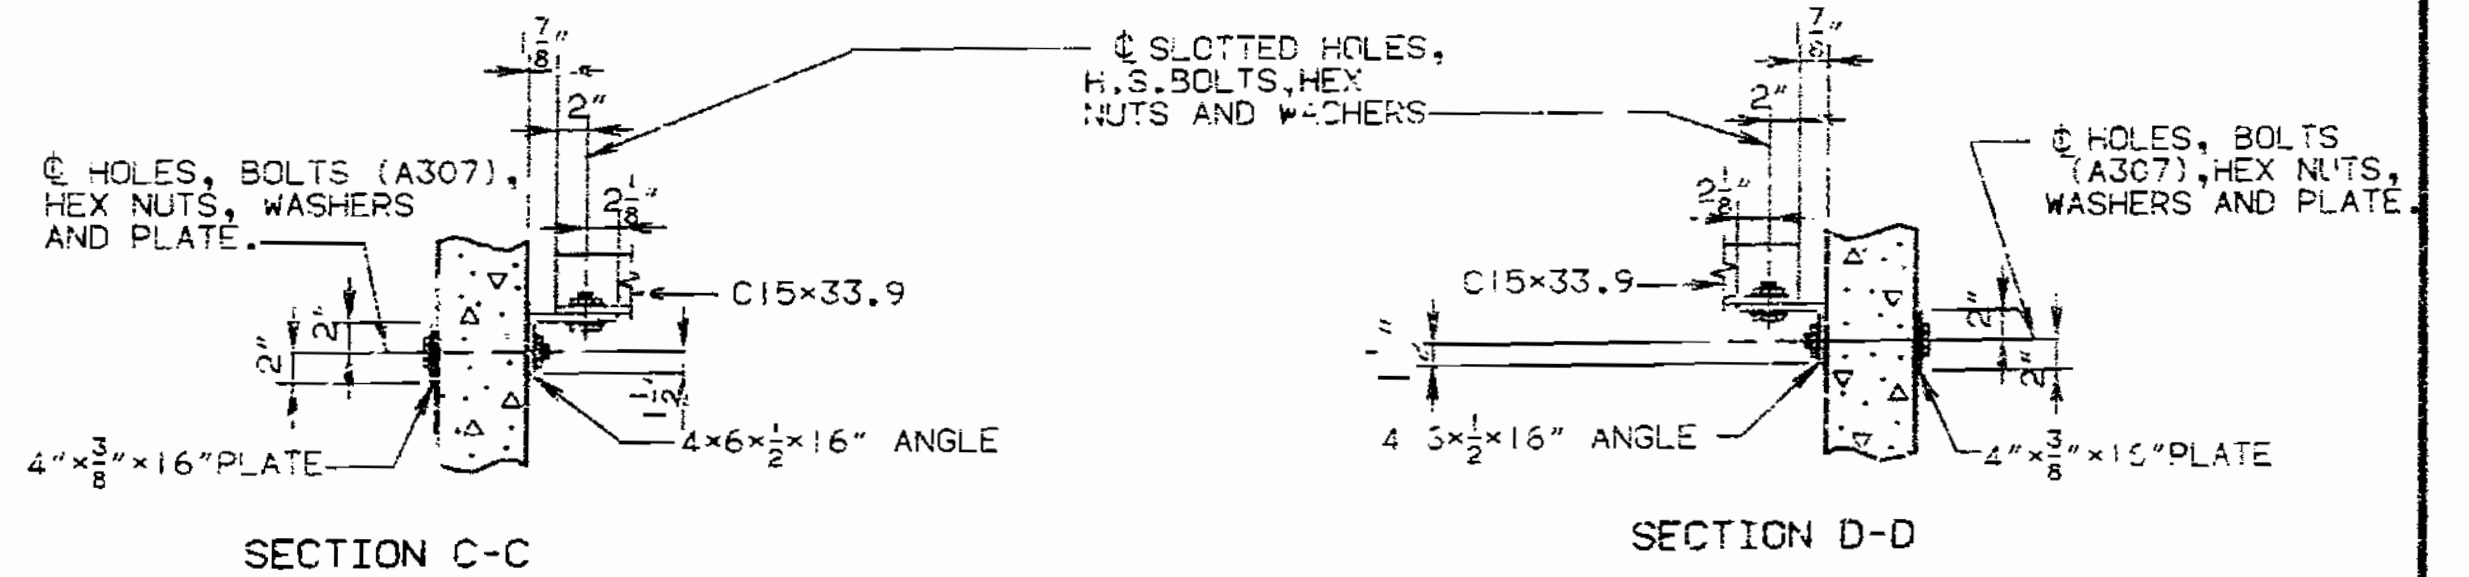

DETAILED JULY 1988  
CHECKED FEB 1989

NOTE: THIS DRAWING IS NOT TO SCALE. FOLLOW DIMENSIONS.

SHEET NO. 68 OF 93.

JACKSON

COUNTY


A-2745

1988/69





STATE	PROJ. NO.	SHEET NO.
MO		150

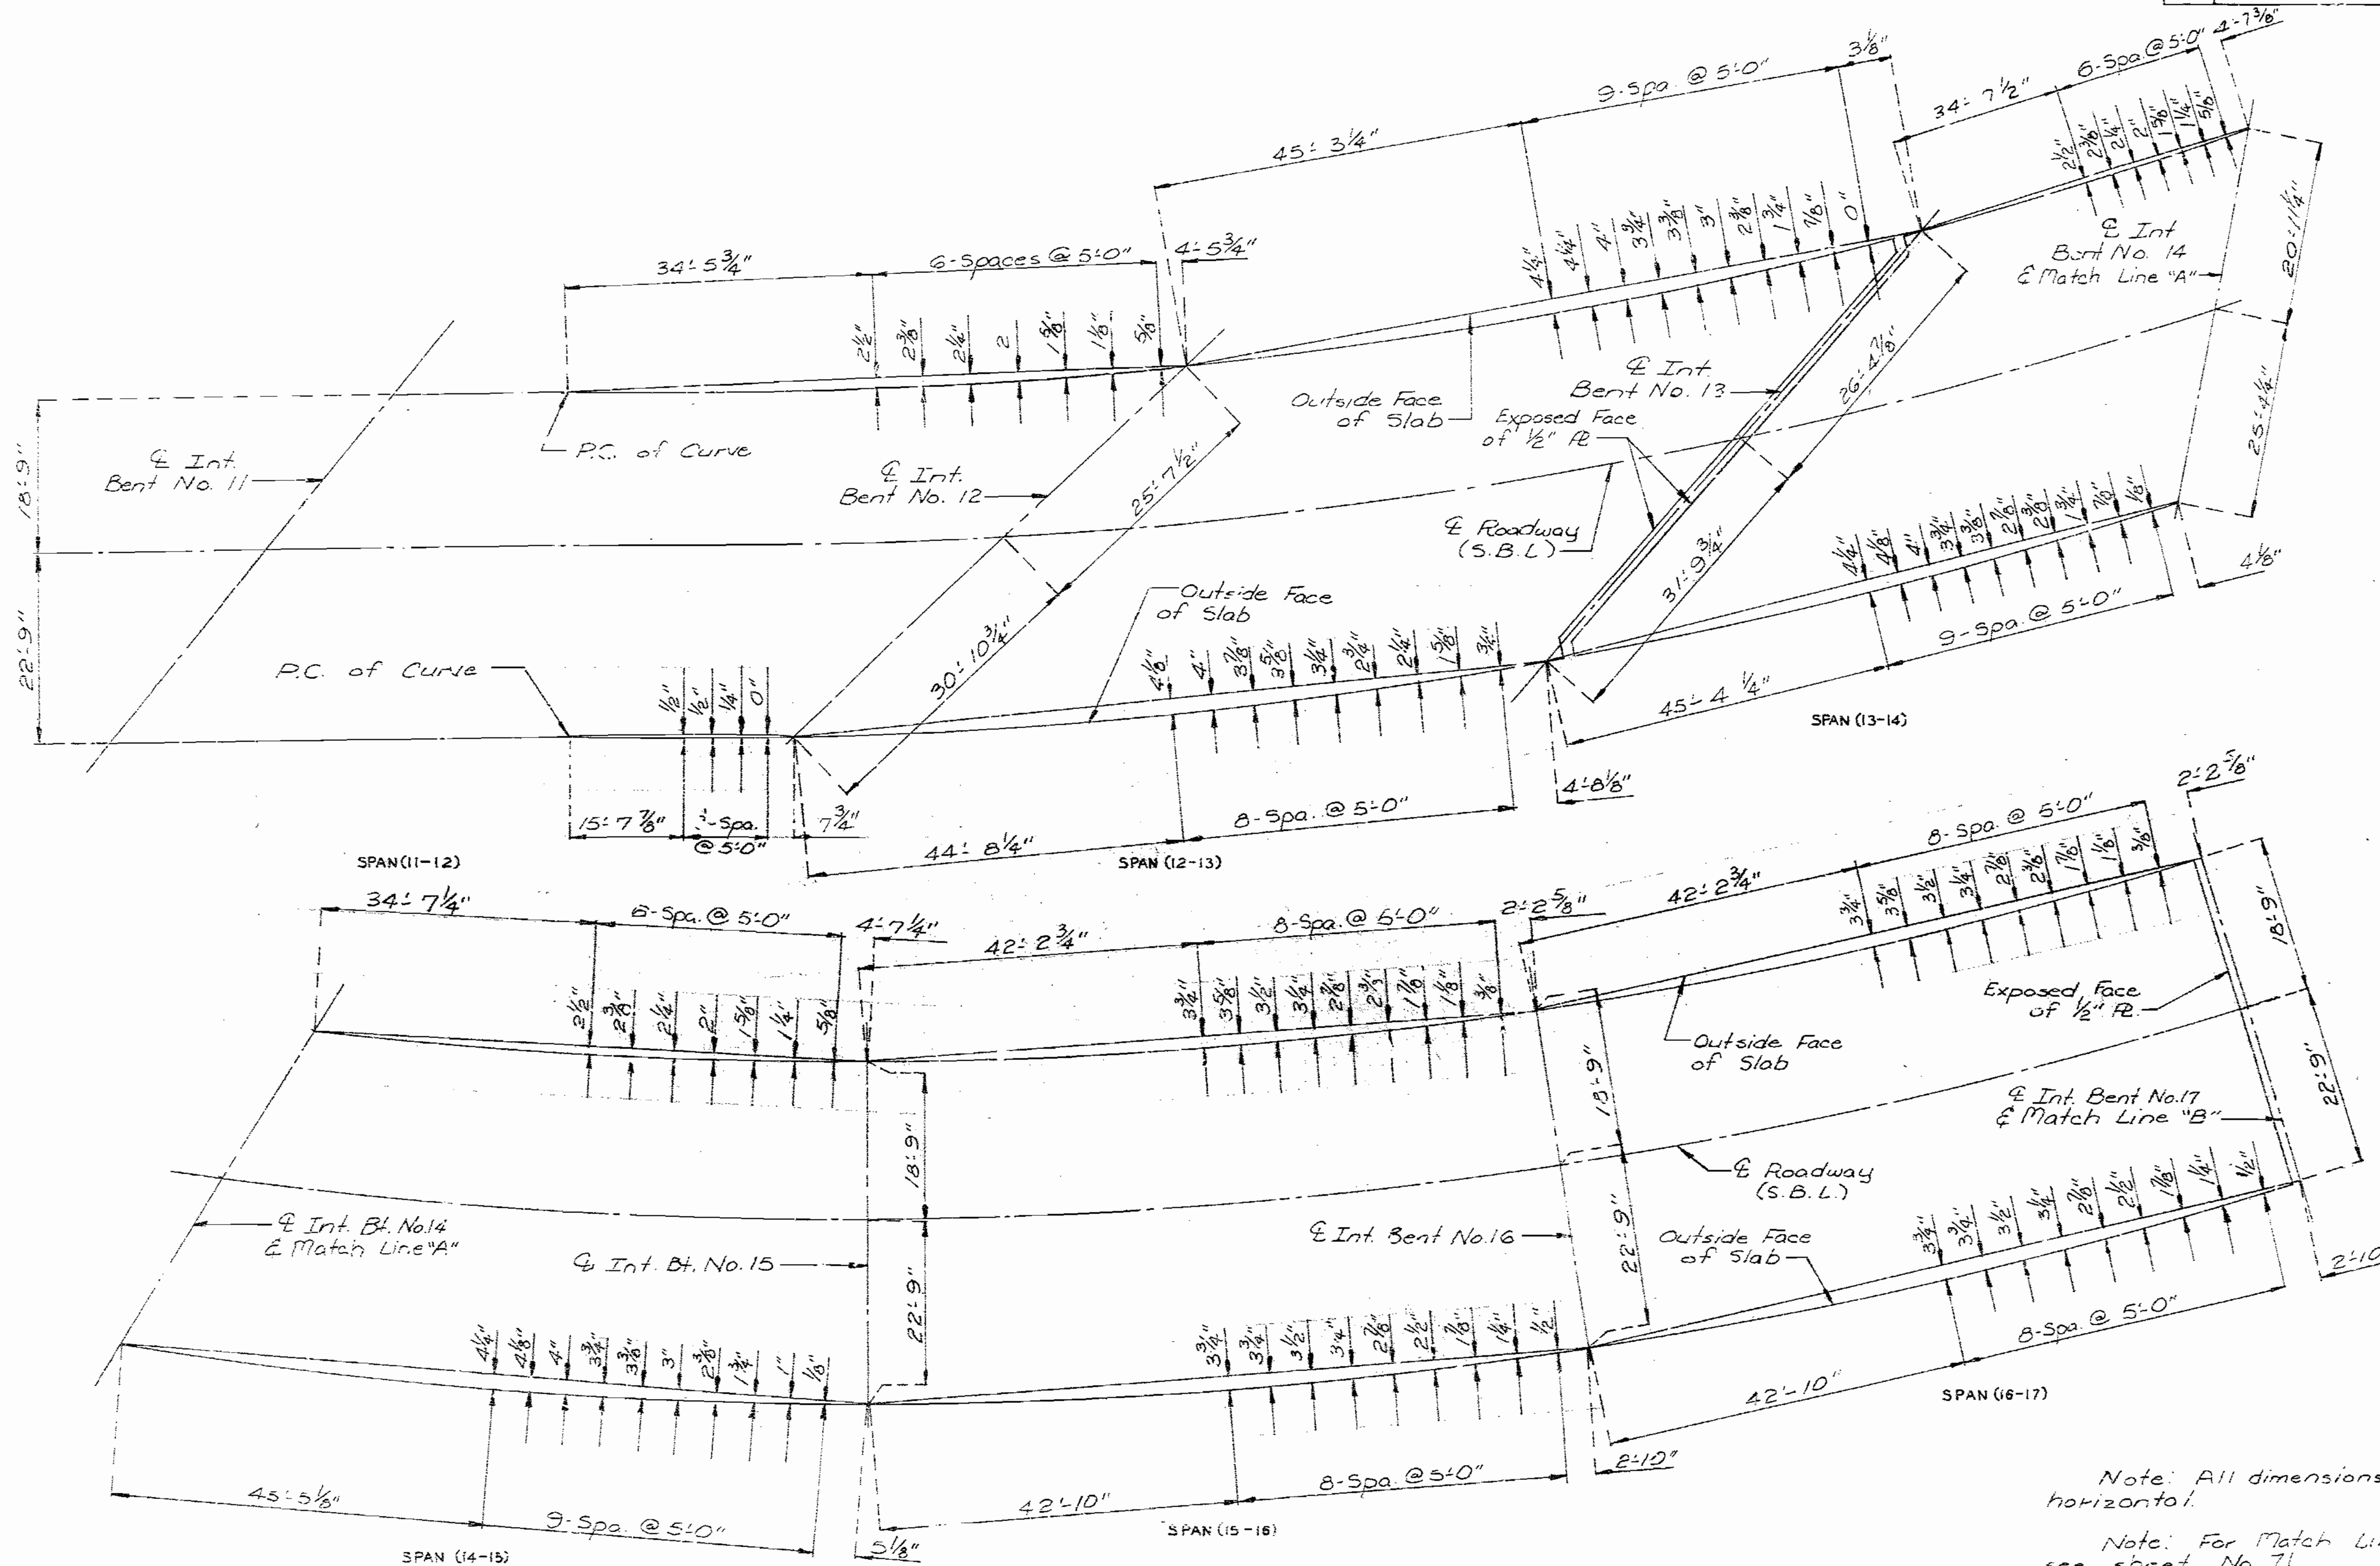

797/66

Note: All dimensions are horizontal.  
 Note: For Match Line "B" see sheet No. 71.

PART PLAN OF SLAB SHOWING CURVE ORDINATES

DETAILED JULY 1988  
 CHECKED Feb. 1989


Note: This drawing is not to scale. Follow dimensions.

Sheet No. 70 of 98

JACKSON COUNTY

A-2745

STATE	PROJ. NO.	SHEET NO.
MO.		151

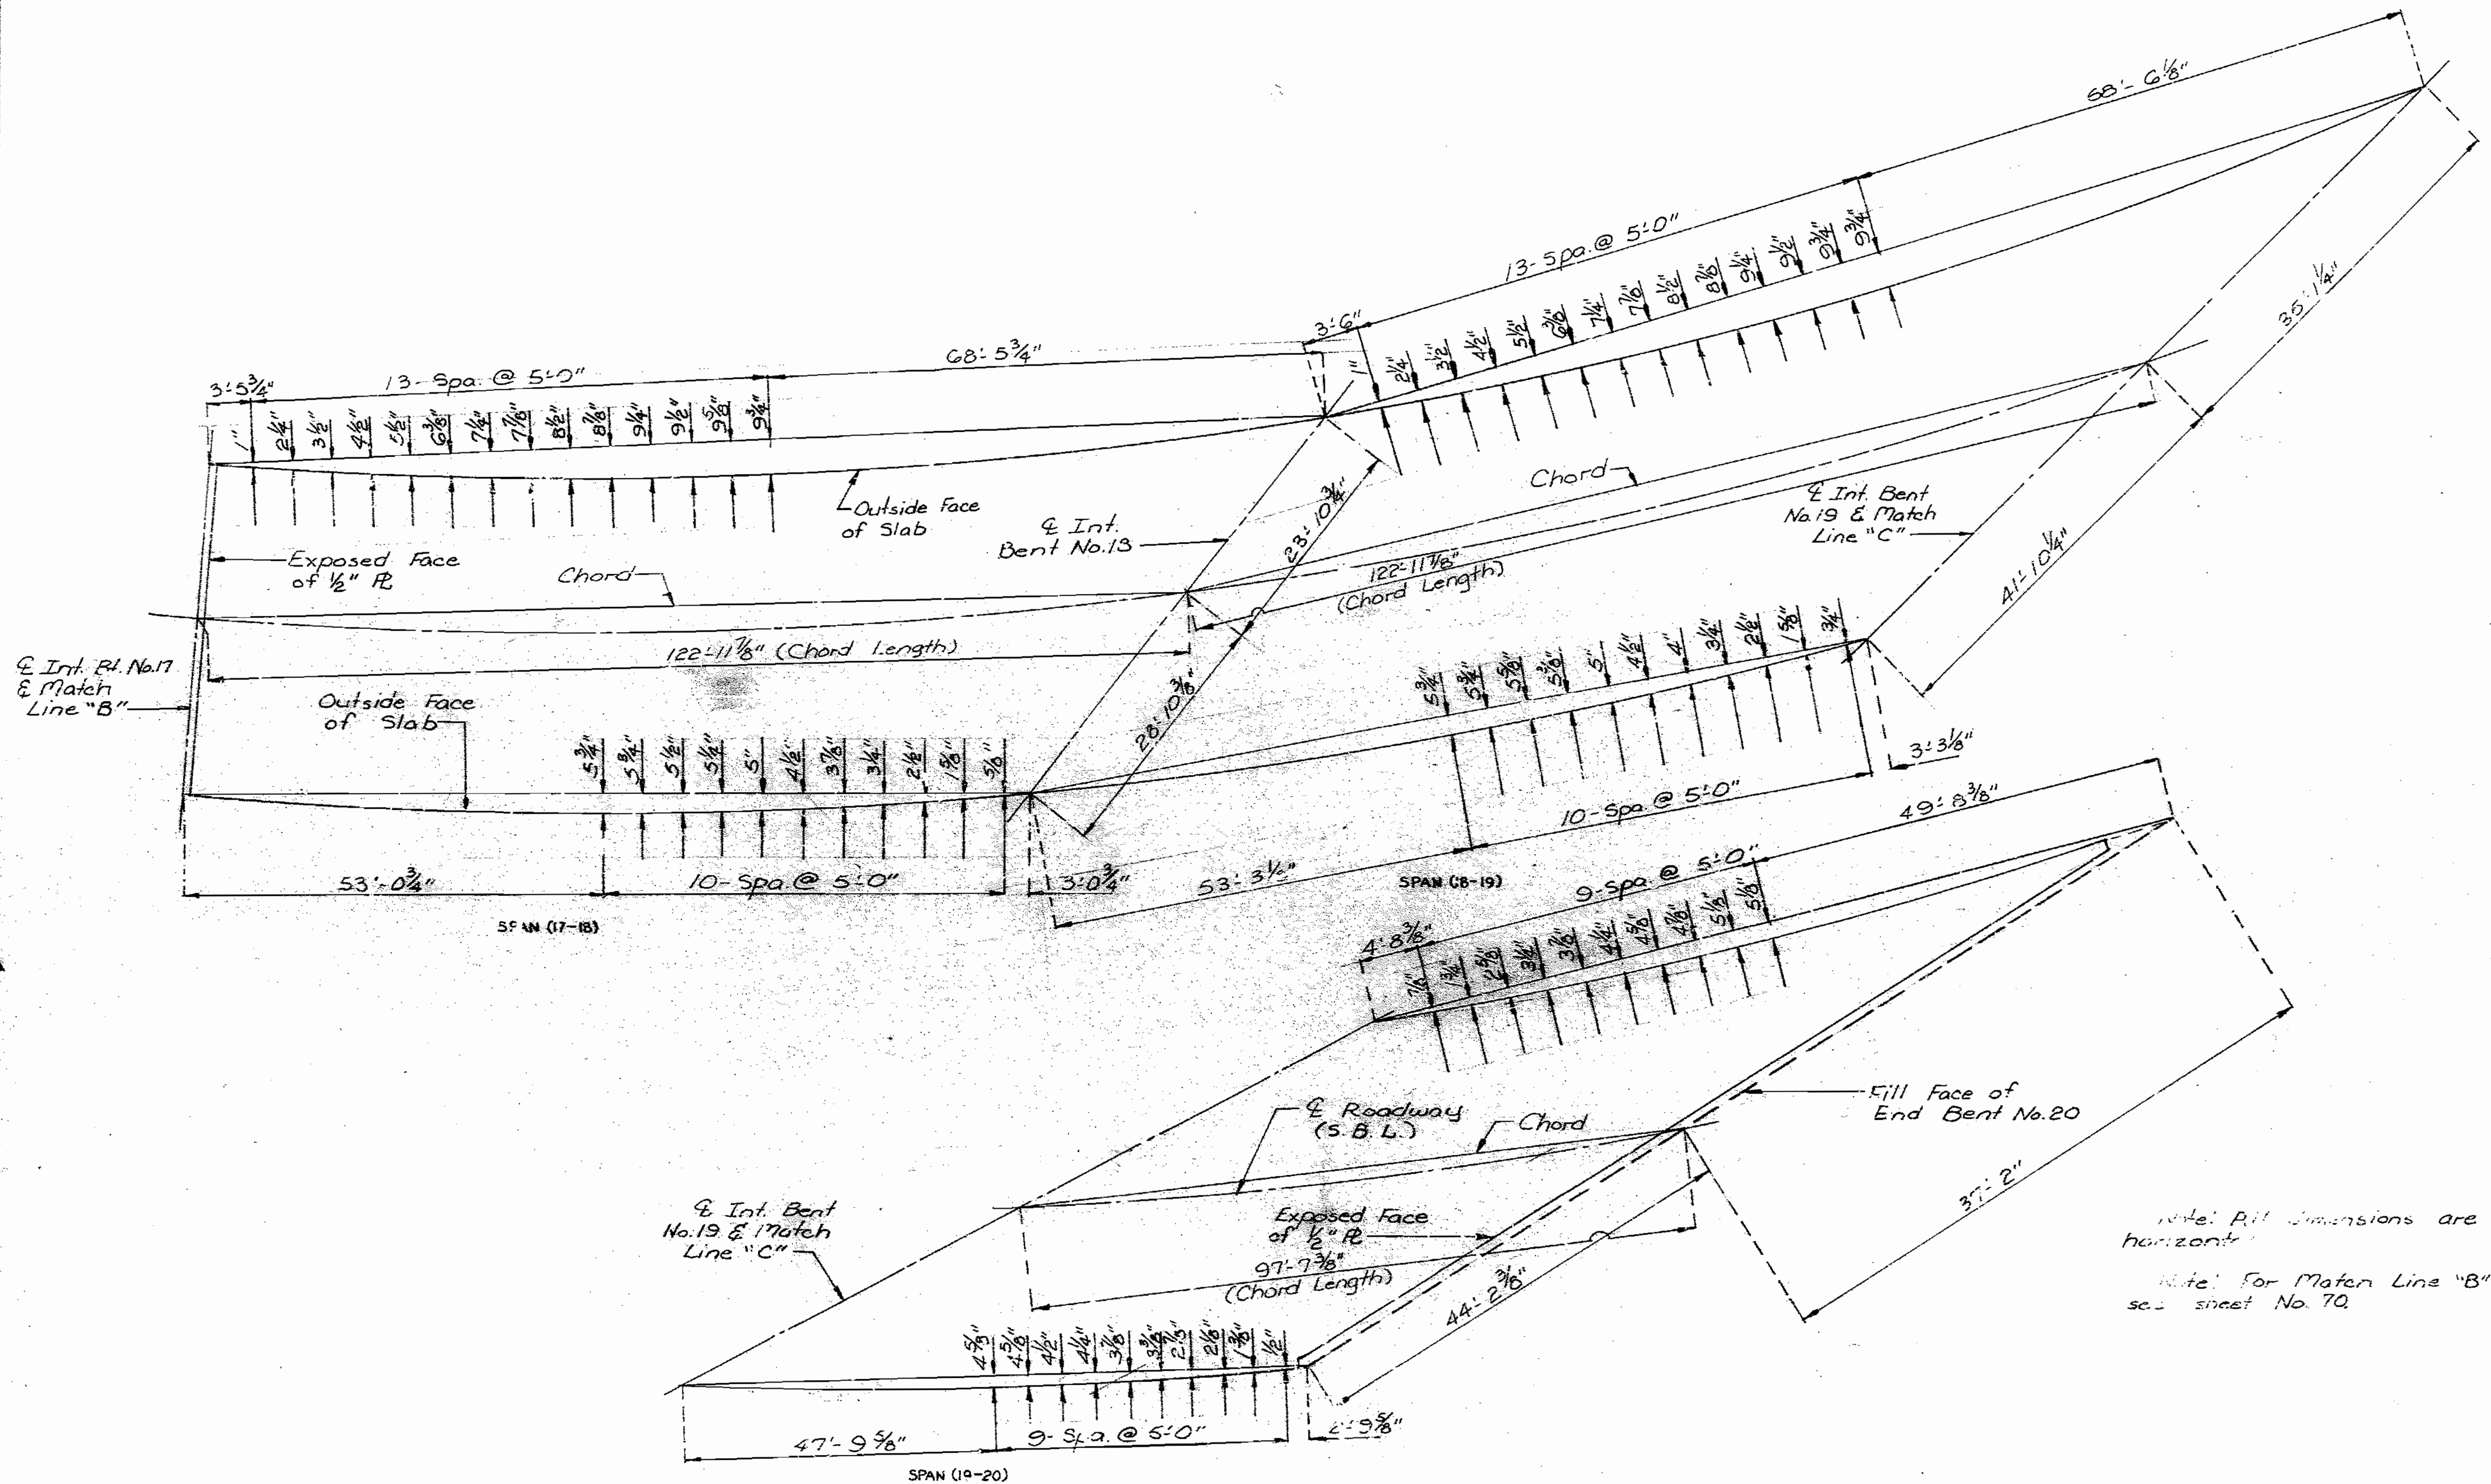

193/67

DETAILED JULY 1988  
CHECKED Feb. 1989

Note: This drawing is not to scale. Follow dimensions.


PART PLAN OF SLAB SHOWING CURVE ORDINATES

Sheet No. 71 of 93

JACKSON COUNTY

A-2745

STATE	PROJ. NO.	SHEET NO.
MO.		152

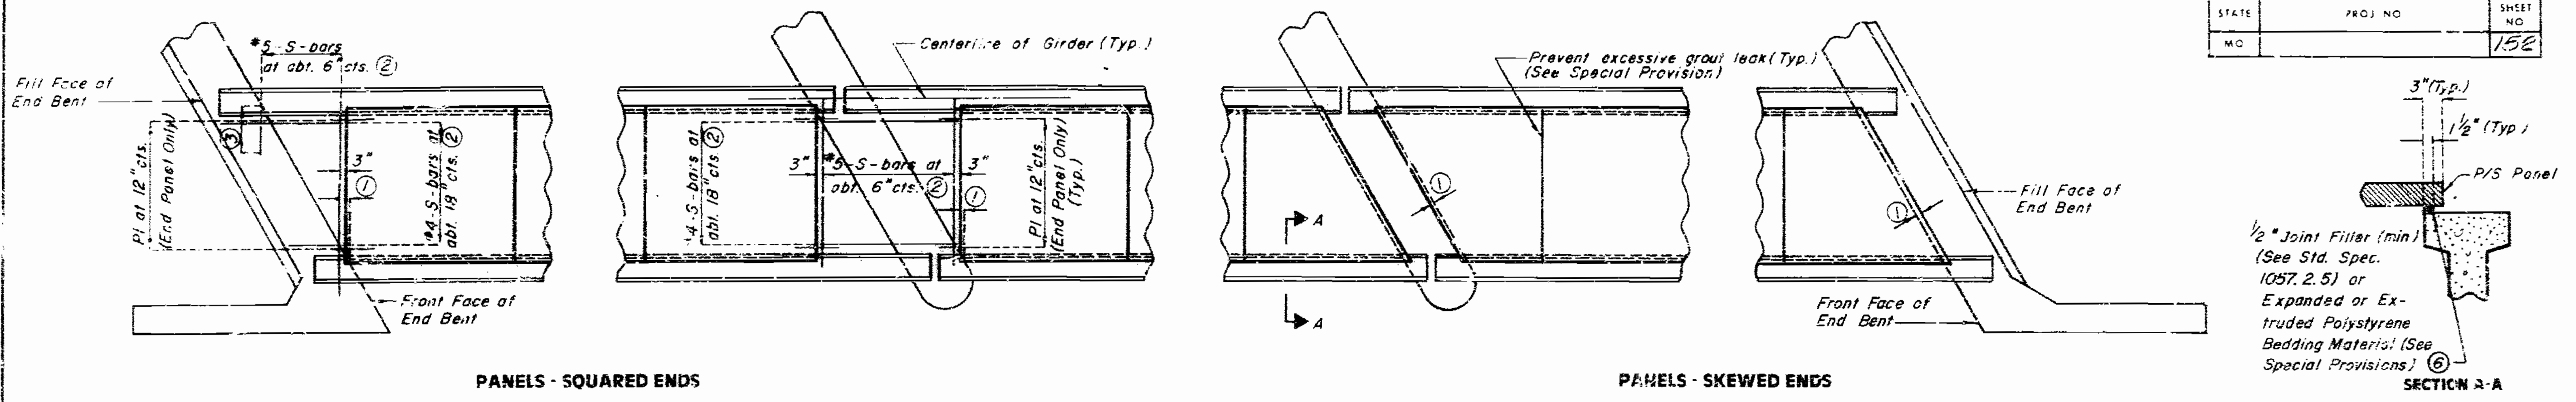


PANELS - SQUARED ENDS

PANELS - SKEWED ENDS

PLAN OF PRECAST PRESTRESSED PANELS PLACEMENT


NOTE  
USE SLAB HAUNCHING DIAGRAM ON SHEET NO. 69 FOR DETERMINING THICKNESS OF JOINT FILLER OR POLYSTYRENE BEDDING MATERIAL WITHIN THE LIMITS NOTED BELOW.

**GENERAL NOTES:**  
**PRESTRESSED PANELS:**  
 CONCRETE FOR PRESTRESSED PANELS SHALL BE CLASS A1 WITH  $F'_c = 5,000$  PSI,  $F'_t = 3,500$  PSI.  
 THE TOP SURFACE OF ALL PANELS SHALL RECEIVE A SCORED FINISH WITH A DEPTH OF SCORING OF 1/4 INCH PERPENDICULAR TO THE PRESTRESSING STRANDS IN THE PANELS (SEE SPECIAL PROVISIONS).  
 PRESTRESSING TENDONS SHALL BE HIGH-TENSILE STRENGTH UNCOATED SEVEN-WIRE (7); LOW RELAXATION STRANDS FOR PRESTRESSED CONCRETE CONFORMING TO AASHTO M203, EXCEPT THAT NOMINAL DIAMETER OF STRAND = 3/8 INCH AND NOMINAL AREA = 0.885 SQ. IN. AND MINIMUM ULTIMATE STRENGTH = 23,000 LBS./SQ. IN. LARGER STRANDS MAY BE USED WITH THE SAME SPACING AND INITIAL TENSION.  
 INITIAL PRESTRESSING FORCE = 14.9 KIPS/STRAND.  
 THE METHOD AND SEQUENCE OF RELEASE OF THE STRANDS SHALL BE SHOWN ON THE SHOP DRAWINGS.  
 SUITABLE ANCHORAGE DEVICE FOR LIFTING PANELS MAY BE CAST IN PANELS, PROVIDED THEY ARE SHOWN ON THE SHOP DRAWINGS AND APPROVED BY THE ENGINEER. PANEL LENGTHS SHALL BE DETERMINED BY THE CONTRACTOR AND SHOWN ON THE SHOP DRAWINGS.  
 WHEN SQUARE END PANELS ARE USED AT SKEWED BENTS, IT IS REQUIRED THAT THE SKEWED PORTION BE CAST FULL DEPTH. NO SEPARATE PAYMENT WILL BE MADE FOR THE ADDITIONAL CONCRETE AND REINFORCING REQUIRED.  
 MINIMUM JOINT FILLER OR POLYSTYRENE BEDDING MATERIAL THICKNESS SHALL BE 1/2 INCH. THICKER JOINT FILLER OR POLYSTYRENE BEDDING MATERIAL MAY BE USED ON ONE OR BOTH SIDES OF THE GIRDER TO REDUCE CAST-IN-PLACE CONCRETE THICKNESS, WITHIN TOLERANCES, NO MORE THAN 2 INCHES TOTAL THICKNESS OF JOINT FILLER OR POLYSTYRENE BEDDING MATERIAL SHALL BE USED.  
 THE SAME THICKNESS OF JOINT FILLER MATERIAL SHALL BE USED UNDER ANY ONE EDGE OF ANY PANEL AND THE MAXIMUM CHANGE IN THICKNESS BETWEEN ADJACENT PANELS SHALL BE 1/4 INCH. THE POLYSTYRENE BEDDING MATERIAL MAY BE CUT TO MATCH HAUNCH HEIGHT ABOVE TOP OF GIRDER.  
 AT THE CONTRACTOR'S OPTION THE VARIATION IN SLAB THICKNESS OVER PRESTRESSED PANELS MAY BE ELIMINATED OR REDUCED BY INCREASING AND VARYING THE GIRDER TOP FLANGE THICKNESS. DIMENSIONS SHALL BE SHOWN ON THE SHOP DRAWINGS.

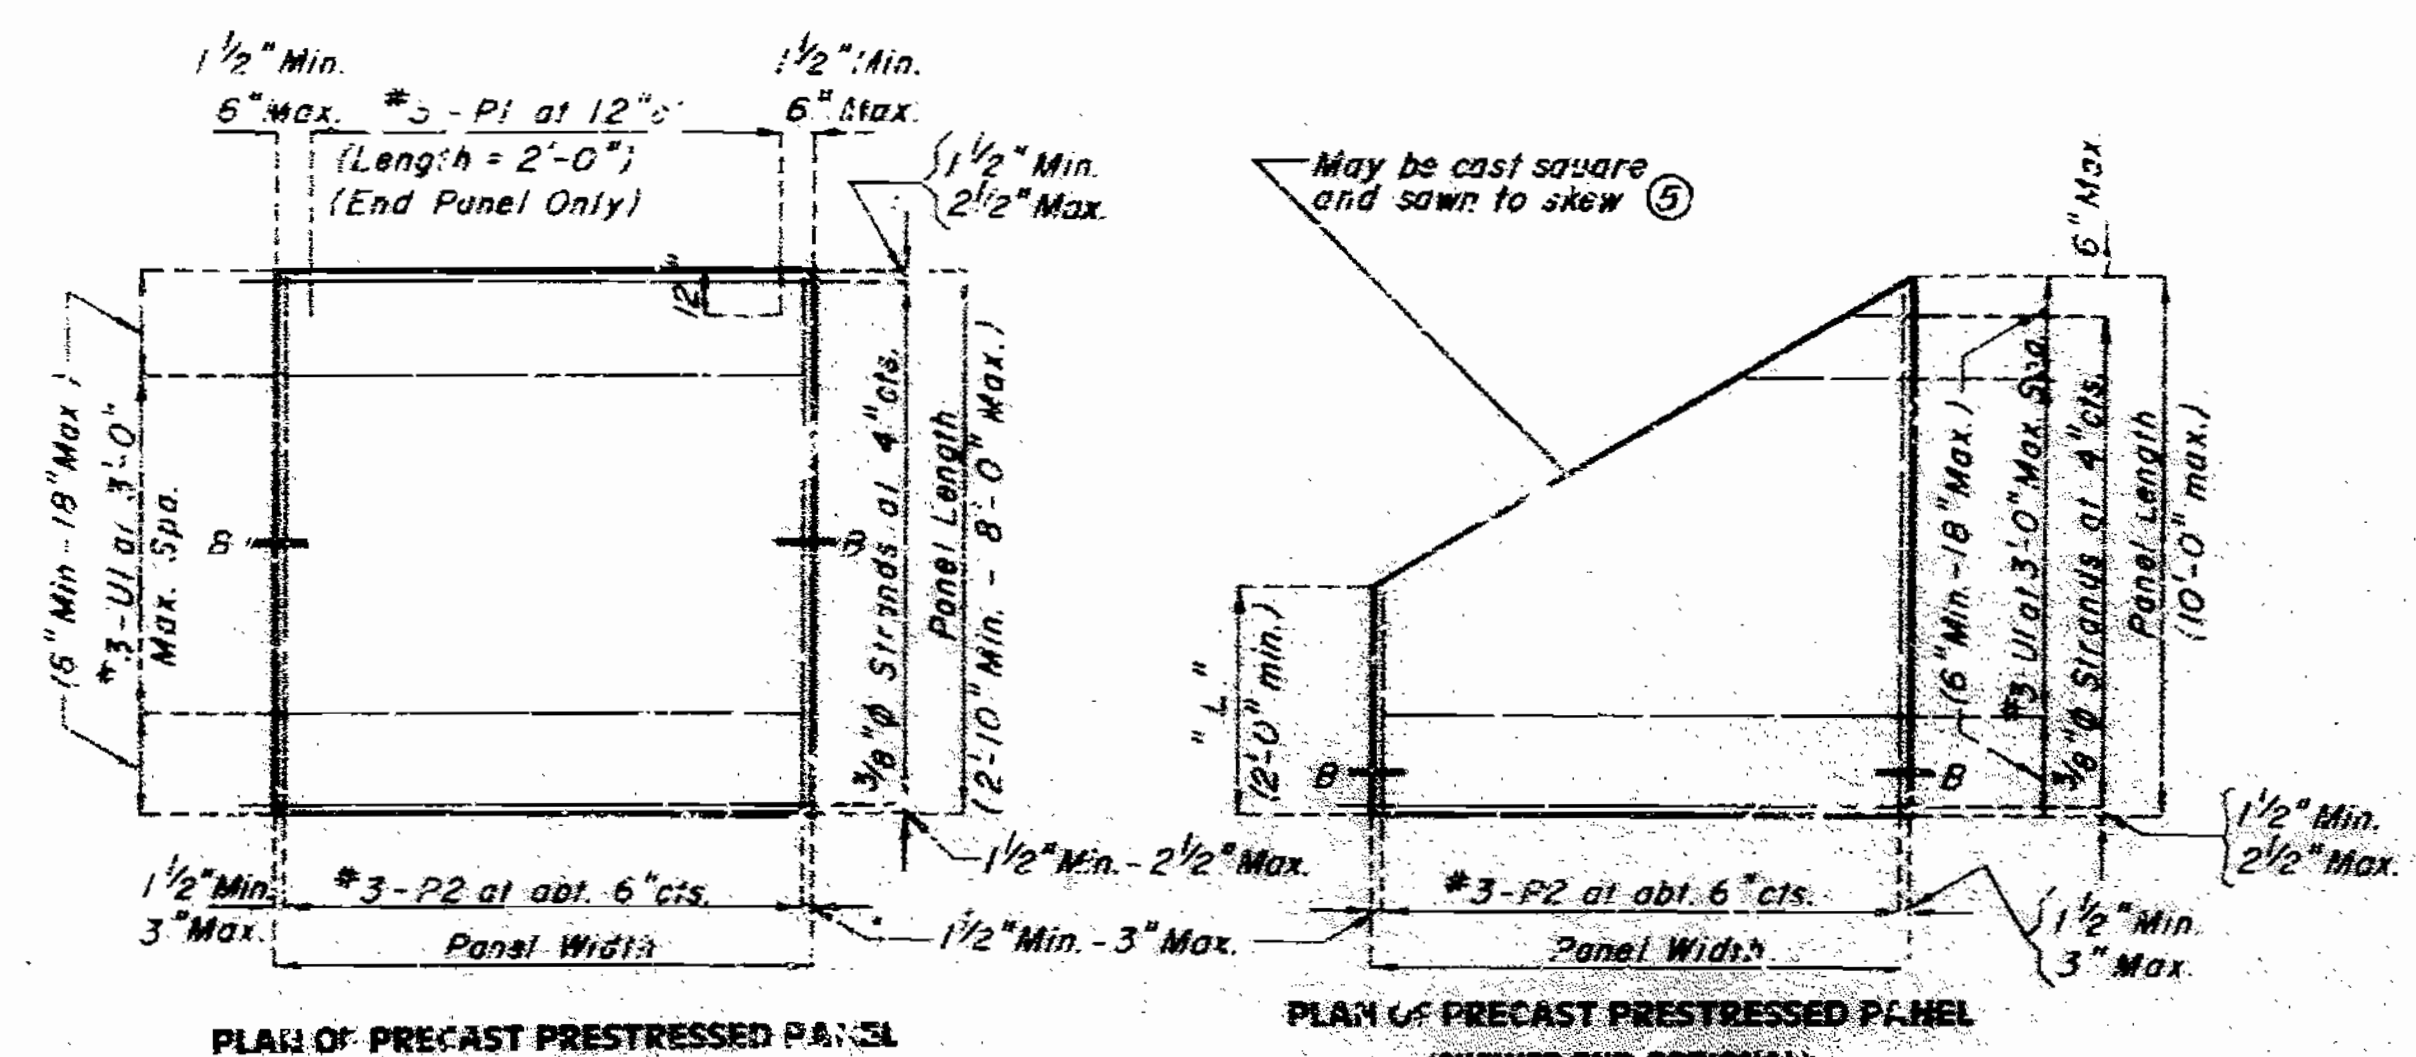

PLAN OF PRECAST PRESTRESSED PANEL


PLAN OF PRECAST PRESTRESSED PANEL (SKEWED END-OPTIONAL)

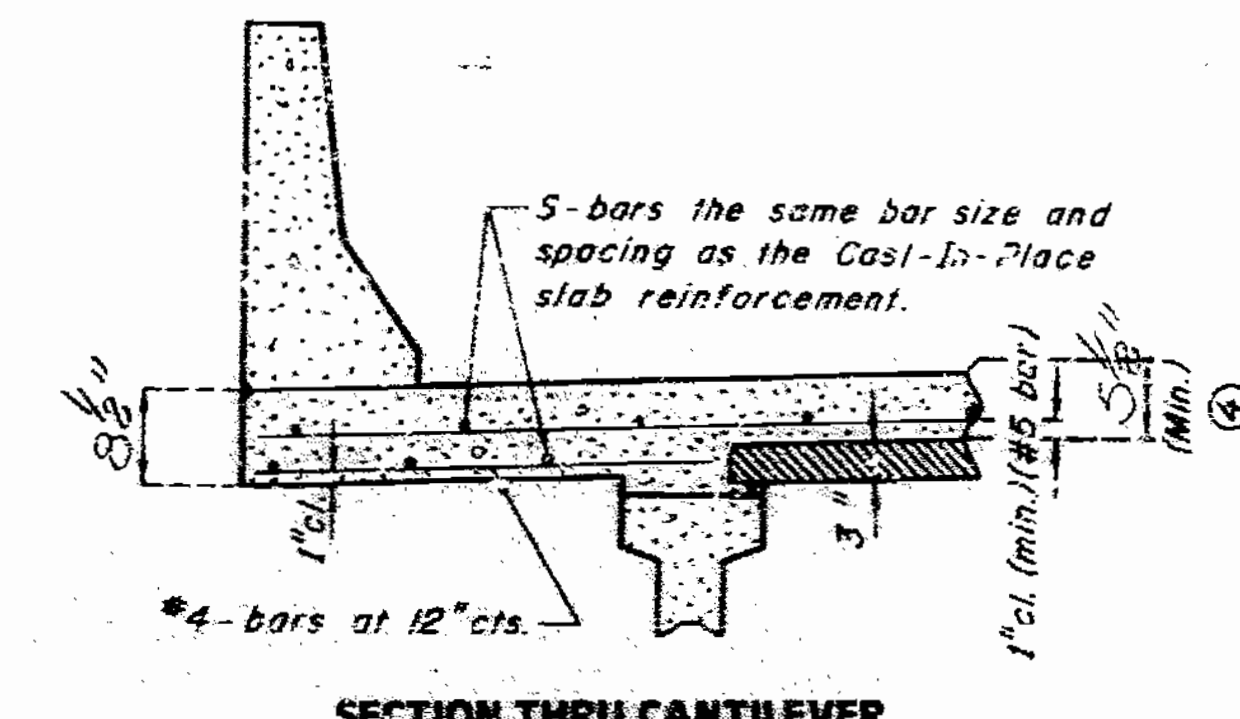


SECTION THRU CANTILEVER

- NOTE:**
- END PANELS TO BE DIMENSIONED 1/4 INCHES FROM THE INSIDE FACE OF DIAPHRAGM.
  - S-BARS SHOWN ARE BOTTOM STEEL IN SLAB BETWEEN PANELS AND USED WITH SQUARED-END PANELS ONLY. COST OF S-BARS SHALL BE INCLUDED IN THE PRICE BID FOR SLAB PER SQ. YD. S-BARS ARE NOT LISTED IN BILL OF REINFORCING. SUPPORT FROM DIAPHRAGM FORMS IS REQUIRED UNDER THE OPTIONAL SKEWED END LIMIT. CAST-IN-PLACE CONCRETE HAS REACHED 3,000 PSI COMPRESSIVE STRENGTH.
  - EXTEND S-BARS 18 INCHES BEYOND THE FRONT FACE OF END BENT ONLY.
  - SLAB EXTERIOR GIRDER HAUNCH SHALL BE THE SAME AS CAST-IN-PLACE. SLAB THICKNESS OVER PRESTRESSED PANELS VARIES DUE TO GIRDER CAMBER.
  - IN ORDER TO MAINTAIN MINIMUM SLAB THICKNESS IT MAY BE NECESSARY TO RAISE THE GRADE UNIFORMLY THROUGHOUT THE STRUCTURE. NO PAYMENT WILL BE MADE FOR ADDITIONAL LABOR OR MATERIALS REQUIRED FOR NECESSARY GRADE ADJUSTMENT.
  - LIFT STRAND 2'-0" OR SHORTER SHALL HAVE A #3 REINFORCING BAR ON EACH SIDE OF IT, CENTERED BETWEEN STRANDS. STRANDS 2'-0" OR SHORTER MAY THEN BE DEBONDED AT THE FABRICATOR'S OPTION.
  - ALL PANEL SUPPORT PADS SHALL BE GLUED TO THE GIRDER WHEN SUPPORT THICKNESS EXCEEDS 1 1/2 INCHES. THE PADS SHALL BE GLUED TOP AND BOTTOM. THE GLUE USED SHALL BE THE TYPE RECOMMENDED BY THE PANEL SUPPORT PADS MANUFACTURER.


**REINFORCING STEEL:**  
 ALL DIMENSIONS ARE OUT TO OUT.  
 MINIMUM CLEARANCE TO REINFORCING STEEL SHALL BE 1/2 INCH UNLESS OTHERWISE SHOWN.  
 HOOKS AND BENDS SHALL BE IN ACCORDANCE WITH THE C.R.S.I. MANUAL OF STANDARD PRACTICE FOR DETAILING REINFORCED CONCRETE STRUCTURES, STIRRUPS AND THE DIMENSIONS.  
 ACTUAL LENGTHS ARE MEASURED ALONG CENTERLINE OF BAR TO THE NEAREST INCH.  
 THE PRESTRESSED PANEL QUANTITIES ARE NOT INCLUDED IN THE TABLE OF ESTIMATED QUANTITIES FOR ALTERNATE SLABS.  
 IF U1 BARS INTERFERE WITH PLACEMENT OF SLAB STEEL, U1 LOOPS MAY BE BENT OVER, AS NECESSARY, TO CLEAR SLAB STEEL.  
 WELDED WIRE FABRIC OR WELDED DEFORMED BAR MATS PROVIDING A MINIMUM AREA OF REINFORCING PERPENDICULAR TO STRANDS OF 0.22 SQ. IN./FT. WITH SPACING PARALLEL TO STRANDS SUFFICIENT TO INSURE PROPER HANDLING, MAY BE USED IN LIEU OF THE #3 U1 BARS SHOWN. WIRE OR BAR DIAMETER SHALL NOT BE LARGER THAN 0.375 INCHES.

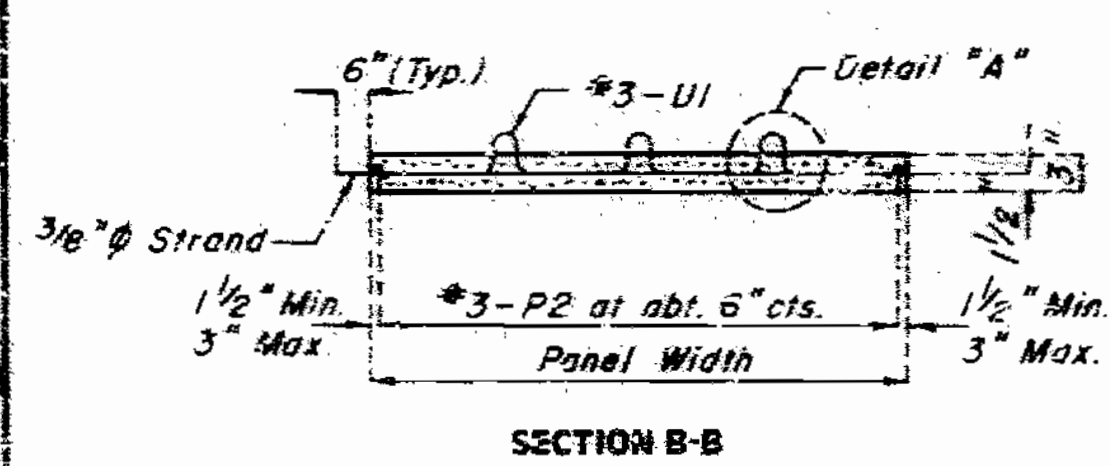


SECTION B-B

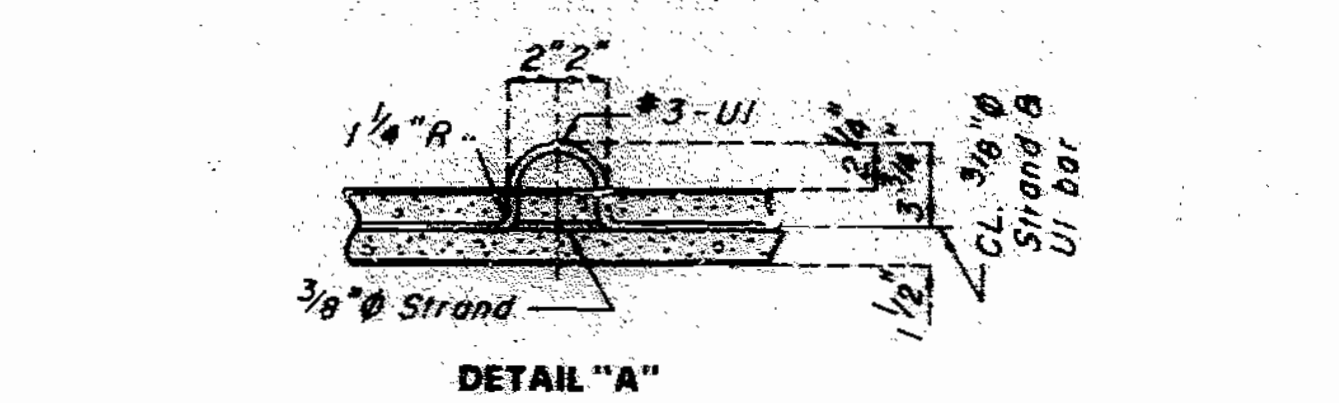

DETAIL "A"

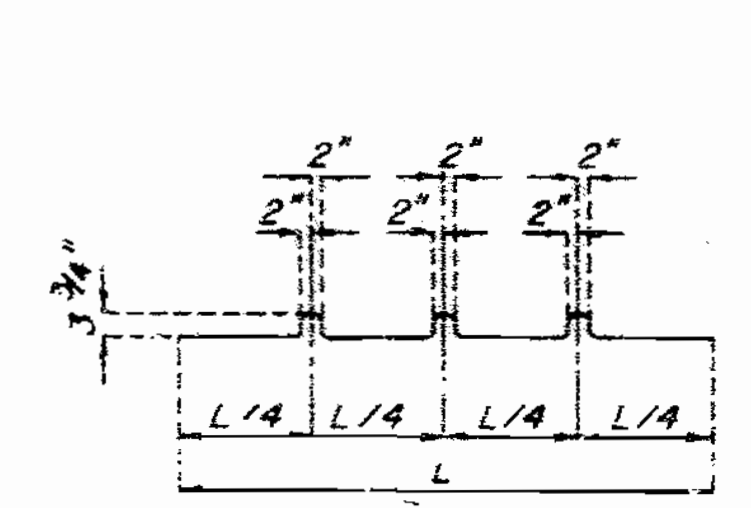

BENDING DIAGRAM FOR U1 BAR

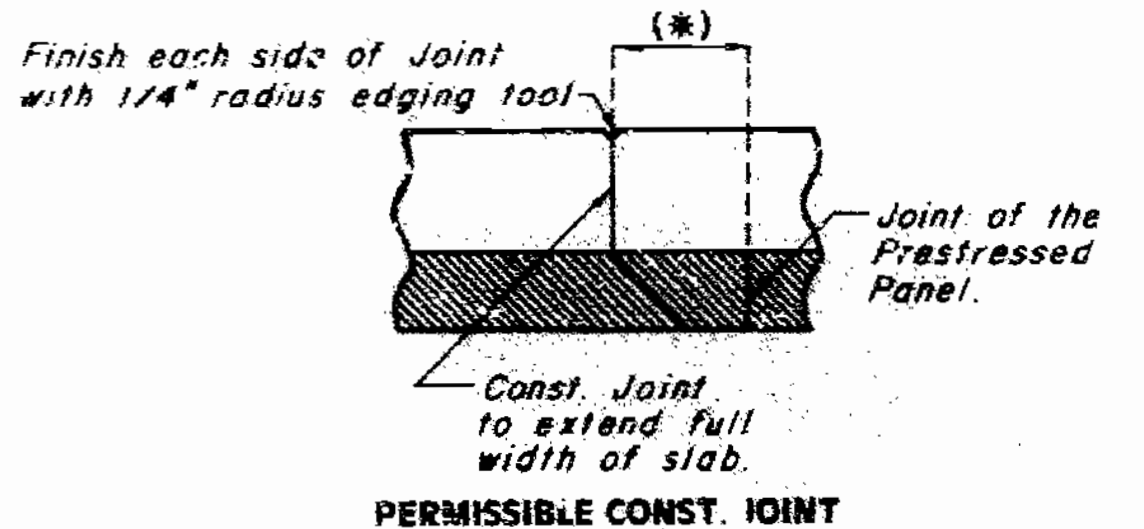

PERMISSIBLE CONST. JOINT

(\*) ADJUST THE PERMISSIBLE CONST. JOINT TO A CLEARANCE OF 6 INCHES MIN FROM THE JOINTS OF THE PRESTRESSED PANELS.

#3 U1 BARS MAY BE ORIENTED AT RIGHT ANGLES TO LOCATE JOINT AND SPACING SHOWN. U1 BARS SHALL BE PLACED BETWEEN P1 BARS


DETAILS OF PRECAST PRESTRESSED PANELS

Note: This drawing is not to scale. Follow dimensions.


Sheet No. 72 of 98.

PRESTRESS P/C-P/S PANEL (37) REVISED AUG. 1984  
 CHECKED July 1983  
 DETAILED July 1983

STATE	PROJ. NO.	SHEET NO.
MO		153

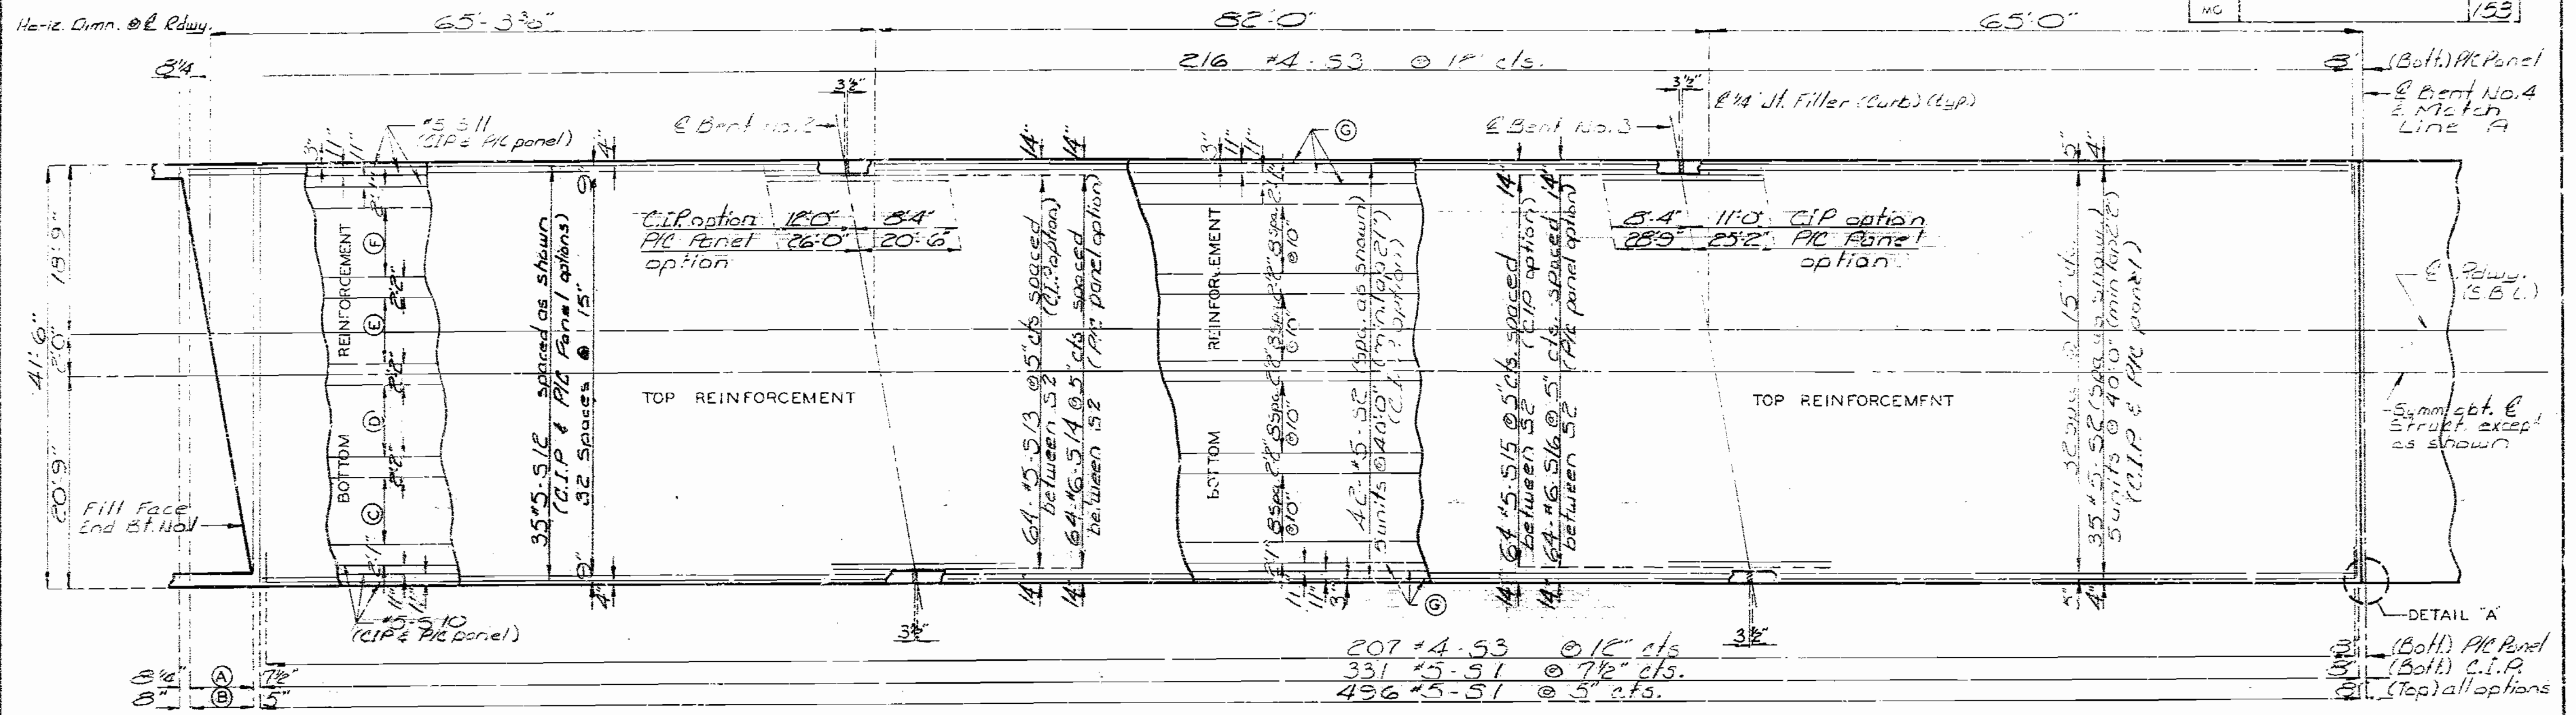

- Ⓐ #5-54 @ 7 1/2' cts.
- Ⓑ #5-55 @ 5' cts.
- Ⓒ #5-56 @ 10' cts. (C.I.P.)
- Ⓓ #5-57 @ 10' cts. (C.I.P.)
- Ⓔ #5-58 @ 10' cts. (C.I.P.)
- Ⓕ #5-59 @ 10' cts. (C.I.P.)
- Ⓖ #5-52 Sunits @ 40' 0" (P.C. Panel opt.)

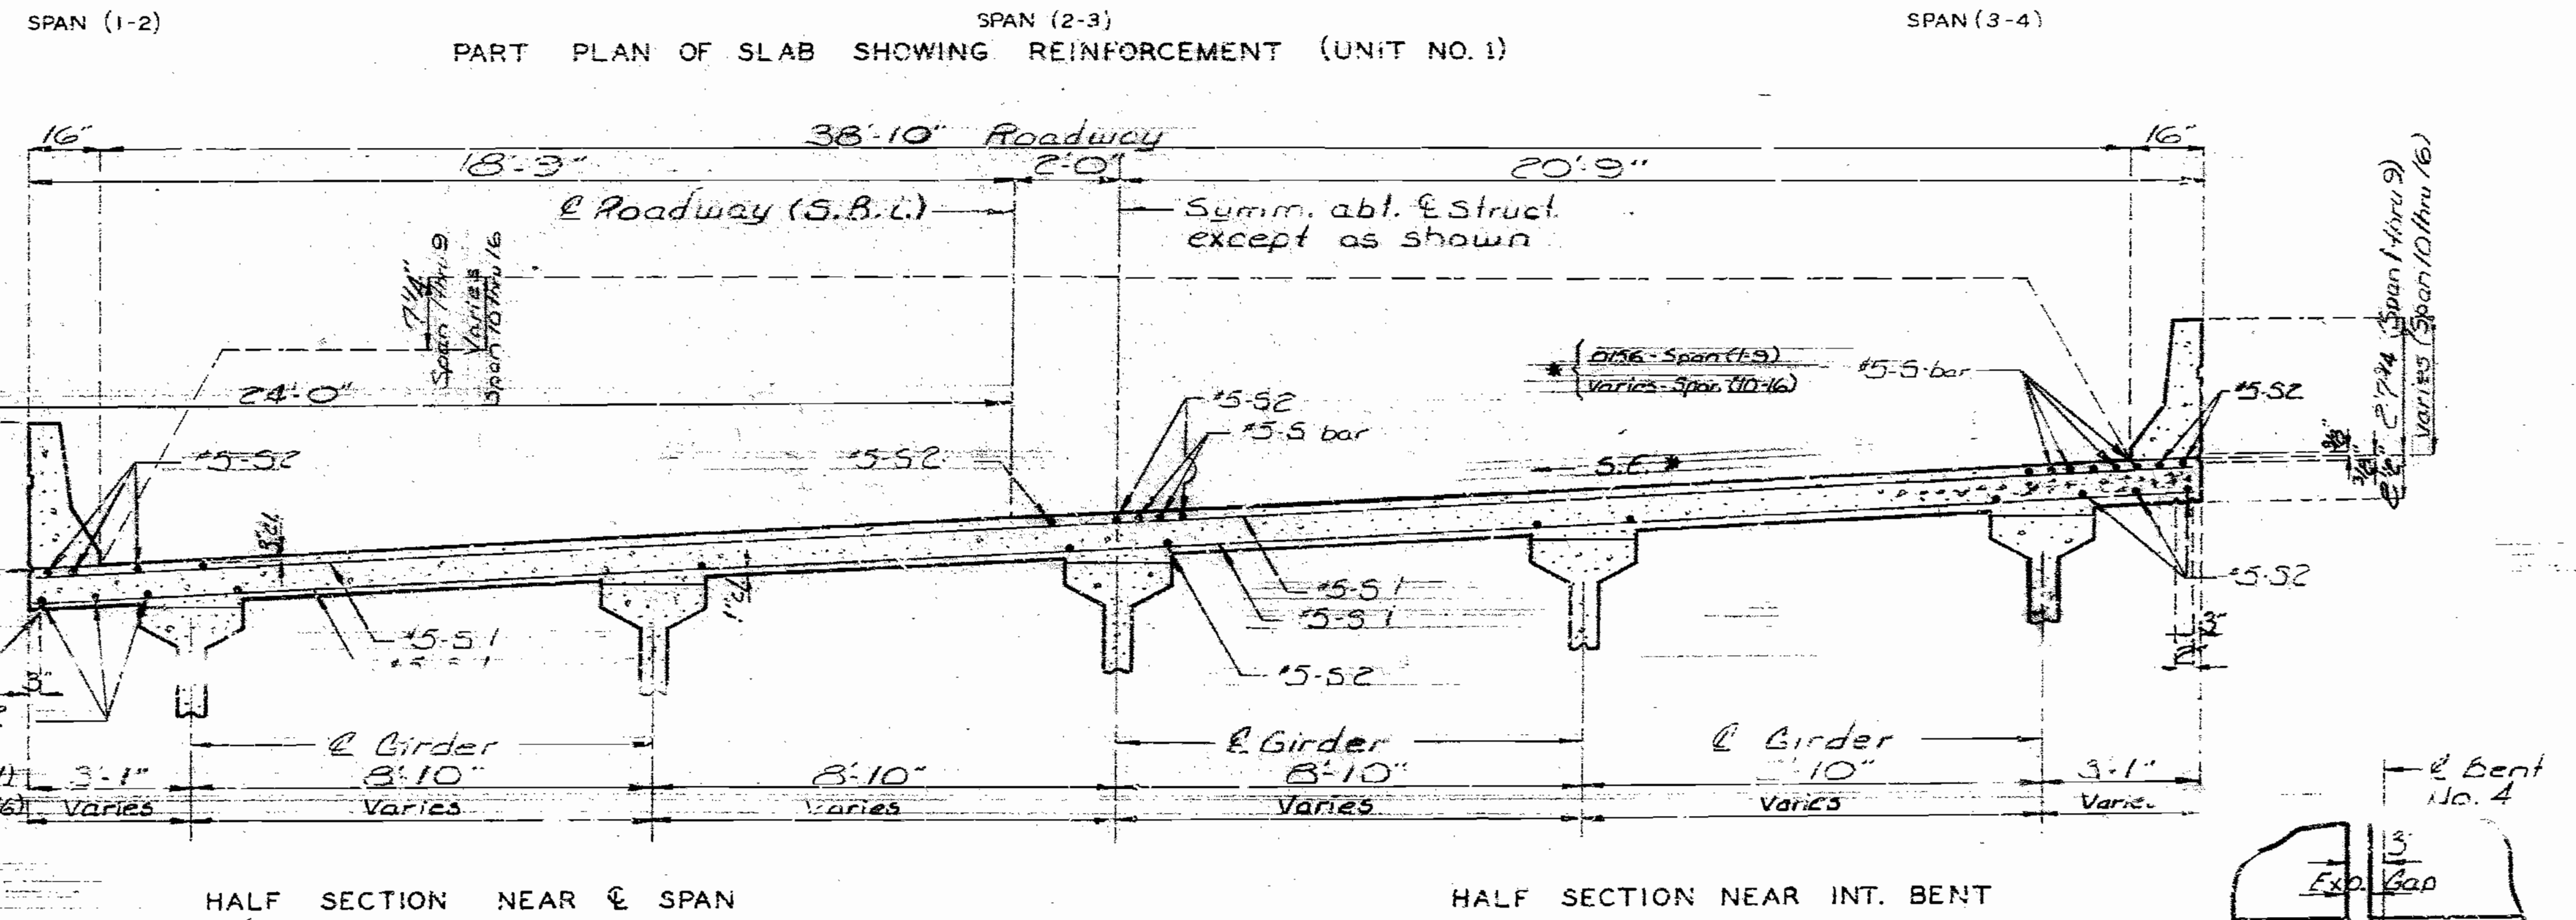

SKEW ANGLES	
BENT NO.	SKEW
1, 2 & 3	12° 15' RA
4 & 5	RT L°
6, 7, 8, 9 & 10	20° LA
11	41° 46' 20" LA
12	42° 47' 38" LA
13	44° 34' 06" LA
14	26° 15' 44" LA
15, 16, & 17	Radial
18	36° 03' 11" LA
19	57° 25' 06" LA
20	59° 17' 55" LA

Note: Skew angles are measured at & Roadway (S.B.L.)


199/169

DETAILED FEB. 1988  
CHECKED March 1989


Note: This drawing is not to scale. Follow dimensions.

Sheet No. 73 of 98

STATE	PROJ NO	SHEET NO
MO		154

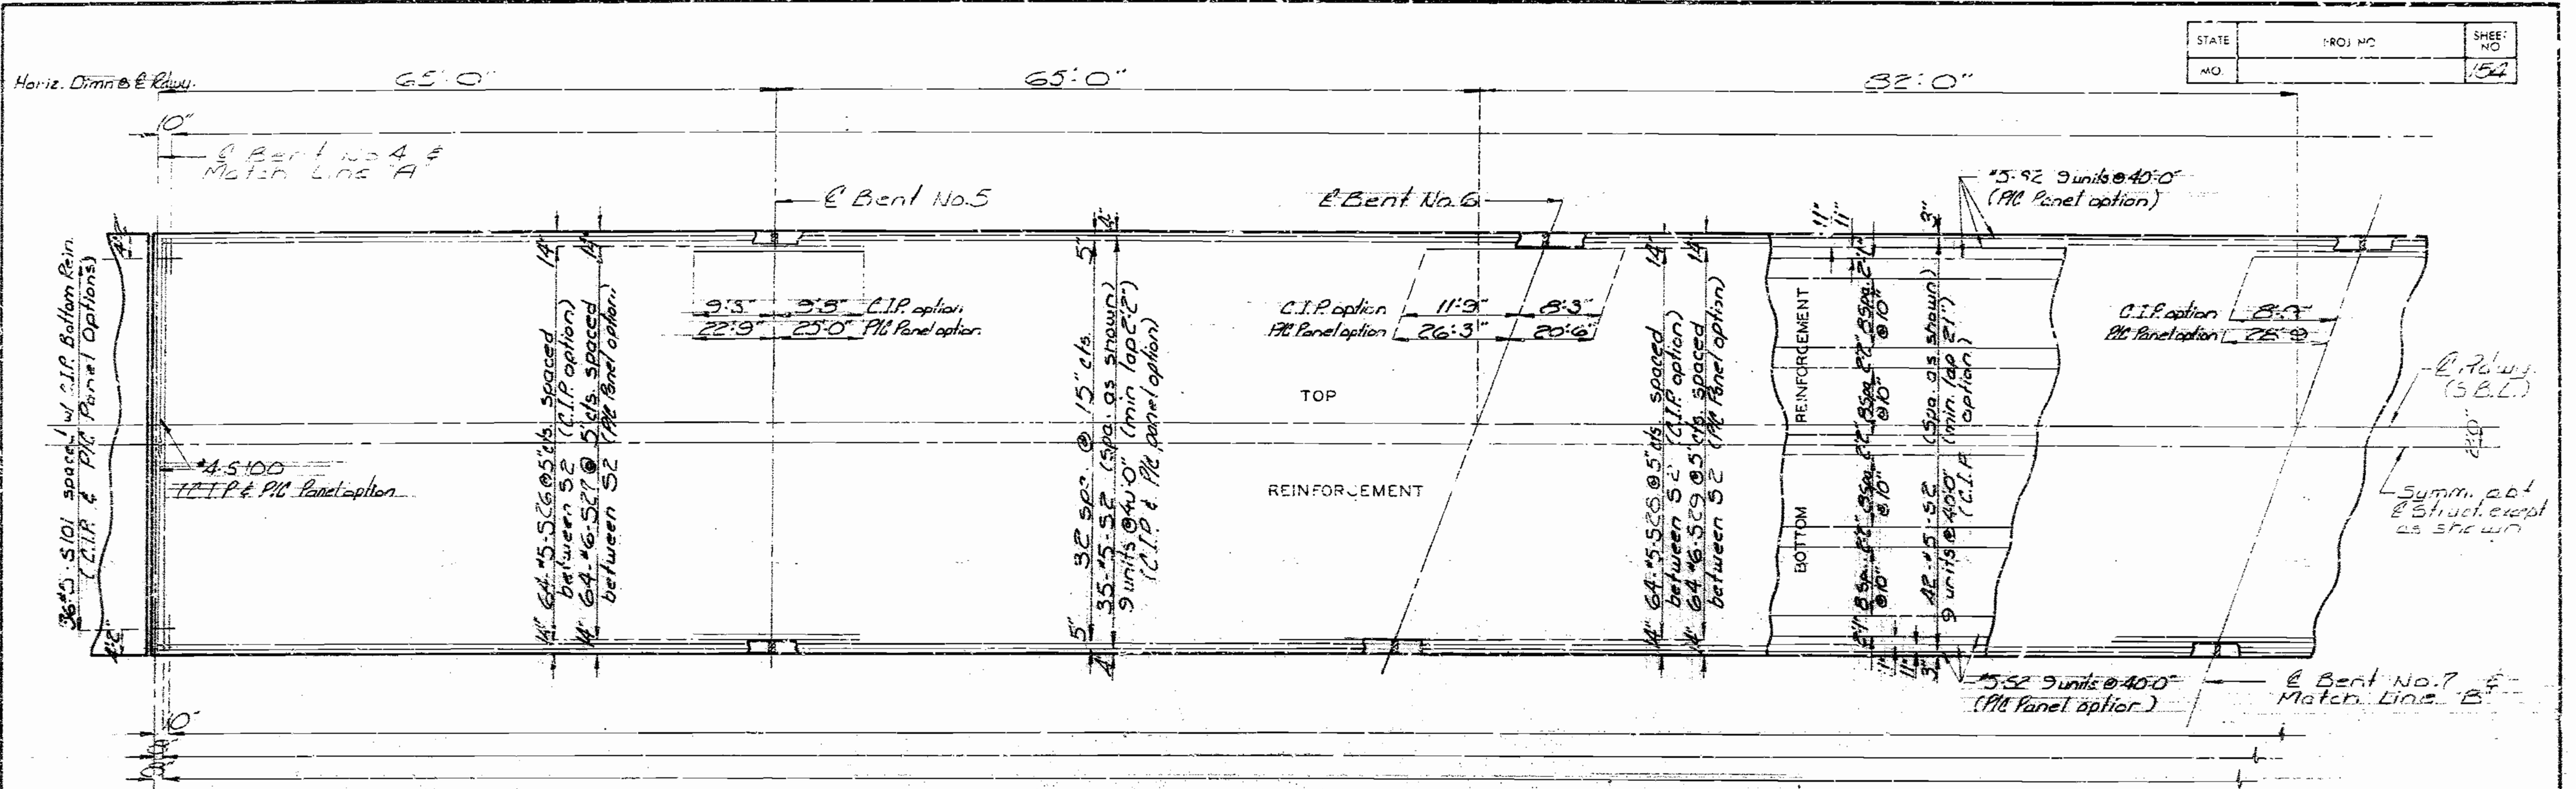


SPAN (4-5) PART PLAN OF SLAB SHOWING REINFORCEMENT (UNIT 2) SPAN (6-7)

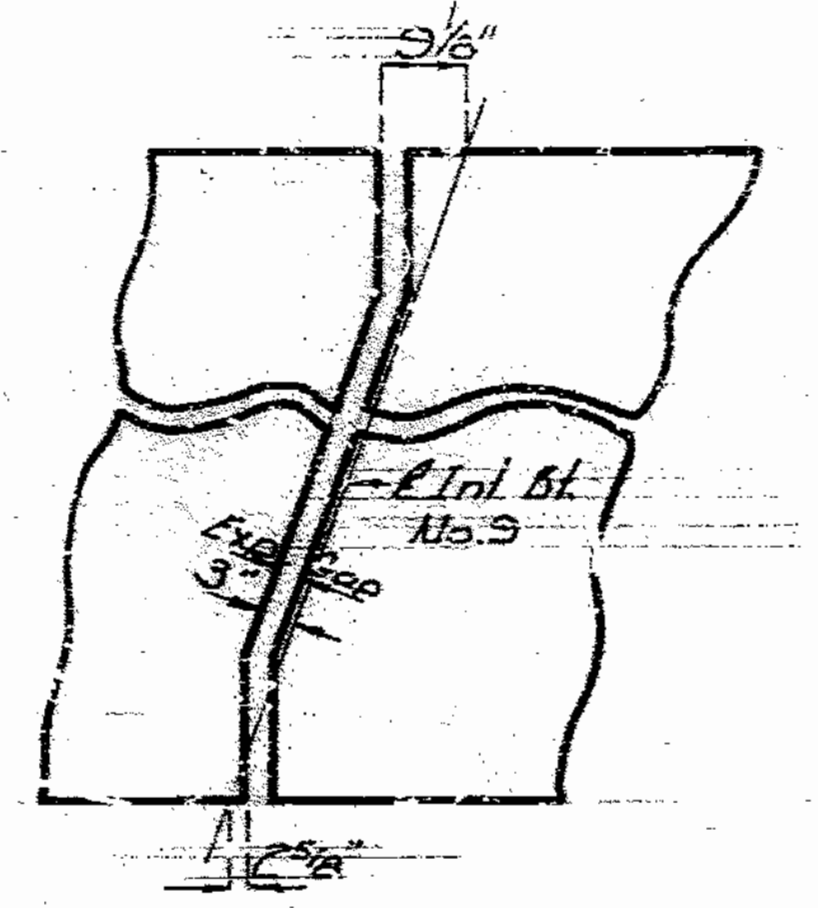

PART PLAN AT BENT NO. 9

Symm. abt. E struct. except as shown

- (A) 22'-5.51 @ 7 1/2' cts.
- (B) 34'-5.51 @ 5' cts.
- (C) 9'-5.52 @ 10' cts. (C.I.P.)
- (D) 9'-5.52 @ 10' cts. (C.I.P.)
- (E) 9'-5.52 @ 15' cts. (C.I.P.)
- (F) 9'-5.52 @ 10' cts. (C.I.P.)

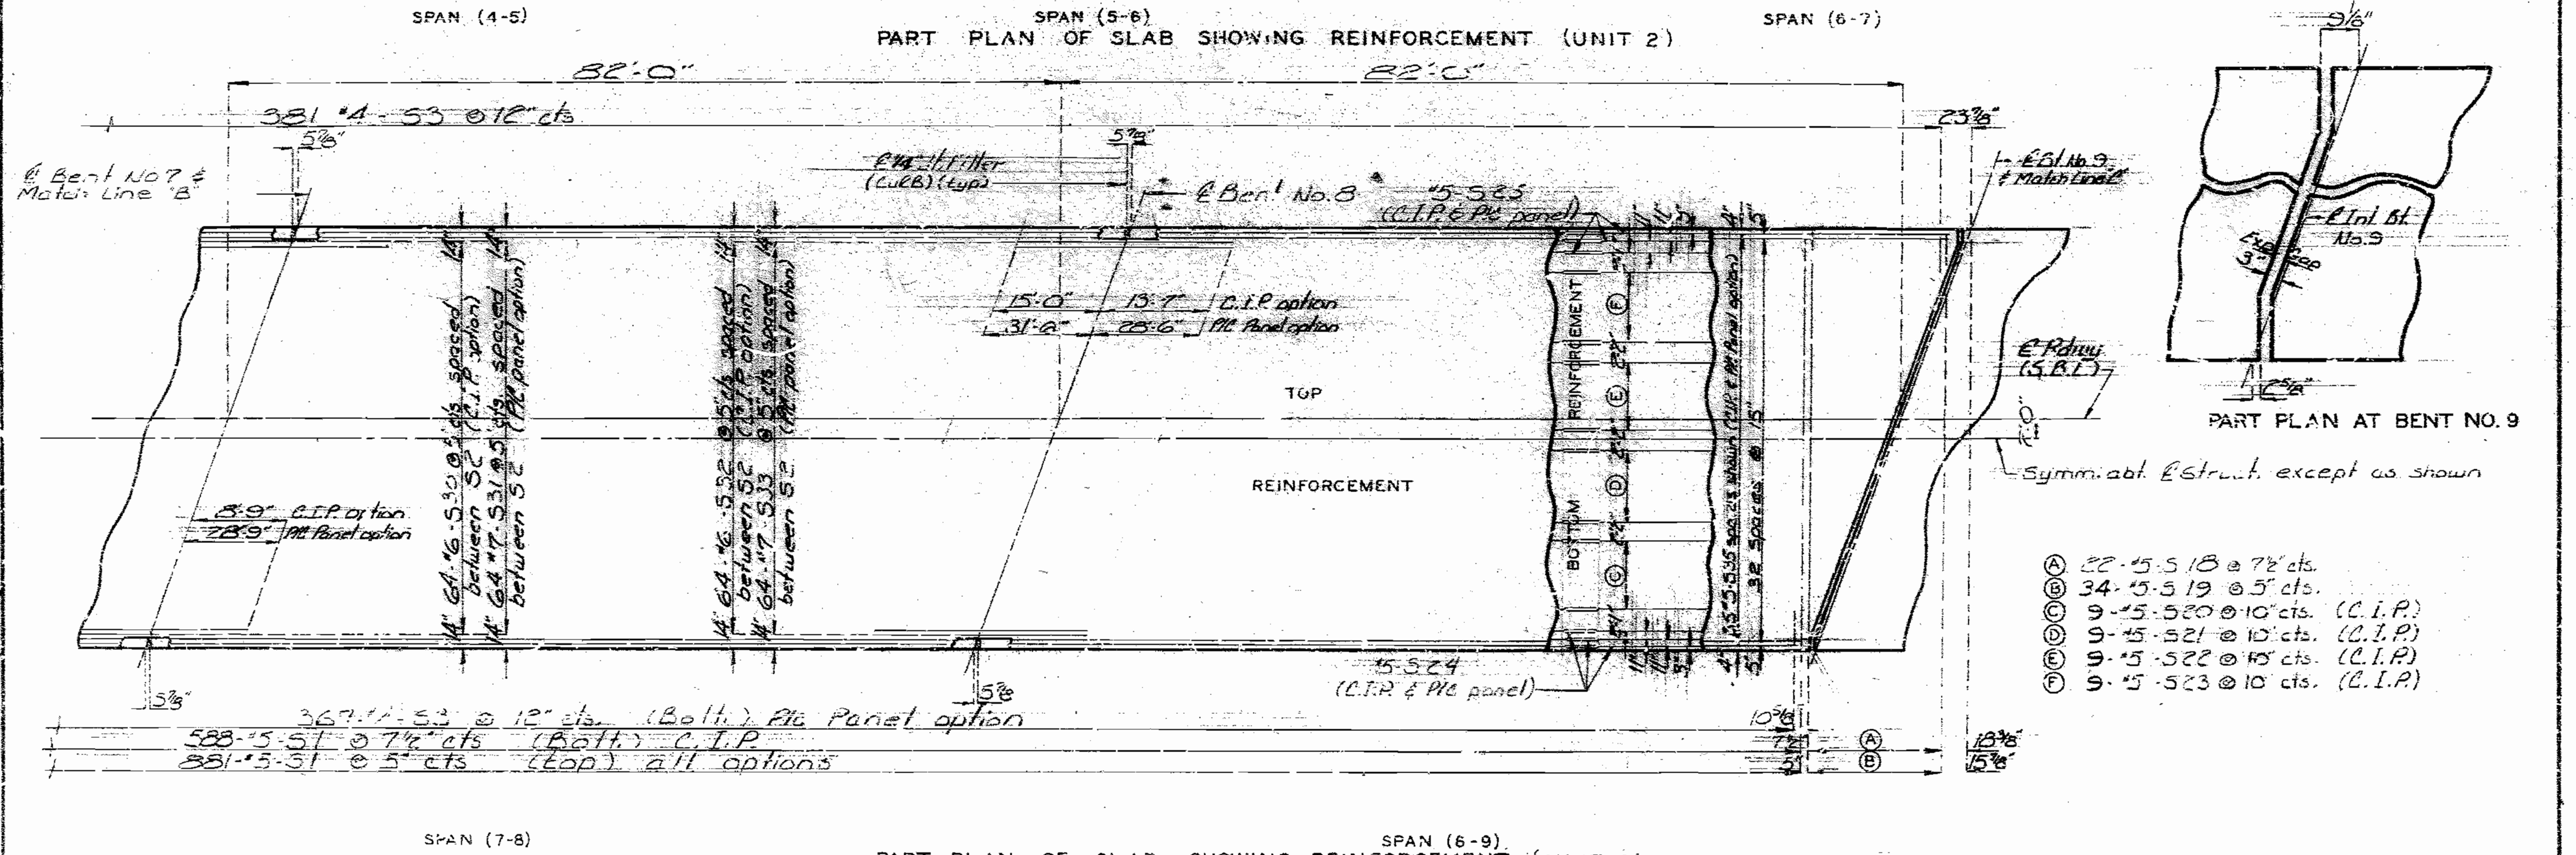

SPAN (7-8) PART PLAN OF SLAB SHOWING REINFORCEMENT (UNIT 2) SPAN (8-9)

198/170

DETAILED FEB. 1988  
CHECKED March 1989



Note: This drawing is not to scale. Follow dimensions.

Sheet No. 74 of 93

JACKSON COUNTY

A-2745

STATE	PROJ. NO.	SHEET NO.
MO.		155

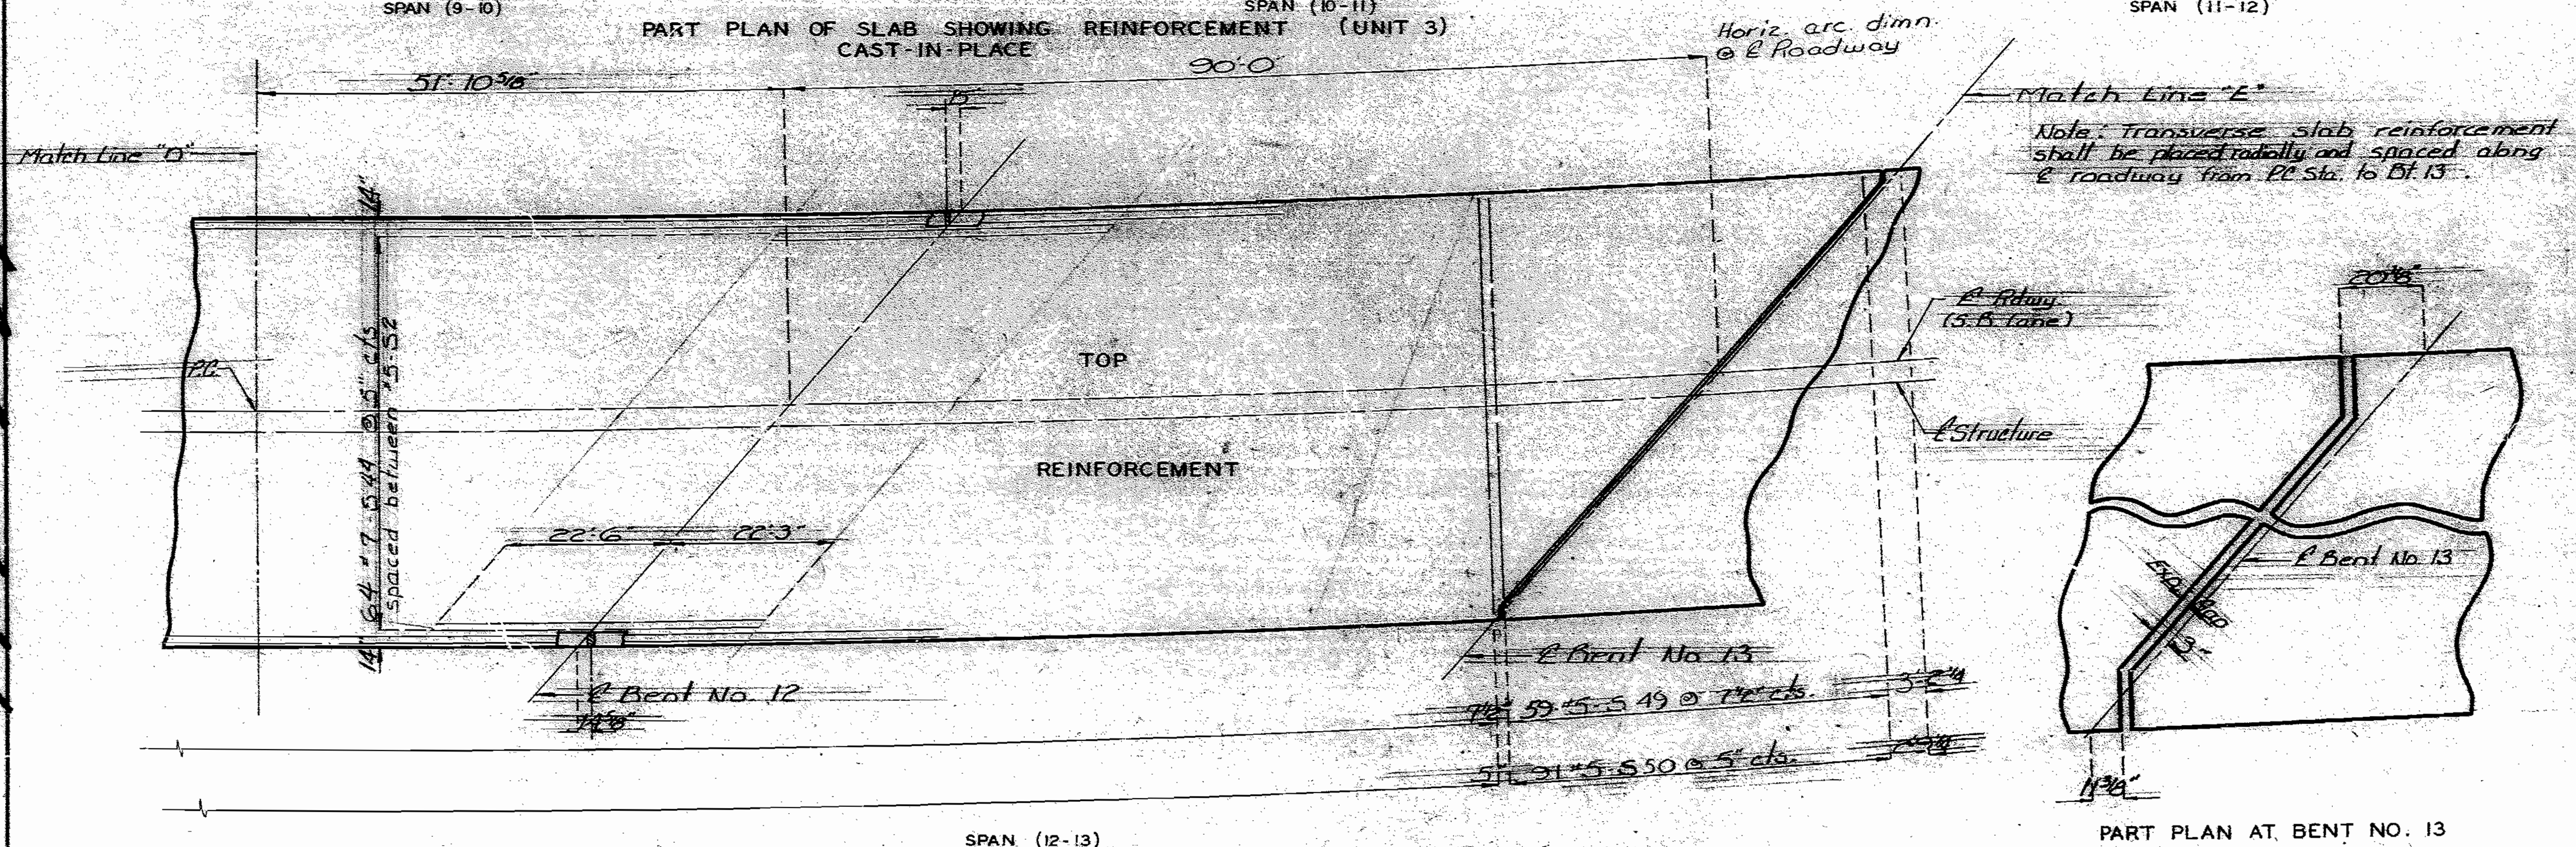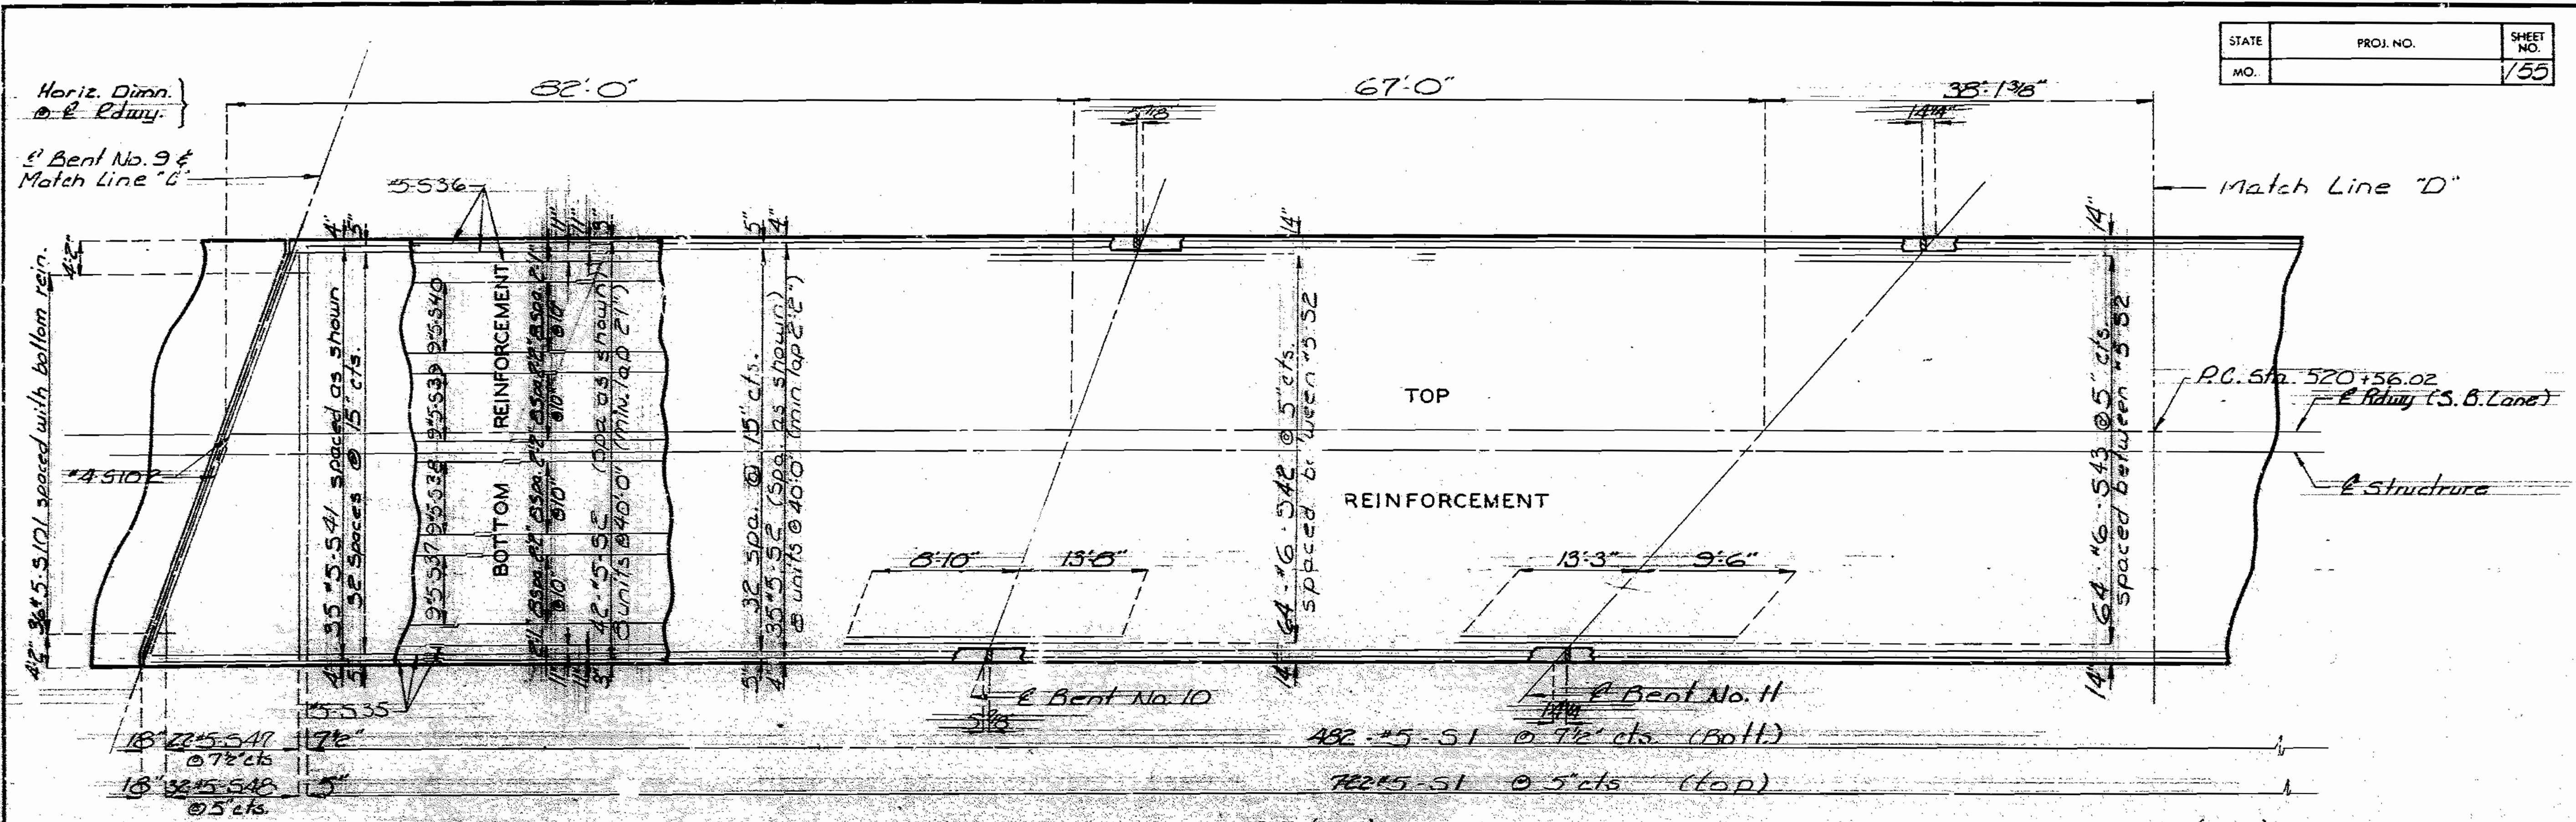

DETAILED MAR. 1958  
 CHECKED Oct. 1958

PART PLAN OF SLAB. SHOWING REINFORCEMENT CAST-IN-PLACE (UNIT 3)



Note: This drawing is not to scale. Follow dimensions.

Sheet No. 75 of 98

JACKSON COUNTY

A-2745

STATE	PROJ. NO.	SHEET NO.
MO		156

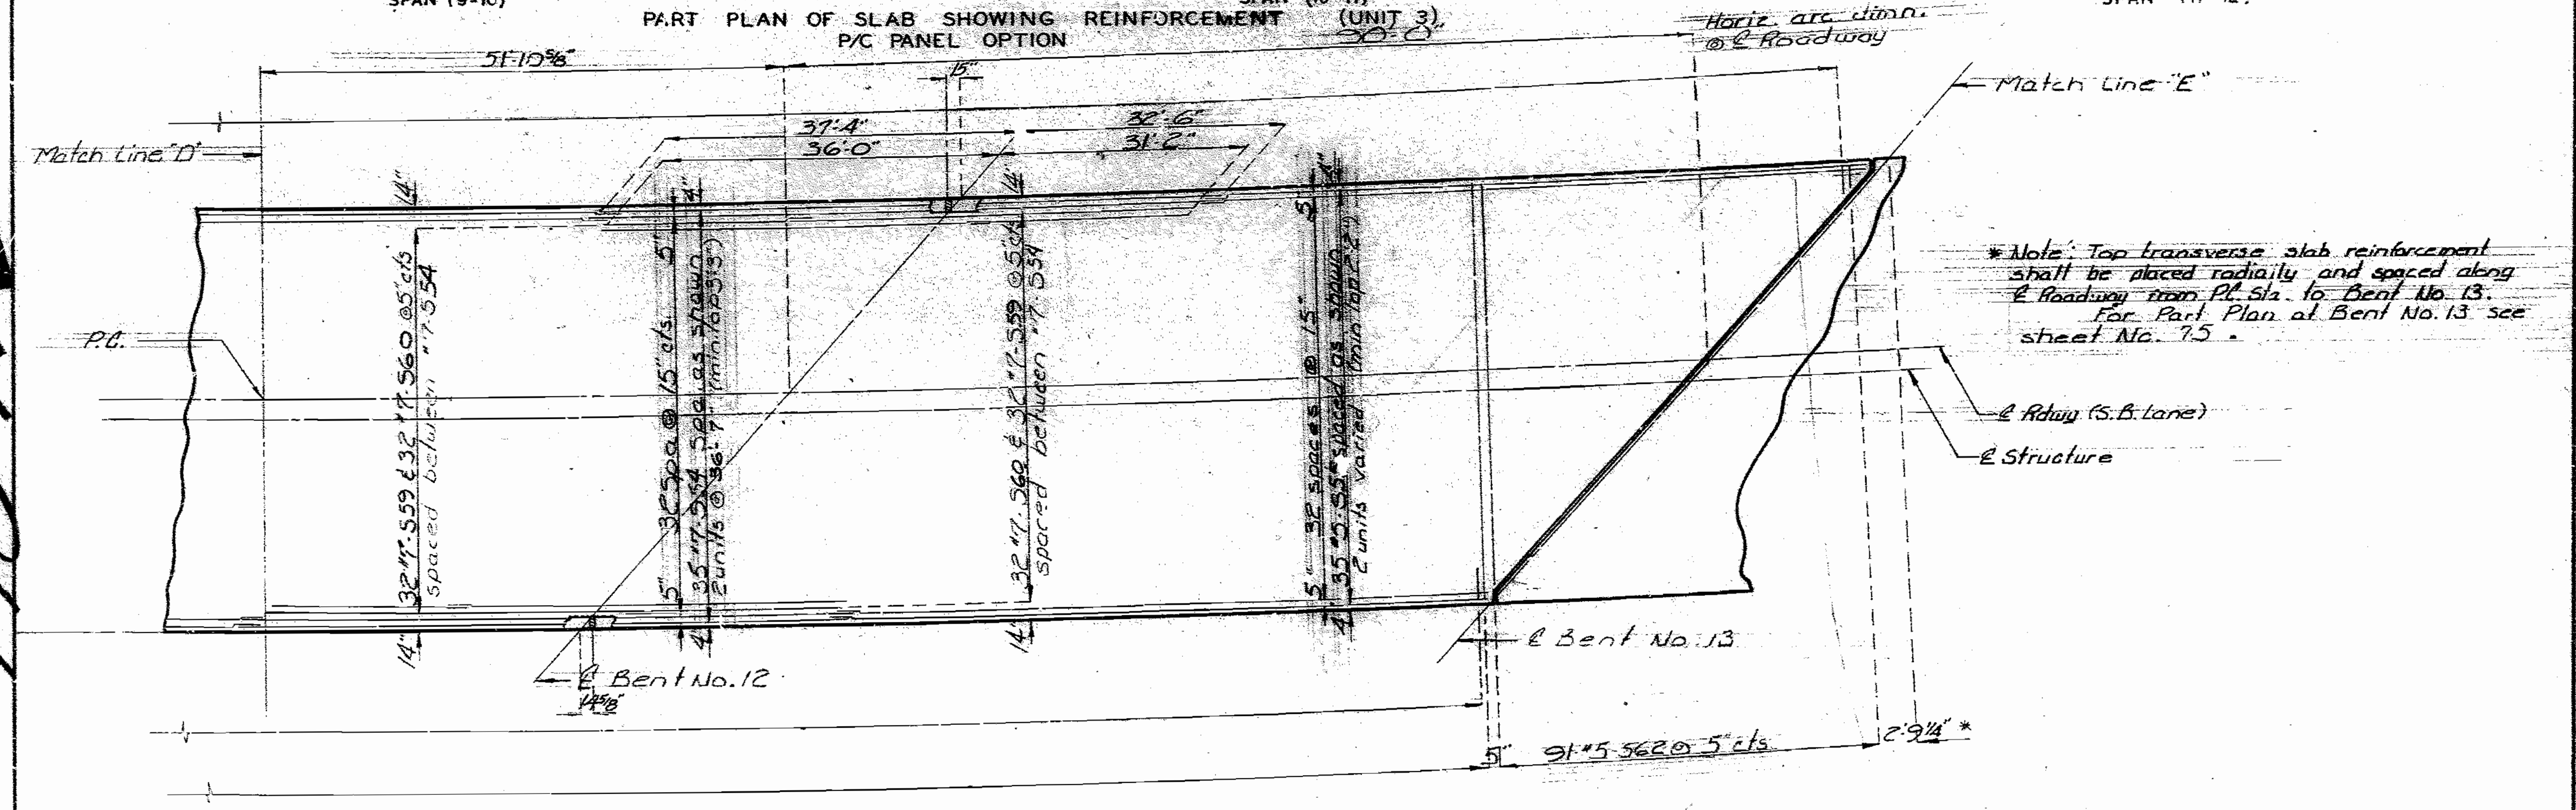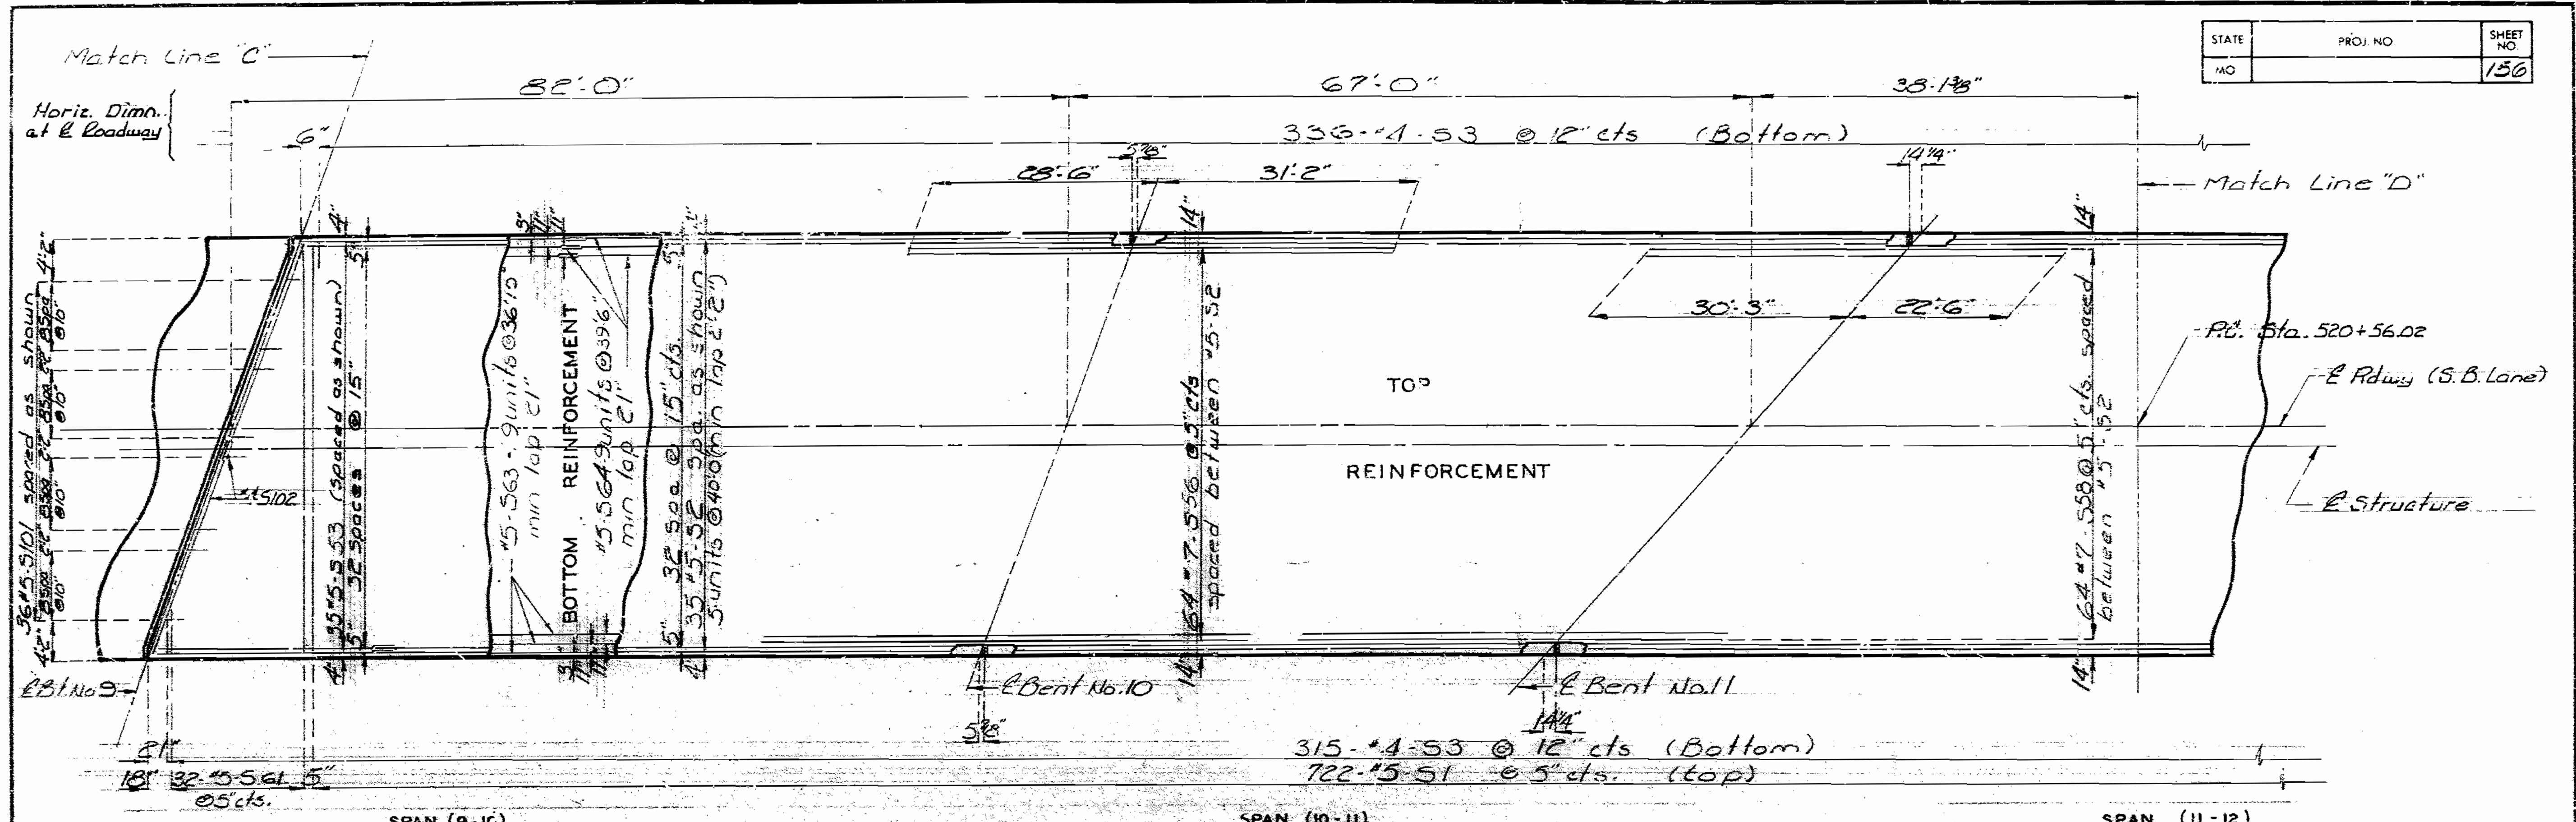

\*Note: Top transverse slab reinforcement shall be placed radially and spaced along Rdwy from P.C. Sta. to Bent No. 13. For Part Plan of Bent No. 13 see sheet No. 75.

788172


DETAILED MAR. 1988  
CHECKED March 1989

Note: This drawing is not to scale. Follow dimensions.


Sheet No. 76 of 98



STATE	PROJ NO	SHEET NO
MO		157

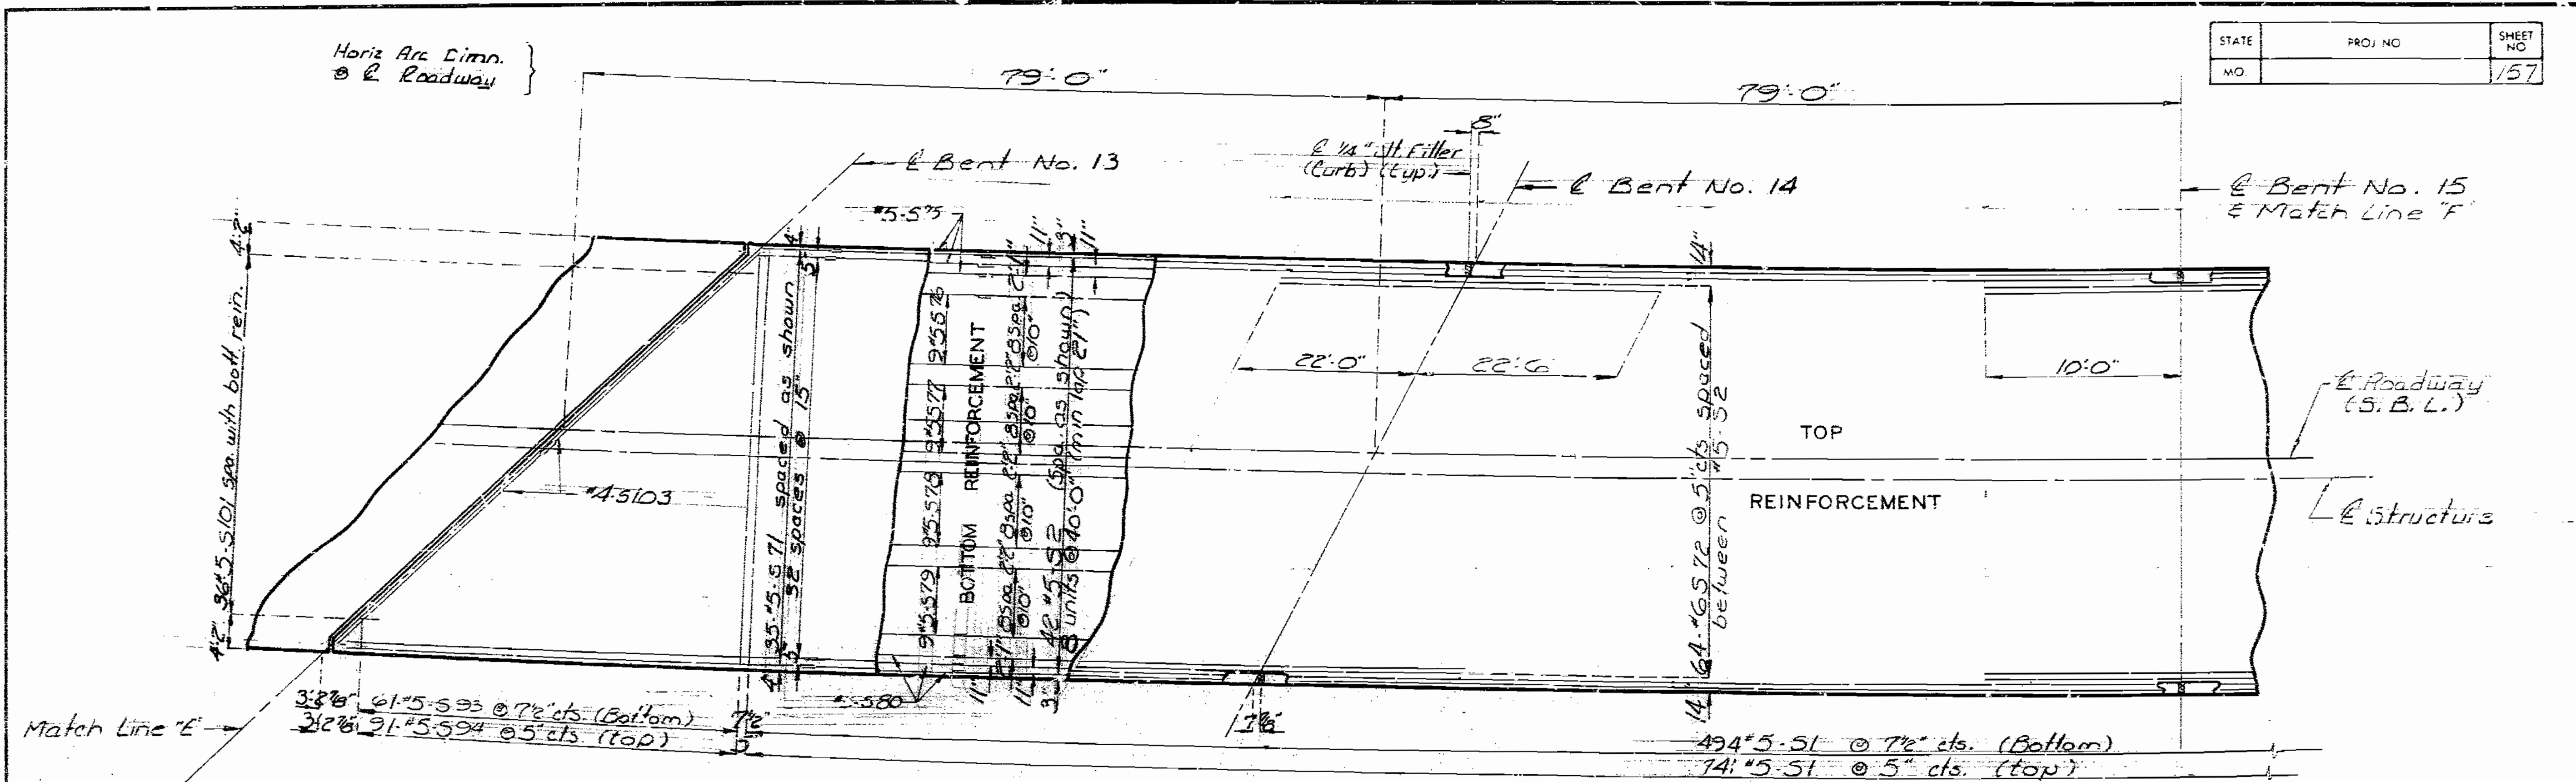

SPAN (13-14) PART PLAN OF SLAB SHOWING REINFORCEMENT CAST-IN-PLACE (UNIT 4) SPAN (14-15)

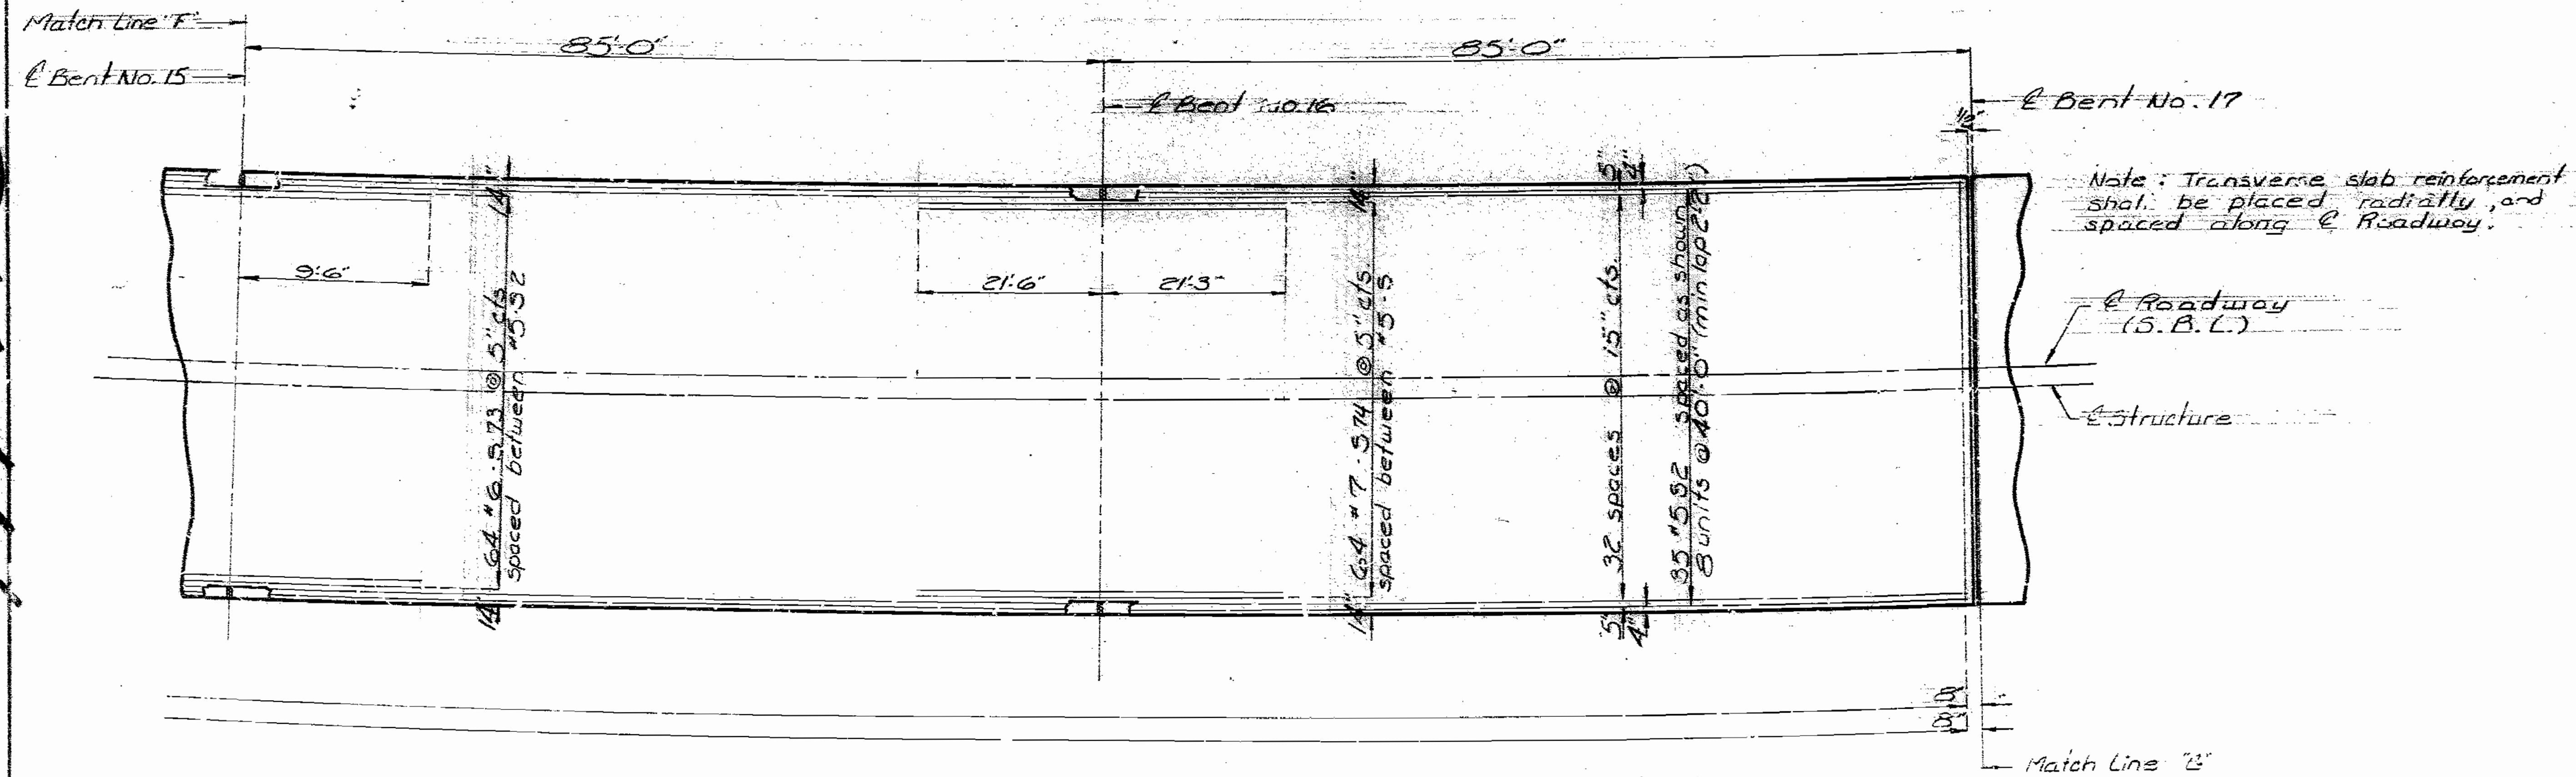

SPAN (15-16) PART PLAN OF SLAB SHOWING REINFORCEMENT CAST-IN-PLACE (UNIT 4) SPAN (16-17)

DETAILED MAR 1988  
 CHECKED Out 1988



Note: This drawing is not to scale. Follow dimensions

Sheet No. 77 of 98


JACKSON COUNTY

A-2745


STATE	PROJ. NO.	SHEET NO.
MJ		158

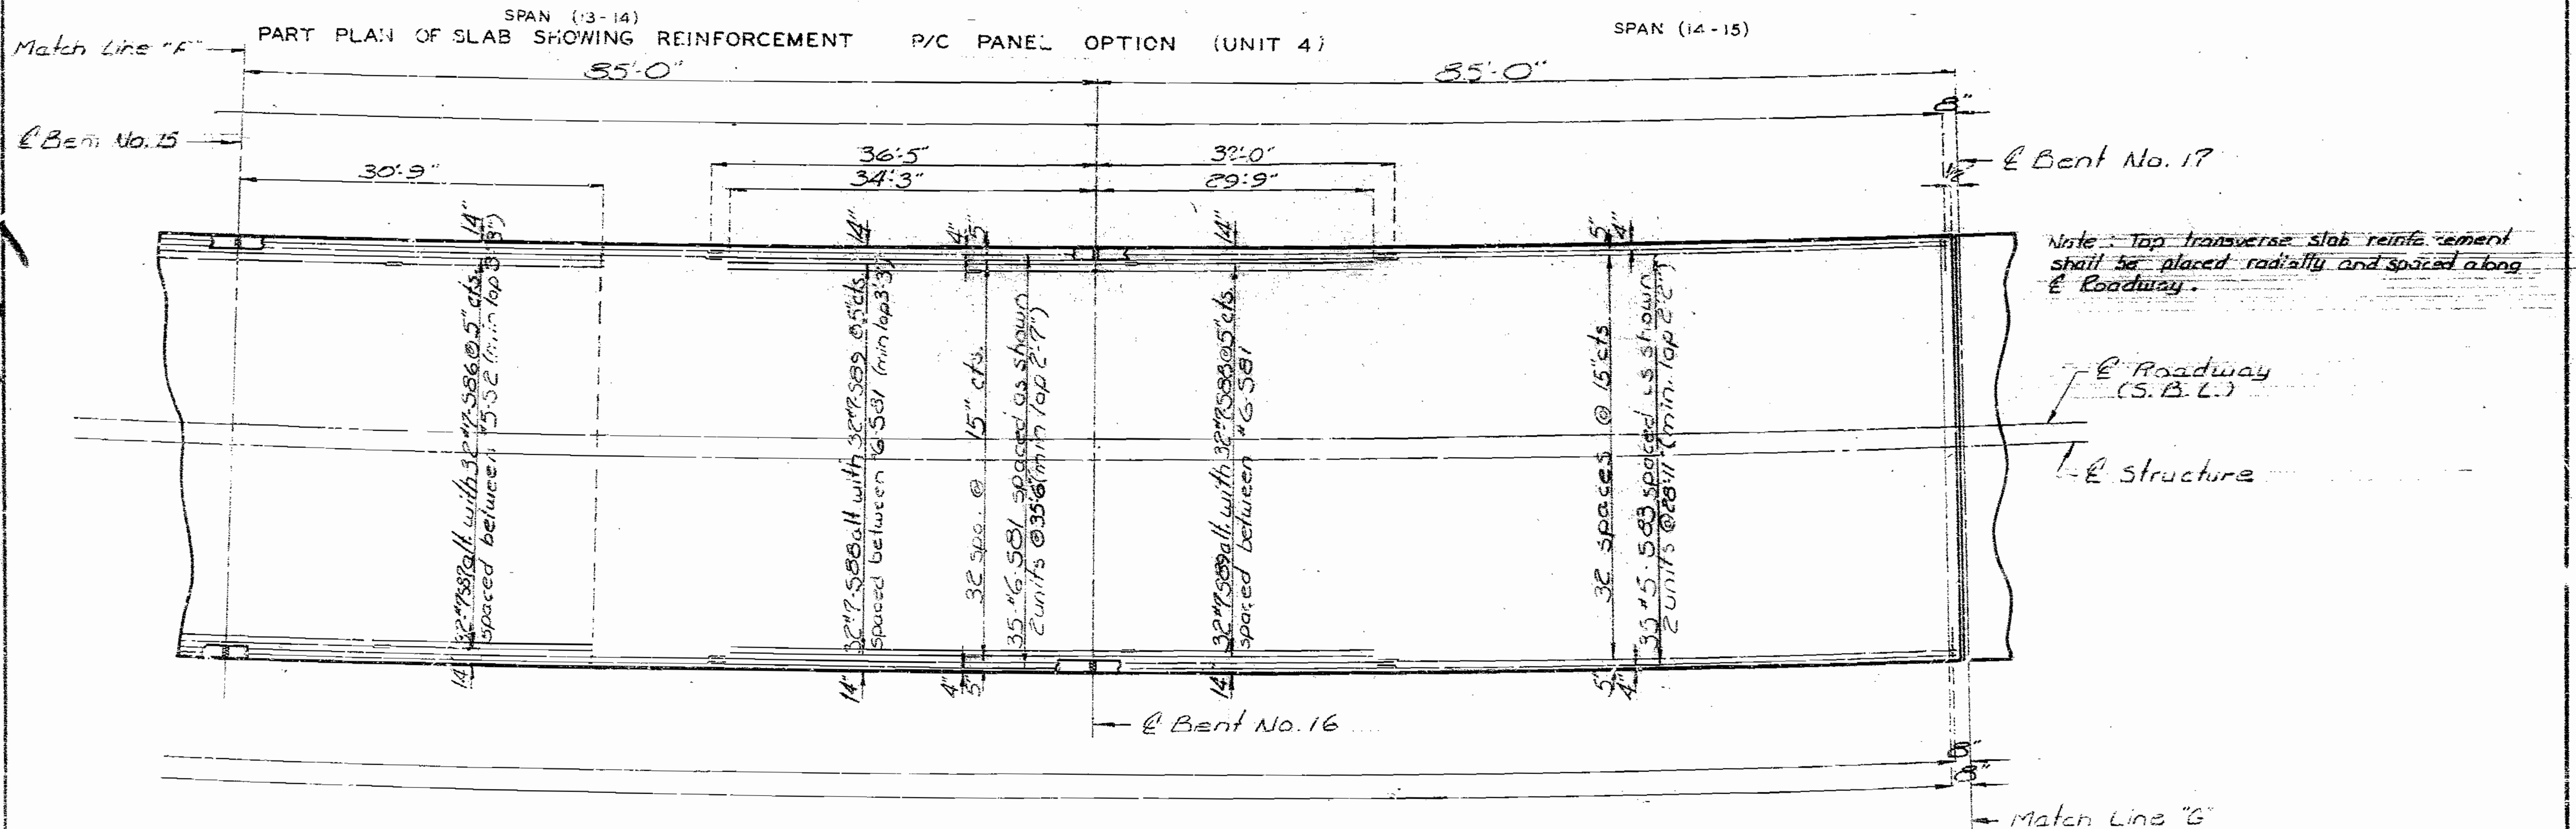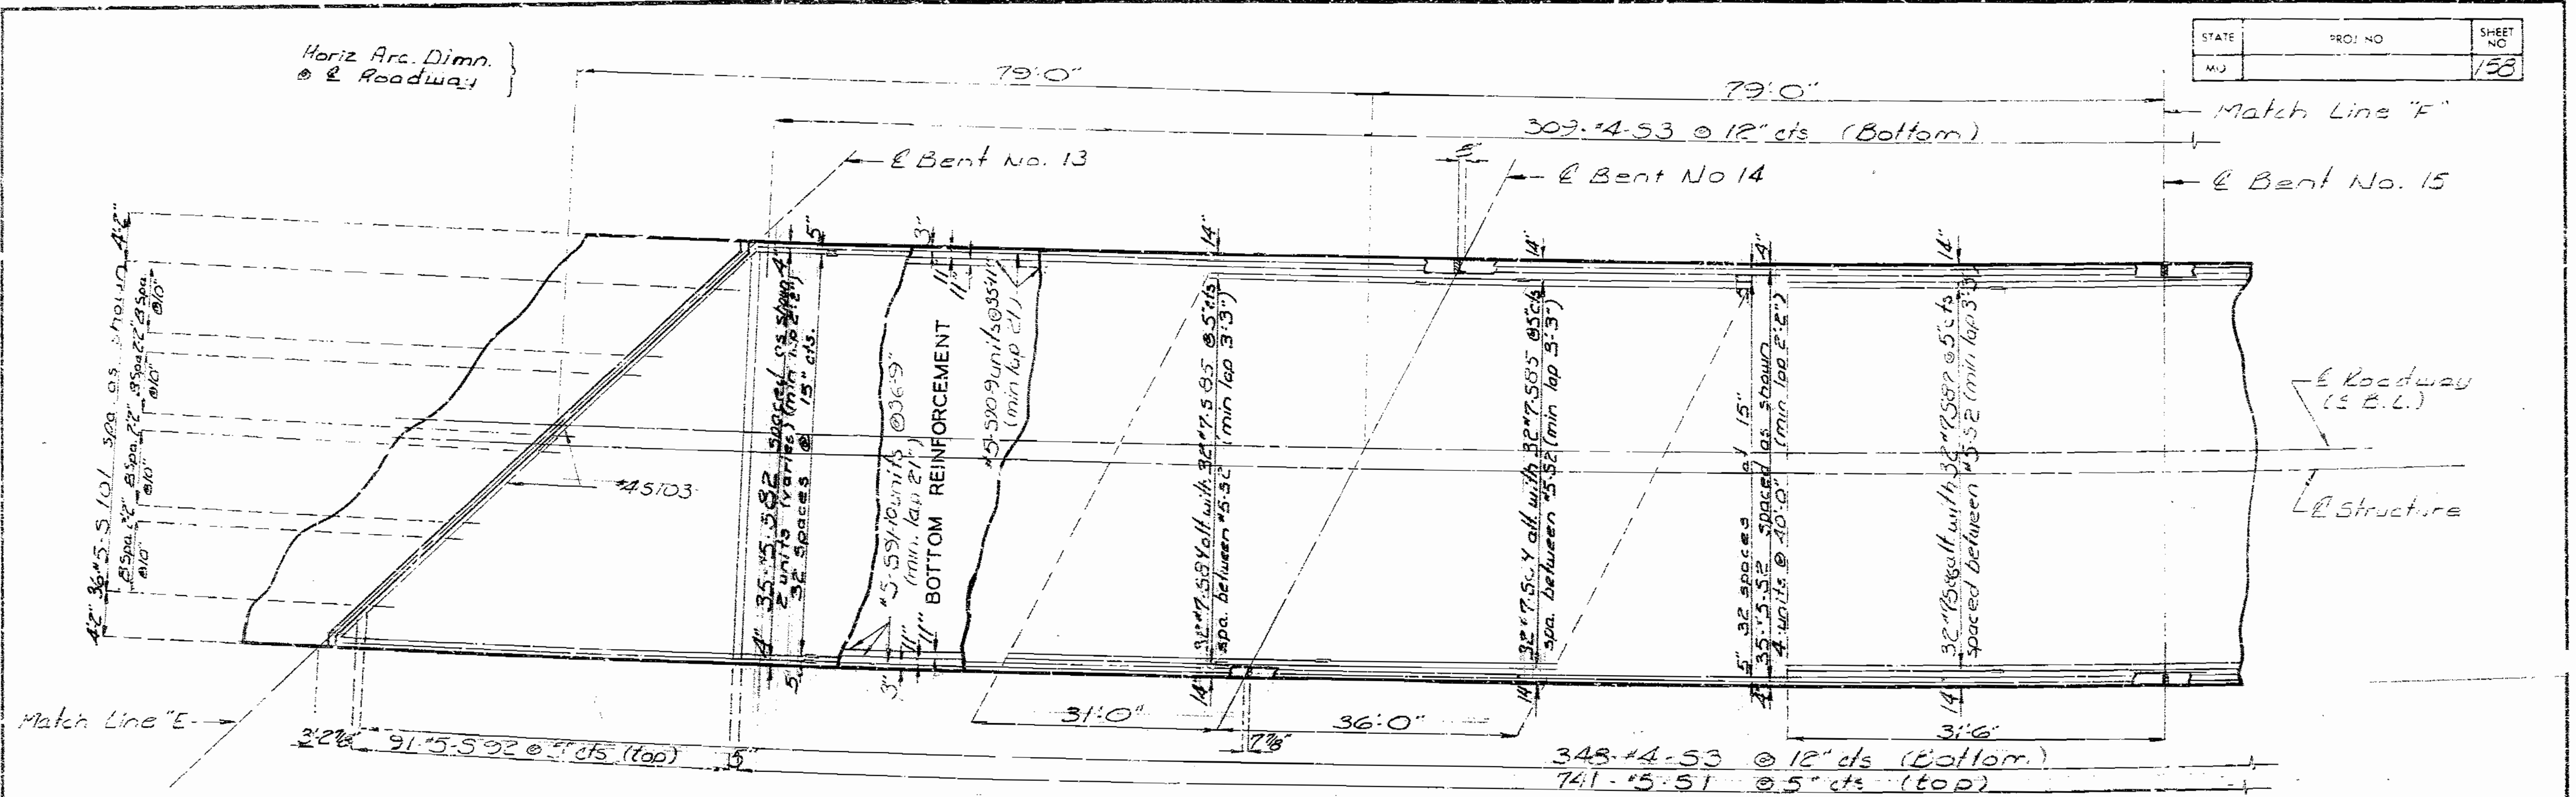

STATE	PROJ. NO.	SHEET NO.
MO		159

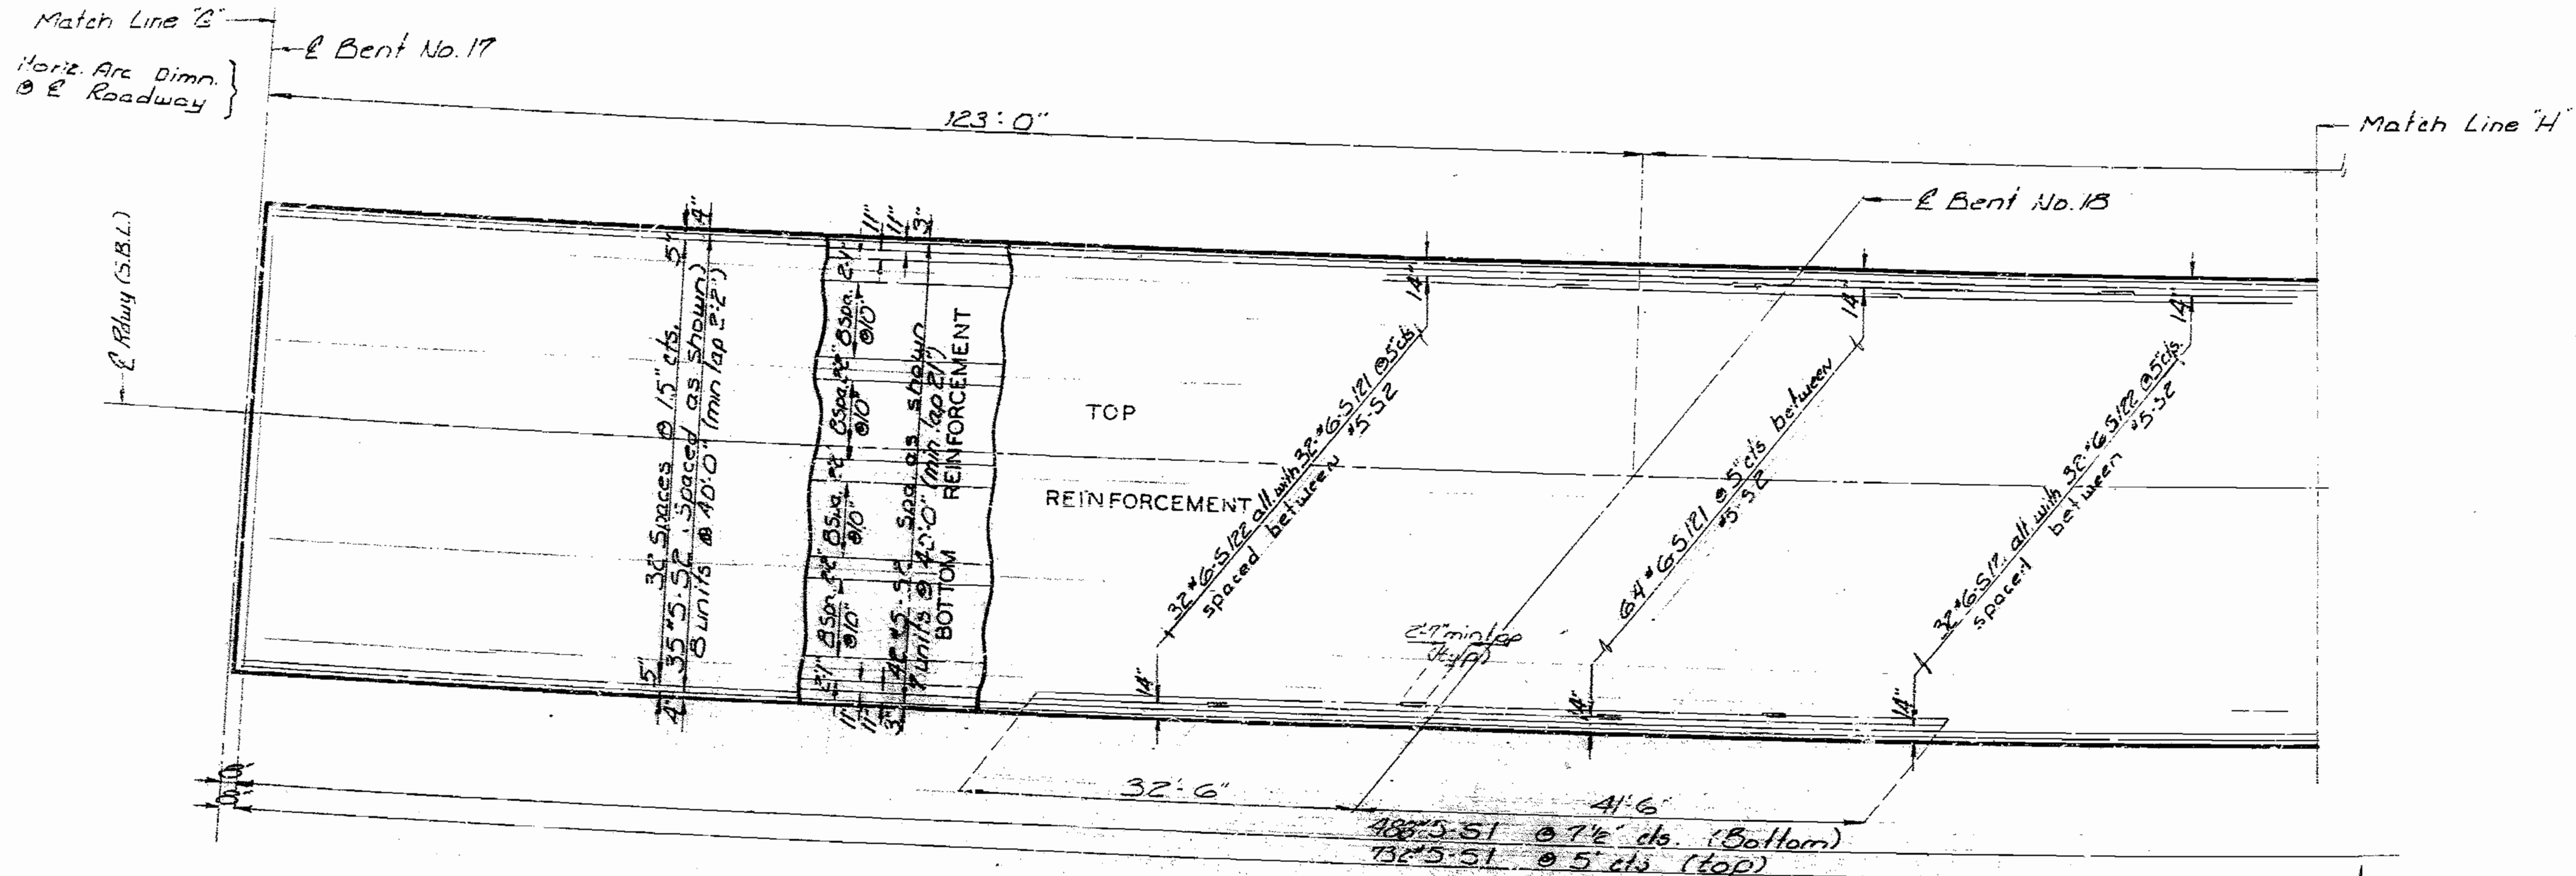

SPAN (17-18)  
PART PLAN OF SLAB SHOWING REINFORCEMENT (CIP & S.I.P. OPTION) (UNIT 5)

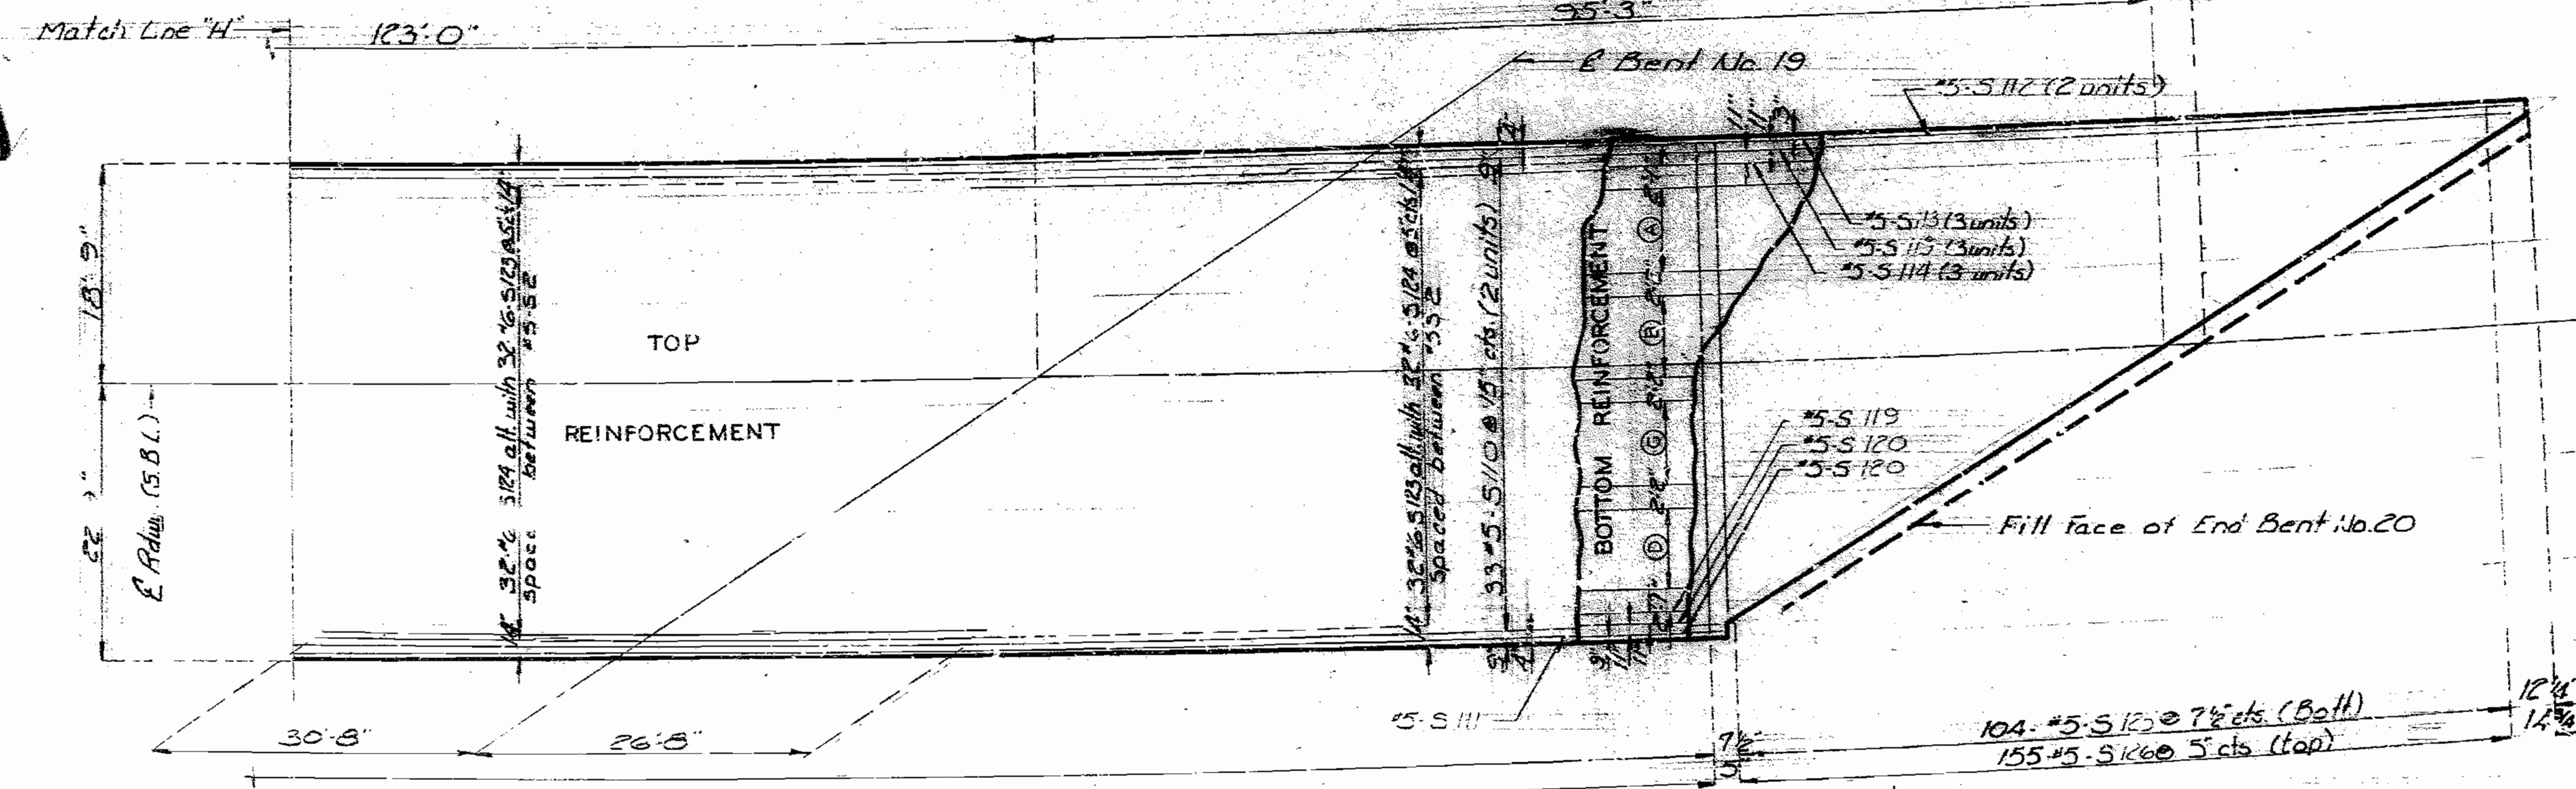

SPAN (19-20)  
PART PLAN OF SLAB SHOWING REINFORCEMENT (CIP & S.I.P. OPTION) (UNIT 5)

- (A) 3 #5-S115 @ 10' cts. (3 units)
- (B) 3 #5-S116 @ 10' cts. (3 units)
- (C) 2 #5-S117 @ 10' cts. (2 units)
- (D) 2 #5-S118 @ 10' cts. (2 units)

Note: Transverse slab reinforcement shall be placed radially and spaced along E roadway.



20175

DETAILED JULY 1988  
CHECKED 1989



Note: This drawing is not to scale. Follow dimensions.

Sheet No. 79 of 98

STATE	PROJ. NO.	SHEET NO.
MO		160

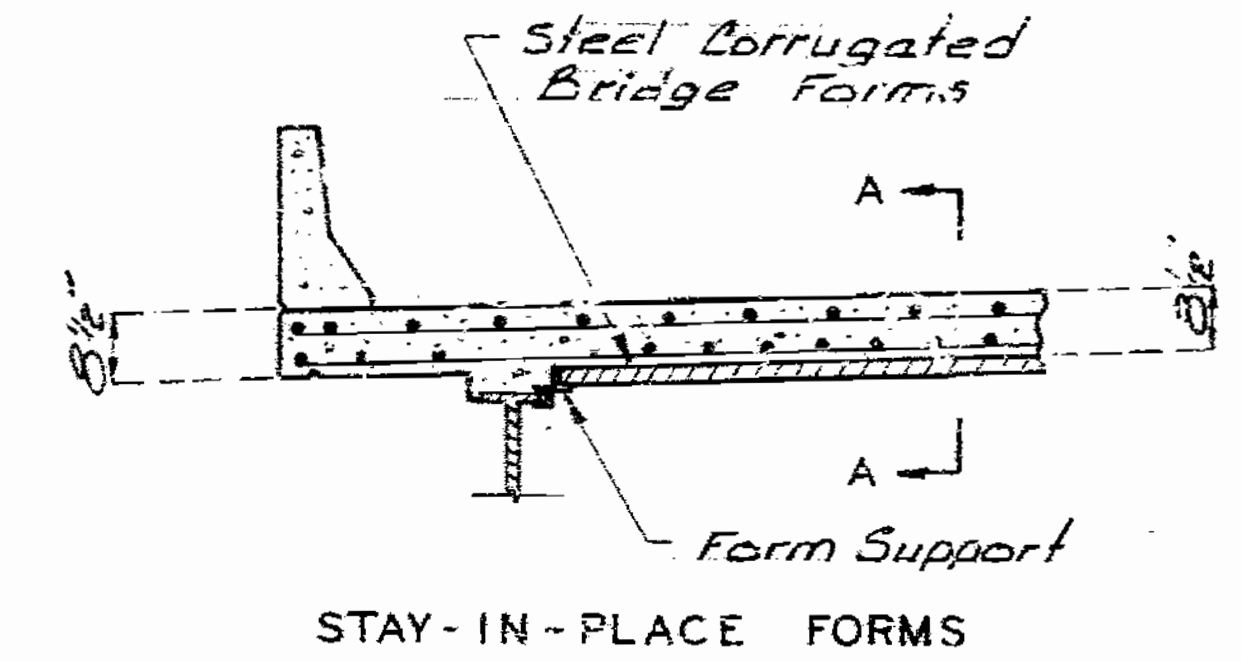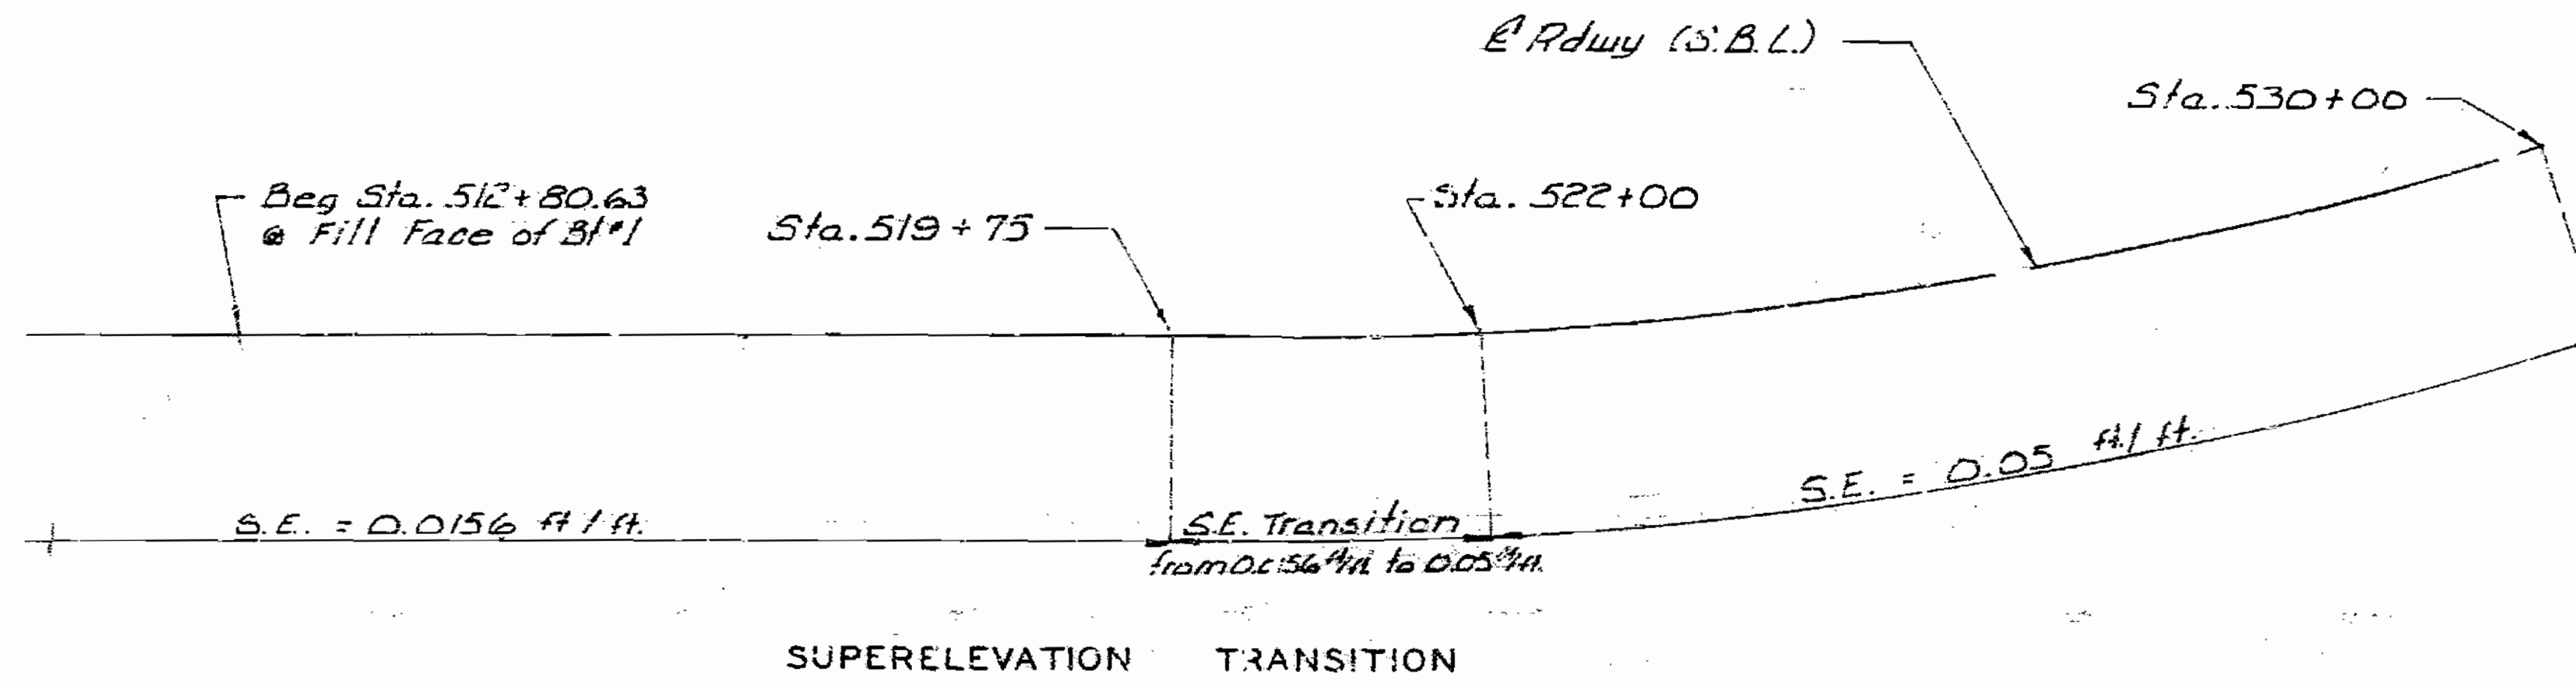

Stay-in-Place Forms  
 Note: To determine the haunch for the stay-in-place alternate, add 1/2" to the haunch for the cast-in-place alternate.

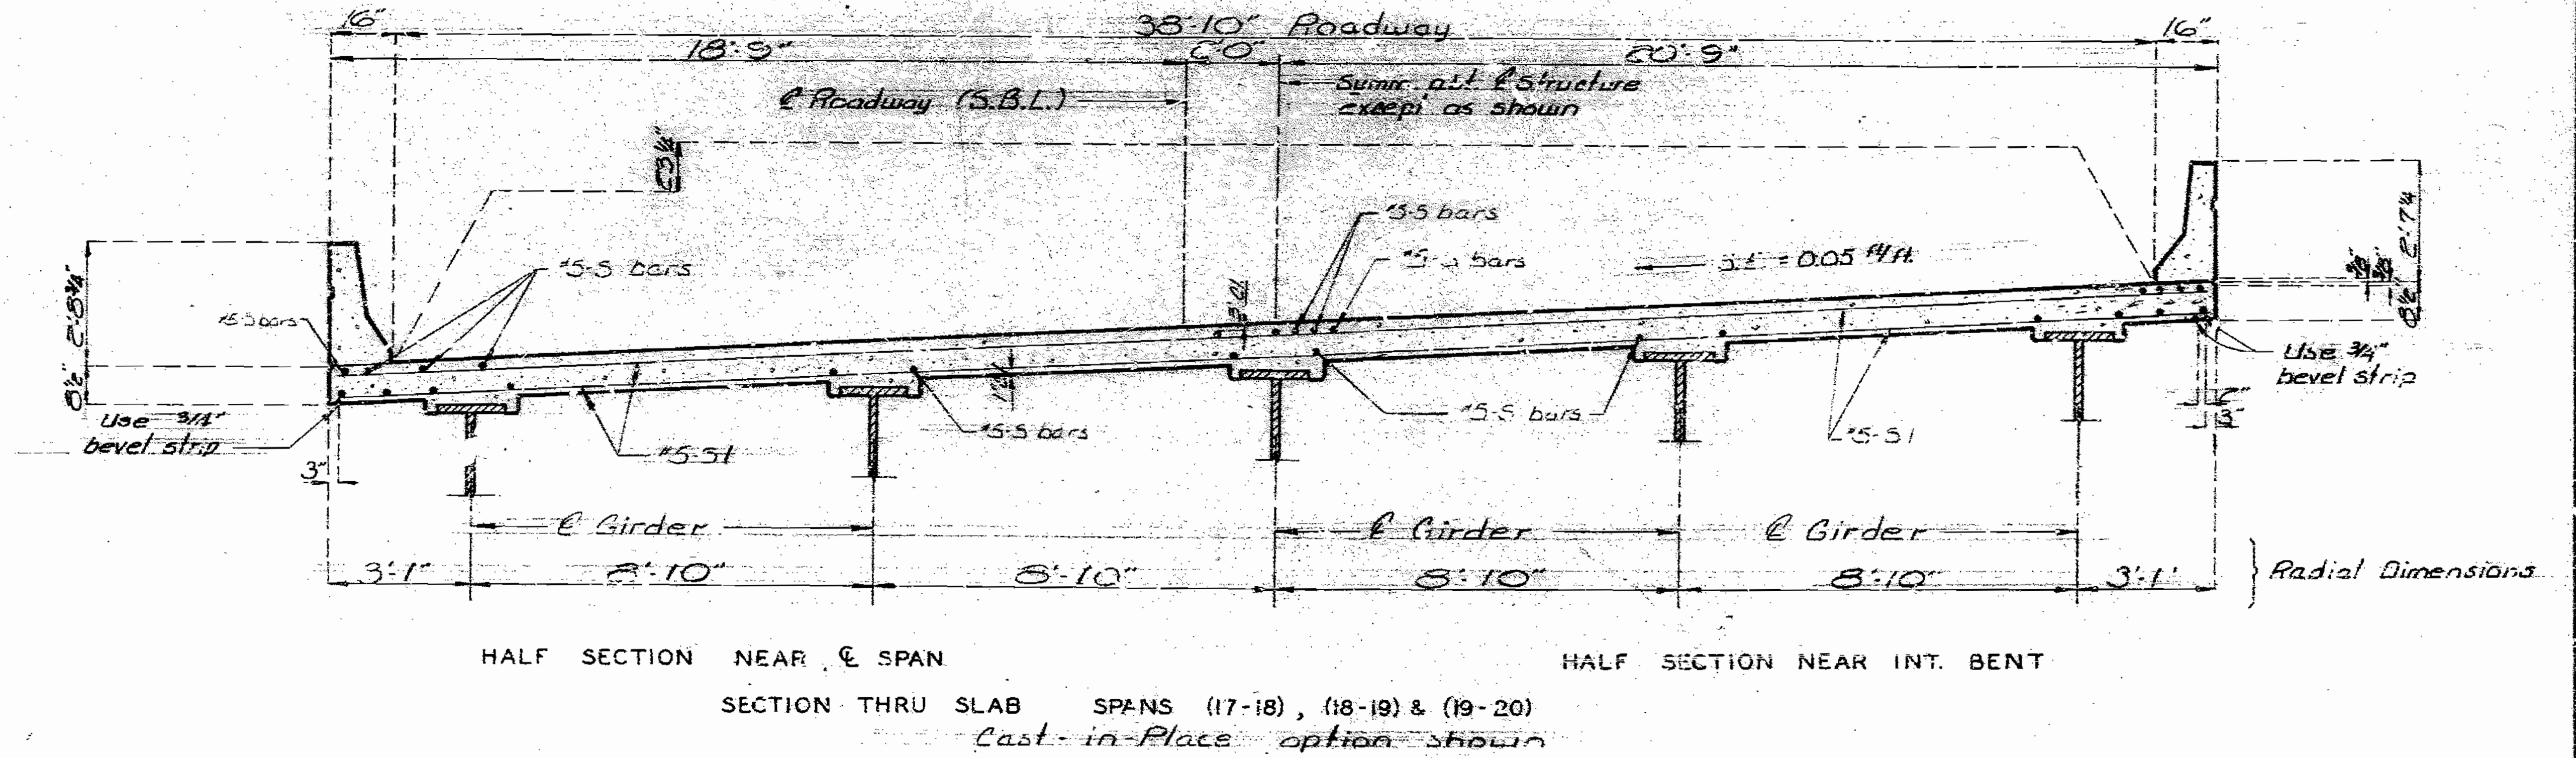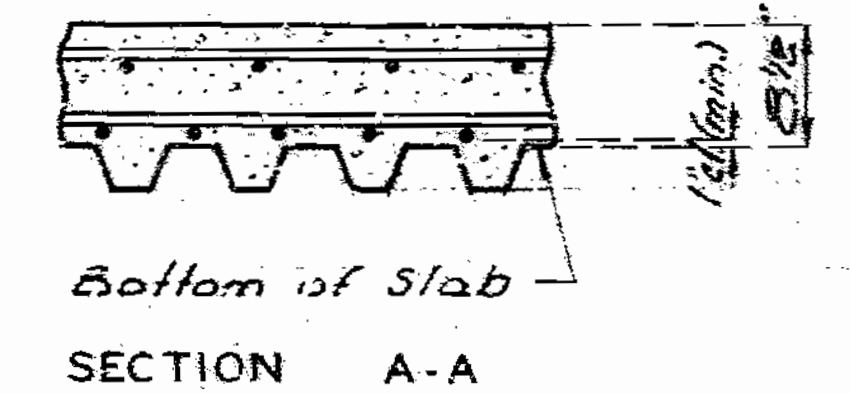

2008/1/2

UNIT NO. 3 & 4	SEQUENCE OF POURS							MINIMUM RATE OF POUR (CUBIC YARDS PER HOUR)
	DIRECTION							
BASIC SEQUENCE	1	2	3	4	5	6	7	25
EITHER DIRECTION								
ALTERNATE POURS TO THE BASIC SKIP SEQUENCE ARE SUBJECT TO THE APPROVAL OF THE ENGINEER IN ACCORDANCE WITH SECTION 703.3.12.4 OF MISSOURI STANDARD SPECIFICATIONS.								
ALTERNATE "A" POURS	1	7 + 2	6 + 3	5 + 4				30
	END TO 7	1 TO 6	2 TO 5	3 TO END				
ALTERNATE "B" POURS	1 + 7 + 2	6 + 3	5 + 4				30	
	END TO 6	2 TO 5	3 TO END					
ALTERNATE "C" POURS	1 + 7 + 2	6 + 3 + 5 + 4				30		
	END TO 6	2 TO END						
ALTERNATE "D" POURS	1 + 7 + 2 + 6 + 3 + 5 + 4						30	
	END TO END							

UNIT NO. 5	SEQUENCE OF POURS					MINIMUM RATE OF POUR (CUBIC YARDS PER HOUR)	
	DIRECTION					NO RETARDER	WITH RETARDER
BASIC SEQUENCE	1	2	3	4	5	25	
EITHER DIRECTION							
ALTERNATE POURS TO THE BASIC SKIP SEQUENCE ARE SUBJECT TO THE APPROVAL OF THE ENGINEER IN ACCORDANCE WITH SECTION 703.3.12.4 OF MISSOURI STANDARD SPECIFICATIONS.							
ALTERNATE "A" POURS	1 + 5 + 2	4 + 3				40	
	END TO 4	2 TO END					
ALTERNATE "B" POURS	1 + 5 + 2 + 4 + 3						40
	END TO END						

UNIT NO. 2	SEQUENCE OF POURS									MINIMUM RATE OF POUR (CUBIC YARDS PER HOUR)
	DIRECTION									
BASIC SEQUENCE	1	2	3	4	5	6	7	8	9	25
EITHER DIRECTION										
ALTERNATE POURS TO THE BASIC SKIP SEQUENCE ARE SUBJECT TO THE APPROVAL OF THE ENGINEER IN ACCORDANCE WITH SECTION 703.3.12.4 OF MISSOURI STANDARD SPECIFICATIONS.										
ALTERNATE "A" POURS	1	9 + 2	8 + 3	7 + 4	6 + 5					27
	EITHER DIR.	1 TO 8	2 TO 7	3 TO 6	4 TO END					
ALTERNATE "B" POURS	1 + 9 + 2	8 + 3	7 + 4 + 6 + 5				27			
	END TO 8	2 TO 7	3 TO END							
ALTERNATE "C" POURS	1 + 9 + 2 + 8 + 3	7 + 4 + 6 + 5				27				
	END TO 7	3 TO END								
ALTERNATE "D" POURS	1 + 9 + 2 + 8 + 3 + 7 + 4 + 6 + 5									27
	END TO END									

THE CONTRACTOR SHALL FURNISH AN APPROVED RETARDER TO RETARD THE SET OF THE CONCRETE TO 2.5 HOURS AND SHALL POUR AND SATISFACTORILY FINISH THE SLAB POURS AT THE RATE GIVEN ABOVE.

THE CONCRETE DIAPHRAGM AT THE INTERMEDIATE BENT AND INTEGRAL END BENTS SHALL BE POURED A MINIMUM OF 30 MINUTES AND A MAXIMUM OF 2 HOURS BEFORE THE SLAB IS POURED.

END DIAPHRAGMS AT EXPANSION DEVICES MAY BE POURED WITH A CONSTRUCTION JOINT BETWEEN THE DIAPHRAGM AND SLAB OR MONOLITHIC WITH THE SLAB.

IF THE PRECAST PRESSED PANEL OPTION IS USED, THE VALUES SHOWN FOR THE MINIMUM RATE OF POUR MAY BE REDUCED BY 25%. HOWEVER, IN NO CASE SHALL THE MINIMUM RATE OF POUR BE LESS THAN 25 CU. YD. PER HOUR.

THE CONTRACTOR SHALL POUR AND SATISFACTORILY FINISH THE SLAB POURS AT THE RATE GIVEN. RETARDER, IF USED, SHALL BE AN APPROVED TYPE AND RETARD THE SET OF CONCRETE TO 2.5 HOURS.

FOR UNIT 5 POUR, IF THE BASIC SEQUENCE IS USED A LONGITUDINAL CONST. JT. SHALL BE USED FOR POURS ①, ② & ⑤ AND THE ROADWAY SLAB FINISHED ALONG THE SKEW FOR POURS ①, ② & ⑤.


FOR UNIT 5 POUR, IF ALTERNATE POURS A OR B ARE USED THE LONGITUDINAL CONST. JT. SHALL BE ELIMINATED AND THE ROADWAY SLAB FINISHED RADIALLY.

THE CONTRACTOR SHALL FURNISH AN APPROVED RETARDER TO RETARD THE SET OF THE CONCRETE TO 2.5 HOURS AND SHALL POUR AND SATISFACTORILY FINISH THE SLAB POURS AT THE RATE GIVEN ABOVE.

THE CONCRETE DIAPHRAGM AT THE INTERMEDIATE BENT AND INTEGRAL END BENTS SHALL BE POURED A MINIMUM OF 30 MINUTES AND A MAXIMUM OF 2 HOURS BEFORE THE SLAB IS POURED.

END DIAPHRAGMS AT EXPANSION DEVICES MAY BE POURED WITH A CONSTRUCTION JOINT BETWEEN THE DIAPHRAGM AND SLAB OR MONOLITHIC WITH THE SLAB.

IF THE PRECAST PRESSED PANEL OPTION IS USED, THE VALUES SHOWN FOR THE MINIMUM RATE OF POUR MAY BE REDUCED BY 25%. HOWEVER, IN NO CASE SHALL THE MINIMUM RATE OF POUR BE LESS THAN 25 CU. YD. PER HOUR.

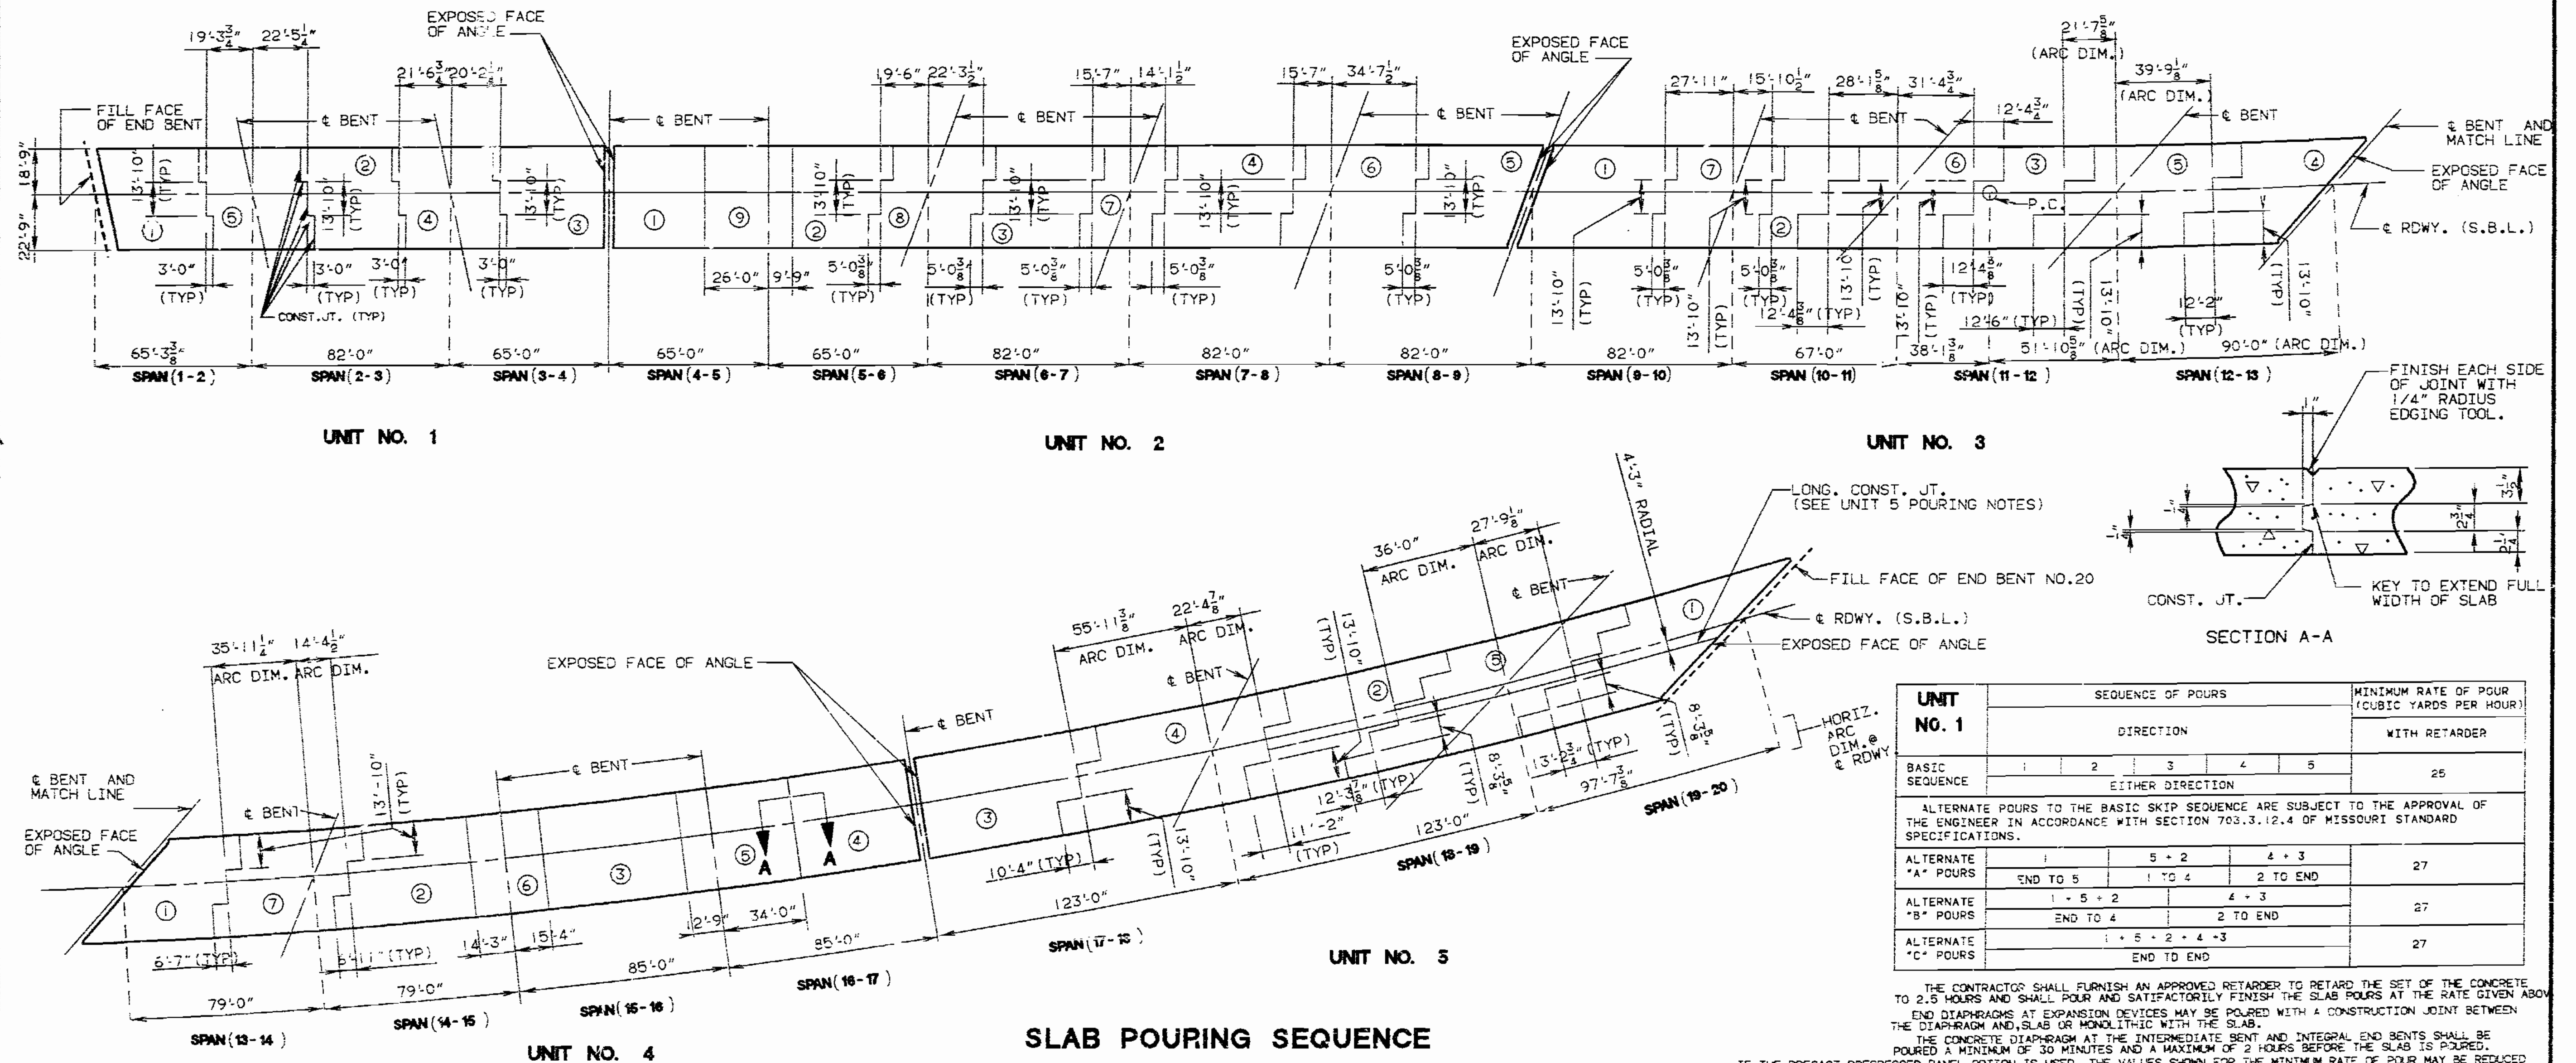

UNIT NO. 1	SEQUENCE OF POURS					MINIMUM RATE OF POUR (CUBIC YARDS PER HOUR)
	DIRECTION					
BASIC SEQUENCE	1	2	3	4	5	25
EITHER DIRECTION						
ALTERNATE POURS TO THE BASIC SKIP SEQUENCE ARE SUBJECT TO THE APPROVAL OF THE ENGINEER IN ACCORDANCE WITH SECTION 703.3.12.4 OF MISSOURI STANDARD SPECIFICATIONS.						
ALTERNATE "A" POURS	1	5 + 2	4 + 3			27
	END TO 5	1 TO 4	2 TO END			
ALTERNATE "B" POURS	1 + 5 + 2	4 + 3				27
	END TO 4	2 TO END				
ALTERNATE "C" POURS	1 + 5 + 2 + 4 + 3					27
	END TO END					

THE CONTRACTOR SHALL FURNISH AN APPROVED RETARDER TO RETARD THE SET OF THE CONCRETE TO 2.5 HOURS AND SHALL POUR AND SATISFACTORILY FINISH THE SLAB POURS AT THE RATE GIVEN ABOVE.

END DIAPHRAGMS AT EXPANSION DEVICES MAY BE POURED WITH A CONSTRUCTION JOINT BETWEEN THE DIAPHRAGM AND SLAB OR MONOLITHIC WITH THE SLAB.

THE CONCRETE DIAPHRAGM AT THE INTERMEDIATE BENT AND INTEGRAL END BENTS SHALL BE POURED A MINIMUM OF 30 MINUTES AND A MAXIMUM OF 2 HOURS BEFORE THE SLAB IS POURED.

IF THE PRECAST PRESSED PANEL OPTION IS USED, THE VALUES SHOWN FOR THE MINIMUM RATE OF POUR MAY BE REDUCED BY 25%. HOWEVER, IN NO CASE SHALL THE MINIMUM RATE OF POUR BE LESS THAN 25 CU. YD. PER HOUR.

DETAILED SEPT. 1988  
CHECKED FEB. 1989


NOTE: THIS DRAWING IS NOT TO SCALE. FOLLOW DIMENSIONS.

SHEET NO. 81 OF 98.

JACKSON COUNTY


A-2745

STATE	PROJ. NO.	SHEET NO.
MO		162

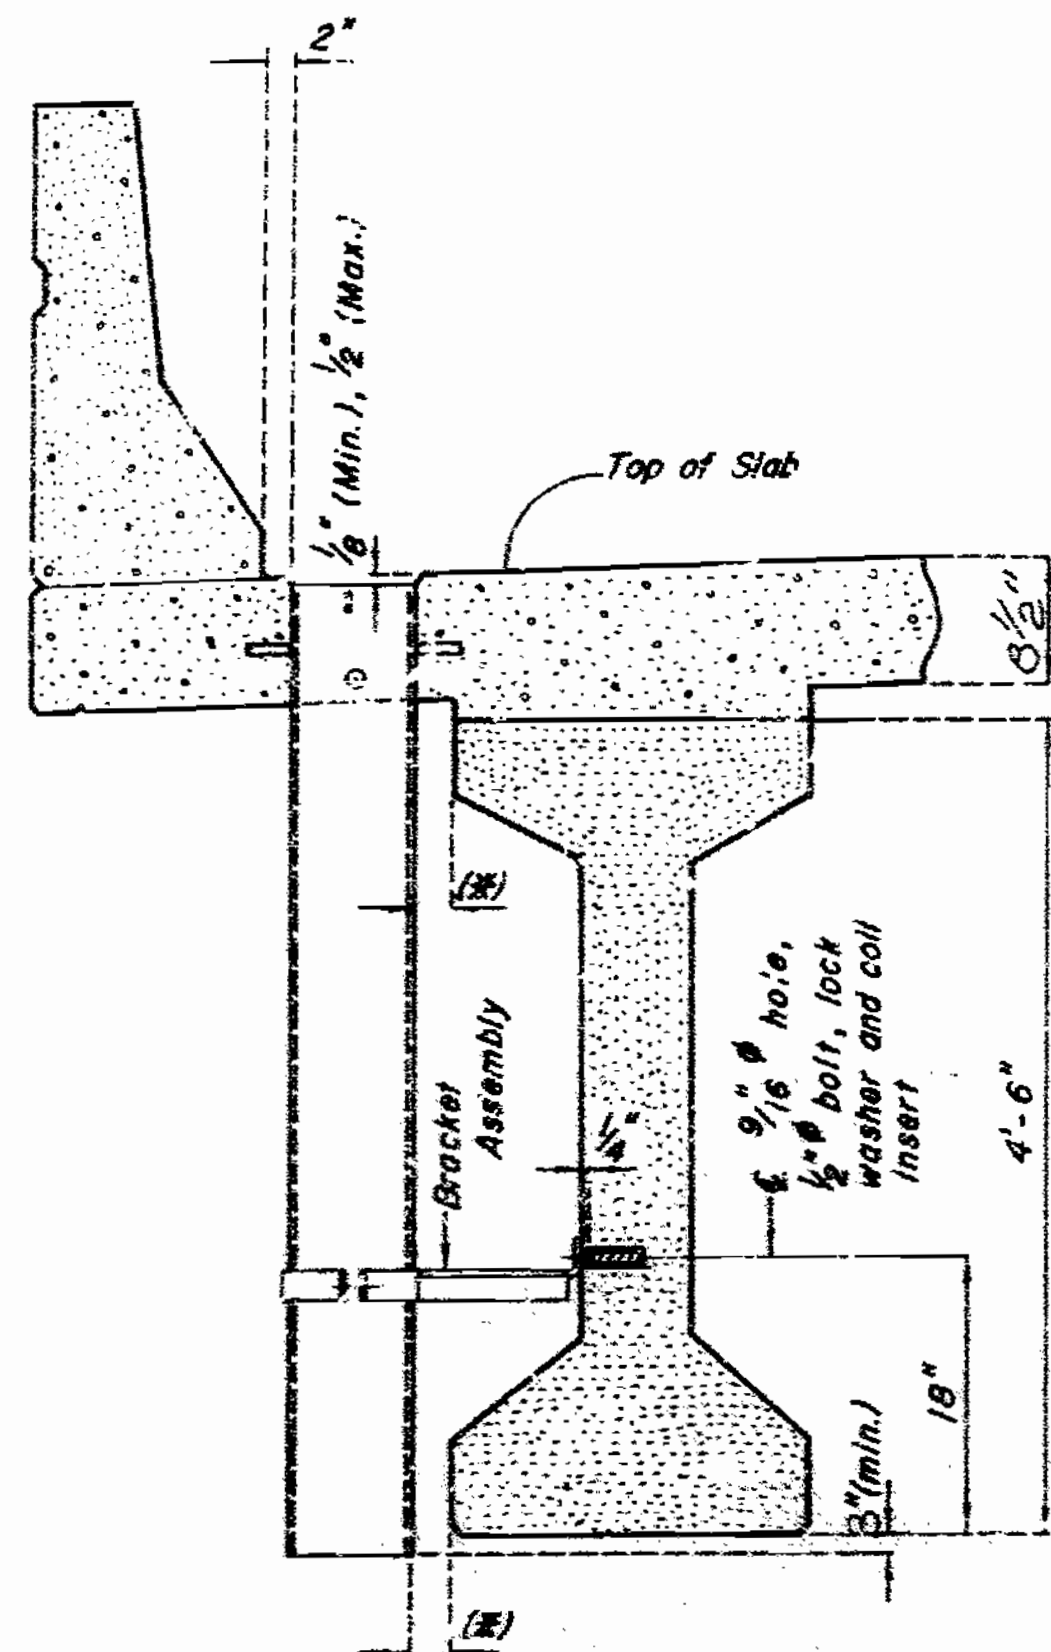


PART ELEVATION OF SLAB AT DRAIN


(E) If dimension is less than 1", drains shall be placed parallel to roadway, otherwise place drains transverse to roadway.

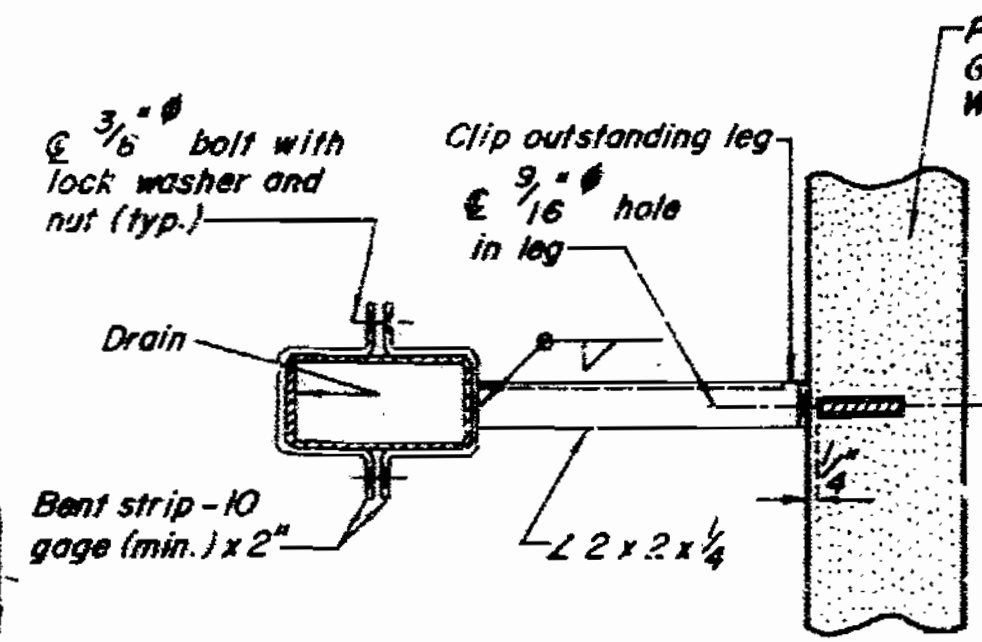


PART SECTION SHOWING BRACKET ASSEMBLY

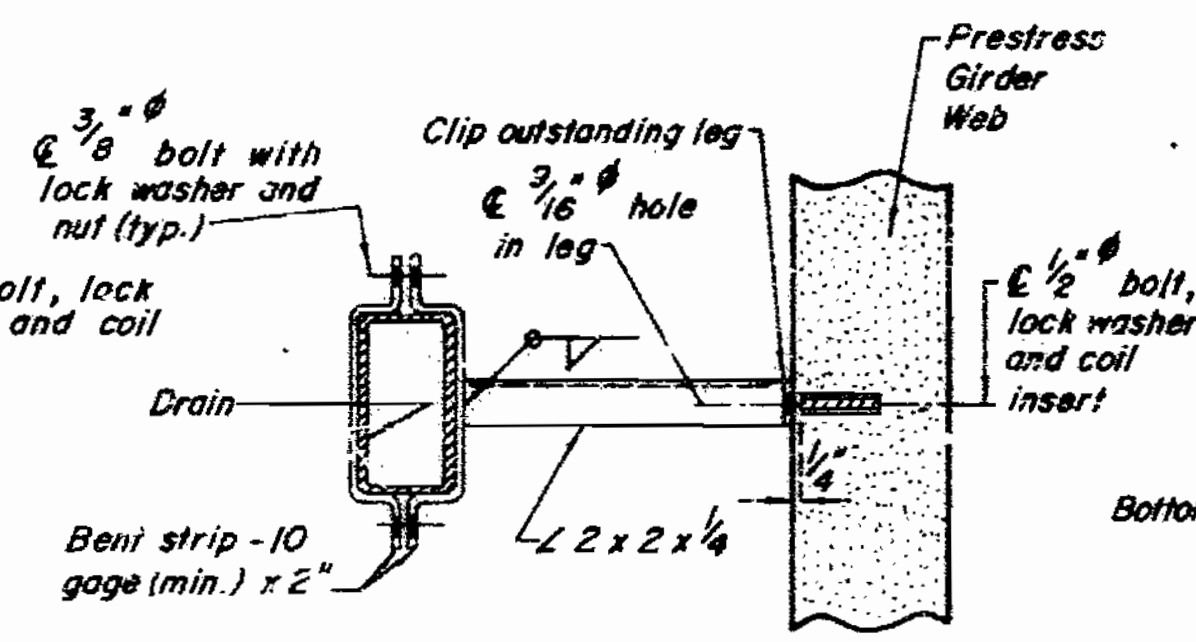


PART SECTION SHOWING BRACKET ASSEMBLY

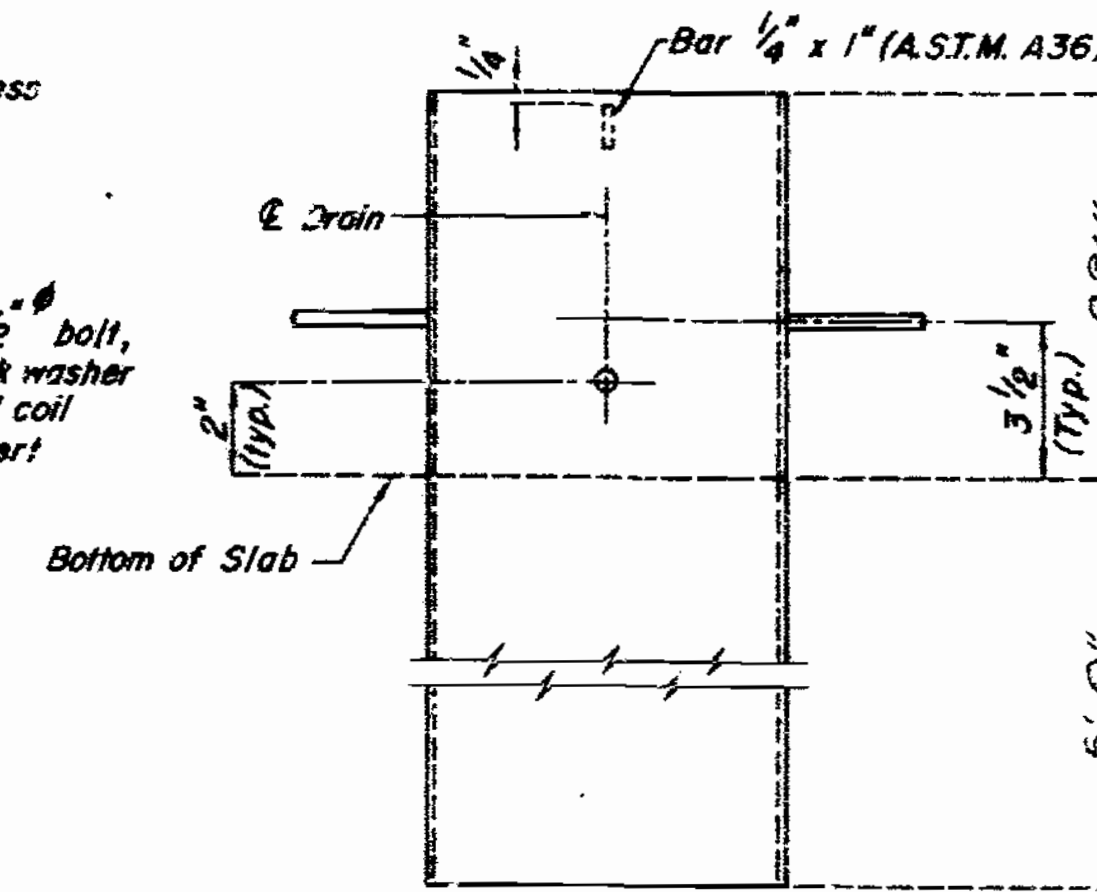


ELEVATION OF DRAIN

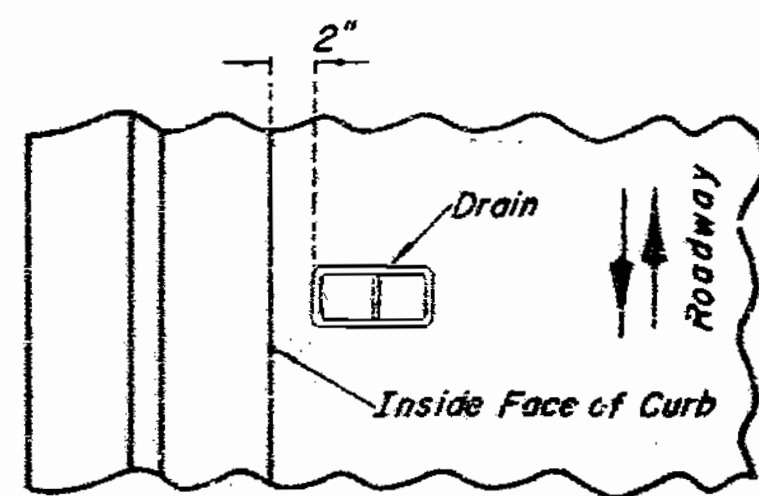

PART PLAN OF SLAB AT DRAIN  
DETAILS OF DRAINS TRANSVERSE TO ROADWAY


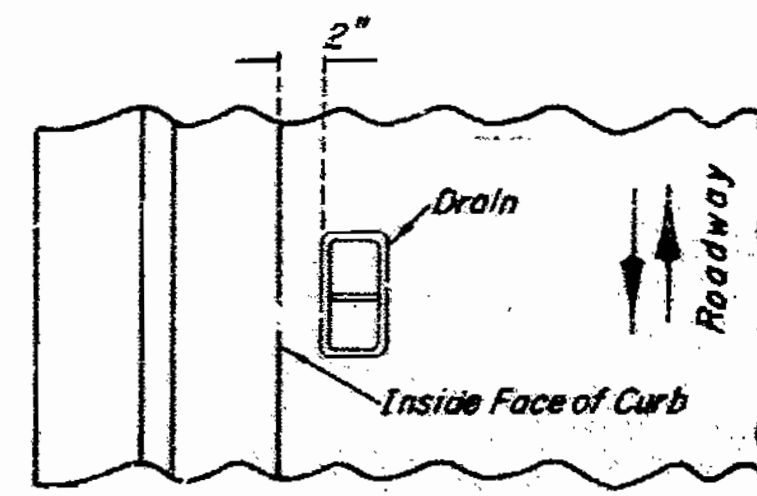


PART PLAN OF SLAB AT DRAIN  
DETAILS OF DRAINS PARALLEL TO ROADWAY

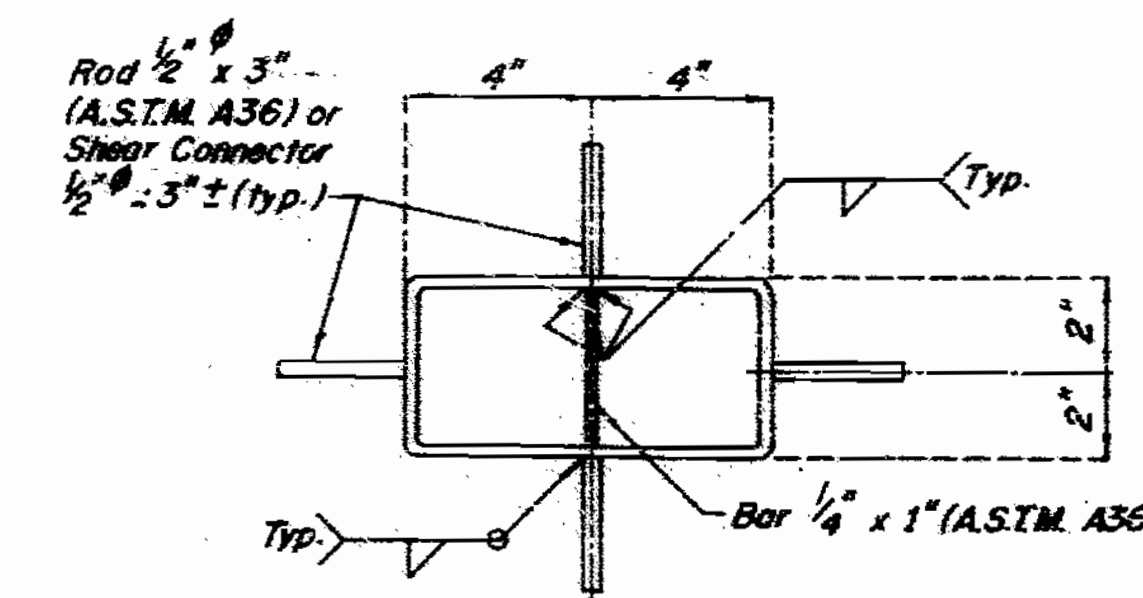


PLAN OF DRAIN

SLAB DRAIN DETAILS

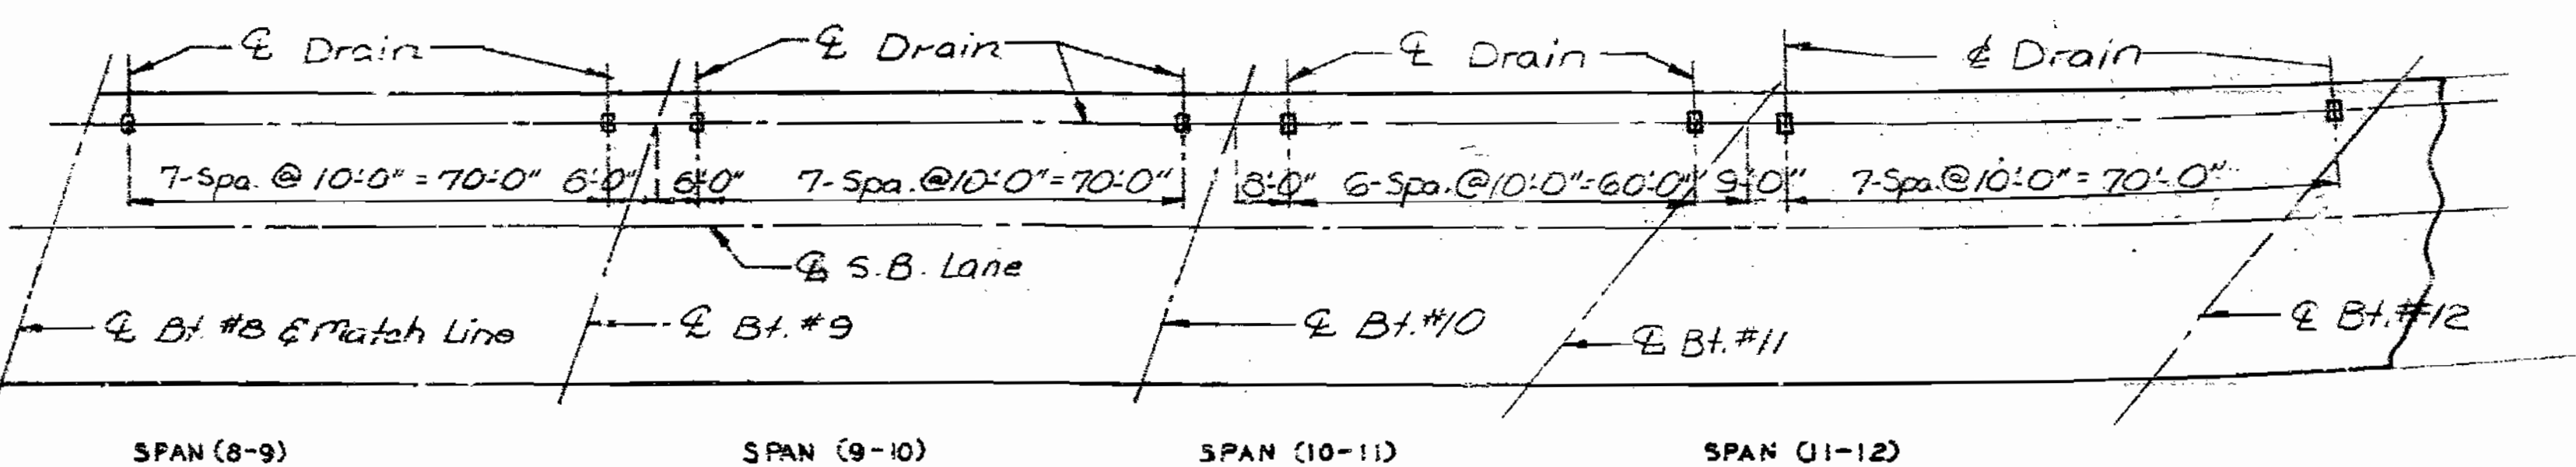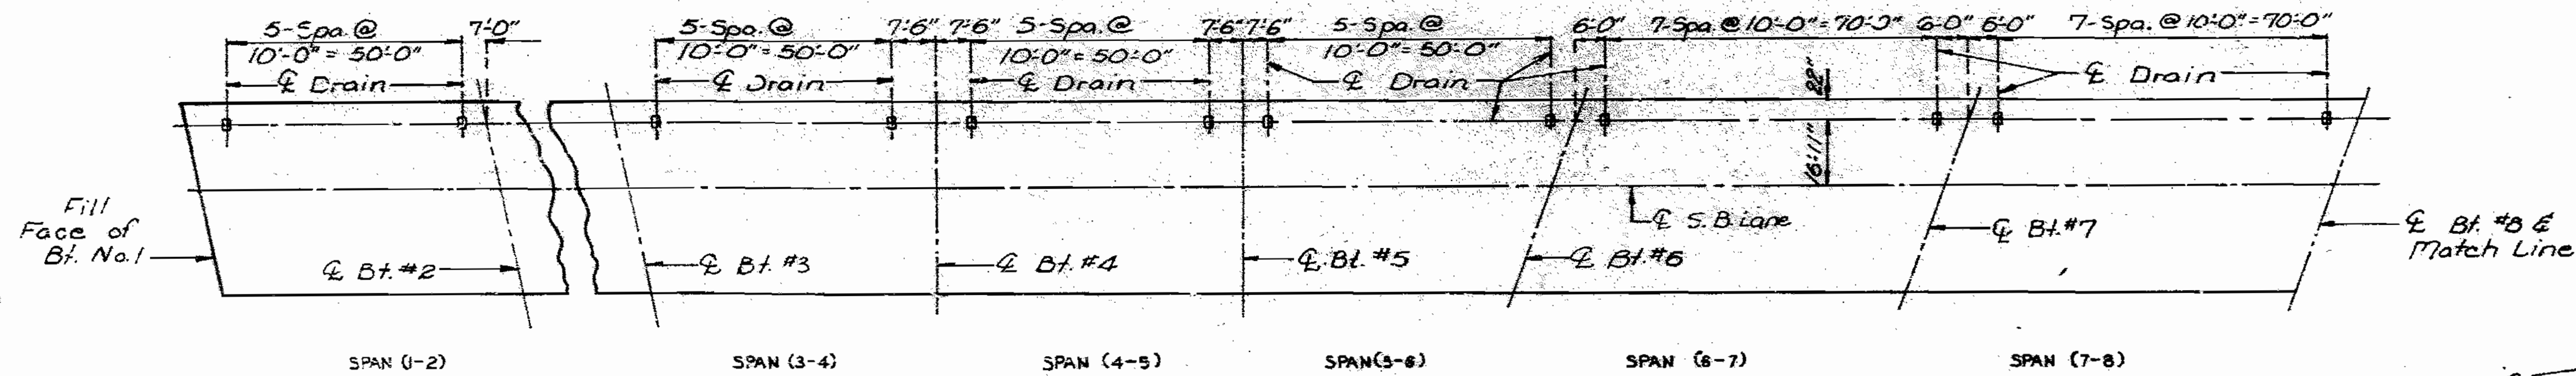

PART PLAN OF SLAB SHOWING DRAINS

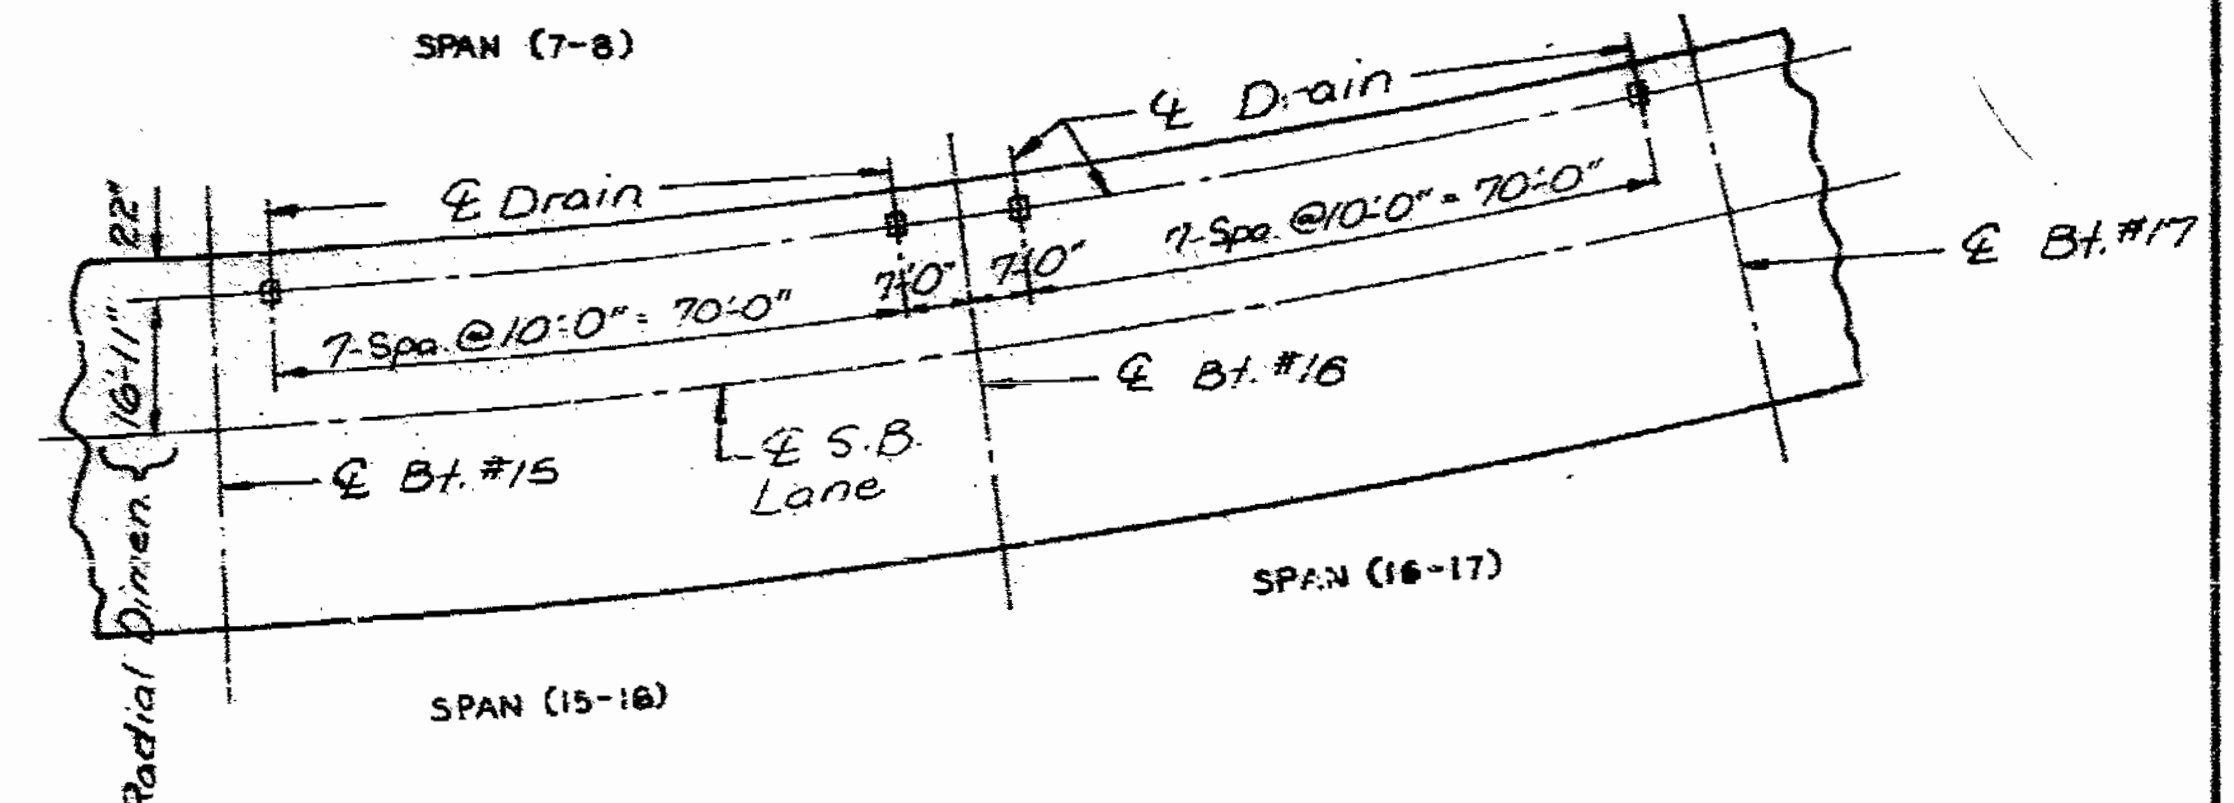

204 170  
 DETAILED July 1989  
 CHECKED July 1989


Note: This drawing is not to scale. Follow dimensions.

Sheet No. 82 of 98

JACKSON COUNTY


A-2745

STATE	PROJ. NO.	SHEET NO.
M.O.		103

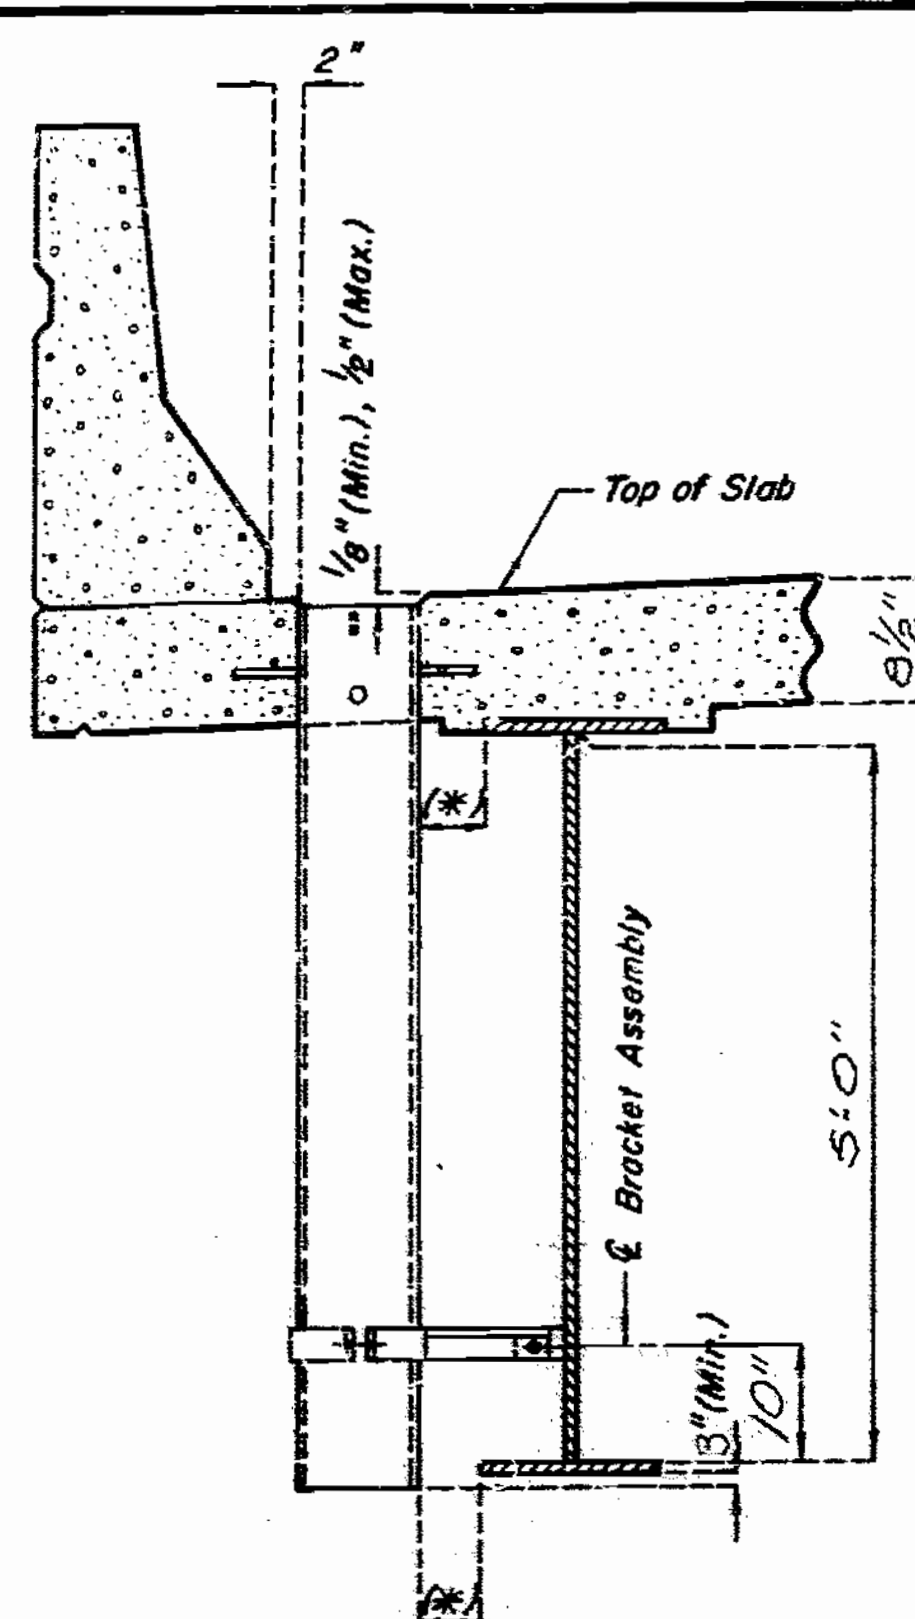


PART ELEVATION OF SLAB AT DRAIN


(\*.) If dimension is less than 1", drains shall be placed parallel to roadway, otherwise place drains transverse to roadway.

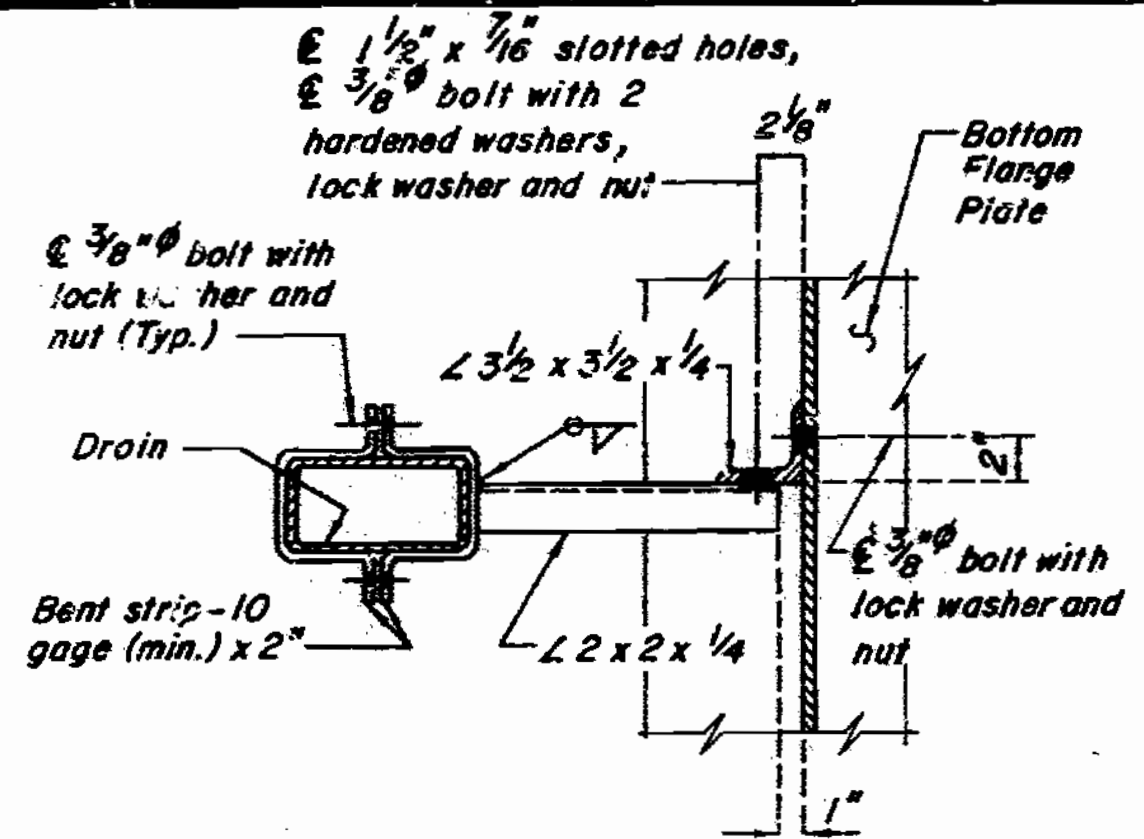

PART SECTION SHOWING BRACKET ASSEMBLY

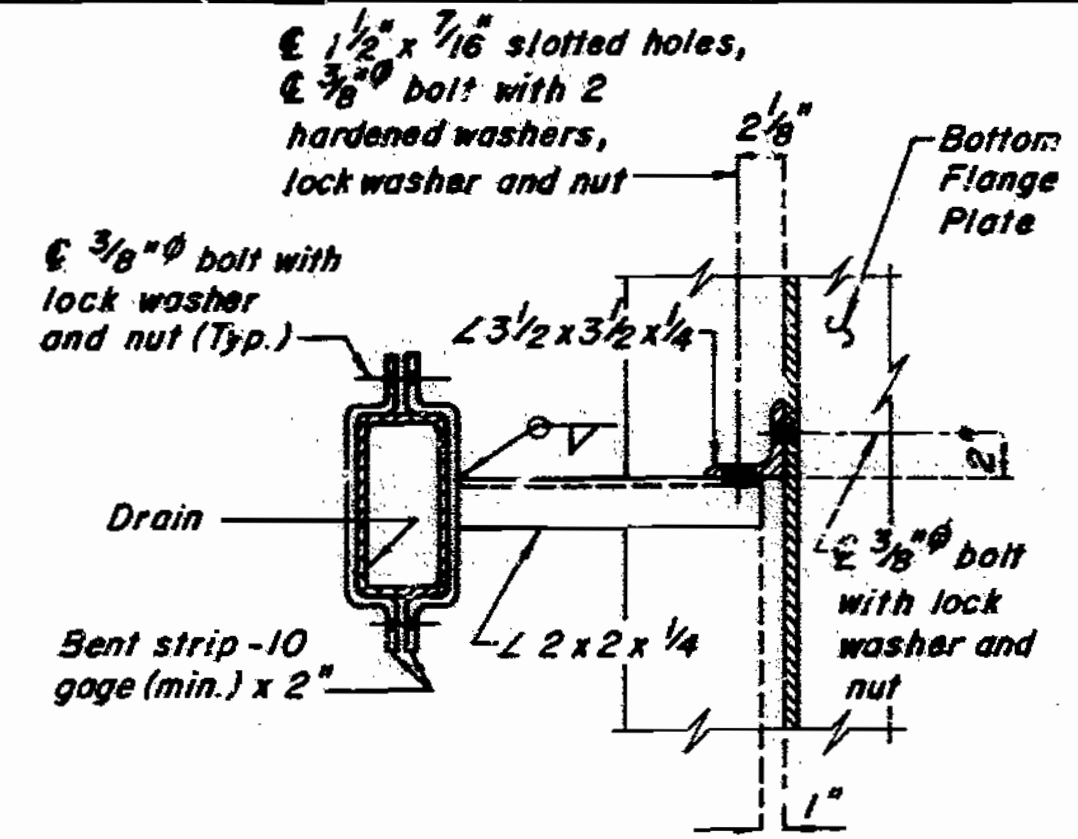


PART SECTION SHOWING BRACKET ASSEMBLY

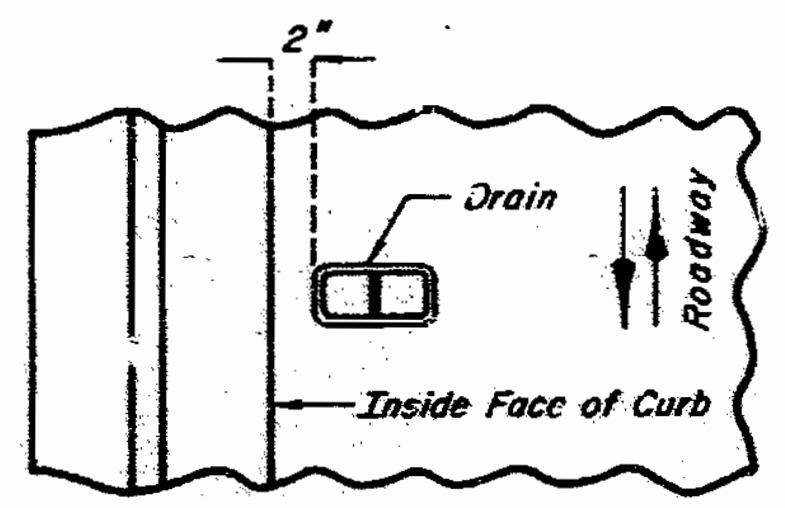


PART PLAN OF SLAB AT DRAIN

DETAILS OF DRAINS TRANSVERSE TO ROADWAY

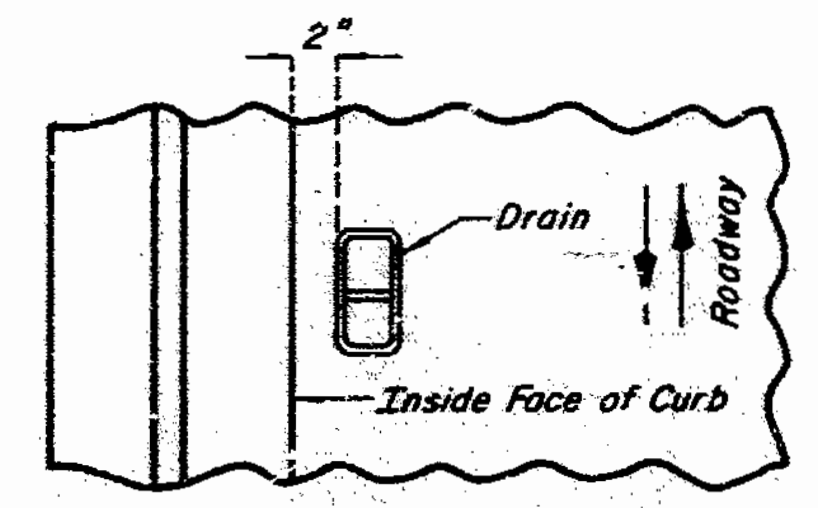


PART PLAN OF SLAB AT DRAIN

DETAILS OF DRAINS PARALLEL TO ROADWAY

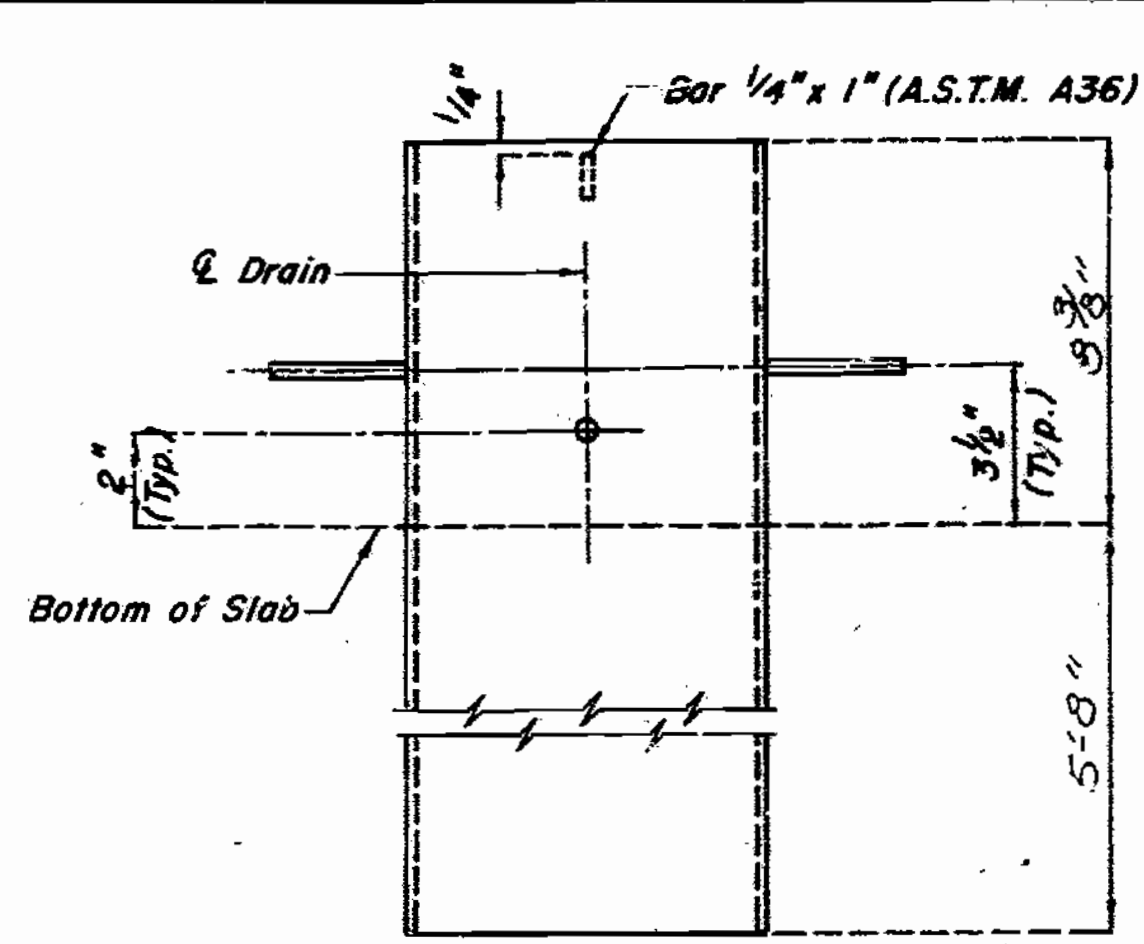


ELEVATION OF DRAIN

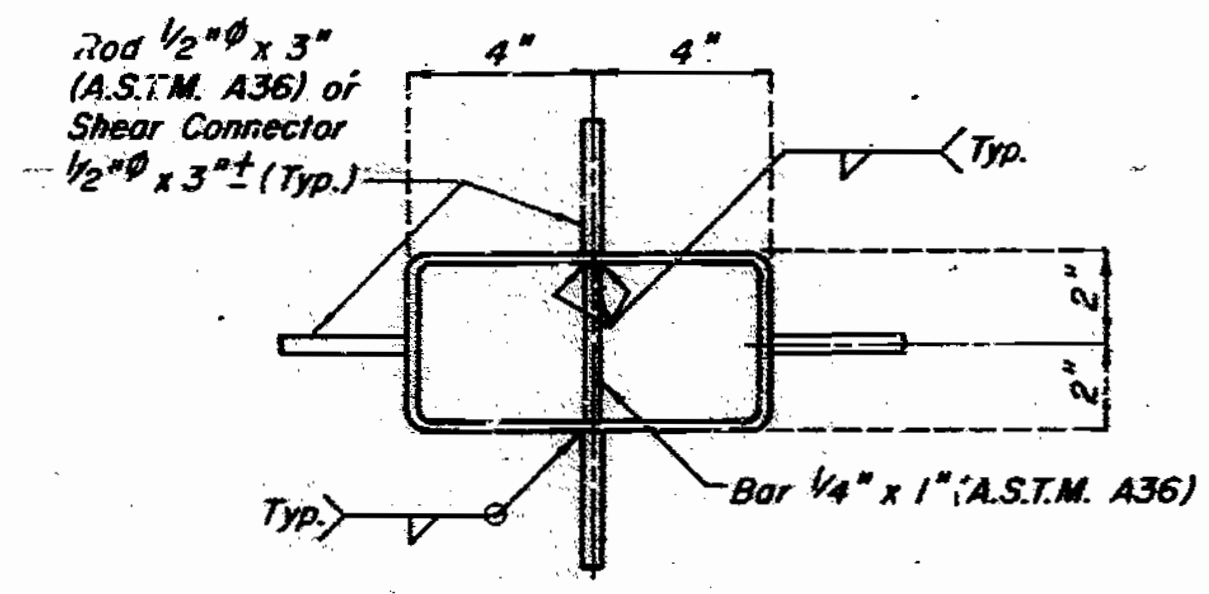

PLAN OF DRAIN

**GENERAL NOTES:**  
 SLAB DRAINS MAY BE FABRICATED OF EITHER 1/4" WELDED SHEETS OF A.S.T.M. A36 STEEL OR FROM 1/4" STRUCTURAL STEEL TUBING A.S.T.M. A500 OR A501.  
 OUTSIDE DIMENSIONS OF DRAINS ARE 8" x 4".  
 LOCATE DRAINS IN THE SLAB BY DIMENSIONS SHOWN IN THE PART ELEVATION. SHIFT REINFORCING IN FIELD WHERE NECESSARY TO CLEAR DRAINS.  
 THE DRAINS AND BRACKET ASSEMBLY SHALL BE GALVANIZED IN ACCORDANCE WITH A.S.T.M. A123.  
 ALL BOLTS, HARDENED WASHERS, LOCK WASHERS AND NUTS SHALL BE GALVANIZED IN ACCORDANCE WITH A.S.T.M. A157.  
 THE BOLT HOLE FOR THE BRACKET ASSEMBLY ATTACHMENT SHALL BE LOCATED ON THE PLATE GIRDER SHOP DRAWINGS.  
 SHOP DRAWINGS WILL NOT BE REQUIRED FOR SLAB DRAINS AND BRACKET ASSEMBLY.

SLAB DRAIN DETAILS

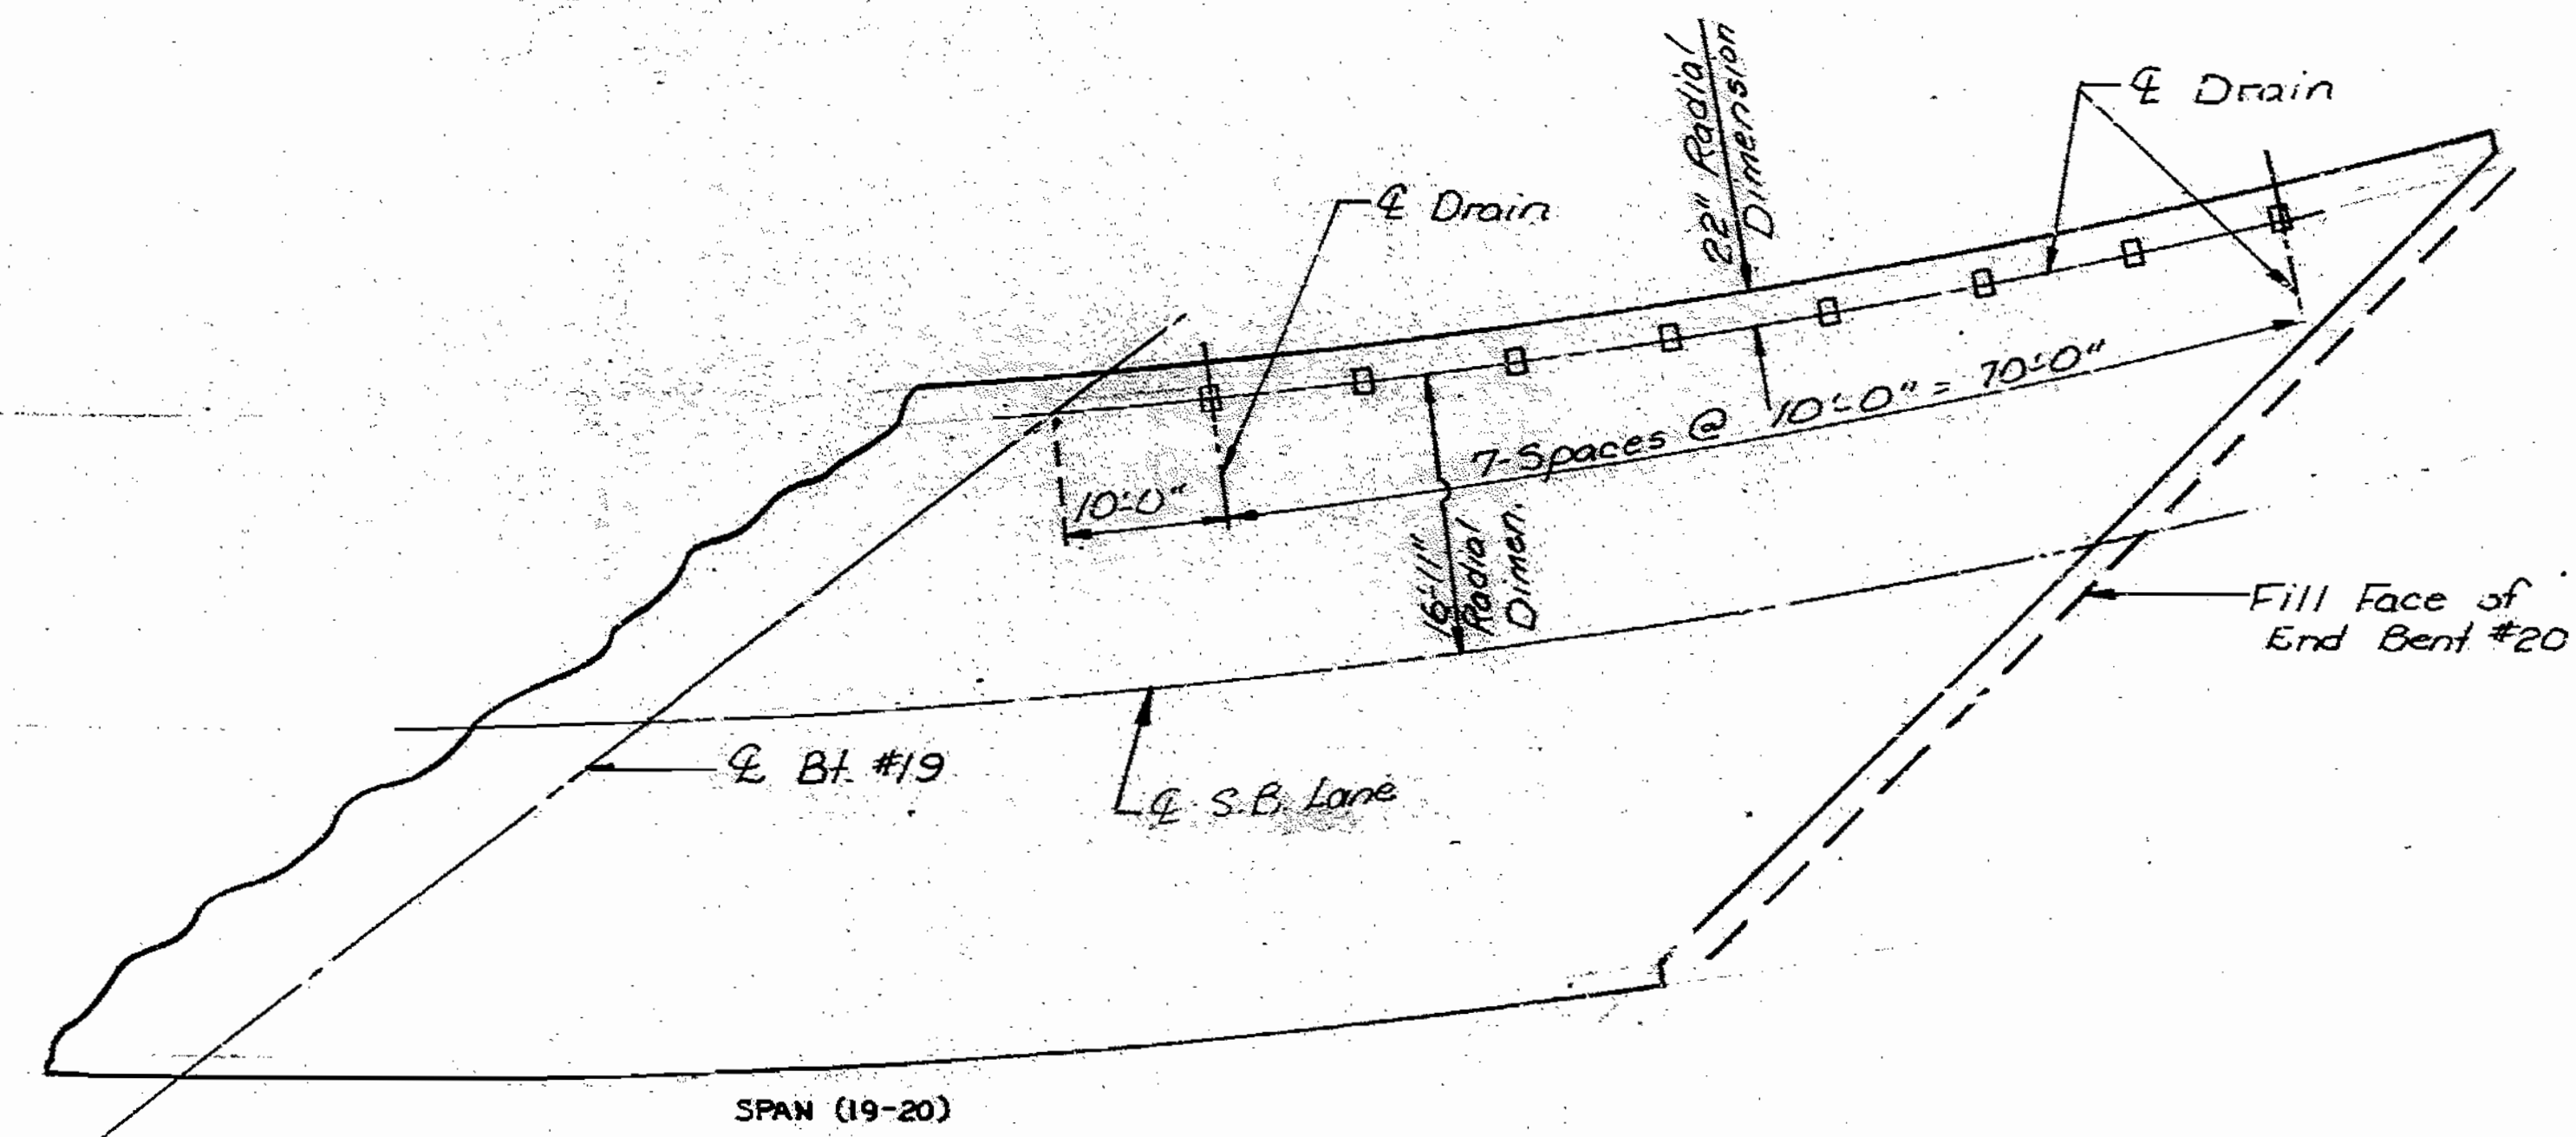

PART PLAN OF SLAB SHOWING DRAINS

STEEL
Edr. Depth 48" and Over
SPS-S.D.(N.W.S.) REVISED
FEB 1973
FEB 1988

DETAILED JULY 1928  
 CHECKED Feb. 1988

Note: This drawing is not to scale. Follow dimensions.

Sheet No. 83 of 98.


JACKSON COUNTY

A-2745

STATE	PRO. NO.	SHEET NO.
MO.		164


LOCATION	ACCEPTABLE ALTERNATE TYPES	EXP. GAP AT 60°	"A" AT 60°	"B"	"C"	"D"	"E"	"F"	ANCHOR STUDS		
									SIZE	SPA.	"G"
BENT NO. 4	ONI-Flex 45	2 1/4"	11 3/4"	4 1/4"	1 5/8"	1 1/2"	2 3/4"	3 1/4"	3/8"	12"	65
	WABO BENDOFLEX 450	2 1/2"	12"	4 1/4"	1 5/8"	1 1/4"	2 3/4"	3 1/4"	1/2"	12"	50
	FEL-SPARK TADA C5	2 1/4"	12 1/4"	4 1/2"	1 5/8"	1 1/2"	2 1/4"	2 3/4"	1/2"	12"	50
	ACME TROJAN TR400	2 1/2"	12"	4 1/4"	1 3/4"	1 1/2"	1 3/4"	2 1/4"	1/2"	12"	40
	DELASTIFLEX LM400	2 1/2"	12 1/8"	4 1/16"	2 3/16"	1 1/8"	2"	2 1/2"	1/2"	9"	45
GEN-STRIP CCLA"	2 1/2"	12"	4 1/4"	1 3/4"	1 1/8"	1 3/4"	2 1/4"	3/8"	12"	65	

NOTE: ALL DIMENSIONS ARE AT RIGHT ANGLES. EXPAN. GAP AND DIMENSION "A" SHALL BE INCREASED 5/16" FOR EACH 10° FALL IN TEMPERATURE AND DECREASED 5/16" FOR EACH 10° RISE IN TEMPERATURE.

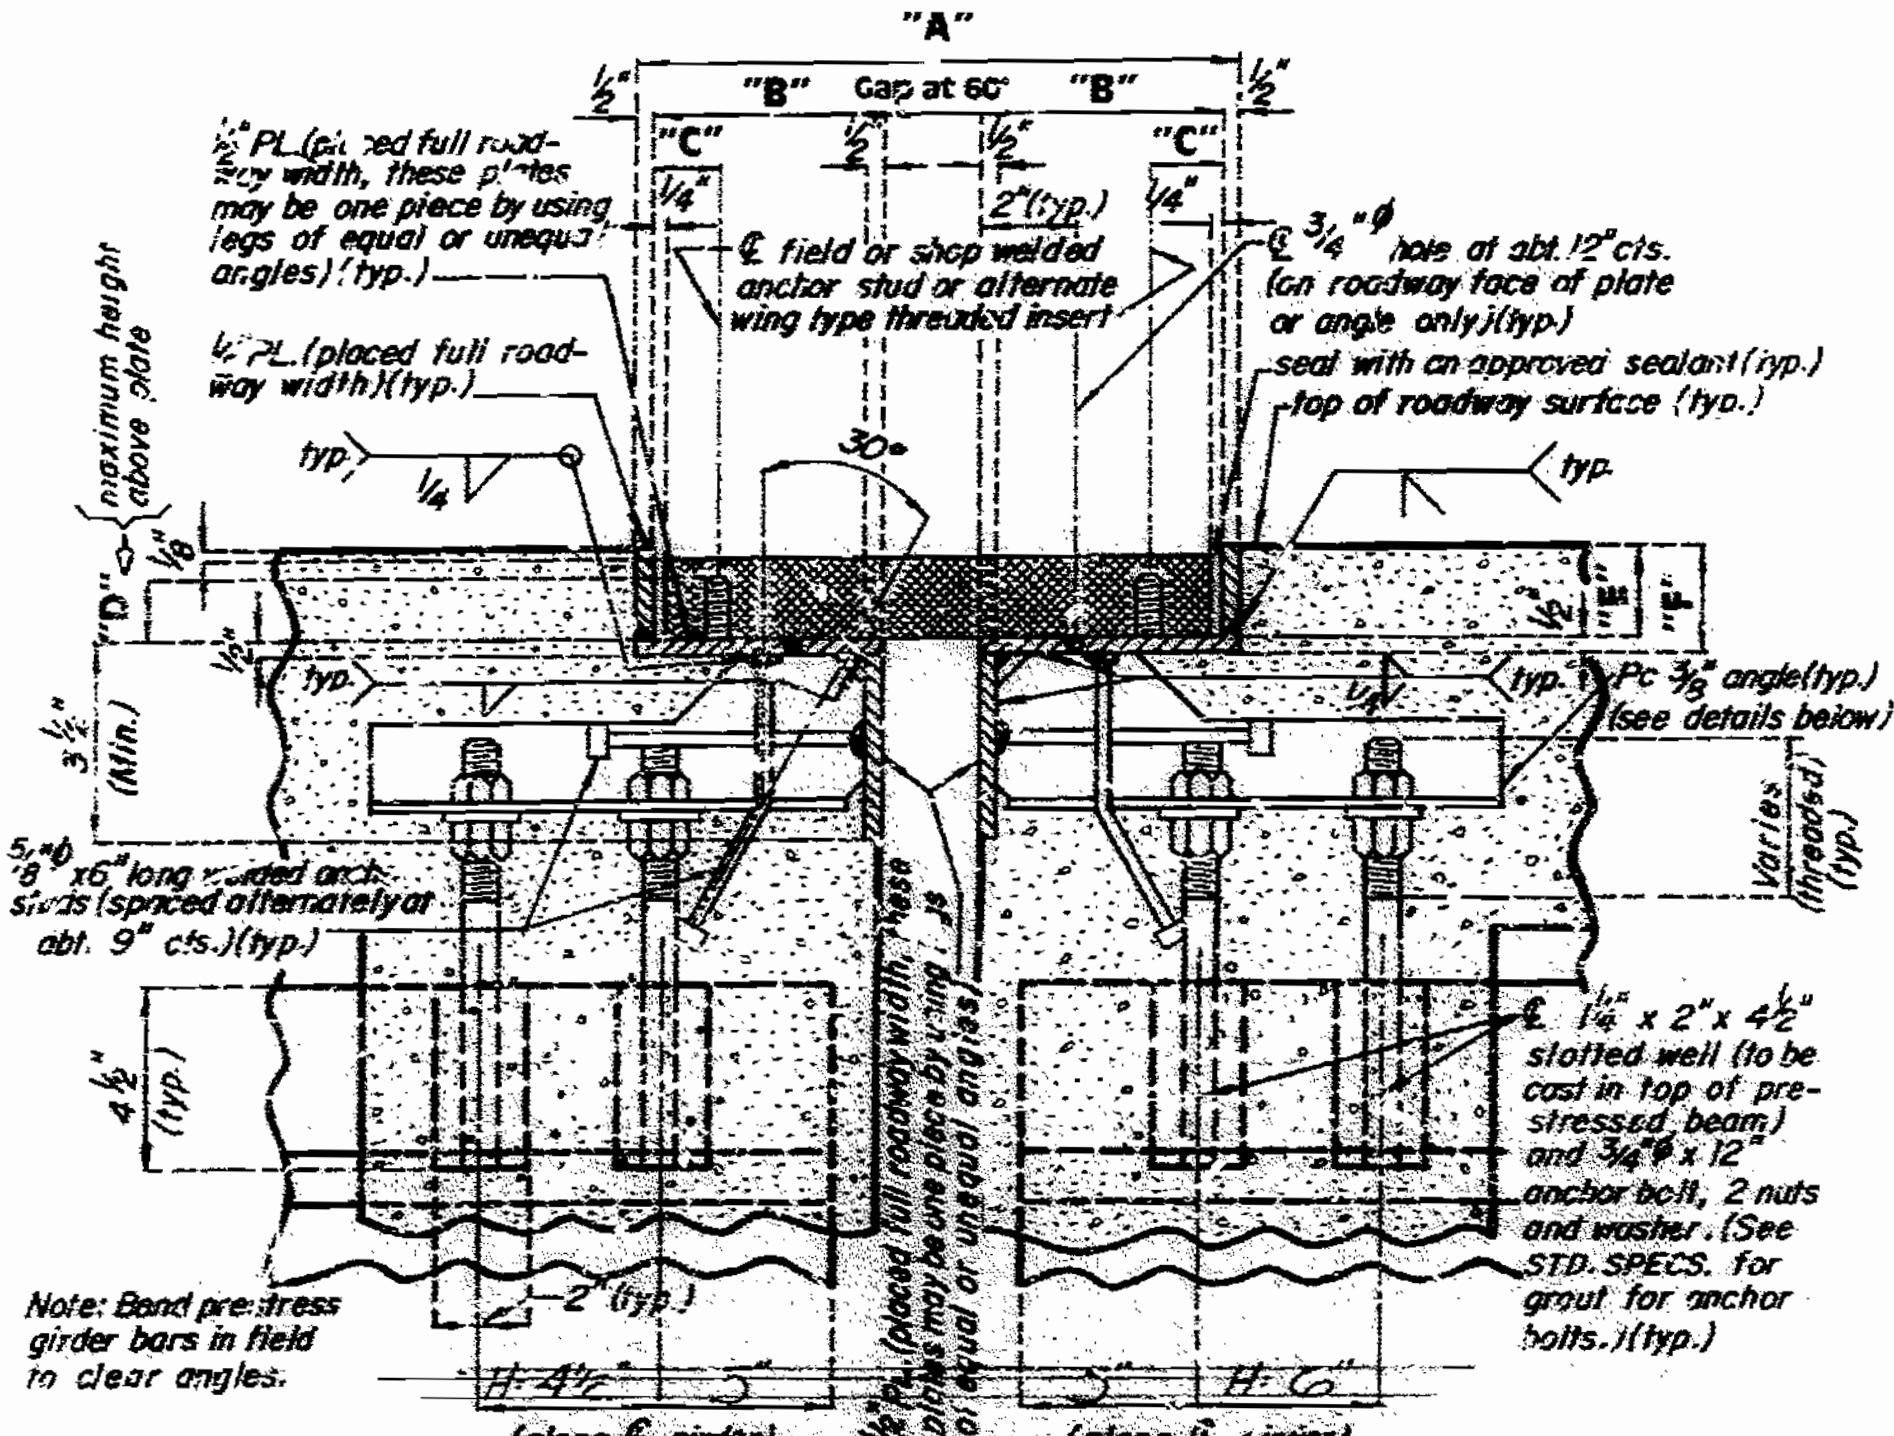


PART SECTION THRU ARMORED JOINT

SPAN (3-4) SPAN (4-5)

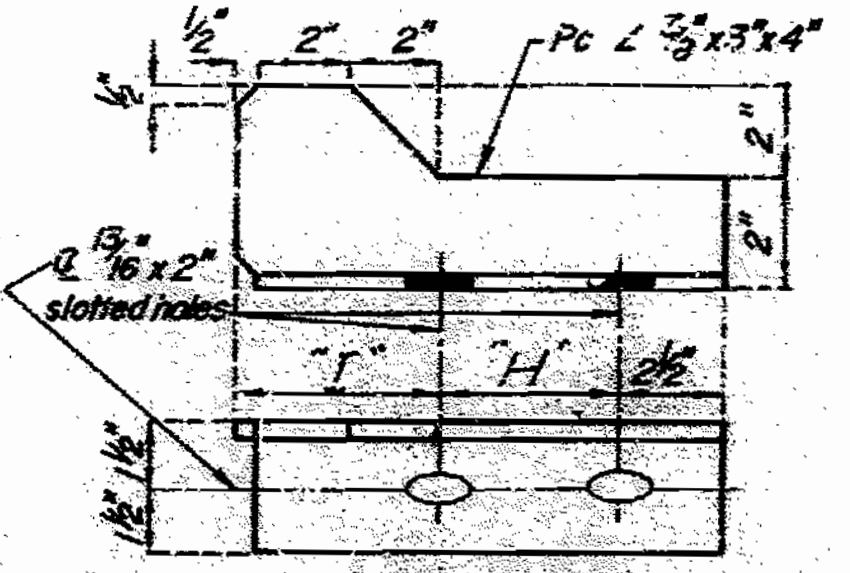


DETAIL OF ANGLE

Note: Angles placed at each girder.  
 E = 8" (Span 3-4)  
 H = 11 1/2" (Span 4-5)

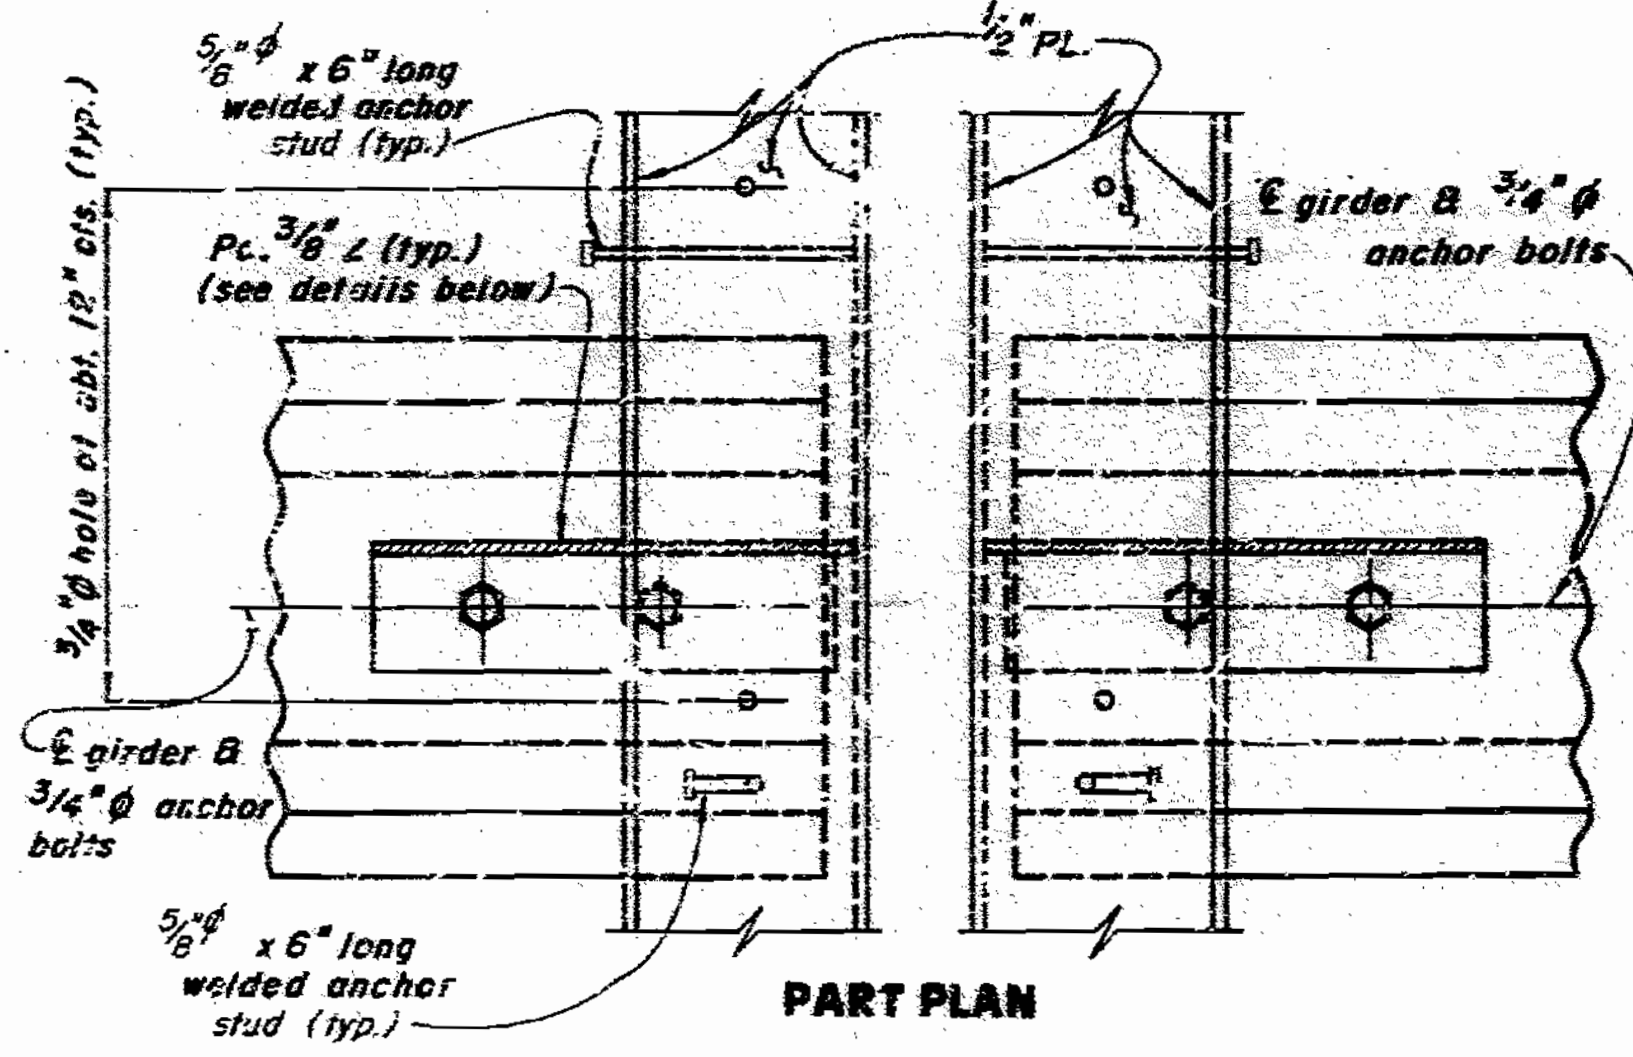


PART PLAN


GENERAL NOTES:  
 THE CERTIFIED NUTS AND BOLTS FOR THE ANCHOR STUDS OR WING TYPE THREADED INSERTS SHALL BE TIGHTENED TO THE FOOT POUNDS "G" SPECIFIED IN THE TABLE OF DIMENSIONS. RETIGHTEN TO "G" FOOT POUNDS A MINIMUM OF 30 MINUTES AFTER INITIAL TIGHTENING. THE WELDED ANCHOR STUDS SHALL BE THE REDUCED BASE TYPE.  
 MATERIAL FOR THE ARMORED JOINT SHALL BE A36 STRUCTURAL GRADE STEEL ANCHORS FOR THE ARMORED JOINT SHALL BE APPROVED STUD WELDED ANCHORS (C1010 THRU C1020).  
 SEE SPECIAL PROVISIONS FOR PAINTING.  
 ANCHOR BOLTS IN THE BARRIER CURB SHALL BE CAST-IN-PLACE, GROUTED OR CONE EXPANSION TYPE. HOLES IN THE BARRIER CURB FOR ANCHORS SHALL NOT BE DRILLED UNTIL THE CONCRETE IS AT LEAST 7 DAYS OLD.  
 PLAN DIMENSIONS ARE BASED ON INSTALLATION AT 60°F. THE EXPANSION GAP AND OTHER DIMENSIONS SHALL BE ADJUSTED DURING INSTALLATION FOR COMPLIANCE WITH ANY TEMPERATURE CHANGE.  
 CONTACT SURFACE OF STEEL TO ALUMINUM SHALL BE INSULATED WITH THE MATERIAL SPECIFIED ON THE SHOP DRAWINGS.  
 FURNISHING, PAINTING AND INSTALLING THE STRUCTURAL STEEL ARMORED JOINT AND CURB PLATES SHALL BE INCLUDED IN THE CONTRACT UNIT PRICE FOR ELASTOMERIC EXPANSION JOINT SEAL.  
 BOLT CAVITIES TO BE FILLED WITH APPROVED SEALANT IN COMPLIANCE WITH MANUFACTURER'S CERTIFICATION.

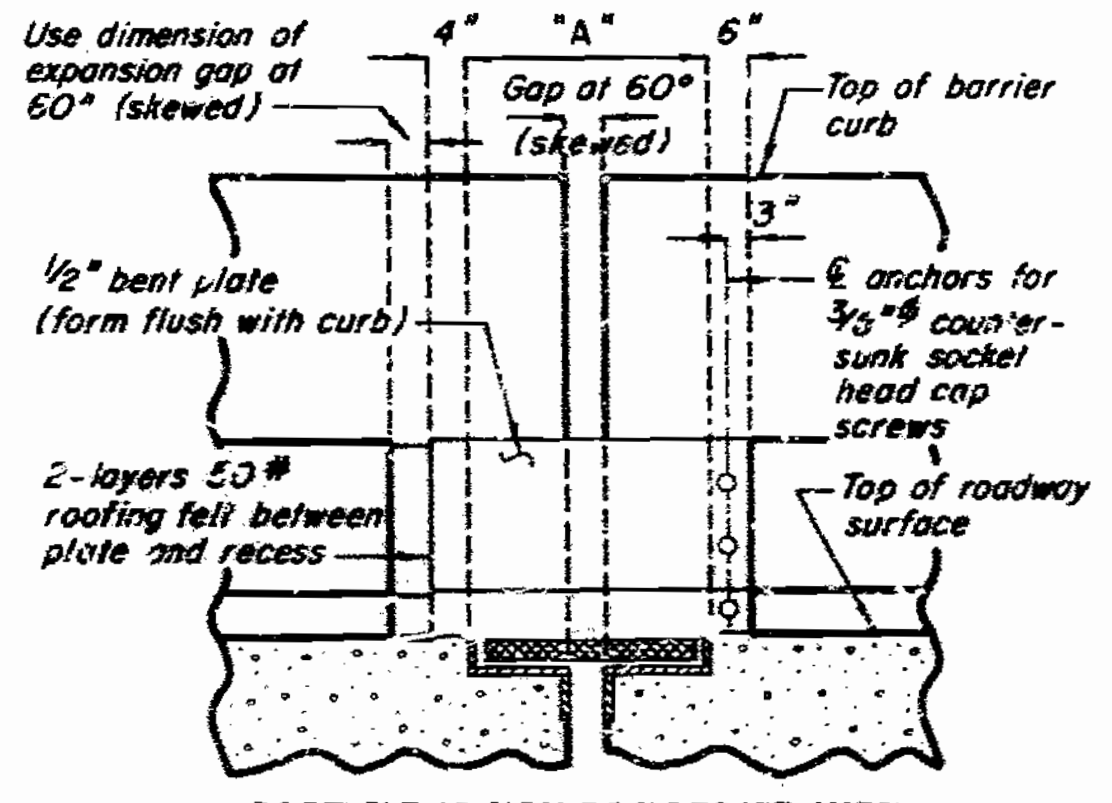


PART ELEVATION OF BARRIER CURB

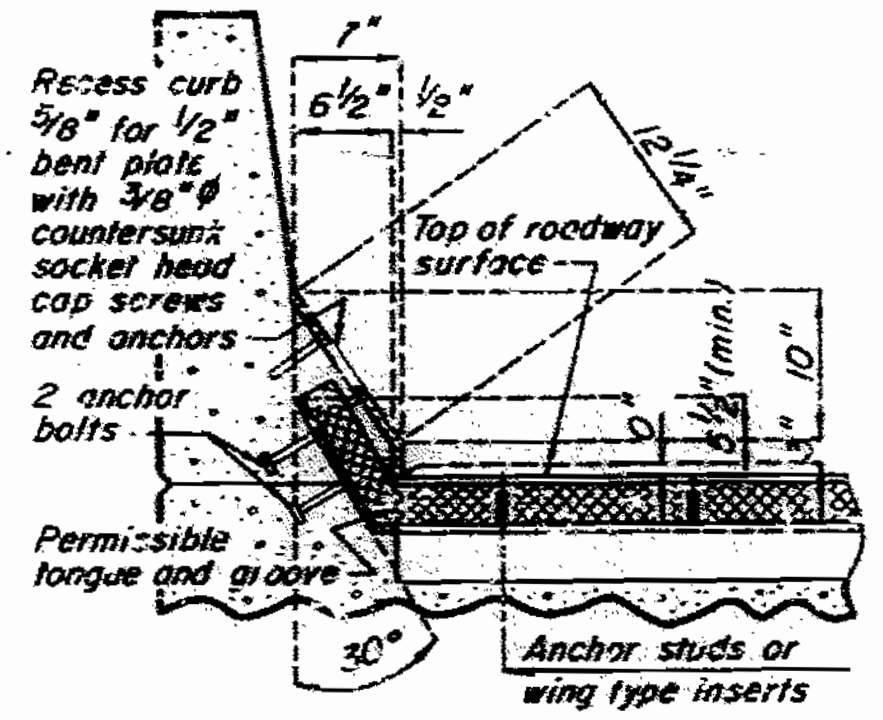


TYPE "A" CURB

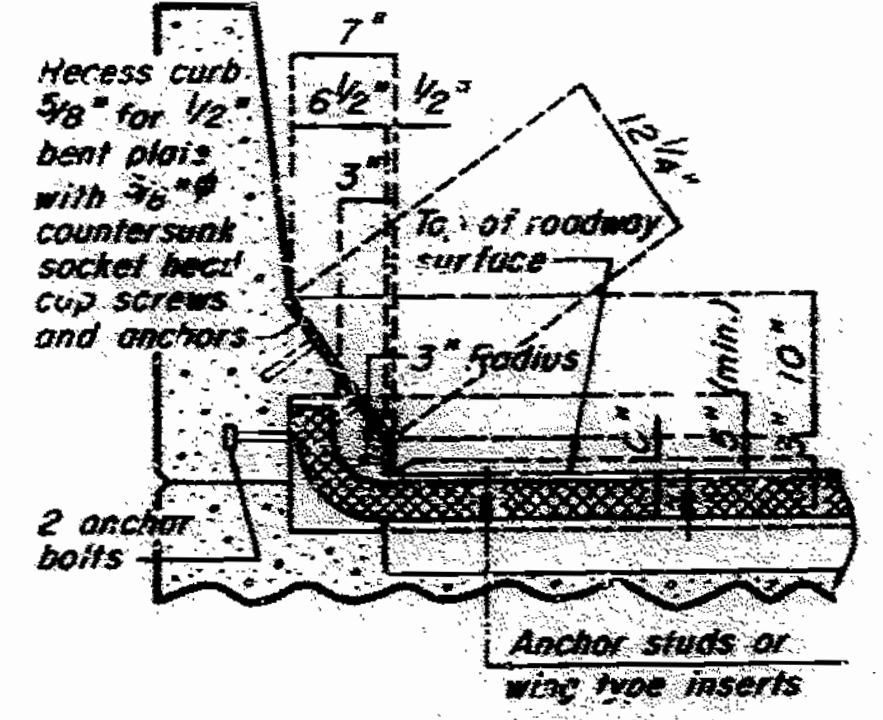

TYPE "B" CURB

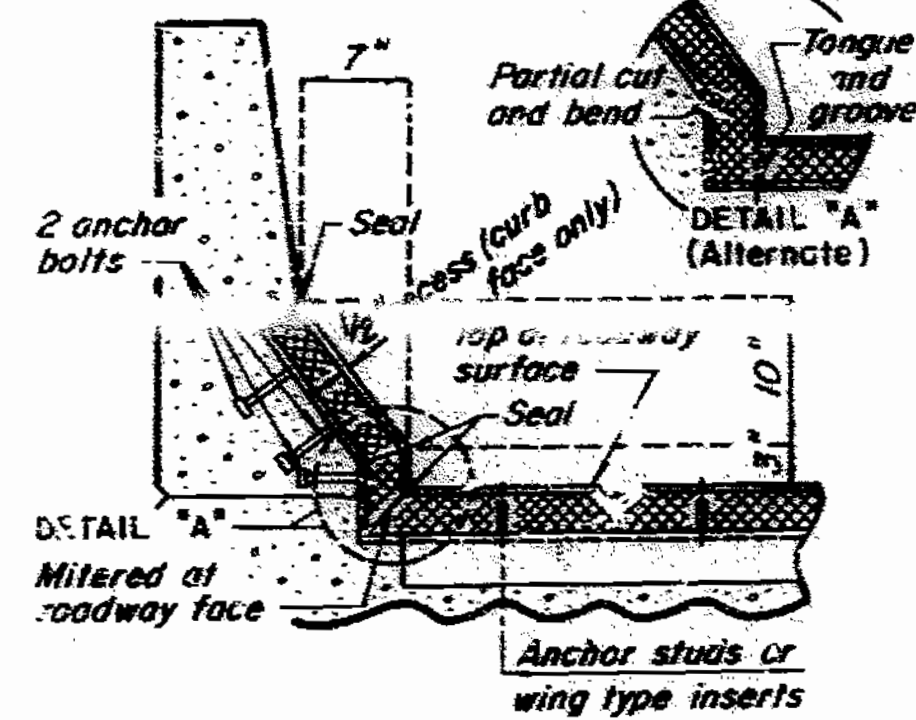

ALTERNATE CURB TREATMENTS

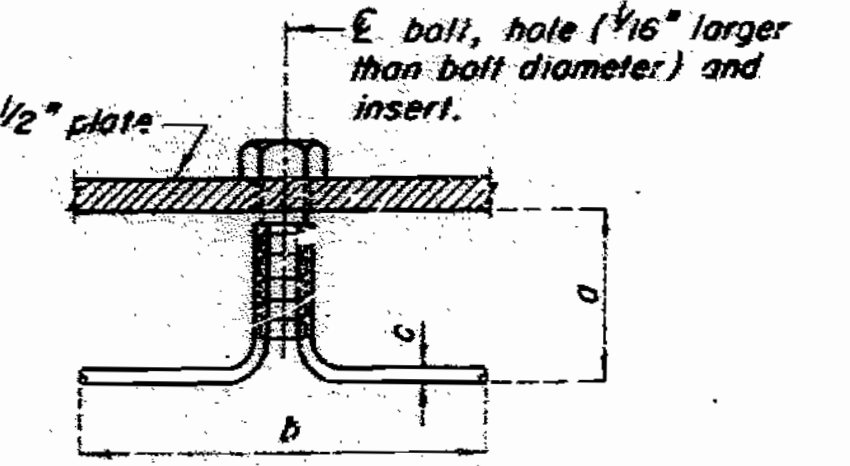

BOLT DIAMETER	SAFE LOAD TENSION (LBS.) (MIN.)	APPROX. ULT. CAP. TENSION (LBS.) (MIN.)	DIMENSIONS		
			a	b	c
1/2"	600	8,000	1-5/8"	5"	218"
5/8"	1,300	9,200	1-5/8"	5"	218"
3/4"	1,800	13,200	2-1/4"	6"	267"
7/8"	2,800	16,200	2-1/2"	6-1/2"	306"
1"	2,800	16,200	2-1/2"	6-1/2"	306"

DETAILS OF ALTERNATE WING TYPE THREADED INSERT  
 (MACHINE BOLTS NEED ONLY BE USED TO SECURE THE WING TYPE THREADED INSERTS TO THE STEEL PLATE UNTIL THE CONCRETE HAS ATTAINED 3,000 p.s.i.)

DETAILS OF ELASTOMERIC EXPANSION JOINT SEAL AT BENT NO. 4


Note: This drawing is not to scale. Follow dimensions.

Elastic Expansion Jt. Seal  
 SPS-INT. BT. REVISED  
 FEB. 1978 MAY 1987

DETAILED MAR. 1988  
 CHECKED NOV. 1988



STATE	PROJ. NO.	SHEET NO.
MO		165

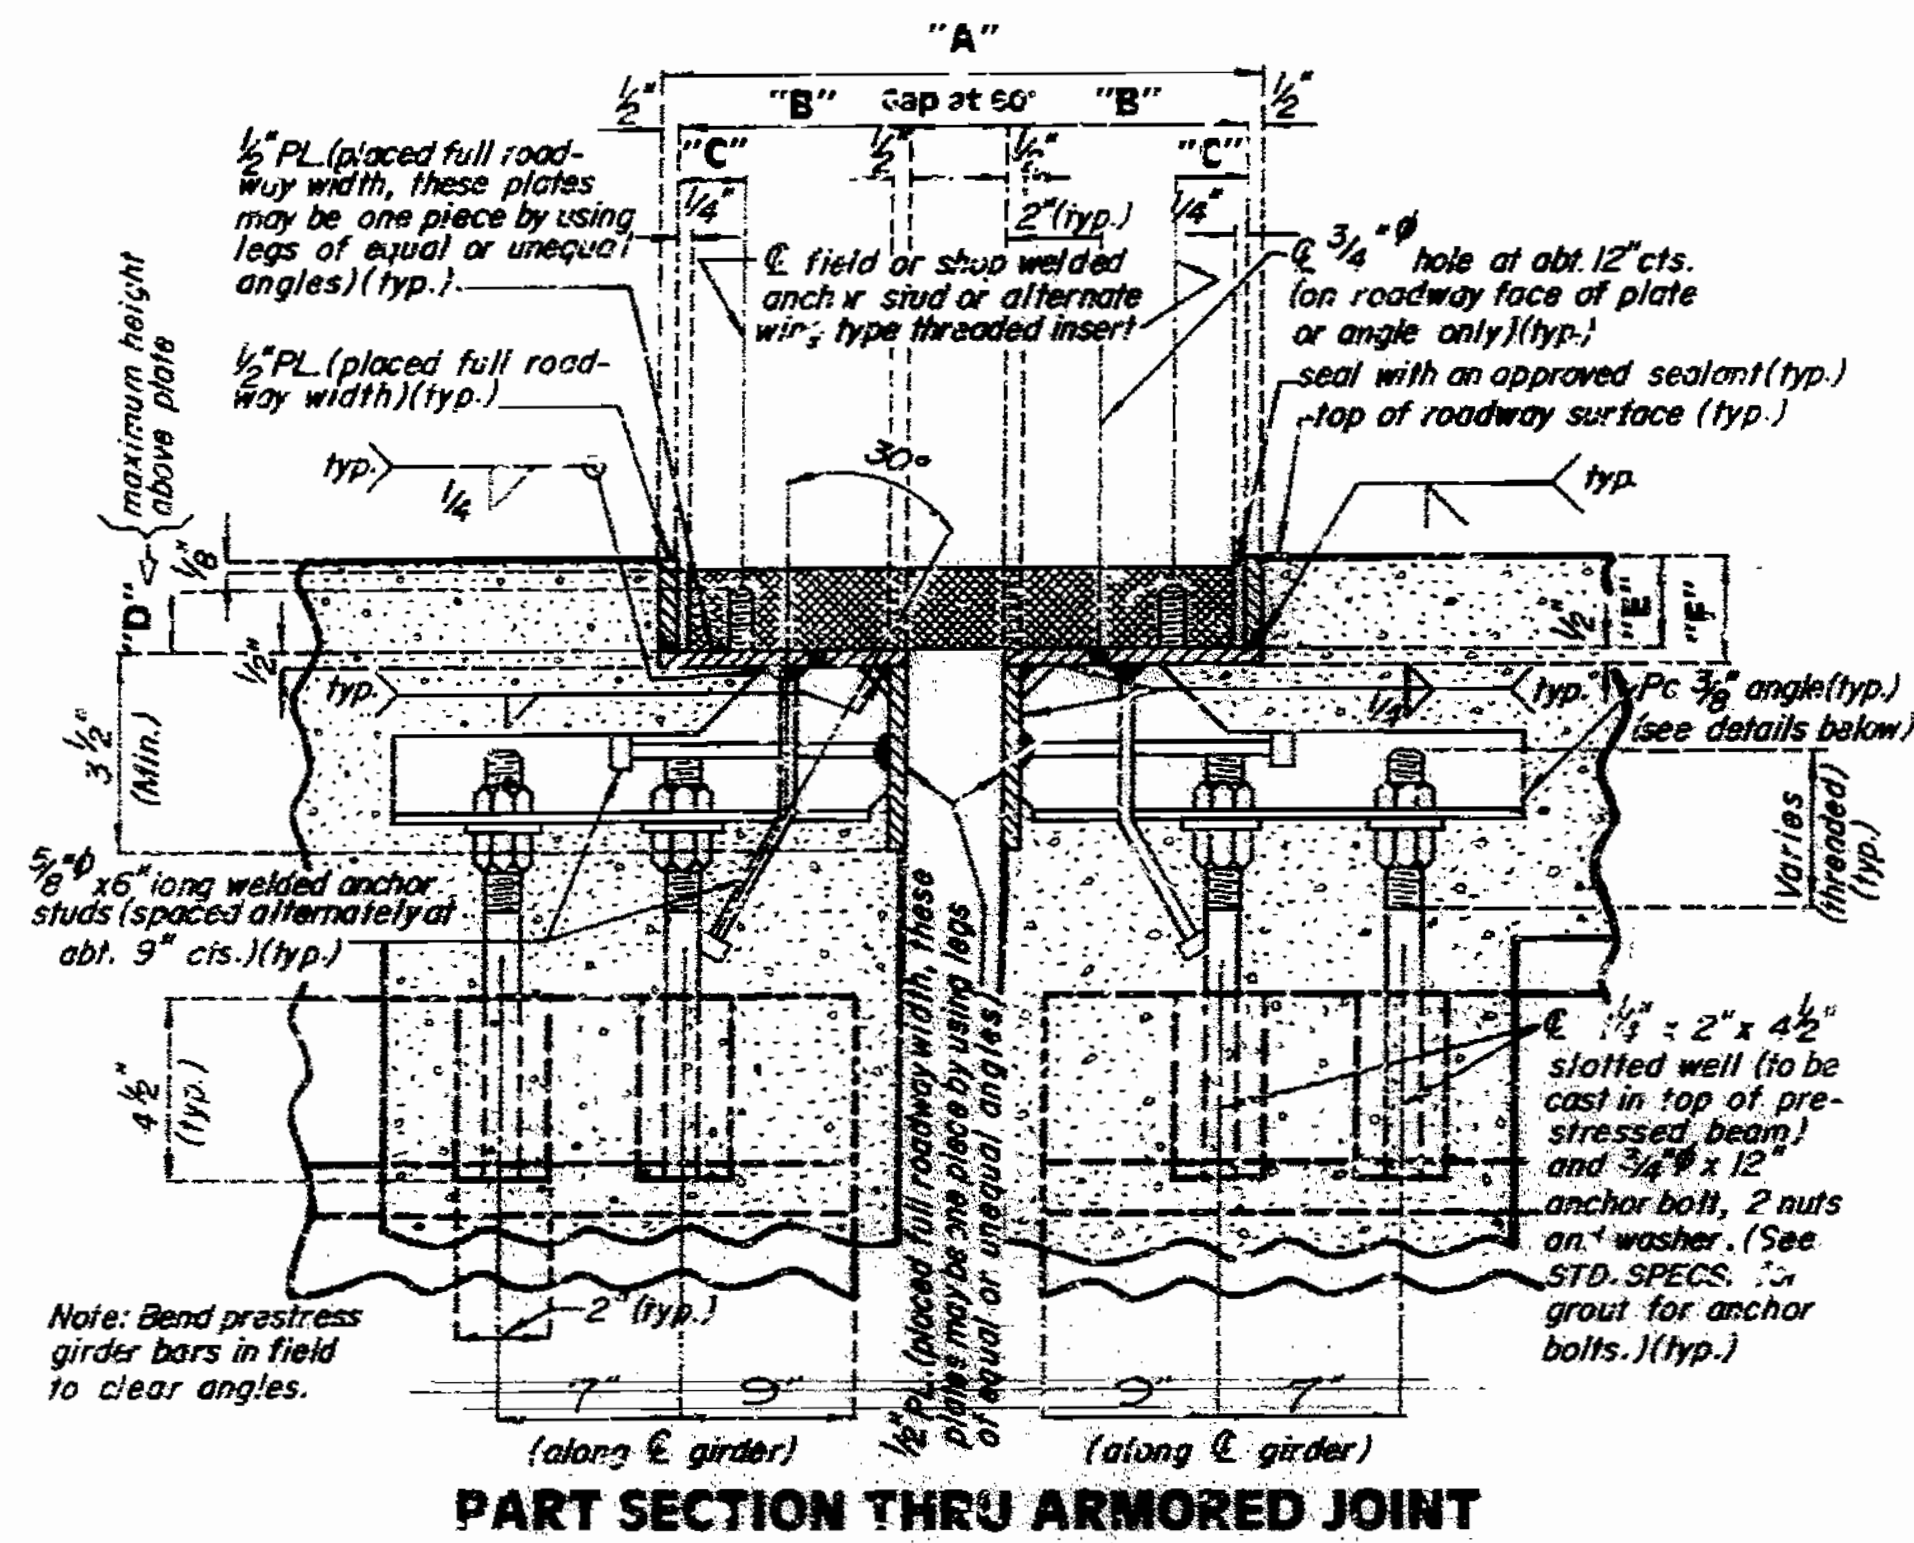

**TABLE OF DIMENSIONS**

LOCATION	ACCEPTABLE ALTERNATE TYPES	EXP. GAP AT 60°	"A" AT 60°	"B"	"C"	"D"	"E"	"F"	ANCHOR STUDS	
									SIZE	SPA.
BENT NO. 9	ON-FLEX 45	2 1/4"	11 3/4"	4 1/4"	1 3/8"	1 1/2"	2 3/4"	3 1/4"	3/8"	12"
	WACO BENDOFLEX 450	2 1/2"	12"	4 1/4"	1 3/8"	1 1/2"	2 3/4"	3 1/4"	3/8"	12"
	FEL-SPAN T40A C5	2 1/4"	12 1/4"	4 1/2"	1 3/8"	1 1/2"	2 1/4"	2 3/4"	3/8"	12"
	ACME TROJAN T400	2 1/2"	12"	4 1/4"	1 3/8"	1 1/2"	2 3/4"	3 1/4"	3/8"	12"
	DELASTIFLEX LM400	2 1/2"	12 1/8"	4 1/16"	1 3/8"	1 1/2"	2 1/2"	2 3/4"	3/8"	9"
BENT NO. 13	GEN-STRIP CCL 4"	2 1/2"	12"	4 1/4"	1 3/8"	1 1/2"	2 1/4"	2 3/4"	3/8"	12"
	DELASTIFLEX LTM300	2 1/2"	12 3/8"	4 1/16"	1 3/8"	1 1/2"	2 1/2"	2 3/4"	3/8"	9"
	GEN-STRIP CCL 3"	2 1/4"	11 3/4"	4 1/4"	1 3/8"	1 1/2"	2 3/4"	2 3/4"	3/8"	12"
	DEL-FLEX 35	2"	11 1/2"	4 1/4"	1 3/8"	1 1/2"	2 3/8"	2 3/8"	3/8"	12"
	WACO BENDOFLEX 450	2"	12"	4 1/4"	1 3/8"	1 1/2"	2 3/4"	3 1/4"	3/8"	12"
	FEL-SPAN T40A C5	2"	12"	4 1/4"	1 3/8"	1 1/2"	2 1/4"	2 3/4"	3/8"	12"
	ACME TROJAN T400	2 1/2"	12"	4 1/4"	1 3/8"	1 1/2"	2 3/4"	3 1/4"	3/8"	12"

**NOTE:** ALL DIMENSIONS ARE AT RIGHT ANGLES. EXPANSION GAP AND DIMENSION "A" SHALL BE INCREASED \* FOR EACH 10° FALL IN TEMPERATURE AND DECREASED \* FOR EACH 10° RISE IN TEMPERATURE.

\* 1/4" (Bent No. 9)  
\* 3/16" (Bent No. 13)

**GENERAL NOTES:**

THE CERTIFIED NUTS AND BOLTS FOR THE ANCHOR STUDS OR WING TYPE THREADED INSERTS SHALL BE TIGHTENED TO THE FOOT POUNDS "G" SPECIFIED IN THE TABLE OF DIMENSIONS. RETIGHTEN TO "G" FOOT POUNDS A MINIMUM OF 30 MINUTES AFTER INITIAL TIGHTENING. THE WELDED ANCHOR STUDS SHALL BE THE REDUCED BASE TYPE.

MATERIAL FOR THE ARMORED JOINT SHALL BE #3 STRUCTURAL GRADE STEEL. ANCHORS FOR THE ARMORED JOINT SHALL BE APPROVED STUD WELDED ANCHORS (C1010 THRU C120).

SEE SPECIAL PROVISIONS FOR PAINTING.




ANCHOR BOLTS IN THE BARRIER CURB SHALL BE CAST-IN-PLACE, GROUTED OR CONE-EXPANSION TYPE. HOLES IN THE BARRIER CURB FOR ANCHORS SHALL NOT BE DRILLED UNTIL THE CONCRETE IS AT LEAST 7 DAYS OLD.

PLAN DIMENSIONS ARE BASED ON INSTALLATION AT 60°F. THE EXPANSION GAP AND OTHER DIMENSIONS SHALL BE ADJUSTED DURING INSTALLATION FOR COMPLIANCE WITH ANY TEMPERATURE CHANGE.

CONTACT SURFACE OF STEEL TO ALUMINUM SHALL BE INSULATED WITH THE MATERIAL SPECIFIED ON THE SHOP DRAWINGS.





FURNISHING, PAINTING AND INSTALLING THE STRUCTURAL STEEL ARMORED JOINT AND CURB PLATES SHALL BE INCLUDED IN THE CONTRACT UNIT PRICE FOR ELASTOMERIC EXPANSION JOINT SEAL.

BOLT CAVITIES TO BE FILLED WITH APPROVED SEALANT IN COMPLIANCE WITH MANUFACTURER'S CERTIFICATION.

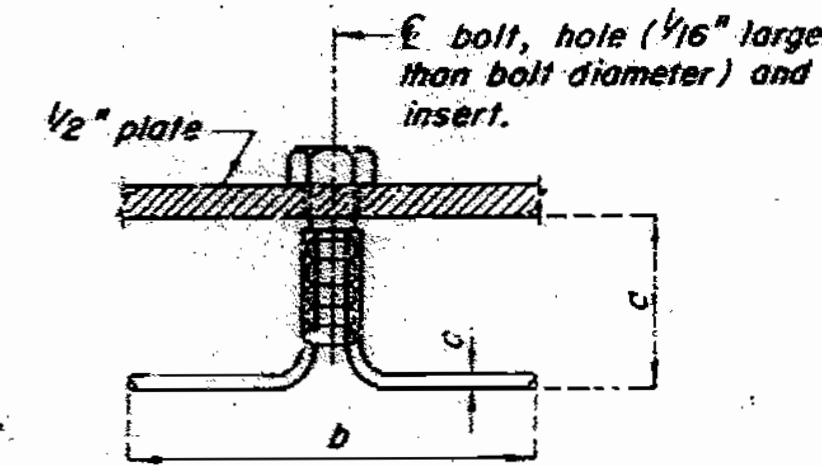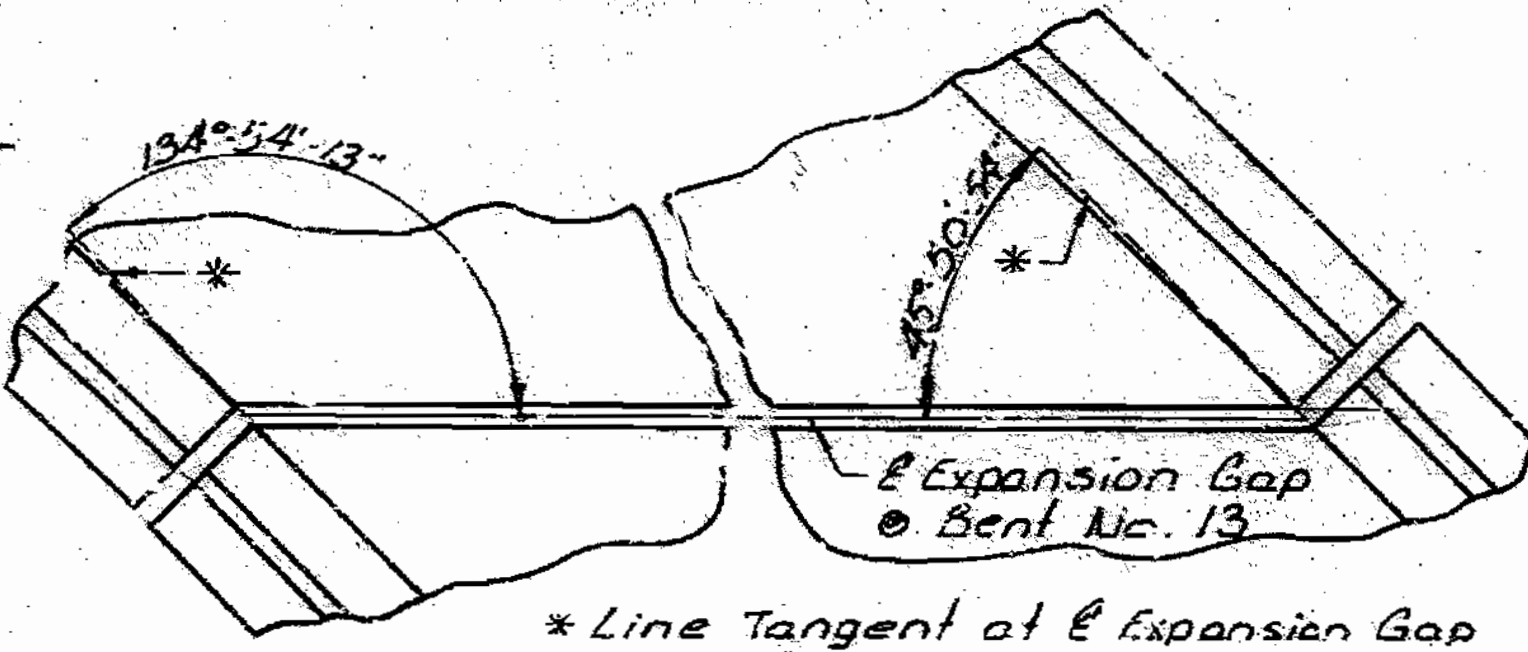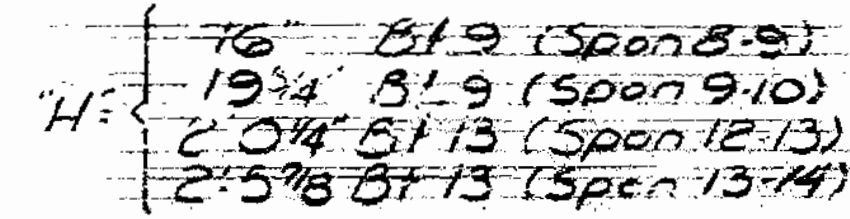


BOLT DIAMETER	SAFE LOAD TENSION (LBS.) (MIN.)	APPROX. ULT. CAP. TENSION (LBS.) (MIN.)	DIMENSIONS		
			a	b	c
1/2"	800	8,000	1-5/8"	5"	215"
5/8"	1,300	9,200	1-5/8"	5"	218"
3/4"	1,800	13,200	2-1/8"	6"	262"
7/8"	2,000	16,200	2-1/2"	6-1/2"	306"
1"	2,000	16,200	2-1/2"	6-1/2"	306"

**DETAILS OF ALTERNATE WING TYPE THREADED INSERT**  
(MACHINE BOLTS NEED ONLY BE USED TO SECURE THE WING TYPE THREADED INSERTS TO THE STEEL PLATE UNTIL THE CONCRETE HAS ATTAINED 3,000 p.s.i.)

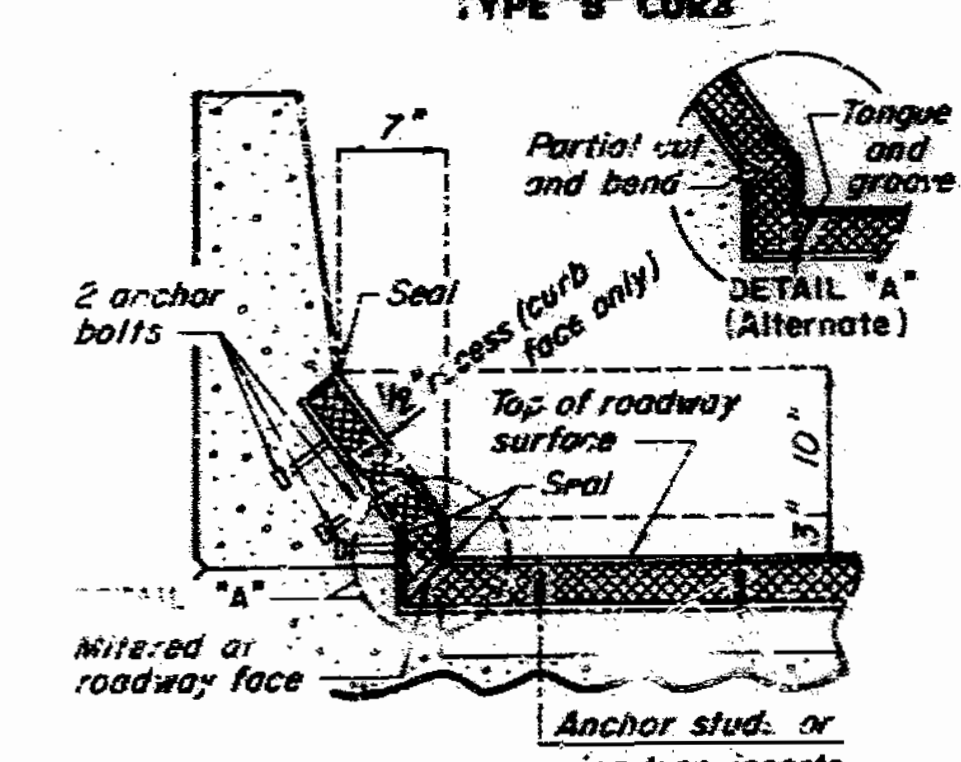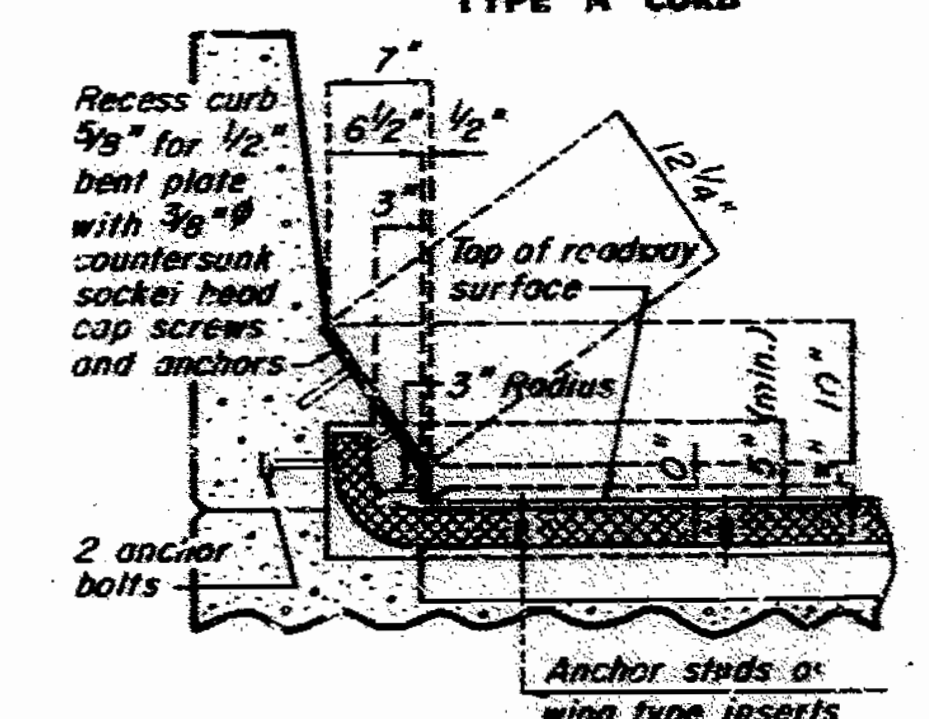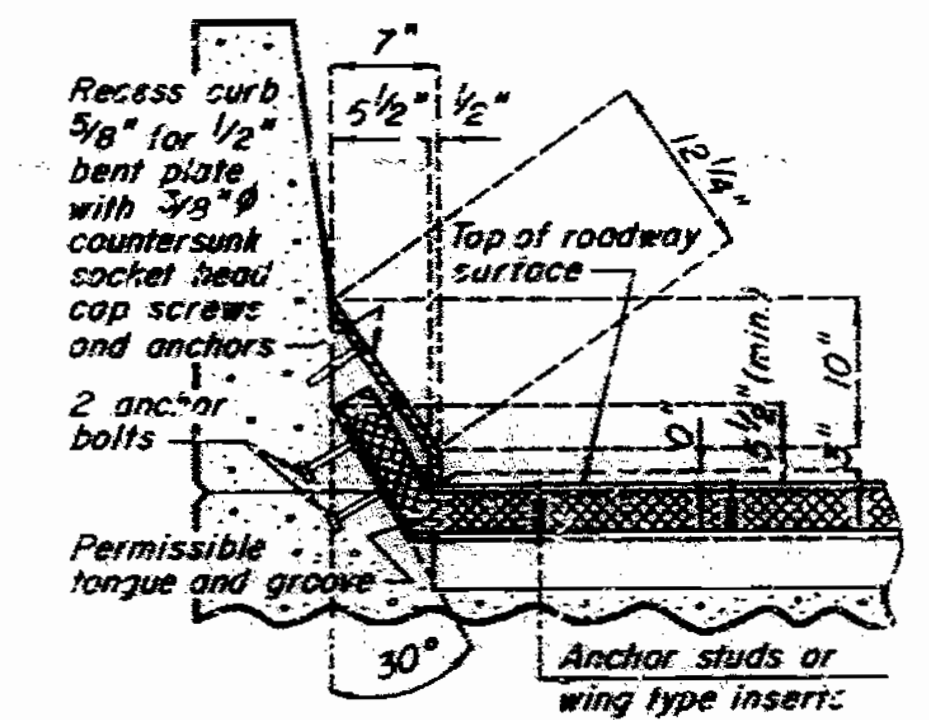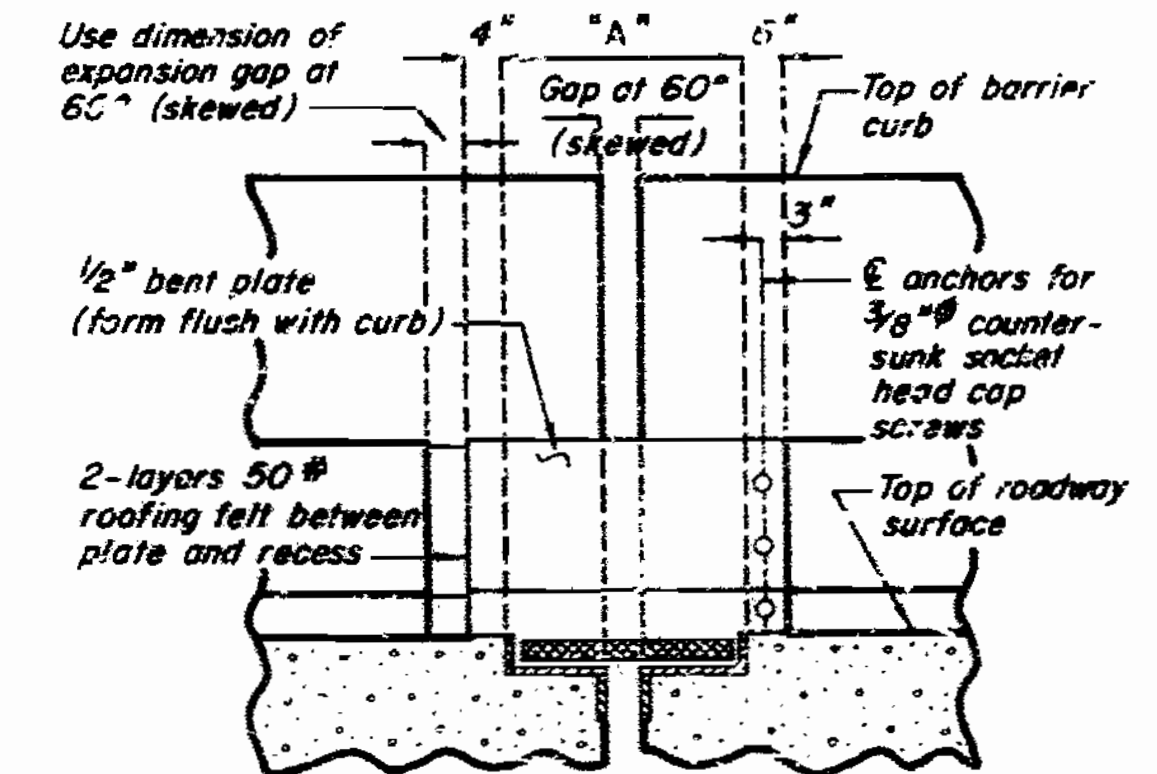

**ALTERNATE CURB TREATMENTS**

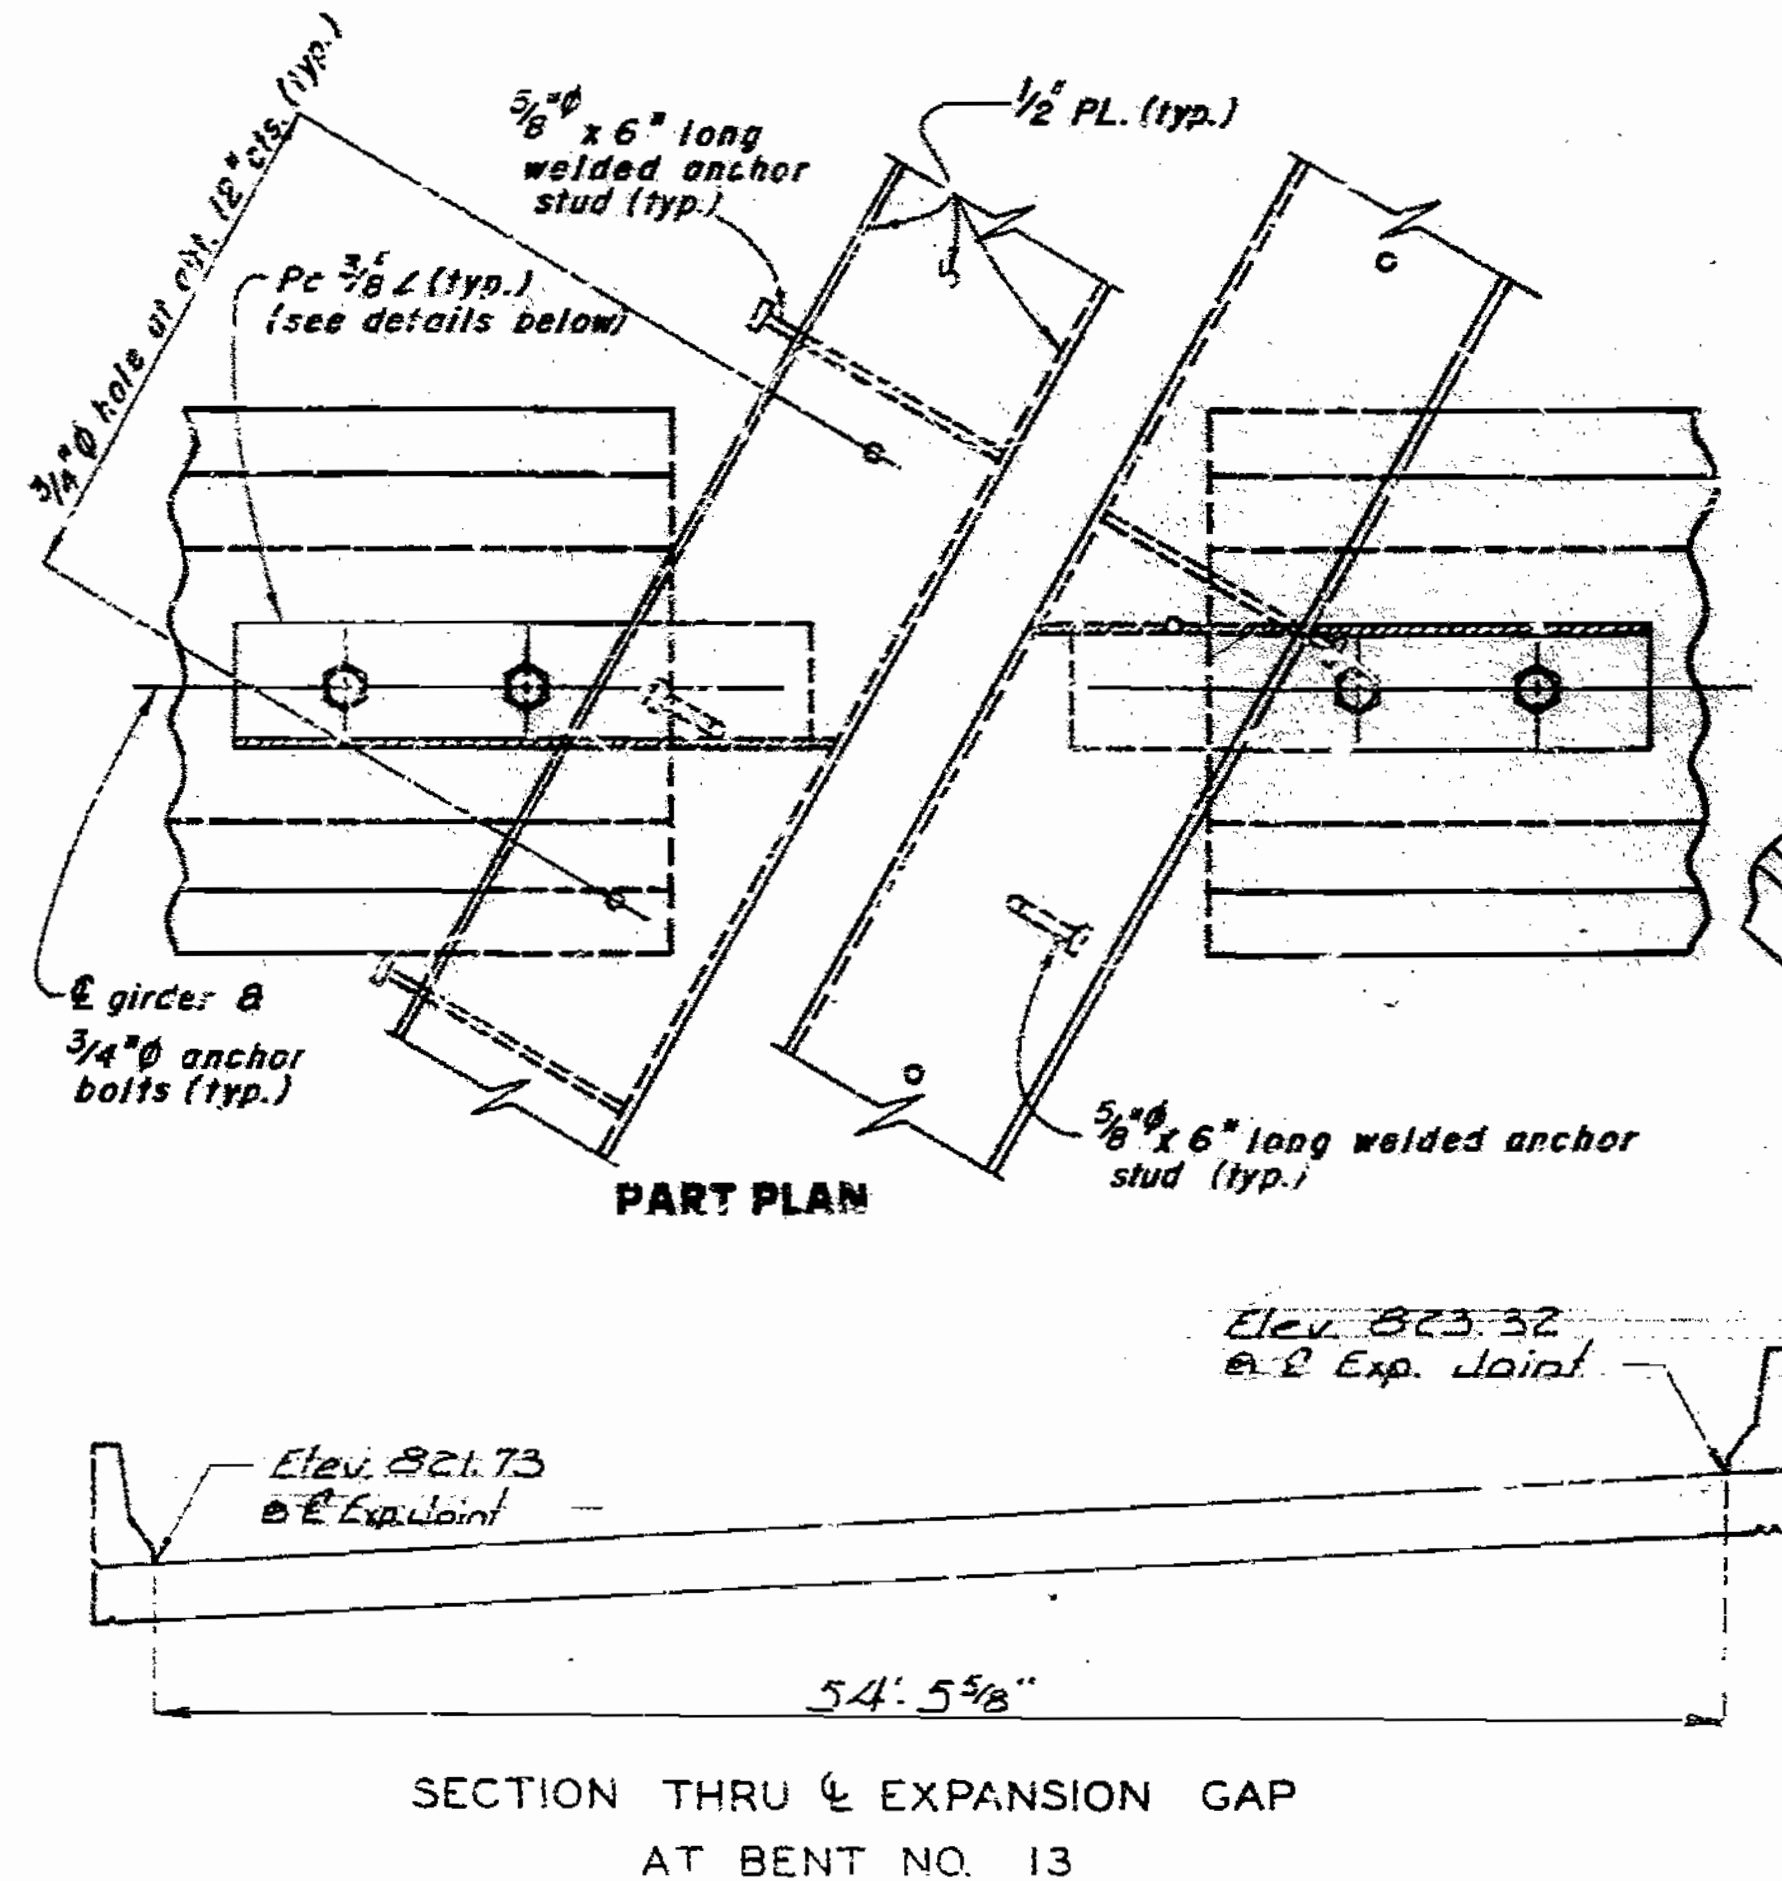

**DETAILS OF ELASTOMERIC EXPANSION JOINT SEAL AT BENT NO. 9 & NO. 13**

Note: This drawing is not to scale. Follow dimensions


Sheet No. 85 of 98

JACKSON COUNTY


A-2745

Elastomeric Expansion Jt. Seal  
SPS - INT. BT. REVISED  
FEB. 1978 M.A.Y. 1987


DETAILED MAR. 1988  
CHECKED Nov. 1985

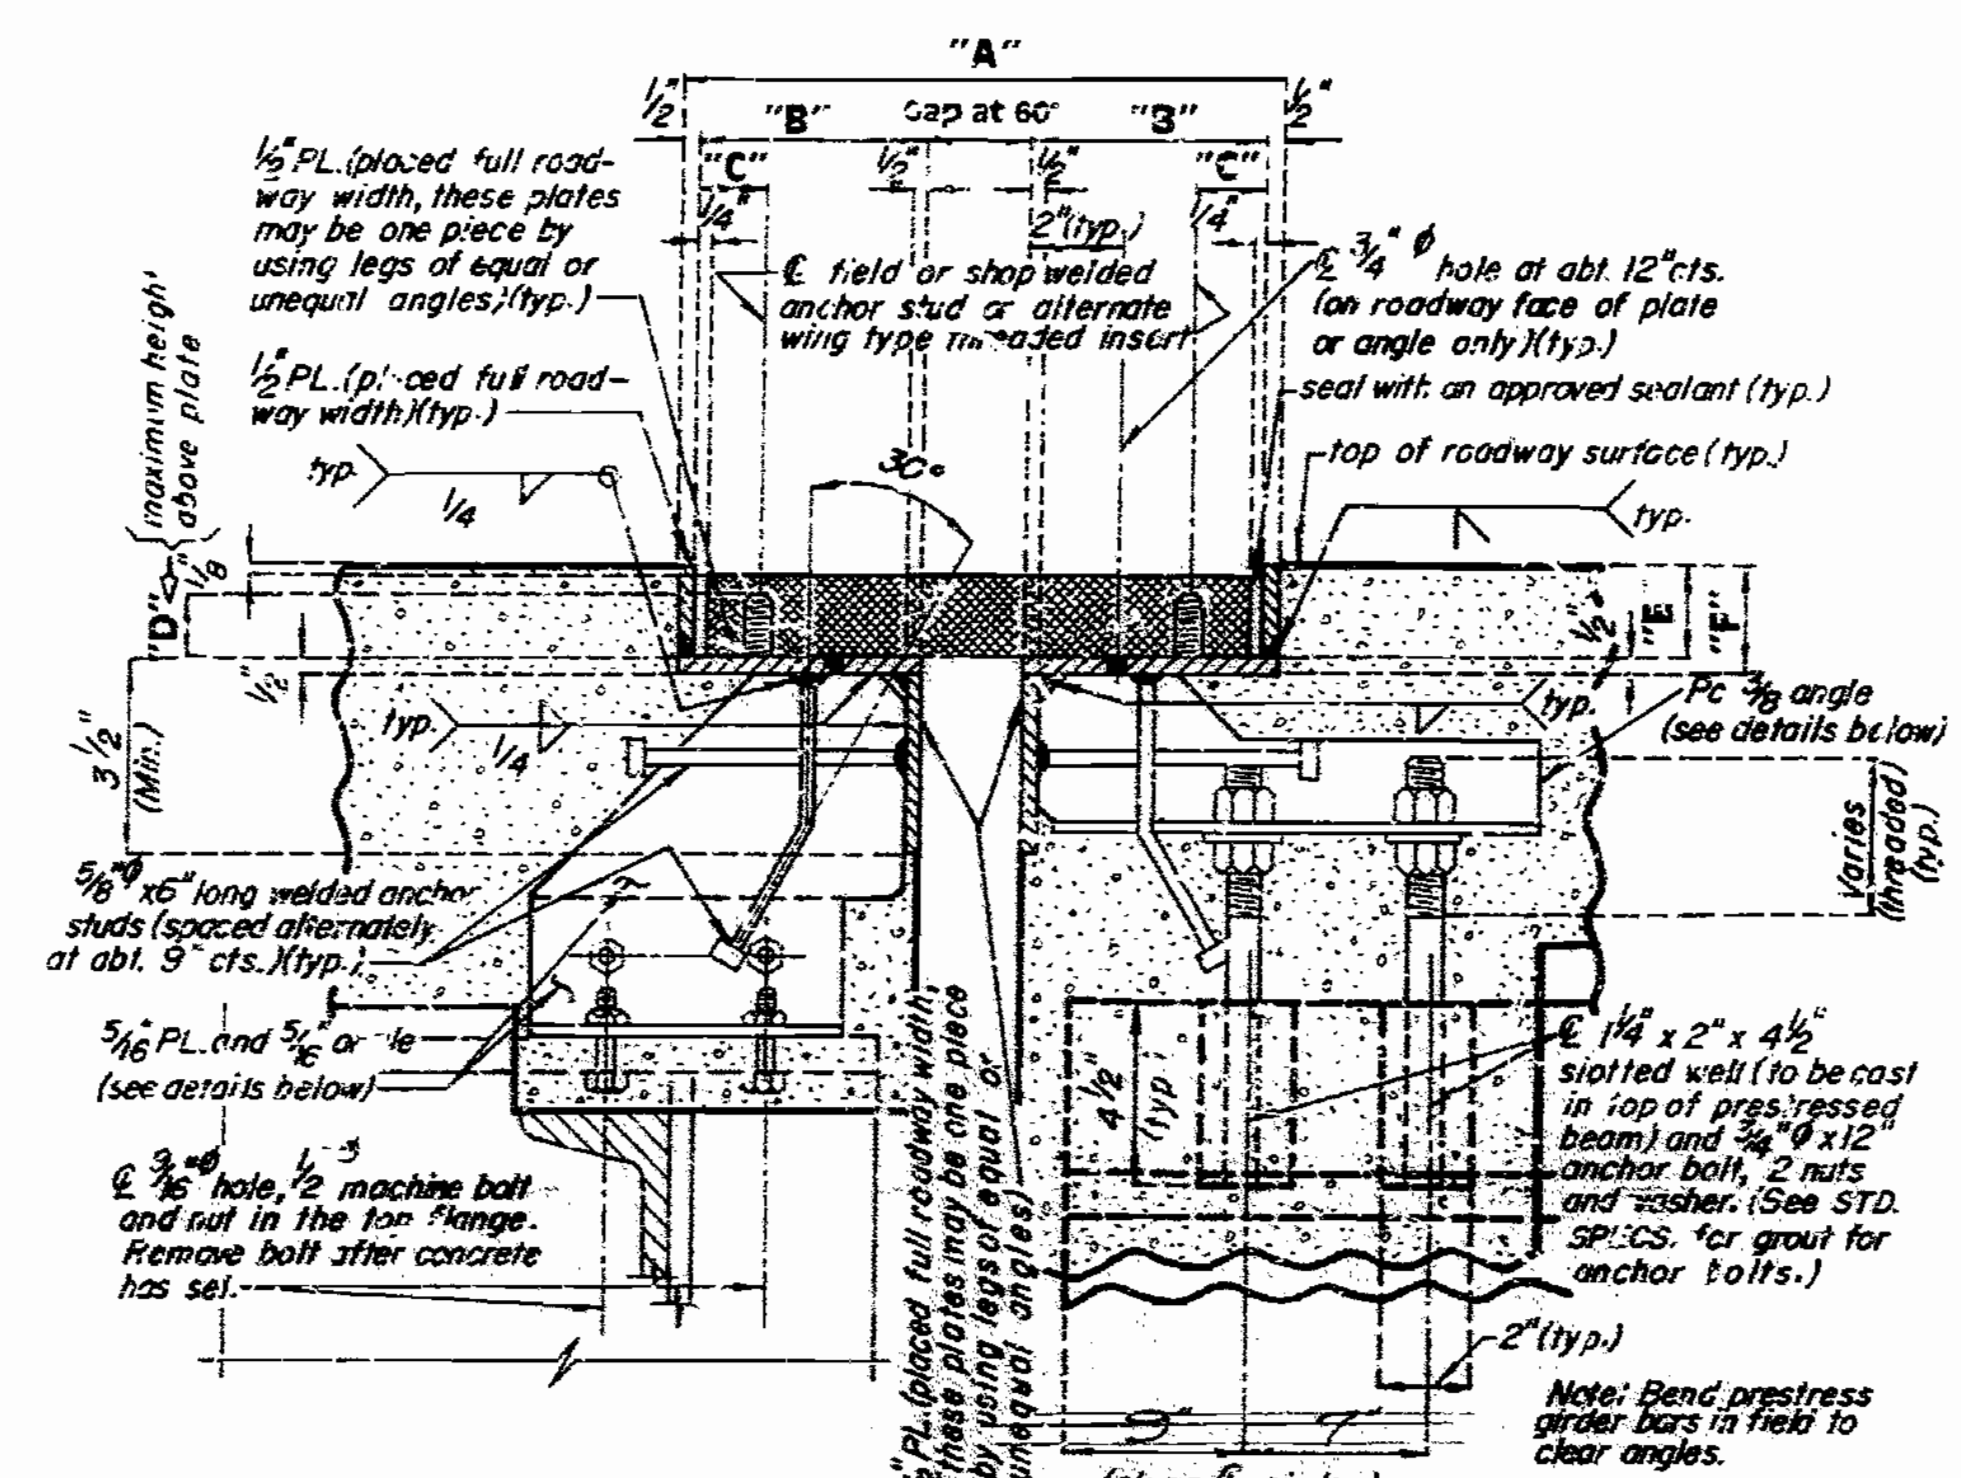

PART SECTION THRU ARMORED JOINT

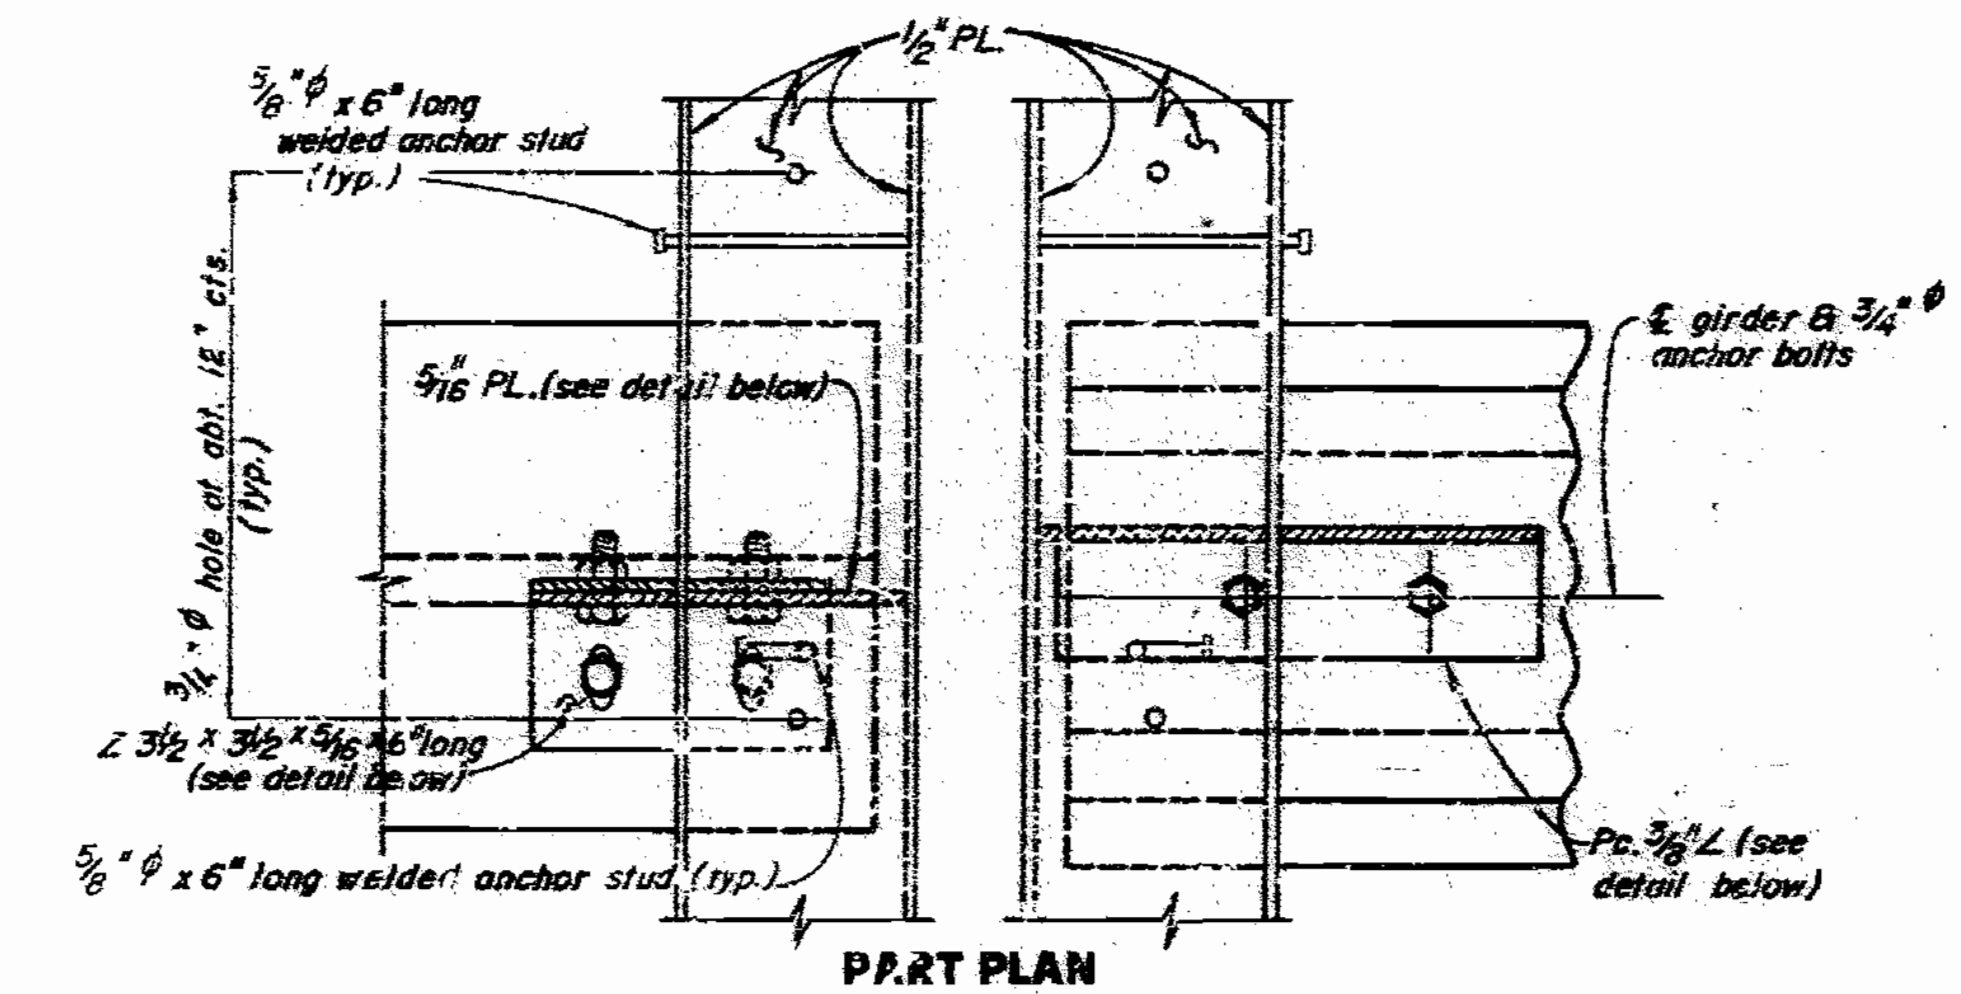

PART PLAN

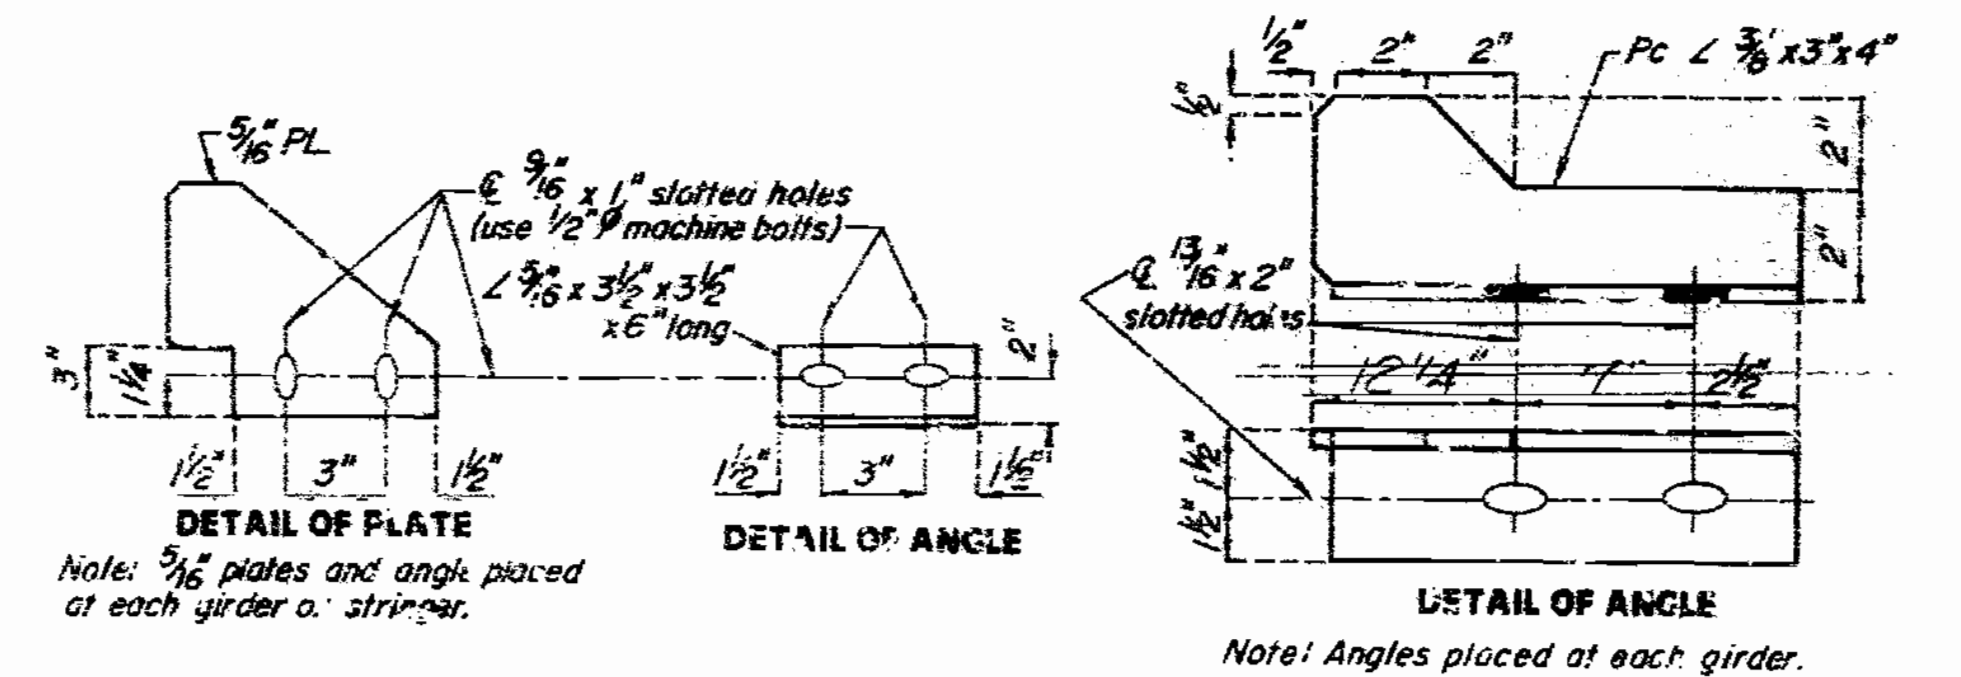

DETAIL OF PLATE


DETAIL OF ANGLE

DETAIL OF ANGLE


LOCATION	ACCEPTABLE ALTERNATE TYPES	EXP. GAP AT 60°	TABLE OF DIMENSIONS						ANCHOR STUDS		
			"A" AT 60°	"B"	"C"	"D"	"E"	"F"	SIZE	SPA.	"G"
			INCHES	INCHES	INCHES	INCHES	INCHES	INCHES	INCHES	INCHES	INCHES
BENT NO. 17	DELASTIFLEX LM300	2"	12 3/8"	4 1/16"	2 9/16"	1 1/8"	2"	2 1/2"	1/2"	5"	45
	BEN-STRIP CCL 3"	2 1/4"	11 3/4"	4 1/4"	1 3/4"	1 1/4"	1 1/4"	2 1/4"	3/8"	12"	65
	DN-FLEX 35	2"	11 1/2"	4 1/4"	1 3/8"	1 1/4"	2 3/8"	2 1/8"	3/8"	10"	65
	WALDO BENDOFLEX 450	2"	11 1/2"	4 1/4"	1 3/8"	1 1/4"	2 1/4"	2 1/8"	3/8"	12"	50
	FEL-SPAN TADARS	2"	12"	4 1/2"	1 3/8"	1 1/4"	2 1/4"	2 1/8"	3/8"	12"	50
ACME TROJAN TR400	2 1/2"	12"	4 1/4"	1 1/4"	1 1/8"	1 3/4"	2 1/4"	1/2"	12"	40	

NOTE: ALL DIMENSIONS ARE AT RIGHT ANGLES. EXPANSION GAP AND DIMENSION "A" SHALL BE INCREASED 9/16" FOR EACH 10° FALL IN TEMPERATURE AND DECREASED 3/16" FOR EACH 10° RISE IN TEMPERATURE.


**GENERAL NOTES:**  
 THE CERTIFIED NUTS AND BOLTS FOR THE ANCHOR STUDS OR WING TYPE THREADED INSERTS SHALL BE TIGHTENED TO THE FOOT POUNDS "G" SPECIFIED IN THE TABLE OF DIMENSIONS. RETIGHTEN TO "G" FOOT POUNDS A MINIMUM OF 30 MINUTES AFTER INITIAL TIGHTENING. THE WELDED ANCHOR STUDS SHALL BE THE PRODUCED BASE TYPE.  
 MATERIAL FOR THE ARMORED JOINT SHALL BE A36 STRUCTURAL GRADE STEEL ANCHORS FOR THE ARMORED JOINT SHALL BE APPROVED STANDARD WELDED ANCHORS (C1010 THRU C1020).  
 SEE SPECIAL PROVISIONS FOR PAINTING.  
 ANCHOR BOLTS IN THE BARRIER CURB SHALL BE CAST-IN-PLACE, GROUTED OR CONE-EXPANSION TYPE. HOLES IN THE BARRIER CURB FOR ANCHORS SHALL NOT BE DRILLED UNTIL THE CONCRETE IS AT LEAST 7 DAYS OLD.  
 PLAN DIMENSIONS ARE BASED ON INSTALLATION AT 60°F. THE EXPANSION GAP AND OTHER DIMENSIONS SHALL BE ADJUSTED DURING INSTALLATION FOR COMPLIANCE WITH ANY TEMPERATURE CHANGE.  
 CONTACT SURFACE OF STEEL TO ALUMINUM SHALL BE INSULATED WITH THE MATERIAL SPECIFIED ON THE SHOP DRAWINGS.  
 FURNISHING, PAINTING, AND INSTALLING THE STRUCTURAL STEEL ARMORED JOINT AND CURB PLATES SHALL BE INCLUDED IN THE CONTRACT UNIT PRICE FOR ELASTOMERIC EXPANSION JOINT SEAL.  
 BOLT CAVITIES TO BE FILLED WITH APPROVED SEALANT IN COMPLIANCE WITH MANUFACTURER'S CERTIFICATION.

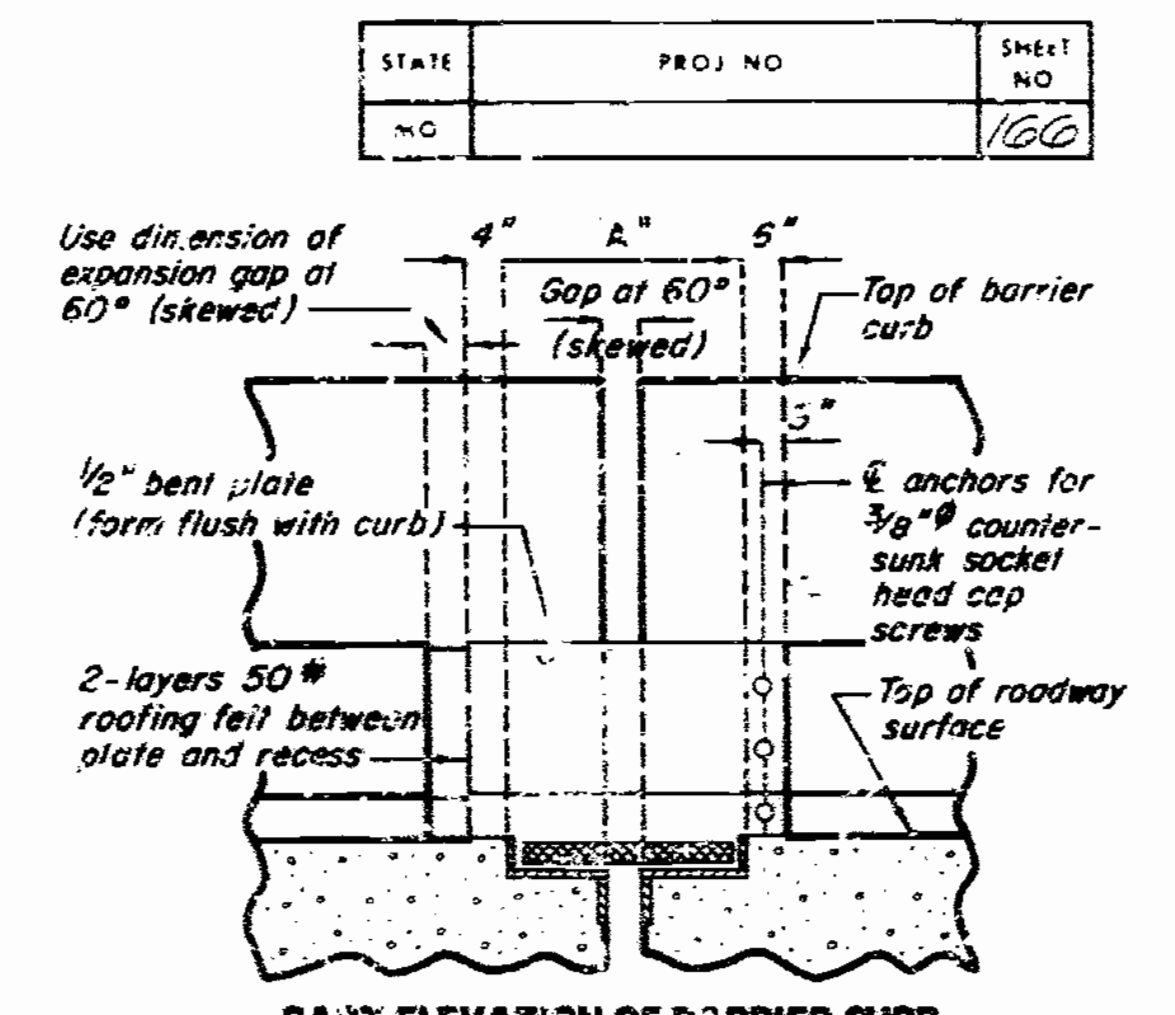


PAINT ELEVATION OF BARRIER CURB

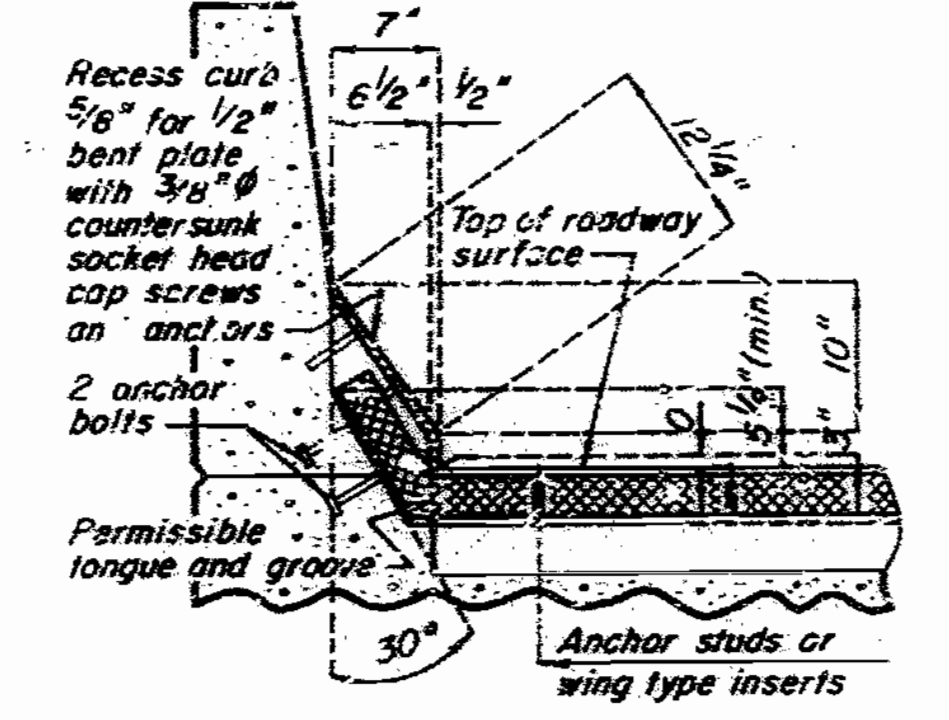


TYPE "A" CURB

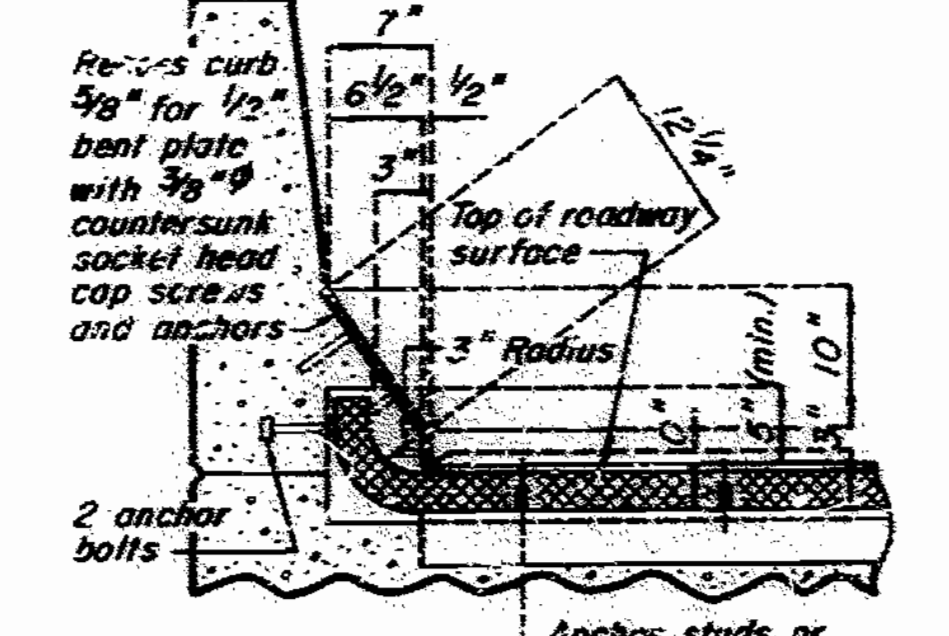

TYPE "B" CURB

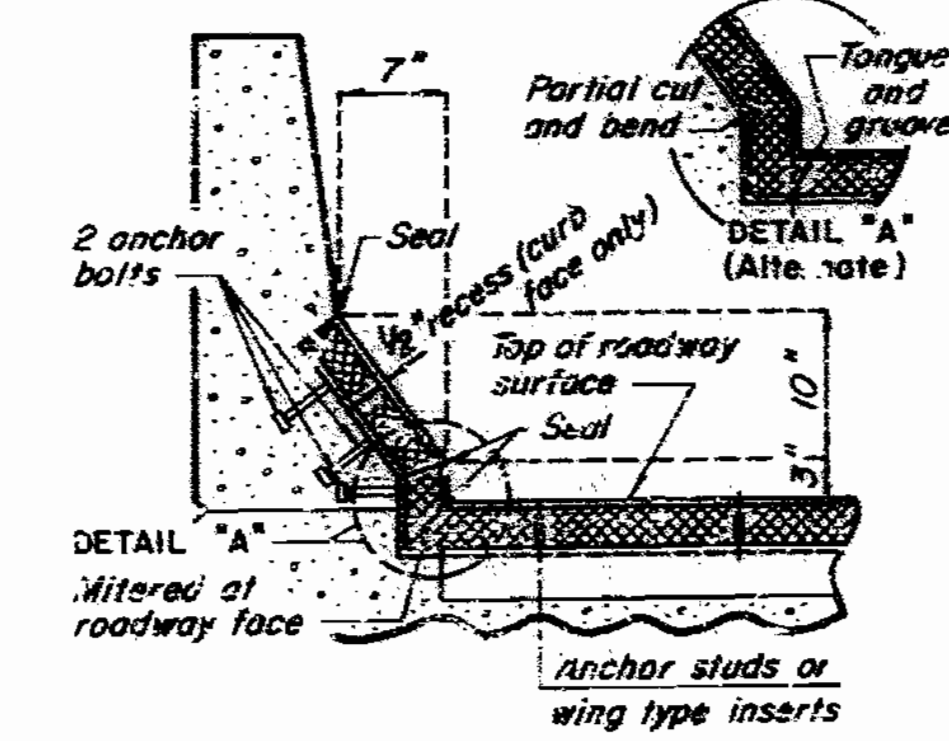

TYPE "C" CURB

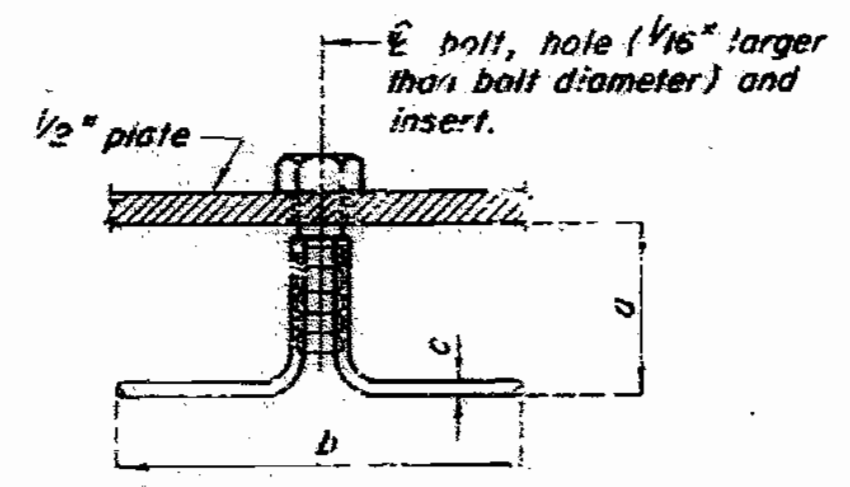

BOLT DIAMETER	SAFE LOAD TENSION (LBS.) (MIN.)	APPROX. ULT. CAP. TENSION (LBS.) (MIN.)	DIMENSIONS (INCHES)		
			a	b	c
1/2"	900	8,000	1-5/8"	5"	218"
5/8"	1,300	9,200	1-5/8"	5"	218"
3/4"	1,800	13,700	2-1/4"	6"	262"
7/8"	2,000	16,200	2-1/2"	6-1/2"	306"
1"	2,000	16,200	2-1/2"	6-1/2"	306"

DETAILS OF ALTERNATE WING TYPE THREADED INSERT (MACHINE BOLTS NEED ONLY BE USED TO SECURE THE WING TYPE THREADED INSERTS TO THE STEEL PLATE UNTIL THE CONCRETE HAS ATTAINED 3,000 P.S.I.)

ALTERNATE CURB TREATMENTS

DETAILS OF ELASTOMERIC EXPANSION JOINT SEAL AT BENT NO. 17

Note: This drawing is not to scale. Follow dimensions.

Elastomeric Expansion Joint Seal SPS-INT. BT. REVISED FEB. 1978 MAY 1987

Detailed MAR. 1985  
 Checked Nov. 1988

Sheet No. 86 of 88


JACKSON COUNTY

A-2745


STATE	PROJ NO	SHEET NO
MO		167

LOCATION	ACCEPTABLE ALTERNATE TYPES	EXP. GAP AT 60°	"A" AT 60°						ANCHOR STUDS		
			"B"	"C"	"D"	"E"	"F"	SIZE	SPA.	"G"	
BENT NO. 20	ON-FLEX 45	2 1/4"	11 3/4"	4 1/4"	1 5/8"	1 1/2"	2 3/4"	3 1/4"	5/8"	12"	65
	WABO BENDOFLEX 450	2 1/2"	12"	4 1/4"	1 5/8"	1 1/4"	2 3/4"	3 1/4"	1/2"	12"	50
	FEL-SPAN TAOA CS	2 1/4"	12 1/4"	4 1/2"	1 5/8"	1 1/2"	2 1/4"	2 3/4"	1/2"	12"	50


NOTE: ALL DIMENSIONS ARE AT RIGHT ANGLES. EXPANSION GAP AND DIMENSION "A" SHALL BE INCREASED 1/8" FOR EACH 10° FALL IN TEMPERATURE AND DECREASED 1/8" FOR EACH 10° RISE IN TEMPERATURE.

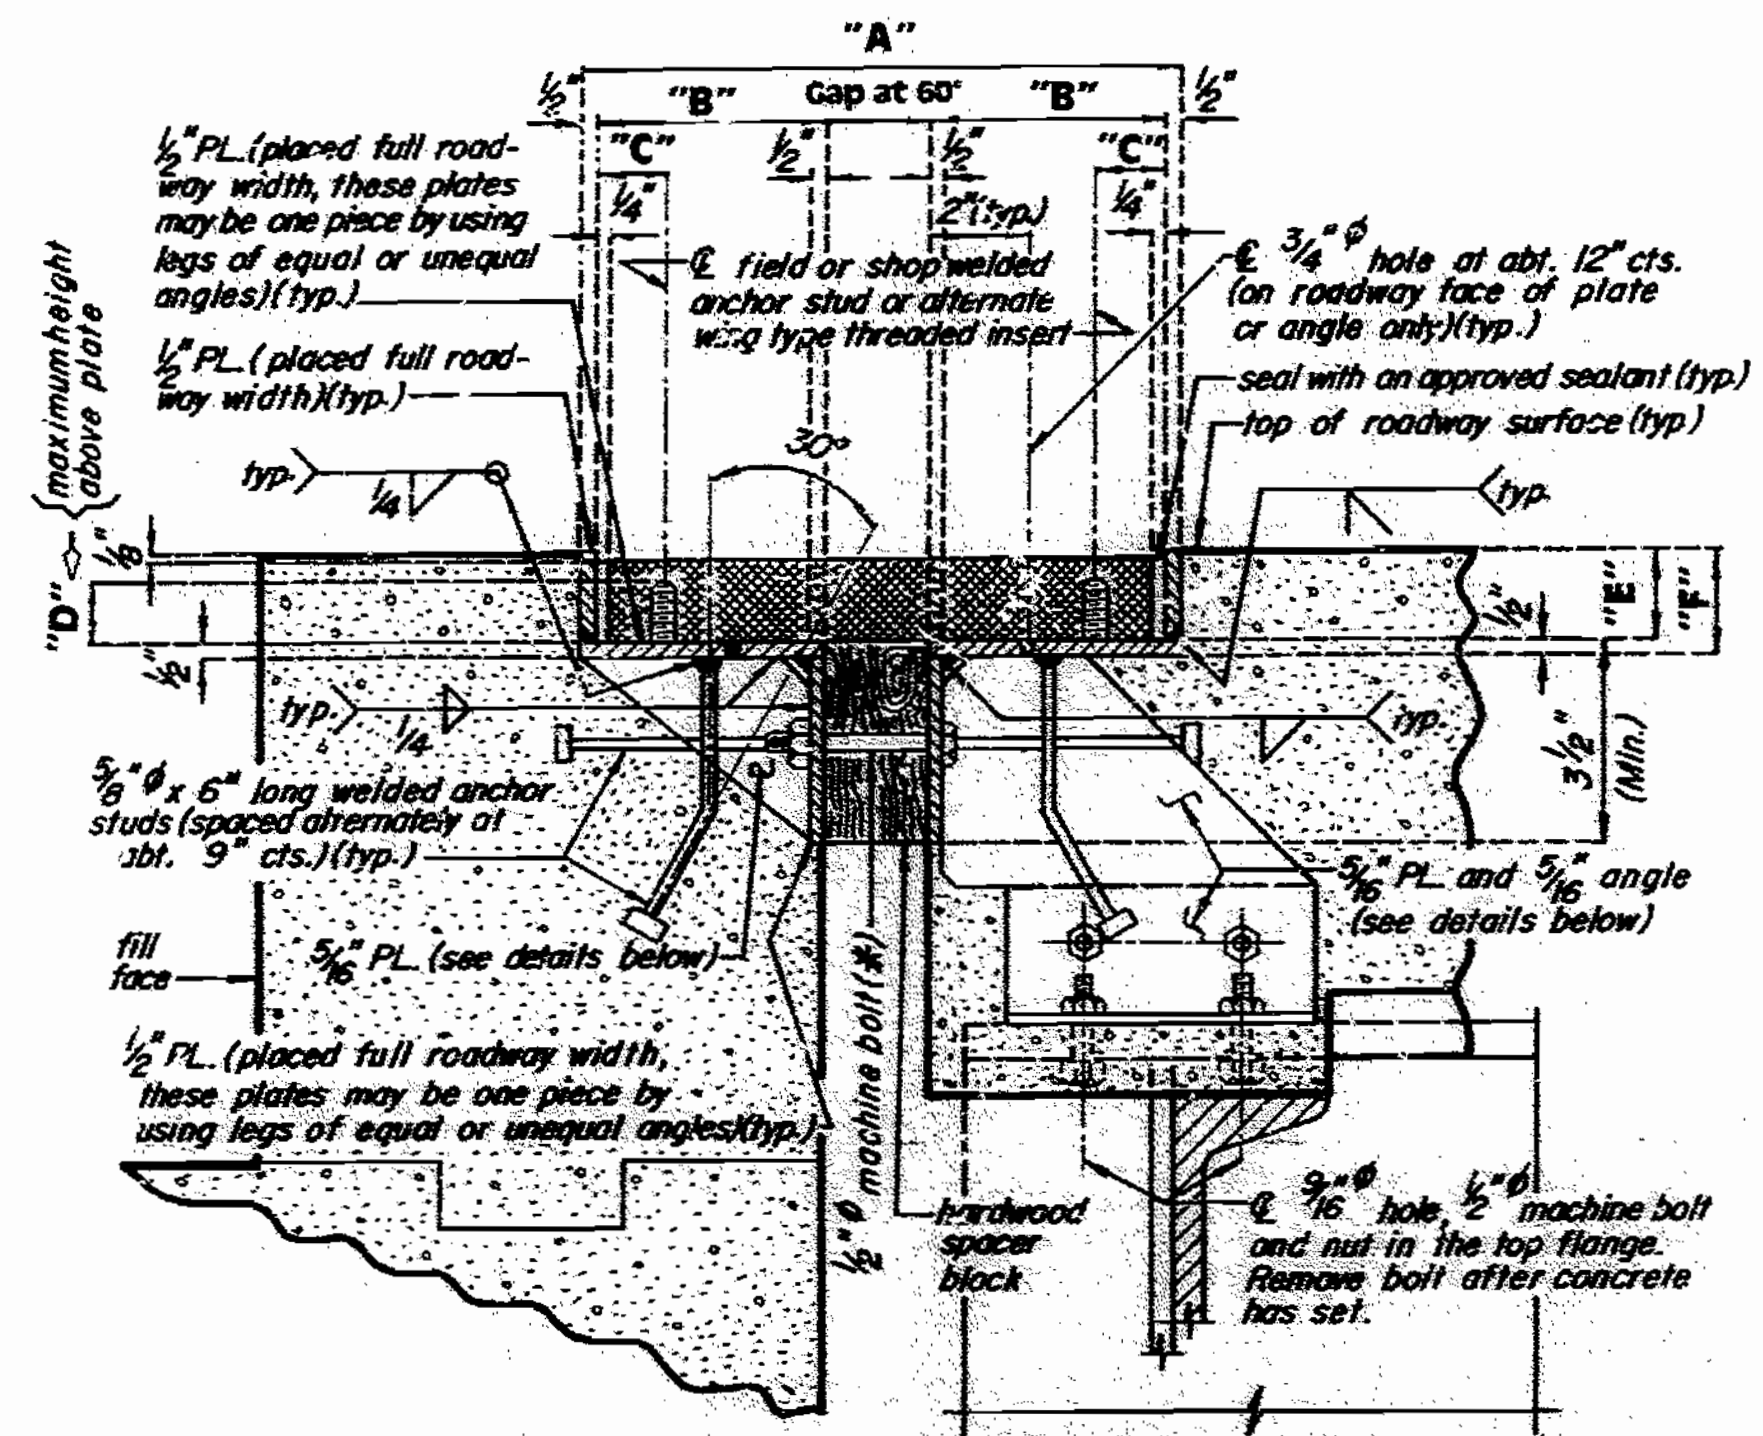


PART SECTION THRU ARMORED JOINT

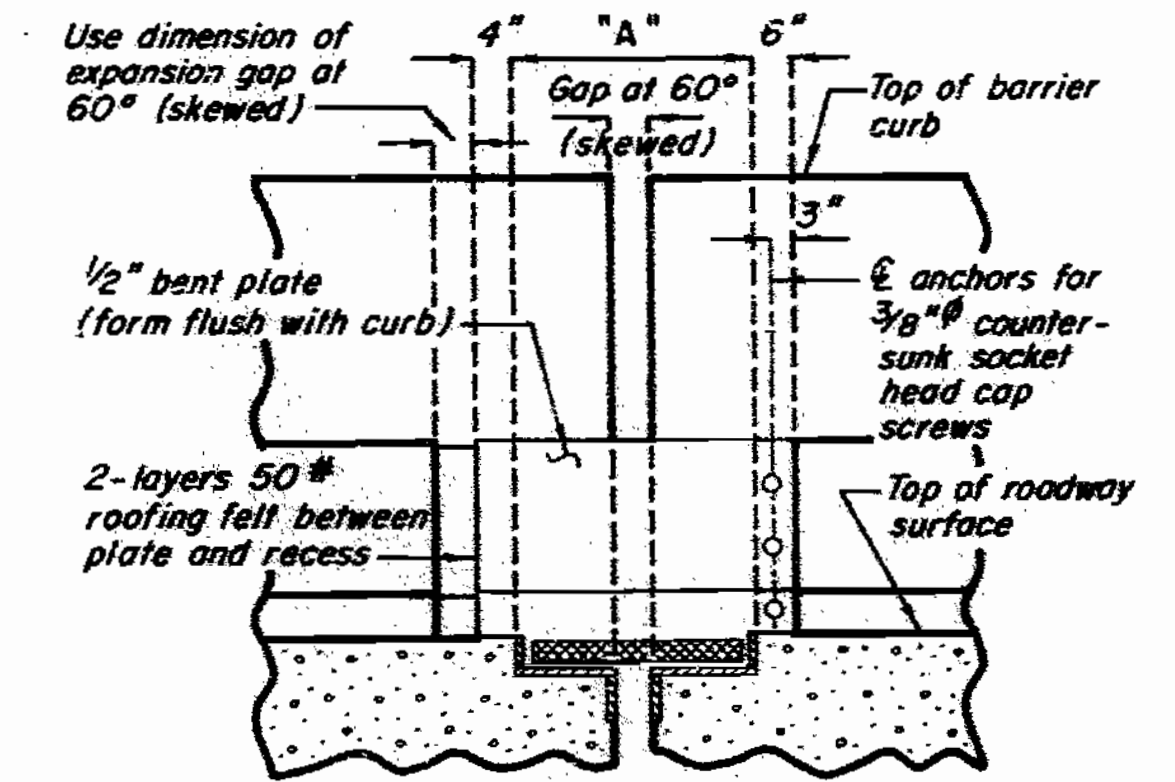


PART ELEVATION OF BARRIER CURB

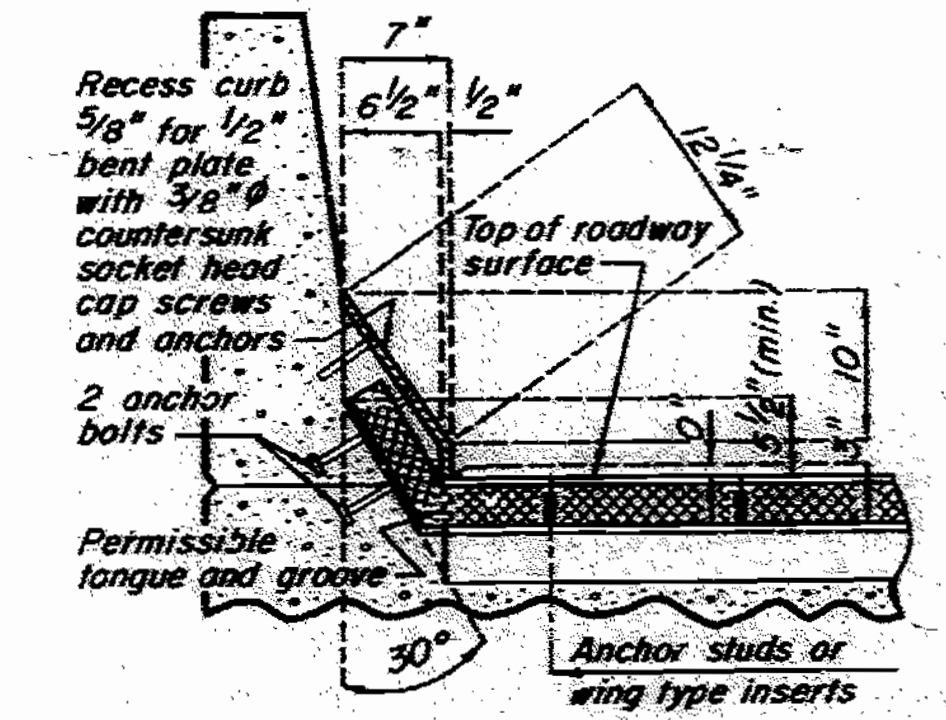

TYPE "A" CURB

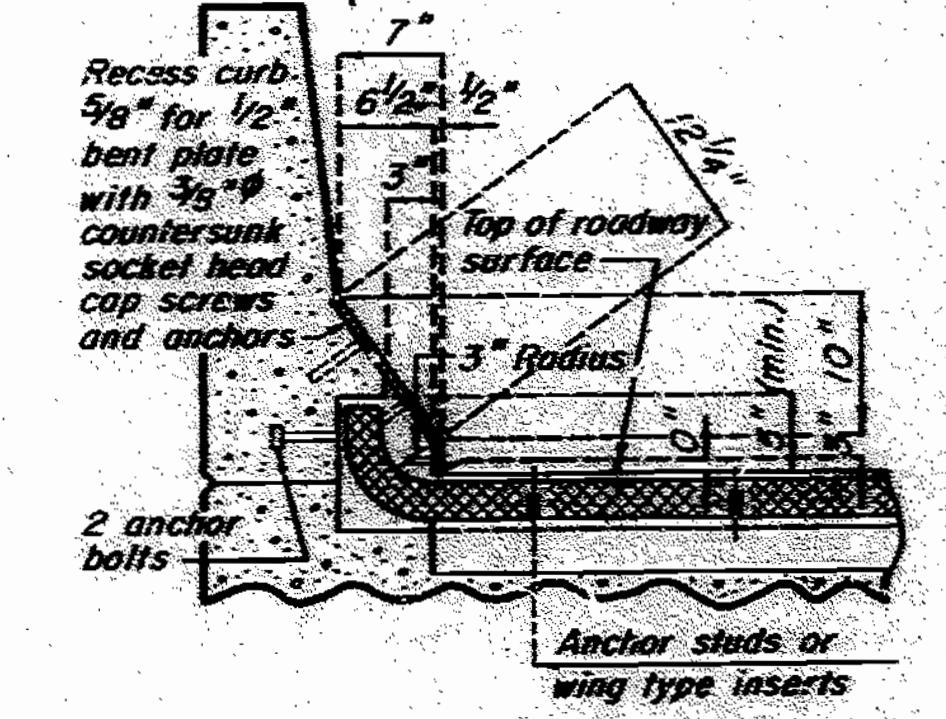


TYPE "B" CURB

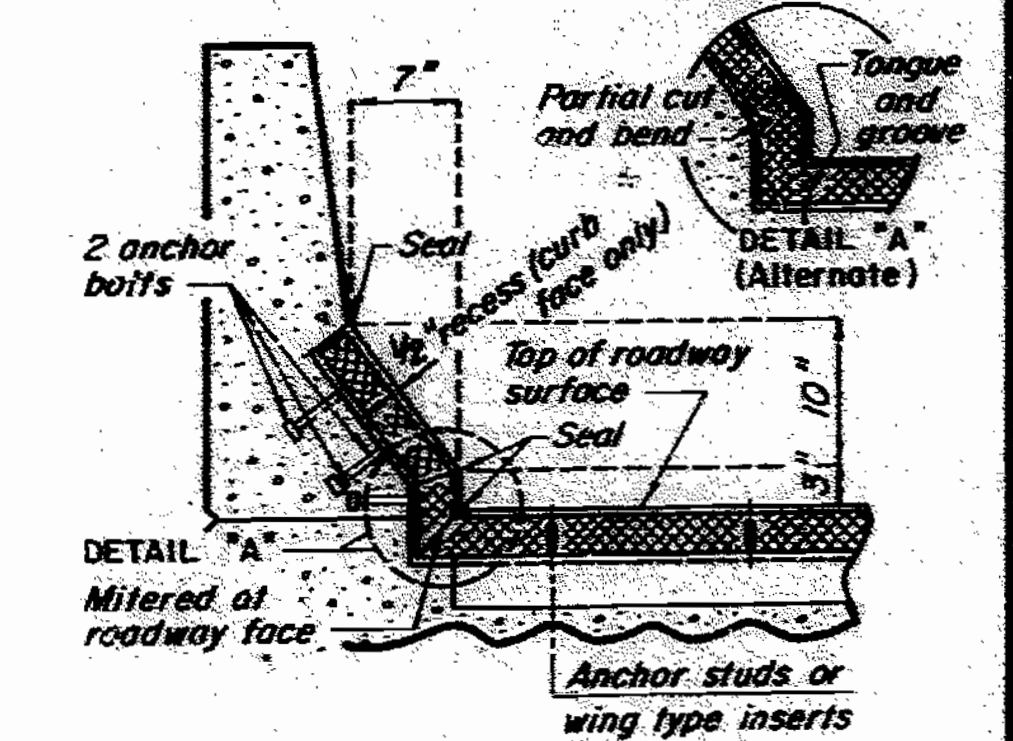


ALTERNATE CURB TREATMENTS


**GENERAL NOTES:**  
 THE CERTIFIED NUTS AND BOLTS FOR THE ANCHOR STUDS OR WING TYPE THREADED INSERTS SHALL BE TIGHTENED TO THE FOOT POUNDS "G" SPECIFIED IN THE TABLE OF DIMENSIONS. RETIGHTEN TO "G" FOOT POUNDS A MINIMUM OF 30 MINUTES AFTER INITIAL TIGHTENING. THE WELDED ANCHOR STUDS SHALL BE THE REDUCED BASE TYPE.  
 MATERIAL: FOR THE ARMORED JOINT SHALL BE A36 STRUCTURAL GRADE STEEL ANCHORS FOR THE ARMORED JOINT SHALL BE APPROVED STUD WELDED ANCHORS (C1010 THRU C1020).  
 SEE SPECIAL PROVISIONS FOR PAINTING.  
 ANCHOR BOLTS IN THE BARRIER CURB SHALL BE CAST-IN-PLACE, GROUTED OR CONE-EXPANSION TYPE. HOLES IN THE BARRIER CURB FOR ANCHORS SHALL NOT BE DRILLED UNTIL THE CONCRETE IS AT LEAST 7 DAYS OLD.  
 PLAN DIMENSIONS ARE BASED ON INSTALLATION AT 60°F. THE EXPANSION GAP AND OTHER DIMENSIONS SHALL BE ADJUSTED DURING INSTALLATION FOR COMPLIANCE WITH ANY TEMPERATURE CHANGE.  
 CONTACT SURFACE OF STEEL TO ALUMINUM SHALL BE INSULATED WITH THE MATERIAL SPECIFIED ON THE SHOP DRAWINGS.  
 FURNISHING, PAINTING AND INSTALLING THE STRUCTURAL STEEL ARMORED JOINT AND CURB PLATES SHALL BE INCLUDED IN THE CONTRACT UNIT PRICE FOR ELASTOMERIC EXPANSION JOINT SEAL.  
 BOLT CAVITIES TO BE FILLED WITH APPROVED SEALANT IN COMPLIANCE WITH MANUFACTURER'S CERTIFICATION.  
 PLATES SHALL BE FIELD ADJUSTED BY ADDING OR REMOVING METAL SHIMS (2" x 3"), AS REQUIRED FOR TEMPERATURE CORRECTION. THE EXPANSION GAP SHALL BE ADJUSTED FOR ANY TEMPERATURE CORRECTION PRIOR TO POURING TOP OF END BENT BACKWALL.

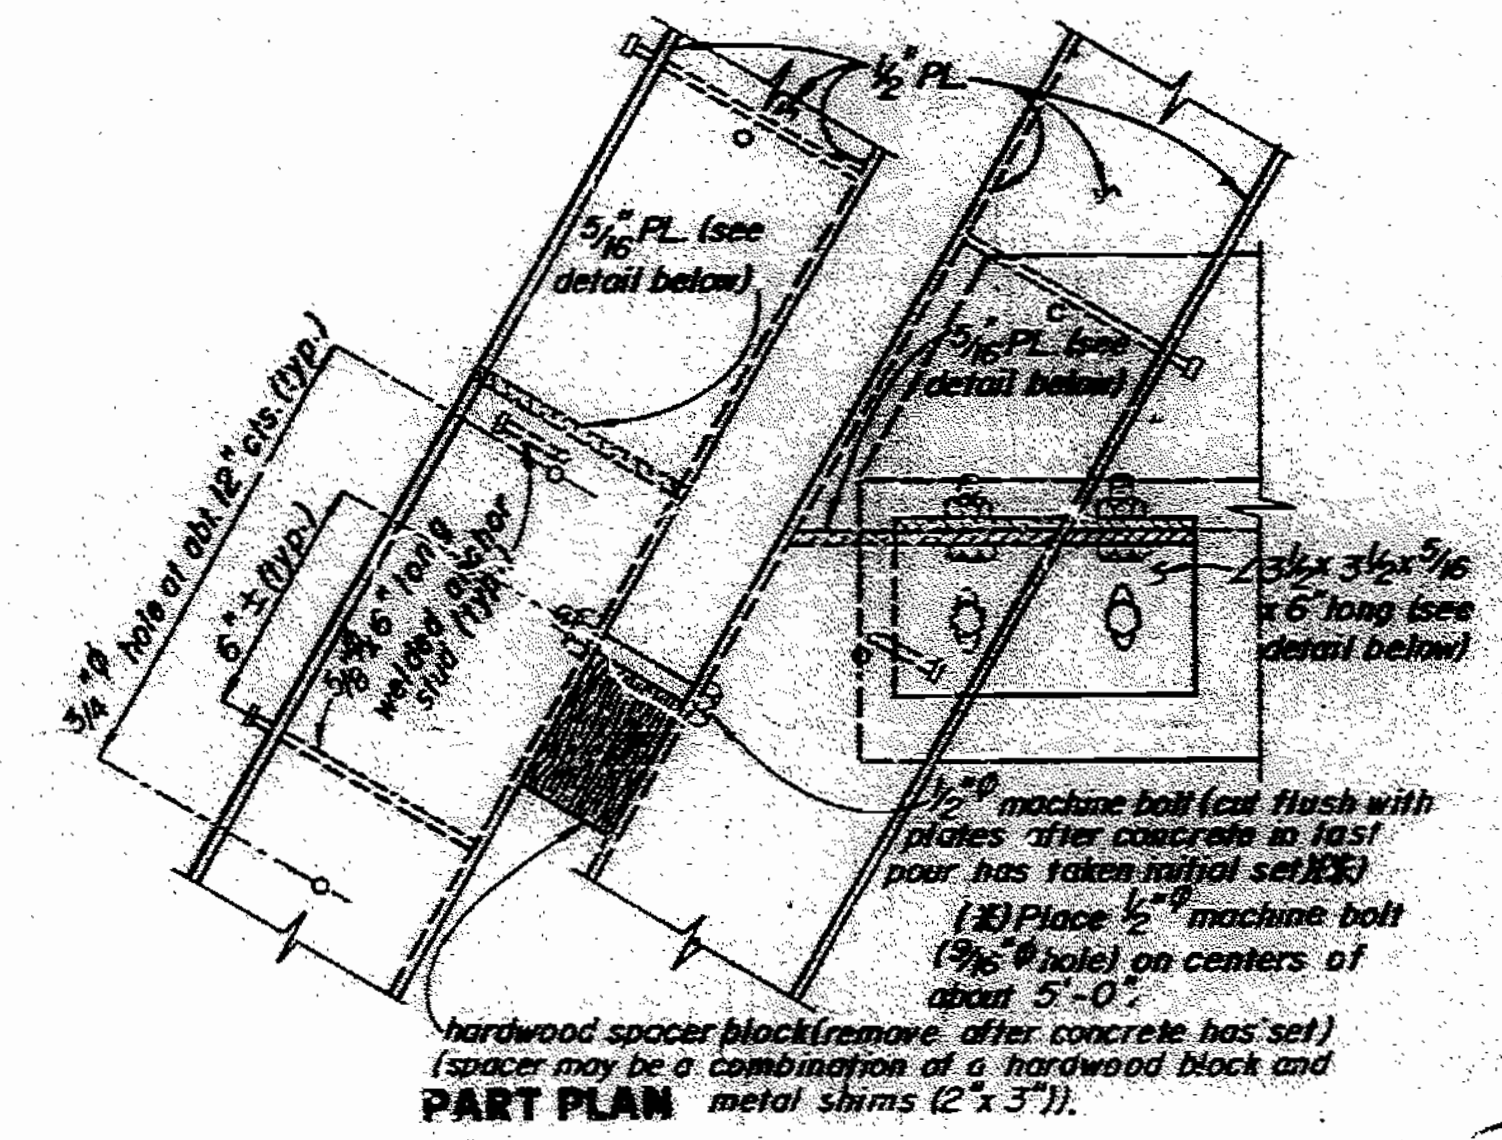

PART PLAN

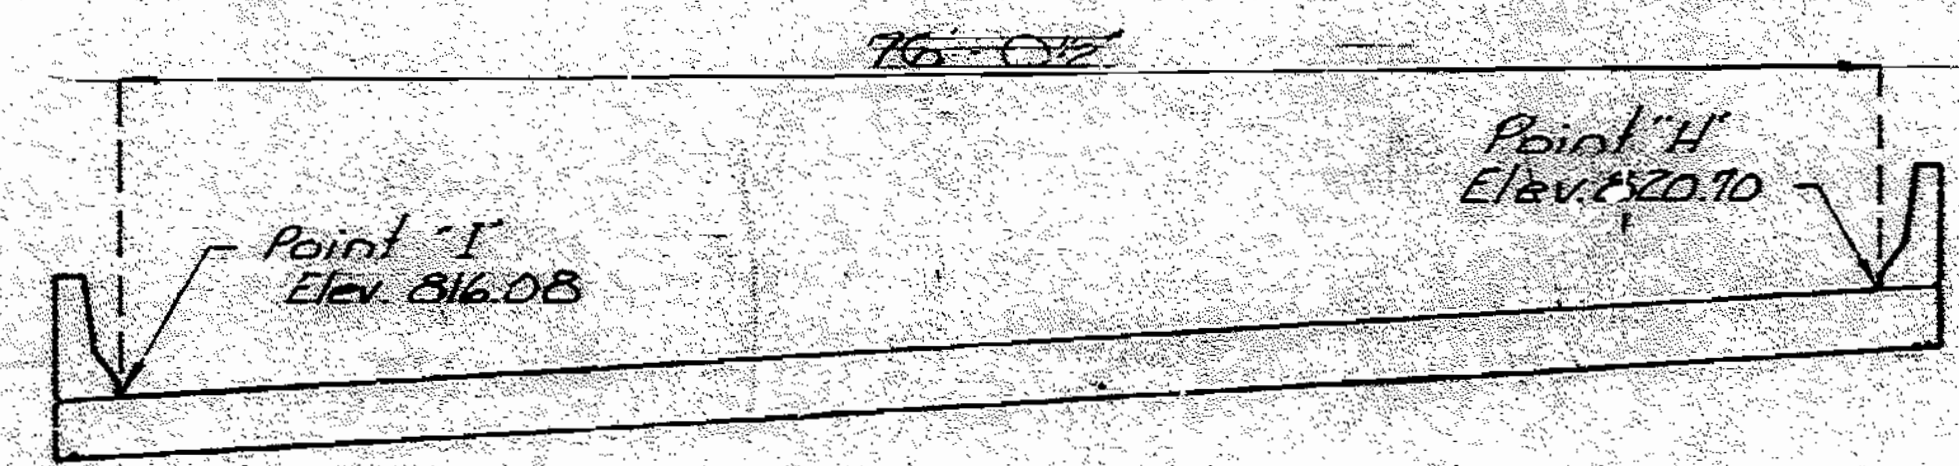

SECTION THRU 1/2 OF EXPANSION GAP

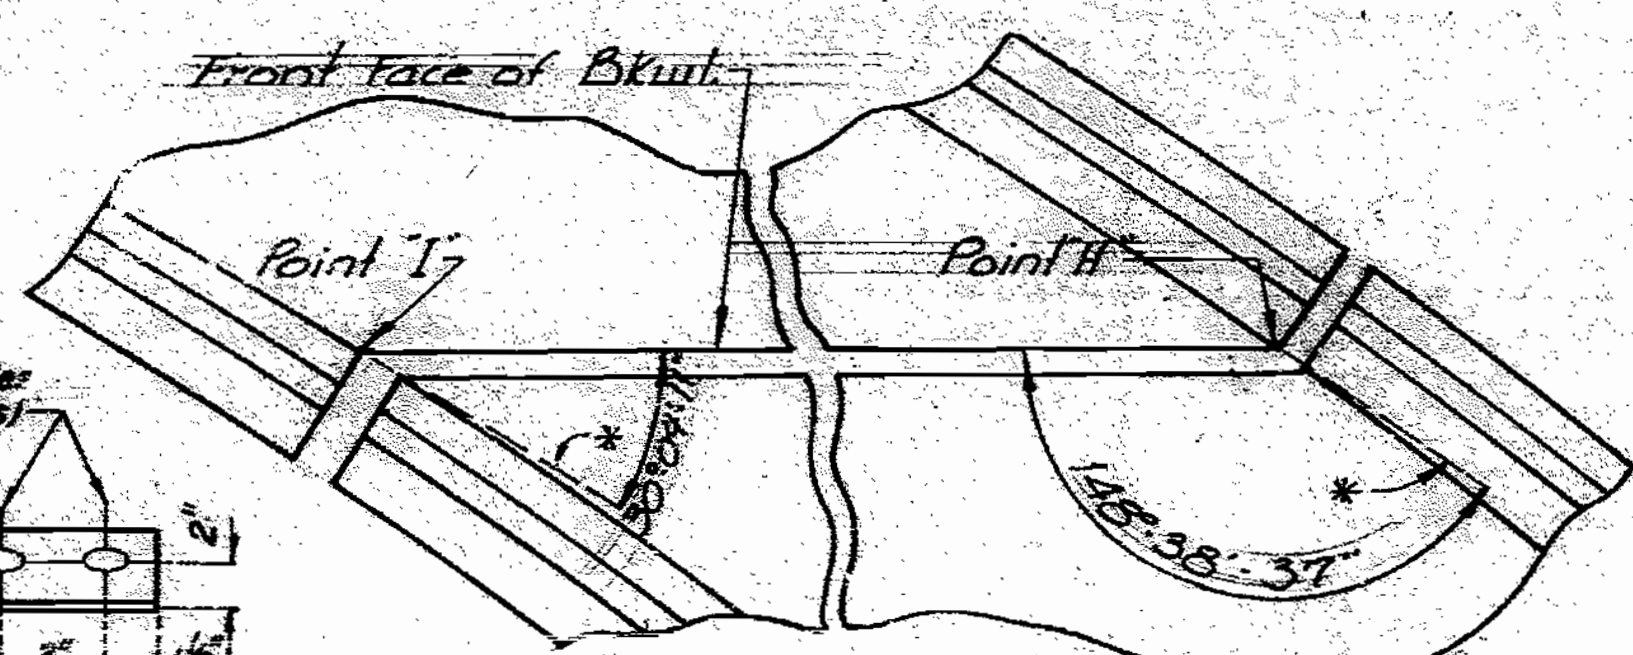

PART PLAN

BOLT DIAMETER	SAFE LOAD TENSILE (LBS./SQ. IN.)	APPROX. ULT. CAP. TENSION (LBS./SQ. IN.)	DIMENSIONS (INCH)		
			a	b	c
1/2"	800	8,000	1-5/8"	5"	218"
5/8"	1,300	9,200	1-5/8"	5"	218"
3/4"	1,800	13,200	2-1/8"	6"	262"
7/8"	2,000	16,200	2-1/2"	6-1/2"	306"
1"	2,000	19,200	2-1/2"	6-1/2"	306"

(MACHINE BOLTS NEED ONLY BE USED TO SECURE THE WING TYPE THREADED INSERTS TO THE STEEL PLATE UNTIL THE CONCRETE HAS ATTAINED 3,000 PSI)

DETAILS OF ELASTOMERIC EXPANSION JOINT SEAL AT BENT NO. 20


Note: This drawing is not to scale. Follow dimensions.

209 183  
 Elastomeric Expansion Jt. Seal  
 SPS- END. BT. REVISED  
 FEB. 1978 MA Y 1987


DETAILED MAR. 1988  
 CHECKED Nov. 1988

Sheet No. 87 of 98

STATE	PROJ. NO.	SHEET NO.
MO.		168

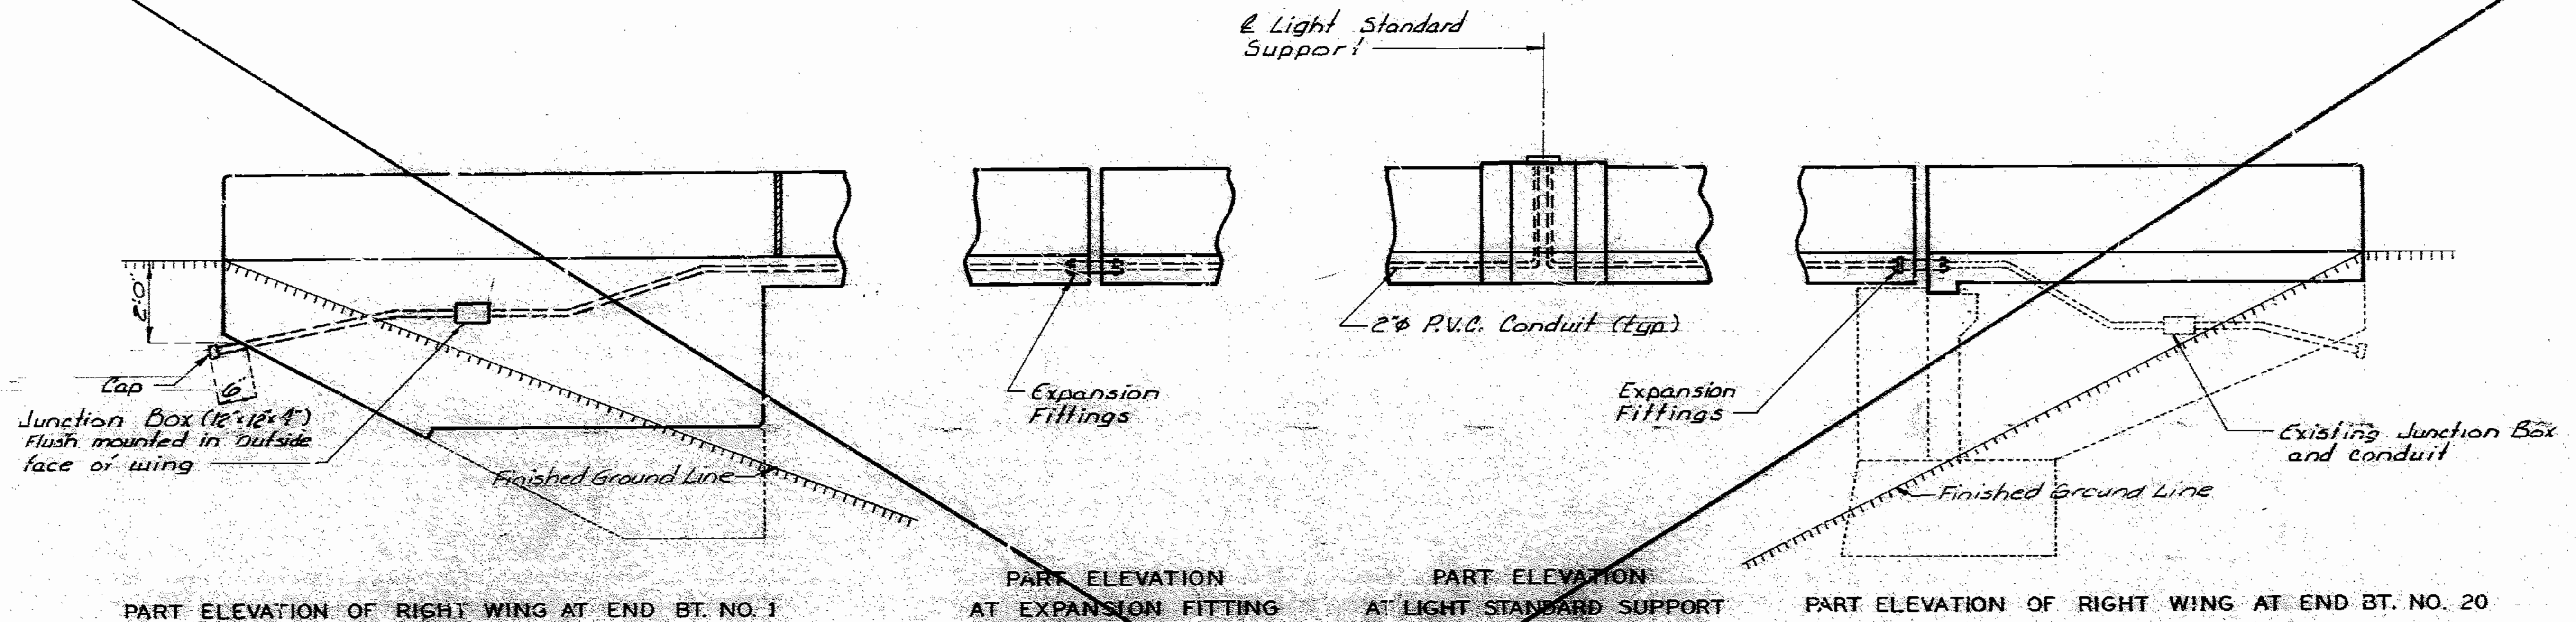


CONDUIT DETAILS

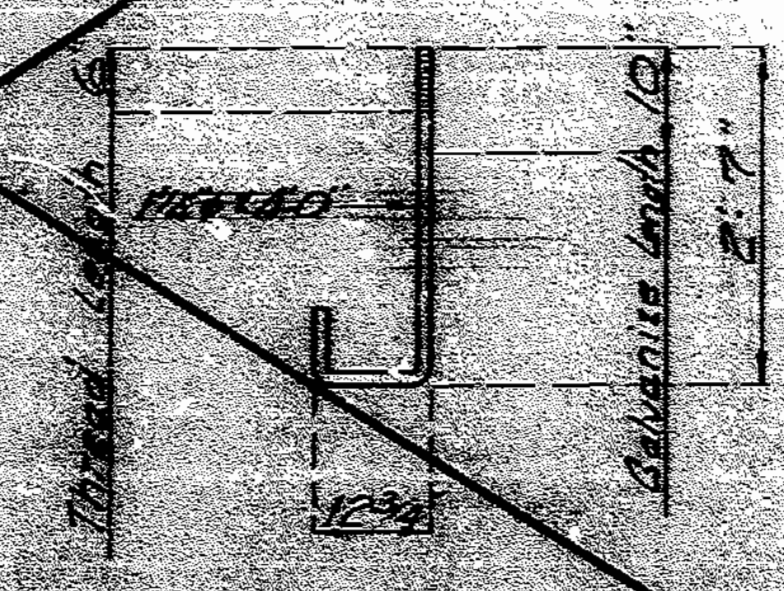

Notes:

- See Elevation of Right Barrier Curb for location of Expansion Fittings and Light Standard Support.
- Cost of furnishing and placing anchor bolts for light standard shall be included in the Contract Unit Price for other items.
- All conduit shall be rigid non-metallic Schedule 40 heavy wall PVC (Polyvinyl Chloride Plastic) with 3" minimum cover in concrete. Each section of conduit shall bear the Underwriters Laboratories Inc. (UL) label.
- Shall reinforcing steel in field where necessary to clear conduit and junction boxes.
- Light Standards, wiring and fixtures shall be furnished and installed by others.
- Top of light standard supports shall be made horizontal; anchor bolts shall be placed vertically.
- For details of Light Standards and wiring see Electrical Plans.
- Expansion fittings shall provide a minimum movement in either direction of 4" at open joints. Expansion fittings shall be equal to Carlson Electrical Construction Products or Triangle Conduit and Cable Company, Inc.
- All end bolt junction boxes shall be PVC molded flush surfaces mounted and equal to Carlson Electrical Construction Products or Triangle Conduit and Cable Co. Inc. The conduit terminations be permanent or separable. The terminations and covers shall be of watertight construction.
- Weepholes shall be provided at appropriate locations to drain any moisture in the conduit lines.

VOID

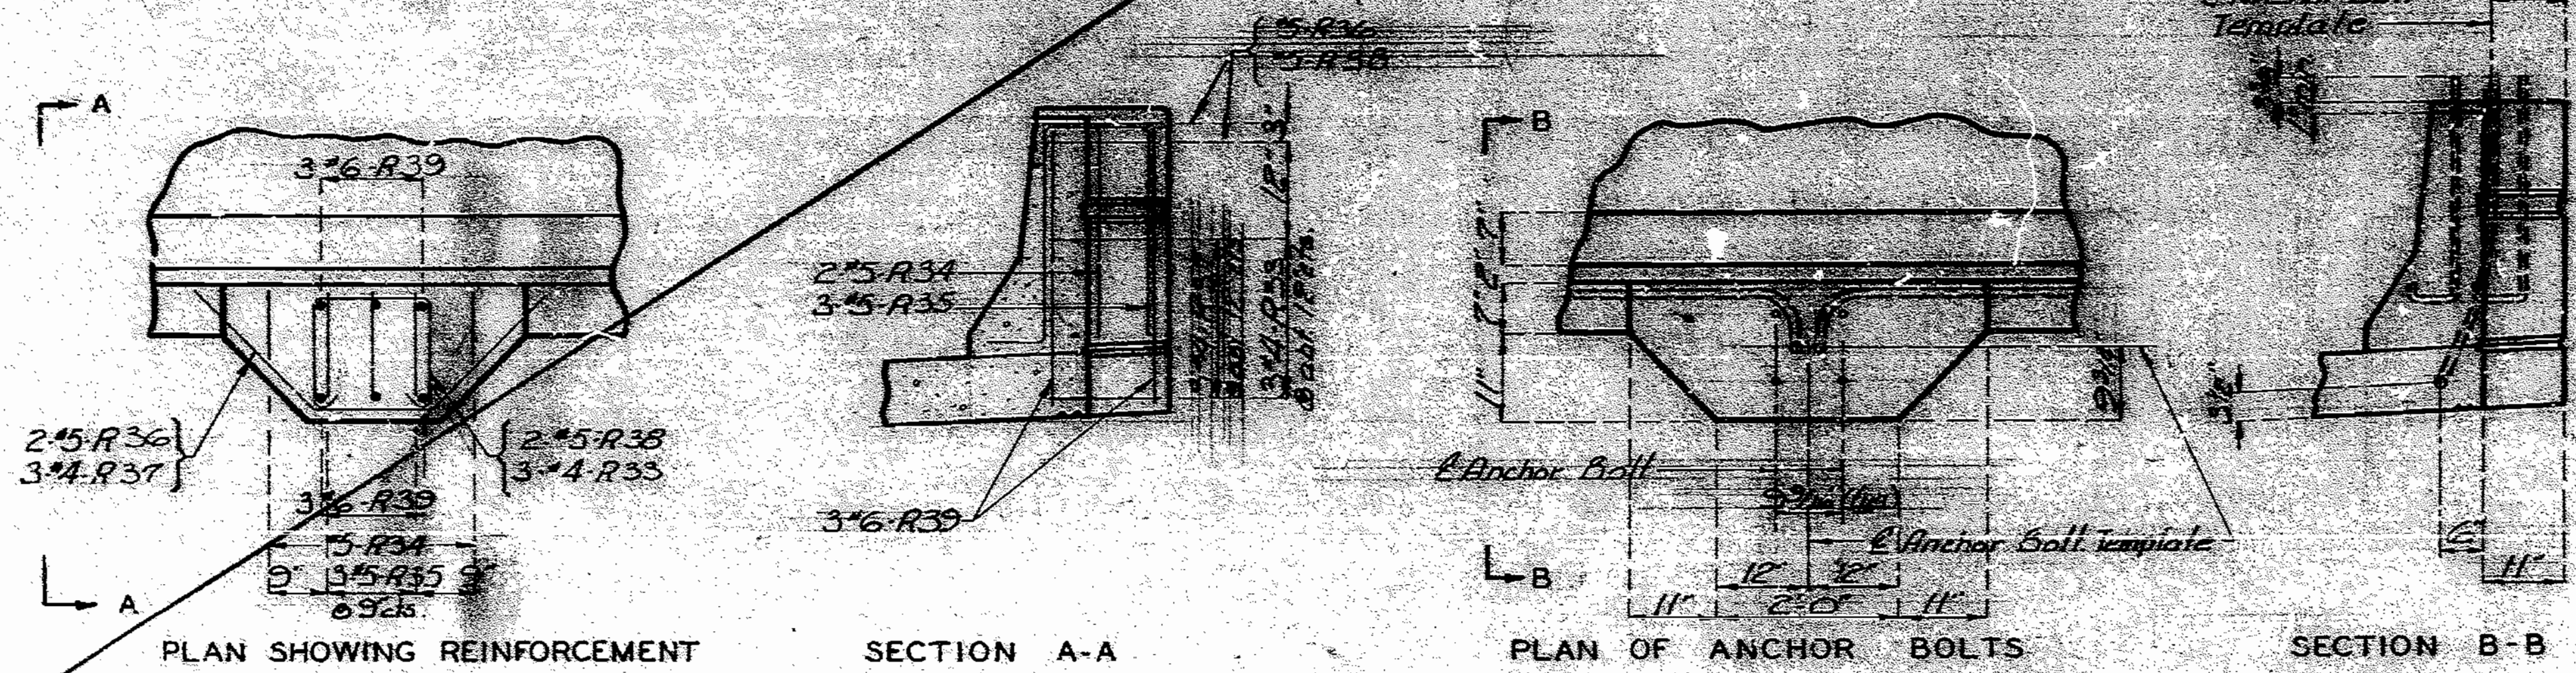

DETAILED September 1988  
CHECKED Oct. 1988




Note: This drawing is not to scale. Follow dimensions.

VOID  
Sheet No. 38 of 38

JACKSON COUNTY

A-2745

STATE	PROJ. NO.	SHEET NO.
MO		169

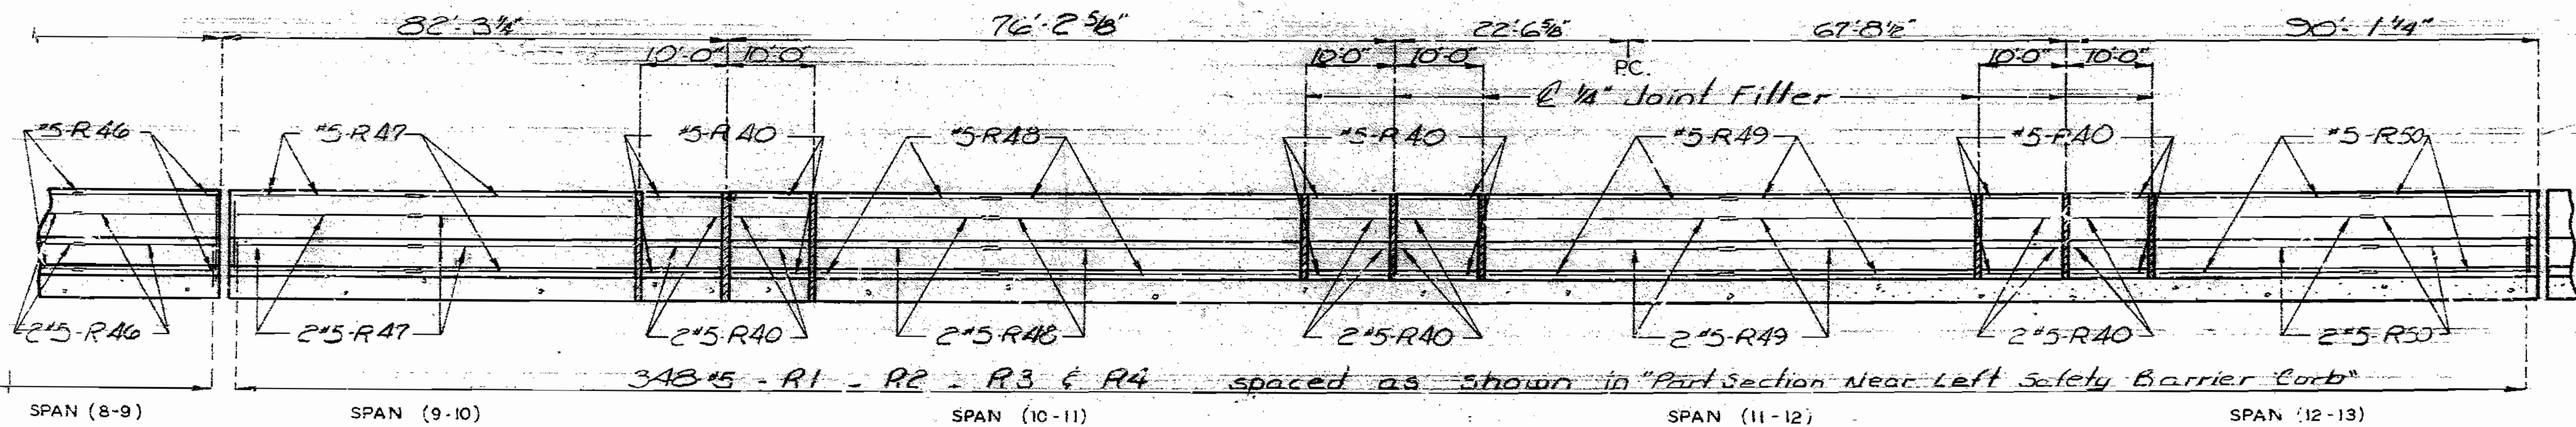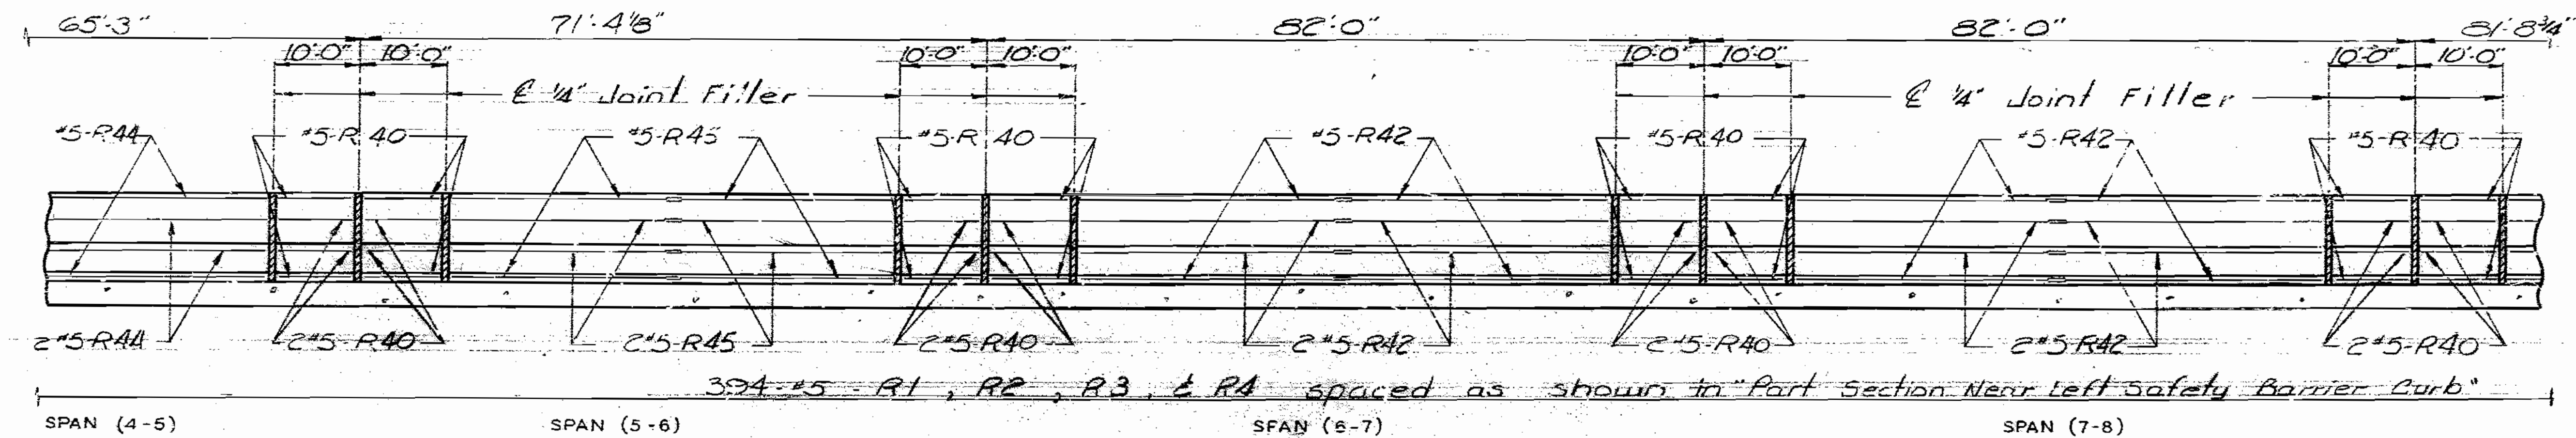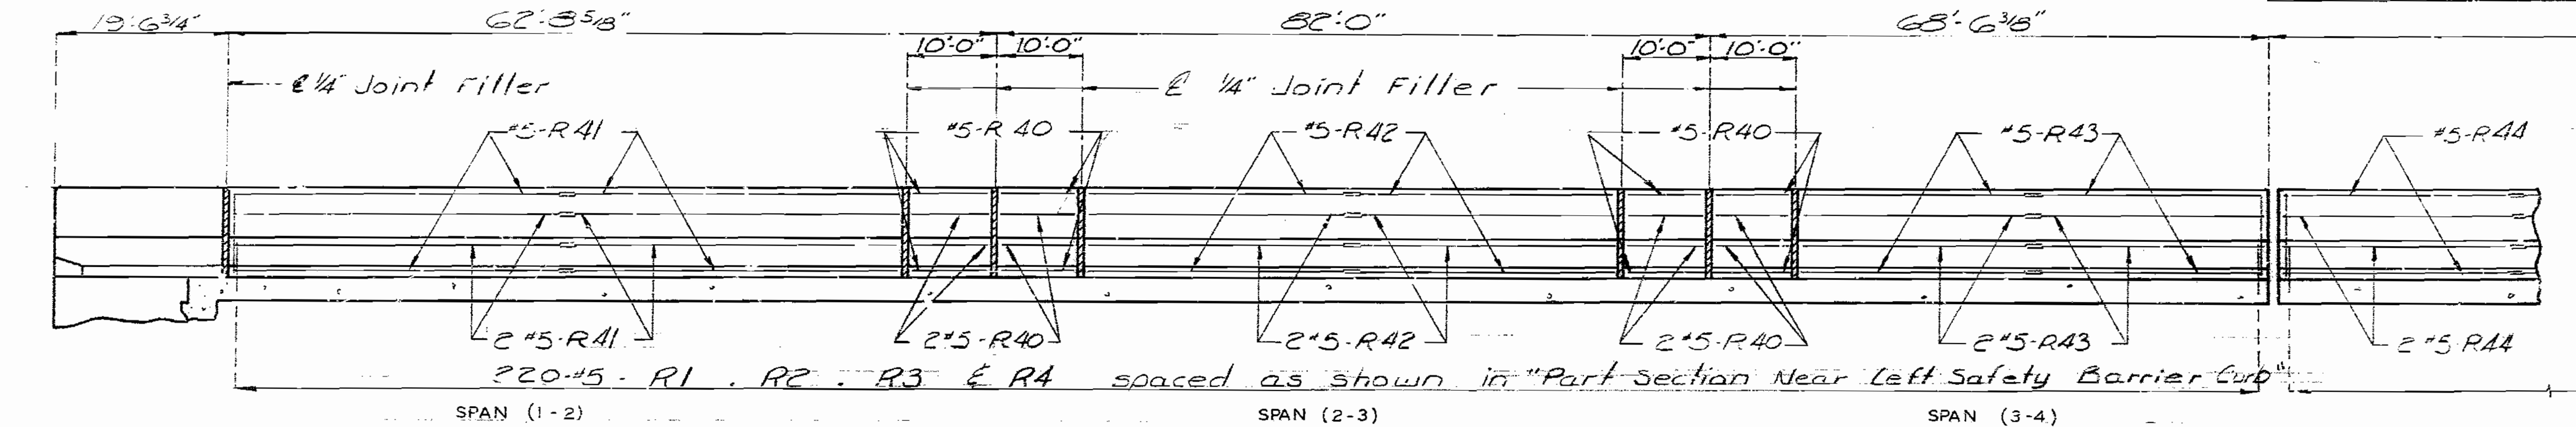




SECTION NEAR LEFT BARRIER CURB

Note: For "Part Section near Left Safety Barrier Curb" see sheet NO. 93.

Note: Longitudinal dimensions are horizontal dimensions measured at top outside edge of slab (Span 12 thru 10-11 and Part Span 11-12). Longitudinal dimensions are horizontal arc dimensions measured at top edge of slab (Part Span 11-12 and Span 12-13). Rustication not shown for clarity.

211185

STATE	PROJ. NO.	SHEET NO.
MO.		170

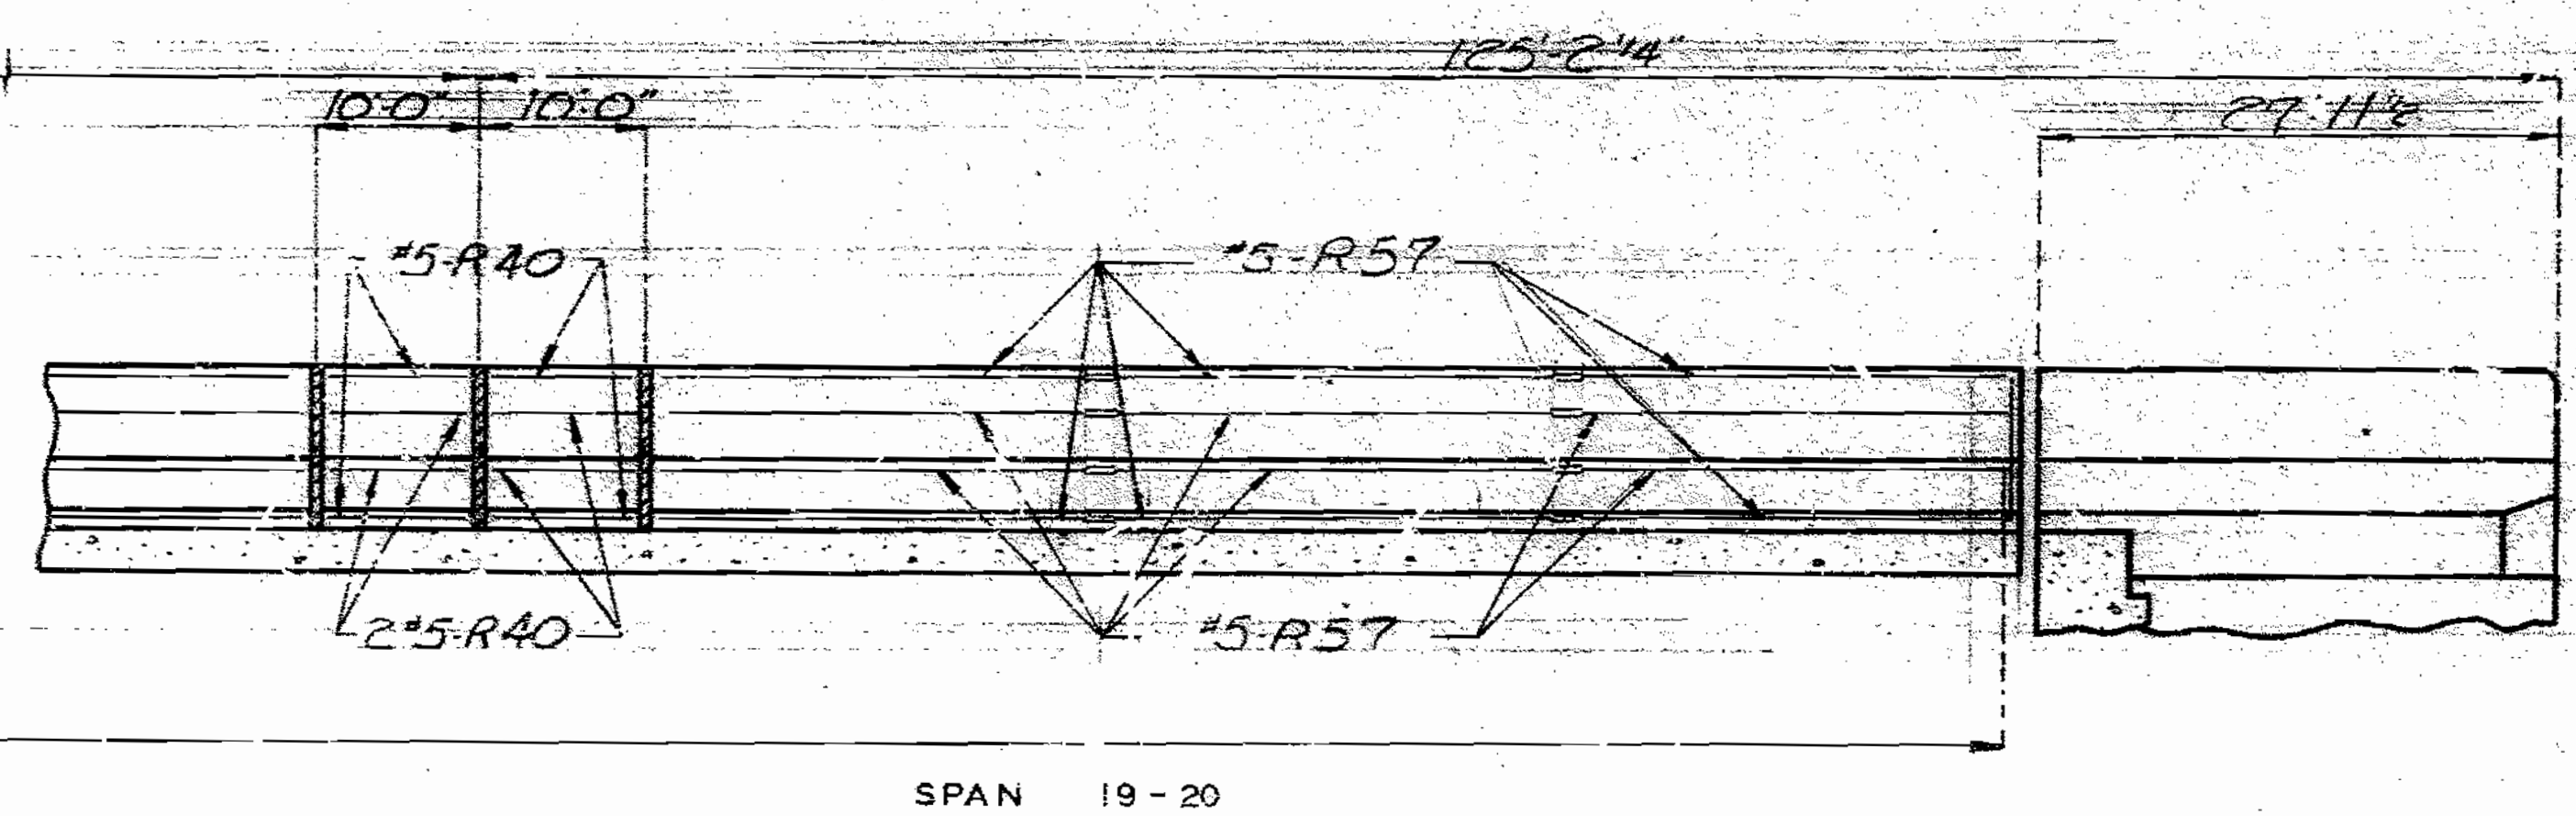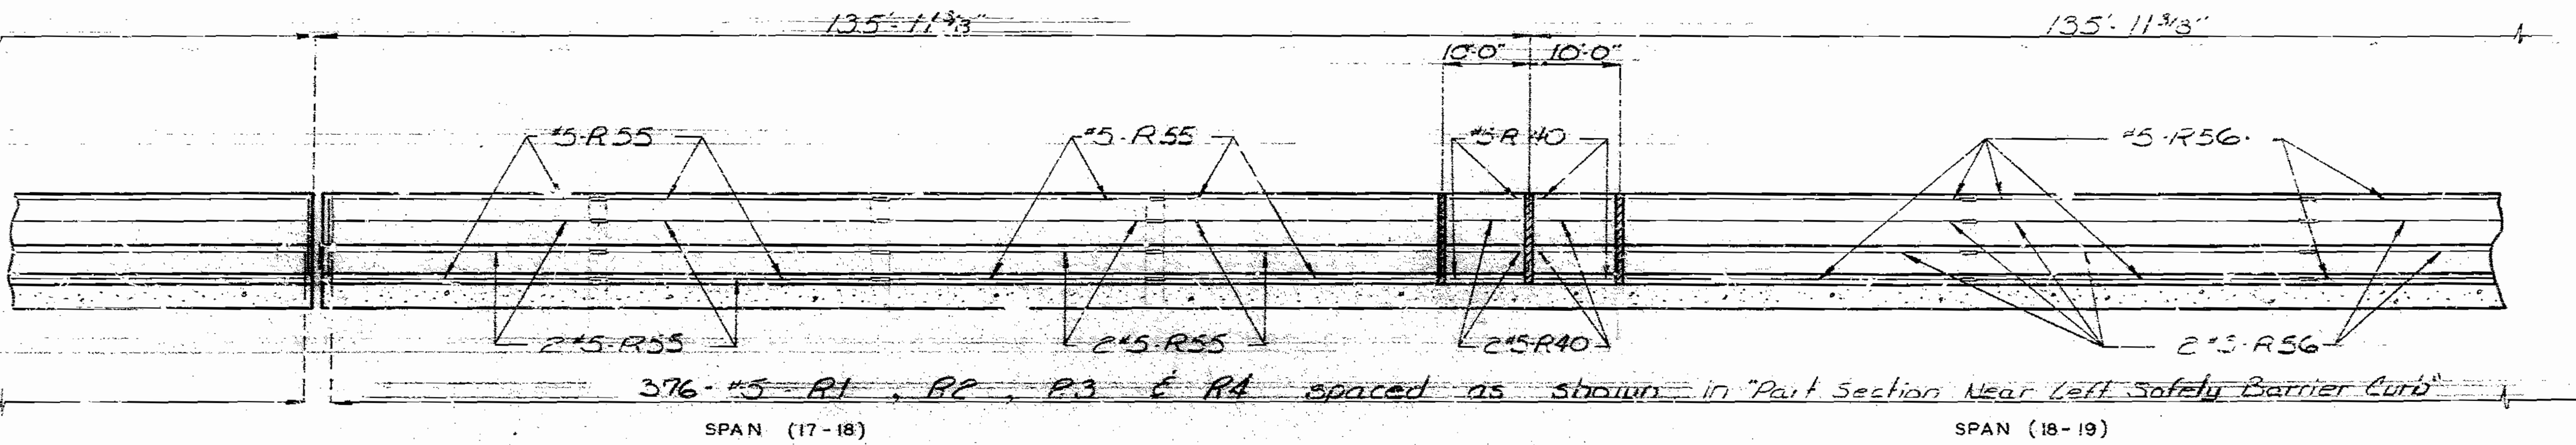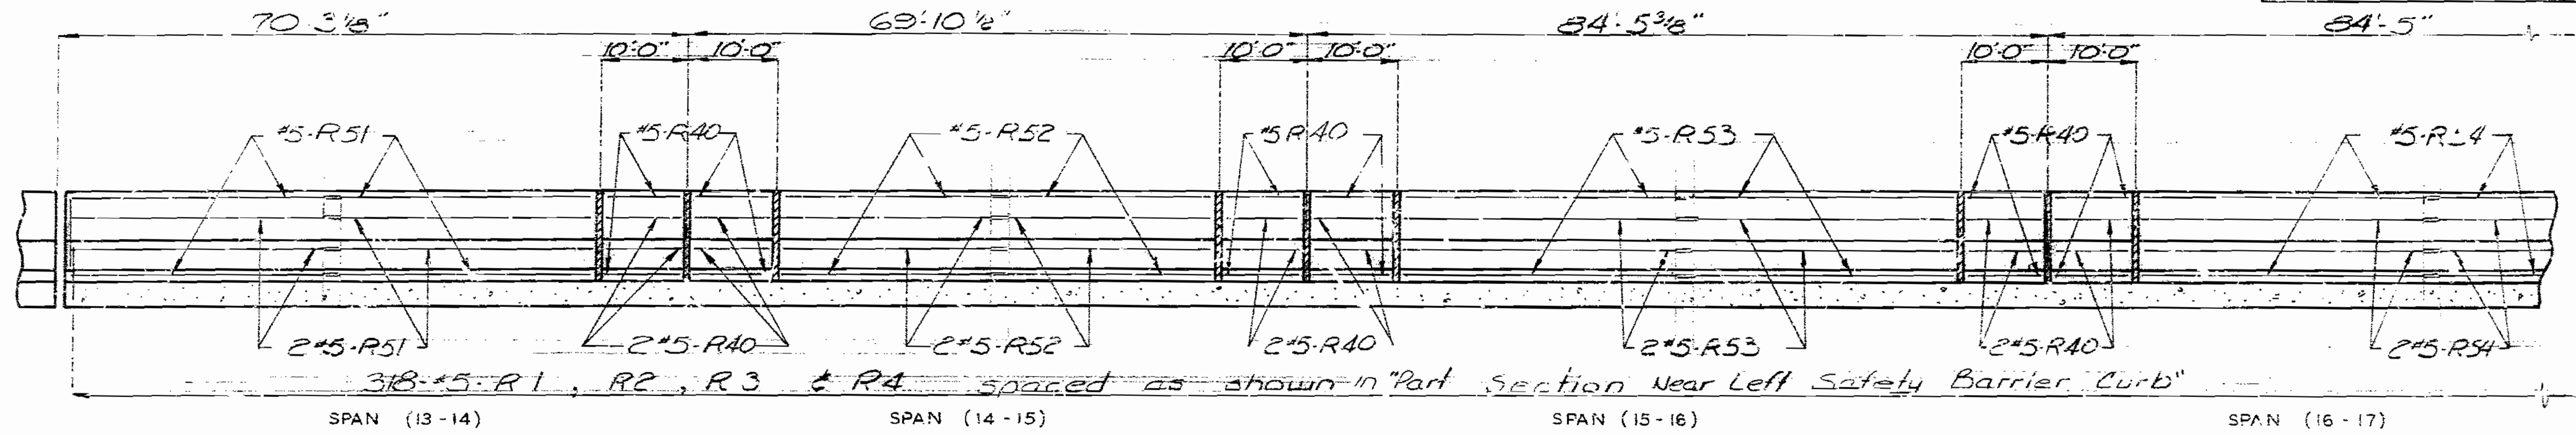

SECTION NEAR LEFT BARRIER CURB

Note: Longitudinal dimensions are horizontal arc dimensions measured at top outside edge of slab.  
 Rustication not shown for clarity.  
 For "Part Section Near Left Safety Barrier Curb" see sheet No. 93

272 186

DETAILED APRIL 1988  
 CHECKED Oct 1988




Note: This drawing is not to scale. Follow dimensions.

Sheet No. 90 of 98

JACKSON COUNTY

A-2745

STATE	PROJ NO	SHEET NO
MO		177

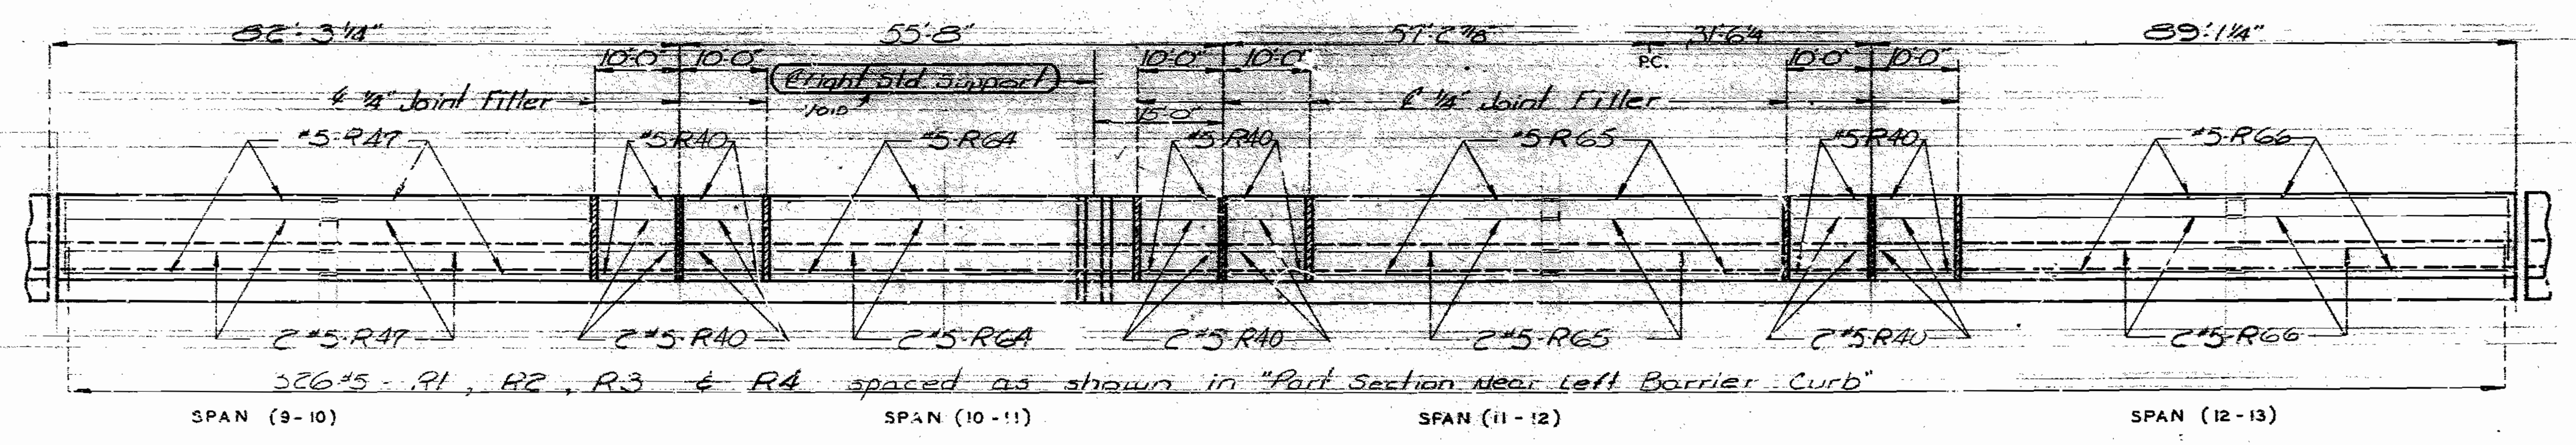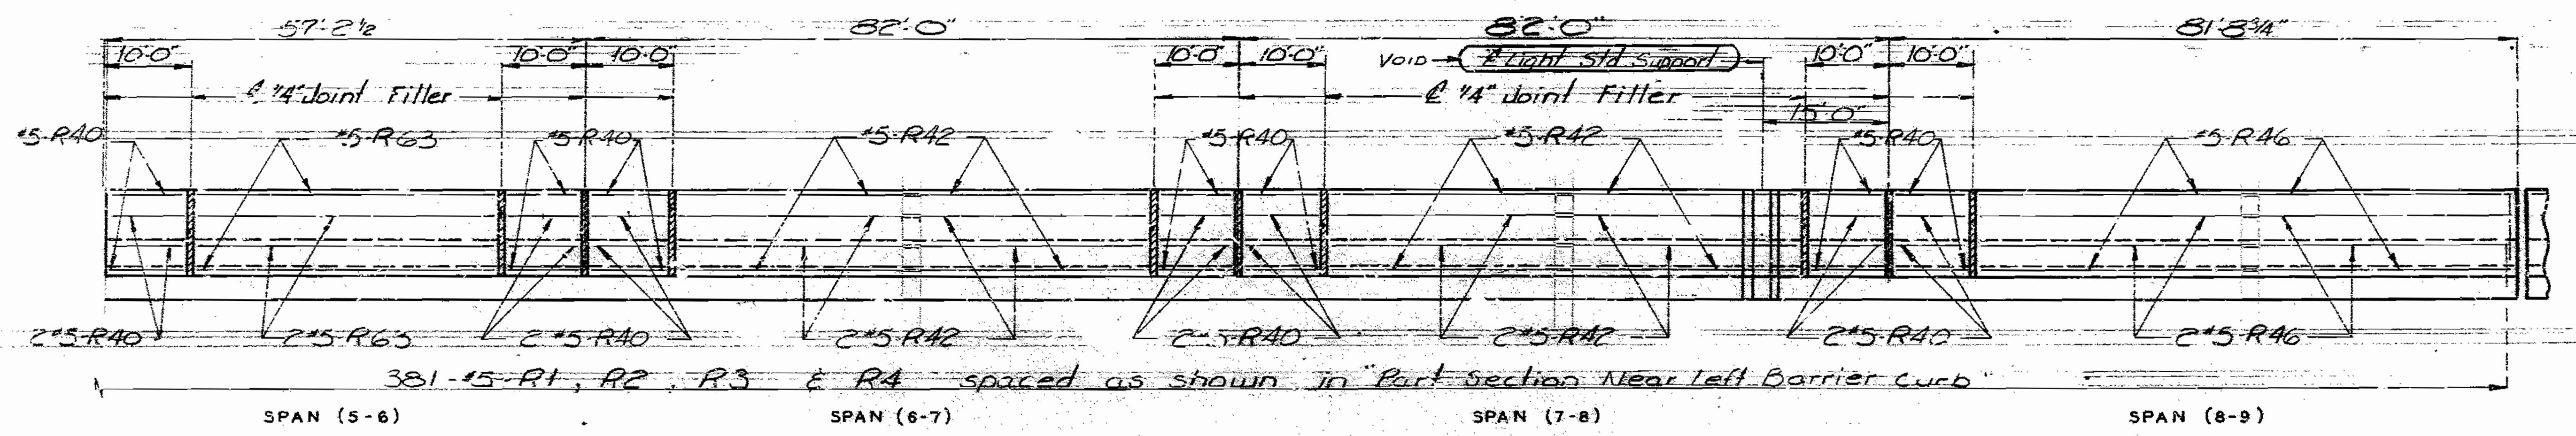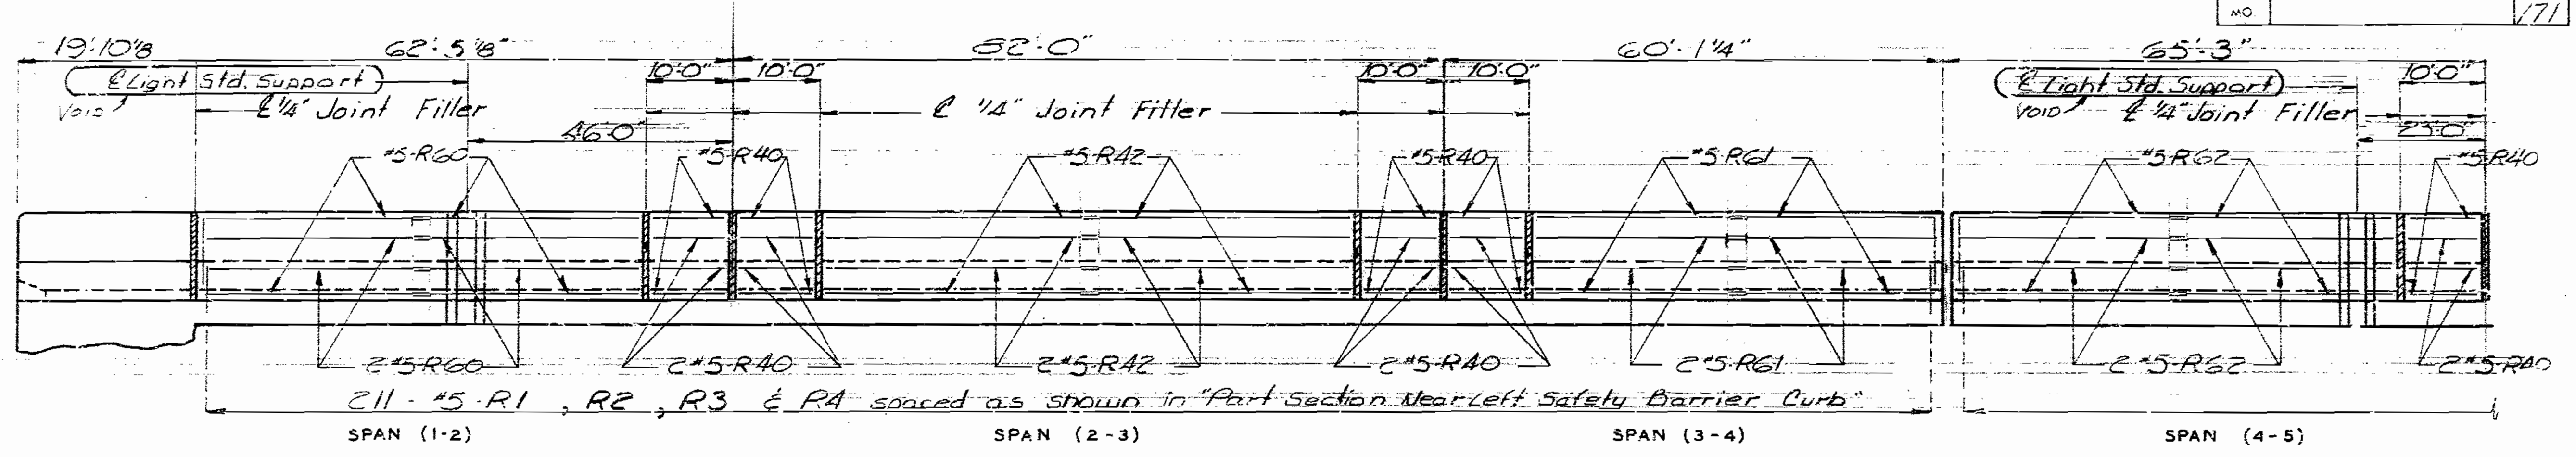

ELEVATION NEAR RIGHT BARRIER CURB

Note: Longitudinal dimensions are horizontal dimensions measured at top outside edges of slabs (Span 1-2 thru 10-11 and Part Span 11-12).  
 Longitudinal dimensions are horizontal arc dimensions measured at top outside edges of slabs (Part Span 11-12 and Span 12-13).  
 Rustication, etc. show clearly.  
 For "Part Section Near Left Safety Barrier Curb" see sheet No. 93

273187

DETAILED APRIL 1988  
 CHECKED Oct. 1988




Note: This drawing is not to scale. Follow dimensions.

Sheet No. 91 of 98

JACKSON COUNTY

A-2745

STATE	PROJ. NO.	SHEET NO.
MO		172

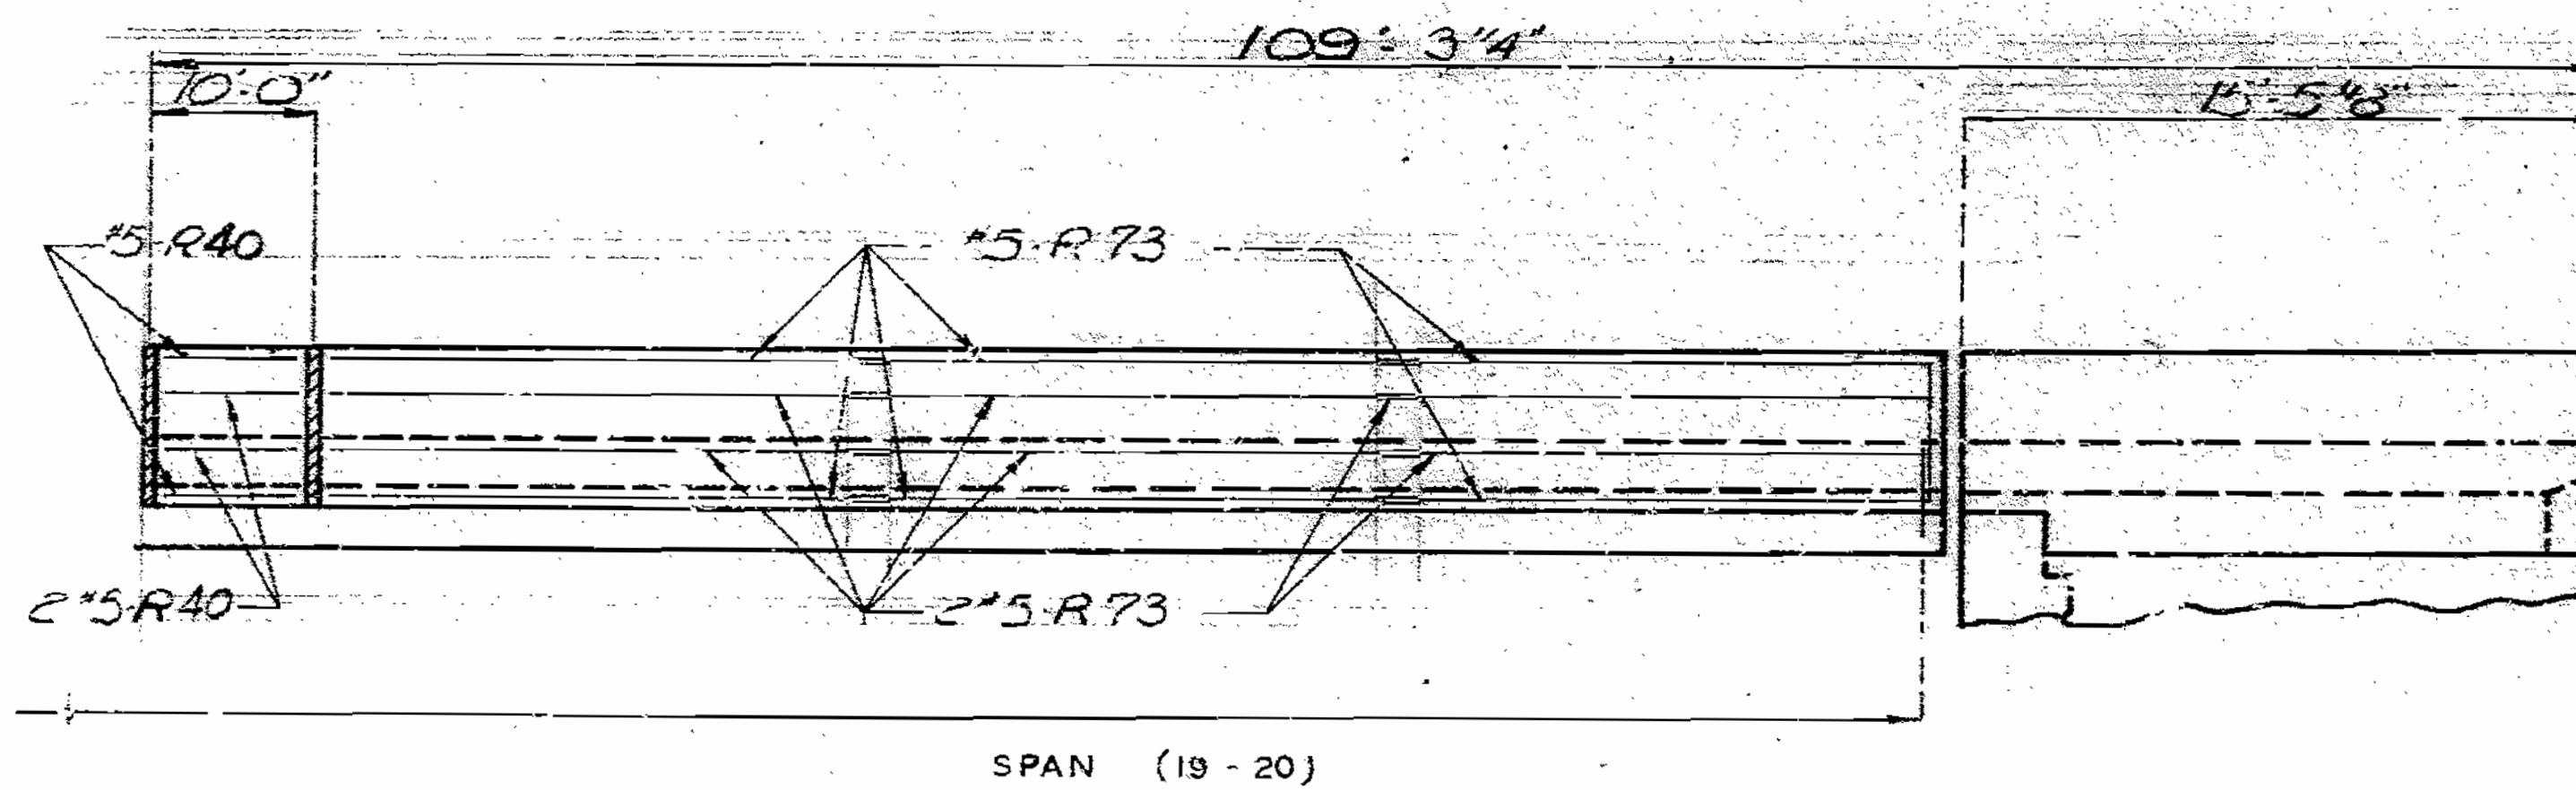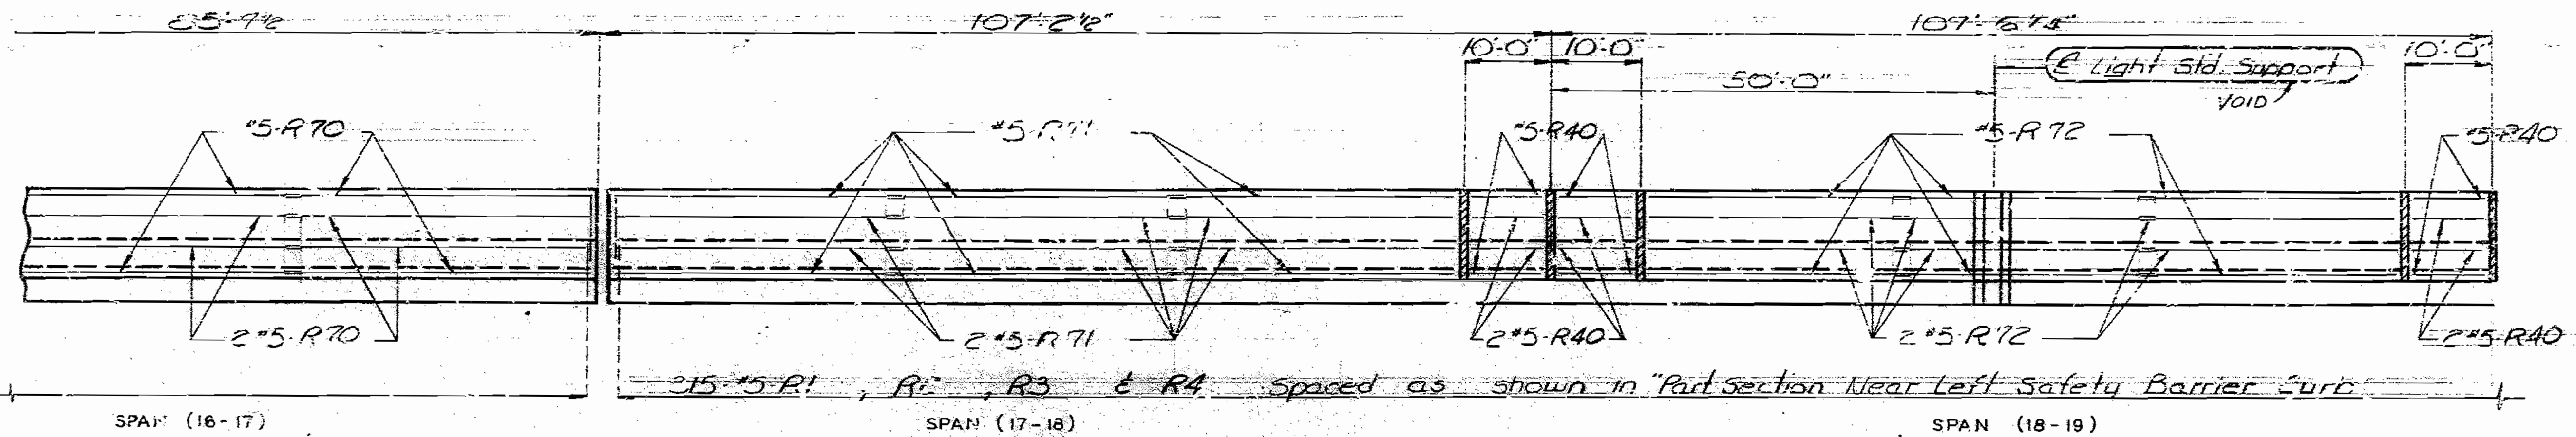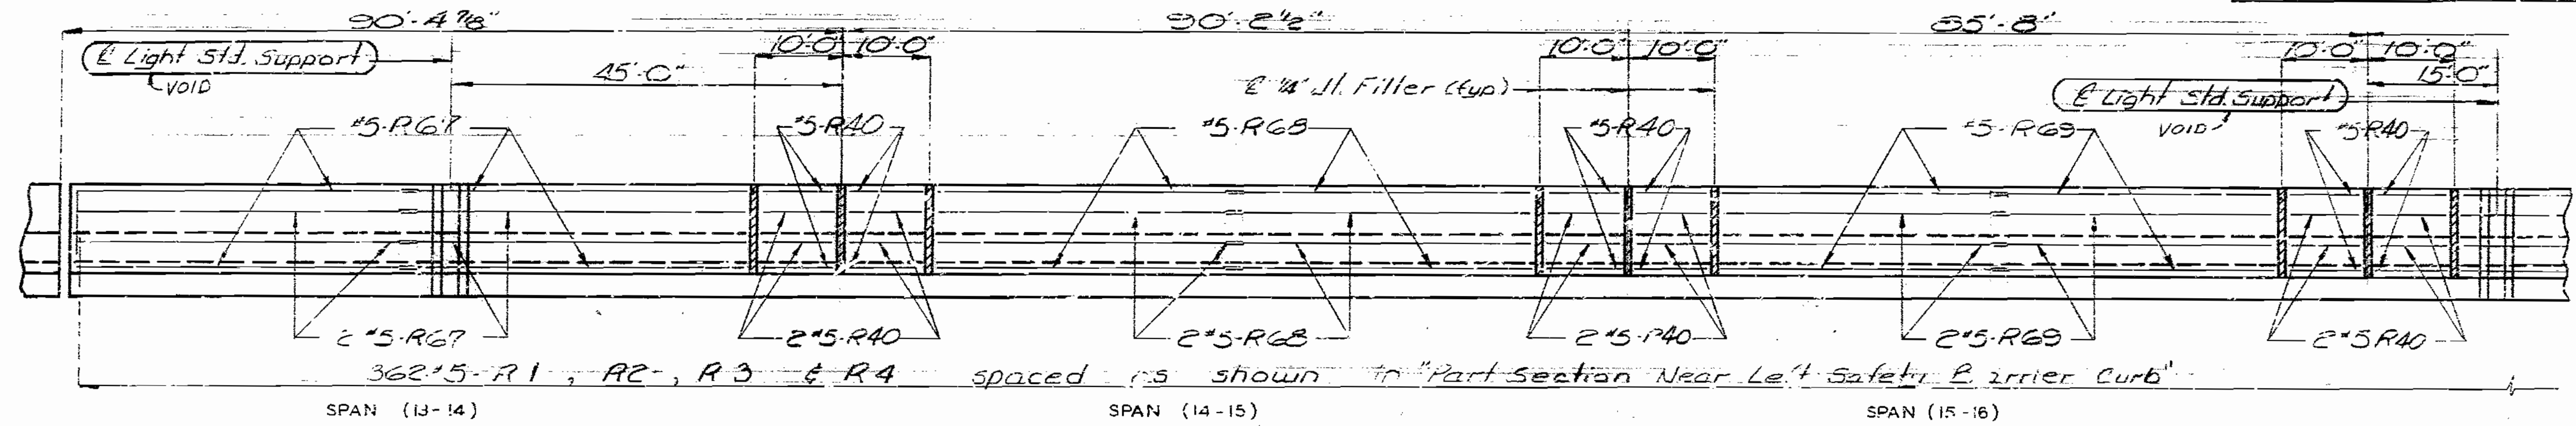

ELEVATION NEAR RIGHT BARRIER CURB

Note: Longitudinal dimensions are horizontal arc dimensions measured at top outside edge of slab. Rustication not shown for clarity. For "Part section Near Left Safety Barrier Curb" see sheet No. 93

27452 180

DETAILED APPIL 1988  
CHECKED Oct. 1988

Note: This drawing is not to scale. Follow dimensions.

Sheet No. 92 of 98





JACKSON COUNTY

A-2745



STATE	PROJ NO	SHEET NO
MO		173

Note: For location of conduit in Safety Barrier Curb see sheet No. 88.

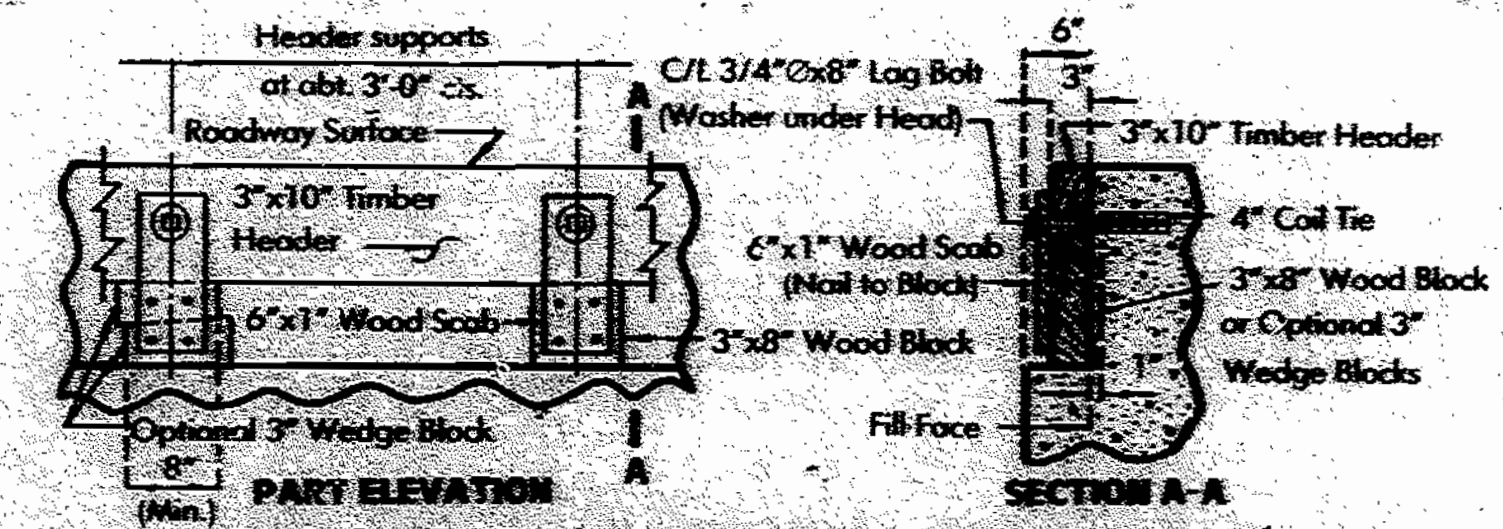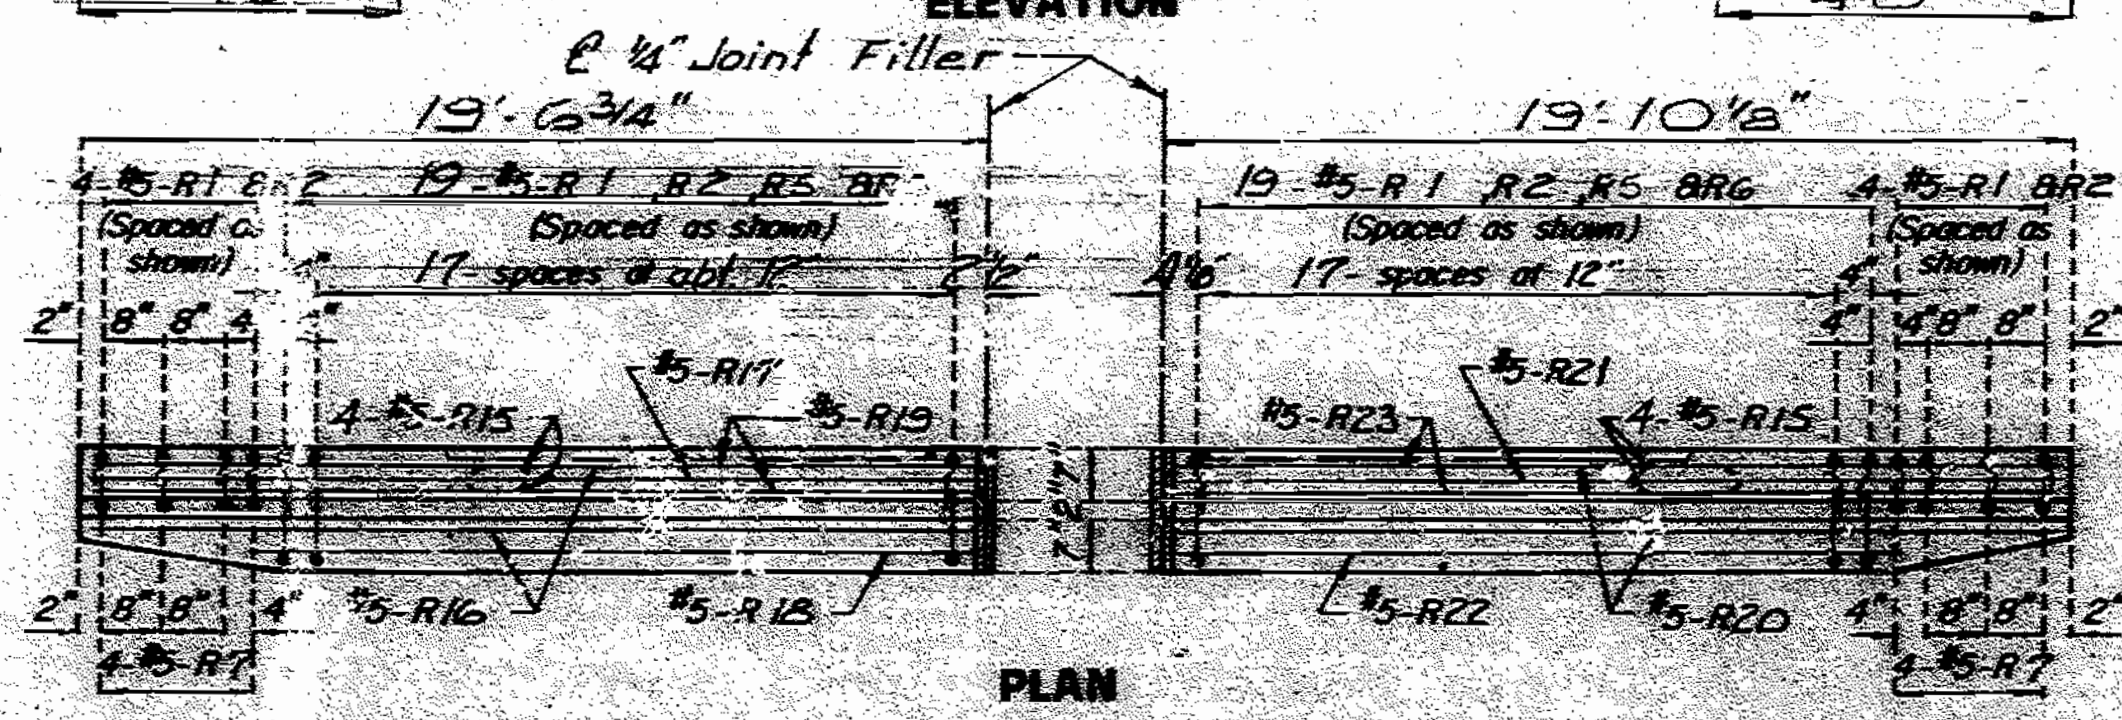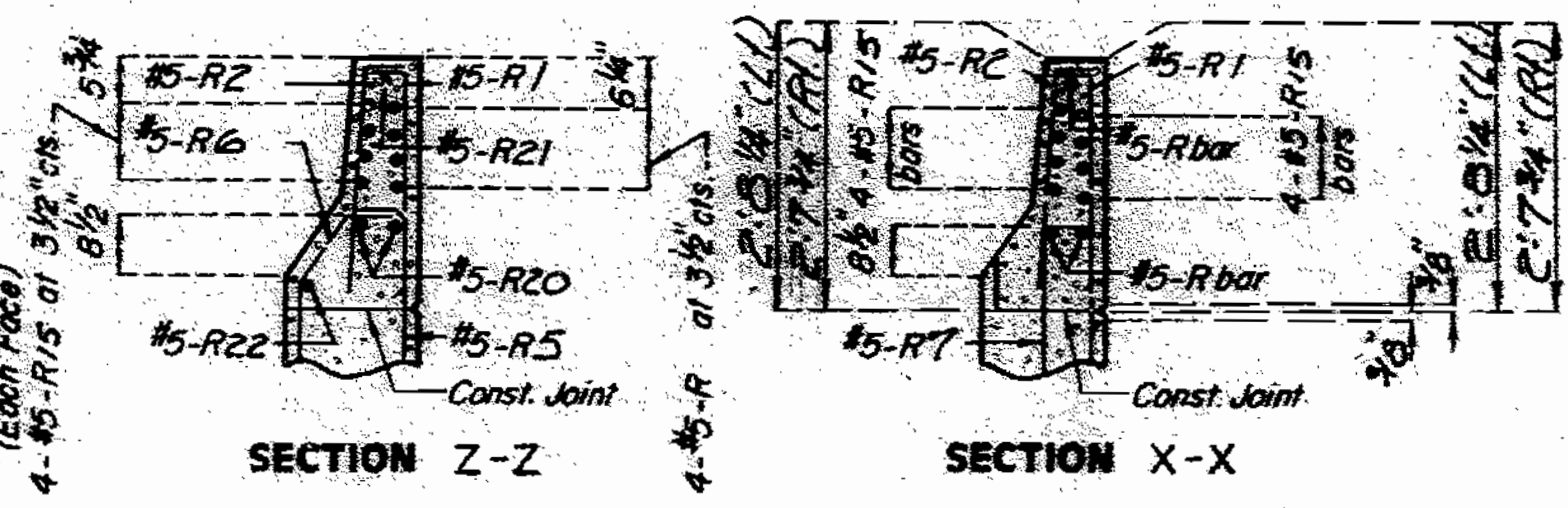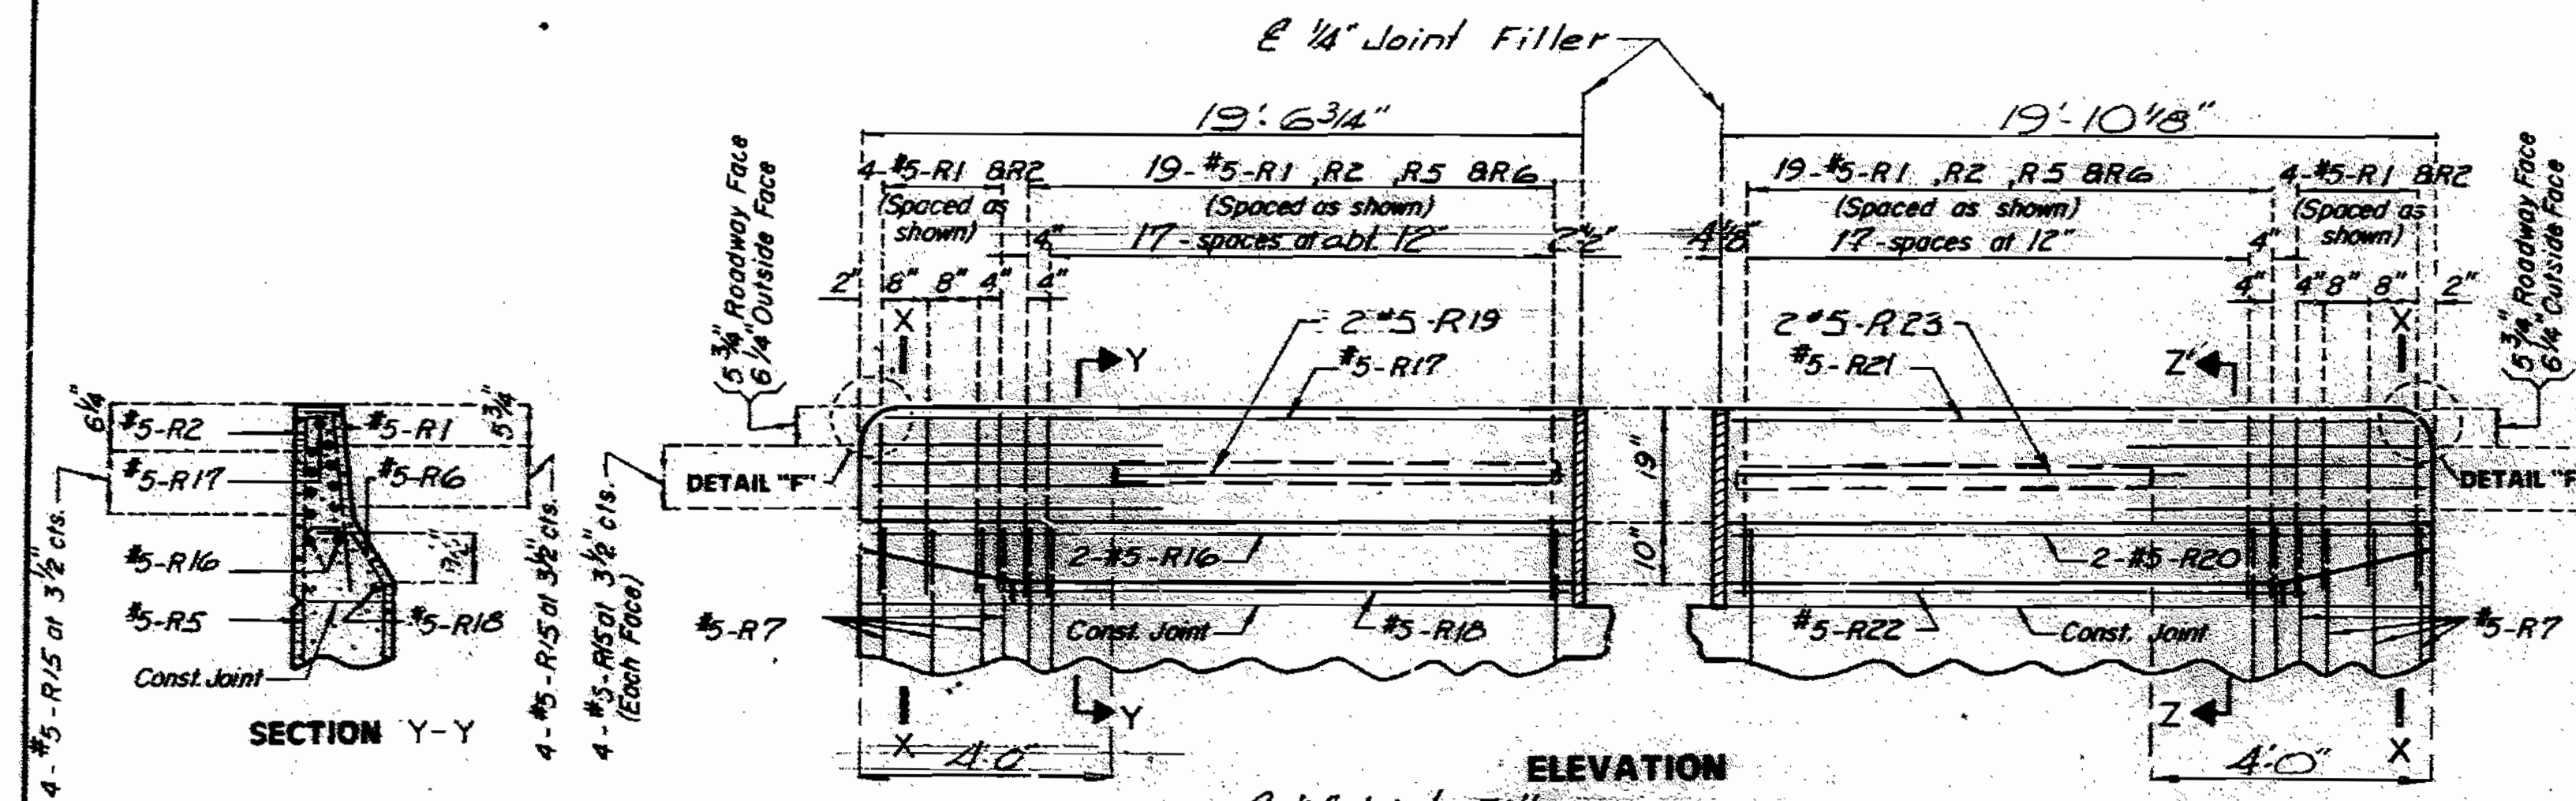

DETAILS OF TIMBER HEADER AT END BENTS


NOTE: TOP OF SAFETY BARRIER CURB SHALL BE BUILT PARALLEL TO GRADE WITH SAFETY BARRIER CURB JOINTS EXCEPT AT END BENTS NORMAL TO GRADE.

ALL EXPOSED EDGES OF SAFETY BARRIER CURB SHALL HAVE EITHER A 1/2" RADIUS OR A 3/8" BEVEL, UNLESS OTHERWISE NOTED.


WHEN THE SAFETY BARRIER CURB IS BID BY LINEAR FEET, THE CONTRACT UNIT PRICE SHALL INCLUDE THE COST OF ALL CONCRETE AND REINFORCEMENT, COMPLETE IN PLACE.

CONCRETE FOR THE SAFETY BARRIER CURB SHALL BE CLASS B1.

MEASUREMENT OF SAFETY BARRIER CURB IS TO THE NEAREST LINEAL FOOT FOR EACH STRUCTURE, MEASURED ALONG THE OUTSIDE TOP OF SLAB FROM END OF WING TO END OF WING.


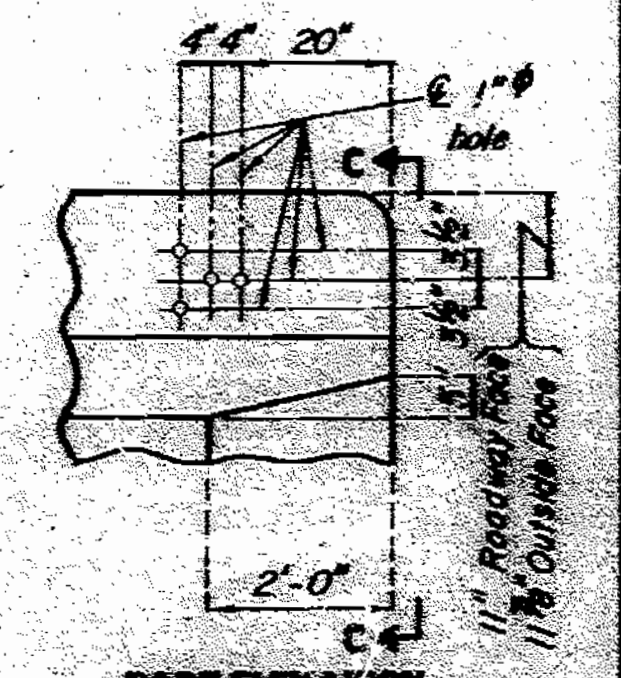


DETAILS OF GUARD RAIL ATTACHMENT


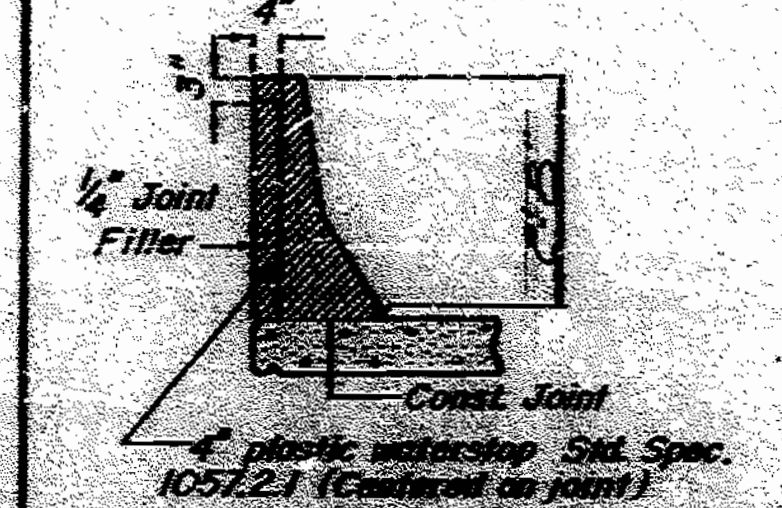


NOTE: PLASTIC WATERSTOP SHALL BE PLACED IN ALL SAFETY BARRIER CURB JOINTS, EXCEPT STRUCTURES BUILT BY DESIGN FOR USE ON ALL LOWER SAFETY BARRIER CURBS (CONC. CURB).


COST OF PLASTIC WATERSTOP COMPLETE IN PLACE TO BE INCLUDED IN CONTRACT UNIT PRICE FOR SAFETY BARRIER CURB.

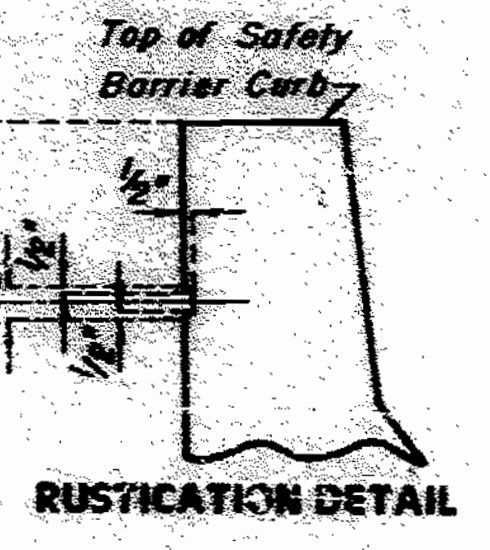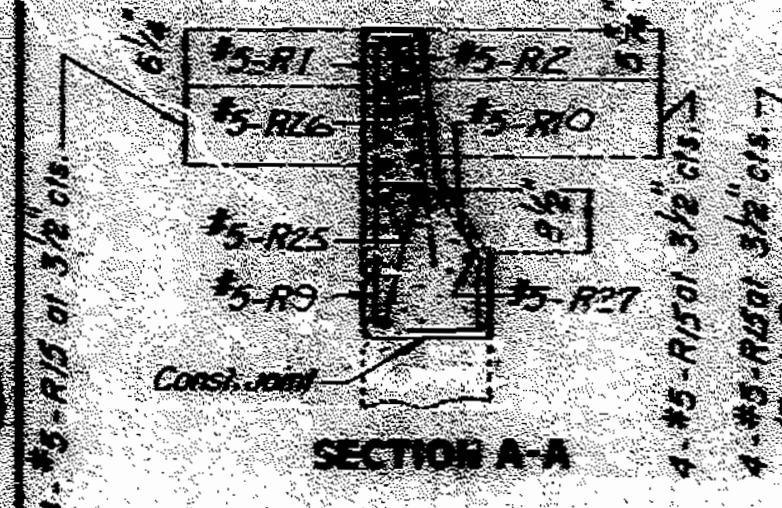

RUSTICATION DETAIL

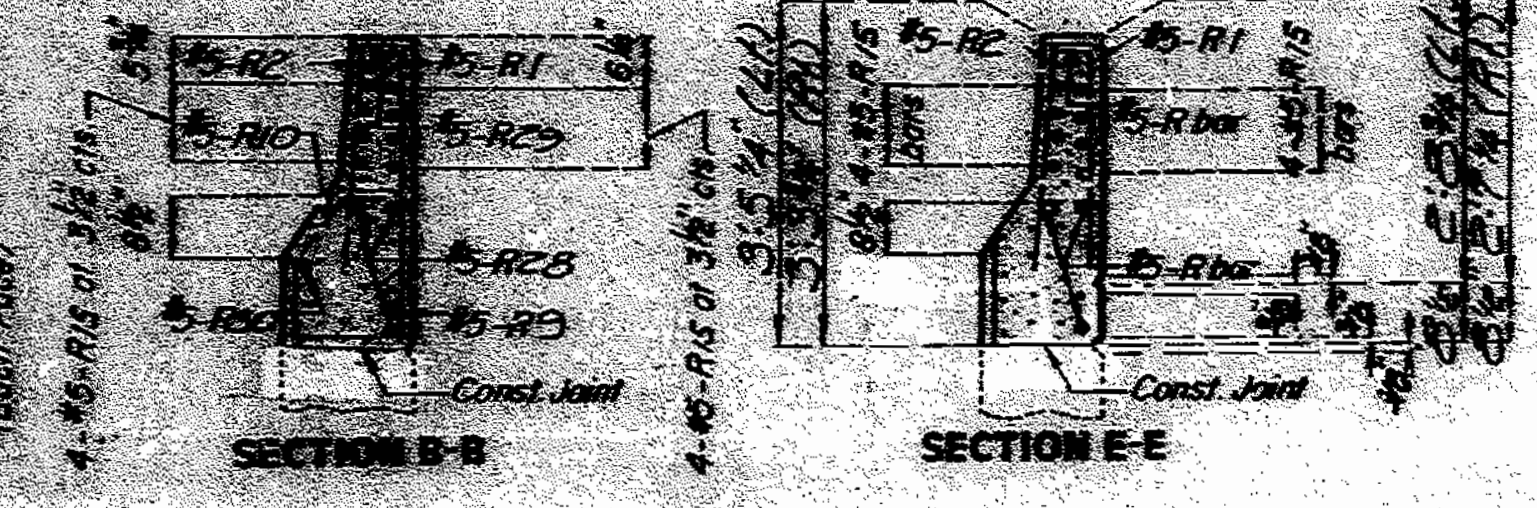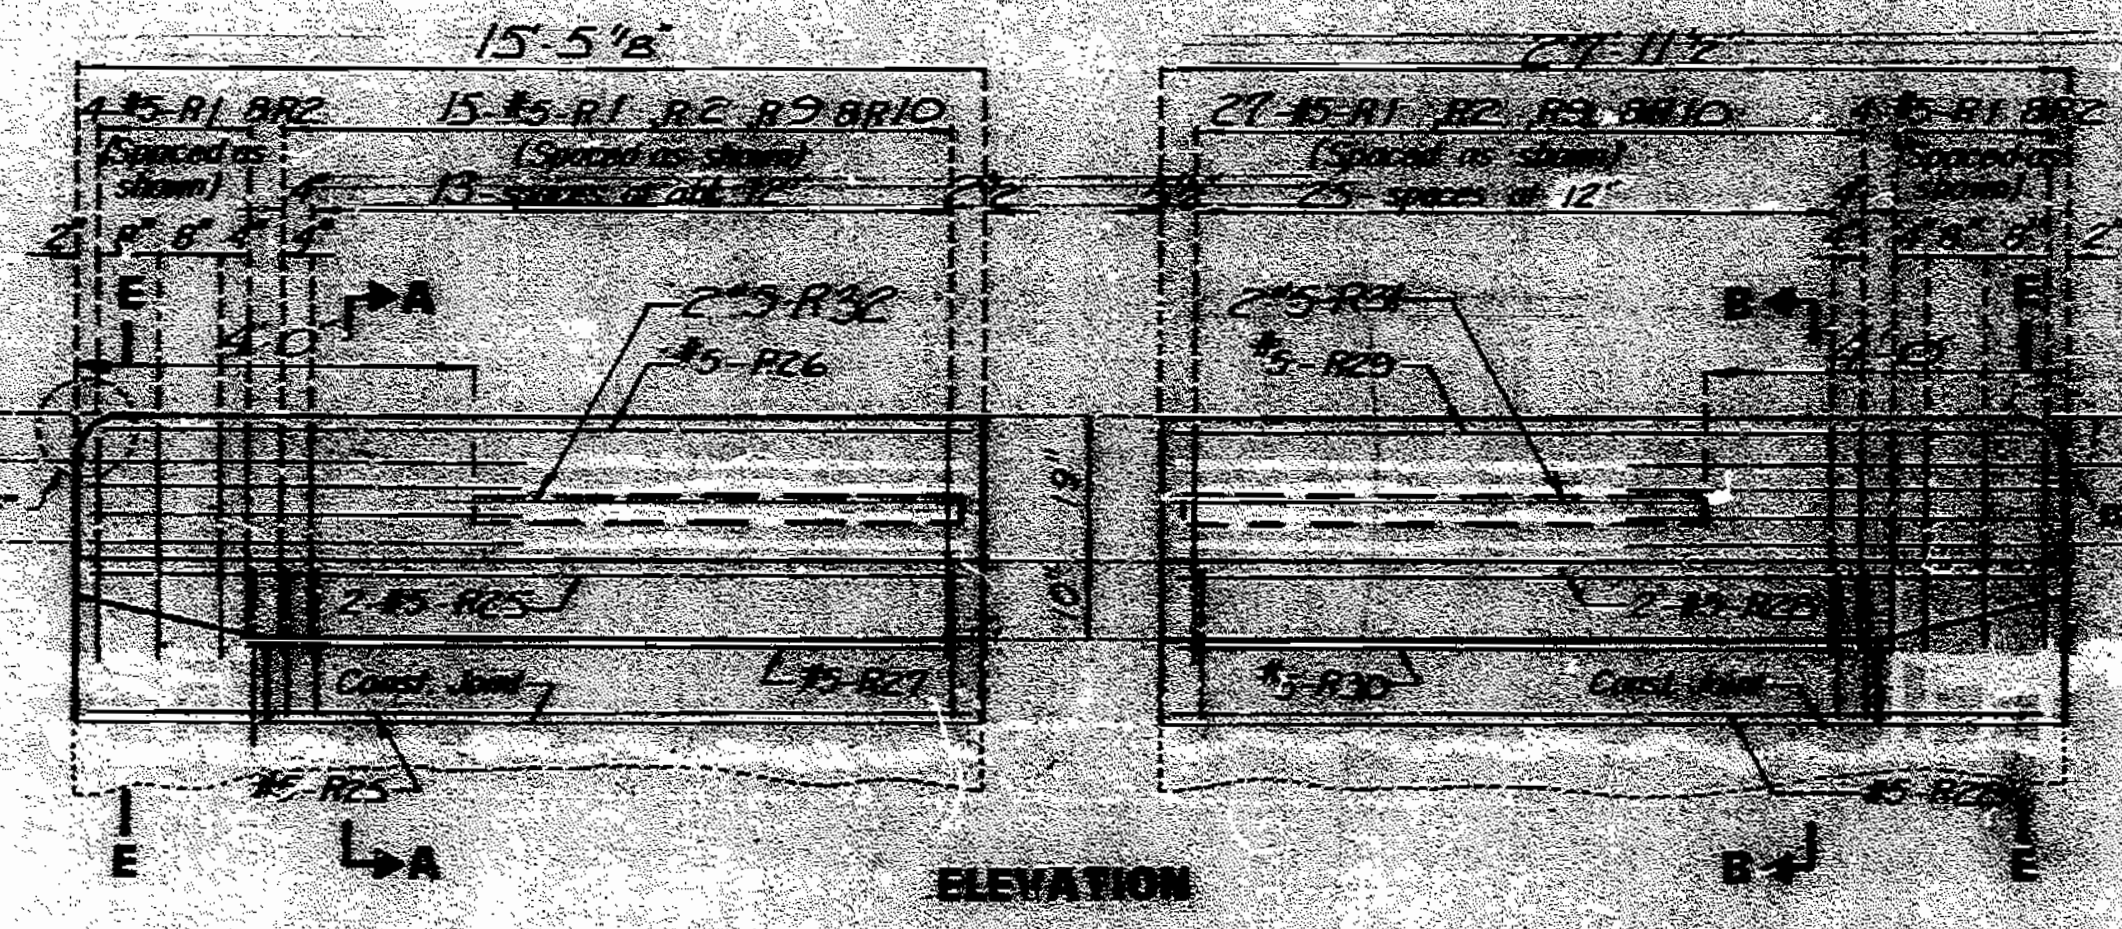


PART SECTION NEAR LEFT SAFETY BARRIER CURB

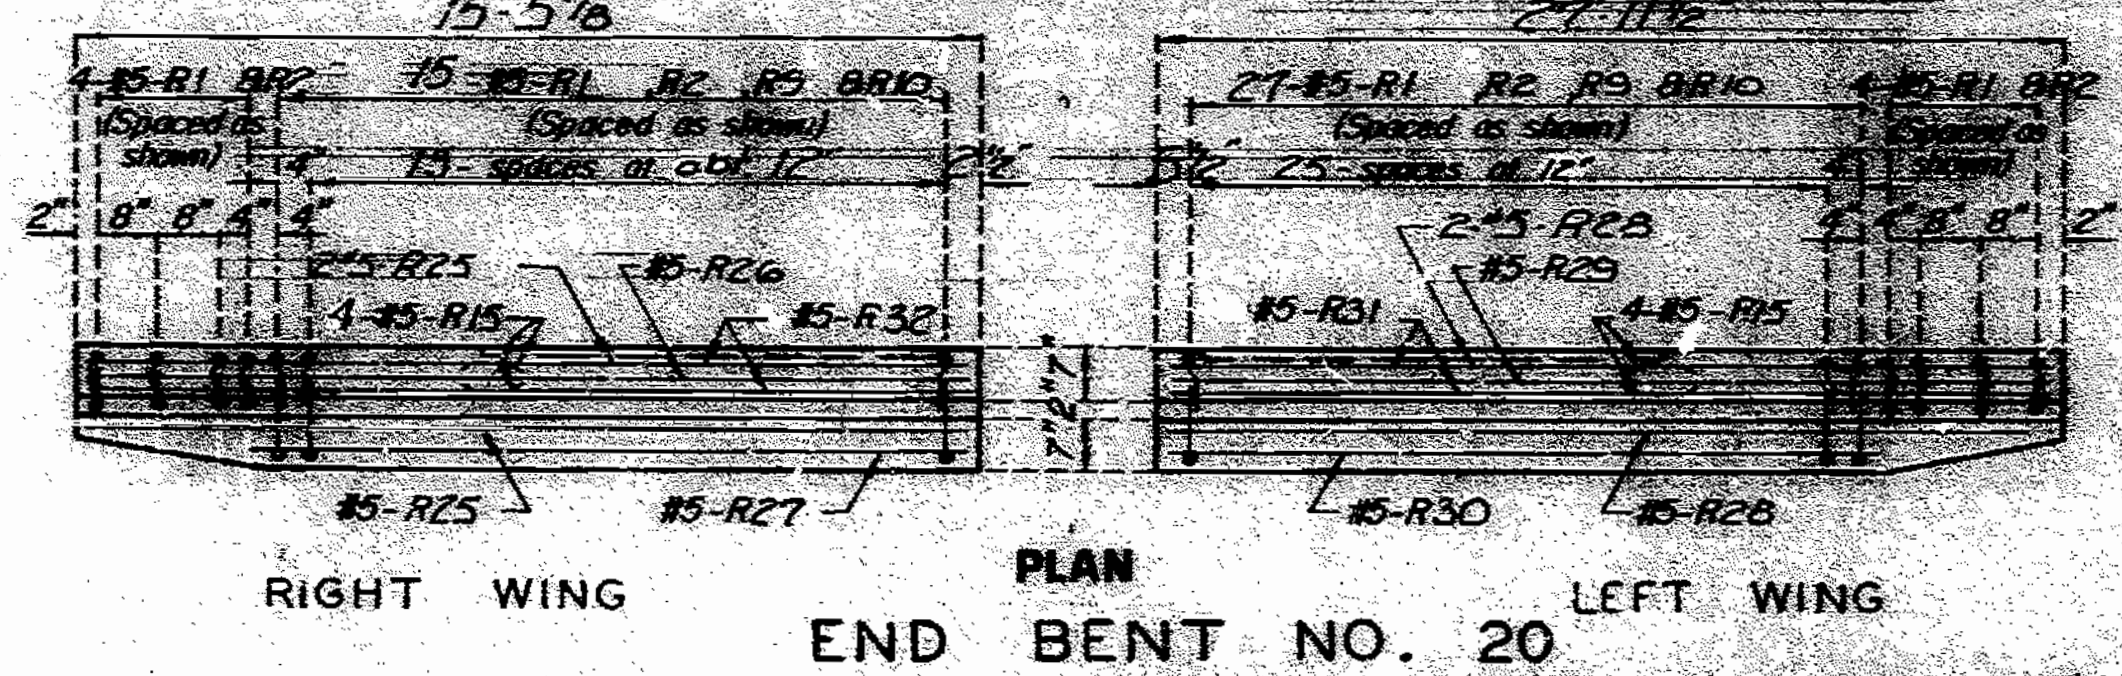


DETAILS OF SAFETY BARRIER CURB AT END BENTS

Note: This drawing is not to scale. Follow dimensions.

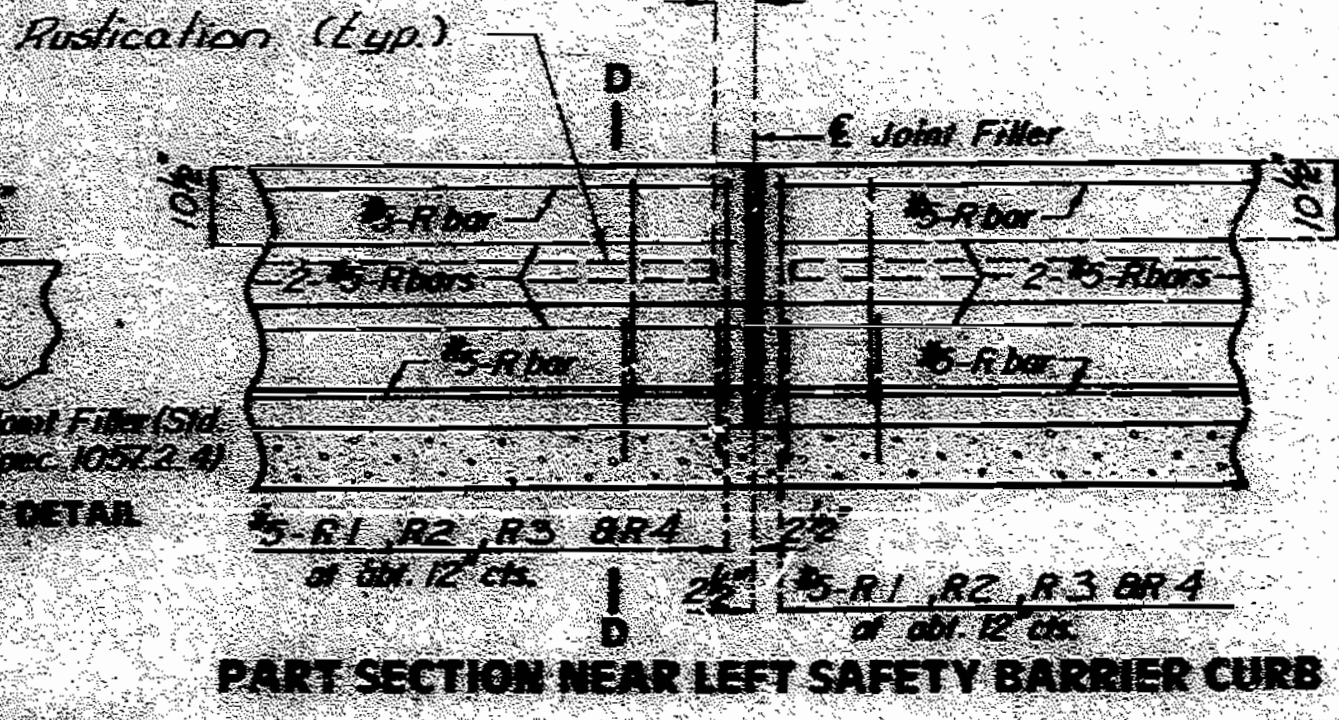

FILLED JOINT DETAIL

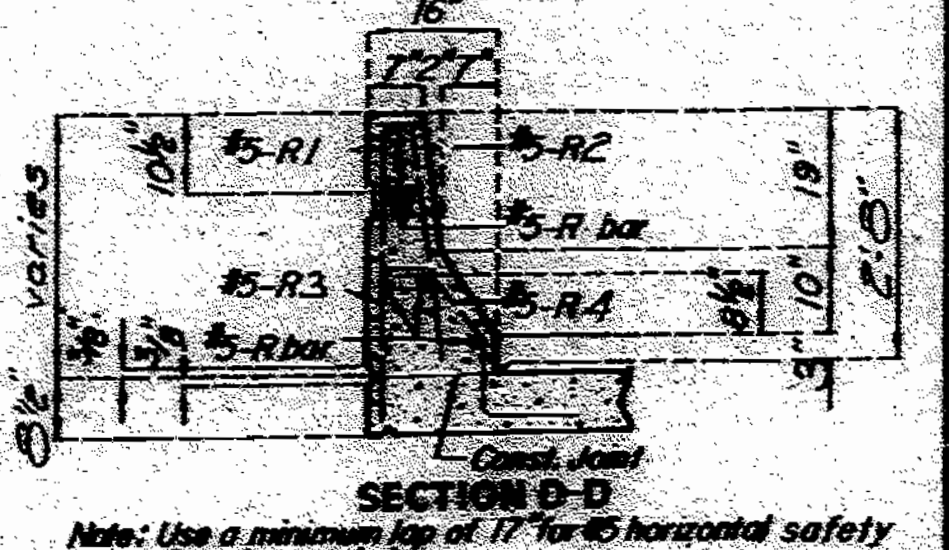

SECTION D-D

Note: Use a minimum top of 17' for horizontal safety barrier curb bars.


Handwritten signature/initials.

SPS 127(N)	REVISED	MAY 1987
AUG. 1978	CHECKED	OCT. 1988

DETAILED AUG. 1988

COMPLETE BILL OF REINFORCING STEEL																									
NO. REQD.	MARK NO.	LOCATION	EPOXY	SHAPE NO.	STIRRUP	SUBSTR.	VARIES	NO. EACH	DIMENSIONS						NOMINAL LENGTH	ACTUAL LENGTH	WEIGHT								
									B		C		D					E		F		H		K	
									FT.	IN.	FT.	IN.	FT.	IN.				FT.	IN.	FT.	IN.	FT.	IN.	FT.	IN.
		END BENT NO. 1																							
5	4F1	DIAPH. & WING		23					14.000	5	3.000	14.000	8.750	10.875	8.750	10.875	7	7	6	56					
5	4F2	DIAPH.		21					2	3.625	5	0.000			2	3.000	5.875	7	7	1	53				
5	4F3	DIAPH.		23					2	3.625	4	8.000			2	3.000	5.875	7	0	6	10	53			
5	4F4	DIAPH. & WING		23					14.000	4	3.000	14.000	10.875	8.750	10.875	8.750	6	7	6	6	49				
3	4H1	DIAPH.		20					42	3	0.000					42	3	42	3	190					
12	4H2	DIAPH.		20					6	10.000					6	10	6	10	123						
4	4H3	DIAPH.		E 20					42	3	0.000				42	3	42	3	254						
2	4H4	APPROACH HAMBURCH		20					22	0	0.000				22	0	22	0	28						
5	5H5	STRAND TIE BAR		23					15.000	2	0.000	15.000	3.125	14.625	3.125	14.625	4	6	4	23					
4	4H6	WING		E 20					18	5	0.000				18	5	18	5	164						
8	4H7	WING		20					18	5	0.000				18	5	18	5	221						
16	4H8	WING		20					17	9	0.000				17	9	17	9							
		INCR = 23.000 IN							12	0	0.000				12	0	12	0	357						
4	4T1	WING		23					9	1.625	2	1.000			8	6.000	3	4	0.000	11	3	11	2	67	
57	4G2	DIAPH.		E 19					5	0.000	3	8.000			8	8	8	6	726						
30	5H3	DIAPH.		E 18 S					5	0.000	2	3.500			12	5	12	1	378						
24	4H4	APPROACH HAMBURCH		18 S					17	5	0.000	6	0.000		3	5	3	3	52						
16	4V1	WIP		20					4	11.000					4	11	4	11	118						
16	4V2	WING		20					2	3.000					2	3	2	3	80						
		INCR = 4.875 IN							5	1.000					5	1	5	1	92						
16	4V3	WING		20					2	5.000					2	5	2	5	92						
		INCR = 4.875 IN							5	3.000					5	3	5	3	122						
16	4V5	WING		20					5	1.000					5	1	5	1	122						
		END BENT NO. 2																							
2	4H20	DIAPH.		E 20					35	5	0.000				34	5	36	5	59						
2	4H21	DIAPH.		E 20					45	0	0.000				45	0	45	0	60						

COMPLETE BILL OF REINFORCING STEEL																									
NO. REQD.	MARK NO.	LOCATION	EPOXY	SHAPE NO.	STIRRUP	SUBSTR.	VARIES	NO. EACH	DIMENSIONS						NOMINAL LENGTH	ACTUAL LENGTH	WEIGHT								
									B		C		D					E		F		H		K	
									FT.	IN.	FT.	IN.	FT.	IN.				FT.	IN.	FT.	IN.	FT.	IN.	FT.	IN.
		INT. BT. NO. 3																							
16	4H20	DIAPH.		20					7	3.000					7	3	7	3	77						
16	4H21	DIAPH.		20					6	7.000					6	7	6	7	158						
12	5H22	STRAND TIE BAR		20					4	6.000					4	6	4	6	56						
8	5H23	STRAND TIE BAR		20					3	3.000					3	3	3	3	27						
20	5H24	DIAPH.		19 S					10.000	2	8.000				3	6	3	5	71						
48	4H20	DIAPH.		E 28 S					20.000	4	8.000	12.000			7	4	7	2	230						
16	4H21	DIAPH.		E 28 S					20.000	4	8.000	14.000			7	6	7	2	172						
8	5V20	DIAPH.		E 20					4	11.000					4	11	4	11	41						
		INT. BT. NO. 4																							
24	4H20	DIAPH.		20					7	3.000					7	3	7	3	592						
16	4H21	DIAPH.		20					6	7.000					6	7	6	7	158						
16	4H22	DIAPH.		20					6	7.000					6	7	6	7	70						
2	5H23	DIAPH.		20					37	7.000					37	7	37	7	78						
16	5H44	DIAPH.		19 S					15.000	2	2.000				3	5	3	4	56						
44	4H20	DIAPH.		E 28 S					15.000	2	2.000	12.000			4	5	4	3	182						
48	4H21	DIAPH.		E 28 S					15.000	2	2.000	12.000			4	5	4	3	182						
16	4H22	DIAPH.		E 28 S					15.000	4	1.000	14.000			6	6	6	2	148						
16	4H23	DIAPH.		E 11 S					15.000	4	1.000	14.000			6	6	6	2	148						
8	5H20	DIAPH.		E 20					4	1.000					4	1	4	1	39						
		INT. BT. NO. 5																							
12	5H22	STRAND TIE BAR		20					4	6.000					4	6	4	6	56						
16	4H21	DIAPH.		20					7	3.000					7	3	7	3	77						
16	4H22	DIAPH.		20					6	7.000					6	7	6	7	158						
20	5H23	DIAPH.		19 S					10.000	2	8.000				3	6	3	5	71						
8	5H24	STRAND TIE BAR		20					3	3.000					3	3	3	3	27						
48	4H20	DIAPH.		E 28 S					20.000	4	8.000	12.000			7	5	7	2	232						
16	4H21	DIAPH.		E 28 S					20.000	4	8.000	14.000			7	7	7	2	174						
8	5V20	DIAPH.		E 20					4	11.000					4	11	4	11	41						
		INT. BT. NO. 6																							
12	5H22	STRAND TIE BAR		20					4	6.000					4	6	4	6	56						
8	5H23	STRAND TIE BAR		20					3	3.000					3	3	3	3	27						
16	4H21	DIAPH.		20					7	10.000					7	10	7	10	80						
16	4H22	DIAPH.		20					7	9.000					7	9	7	9	168						
20	5H23	DIAPH.		19 S					10.000	2	8.000				3	6	3	5	71						
48	4H20	DIAPH.		E 28 S					20.000	4	8.000	12.000			7	4	7	2	230						
16	4H21	DIAPH.		E 28 S					20.000	4	8.000	14.000			7	6	7	2	172						
8	5V20	DIAPH.		E 20					4	11.000					4	11	4	11	41						

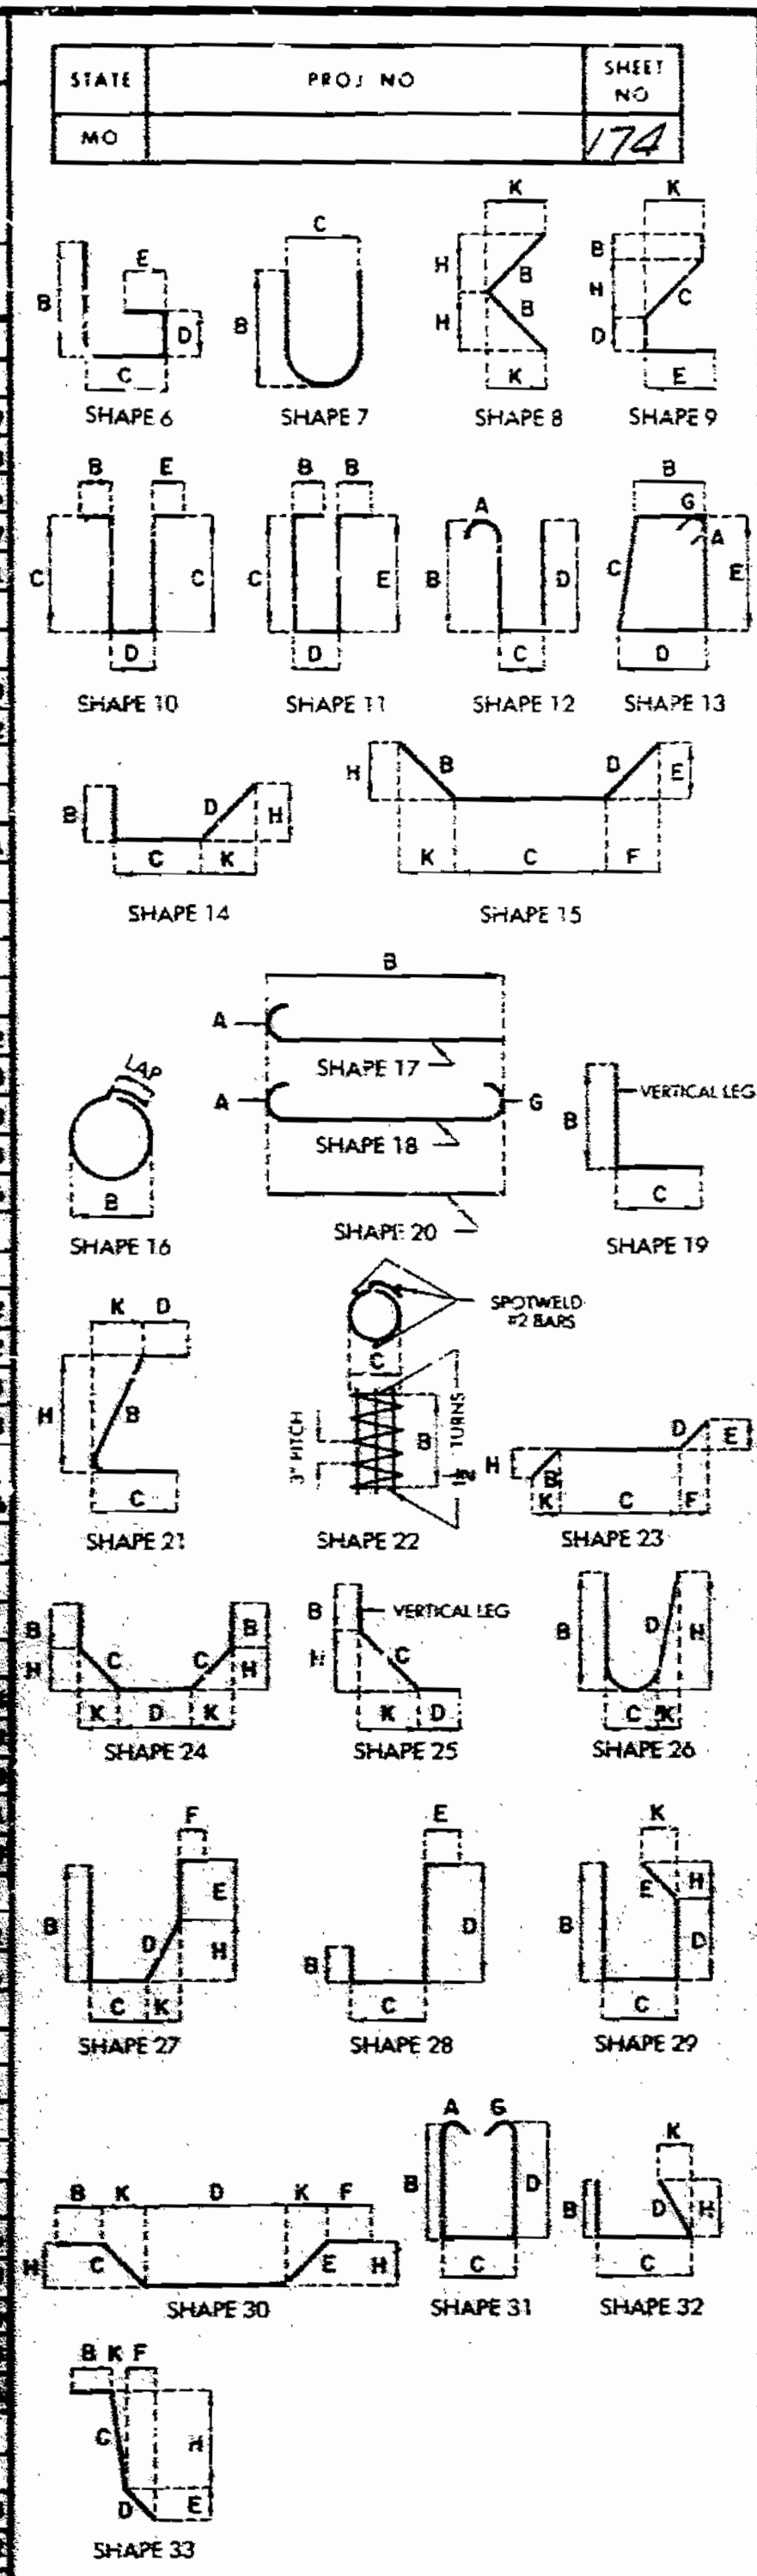


BENDING DIAGRAMS

\*Two (2) additional #6-H6 are included in bar bill for testing.


BAR SIZE	D (IN.)	END HOOK DIMENSIONS			
		180° HOOKS		90° HOOKS	
		A OR G	J	A OR G	A OR G
#3	2 1/4"	5"	3"	6"	6"
#4	3"	6"	4"	8"	8"
#5	3 1/2"	7"	5"	10"	10"
#6	4 1/4"	8"	6"	12"	12"
#7	5 1/4"	10"	7"	14"	14"
#8	6"	11"	8"	16"	16"
#9	9 1/4"	15"	11 1/4"	19"	19"
#10	10 1/4"	17"	13 1/4"	22"	22"
#11	12"	19"	14 1/4"	24"	24"
#14	18 1/4"	27"	21 1/4"	33"	33"

**NOTES:**  
 ALL STANDARD HOOKS AND BENDS OTHER THAN 180 DEG. TO BE BENT WITH SAME PROCEDURE AS FOR 90 DEG. STD. HOOKS.  
 HOOKS AND BENDS SHALL BE IN ACCORDANCE WITH THE PROCEDURES AS SHOWN ON THIS SHEET.  
 E - EPOXY COATED REINFORCEMENT.  
 S - STIRRUP.  
 X - BAR IS INCLUDED IN SUBSTRUCTURE QUANTITIES.  
 V - BAR DIMENSIONS VARY IN EQUAL INCREMENTS BETWEEN DIMENSIONS SHOWN ON THIS LINE AND THE FOLLOWING LINE.  
 NO. EA. - NUMBER OF BARS OF EACH LENGTH.  
 NOMINAL LENGTHS - ARE BASED ON OUT TO OUT DIMENSIONS SHOWN IN BENDING DIAGRAMS AND ARE LISTED FOR FABRICATORS USE (NEAREST INCH).  
 ACTUAL LENGTHS - ARE MEASURED ALONG CENTERLINE BAR TO THE NEAREST INCH.  
 PAYWEIGHTS ARE BASED ON ACTUAL LENGTHS.

Handwritten signature/initials.

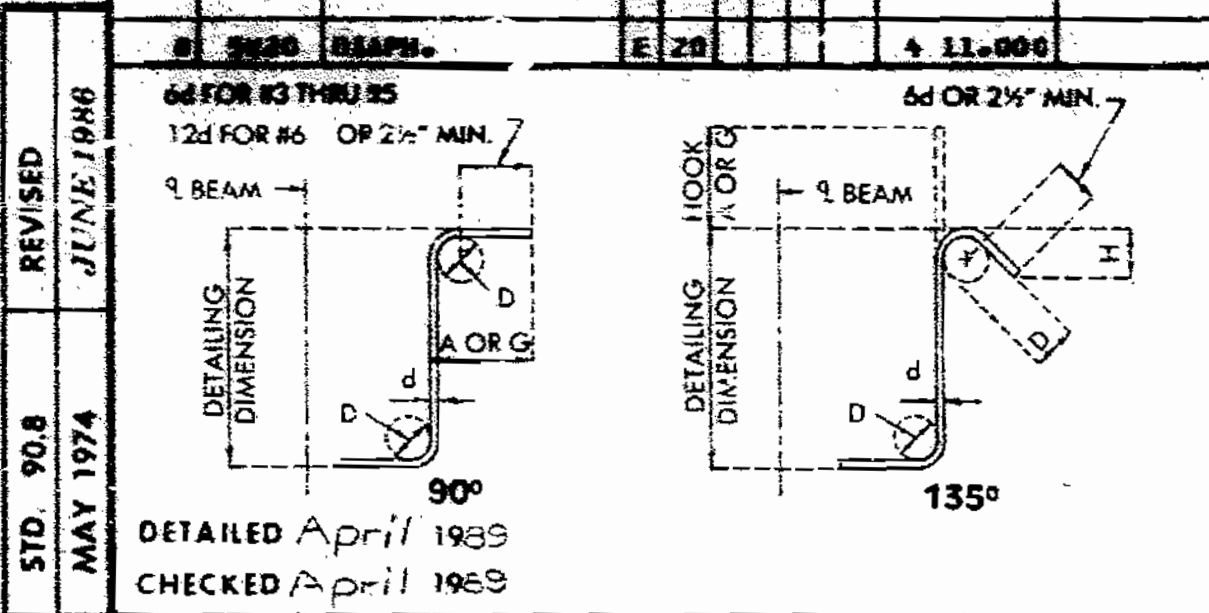

BAR SIZE	D (IN.)	STIRRUP HOOK DIMENSIONS			
		90° HOOK		135° HOOK	
		HOOK A OR G	HOOK A OR G	APPROX. H	
#3	1 1/4"	4"	4"	2 1/4"	
#4	2"	4 1/4"	4 1/4"	3"	
#5	2 1/2"	6"	5 1/4"	3 1/4"	
#6	4 1/4"	12"	7 3/4"	4 1/4"	

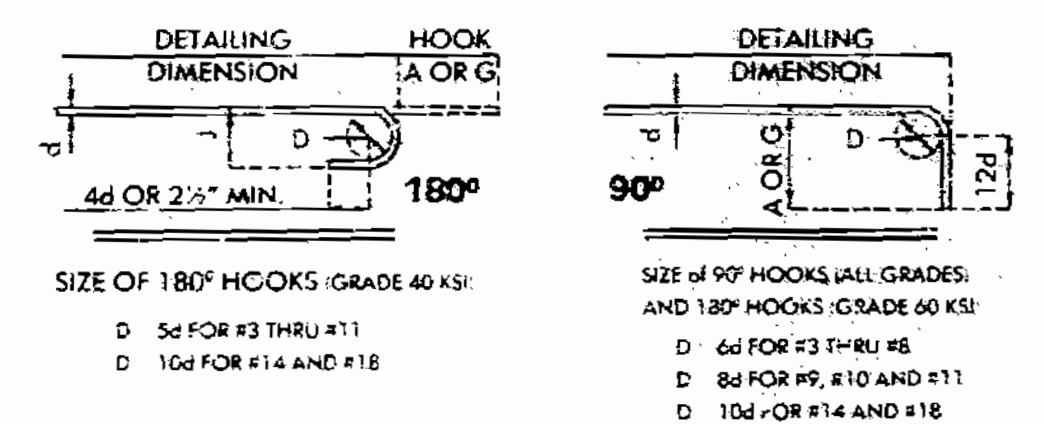


NOTE: UNLESS OTHERWISE NOTED DIAMETER "D" IS THE SAME FOR ALL BENDS AND HOOKS ON A BAR.  
 Note: This drawing is not to scale. Follow dimensions.


REVISED 7/16/19

COMPLETE BILL OF REINFORCING STEEL																		
NO. REQD.	MARK NO.	LOCATION	EPOXY	SHAPE NO.	STIRRUP	SUBSTR.	VARIES	DIMENSIONS							NOMINAL LENGTH	ACTUAL LENGTH	WEIGHT	
								B	C	D	E	F	H	K				
SIZE	MARK							FT.	IN.	FT.	IN.	FT.	IN.	FT.	IN.	FT.	IN.	LBS.
INT. BT. NO. 7																		
12	5H22	STRAND TIE BAR		20				4	6.000						4	6	4	56
8	5H23	STRAND TIE BAR		20				3	3.000						3	3	3	27
16	4H60	DIAPH.		20				7	10.000					7	10	7	84	
16	4H61	DIAPH.		20				7	0.000					7	0	7	168	
20	5H67	DIAPH.		19	S			10.000		2	8.000			3	6	3	71	
INT. BT. NO. 8																		
12	5H22	STRAND TIE BAR		20				4	6.000					4	6	4	56	
8	5H23	STRAND TIE BAR		20				3	3.000					3	3	3	27	
16	4H60	DIAPH.		20				7	10.000					7	10	7	84	
16	4H61	DIAPH.		20				7	0.000					7	0	7	168	
20	5H67	DIAPH.		19	S			10.000		2	8.000			3	6	3	71	
48	4U60	DIAPH.	E	28	S			20.000		4	8.000		12.000	7	4	7	230	
16	4U61	DIAPH.	E	28	S			20.000		4	8.000		14.000	7	6	7	172	
8	5V60	DIAPH.	E	20				4	11.000					4	11	4	41	
INT. BT. NO. 9																		
16	4H90	DIAPH.		20				7	0.000					7	0	7	168	
16	4H91	DIAPH.		20				7	2.000					7	2	7	27	
24	5H92	DIAPH.		20				7	10.000					7	10	7	630	
2	5H93	DIAPH.		20				4	0.000					4	0	4	80	
8	5H94	DIAPH.		21	S			22.000		2	10.000			20.625	2.500	4	36	
8	5H95	DIAPH.		22	S			14.000		2	10.000			13.625	5.000	4	39	
64	4H90	DIAPH.	E	28	S			15.000		2	2.000		12.000	4	5	4	182	
64	4H91	DIAPH.	E	11	S			15.000		2	2.000		12.000	4	5	4	182	
16	4H92	DIAPH.	E	28	S			15.000		4	1.000		14.000	6	6	6	144	
16	4H93	DIAPH.	E	11	S			15.000		4	1.000		14.000	6	6	6	144	
8	5V90	DIAPH.	E	20				4	1.000					4	1	4	34	
INT. BT. NO. 10																		
12	5H22	STRAND TIE BAR		20				4	6.000					4	6	4	56	
8	5H23	STRAND TIE BAR		20				3	3.000					3	3	3	27	
16	4H60	DIAPH.		20				7	10.000					7	10	7	84	
16	4H61	DIAPH.		20				7	0.000					7	0	7	168	
20	5H67	DIAPH.		19	S			10.000		2	8.000			3	6	3	71	
48	4U60	DIAPH.	E	28	S			20.000		4	8.000		12.000	7	4	7	230	
16	4U61	DIAPH.	E	28	S			20.000		4	8.000		14.000	7	6	7	172	
8	5V60	DIAPH.	E	20				4	11.000					4	11	4	41	


COMPLETE BILL OF REINFORCING STEEL																					
NO. REQD.	MARK NO.	LOCATION	EPOXY	SHAPE NO.	STIRRUP	SUBSTR.	VARIES	DIMENSIONS							NOMINAL LENGTH	ACTUAL LENGTH	WEIGHT				
								B	C	D	E	F	H	K							
SIZE	MARK							FT.	IN.	FT.	IN.	FT.	IN.	FT.	IN.	FT.	IN.	LBS.			
INT. BT. NO. 11																					
12	5H120	STRAND TIE BAR		23	S			15.000		2	0.000		15.000	10.000	11.250	10.000	11.250	4	4	5	55
16	4H111	DIAPH.		20				7	9.000					9	9	9	9	9	9	9	104
16	4H112	DIAPH.		20				8	10.000					8	10	8	10	8	10	8	212
8	5H113	STRAND TIE BAR		23	S			15.000		2	0.000		15.000	10.000	11.250	10.000	11.250	3	3	3	27
20	5H114	DIAPH.		19	S			10.000		2	8.000			3	6	3	5	71			
48	4U110	DIAPH.	E	28	S			2	6.000		4	8.000		12.000	8	2	8	8	2	8	257
16	4U111	DIAPH.	E	28	S			2	6.000		4	8.000		14.000	8	4	8	8	4	8	192
8	5V110	DIAPH.	E	20				4	11.000					4	11	4	11	4	11	4	41
INT. BT. NO. 12																					
12	5H120	STRAND TIE BAR		23	S			15.000		2	0.000		15.000	10.125	11.000	10.125	11.000	4	6	4	55
16	4H121	DIAPH.		20				10	0.000					10	0	10	0	10	0	10	107
16	4H122	DIAPH.		20				9	0.000					9	0	9	0	9	0	9	216
8	5H123	STRAND TIE BAR		23	S			15.000		2	0.000		15.000	10.125	11.000	10.125	11.000	3	3	3	27
20	5H124	DIAPH.		19	S			11.000		2	8.000			3	7	3	6	73			
48	4U120	DIAPH.	E	28	S			2	6.000		4	8.000		12.000	8	2	8	8	2	8	257
16	4U121	DIAPH.	E	28	S			2	6.000		4	8.000		14.000	8	4	8	8	4	8	192
8	5V120	DIAPH.	E	20				4	11.000					4	11	4	11	4	11	4	41
INT. BT. NO. 13																					
16	4H130	DIAPH.		20				9	4.000					9	4	9	4	9	4	9	221
16	4H131	DIAPH.		20				9	6.000					9	4	9	4	9	4	9	100
2	5H132	DIAPH.		20				52	5.000					52	9	52	9	52	9	52	110
4	5H133	DIAPH.		23	S			10	7.50		3	8.000		7.500	7.625	4	7	4	7	38	
20	5H134	DIAPH.		20				10	3.000					10	3	10	3	10	3	10	836
8	5H135	DIAPH.		21	S			2	11.750		3	9.000		2	1.000	2	1.500	6	9	6	52
44	4U130	DIAPH.	E	28	S			2	1.000		2	2.000		12.000	5	3	5	1	217		
44	4U131	DIAPH.	E	11	S			2	1.000		2	2.000		12.000	5	3	5	1	217		
16	4U132	DIAPH.	E	28	S			2	1.000		4	1.000		14.000	7	4	7	0	168		
16	4U133	DIAPH.	E	11	S			2	1.000		4	1.000		14.000	7	4	7	0	168		
8	5V130	DIAPH.	E	20				4	1.000					4	1	4	1	4	1	4	34
INT. BT. NO. 14																					
12	5H22	STRAND TIE BAR		20				4	6.000					4	6	4	56				
8	5H23	STRAND TIE BAR		20				3	3.000					3	3	3	27				
16	4H60	DIAPH.		20				7	10.000					7	10	7	84				
16	4H61	DIAPH.		20				7	0.000					7	0	7	168				
20	5H67	DIAPH.		19	S			10.000		2	8.000			3	6	3	71				
48	4U60	DIAPH.	E	28	S			20.000		4	8.000		12.000	7	4	7	230				
16	4U61	DIAPH.	E	28	S			20.000		4	8.000		14.000	7	6	7	172				
8	5V60	DIAPH.	E	20				4	11.000					4	11	4	41				

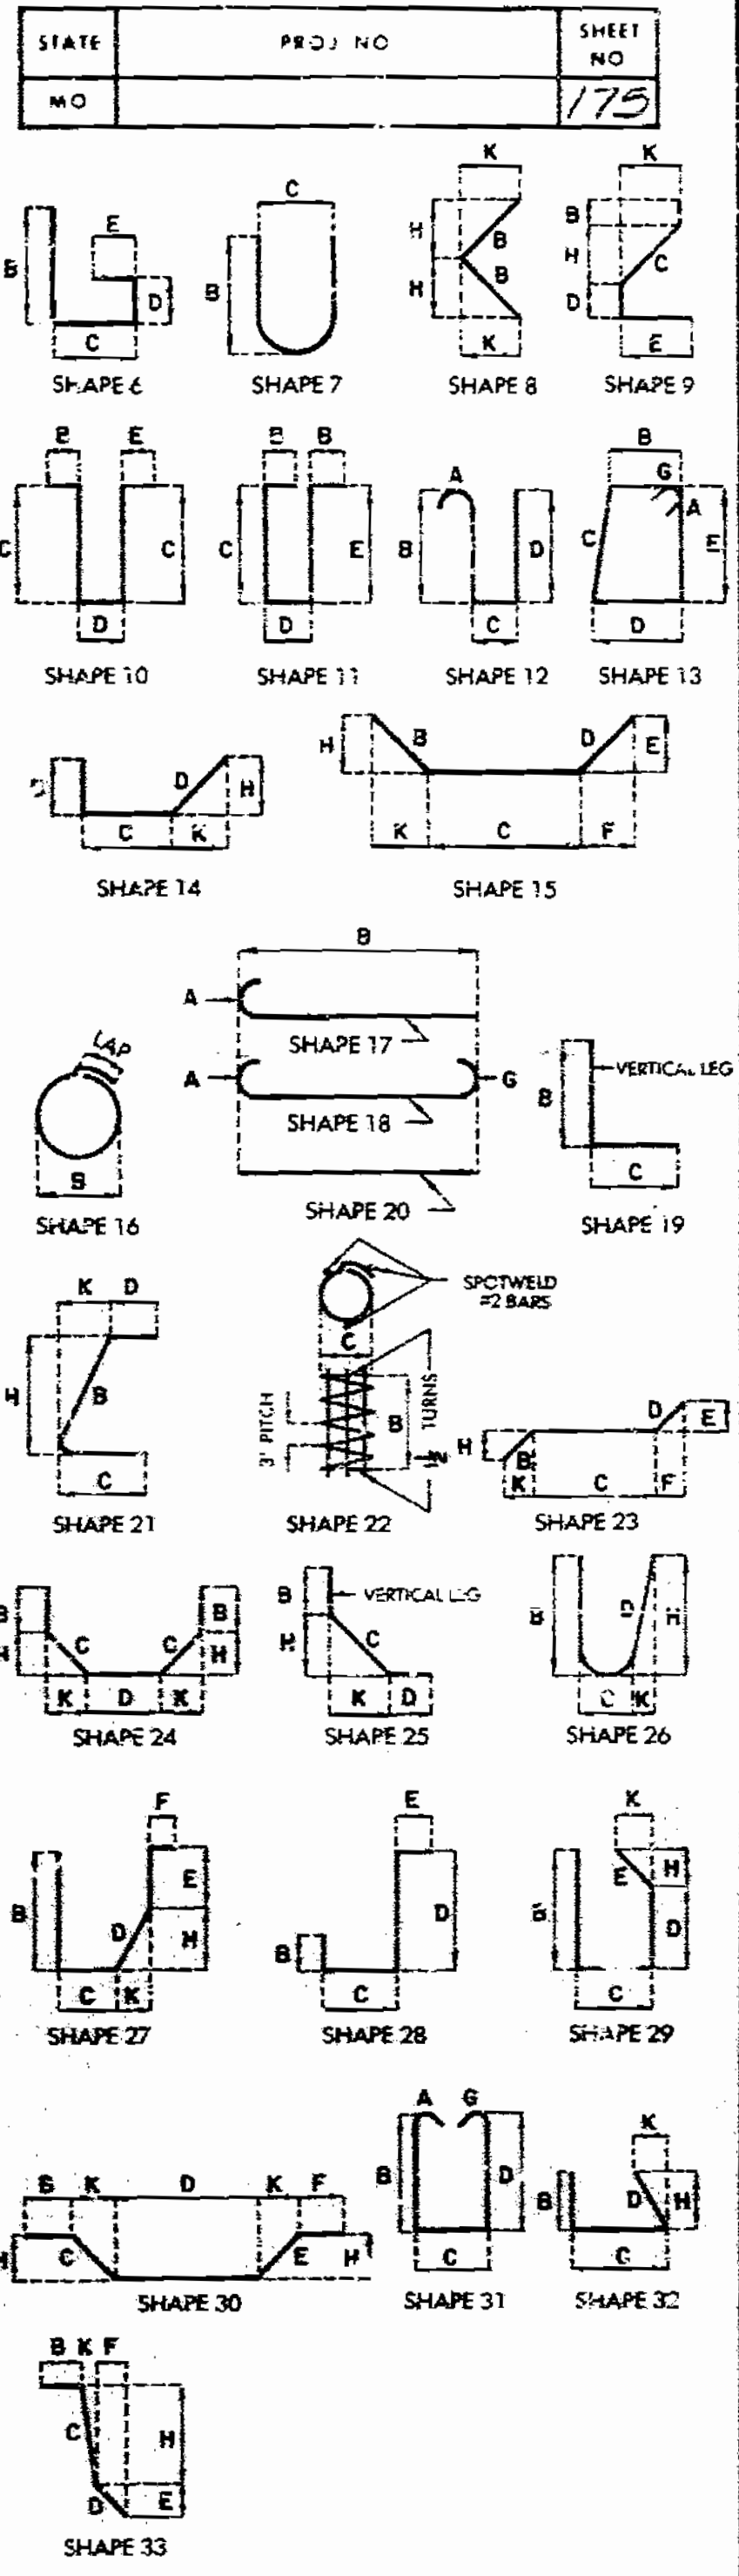

BENDING DIAGRAMS

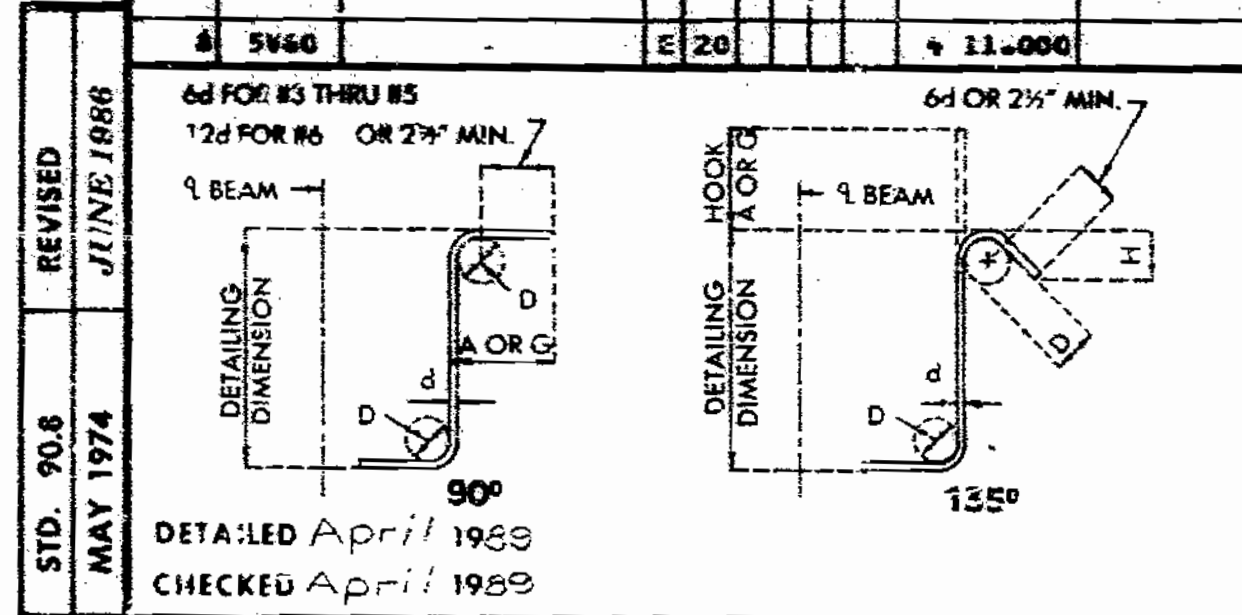


BAR SIZE	D (IN.)	90° HOOK		135° HOOK		APPROX. H
		HOOK A OR G	A OR G	HOOK A OR G	A OR G	
#3	1 1/2"	4"	4"	4"	4"	2 1/2"
#4	2"	4 1/2"	4 1/2"	4 1/2"	4 1/2"	3"
#5	2 1/2"	6"	6"	5 1/2"	5 1/2"	3 1/2"
#6	4 1/2"	12"	12"	7 1/2"	7 1/2"	4 1/2"

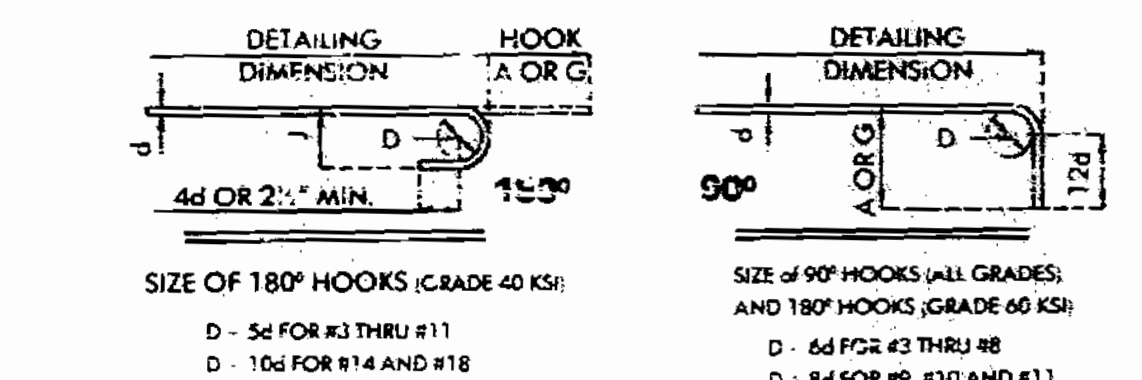

BAR SIZE	D (IN.)	180° HOOKS		90° HOOKS	
		ALL GRADES		ALL GRADES	
		A OR G	J	A OR G	J
#3	2 1/4"	5"	5"	5"	5"
#4	3"	6"	6"	6"	6"
#5	3 3/4"	7"	7"	7"	7"
#6	4 1/2"	8"	8"	8"	8"
#7	5 1/2"	10"	10"	10"	10"
#8	6"	11"	11"	11"	11"
#9	9 1/2"	15"	15"	15"	15"
#10	10 1/2"	17"	17"	17"	17"
#11	12"	19"	19"	19"	19"




COMPLETE BILL OF REINFORCING STEEL														COMPLETE BILL OF REINFORCING STEEL																							
NO. REQ'D.	MARK NO.	LOCATION	EPOXY	SHAPE NO.	STIRRUP	SUBSTR.	VARIES	NO. EACH	DIMENSIONS							NOMINAL LENGTH	ACTUAL LENGTH	WEIGHT	NO. REQ'D.	MARK NO.	LOCATION	EPOXY	SHAPE NO.	STIRRUP	SUBSTR.	VARIES	NO. EACH	DIMENSIONS							NOMINAL LENGTH	ACTUAL LENGTH	WEIGHT
									B	C	D	E	F	H	K													FT.	IN.	FT.	IN.	FT.	IN.	FT.			
1204	581	SLAB CIP UNIT 3							41	3	41	3	51801			5	5	0	0	0								5	0	3	0	5					
414	582	SLAB TOP & BOT.							40	0	40	0	25700			33	10	0	0	0								33	10	0	0	71					
9	5517	SLAB BOT. BT-9							11	4	11	9				34	9	0	0	0							34	9	3	9	217						
9	5514	SLAB BOT. BT-9							15	4	15	4	127			34	3	0	0	0							34	3	3	3	102						
9	5514	SLAB BOT. BT-9							20	0	20	0	171			29	0	0	0	0							29	0	2	2	689						
9	5514	SLAB BOT. BT-9							20	0	20	0				28	6	2	6	6							28	6	2	6	689						
9	5514	SLAB BOT. BT-9							25	0	25	0	211			25	1	2	1	1							25	1	2	1	754						
9	5514	SLAB BOT. BT-9							26	3	26	3				35	0	0	0	0							35	0	3	9	608						
35	5541	SLAB TOP BT-9							29	6	29	6	262			28	1	2	1	1							28	1	2	1							
		SLAB TOP BT-9							34	0	34	0	894			22	6	2	2	2							22	6	2	2	475						
64	6562	SLAB TOP BT-10							22	6	22	6	216			41	0	0	0	0							41	0	1	0	43						
64	6563	SLAB TOP BT-11							22	9	22	9	218			40	0	0	0	0							40	0	0	0	83						
44	7541	SLAB TOP BT-12							44	9	44	9	509			30	0	0	0	0							30	0	0	0	9268						
22	5567	SLAB BOT. BT-5							3	9	3	9				19	2	1	2	1							19	2	1	2	1842						
32	5594	SLAB TOP BT-9							39	10	39	10	504			39	11	0	0	0							39	11	0	0	2299						
3	5535	SLAB BOT. BT-9							10	0	10	0	35			21	0	0	0	0							21	0	0	0	3368						
3	5536	SLAB BOT. BT-9							32	2	32	2	101			39	11	0	0	0							39	11	0	0							
2	4856	SLAB BT-9							22	5	22	5	35																								
36	5814	SLAB BT-9							3	2	3	2	116																								

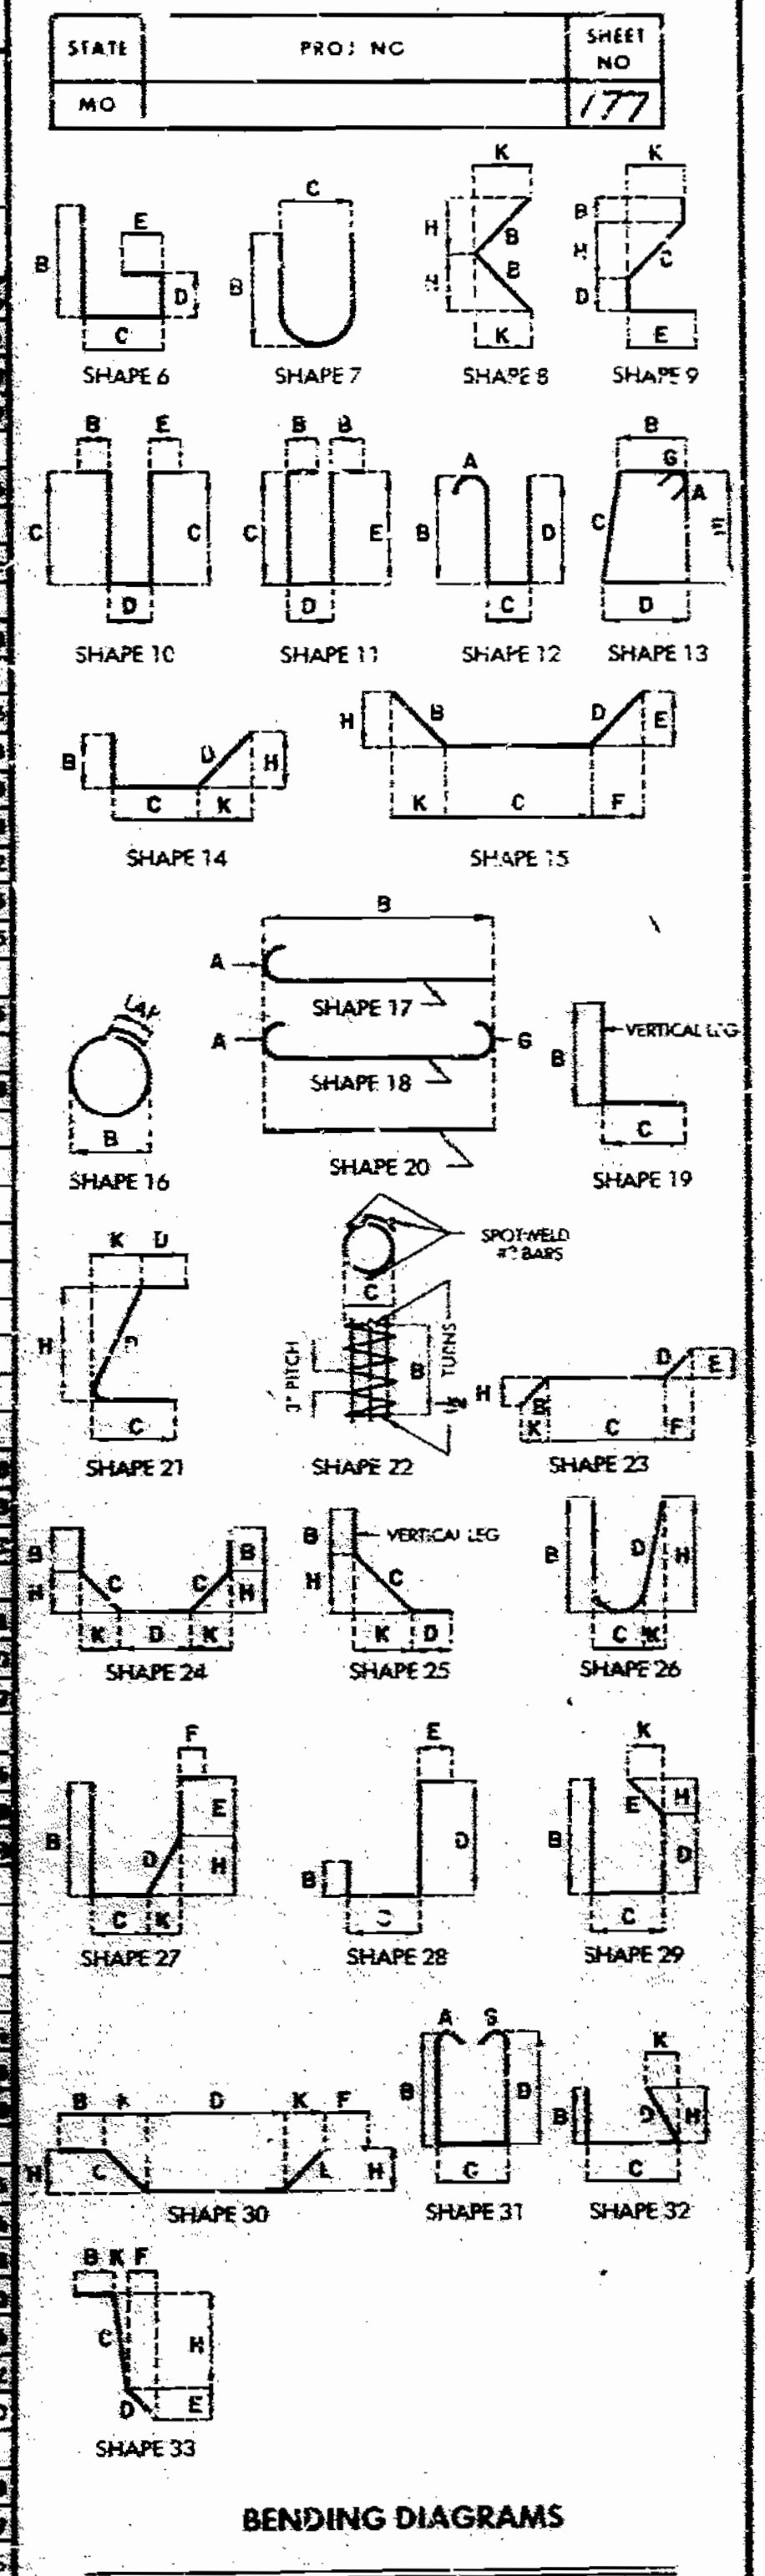



BENDING DIAGRAMS

Handwritten notes and signatures on the left side of the page.

\* Two (2) additional #4-5/00 #7-5/4 are included in bar bill for testing.

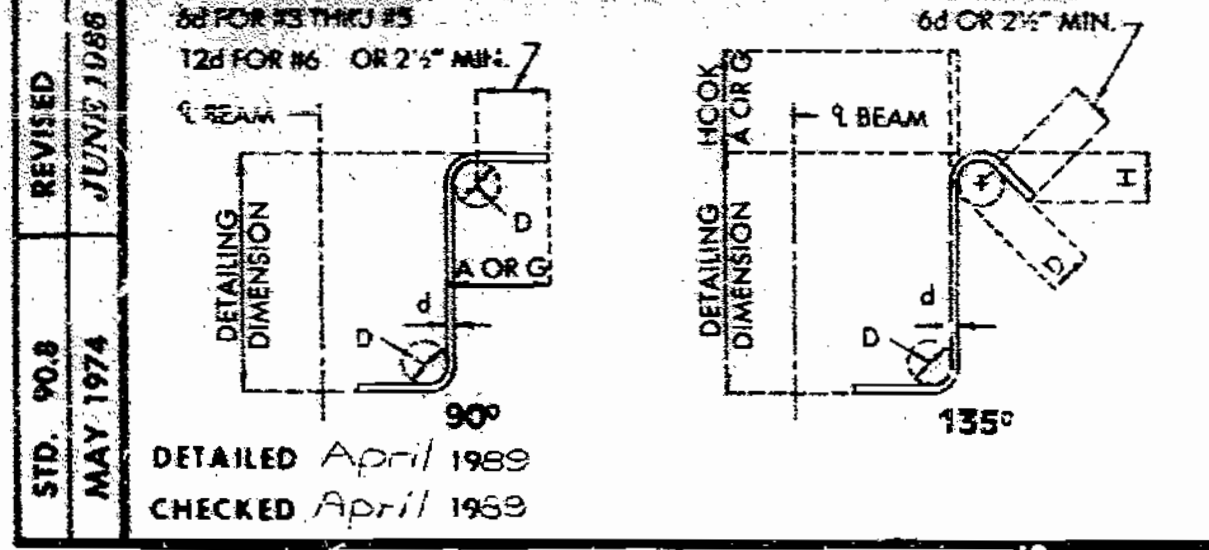

BAR SIZE	D (IN.)	90° HOOK		135° HOOK	
		A O.G.	H	A O.G.	H
#3	1 1/2"	4"	2 1/2"	4"	2 1/2"
#4	2"	5 1/2"	3 1/2"	5 1/2"	3 1/2"
#5	2 1/2"	6"	4 1/2"	6"	4 1/2"
#6	3 1/2"	12"	7 1/2"	12"	7 1/2"

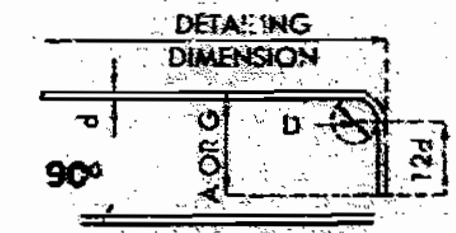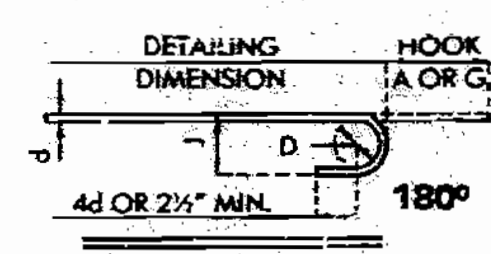

NOTE: UNLESS OTHERWISE NOTED DIAMETER "D" IS THE SAME FOR ALL BENDS AND HOOKS ON A BAR.  
Note: This drawing is not to scale. Follow dimensions.

BAR SIZE	D (IN.)	180° HOOKS		90° HOOKS	
		A O.G.	H	A O.G.	H
#3	2 1/2"	6"	3"	6"	3"
#4	3"	7"	4"	7"	4"
#5	3 1/2"	8"	5"	8"	5"
#6	4 1/2"	10"	6"	10"	6"
#7	5 1/2"	12"	7"	12"	7"
#8	6"	14"	8"	14"	8"
#9	7 1/2"	16"	9"	16"	9"
#10	10 1/2"	17"	13 1/2"	22"	10"
#11	12"	19"	14 1/2"	24"	11"
#14	18 1/2"	23"	21 1/2"	27"	14"

NOTES:  
ALL STANDARD HOOKS AND BENDS OTHER THAN 180 DEG. TO BE BENT WITH SAME PROCEDURE AS FOR 90 DEG. STD. HOOKS.  
HOOKS AND BENDS SHALL BE IN ACCORDANCE WITH THE PROCEDURES AS SHOWN ON THIS SHEET.  
E - EPOXY COATED REINFORCEMENT.  
S - STIRRUP  
X - BAR IS INCLUDED IN SUBSTRUCTURE QUANTITIES.  
V - BAR DIMENSIONS VARY IN EQUAL INCREMENTS BETWEEN DIMENSIONS SHOWN ON THIS LINE AND THE FOLLOWING LINE.  
NO. EA. - NUMBER OF BARS OF EACH LENGTH.  
NOMINAL LENGTHS - ARE BASED ON OUT TO OUT DIMENSIONS SHOWN IN BENDING DIAGRAMS AND ARE LISTED FOR FABRICATORS USE (NEAREST INCH).  
ACTUAL LENGTHS - ARE MEASURED ALONG CENTERLINE BAR TO THE NEAREST INCH.  
PAYWEIGHTS ARE BASED ON ACTUAL LENGTHS.

REVISED MAY 1974  
JUN 1988

DETAILED April 1989  
CHECKED April 1989

### COMPLETE BILL OF REINFORCING STEEL

NO. RECD.	MARK NO.	LOCATION	EPOXY	SHAPE NO.	STIRRUP	SUBSTR.	VARIES	DIMENSIONS											NOMINAL LENGTH	ACTUAL LENGTH	WEIGHT			
								B		C		D		E		F		H				K		
								FT.	IN.	FT.	IN.	FT.	IN.	FT.	IN.	FT.	IN.	FT.				IN.	FT.	IN.
SLAB P/C UNIT 3																								
728	551	SLAB-TOP & BOTTL.	E	20				41	3.000									41	3.000	31063				
175	552	SLAB-TOP & BOTTL.	E	20				40	0.000									40	0.000	7304				
651	553	SLAB-BOTTOM	E	20				3	7.000									3	7.000	2435				
35	5533	SLAB-TOP BT-9	E	20			V	3	1.000									3	1.000					
ENCR = 7-625 IN																								
73	7334	SLAB-TOP BT-12	E	20				24	8.000									24	8.000	507				
70	5535	SLAB-TOP BT-13	E	20			V	2	30 11.000									2	30 11.000	5234				
ENCR = 0-125 IN																								
64	7334	SLAB-TOP BT-10	E	20				59	8.000									59	8.000	7805				
64	7335	SLAB-TOP BT-11	E	20				52	9.000									52	9.000	6961				
64	7339	SLAB-TOP BT-12	E	20				40	0.000									40	0.000	5233				
64	7340	SLAB-TOP BT-12	E	20				30	5.000									30	5.000	79				
32	5541	SLAB-TOP BT-9	E	20			V	1	39 3.000									1	39 3.000	718				
ENCR = 13-750 IN																								
91	5562	SLAB-TOP BT-13	E	20			V	1	2 1.000									1	2 1.000	2997				
ENCR = 5.000 IN																								
27	5563	SLAB-BOTTOM	E	20				36	10.000									36	10.000	1057				
27	5564	SLAB-BOTTOM	E	20				39	6.000									39	6.000	1112				
36	5566	SLAB BT-19	E	19				6.000	2 8.000									3	2 3 1	116				
2	45102	SLAB BT-19	E	20				22	9.000									22	9.000	88				
SLAB P/C UNIT 4																								
741	551	SLAB-TOP	E	20				41	3.000									41	3.000	3188				
140	552	SLAB-TOP	E	20				40	0.000									40	0.000	3081				
657	553	SLAB-BOTTOM	E	20				3	7.000									3	7.000	2435				
70	5581	SLAB-TOP BT-16	E	20				35	6.000									35	6.000	3732				
70	5582	SLAB-TOP BT-13	E	20			V	2	20 4.000									2	20 4.000					
ENCR = 7.500 IN																								
70	5583	SLAB-TOP BT-17	E	20				28	11.000									28	11.000	2113				
64	7334	SLAB-TOP BT-14	E	20				40	0.000									40	0.000	5233				
64	7335	SLAB-TOP BT-15	E	20				30	3.000									30	3.000	392				
64	7336	SLAB-TOP BT-15	E	20				40	0.000									40	0.000	5233				
64	7337	SLAB-TOP BT-16	E	20				25	6.000									25	6.000	306				
64	7338	SLAB-TOP BT-16	E	20				40	0.000									40	0.000	5233				
64	7339	SLAB-TOP BT-16	E	20				27	3.000									27	3.000	366				
27	5584	SLAB-BOTTOM	E	20				35	11.000									35	11.000	1071				
30	5391	SLAB-BOTTOM	E	20				36	9.000									36	9.000	1150				
91	5592	SLAB-TOP BT-13	E	20			V	1	3 2.000									1	3 2.000					
ENCR = 5-125 IN																								
36	5598	SLAB BT-13	E	19				6.000	2 8.000									3	2 3 1	116				
2	45102	SLAB BT-13	E	20				29	0.000									29	0.000	39				


### COMPLETE BILL OF REINFORCING STEEL

NO. RECD.	MARK NO.	LOCATION	EPOXY	SHAPE NO.	STIRRUP	SUBSTR.	VARIES	DIMENSIONS											NOMINAL LENGTH	ACTUAL LENGTH	WEIGHT			
								B		C		D		E		F		H				K		
								FT.	IN.	FT.	IN.	FT.	IN.	FT.	IN.	FT.	IN.	FT.				IN.	FT.	IN.
47	587	CURB	E	10				2	0.000	6.000								4	6 4 4	34				
47	589	CURB	E	19				18.000	6.000									2	0 2 0	84				
47	5810	CURB	E	23				12.000	9.000	11.125	6.000			6.375	9.125	3 2 3		0	0 0	131				
32	5815	CURB	E	20				5	0.000									5	0 5 0	167				
2	5814	CURB	E	20				19	3.000									19	3 19 3	40				
1	5817	CURB	E	20				19	1.000									19	1 19 1	20				
1	5818	CURB	E	20				17	5.000									17	5 17 5	18				
2	5819	CURB	E	20				15	11.000									15	11 15 11	33				
2	5820	CURB	E	20				19	7.000									19	7 19 7	41				
1	5821	CURB	E	20				19	4.000									19	4 19 4	20				
1	5822	CURB	E	20				17	0.000									17	0 17 0	19				
2	5823	CURB	E	20				16	3.000									16	3 16 3	34				
3	5825	CURB	E	20				15	2.000									15	2 15 2	48				
1	5826	CURB	E	20				14	11.000									14	11 14 11	16				
1	5827	CURB	E	20				13	4.000									13	4 13 4	16				
3	5828	CURB	E	20				27	6.000									27	6 27 6	27				
1	5829	CURB	E	20				27	6.000									27	6 27 6	29				
1	5830	CURB	E	20				27	10.000									27	10 27 10	29				
2	5831	CURB	E	20				26	3.000									26	3 26 3	54				
2	5832	CURB	E	20				11	9.000									11	9 11 9	25				
21	5833	CURB (Light Support)	E	31	S			14.500	22.500	14.500								5	3 1 1	69				
12	5834	CURB (Light Support)	E	15	S			6.500	2 5.500	7.250								6	0 5 9	84				
21	5835	CURB (Light Support)	E	15	S			20.500	2 5.500	14.000								4	7 6 3	197				
12	5836	CURB (Light Support)	E	15	S			20.500	22.500	20.500	14.500	14.500	14.500	14.500	14.500	5 4 5 3		5	4 5 3	77				
14	5837	CURB (Light Support)	E	15	S			16.500	22.500	20.500	14.500	14.500	14.500	14.500	5 4 5 3			4	3 5 0	73				
42	5838	CURB (Light Support)	E	20				3 2.000										3	2 3 2	206				
24	5839	CURB	E	20				9 9.000										9	9 9 9	327				
12	5840	CURB	E	20				29 1.000										29	1 29 1	339				
12	5841	CURB	E	20				31 8.000										31	8 31 8	2378				
12	5842	CURB	E	20				29 11.000										29	11 29 11	374				
12	5843	CURB	E	20				28 1.000										28	1 28 1	391				
12	5844	CURB	E	20				26 2.000										26	2 26 2	325				
12	5845	CURB	E	20				28 9.000										28	9 28 9	340				
12	5846	CURB	E	20				36 4.000										36	4 36 4	586				
12	5847	CURB	E	20				36 7.000										36	7 36 7	588				
12	5848	CURB	E	20				25 9.000										25	9 25 9	340				
12	5849	CURB	E	20				35 9.000										35	9 35 9	447				
27	5850	CURB	E	20				40 9.000										40	9 40 9	520				
30	5391	SLAB-BOTTOM	E	20				36 9.000										36	9 36 9	340				
12	5851	CURB	E	20				30 7.000																

MISSOURI HIGHWAY AND TRANSPORTATION COMMISSION

STATE	PROJ NO	SHEET NO
MO	4-U-71-2E	31
SEC / SUR	22 TWP 48	RGE 33

FINAL PLANS

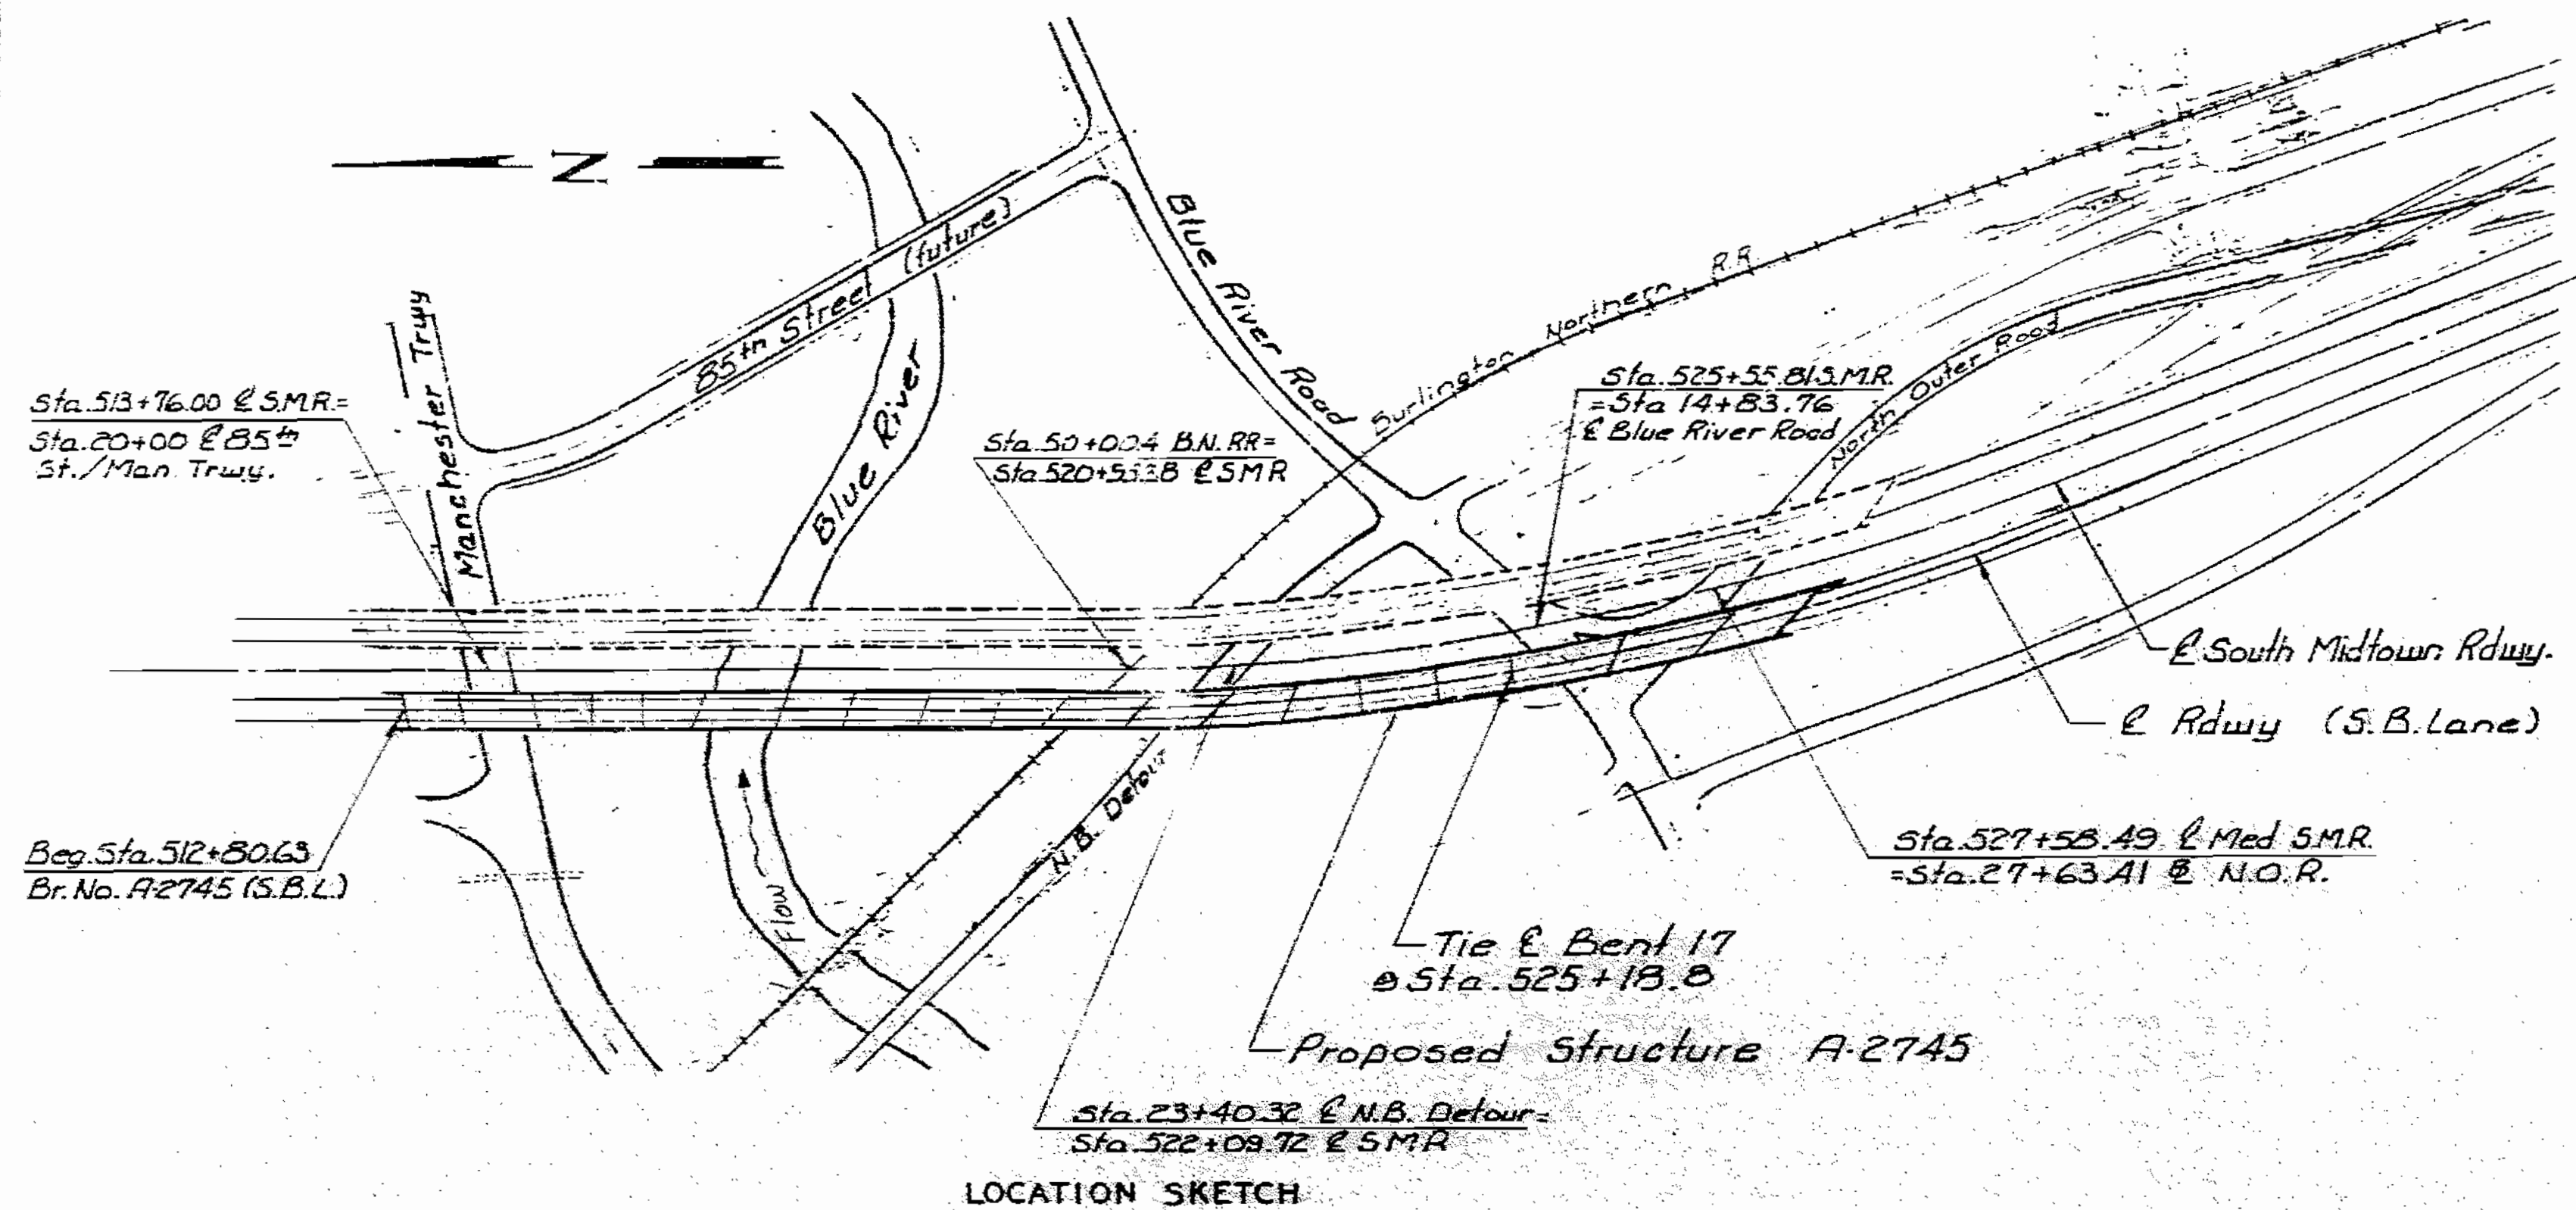

LOCATION SKETCH

INDEX OF DRAWINGS

- |                                      |                              |                               |                                     |
|--------------------------------------|------------------------------|-------------------------------|-------------------------------------|
| 1. INDEX OF DRAWINGS                 | 26. P/S GIRDER LAYOUT        | 51. ELEV. OF P/S CONC. I-GDR  | 76. PLAN OF SLAB                    |
| 2. PART PLAN & ELEVATION             | 27. ELEV. OF P/S CONC. I-GDR | 52. ELEV. OF P/S CONC. I-GDR  | 77. PLAN OF SLAB                    |
| 3. PART PLAN & ELEVATION             | 28. ELEV. OF P/S CONC. I-GDR | 53. ELEV. OF P/S CONC. I-GDR  | 78. PLAN OF SLAB                    |
| 4. PART PLAN & ELEVATION             | 29. ELEV. OF P/S CONC. I-GDR | 54. ELEV. OF P/S CONC. I-GDR  | 79. PLAN OF SLAB                    |
| 5. PART PLAN & ELEVATION             | 30. ELEV. OF P/S CONC. I-GDR | 55. PART LONGITUDINAL SECTION | 80. SUPERELEVATION TRANSITION       |
| 6. PART PLAN & ELEVATION             | 31. ELEV. OF P/S CONC. I-GDR | 56. PLAN OF STRUCTURAL STEEL  | 81. SLAB POURING SEQUENCE           |
| 7. PART PLAN & ELEVATION             | 32. ELEV. OF P/S CONC. I-GDR | 57. ELEVATION OF GIRDER       | 82. SLAB DRAINS                     |
| 8. PART PLAN & ELEVATION             | 33. ELEV. OF P/S CONC. I-GDR | 58. ELEVATION OF GIRDER       | 83. SLAB DRAINS                     |
| 9. GENERAL NOTES & QUANTITIES        | 34. ELEV. OF P/S CONC. I-GDR | 59. FIELD FLANGE SPLICES      | 84. ELASTOMERIC JOINT SEAL          |
| 10. END BENT NO. 1                   | 35. ELEV. OF P/S CONC. I-GDR | 60. MISCELLANEOUS STEEL       | 85. ELASTOMERIC JOINT SEAL          |
| 11. END BENT NO. 1                   | 36. ELEV. OF P/S CONC. I-GDR | 61. EARTHQUAKE RESTRAINERS    | 86. ELASTOMERIC JOINT SEAL          |
| 12. END BENT NO. 1                   | 37. ELEV. OF P/S CONC. I-GDR | 62. EARTHQUAKE RESTRAINERS    | 87. ELASTOMERIC JOINT SEAL          |
| 13. INT. BENT NO. 2 thru NO. 7       | 38. ELEV. OF P/S CONC. I-GDR | 63. INT. BENT DIAPHRAGMS      | 88. LIGHT STANDARD - DELETE 9-22-89 |
| 14. INT. BENT NO. 11 & NO. 12        | 39. ELEV. OF P/S CONC. I-GDR | 64. INT. BENT DIAPHRAGMS      | 89. LEFT BARRIER CURB               |
| 15. INT. BENT NO. 13 & NO. 14        | 40. ELEV. OF P/S CONC. I-GDR | 65. INT. BENT DIAPHRAGMS      | 90. LEFT BARRIER CURB               |
| 16. INT. BENT NO. 15 & NO. 16        | 41. ELEV. OF P/S CONC. I-GDR | 66. INT. BENT DIAPHRAGMS      | 91. RIGHT BARRIER CURB              |
| 17. INT. BENT NO. 8, 9, 10 & 18      | 42. ELEV. OF P/S CONC. I-GDR | 67. INT. BENT DIAPHRAGMS      | 92. RIGHT BARRIER CURB              |
| 18. INT. BENT NO. 17 & NO. 19        | 43. ELEV. OF P/S CONC. I-GDR | 68. STEEL DIAPH FOR P/S       | 93. BARRIER CURB AT END BTS.        |
| 19. END BENT NO. 20                  | 44. ELEV. OF P/S CONC. I-GDR | 69. SLAB HAUNCHING DIAGRAM    | 94. BAR LIST                        |
| 20. VERTICAL DRAIN AT END BENTS      | 45. ELEV. OF P/S CONC. I-GDR | 70. SLAB CURVE ORDINATES      | 95. BAR LIST                        |
| 21. LAMINATED NEOPRENE BRGS. (P/S)   | 46. ELEV. OF P/S CONC. I-GDR | 71. SLAB CURVE ORDINATES      | 96. BAR LIST                        |
| 22. LAMINATED NEOPRENE BRGS. (STEEL) | 47. ELEV. OF P/S CONC. I-GDR | 72. PRECAST P/S PANELS        | 97. BAR LIST                        |
| 23. TYPE "N" PTFE BEARINGS           | 48. ELEV. OF P/S CONC. I-GDR | 73. SECTION THRU SLAB (P/S)   | 98. BAR LIST                        |
| 24. P/S GIRDER LAYOUT                | 49. ELEV. OF P/S CONC. I-GDR | 74. PLAN OF SLAB              |                                     |
| 25. P/S GIRDER LAYOUT                | 50. ELEV. OF P/S CONC. I-GDR | 75. PLAN OF SLAB              |                                     |

**BRIDGE NO. A-2745**  
**OVER**  
 MANCHESTER TRAFFICWAY, BLUE RIVER,  
 BURLINGTON NORTHERN RR,  
 N.B. DETOUR, BLUE RIVER ROAD  
 & NORTH OUTER ROAD

SUPERSTRUCTURE CONTRACT

B.M.

STATE ROAD: "SOUTH MIDTOWN ROADWAY"  
 IN KANSAS CITY  
 PROJECT NO. STA. 512+80.53  
 JOB NO. 4-U-71-2E RTE. 71 S.B.L.

JACKSON COUNTY  
 DATE 8/13/89

STD. 706.35
STD.
A-2745

DESIGNED March 1988  
 DETAILED March 1989  
 CHECKED April 1989

Note: This drawing is not to scale. Follow dimensions.


Sheet No. 1A of 28

783195

STATE	PROJ NO	SHEET NO
MO	4-11-71-2E	82

FINAL PLANS


(64'-82'-65')(65'-65'-82'-82'-82')(82'-67'-90'-90')(79'-79'-85'-85') PRESTRESSED CONCRETE I-GIRDER SPANS  
(123'-123'-93') CONT. COMP. R. GIRDER SPANS

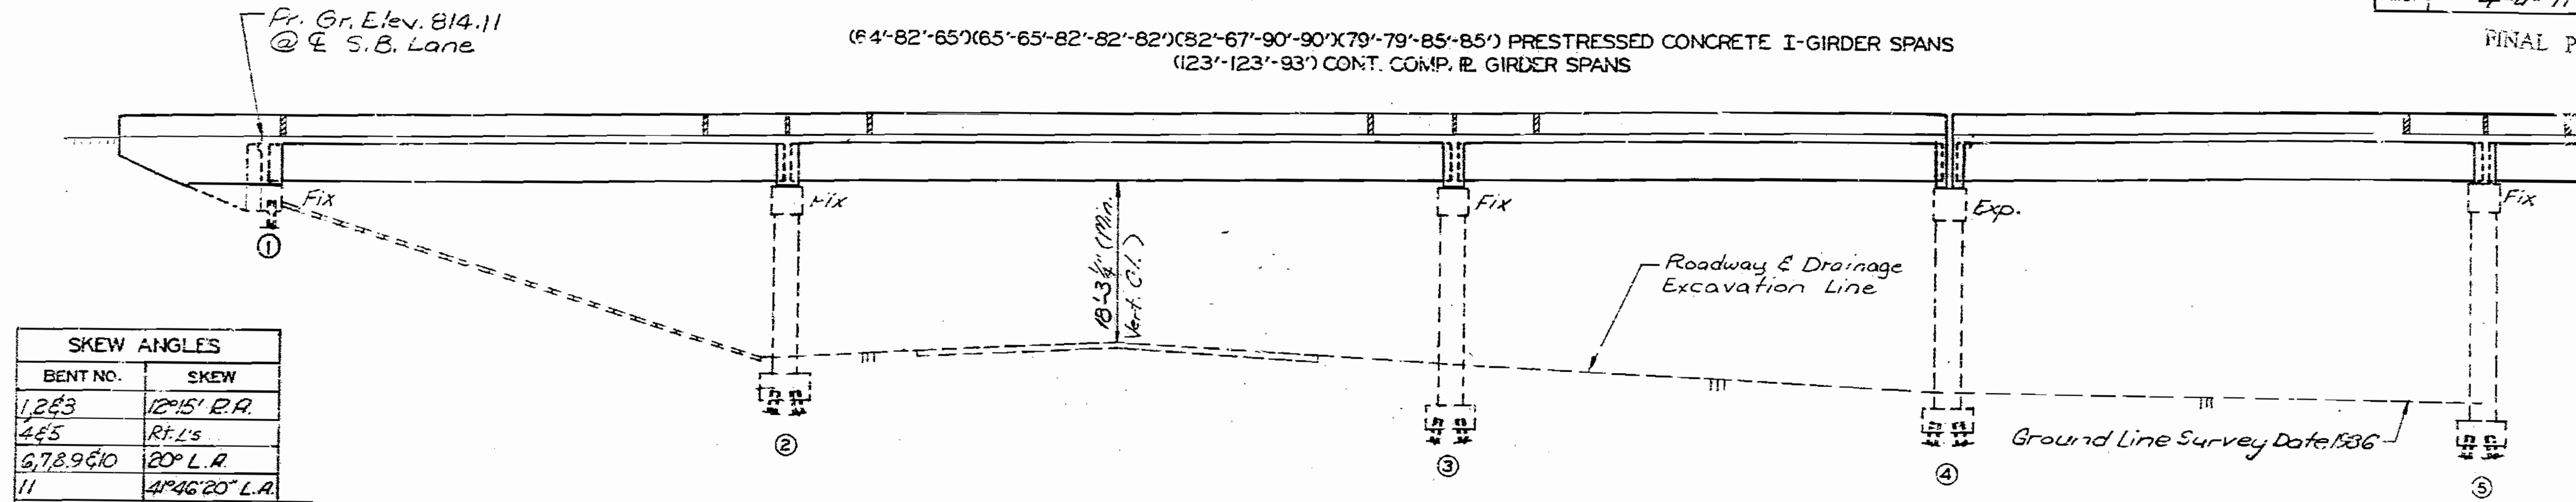

PART GENERAL ELEVATION

SKEW ANGLES	
BENT NO.	SKEW
1, 2 & 3	12°15' R.R.
4 & 5	R.F.L's
6, 7, 8, 9 & 10	20° L.R.
11	41°46'20" L.A.
12	42°41'30" L.A.
13	41°34'00" L.A.
14	26°18'44" L.A.
15, 16 & 17	Radial
18	38°09'11" L.A.
19	57°25'06" L.A.
20	59°17'55" L.A.

Note: Skew angles are measured at S.B.L.

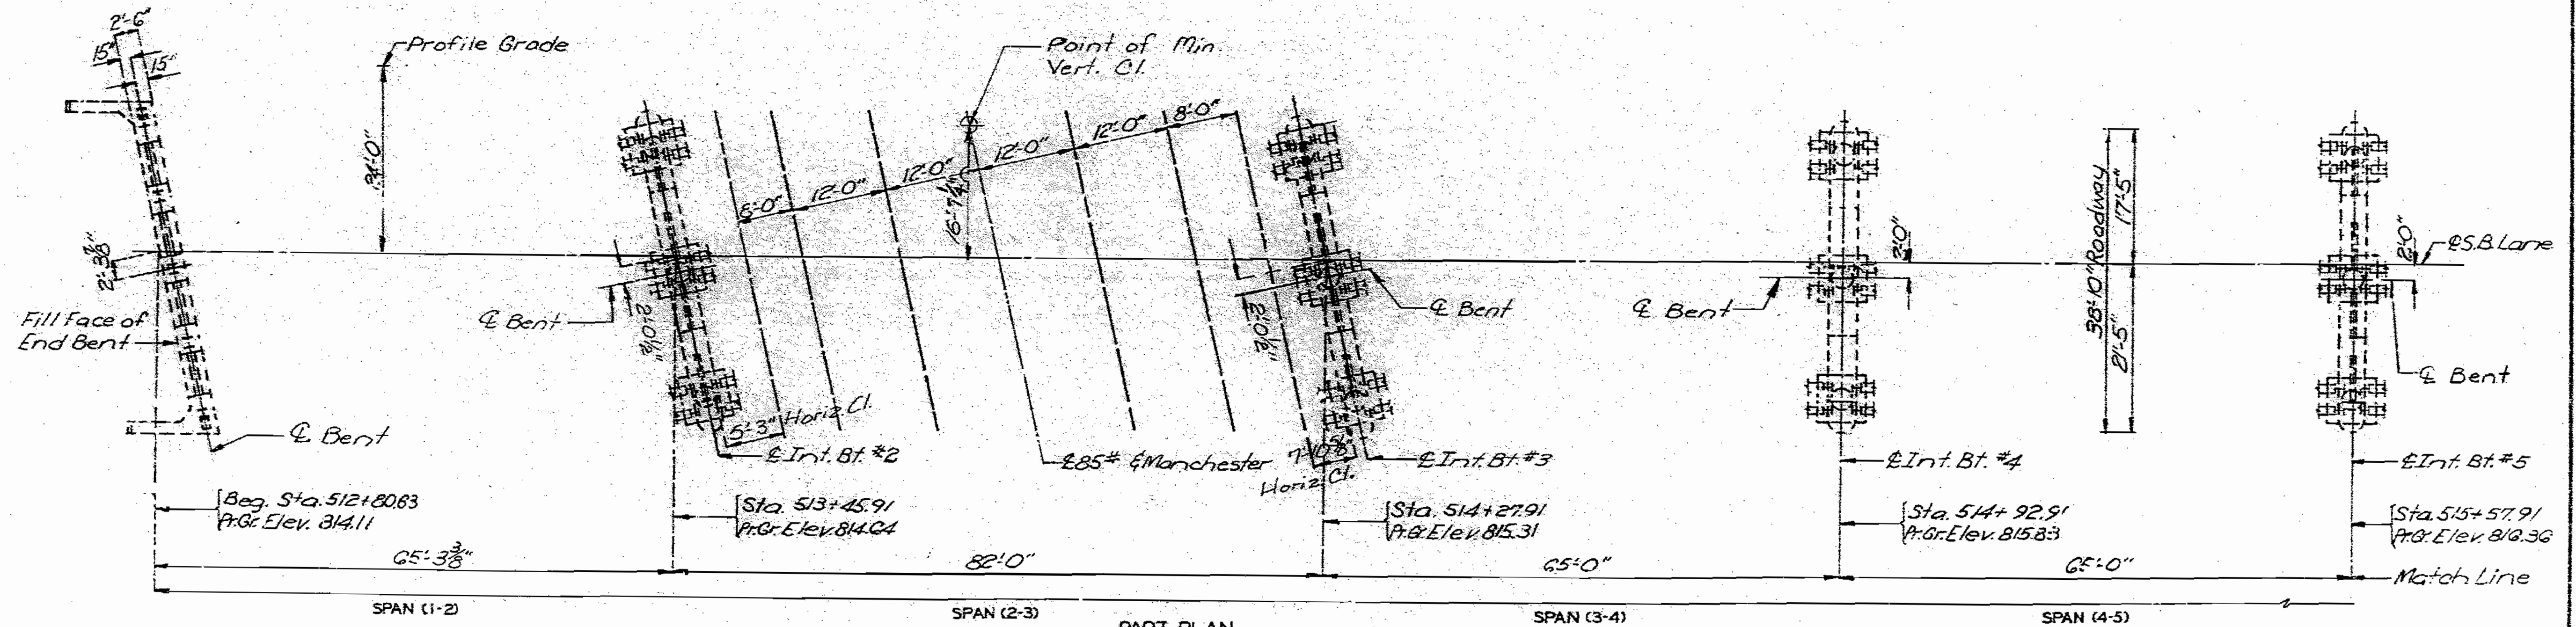

PART PLAN

Note: Deadman Anchor not shown for clarity.

DETAILED Sept. 1988  
CHECKED March 1989

Note: This drawing is not to scale. Follow dimensions.

Sheet No. 2A of 98

JACKSON


COUNTY

A-2745




STATE	PROJ. NO.	SHEET NO.
MO	A-11-71-2E	83

FINAL PLANS

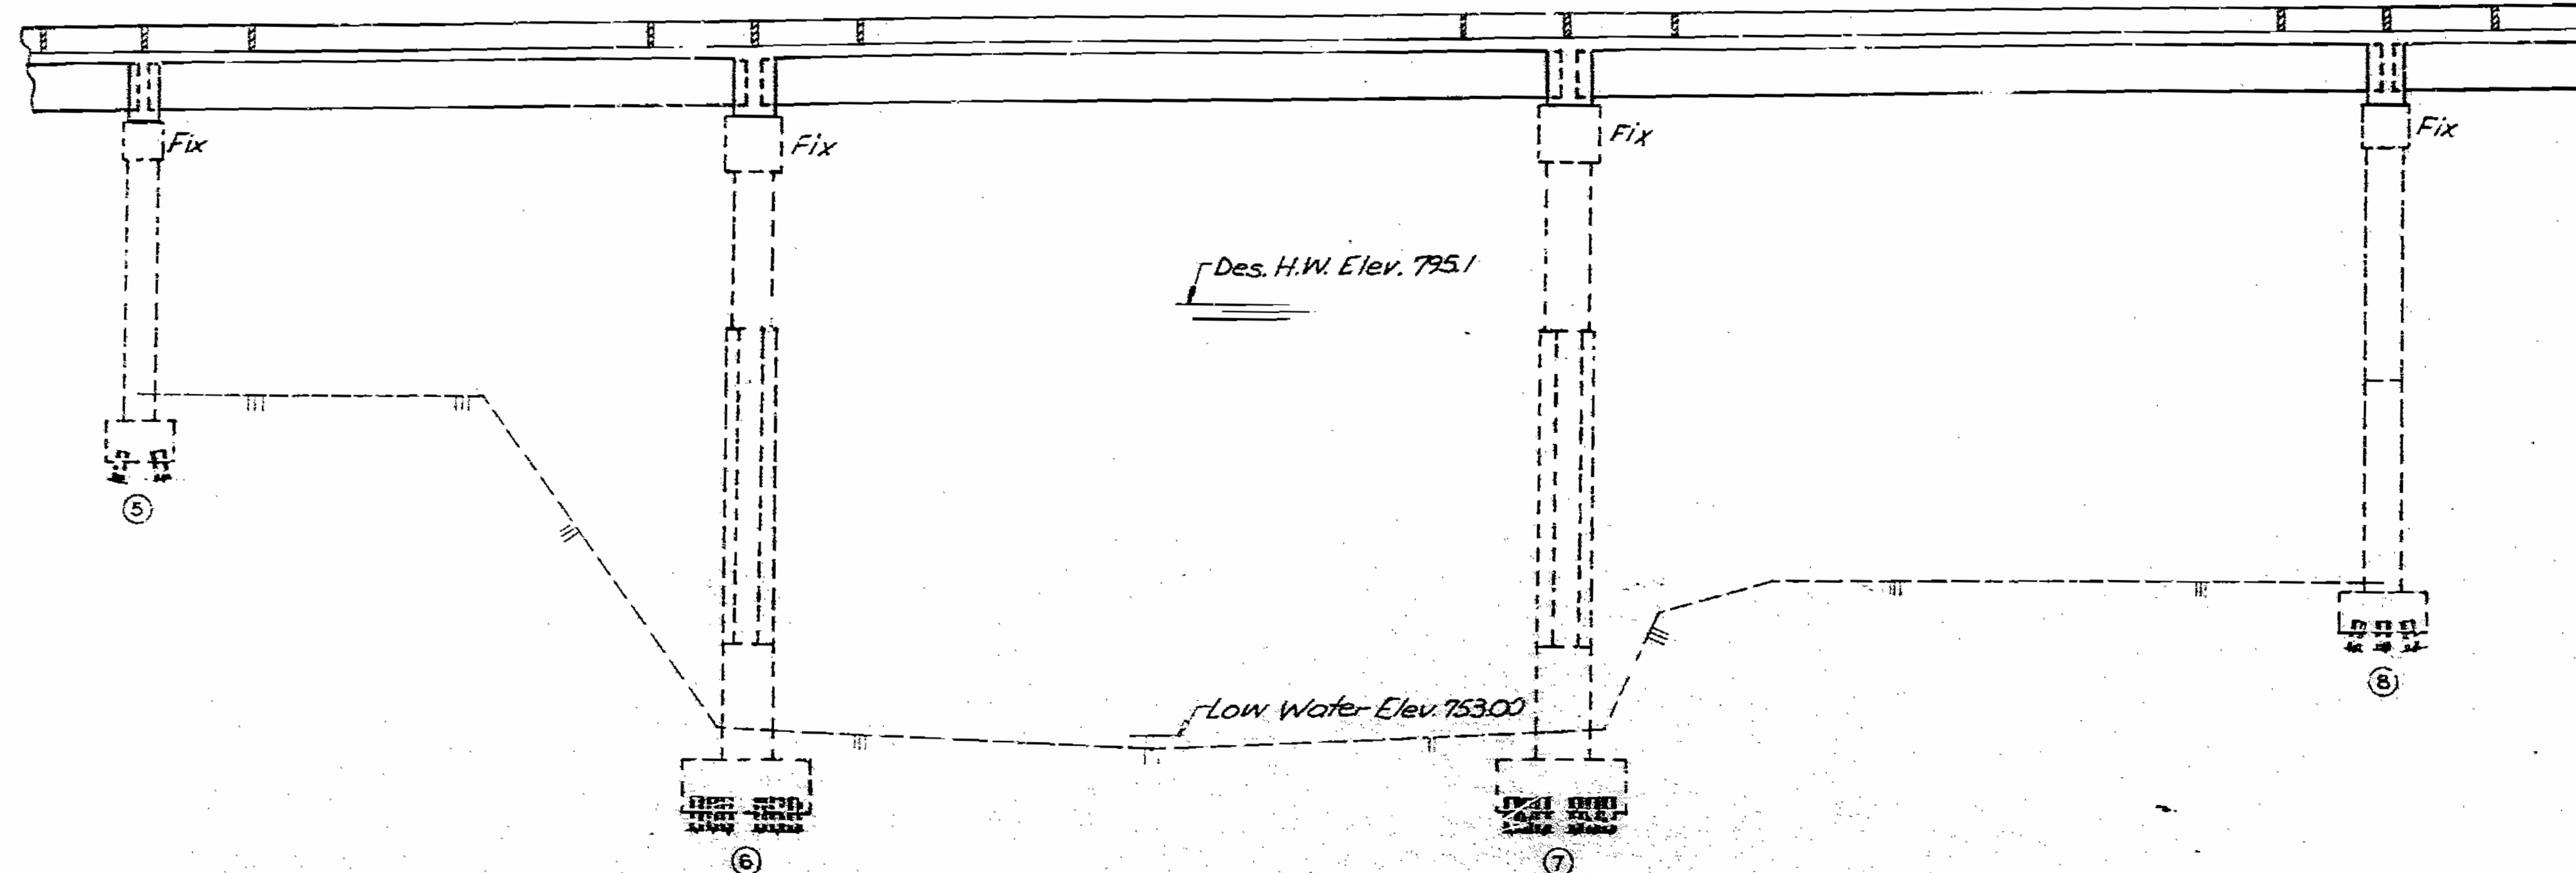

PART GENERAL ELEVATION

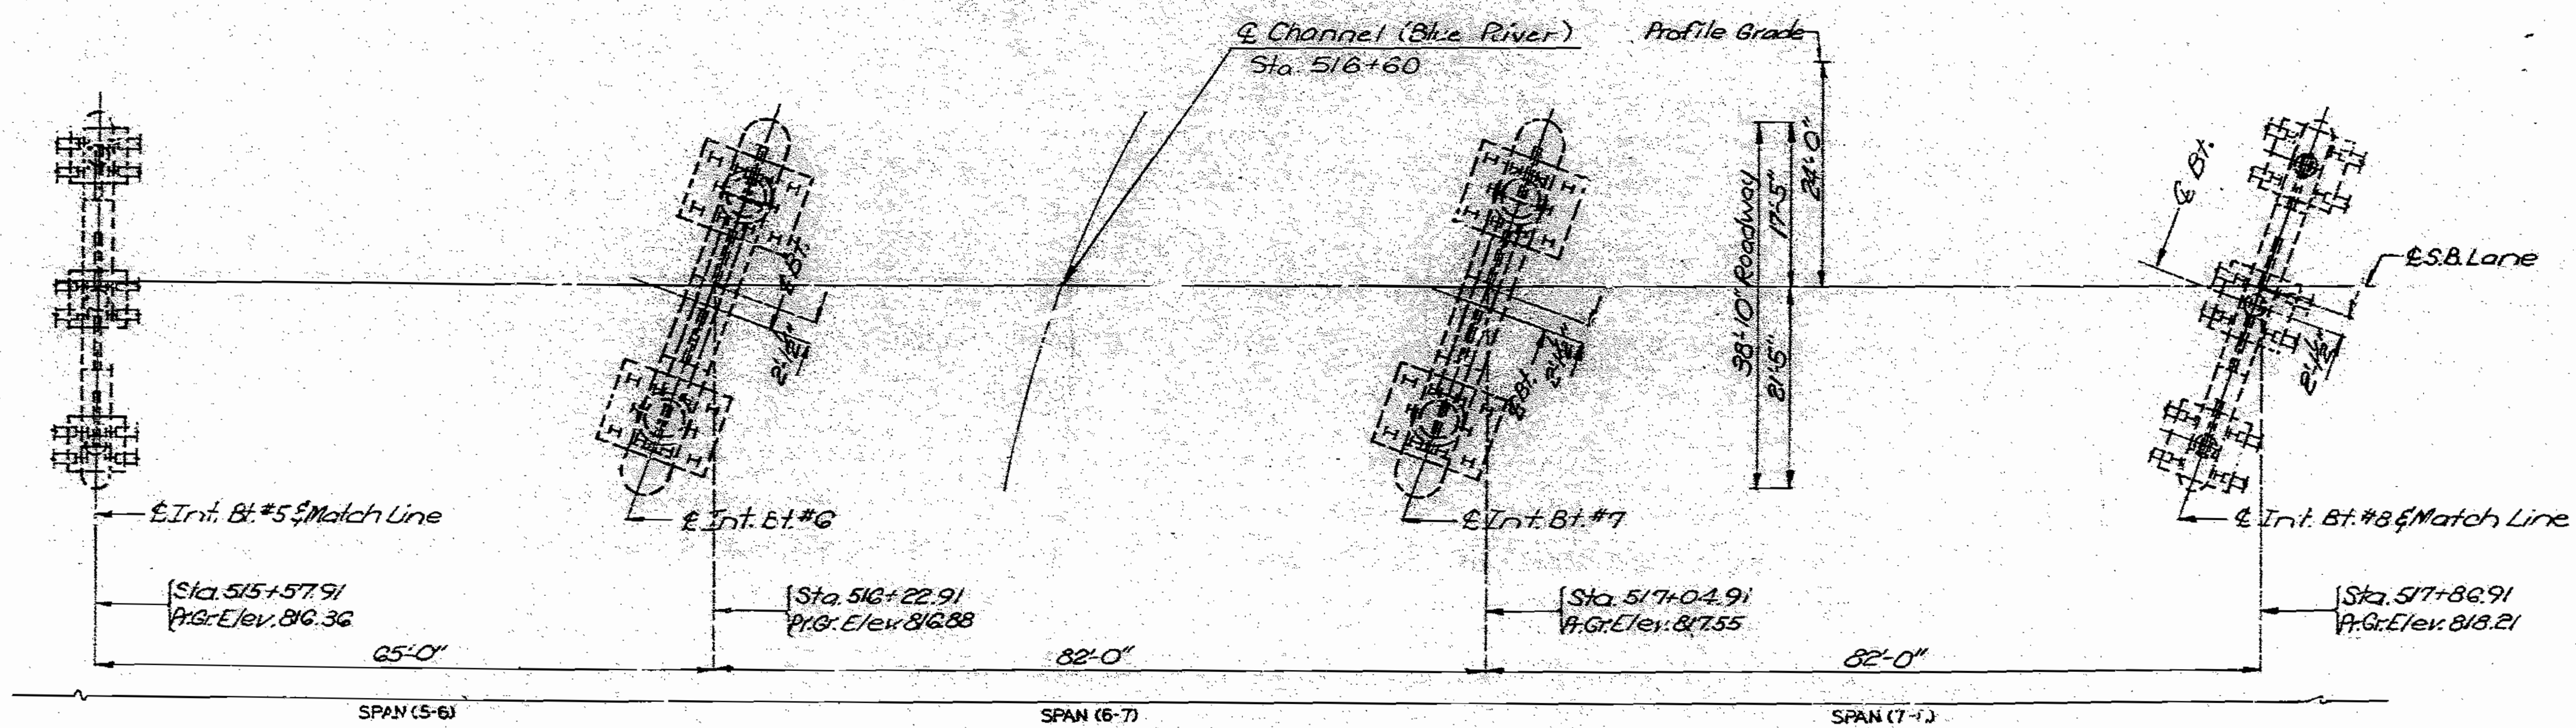

PART PLAN

1951

DETAILED Sept. 1988  
CHECKED March 1989

Note: This drawing is not to scale. Follow dimensions.


Sheet No. 3A of 98

JACKSON COUNTY


A-2745

STATE	PROJ. NO.	SHEET NO.
MO.	4-11-71-2E	34

FINAL PLANS

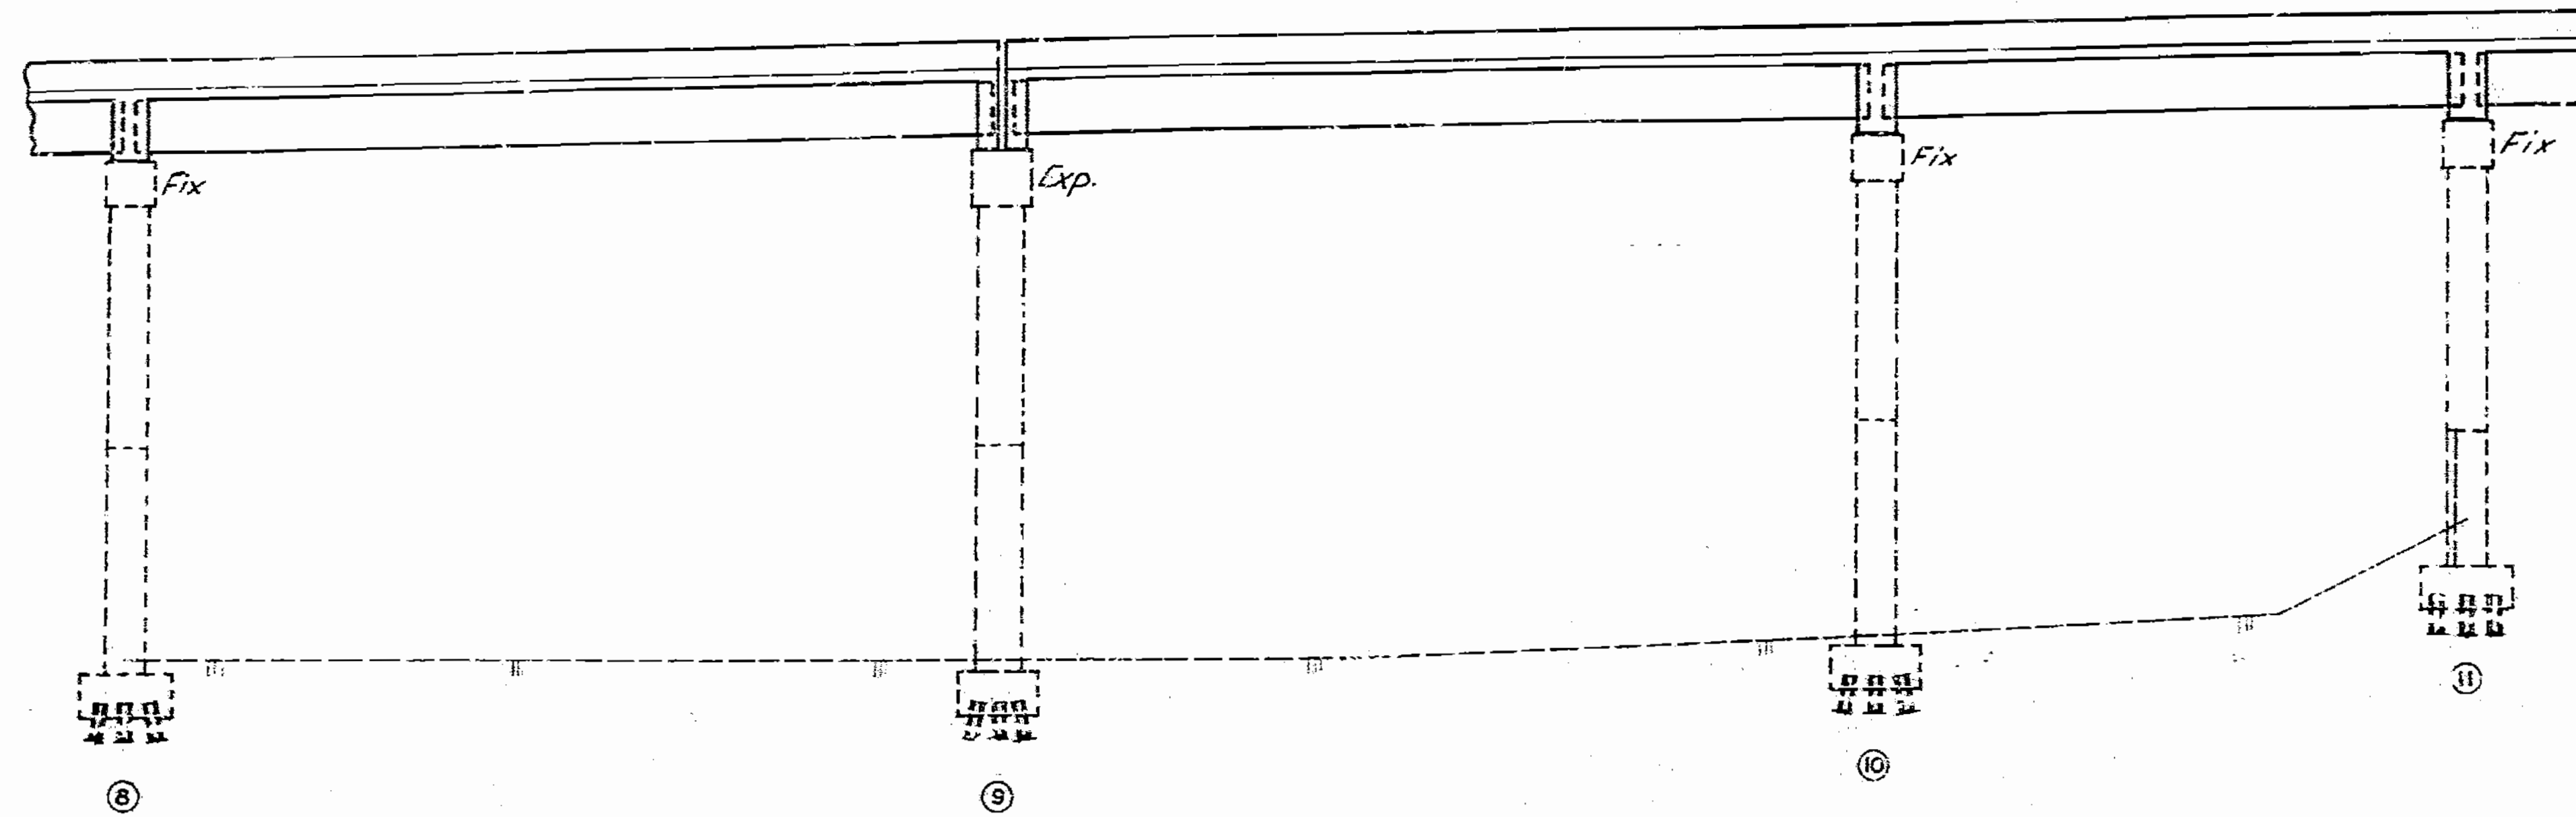

PART GENERAL ELEVATION

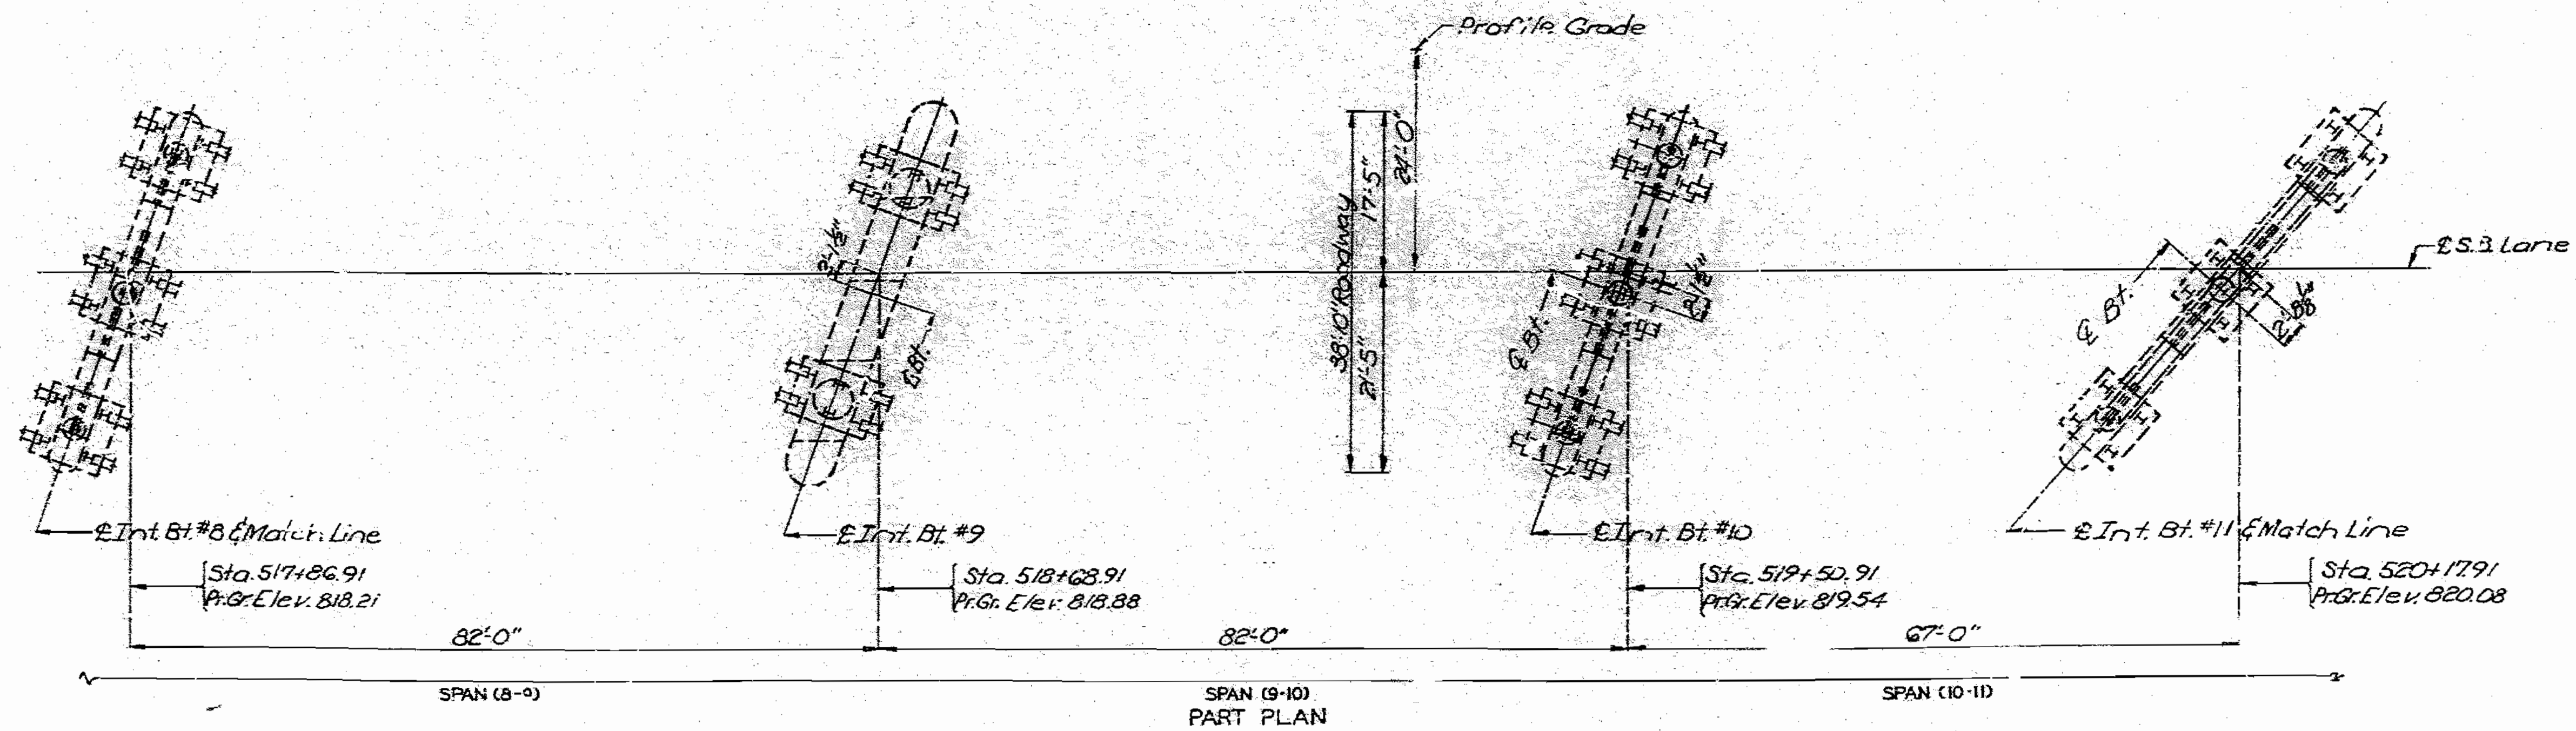

SPAN (9-10)  
PART PLAN

198

DETAILED Sept. 1988  
CHECKED March 1989

Note: This drawing is not to scale. Follow dimensions.


Sheet No. 4A of 98

JACKSON COUNTY


A-2745

STATE	PROJ. NO	SHEET NO.
NO	4-U-71-2E	85

FINAL PLANS

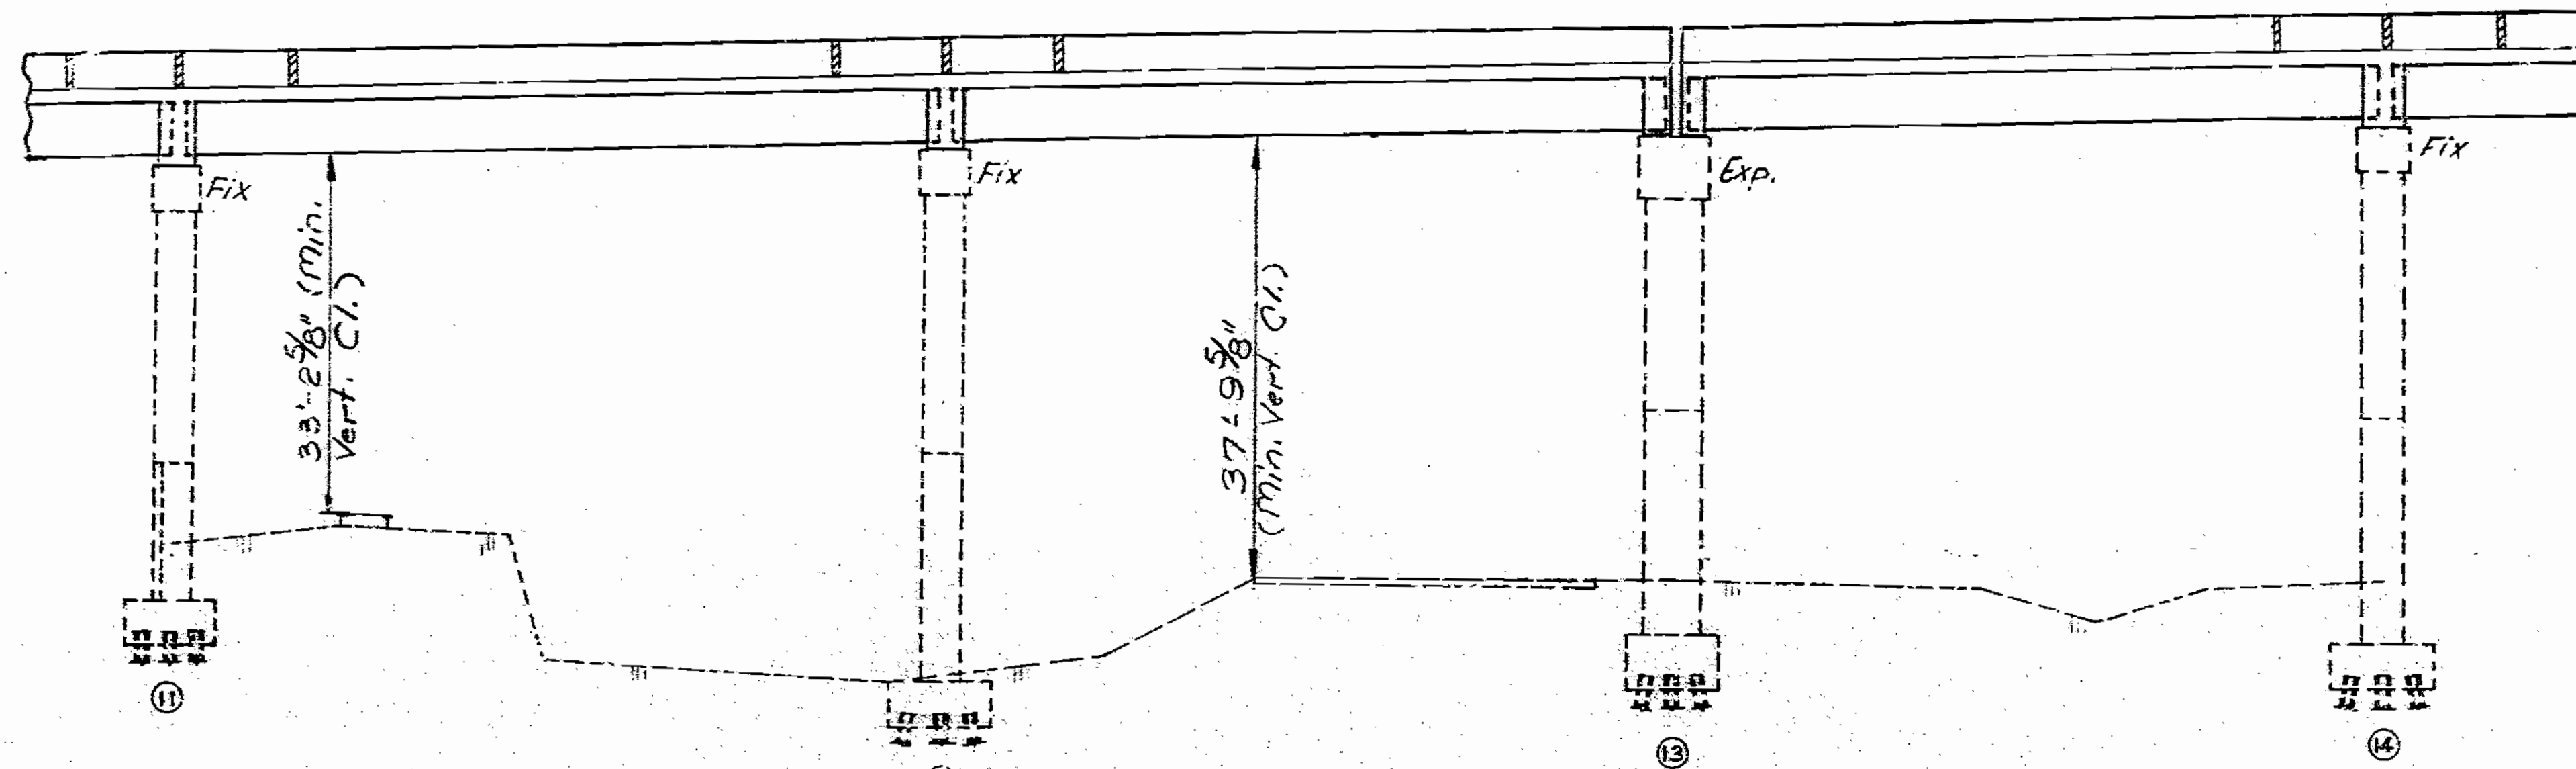

PART GENERAL ELEVATION

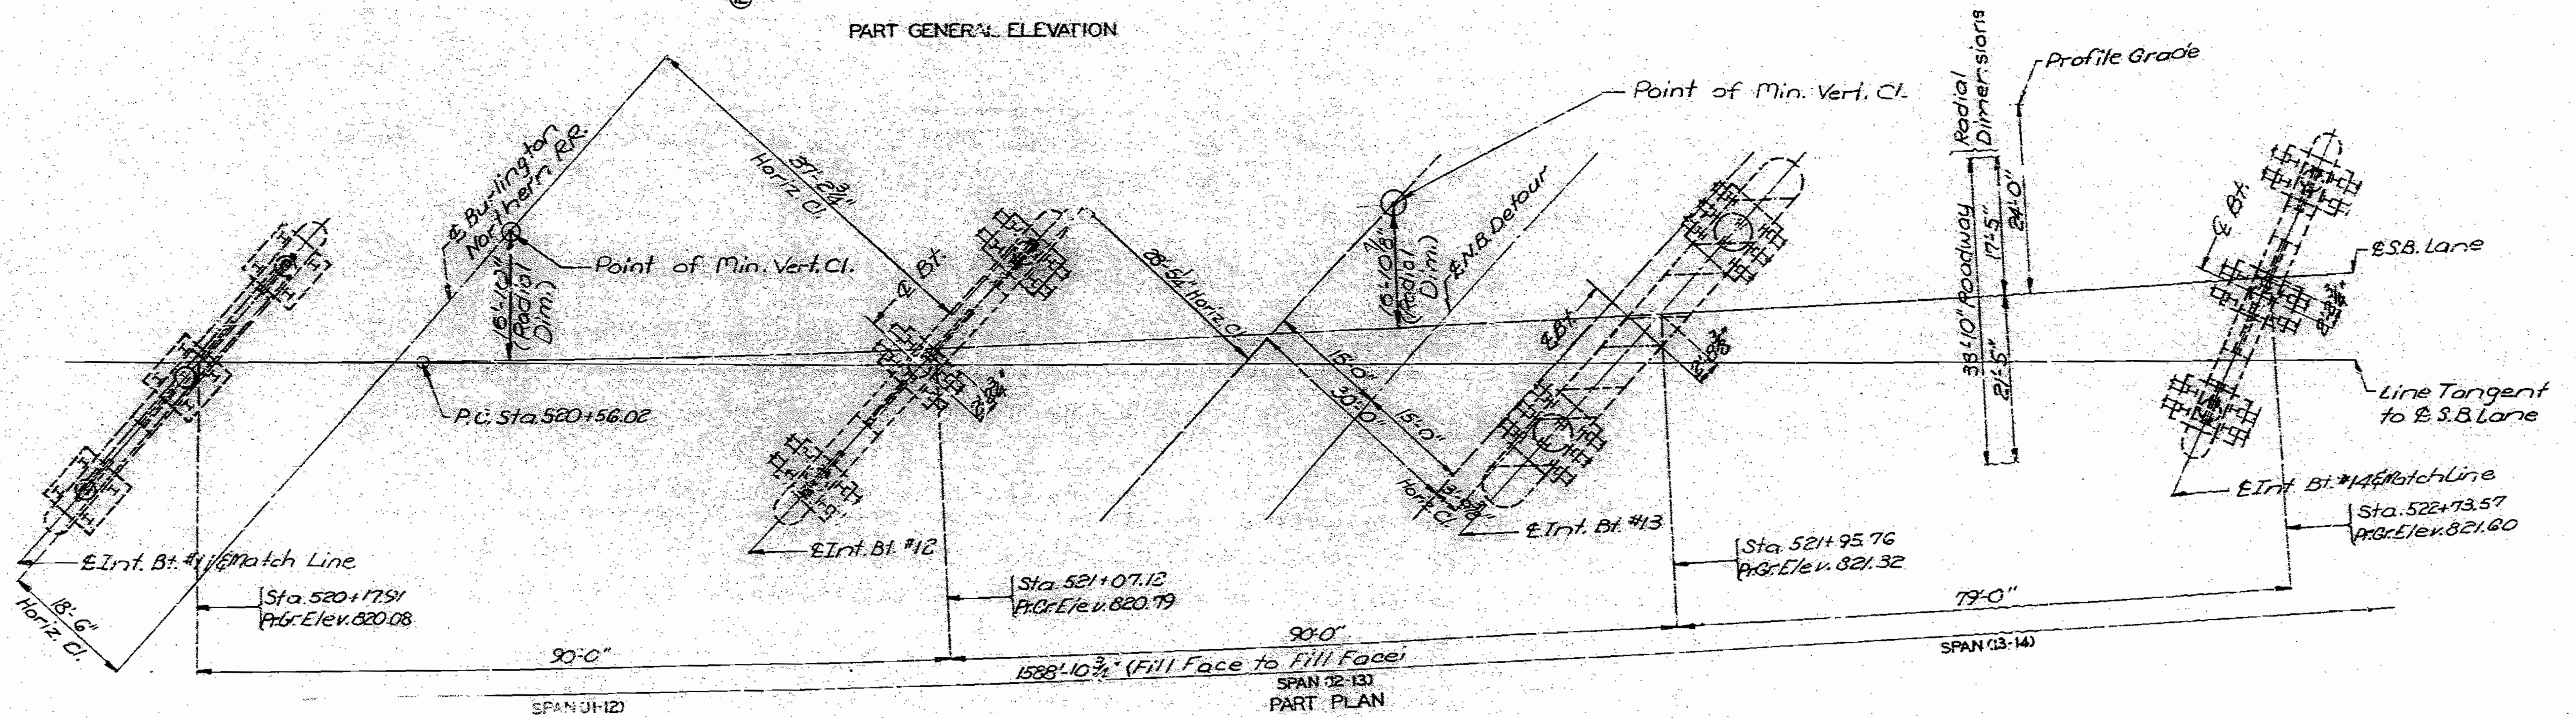

PART PLAN

1989

DETAILED Sept. 1988  
CHECKED March 1989

Note: This drawing is not to scale. Follow dimensions.


Sheet No. 5A of 98

JACKSON COUNTY


A-2745

STATE	PROJ. NO.	SHEET NO.
MO	4-U-71-2E	86

FINAL PLANS

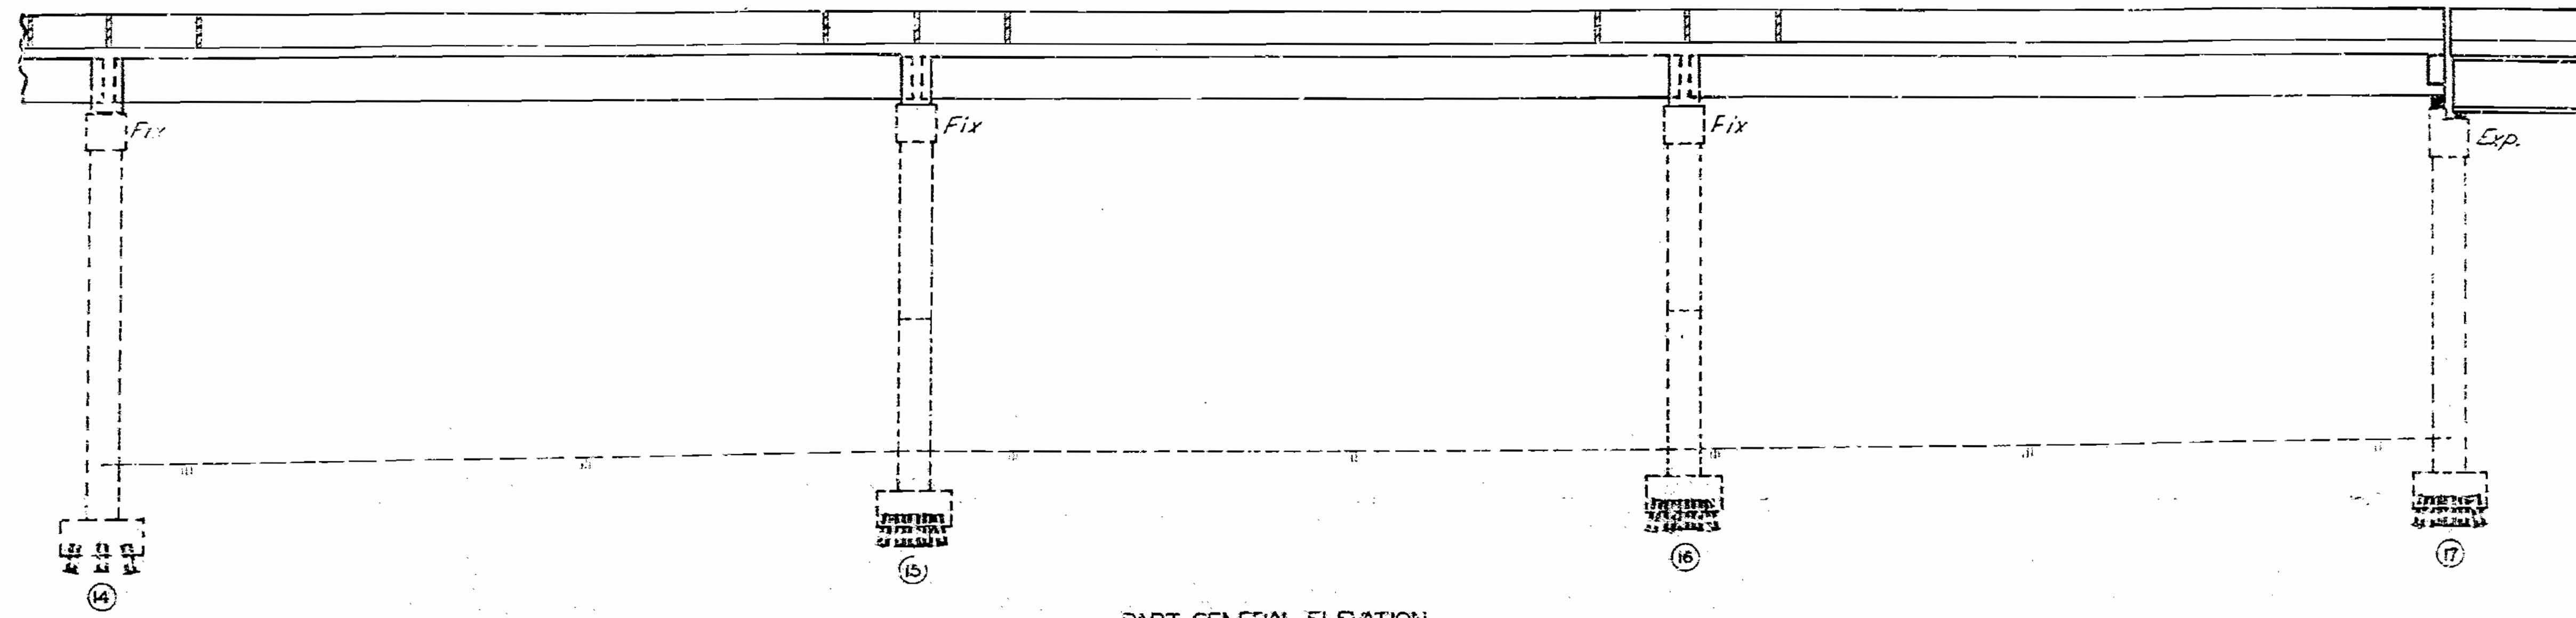

PART GENERAL ELEVATION

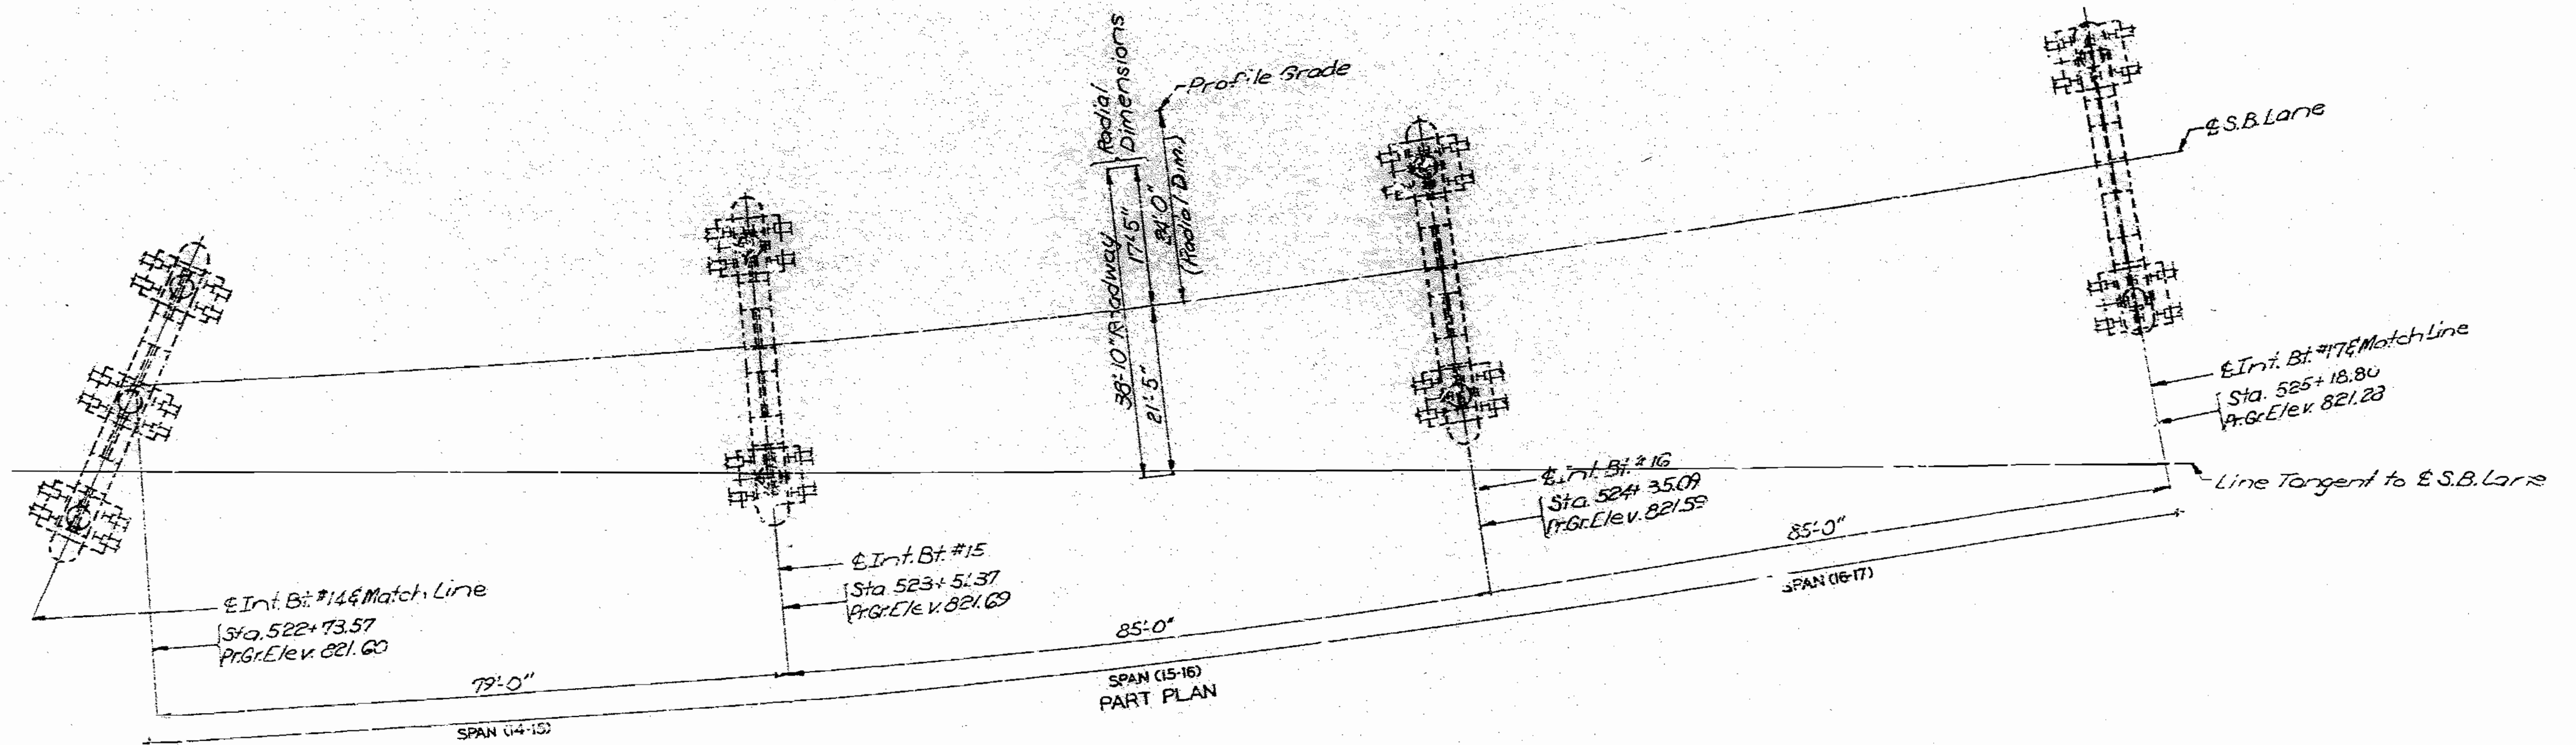

788-200

DETAILED Oct. 1988  
 CHECKED March 1989

Note: This drawing is not to scale. Follow dimensions.


Sheet No. 6A of 95

JACKSON COUNTY


A-2745

STATE	PROJ. NO.	SHEET NO.
MO	A-11-71-2E	87

FINAL PLANS

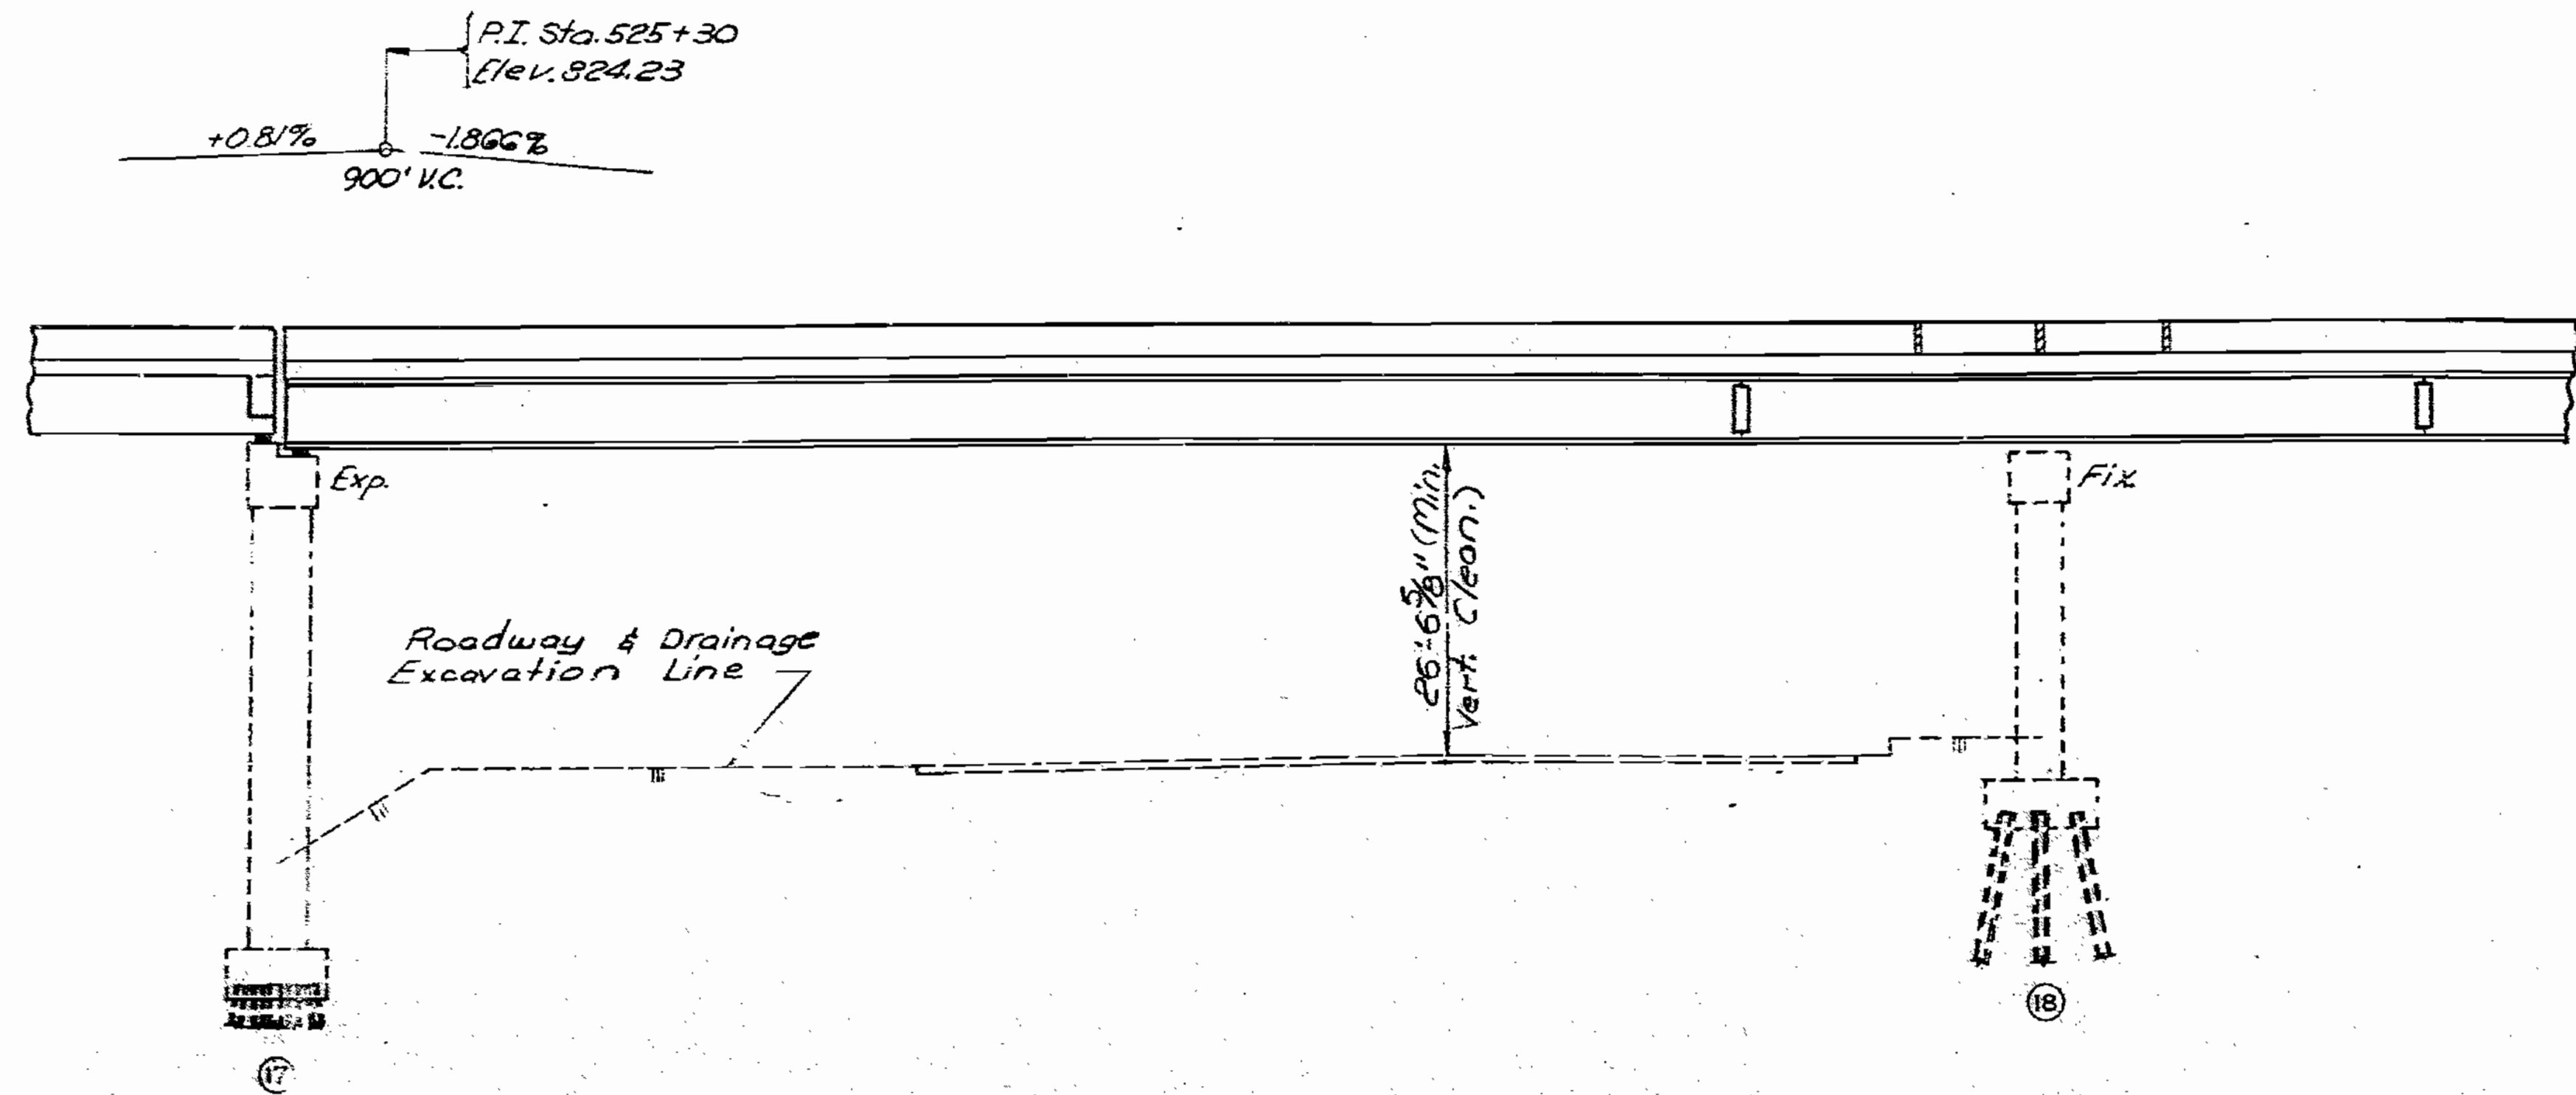

PART GENERAL ELEVATION

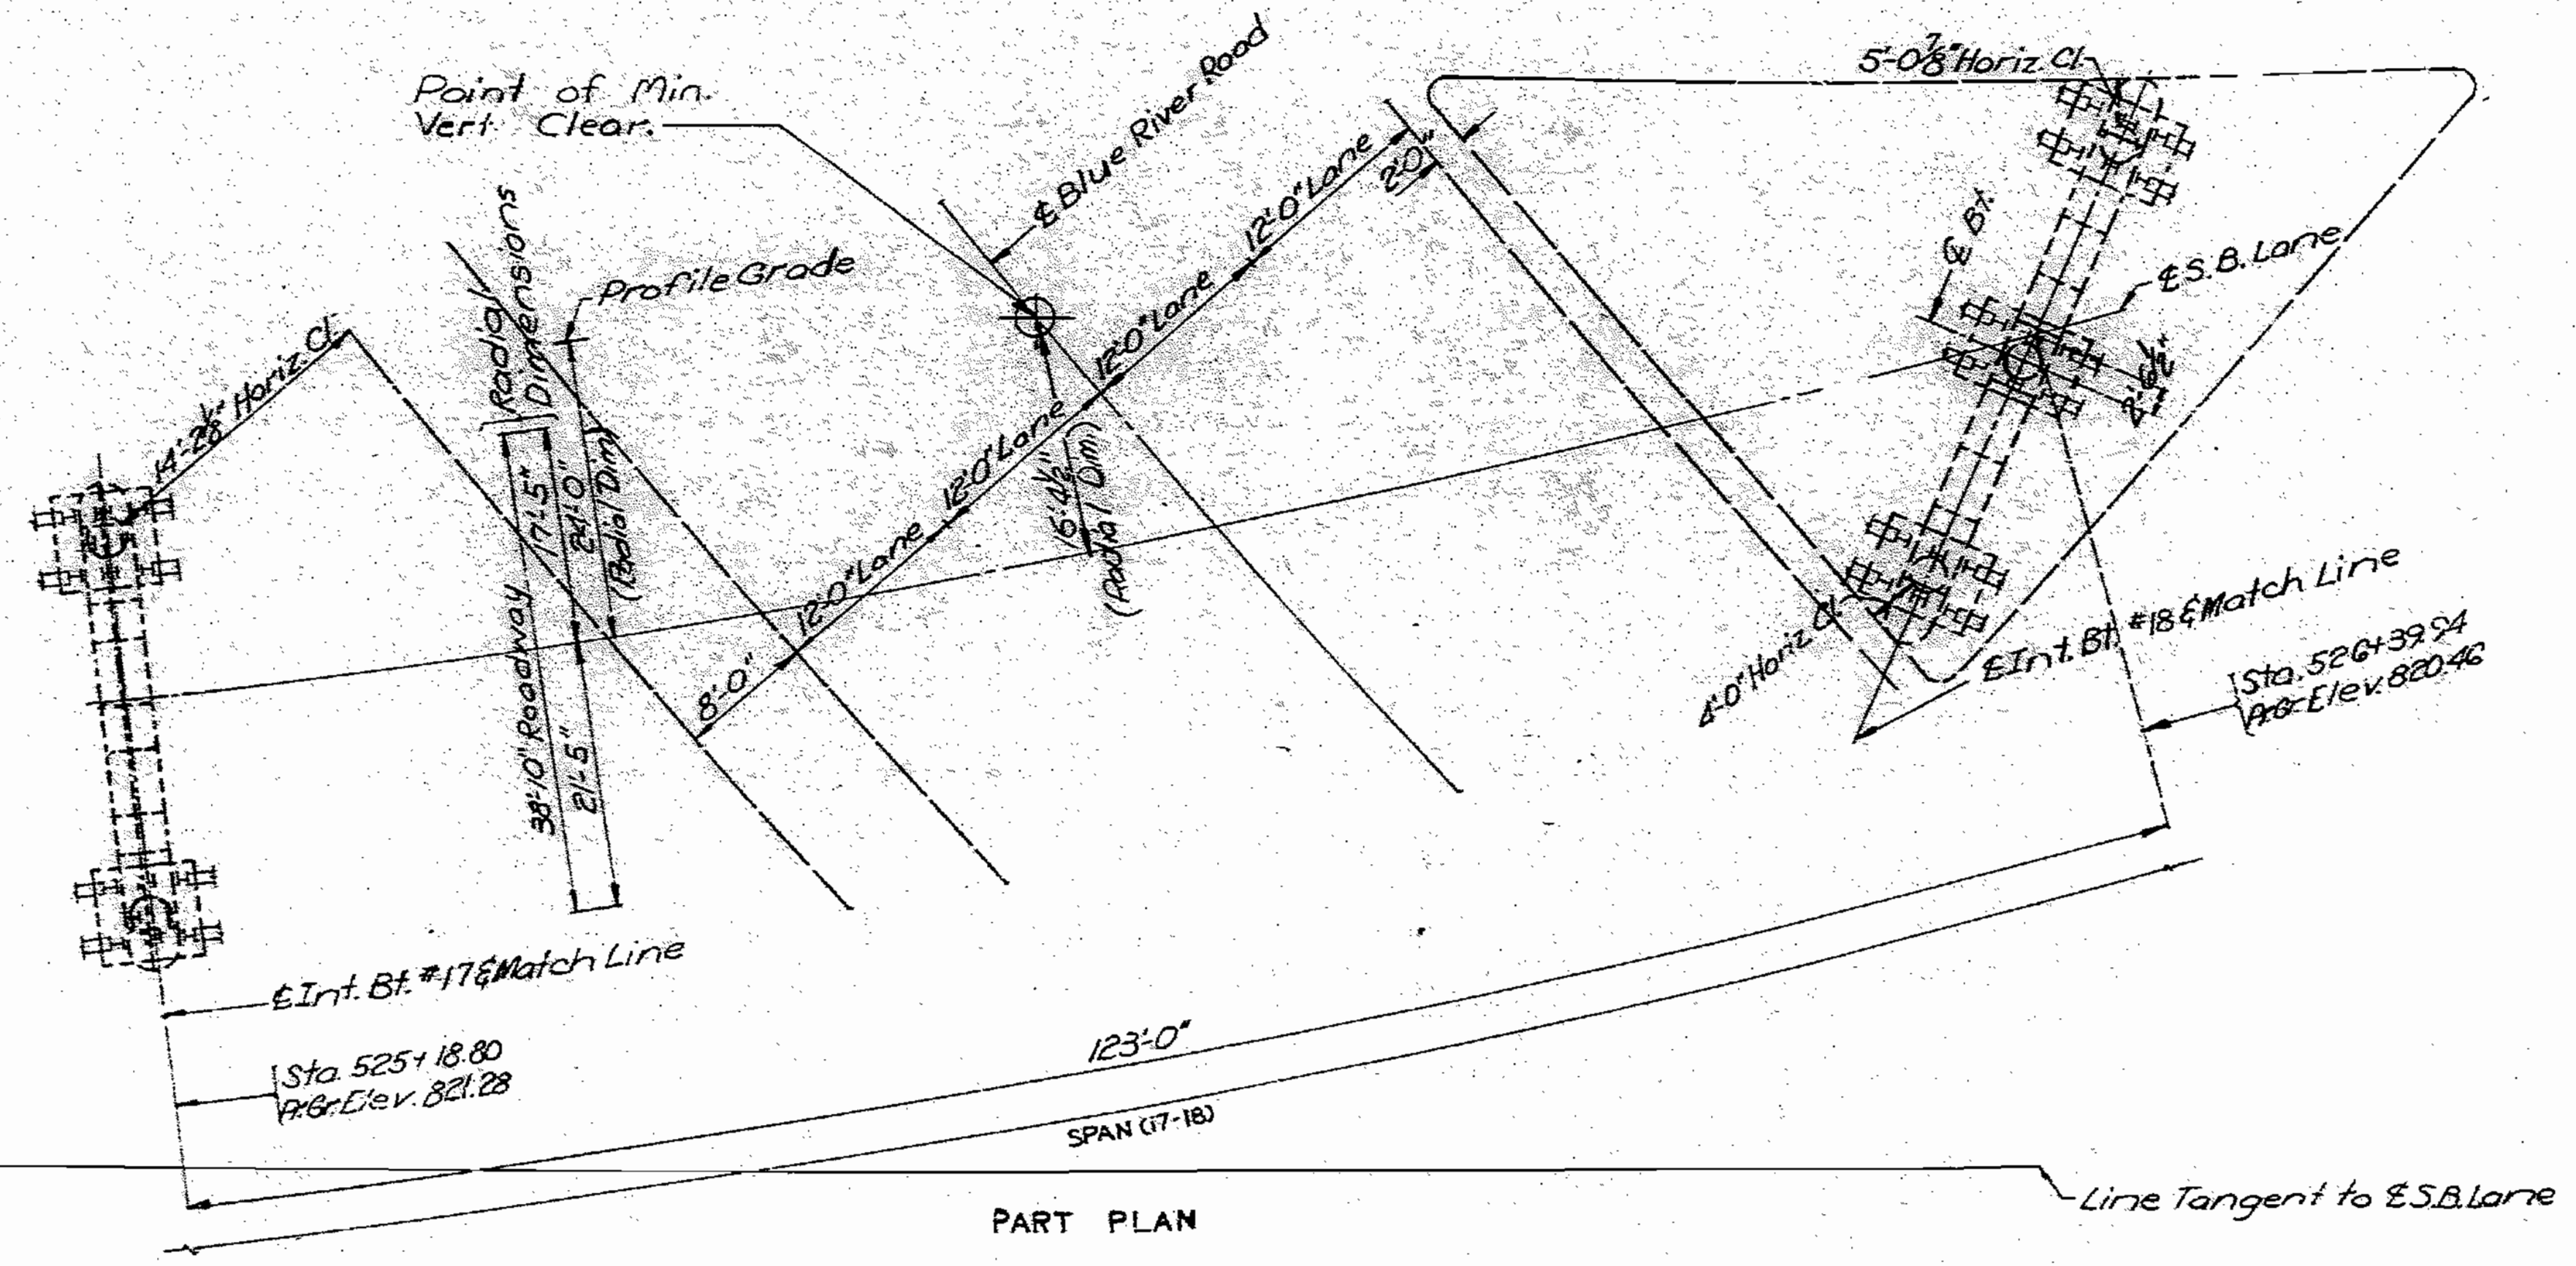

PART PLAN

789 201

DETAILED Oct. 1988  
CHECKED March 1989

Note: This drawing is not to scale. Follow dimensions.



Sheet No. 7A of 98

JACKSON COUNTY

A-2745

STATE	PROJ. NO.	SHEET NO.
MO	4-4-71-2E	88

FINAL PLANS

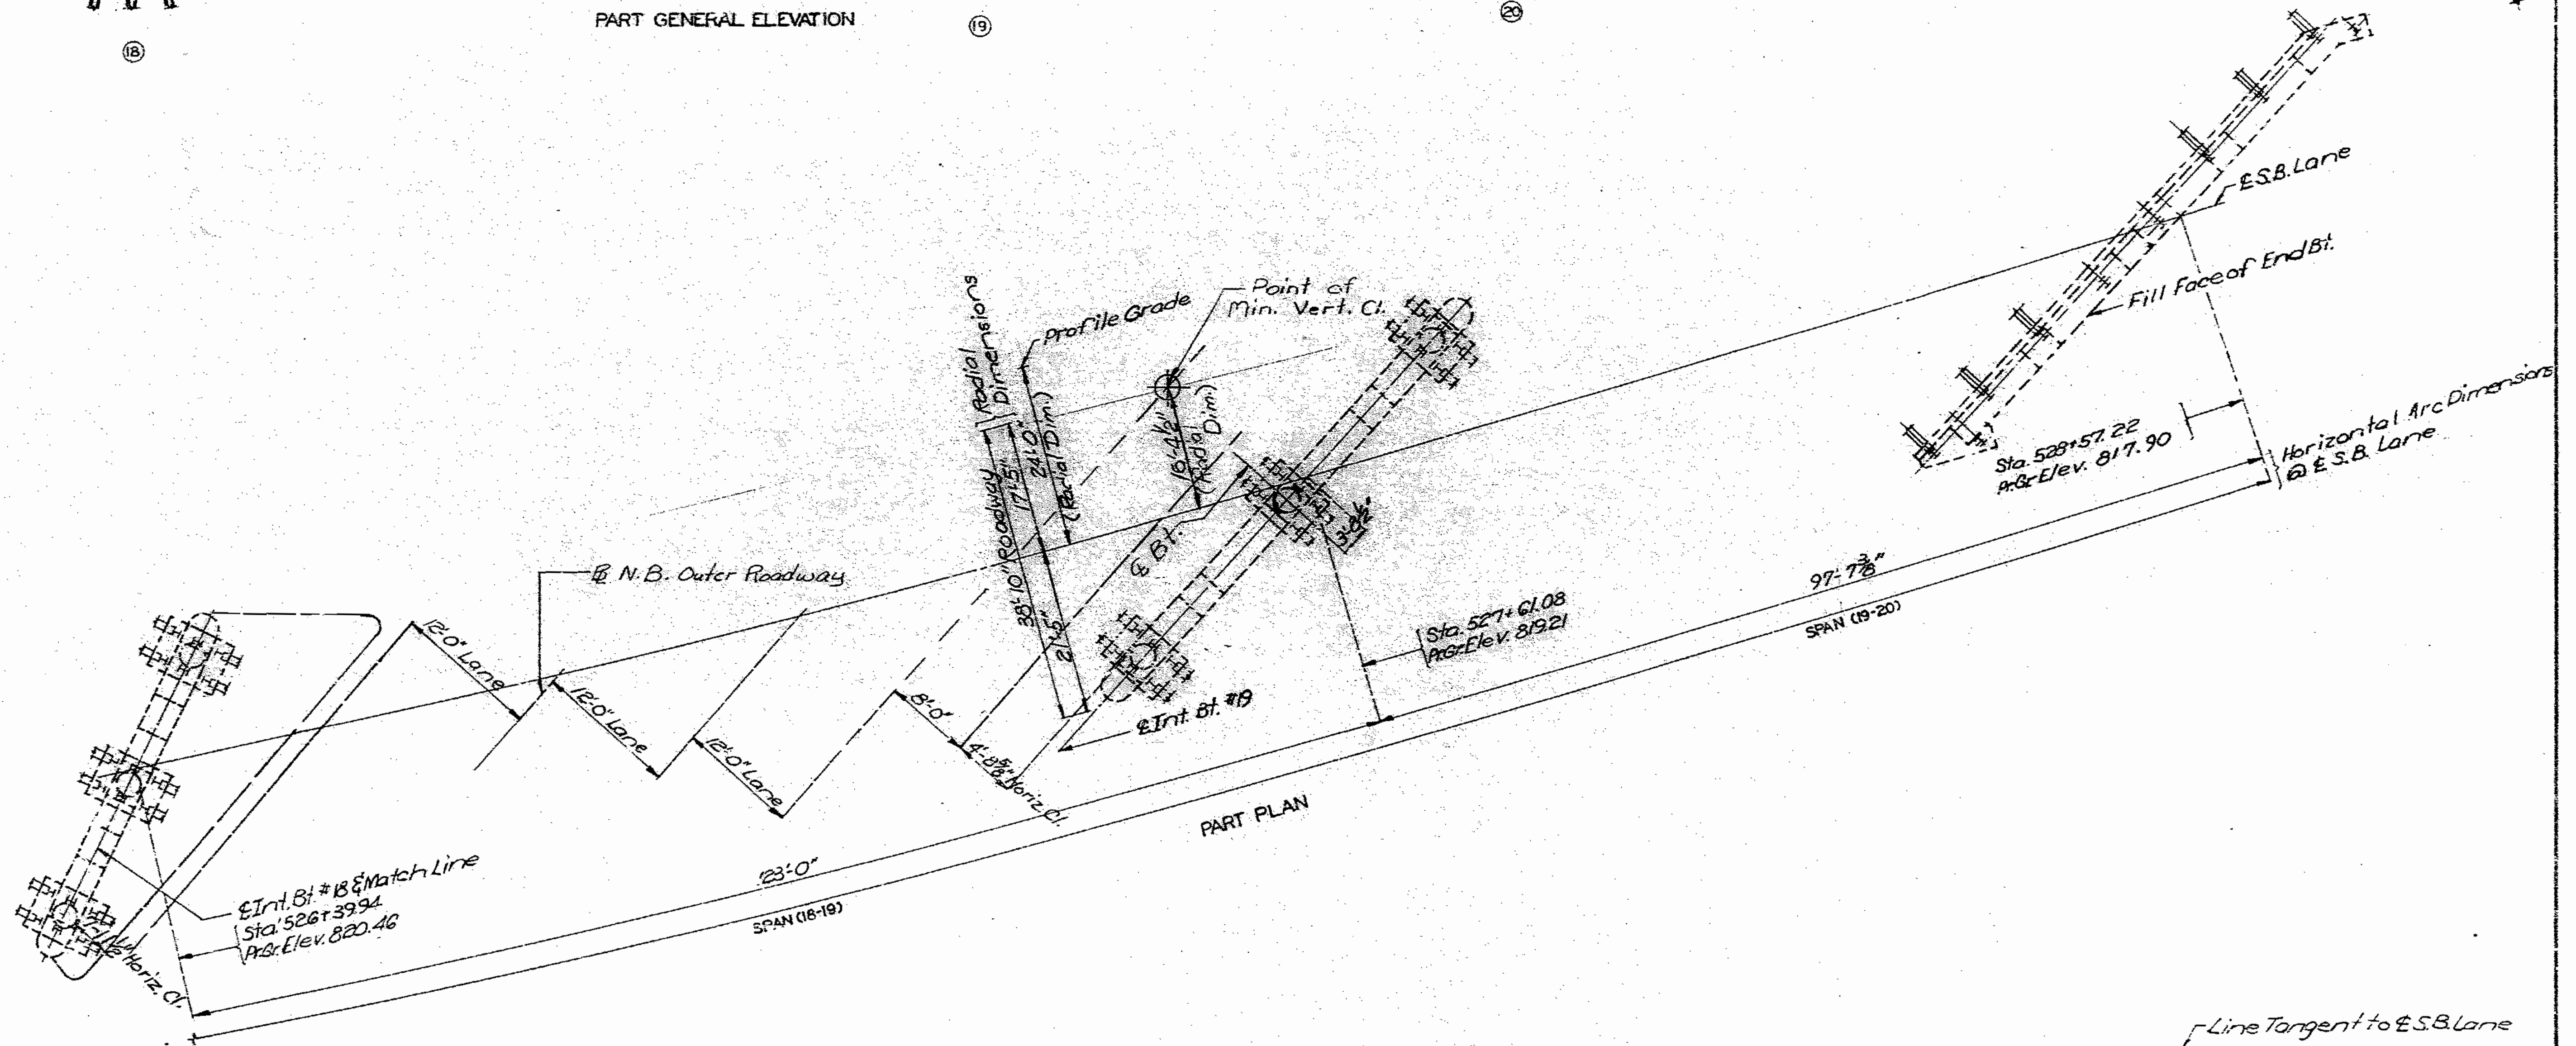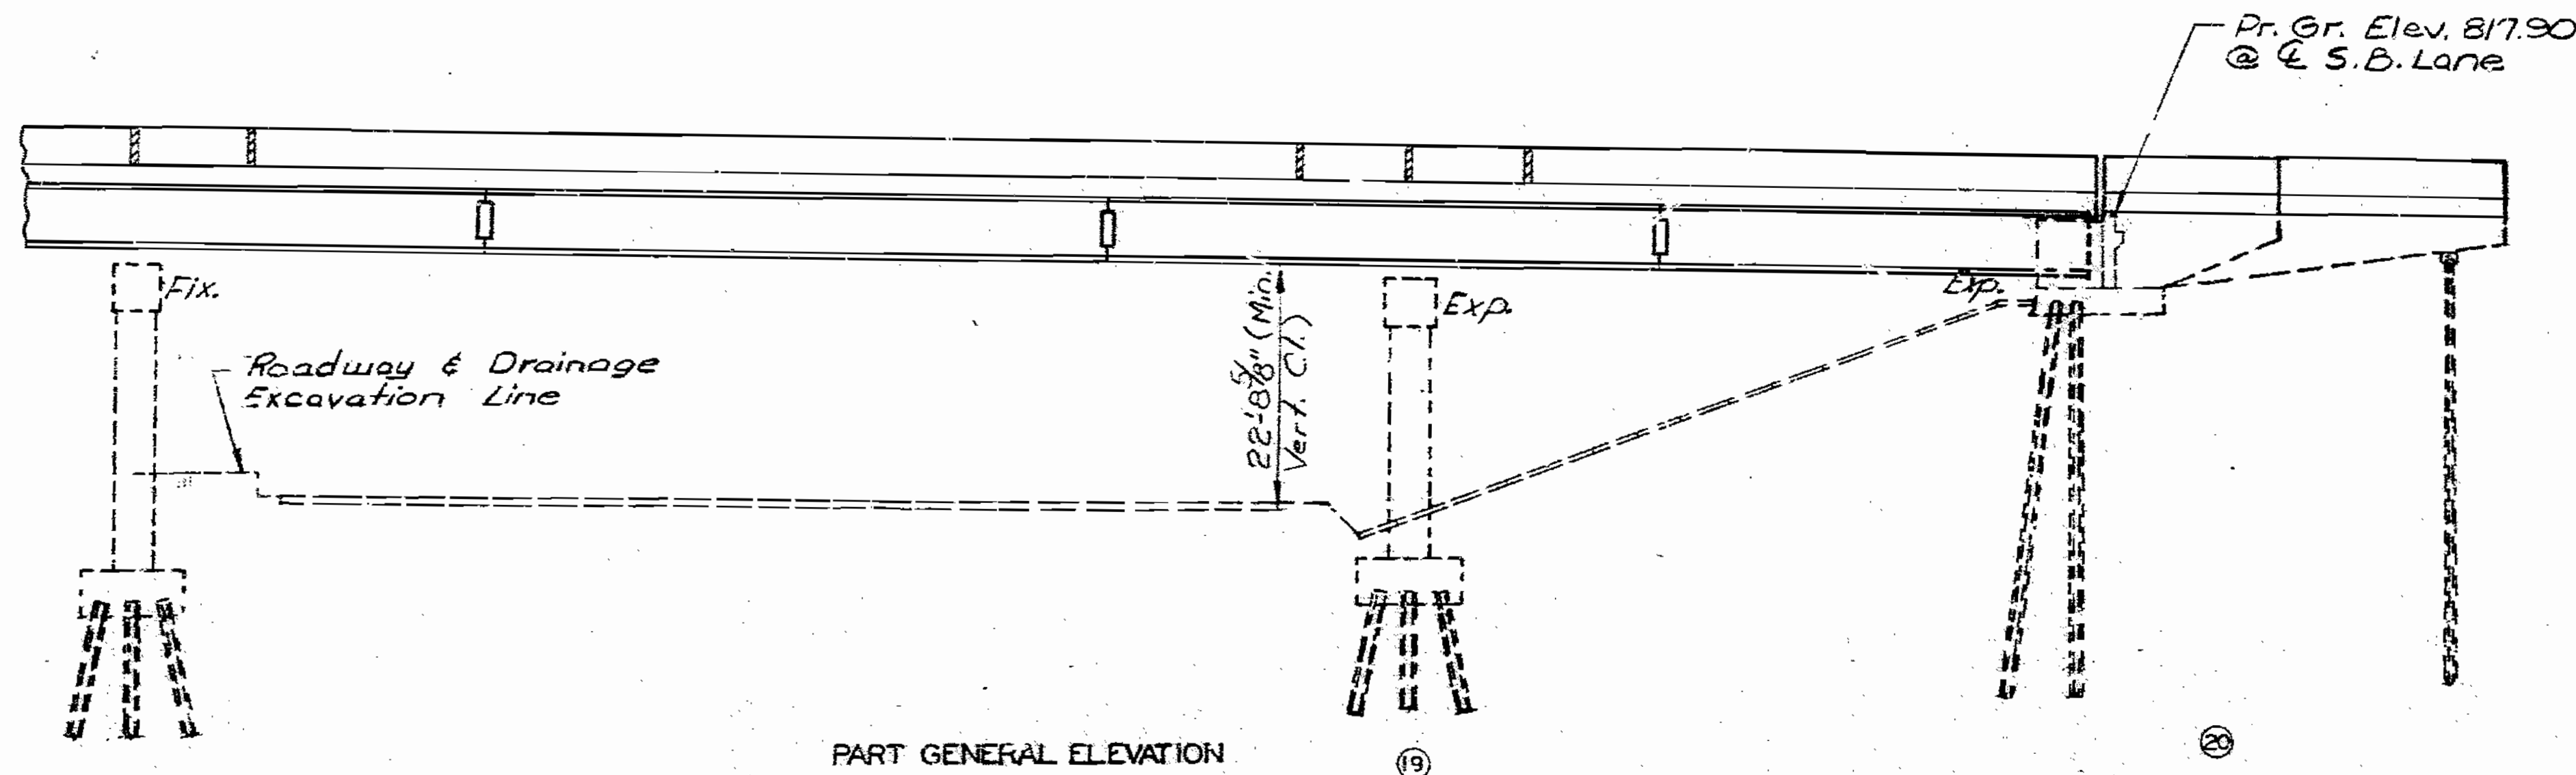

138822

DETAILED Sept 1988  
CHECKED March 1989

Note: This drawing is not to scale. Follow dimensions.

Sheet No. 8A of 98

JACKSON COUNTY A-2745

STATE	PROJ. NO.	SHEET NO.
MO.	4-U-71-2E	89

FINAL PLANS

ESTIMATED QUANTITIES

ITEM		SUPERSTR.	TOTAL
( <del>S.I.P.</del> ) SLAB ON STEEL, SEE SPECIAL PROVISIONS	SQ. YD.	1559	1559
( <del>Precast</del> ) SLAB ON CONCRETE I-GIRDER, SEE SPECIAL PROVISIONS	SQ. YD.	5741	5741
SAFETY BARRIER CURB	LIN. FT.	163	163
LAMINATED NEOPRENE BEARING PADS	EACH	160	160
LAMINATED NEOPRENE BEARING PADS (STEEL STRUCTURE)	EACH	15	15
TYPE N PTFE BEARINGS	EACH	5	5
ELASTOMERIC NEOPRENE EXPANSION JOINT SEAL (3.0 IN.)	LIN. FT.	93	93
ELASTOMERIC NEOPRENE EXPANSION JOINT SEAL (4.0 IN.)	LIN. FT.	156	156
PRESTRESSED CONCRETE I-GIRDER, 64 FT SPAN	EACH	5	5
PRESTRESSED CONCRETE I-GIRDER, 82 FT SPAN	EACH	25	25
PRESTRESSED CONCRETE I-GIRDER, 65 FT SPAN	EACH	15	15
PRESTRESSED CONCRETE I-GIRDER, 67 FT SPAN	EACH	5	5
PRESTRESSED CONCRETE I-GIRDER, 90 FT SPAN	EACH	10	10
PRESTRESSED CONCRETE I-GIRDER, 79 FT SPAN	EACH	10	10
PRESTRESSED CONCRETE I-GIRDER, 85 FT SPAN	EACH	10	10
FABRICATED STRUCTURAL CARBON STEEL (PLATE GIRDERS)	POUND	296,960	296,960
FABRICATED STRUCTURAL LOW ALLOY STEEL (PLATE GIRDERS) A-572	POUND	133,780	133,780
SLAB DRAINS	EACH	95	95
VERTICAL DRAIN AT END BENTS	EACH	2	2
PAINTING (SYSTEM C) GREEN	TON	212.3	212.3
<b>CONTINGENT ITEMS</b>			
<del>Slip Form Barrier Curb</del>	Lin. Ft.	3080	3080
<del>Modify Earthquake Restraint</del>	L.S.	1	1

NOTE: THE COST OF FURNISHING, FABRICATING AND INSTALLING NEOPRENE BEARING PADS, COMPLETE-IN-PLACE, WILL BE PAID FOR AT THE CONTRACT UNIT PRICE FOR LAMINATED NEOPRENE BEARING PADS PER EACH.

NOTE: THE PRESTRESSED PANEL QUANTITIES ARE NOT INCLUDED IN THE TABLE OF ESTIMATED QUANTITIES FOR ALTERNATE SLABS.

TYPE OF SLABS	SLAB ON STEEL		SLAB ON CONC. I-GDR.		
	REINF. (LBS.)	CONC. (CU. YD.)	REINF. (LBS.)	CONC. (CU. YD.)	CONC. (CU. YD.)
	EPOXY		PLAIN	EPOXY	
CAST-IN-PLACE CONVENTIONAL FORMS	100,130	391.7	10,460	356,790	1,689.0
PRECAST PANEL FORMS			10,460	290,490	*** 1,363.0
STAY-IN-PLACE FORMS	100,130	* 395.0			

NOTE: THE TABLE OF ESTIMATED QUANTITIES FOR ALTERNATE SLABS REPRESENTS THE QUANTITIES USED BY THE STATE IN PREPARING THE COST ESTIMATE FOR CONCRETE SLABS. VARIATIONS MAY BE ENCOUNTERED IN THESE ESTIMATED QUANTITIES BUT THESE VARIATIONS CANNOT BE USED FOR AN ADJUSTMENT IN THE CONTRACT UNIT PRICE PER SQUARE YARD OF ALTERNATE SLAB USED.

SEE SPECIAL PROVISIONS FOR ALTERNATE METHODS OF FORMING SLABS.

PRECAST PANEL QUANTITIES ARE BASED ON SKEWED END PANELS.

\* DOES NOT INCLUDE CONCRETE REQUIRED TO FILL CORRUGATIONS OF S.I.P. FORMS.

\*\*\* BASED ON MINIMUM TOP FLANGE THICKNESS AND MINIMUM JOINT FILLER THICKNESS.

NOTE: CONCRETE AND REINFORCEMENT IN ESTIMATED QUANTITIES FOR "SLAB ON STEEL" INCLUDES CONCRETE AND REINFORCING IN BACKWALL ABOVE UPPER CONST. JOINT, AT END BENT NO. 20.

GENERAL NOTES:

DESIGN SPECIFICATIONS: A.A.S.H.T.O.-1980 AND INTERIMS THRU 1988  
LOAD FACTOR DESIGN

DESIGN LOADING: HS20-44

35#/SQ. FT. FUTURE WEARING SURFACE  
MODIFIED 24,000# TANDEM AXLE  
EARTH 120#/CU. FT., EQUIVALENT FLUID PRESSURE 45#/CU. FT.  
FATIGUE STRESS - CASE II (SPAN 17 THRU 19)

DESIGN UNIT STRESSES:

CLASS B2 CONCRETE (SUPERSTRUCTURE, EXCEPT PRESTRESSED GDERS. AND SAFETY BARRIER CURB) F'C=4,000 PSI  
CLASS B1 CONCRETE (SAFETY BARRIER CURB) F'C=4,000 PSI  
REINFORCING STEEL (GRADE 60) FY=60,000 PSI  
STRUCTURAL CARBON STEEL FY=36,000 PSI  
STRUCTURAL STEEL (A.S.T.M. A572) GRADE 50 FY=50,000 PSI

FABRICATED STEEL CONNECTIONS:

FIELD CONNECTIONS, HIGH STRENGTH BOLTS 3/4"Ø, HOLES 13/16"Ø, EXCEPT AS NOTED.

JOINT FILLER:

ALL JOINT FILLER SHALL MEET THE REQUIREMENTS OF STD. SPEC. 1057.2.4, EXCEPT AS NOTED.

REINFORCING STEEL:

MINIMUM CLEARANCE TO REINFORCING STEEL SHALL BE 1-1/2", UNLESS OTHERWISE SHOWN.

PAINT:

SYSTEM C BY CONTRACTOR IN ACCORDANCE WITH STD. SPEC. 712.12. (COLOR OF THE FINAL FIELD COAT SHALL BE GREEN.)

PRESTRESSED GIRDER STRESSES:

FOR PRESTRESSED GIRDER STRESSES SEE SHEET NO. 27 THRU 54.

CONSTRUCTION CLEARANCE:

MANCH. HWY.: A MINIMUM VERT. CLEARANCE OF 14'-6" FROM CROWN OF EXISTING LANES AND A MINIMUM LATERAL CLEARANCE OF 52'-0" CENTERED ON EXISTING LANES SHALL BE MAINTAINED DURING CONSTRUCTION.

N.B. RTE. 71 DETOUR: A MINIMUM VERT. CLEARANCE OF 14'-6" FROM CROWN OF EXISTING LANES AND A MINIMUM LATERAL CLEARANCE OF 34'-0" CENTERED ON LANES.

BLUE RIVER RD.: A MINIMUM VERT. CLEARANCE OF 14'-6" FROM CROWN OF EXISTING LANES AND A MINIMUM LATERAL CLEARANCE OF 52'-0" CENTERED ON LANES.

NORTH OUTER ROAD: A MINIMUM VERT. CLEARANCE OF 14'-6" FROM CROWN OF EXISTING LANES AND A MINIMUM LATERAL CLEARANCE OF 2'-0" FROM PAVT. EDGE (EACH SIDE).

BURLINGTON NORTHERN R.R. MINIMUM LATERAL CLEARANCE OF 12'-0" FROM @ TRACKS, SHALL BE IN ACCORDANCE WITH THE R.R. CONTRACT.


NEOPRENE PADS:

LAMINATED NEOPRENE BEARINGS SHALL BE 60 DUROMETER NEOPRENE PADS.





NOTE:

OUTLINE OF OLD WORK IS INDICATED BY LIGHT DASHED LINES.  
HEAVY LINES INDICATE NEW WORK.

131203

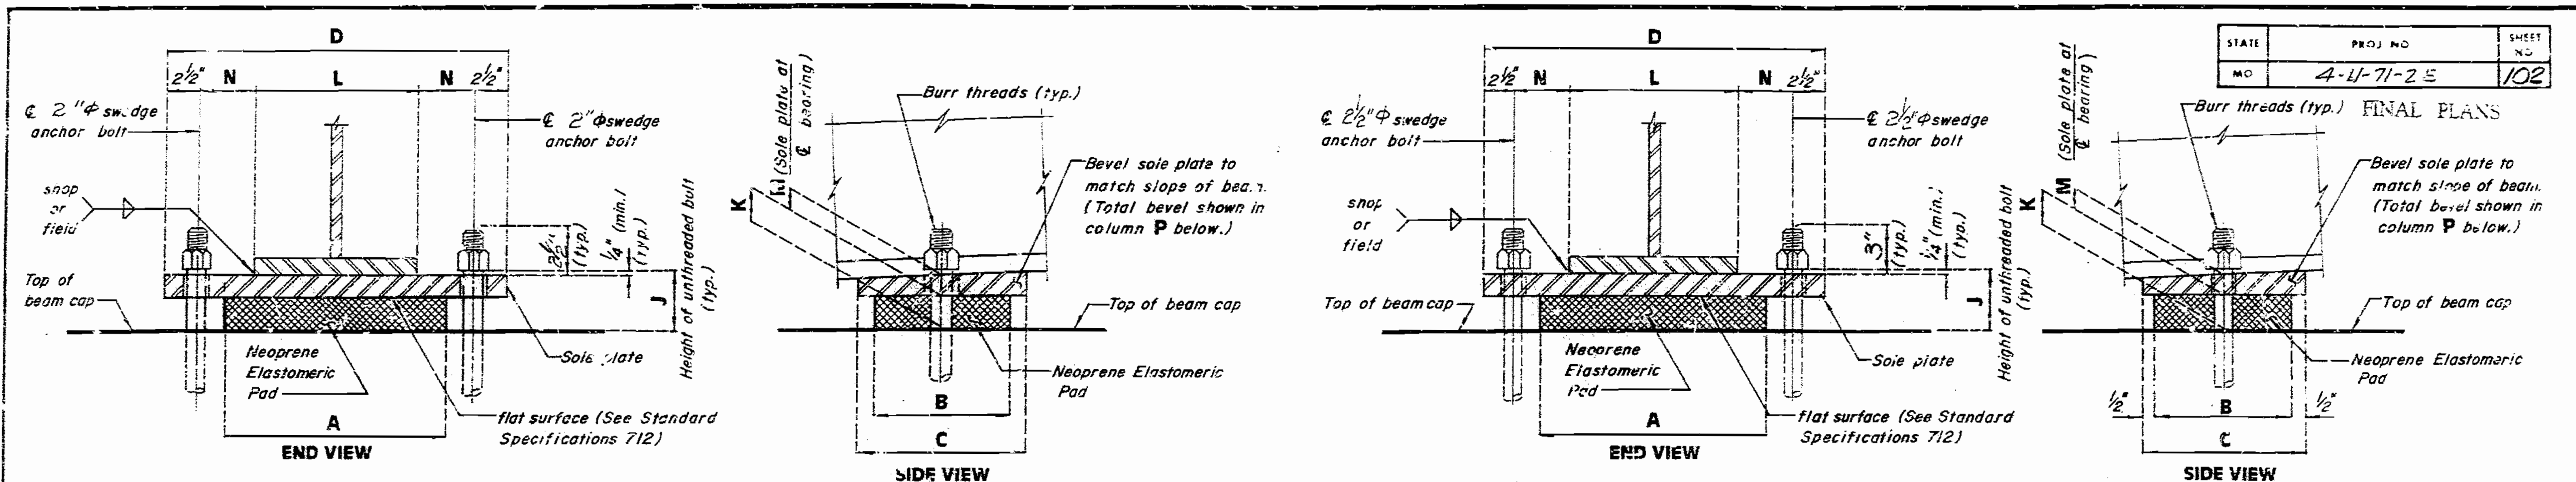

Note: The location of anchor bolts in relation to the slotted holes in the sole plate shall correspond with the temperature at the time of erection. At 60° F. the slotted holes should center on the anchor bolts.

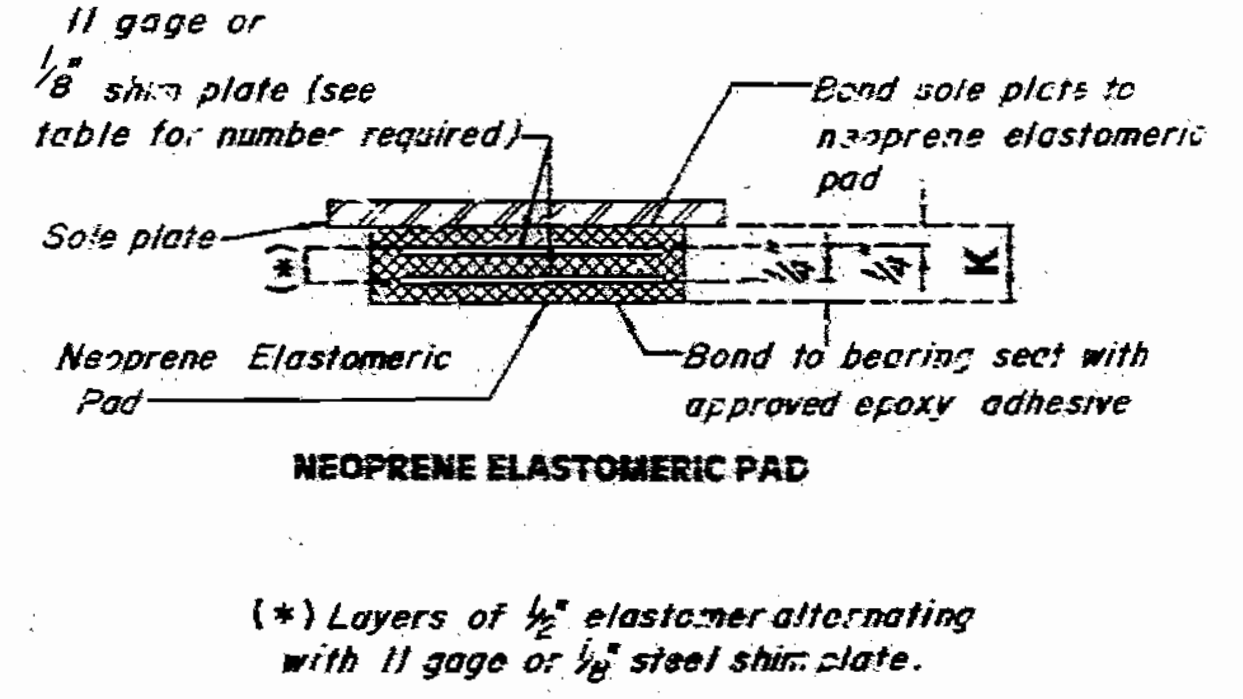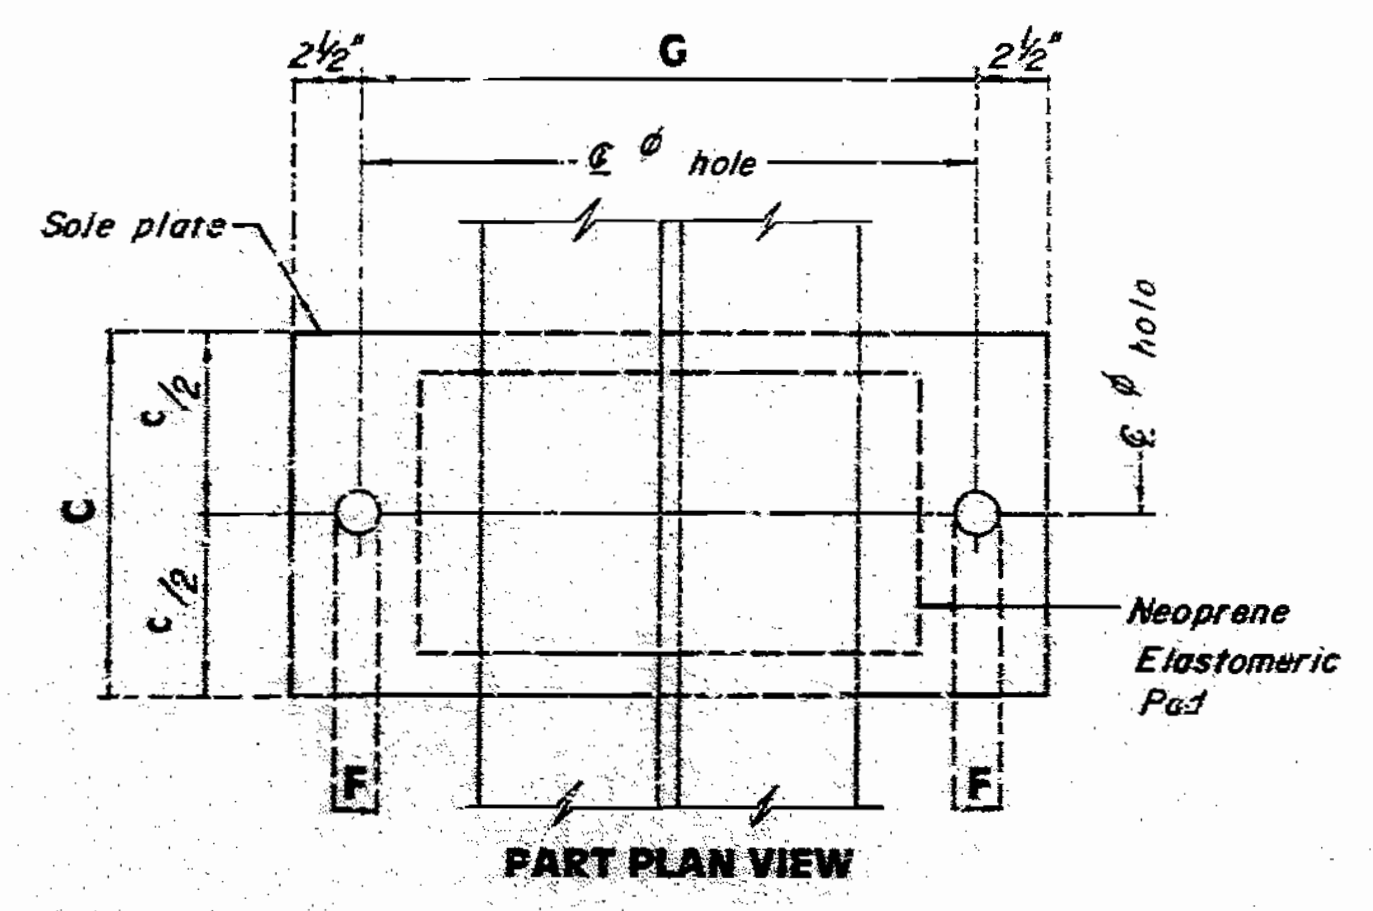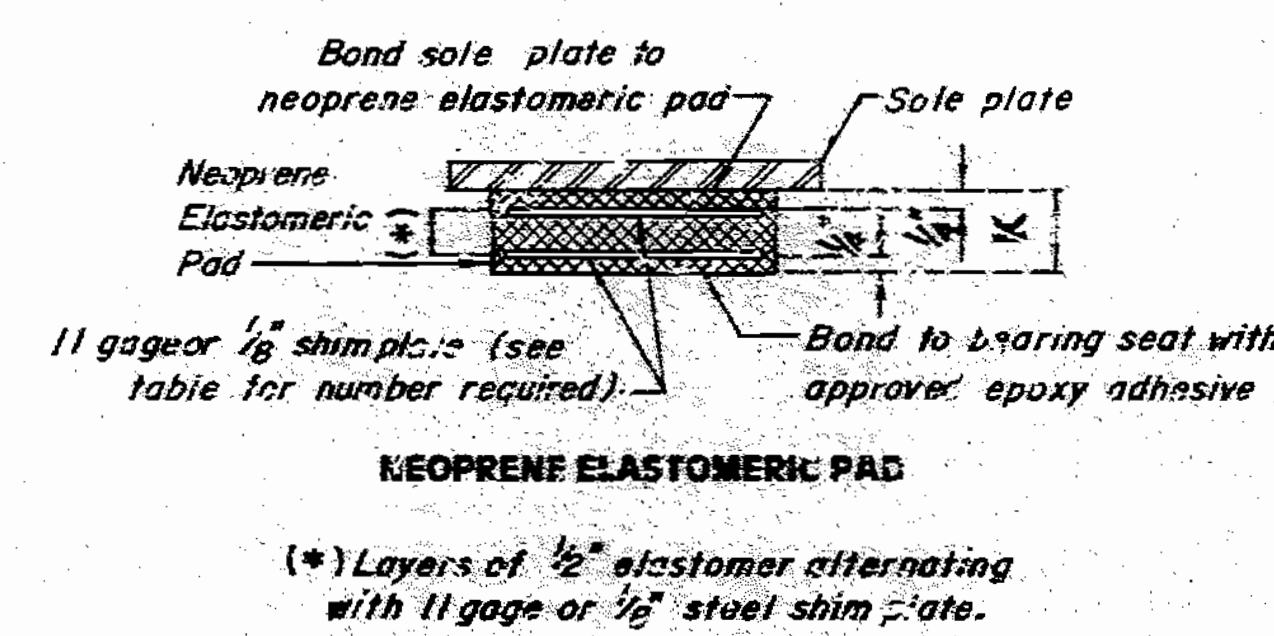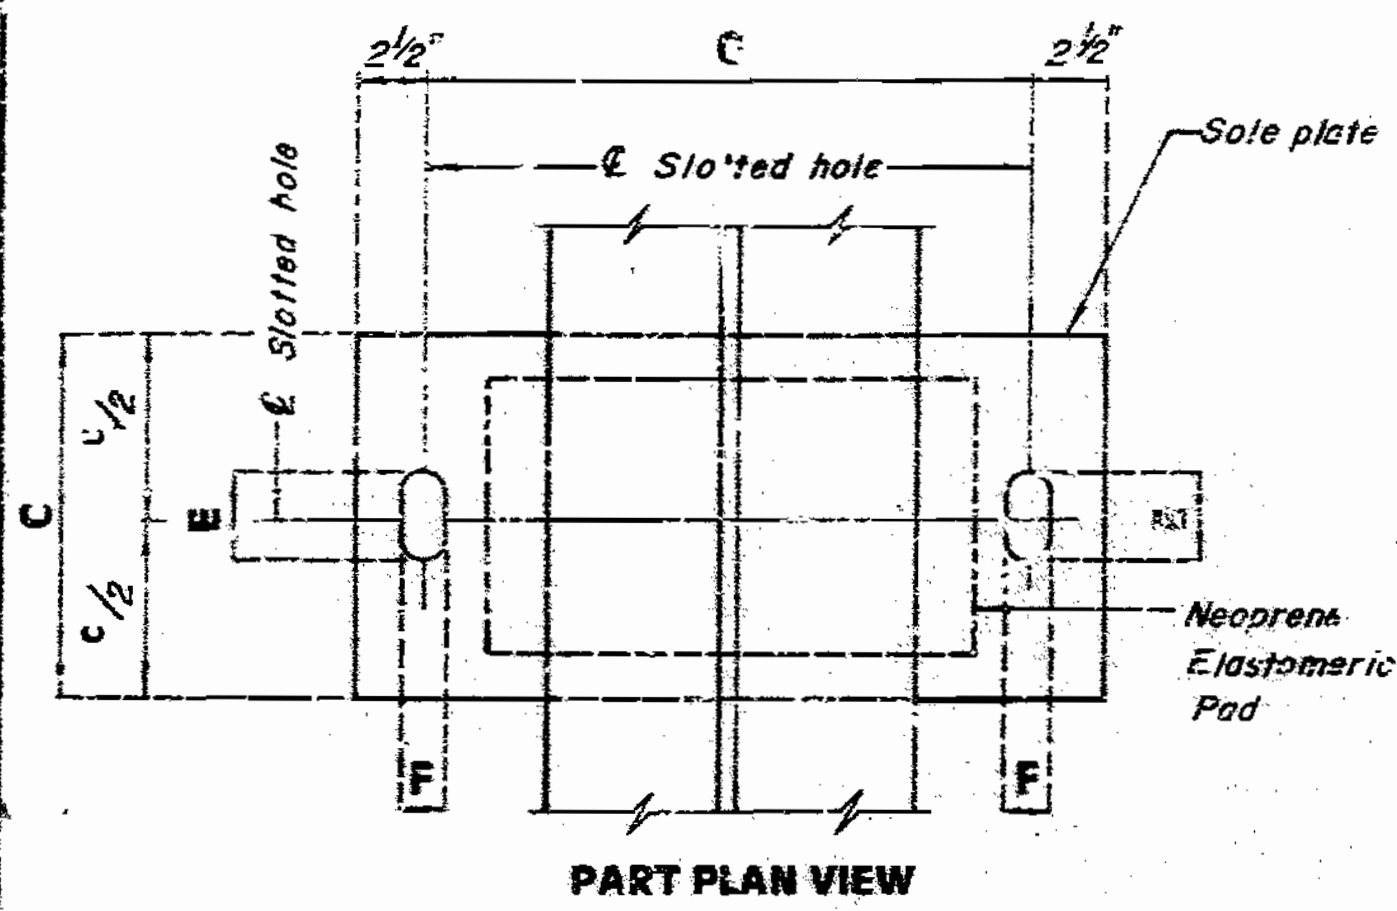

**EXPANSION BEARINGS**

NUMBER REQUIRED = 5 @ Bent No. 17 (Span 17-18)  
5 @ Bent No. 19

- ⑤ Girders No. 1, 2 & 3 = 17"
- Girder No. 4 = 16"
- Girder No. 5 = 14"

- ⑥ Girders No. 1, 2 & 3 = 2 1/2"
- Girder No. 4 = 3"
- Girder No. 5 = 1"

\*\* 18" @ Bts. No. 17 & 19  
25" @ Bt. No. 18  
\*\*\* 2" φ @ Bts. No. 17 & 19  
2 1/2" φ @ Bt. No. 18

**FIXED BEARINGS**

NUMBER REQUIRED = 5 @ Bent No. 18

BENT NO.	A	B	C	D	E	F	G	J	K	L	M	N	P	NUMBER OF SHIM PLATES (*)
19	17"	28"	23"	27"	5"	2 1/8"	22"	5 1/8"	3 3/4"	③	1 1/8"	④	3 1/8"	6
17	18"	12"	13"	27"	5"	2 1/8"	22"	5 1/8"	3 3/4"	⑤	1 1/8"	⑥	-	8

(\*) THE REQUIRED SHIM PLATE SHALL BE PLACED BETWEEN LAYERS OF ELASTOMER AND MOLDED TOGETHER TO FORM AN INTEGRAL UNIT.  
\*\*\* Span (17-18)  
1 1/2" GDR. #2, 4 #3  
1 1/8" SDR. #4, 5

- ④ Girder No. 1 = 2 1/2"
- Girder No. 2 = 3"
- Girders No. 3, 4 & 5 = 3 1/2"

- ③ Girder No. 1 = 17"
- Girder No. 2 = 16"
- Girders No. 3, 4 & 5 = 15"

**GENERAL NOTES:**

ANCHOR BOLTS SHALL BE \*\*\* A588 STEEL SWEDGED BOLTS AND SHALL EXTEND \*\*\* INTO THE CONCRETE WITH A194 - 2, 2H OR A563 - C, C3, D, CH, DI IS HEAVY HEXAGON NUTS. ACTUAL MANUFACTURERS CERTIFIED MILL TEST REPORTS (CHEMICAL AND MECHANICAL) SHALL BE PROVIDED. (SWEDGING SHALL BE 1" LESS THAN EXTENSION INTO THE CONCRETE.)  
ALL STRUCTURAL STEEL FOR THE SOLE PLATE, ANCHOR BOLTS AND HEAVY HEXAGON NUTS SHALL BE PAINTED WITH 2 COATS (5 MILS MIN) OF INORGANIC ZINC WELD AREAS TO BE TOUCHED UP AFTER ASSEMBLY.  
WEIGHT OF ANCHOR BOLTS AND HEAVY HEXAGON NUTS FOR BEARINGS SHALL BE INCLUDED IN WEIGHT OF THE FABRICATED STRUCTURAL STEEL.  
NEOPRENE ELASTOMERIC PADS SHALL BE CALIBRATED.  
THE SOLE PLATE SHALL BE FURNISHED WITH THE BEARING AND FIELD OR SHOP WELDED TO THE STRINGERS OR GIRDERS.  
STRUCTURAL STEEL FOR SOLE PLATE SHALL BE A-36.  
PAYMENT FOR THE SOLE PLATE WILL BE INCLUDED IN THE COST OF THE BEARING ASSEMBLY. SEE SPECIAL PROVISIONS.  
THE ACCEPTED QUANTITY OF ELASTOMERIC BEARING ASSEMBLIES, COMPLETE-IN-PLACE, WILL BE PAID FOR AT THE CONTRACT UNIT PRICE FOR LAMINATED NEOPRENE BEARING PADS (STEEL STRUCTURES), EACH.

BENT NO.	A	B	C	D	F	G	J	K	L	M	N	P	NUMBER OF SHIM PLATES (*)
18	20"	34"	35"	31"	2 3/8"	20"	5 7/8"	3 3/4"	①	1 3/8"	②	1/4"	6

(\*) THE REQUIRED SHIM PLATE SHALL BE PLACED BETWEEN LAYERS OF ELASTOMER AND MOLDED TOGETHER TO FORM AN INTEGRAL UNIT.

- ① Girders No. 1 & 2 = 20"
- Girders No. 3, 4 & 5 = 19"

- ② Girders No. 1 & 2 = 3"
- Girders No. 3, 4 & 5 = 3 1/2"

**DETAILS OF LAMINATED NEOPRENE BEARINGS (STEEL STRUCTURES)**

Note: This drawing is not to scale. Follow dimensions. Revised 12-7-89



Sheet No. 22 of 23

144204  
 REVISED OCT. 1987  
 LAM. NEOP. BRGS. MARCH 1979



DETAILED June 1988  
CHECKED Feb. 1989



STATE	PROJ NO	SHEET NO
MO	4-L-71-2E	103

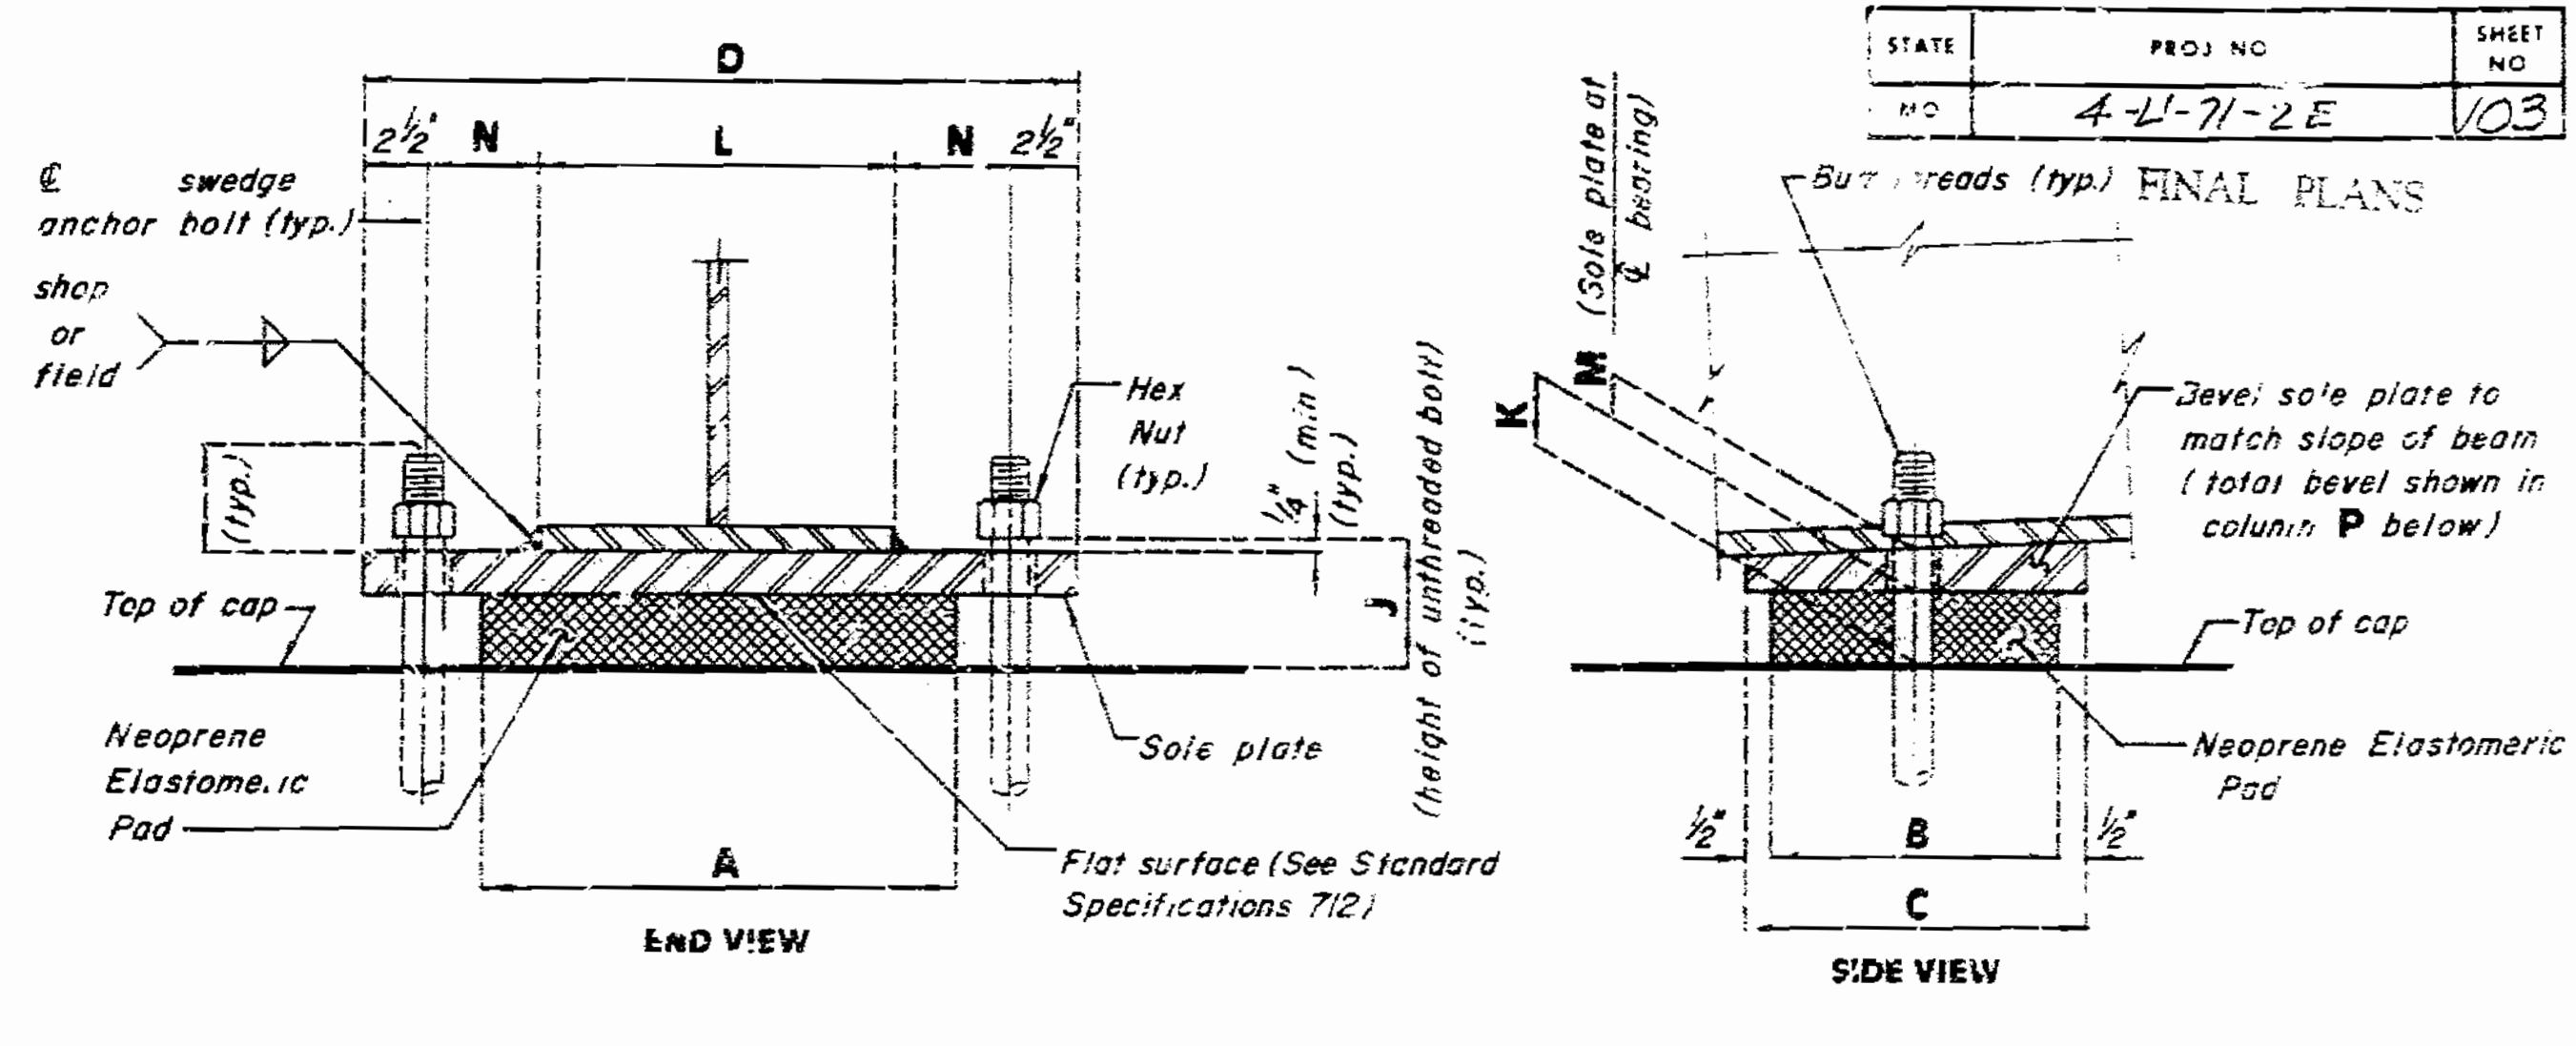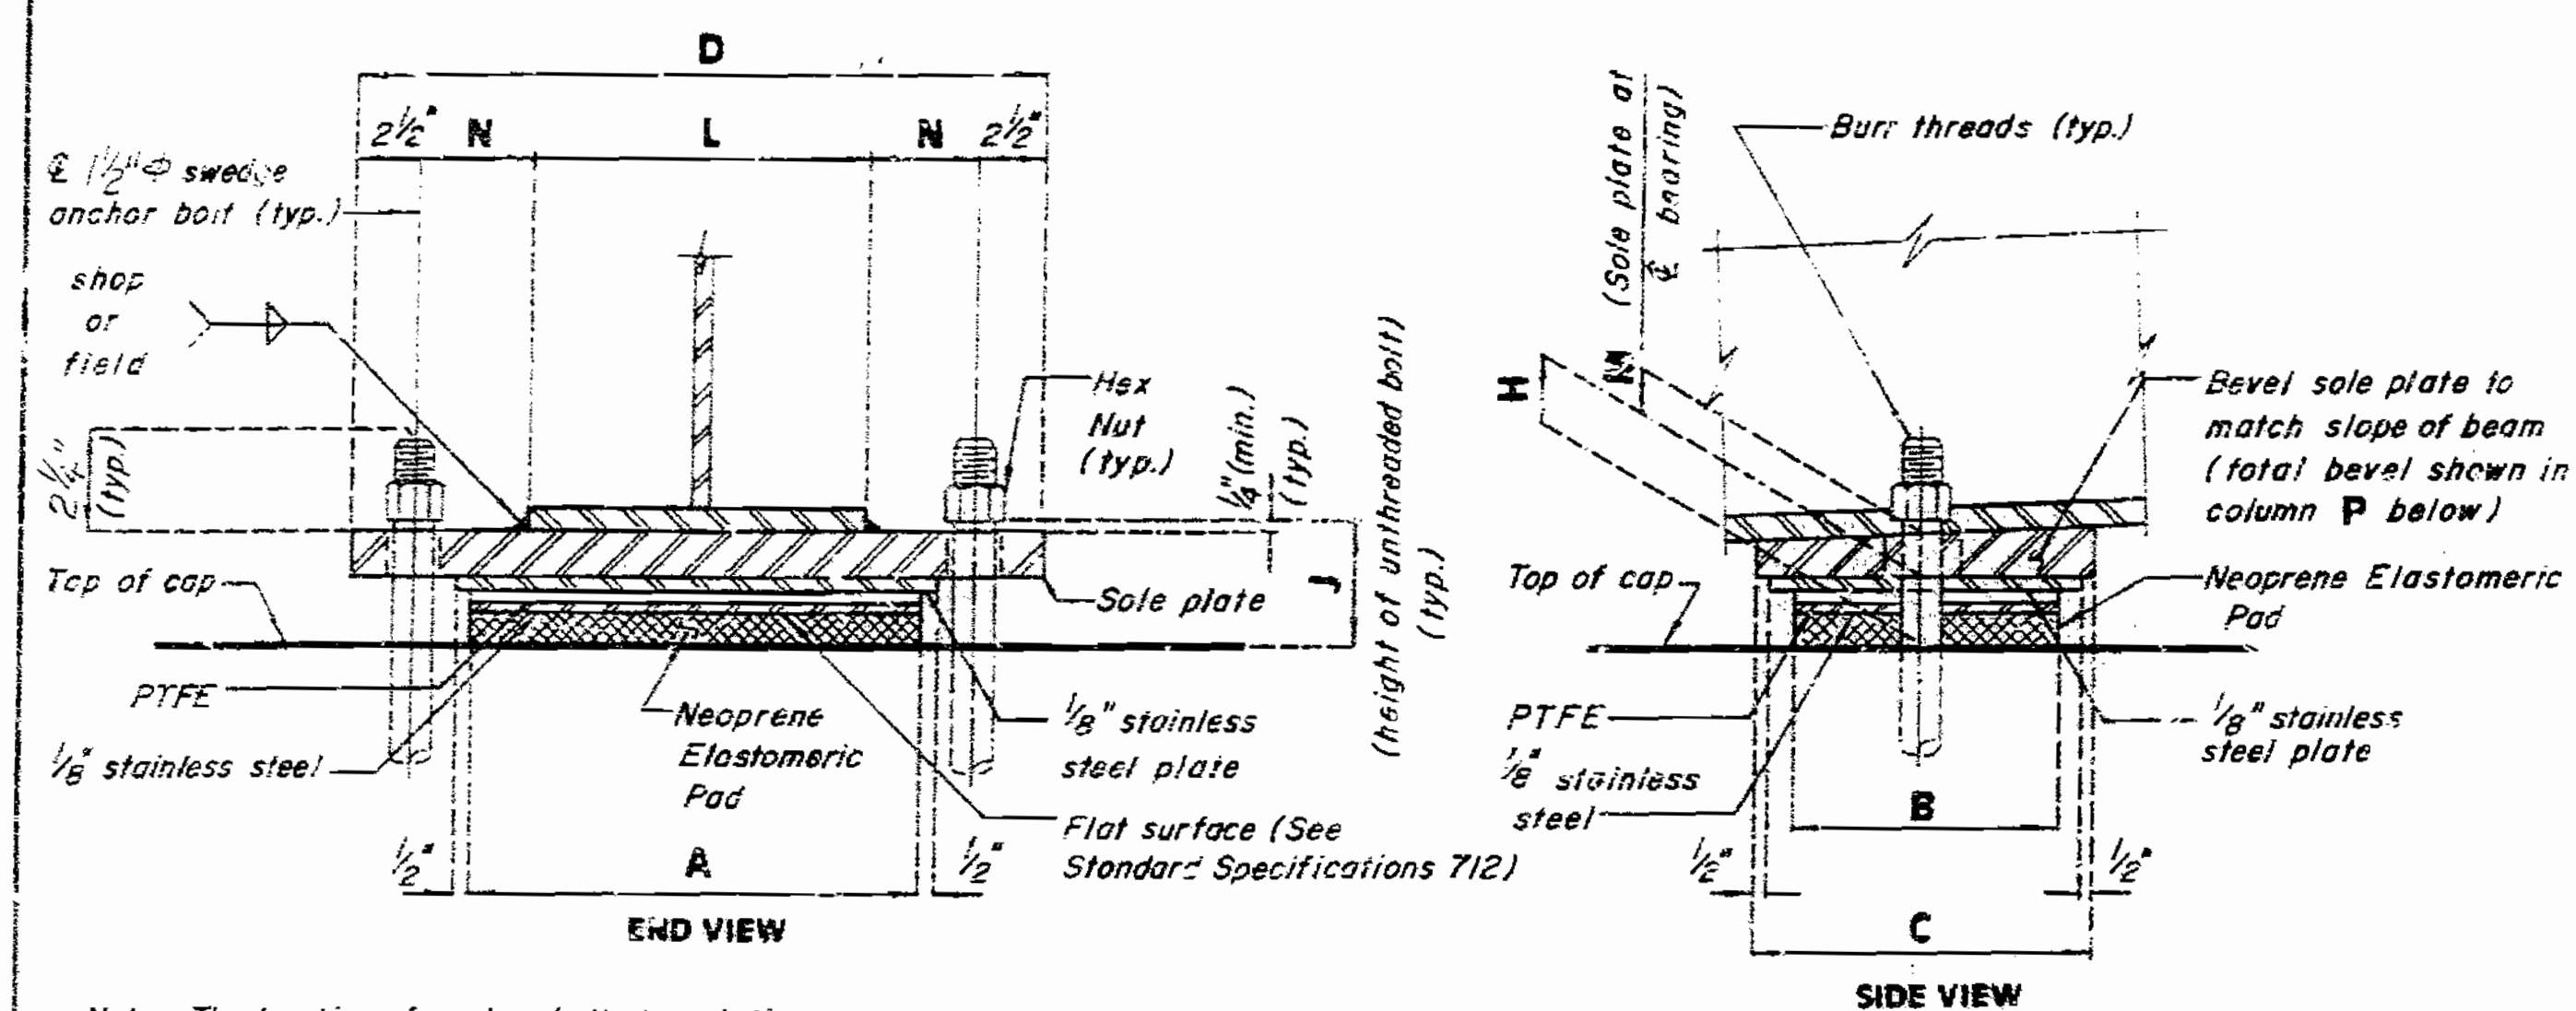

Note: The location of anchor bolts in relation to the slotted holes in the sole plate shall correspond with the temperature at the time of erection. At 60° F. the slotted holes should center on the anchor bolts.

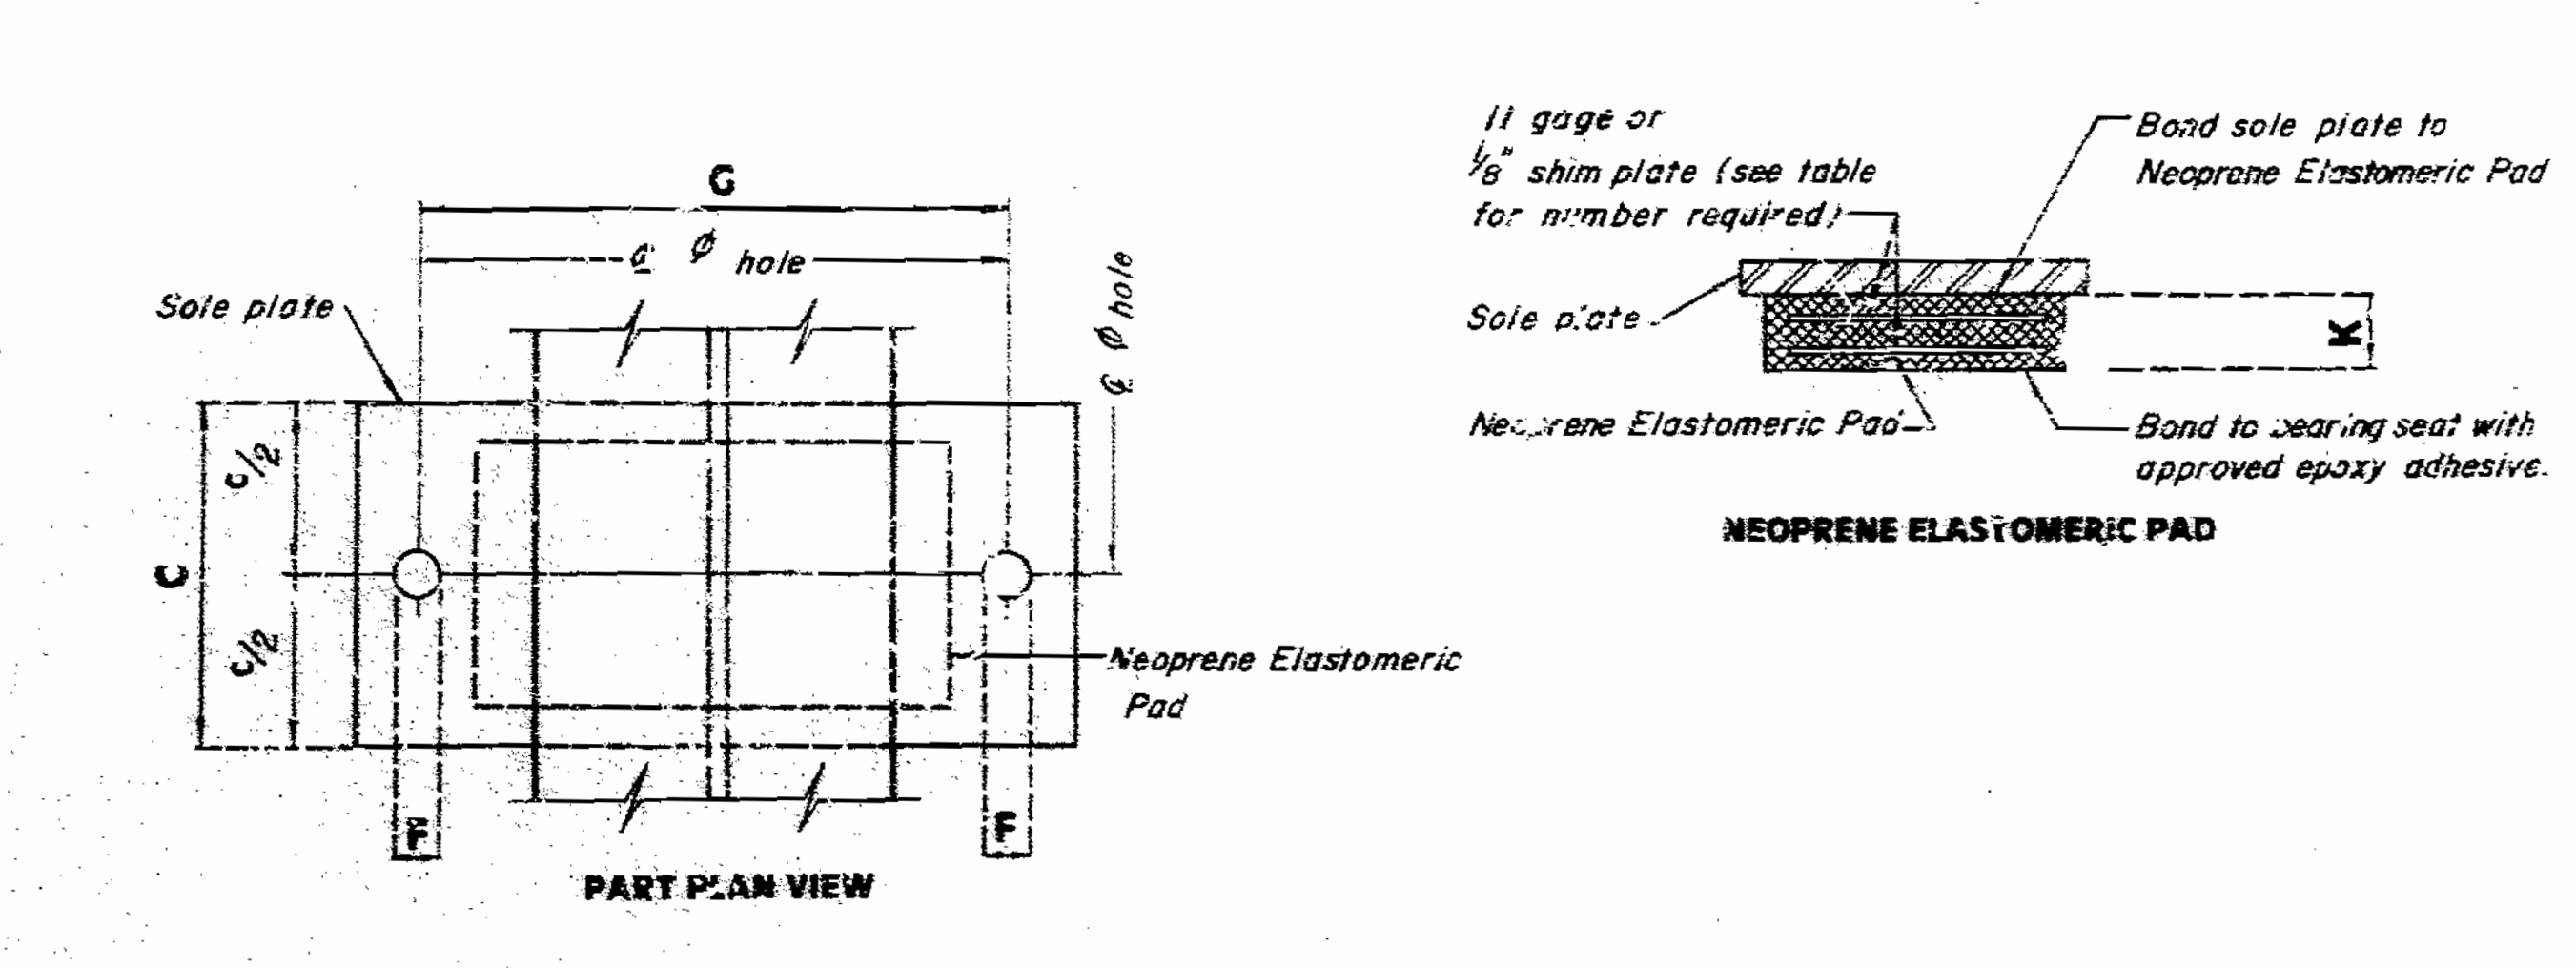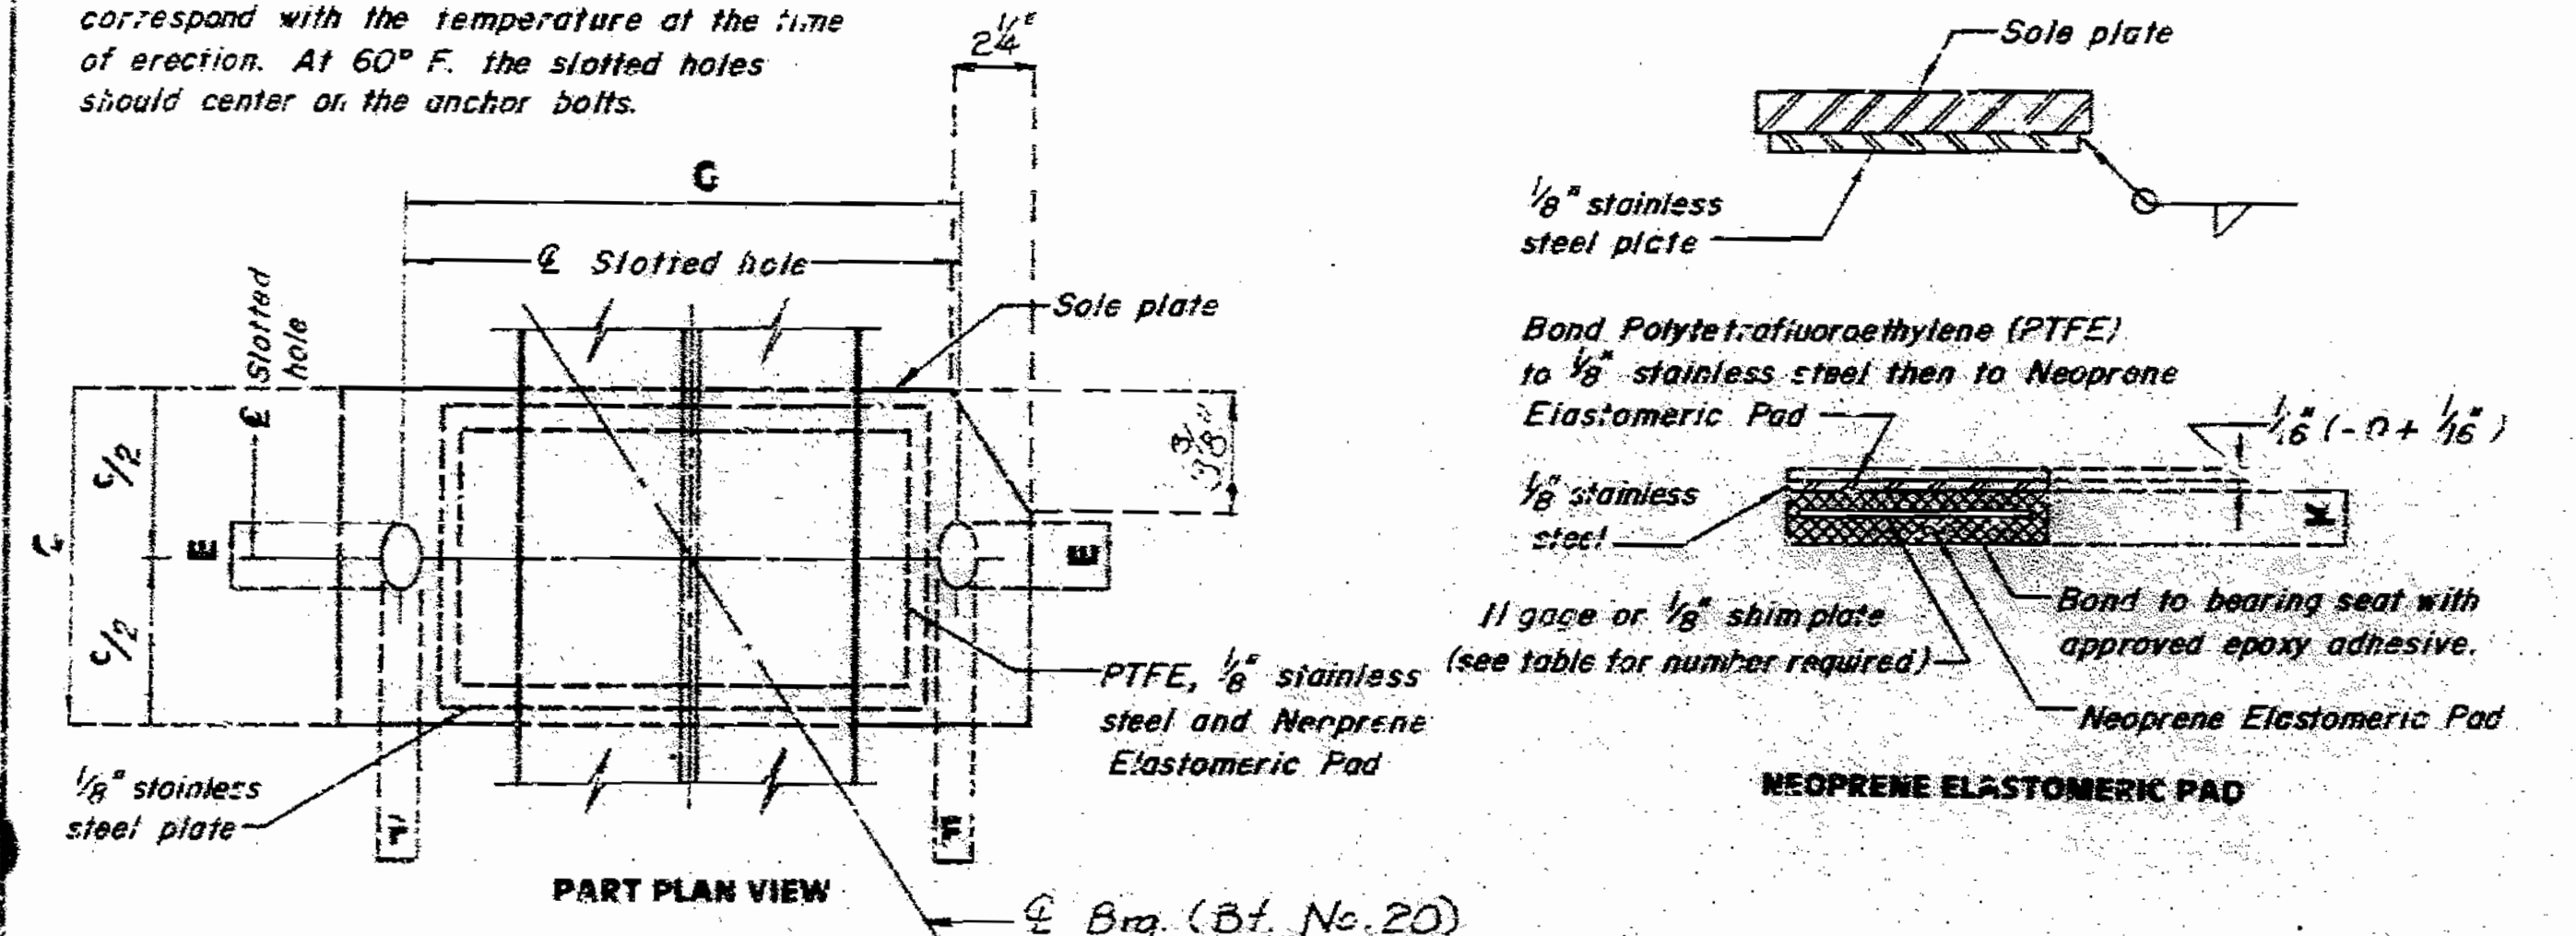

**PTFE SLIDING BEARINGS**  
NUMBER REQUIRED = 5 at Bent No. 20

**FIXED BEARINGS**  
NUMBER REQUIRED =

12 GDR. #3  
1/8 GDR. #1, #2, #4  
1/8 GDR. #5

BENT NO.	A	B	C	D	E	F	G	H	J	K	L	M	N	P	NUMBER OF SHIM PLATES*
20	16"	11"	16 1/2"	25"	6 1/2"	1 5/8"	20"	1 1/8"	3 5/8"	1 1/2"	***	1 7/8"	**	1/4"	1

BENT NO.	A	B	C	D	F	G	J	K	L	M	N	P	NUMBER OF SHIM PLATES*

\* THE REQUIRED SHIM PLATE SHALL BE PLACED BETWEEN EQUAL LAYERS OF ELASTOMER AND MOLDED TOGETHER TO FORM AN INTEGRAL UNIT.

\* THE REQUIRED SHIM PLATE SHALL BE PLACED BETWEEN EQUAL LAYERS OF ELASTOMER AND MOLDED TOGETHER TO FORM AN INTEGRAL UNIT.

\*\* Girders No. 1, 2 & 5 = 3" Girders No. 3 & 4 = 2 1/2"  
\*\*\* Girders No. 1, 2 & 5 = 14" Girders No. 3 & 4 = 15"

**GENERAL NOTES:**  
ANCHOR BOLTS SHALL BE 1/2" A588 STEEL SWEDGED BOLTS AND SHALL EXTEND 15" INTO THE CONCRETE WITH A194 - 2, 2H OR A563 - C, CS, D, DH, DH3 HEAVY HEXAGON NUTS. ACTUAL MANUFACTURER'S CERTIFIED MILL TEST REPORTS (CHEMICAL AND MECHANICAL) SHALL BE PROVIDED. (SWEDGING SHALL BE 1" LESS THAN EXTENSION INTO THE CONCRETE.)  
ALL STRUCTURAL STEEL FOR THE SOLE PLATE, ANCHOR BOLTS AND HEAVY HEXAGON NUTS SHALL BE GALVANNEAL ZINC WELD AREAS TO BE TOUCHED UP AFTER ASSEMBLY.  
WEIGHT OF THE ANCHOR BOLTS AND HEAVY HEXAGON NUTS FOR BEARINGS SHALL BE INCLUDED IN THE WEIGHT OF FABRICATED STRUCTURAL STEEL.  
NEOPRENE ELASTOMERIC PADS SHALL BE 70 DUROMETER.  
THE SOLE PLATE SHALL BE FURNISHED WITH THE BEARING AND FIELD OR SHOP WELDED TO THE STRINGERS OR GIRDERS.  
STRUCTURAL STEEL FOR SOLE PLATE SHALL BE A-36.  
PAYMENT FOR THE SOLE PLATE WILL BE INCLUDED IN THE COST OF THE BEARING ASSEMBLY. SEE SPECIAL PROVISIONS.  
THE ACCEPTED QUANTITY OF ELASTOMERIC BEARING ASSEMBLIES, COMPLETE-IN-PLACE, WILL BE PAID FOR AT THE CONTRACT UNIT PRICE FOR TYPE "N" PTFE BEARINGS, EACH.

STEEL TYPE 'N' BRGS. JANUARY 1980 REVISED OCT. 1987

DETAILED June 1988  
CHECKED March 1989

**DETAILS OF TYPE 'N' PTFE BEARINGS**

Note: This drawing is not to scale. Follow dimensions. Revised 7-1-89

Sheet No. 23 of 28

JACKSON COUNTY

A-2745

STATE	PROJ. NO.	SHEET NO.
MO	4-4-71-2E	137

FINAL PLANS

Notes:

Plate girders shall be fabricated to conform with Camber Diagram shown on sheet No. 63.

Transverse web stiffeners shall be oriented as shown in plan of structural steel.

Intermediate web stiffener plate and diaphragm spacings may vary from plan dimensions by a maximum of 3" for diaphragm to connect to intermediate web stiffener plate.

Fabricated structural steel shall be A36 except as noted.

Longitudinal dimensions are horizontal arc dimensions along centerline of girder.

\*\*\* Indicates Flange Plate subject to notch toughness requirements.

For details of earthquake restrainers, see sheet No. 61 & No. 62.

All web plates shall be subject to notch toughness requirements.


Heat curving of girders in spans (17-18) will not be allowed while in a horizontal position.

\* 3-Spaces @ 10" (3 per Unit)

GIRDER NO. 1		134'-5 1/2"		
" " 2		127'-10 1/2"		
" " 3		121'-3 3/8"		
" " 4		114'-9"		
" " 5		108'-2 1/2"		
GIRDER NO. 1	7"	99'-10 1/2"	34'-0"	43'-0"
" " 2	7"	95'-3 1/2"	32'-0"	42'-0"
" " 3	7"	90'-3 5/8"	30'-0"	37'-0"
" " 4	7"	86'-2"	28'-0"	36'-0"
" " 5	7"	83'-10 1/2"	23'-9"	31'-2"

GIRDER NO. 1	74- Shear Connector Units (Spaced as shown)
" " 2	71- " " " " " " " "
" " 3	68- " " " " " " " "
" " 4	65- " " " " " " " "
" " 5	64- " " " " " " " "

GIRDER NO. 1	16 1/2"	65-Spaces @ 18" (3 per Unit)	19'-18" *	30'-0"	39'-0"	* 18"
" " 2	16"	62-Spaces @ 18" (3 per Unit)	18 1/2'-18" *	28'-0"	38'-0"	* 18"
" " 3	15 5/8"	59-Spaces @ 18" (3 per Unit)	18'-18" *	26'-0"	33'-0"	* 18"
" " 4	15 1/4"	56-Spaces @ 18" (3 per Unit)	17 1/2'-18" *	24'-0"	32'-0"	* 18"
" " 5	14 1/2"	55-Spaces @ 18" (3 per Unit)	13'-18" *	19'-9"	27'-2"	* 18"

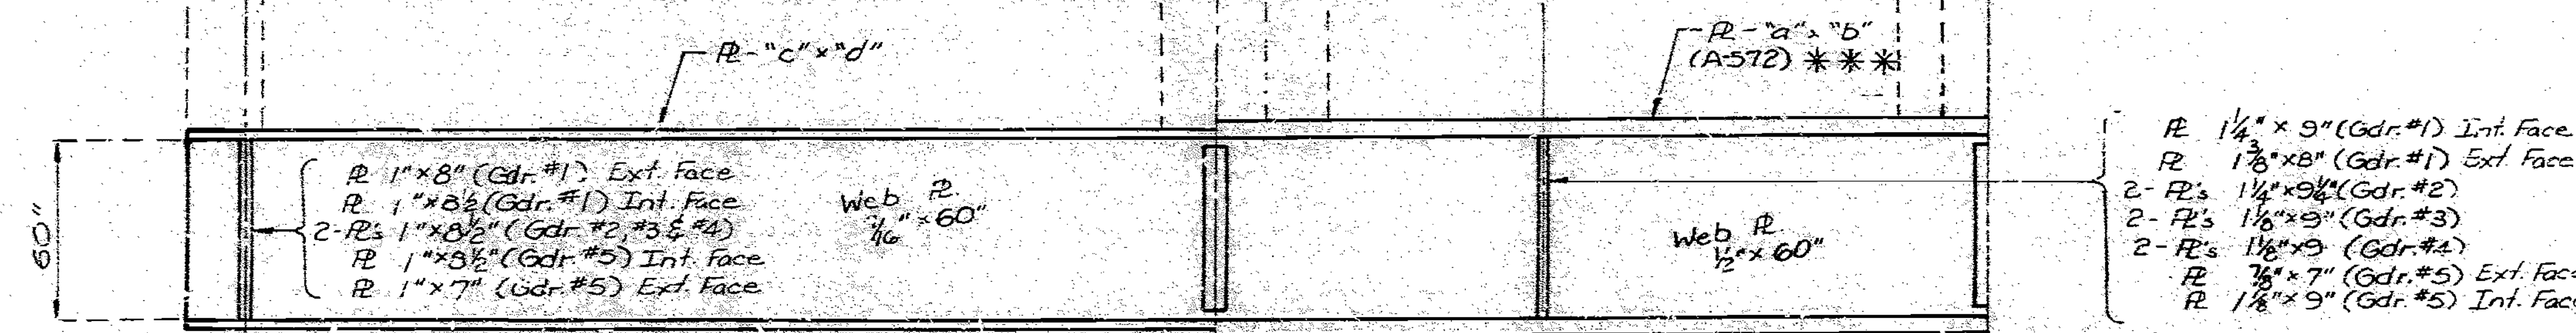

GIRDER NO. 1	2'-6"	Top						Bottom					
		6-Spa @ 5'-0"	34'-1 1/2"	6-Spa @ 5'-0"	5'-0"	5-Spa @ 5'-0"	3'-30" 4'-9"	7-Spa @ 5'-0"	3'-3"				
" " 2	2'-6"	6-Spa @ 5'-0"	34'-9 1/2"	5-Spa @ 5'-0"	5'-0"	5-Spa @ 5'-0"	5'-0"	5'-0"	7-Spa @ 5'-0"	2'-0"			
" " 3	2'-6"	5-Spa @ 5'-0"	41'-2 5/8"	4-Spa @ 5'-0"	4'-0"	5-Spa @ 5'-0"	3'-0"	4'-0"	6-Spa @ 5'-0"	3'-0"			
" " 4	2'-6"	5-Spa @ 5'-0"	36'-8"	4-Spa @ 5'-0"	5'-0"	4-Spa @ 5'-0"	5'-0"	5'-0"	6-Spa @ 5'-0"	1'-2"			
" " 5	2'-6"	5-Spa @ 5'-0"	35'-1 1/2"	4-Spa @ 5'-0"	5'-0"	3-Spa @ 5'-0"	5'-0"	5'-0"	5-Spa @ 5'-0"	1'-4"			

Int. Diaph. Spacing	13'-3"	6-Spaces @ 13'-3 1/8"	13'-6 1/4"	3'-8"	13'-10 1/2"	3-Spaces @ 13'-4"	GIRDER NO. 1
	13'-3 1/2"	6-Spaces @ 13'-3 1/2"	13'-7"	13'-8 1/2"	13'-11 1/4"	2-Spaces @ 13'-4 1/2"	" " 2
	13'-4"	6-Spaces @ 13'-4"	13'-7 5/8"	13'-9"	13'-11 1/2"	2-Spaces @ 13'-5"	" " 3
	13'-4 1/2"	6-Spaces @ 13'-4 1/2"	13'-8"	13'-9 1/2"	14'-0 1/8"	13'-5 1/2"	" " 4
	13'-5"	6-Spaces @ 13'-5"	13'-8 1/2"	13'-10"	14'-0 3/4"		" " 5

LOCATION	"a"	"b"
Girder No. 5	19'	1"
Girder No. 4	19'	1 1/4"
Girder No. 3	19'	1 3/8"
Girder No. 2	20'	1 1/2"
Girder No. 1	20'	1 3/4"
	20'	2"
Girder No. 4 & 5	10'	3 1/4"
Girder No. 3	11'	3"
Girder No. 2	11'	1"
Girder No. 1	12'	1"
	"e"	"f"
Girder No. 5	14'	1 1/8"
Girder No. 4	16'	1 1/2"
Girder No. 3	17'	1 1/4"
Girder No. 1 & 2	17'	1 3/8"

779206

PART ELEVATION OF GIRDER

DETAILED July 1988  
CHECKED Feb. 1989

Note: This drawing is not to scale. Follow dimensions. Revised 12-1-89

Sheet No. 57A of 98

STATE	PROJ. NO.	SHEET NO.
MO	4-U-71-2E	133

FINAL PLANS

134'-8 1/2"	96'-2 1/2"	GIRDER NO. 1
128'-0 3/4"	95'-4 3/4"	" " 2
121'-6 3/8"	94'-7 1/4"	" " 3
115'-1"	93'-10"	" " 4
108'-8 3/4"	93'-1 1/8"	" " 5


62'-8 1/4"	29'-0"	28'-0"	66'-4 7/8"	2 1/8"	GIRDER NO. 1
54'-0 3/4"	32'-0"	27'-0"	66'-7 1/4"	2 1/8"	" " 2
60'-6 3/8"	24'-0"	23'-0"	69'-9 1/8"	2 1/8"	" " 3
53'-1"	26'-0"	22'-0"	70'-0 7/8"	2 1/8"	" " 4
51'-6 3/4"	26'-0"	22'-4"	69'-0 7/8"	2"	" " 5

126- Shear Connector Units (Spaced as shown)				GIRDER NO. 1
118 - "	"	"	"	" " 2
127 - "	"	"	"	" " 3
120 - "	"	"	"	" " 4
117 - "	"	"	"	" " 5


16 5/8"	60 Spaces @ 12" (3 per Unit)	16 1/8" 10" *	25'-2"	24'-2"	* 16 1/2"	56 Spaces @ 14" (3 per Unit)	22 1/2"	GIRDER NO. 1
12 3/8"	52 Spaces @ 12" (3 per Unit)	12 3/8" 16" *	28'-2"	23'-2"	* 16 1/2"	56 Spaces @ 14" (3 per Unit)	21 3/4"	" " 2
15 1/8"	58 Spaces @ 12" (3 per Unit)	15 1/8" 16" *	20'-2"	19'-2"	* 16 1/2"	59 Spaces @ 14" (3 per Unit)	21 1/4"	" " 3
12 1/2"	51 Spaces @ 12" (3 per Unit)	12 1/2" 16" *	22'-2"	18'-2"	* 16 1/2"	59 Spaces @ 14" (3 per Unit)	21 0"	" " 4
15 3/8"	49 Spaces @ 12" (3 per Unit)	15 3/8" 16" *	22'-2"	18'-6"	* 16 1/2"	58 Spaces @ 14" (3 per Unit)	21 1/8"	" " 5

\* 3-Spaces @ 10" (3 per Unit)

Note: For notes see sheet No. 57.

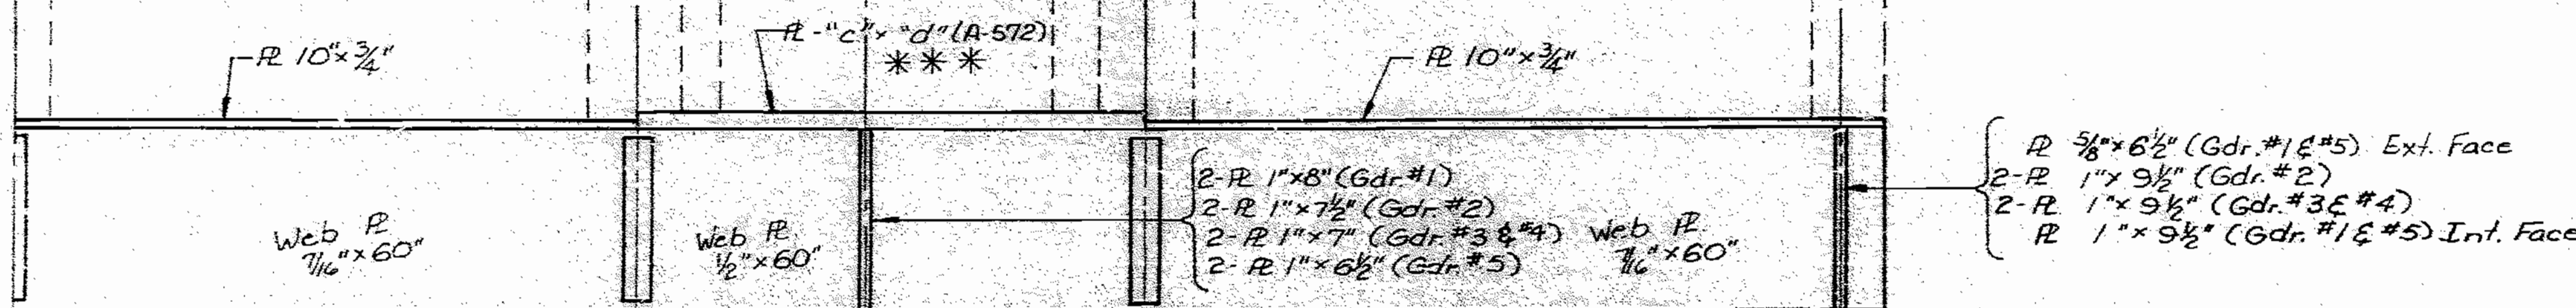

Field Splice (S2)  
Match Line

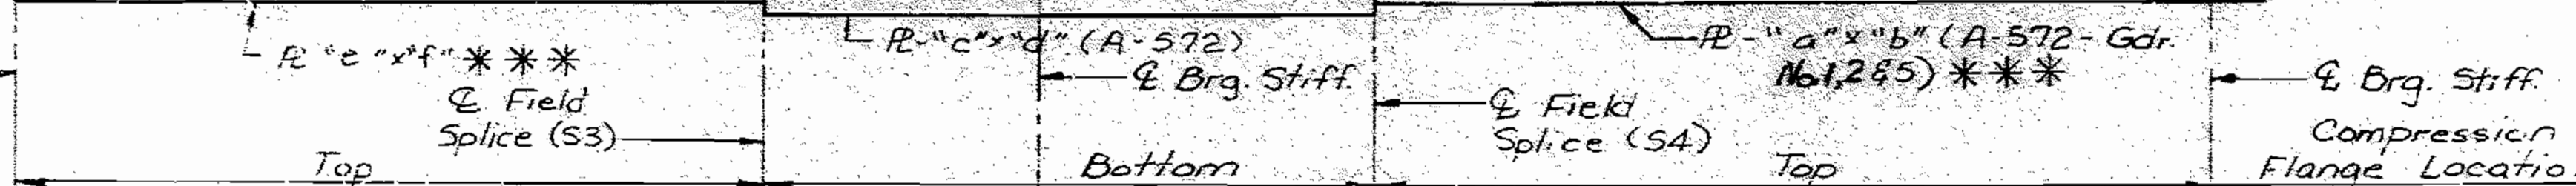

4 1/2" x 3/8"  
Trans. Web  
Stiff. Spacing

2-Spa @ 5'-0"	37'-4"	8-Spa @ 5'-0"	3'-0" 5'-0"	7-Spaces @ 5'-0"	34'-4 7/8"	3-Spa @ 5'-0" 2'-6"	2'-6"	GIRDER NO. 1
3'-0" 5'-0"	37'-0"	2-Spa @ 5'-0"	11'-0 3/4" 3-Spa @ 5'-0"	7-Spaces @ 5'-0"	33'-7 1/4"	3-Spa @ 5'-0" 2'-6"	2'-6"	" " 2
2'-0"	16-Spa @ 5'-0"	2'-0" 5'-0"	2'-0" 5'-0"	7-Spaces @ 5'-0"	25'-3 7/8"	5-Spa @ 5'-0"	2'-6"	" " 3
4'-0" 5'-0"	35'-1"	6-Spaces @ 5'-0"	5'-0" 5'-0"	7-Spa @ 5'-0"	24'-6 7/8"	5-Spa @ 5'-0"	2'-6"	" " 4
3'-10" 5'-0"	33'-8 3/4"	7-Spaces @ 5'-0"	5'-0" 5'-0"	7-Spaces @ 5'-0"	28'-10 7/8"	4-Spa @ 5'-0"	2'-6"	" " 5

GIRDER NO. 1	13'-3 1/8"	13'-4"	13'-2 1/4"	13'-5 1/4"	13'-7 3/8"	13'-9 3/8"	13'-11 1/8"	2-Spa @ 11'-1 3/8"	11'-2 3/8"	14'-5 1/8"	14'-7 5/8"	14'-10 1/4"	17'-0 3/4"	2'-0 1/2"										
" " 2	2-Spaces @ 13'-4 1/2"													13'-2 3/4"	13'-5 3/4"	13'-7 7/8"	13'-10 1/8"	14'-0 3/8"	2-Spa @ 11'-1 3/4"	11'-2 3/4"	14'-5 3/8"	14'-8 1/8"	14'-10 3/4"	2'-0 1/2"
" " 3	3-Spaces @ 13'-5"													13'-3 1/4"	13'-6 1/4"	13'-8 3/8"	13'-10 5/8"	14'-0 1/8"	2-Spa @ 11'-2 3/8"	11'-3 1/4"	14'-6 1/8"	14'-8 5/8"	14'-10 3/4"	2'-0 1/2"
" " 4	3-Spaces @ 12'-5 1/2"													13'-3 3/8"	13'-6 3/4"	13'-8 7/8"	13'-11 1/8"	14'-1 3/8"	2-Spa @ 11'-2 3/8"	11'-3 3/8"	14'-6 3/8"	14'-8 3/8"	14'-10 3/4"	2'-0"
" " 5	4-Spaces @ 13'-6"													13'-4"	13'-7 7/8"	13'-9 3/8"	13'-11 1/8"	14'-1 7/8"	2-Spa @ 11'-3"	11'-4"	14'-6 3/8"	14'-8 3/8"	14'-10 3/4"	2'-0"

PART SPAN (18-19) PART ELEVATION OF GIRDER SPAN (19-20)

Int. Diaph Spacing

LOCATION	"a"	"b"
Girder No. 1 & 2	14"	1"
Girder No. 3	17 1/2"	1 1/8"
Girder No. 4	15"	1"
Girder No. 5	14"	3/4"
	"c"	"d"
Girder No. 1	17"	1 1/8"
Girder No. 2	16"	1 1/8"
Girder No. 3	15"	1 1/8"
Girder No. 4	15"	1"
Girder No. 5	15"	1"
	"e"	"f"
Girder No. 1	17"	1 1/2"
Girder No. 2	16"	1 1/8"
Girder No. 3	15"	1 1/8"
Girder No. 4	14"	1 1/8"
Girder No. 5	14"	1"

788 201

DETAILED July 1988  
CHECKED Feb. 1989

Note: This drawing is not to scale. Follow dimensions. Revised 12-1-89

Sheet No. 58 of 98

JACKSON COUNTY

A-2745

STATE	PROJ. NO.	SHEET NO.
MO.	4-0-71-2E	139

FINAL PLANS

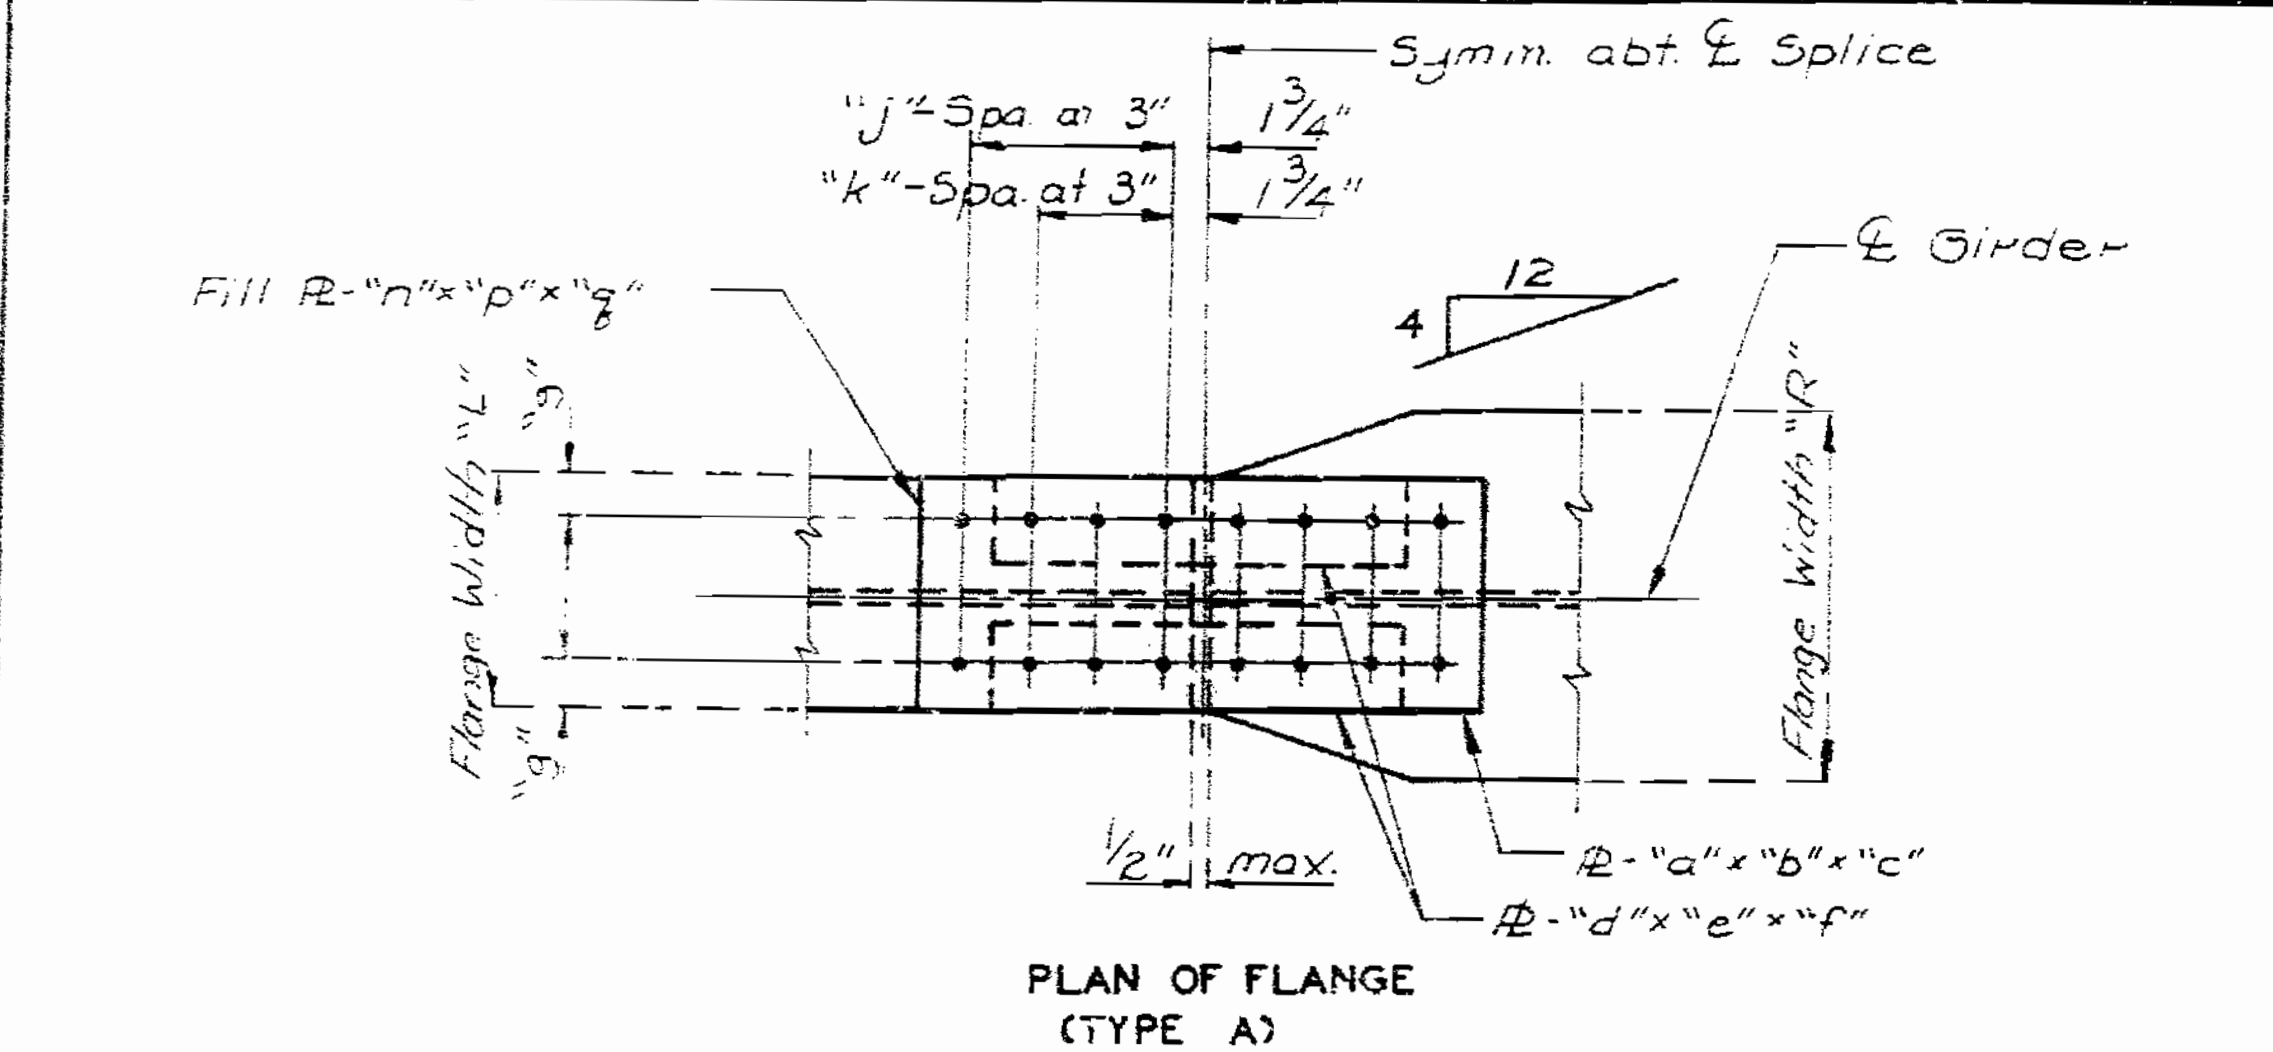


TABLE OF DIMENSIONS (TYPE A SPLICE)

Splice No.	Girder No.	Location	"a"	"b"	"c"	"d"	"e"	"f"	"g"	"j"	"k"	"n"	"p"	"q"	Flange Width "L"	Flange Width "R"
S1&S2	5	Top	10"	3/8"	18 1/2"	4"	1/2"	18 1/2"	2"	2	2	10"	1/4"	9"	10"	19"
S3&S4	4	Top	10"	3/8"	18 1/2"	4"	1/2"	18 1/2"	2"	2	2	10"	1/4"	9"	10"	15"
S3&S4	5	Top	10"	3/8"	18 1/2"	4"	1/2"	18 1/2"	2"	2	2	10"	1/4"	9"	10"	15"
S1&S2	4	Top	10"	3/8"	18 1/2"	4"	1/2"	18 1/2"	2"	2	2	10"	1/2"	9"	10"	19"
S2	3	Top	10"	3/8"	18 1/2"	4"	1/2"	18 1/2"	2"	2	2	10"	3/8"	9"	10"	19"
S3&S4	3	Top	10"	3/8"	18 1/2"	4"	1/2"	18 1/2"	2"	2	2	10"	3/8"	9"	10"	15"
S2	2	Top	10"	3/8"	18 1/2"	4"	1/2"	18 1/2"	2"	2	2	10"	3/4"	9"	10"	20"
S3&S4	2	Top	10"	3/8"	18 1/2"	4"	1/2"	18 1/2"	2"	2	2	10"	3/8"	9"	10"	16"
S2	1	Top	10"	3/8"	18 1/2"	4"	1/2"	18 1/2"	2"	2	2	10"	1"	9"	10"	20"
S3&S4	1	Top	10"	3/8"	18 1/2"	4"	1/2"	18 1/2"	2"	2	2	10"	3/8"	9"	10"	17"
S1	2	Top	11"	5/8"	2-0 1/2"	4 1/2"	5/8"	2-0 1/2"	2 1/2"	3	3	11"	1/2"	12"	11"	20"
S1	1	Top	12"	1/2"	2-6 1/2"	5"	5/8"	2-0 1/2"	2 1/2"	4	3	12"	3/4"	15"	12"	20"
S1	3	Top	11"	3/8"	18 1/2"	4 1/2"	1/2"	18 1/2"	2 1/2"	2	2	11"	5/8"	9"	11"	19"


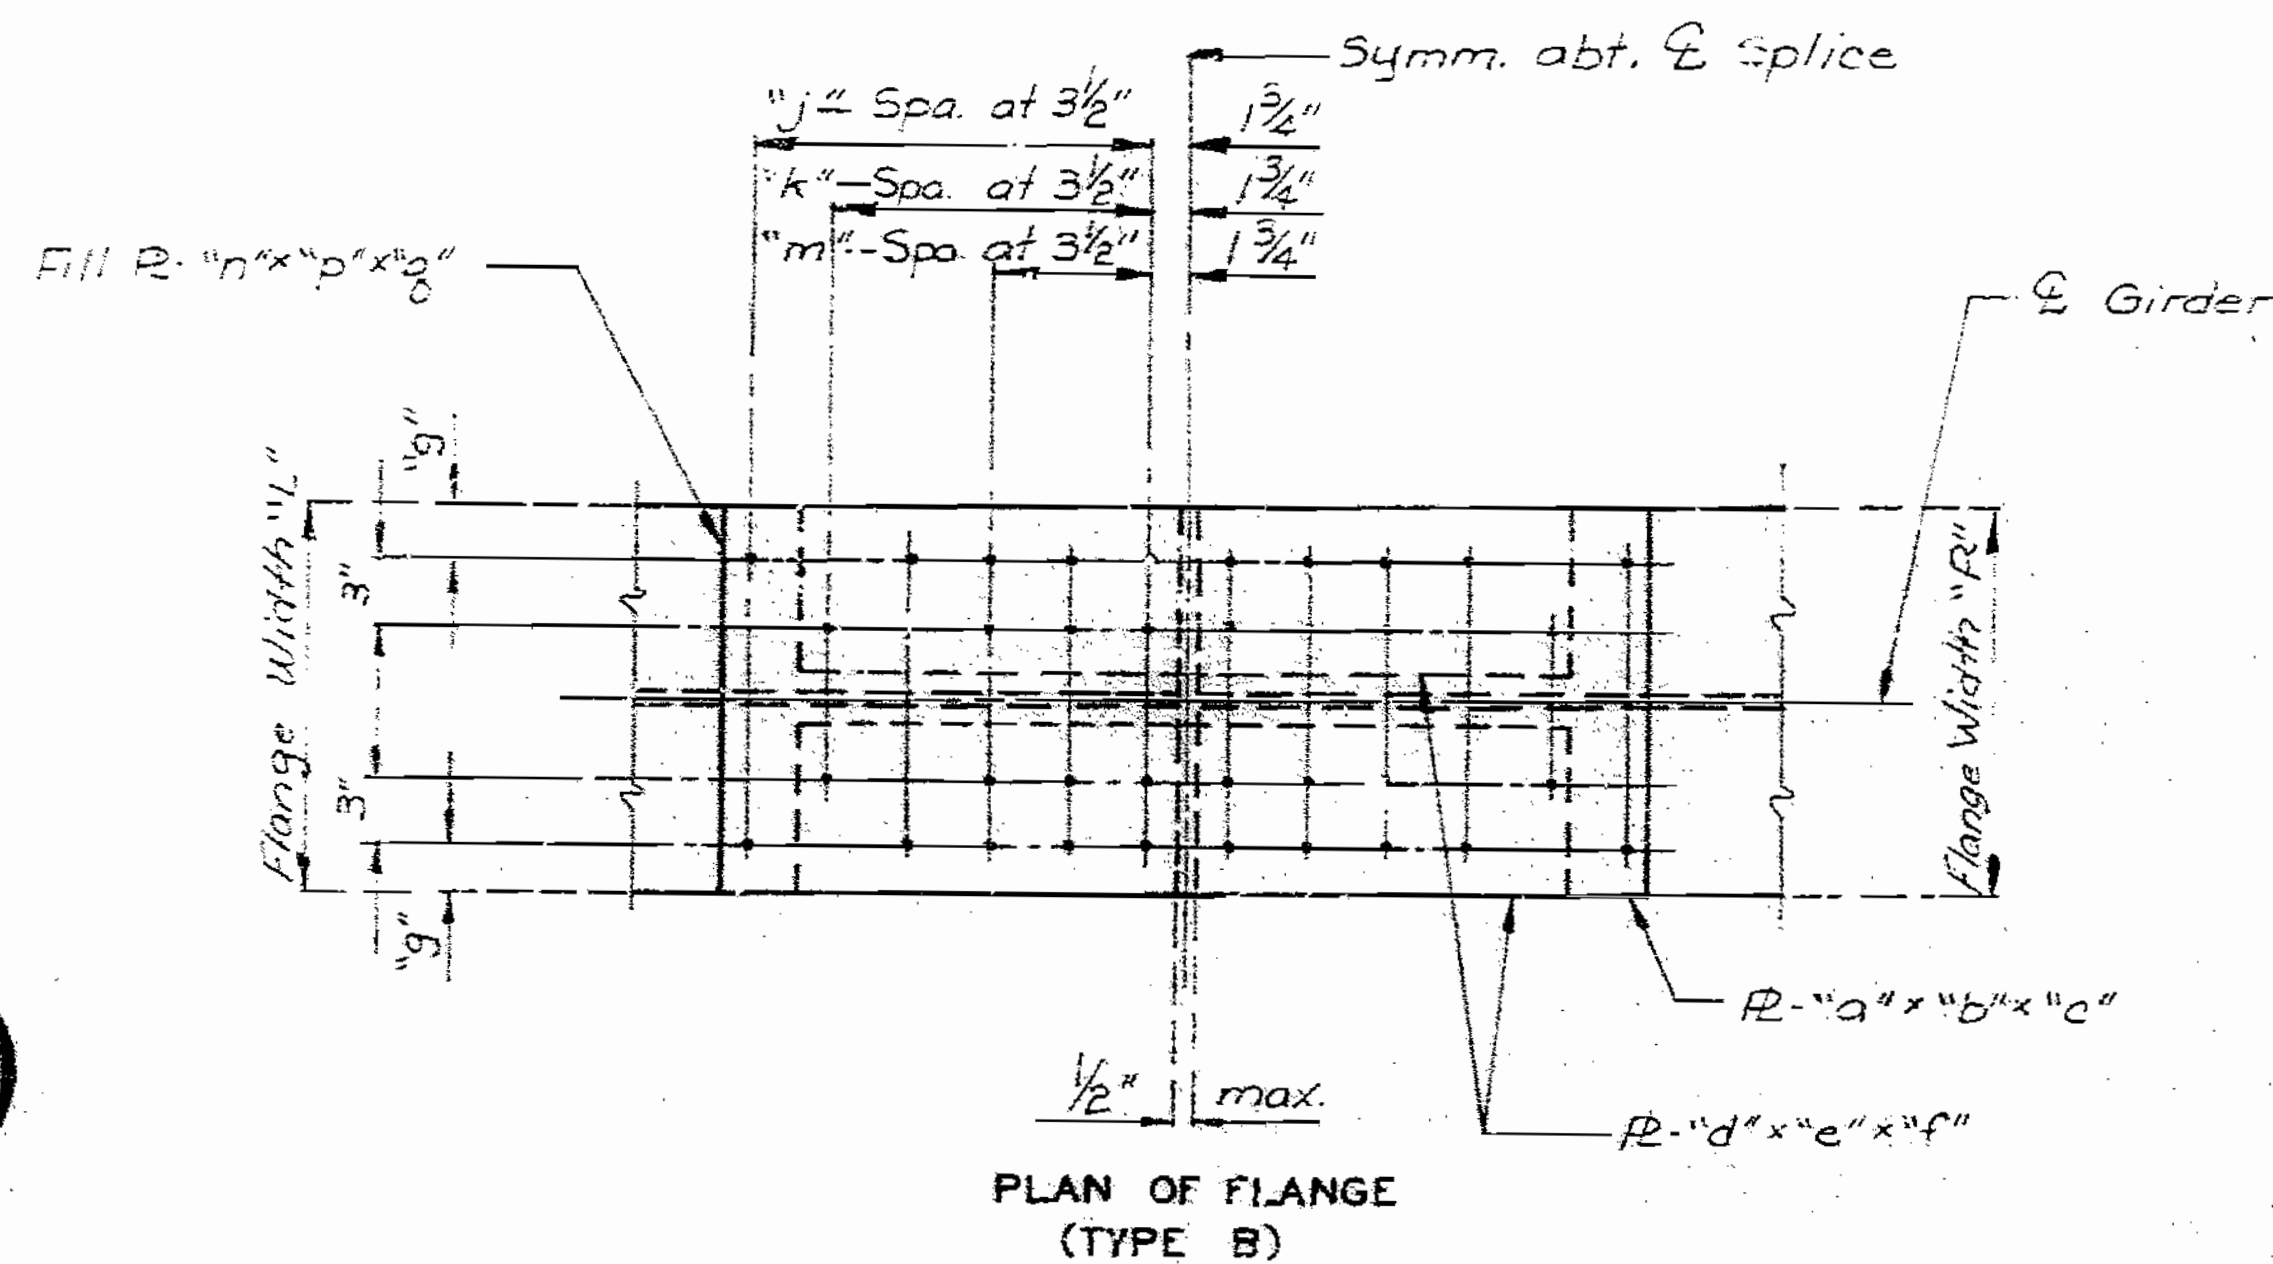


TABLE OF DIMENSIONS

Splice No.	Girder No.	Location	"a"	"b"	"c"	"d"	"e"	"f"	"g"	"j"	"k"	"m"	"n"	"p"	"q"	Flange Width "L"	Flange Width "R"	Type Splice
S2	5	Bot.	14"	5/8"	20 1/2"	6"	3/4"	20 1/2"	1 1/2"	2	2	1	-	-	-	14"	19"	C
S3	5	Bot.	14"	5/8"	20 1/2"	6"	3/4"	20 1/2"	1 1/2"	2	2	1	-	-	-	14"	15"	B
S4	5	Bot.	14"	1/2"	20 1/2"	6"	1/2"	20 1/2"	1 1/2"	2	2	1	14"	1/4"	10"	14"	15"	B
S1	5	Bot.	14"	1"	2-10 1/2"	6"	1 1/8"	2-3 1/2"	1 1/2"	4	3	2	14"	1/8"	17"	14"	19"	C
S1	4	Bot.	16"	1"	3-5 1/2"	7"	1"	2-10 1/2"	2"	5	4	3	16"	1/8"	20 1/2"	16"	19"	C
S2	4	Bot.	14"	3/4"	2-3 1/2"	6"	3/4"	20 1/2"	1 1/2"	3	2	1	14"	1/8"	13 1/2"	14"	19"	C
S3	4	Bot.	14"	3/4"	2-3 1/2"	6"	3/4"	20 1/2"	1 1/2"	3	2	1	14"	1/8"	13 1/2"	14"	15"	B
S4	4	Bot.	15"	3/8"	2-3 1/2"	6 1/2"	3/4"	2-3 1/2"	1 3/4"	3	3	1	-	-	-	15"	15"	B
S1	3	Bot.	17"	1"	4-0 1/2"	7 1/2"	1 1/8"	3-5 1/2"	2 1/4"	6	5	3	17"	1/8"	20"	17"	19"	B
S2	3	Bot.	15"	3/4"	2-3 1/2"	6 1/2"	3/4"	2-3 1/2"	1 3/4"	3	3	2	15"	1/4"	13 1/2"	15"	19"	C
S3&S4	3	Bot.	15"	3/4"	2-3 1/2"	6 1/2"	3/4"	2-3 1/2"	1 3/4"	3	3	2	-	-	-	15"	15"	B
S1	2	Bot.	17"	1 1/8"	4-0 1/2"	7 1/2"	1 1/4"	3-5 1/2"	2 1/4"	6	5	4	17"	1/8"	20"	17"	20"	C
S2	2	Bot.	16"	3/4"	2-3 1/2"	7"	3/4"	2-3 1/2"	2"	3	3	2	16"	3/8"	15 1/2"	16"	20"	C
S3	2	Bot.	16"	3/4"	2-3 1/2"	7"	3/4"	2-3 1/2"	2"	3	3	2	-	-	-	16"	16"	B
S4	2	Bot.	14"	5/8"	20 1/2"	6"	3/4"	20 1/2"	1 1/2"	2	2	1	14"	1/8"	10"	14"	16"	B
S1	1	Bot.	17"	1 1/8"	4-0 1/2"	7 1/2"	1 1/4"	3-5 1/2"	2 1/4"	6	5	4	17"	3/8"	20"	17"	20"	C
S2	1	Bot.	17"	3/4"	2-10 1/2"	7 1/2"	7/8"	2-10 1/2"	2 1/4"	4	4	2	17"	1/2"	17"	17"	20"	C
S3	1	Bot.	17"	3/4"	2-10 1/2"	7 1/2"	3/4"	2-3 1/2"	2 1/4"	4	3	2	17"	1/8"	17"	17"	17"	B
S4	1	Bot.	14"	7/8"	2-10 1/2"	6"	1"	2-3 1/2"	1 1/2"	4	3	2	14"	1/8"	17"	14"	17"	C

See Sheet #59A For Revised Splices

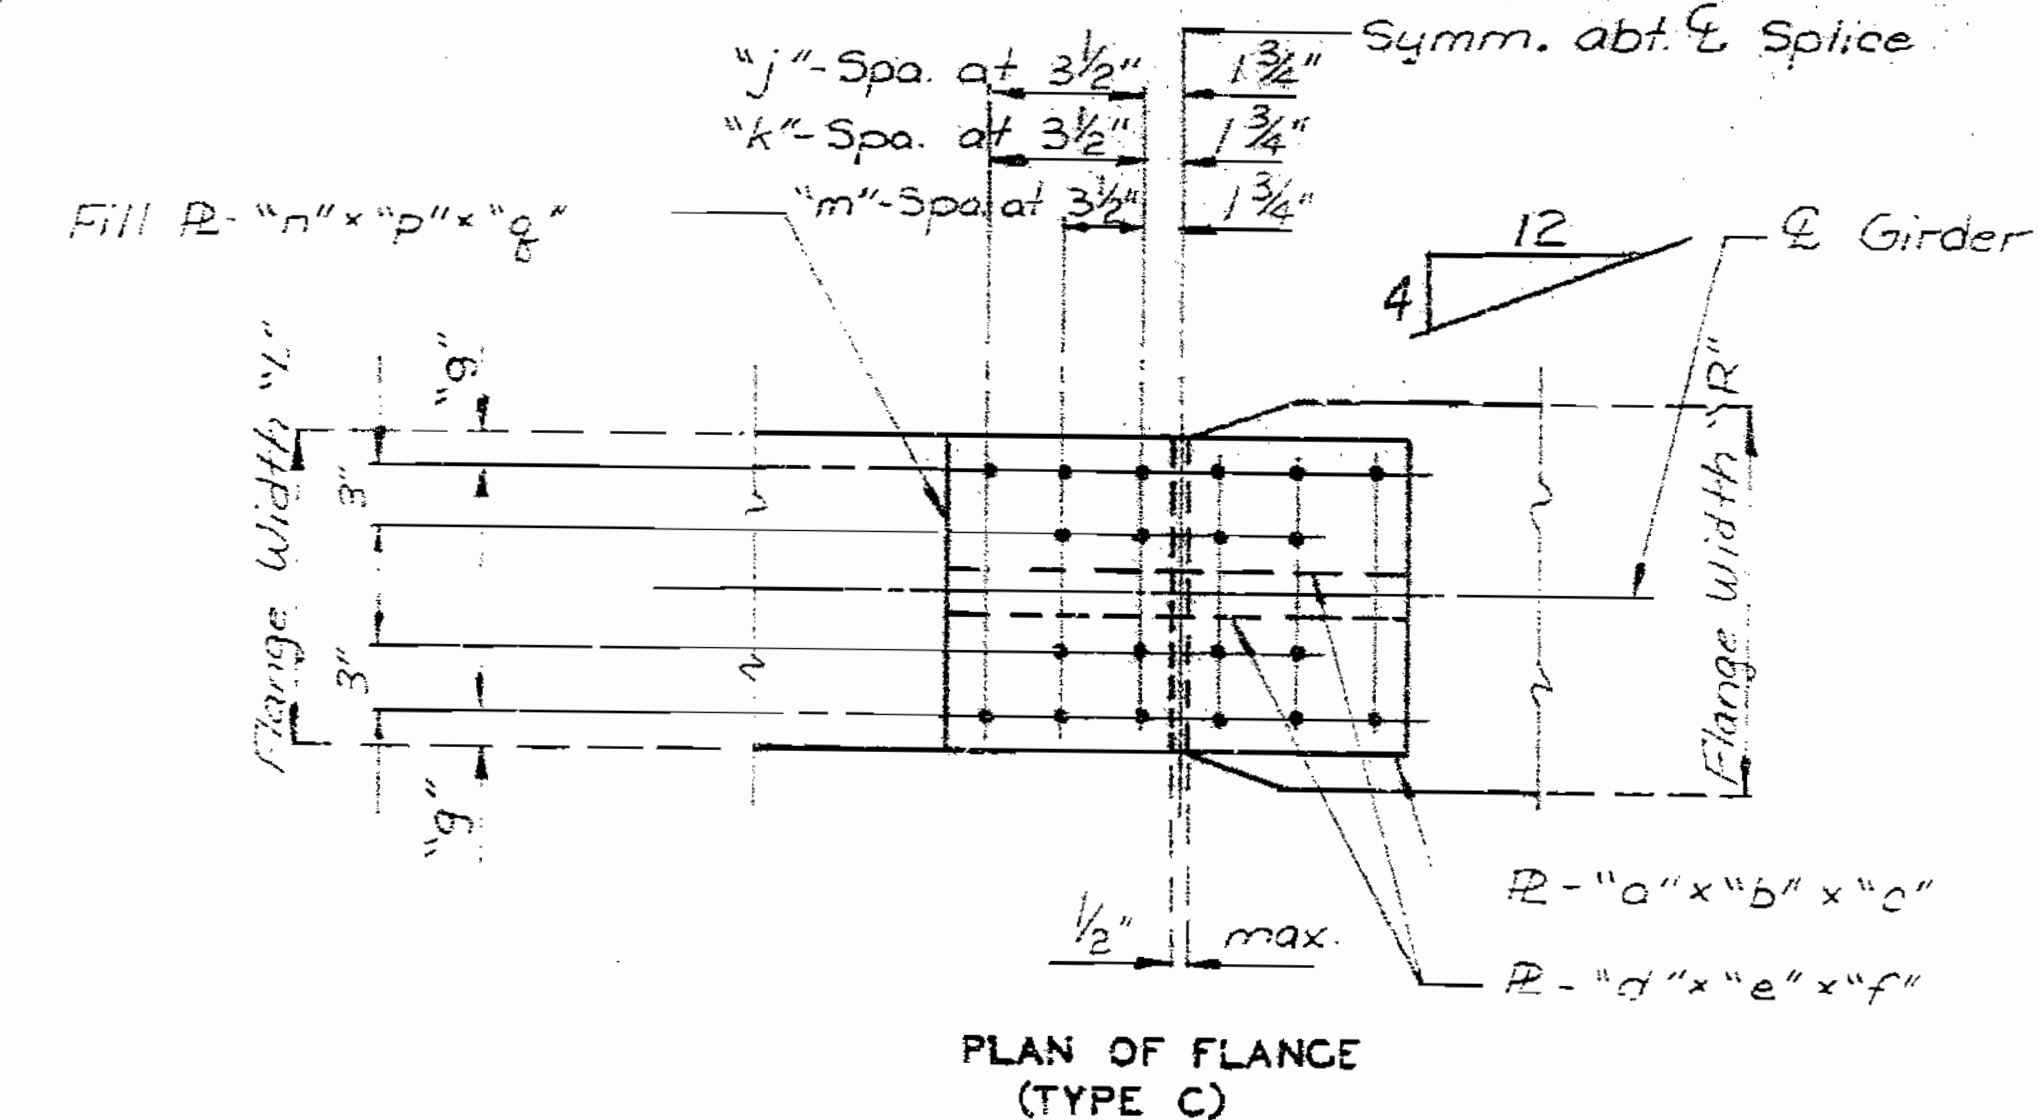

DETAILS OF FIELD FLANGE SPLICES

Note: This drawing is not to scale. Follow dimensions. Revised 12-1-89

Sheet No. 59A of 98

JACKSON COUNTY

A-2745

DETAILED June 1988  
CHECKED Feb. 1989

707 208

STATE	PROJ. NO.	SHEET
MO.	4-11-71-2E	140

FINAL PLANS

SPLICE NO.	GIRDER NO.	LOCATION	"a"	"b"	"c"	"d"	"e"	"f"	"g"	"j"	"k"	"n"	"p"	"q"	FLANGE WIDTH "L"	FLANGE WIDTH "R"
S1	1	TOP	12"	2'-6 1/2"	5"	5/8"	2'-0 1/2"	2 1/2"	4	3	12"	3/2"	15"	12"	20"	
S1	2	TOP	11"	2'-0 1/2"	4 1/2"	5/8"	2'-0 1/2"	2 1/2"	3	3	11"	3/2"	12"	11"	20"	
S1	3	TOP	11"	2'-0 1/2"	4 1/2"	5/8"	2'-0 1/2"	2 1/2"	3	3	11"	3/8"	12"	11"	19"	
S1	4	TOP	10"	2'-0 1/2"	4"	5/8"	18 1/2"	2"	4	3	10"	1/2"	12"	10"	19"	
S1	5	TOP	10"	2'-0 1/2"	4"	5/8"	18 1/2"	2"	4	3	—	—	—	10"	19"	
S2	1	TOP	10"	18 1/2"	4"	1/2"	18 1/2"	2"	2	2	10"	1"	9"	10"	20"	
S2	2	TOP	10"	18 1/2"	4"	1/2"	18 1/2"	2"	2	2	10"	3/8"	9"	10"	20"	
S2	3	TOP	10"	18 1/2"	4"	1/2"	18 1/2"	2"	2	2	10"	3/8"	9"	10"	19"	
S2	4	TOP	10"	18 1/2"	4"	1/2"	18 1/2"	2"	2	2	10"	3/8"	9"	10"	19"	
S2	5	TOP	10"	18 1/2"	4"	1/2"	18 1/2"	2"	2	2	10"	1/2"	9"	10"	19"	
S3 & S4	1	TOP	10"	18 1/2"	4"	1/2"	18 1/2"	2"	2	2	10"	3/8"	9"	10"	17"	
S3 & S4	2	TOP	10"	18 1/2"	4"	1/2"	18 1/2"	2"	2	2	10"	3/8"	9"	10"	16"	
S3 & S4	3	TOP	10"	18 1/2"	4"	1/2"	18 1/2"	2"	2	2	10"	3/8"	9"	10"	15"	
S3 & S4	4	TOP	10"	18 1/2"	4"	1/2"	18 1/2"	2"	2	2	10"	1/2"	9"	10"	15"	
S3 & S4	5	TOP	10"	18 1/2"	4"	1/2"	18 1/2"	2"	2	2	10"	1/2"	9"	10"	15"	

SPLICE NO.	GIRDER NO.	LOCATION	"a"	"b"	"c"	"d"	"e"	"f"	"g"	"j"	"k"	"n"	"p"	"q"	FLANGE WIDTH "L"	FLANGE WIDTH "R"	TYPE SPLICE
S1	1	BOTT.	17"	1 1/8"	4'-0 1/2"	7 1/2"	1 1/4"	3'-5 1/2"	2 1/4"	6	5	4	17"	3/8"	2'-0"	17"	C
S1	2	BOTT.	17"	1 1/8"	4'-0 1/2"	7 1/2"	1 1/4"	3'-5 1/2"	2 1/4"	6	5	4	17"	1/8"	2'-0"	17"	C
S1	3	BOTT.	17"	1"	4'-0 1/2"	7 1/2"	1 1/8"	3'-5 1/2"	2 1/4"	6	5	3	17"	1/8"	2'-0"	17"	B
S1	4	BOTT.	16"	1 1/8"	4'-0 1/2"	7"	1 1/8"	3'-5 1/2"	2"	6	5	3	—	—	16"	19"	C
S1	5	BOTT.	14"	1 1/8"	3'-5 1/2"	6"	1 1/8"	2'-10 1/2"	1 1/2"	5	4	2	14"	1/2"	20 1/2"	14"	C
S2	1	BOTT.	17"	3/4"	2'-10 1/2"	7 1/2"	7/8"	2'-10 1/2"	2 1/4"	4	4	2	17"	1/2"	17"	20"	C
S2	2	BOTT.	16"	3/4"	2'-10 1/2"	7"	7/8"	2'-3 1/2"	2"	4	3	2	16"	1/4"	17"	16"	C
S2	3	BOTT.	15"	7/8"	2'-10 1/2"	6 1/2"	7/8"	2'-3 1/2"	1 3/4"	4	3	2	15"	1/8"	17"	15"	C
S2	4	BOTT.	14"	7/8"	2'-3 1/2"	6"	7/8"	2'-3 1/2"	1 1/2"	3	3	2	—	—	14"	19"	C
S2	5	BOTT.	14"	5/8"	20 1/2"	6"	3/4"	20 1/2"	1 1/2"	2	2	1	—	—	14"	19"	C
S3	1	BOTT.	17"	3/4"	2'-10 1/2"	7 1/2"	3/4"	2'-3 1/2"	2 1/4"	4	3	2	17"	1/8"	17"	17"	B
S3	2	BOTT.	16"	3/4"	2'-10 1/2"	7"	7/8"	2'-3 1/2"	2"	4	3	2	16"	1/8"	17"	16"	B
S3 & S4	3	BOTT.	15"	7/8"	2'-10 1/2"	6 1/2"	7/8"	2'-3 1/2"	1 3/4"	4	3	2	15"	1/8"	17"	15"	B
S3	4	BOTT.	14"	7/8"	2'-3 1/2"	6"	7/8"	2'-3 1/2"	1 1/2"	3	3	2	14"	1/2"	13 1/2"	14"	B
S3	5	BOTT.	14"	5/8"	20 1/2"	6"	3/4"	20 1/2"	1 1/2"	2	2	1	—	—	14"	15"	B
S4	1	BOTT.	14"	7/8"	2'-10 1/2"	6"	1"	2'-3 1/2"	1 1/2"	4	3	2	14"	1/8"	17"	14"	C
S4	2	BOTT.	14"	5/8"	20 1/2"	6"	3/4"	20 1/2"	1 1/2"	2	2	1	14"	1/8"	10"	14"	B
S4	4	BOTT.	15"	5/8"	2'-3 1/2"	6 1/2"	3/4"	2'-3 1/2"	1 3/4"	3	3	1	—	—	15"	15"	B
S4	5	BOTT.	14"	7/8"	2'-10 1/2"	6"	1"	2'-3 1/2"	1 1/2"	4	3	2	—	—	14"	15"	B

209

DETAILED DEC 19 89  
CHECKED DEC 19 89

NOTE: THIS DRAWING IS NOT TO SCALE. FOLLOW DIMENSIONS.  $\Delta$  ADD 12/1 89

59A-A of 89  
SHEET NO. 59A OF 89  
Final Plans





JACKSON

COUNTY

A-2745

GENERAL PLANS

STATE	PROJ. NO.	SHEET NO.
MO.		142

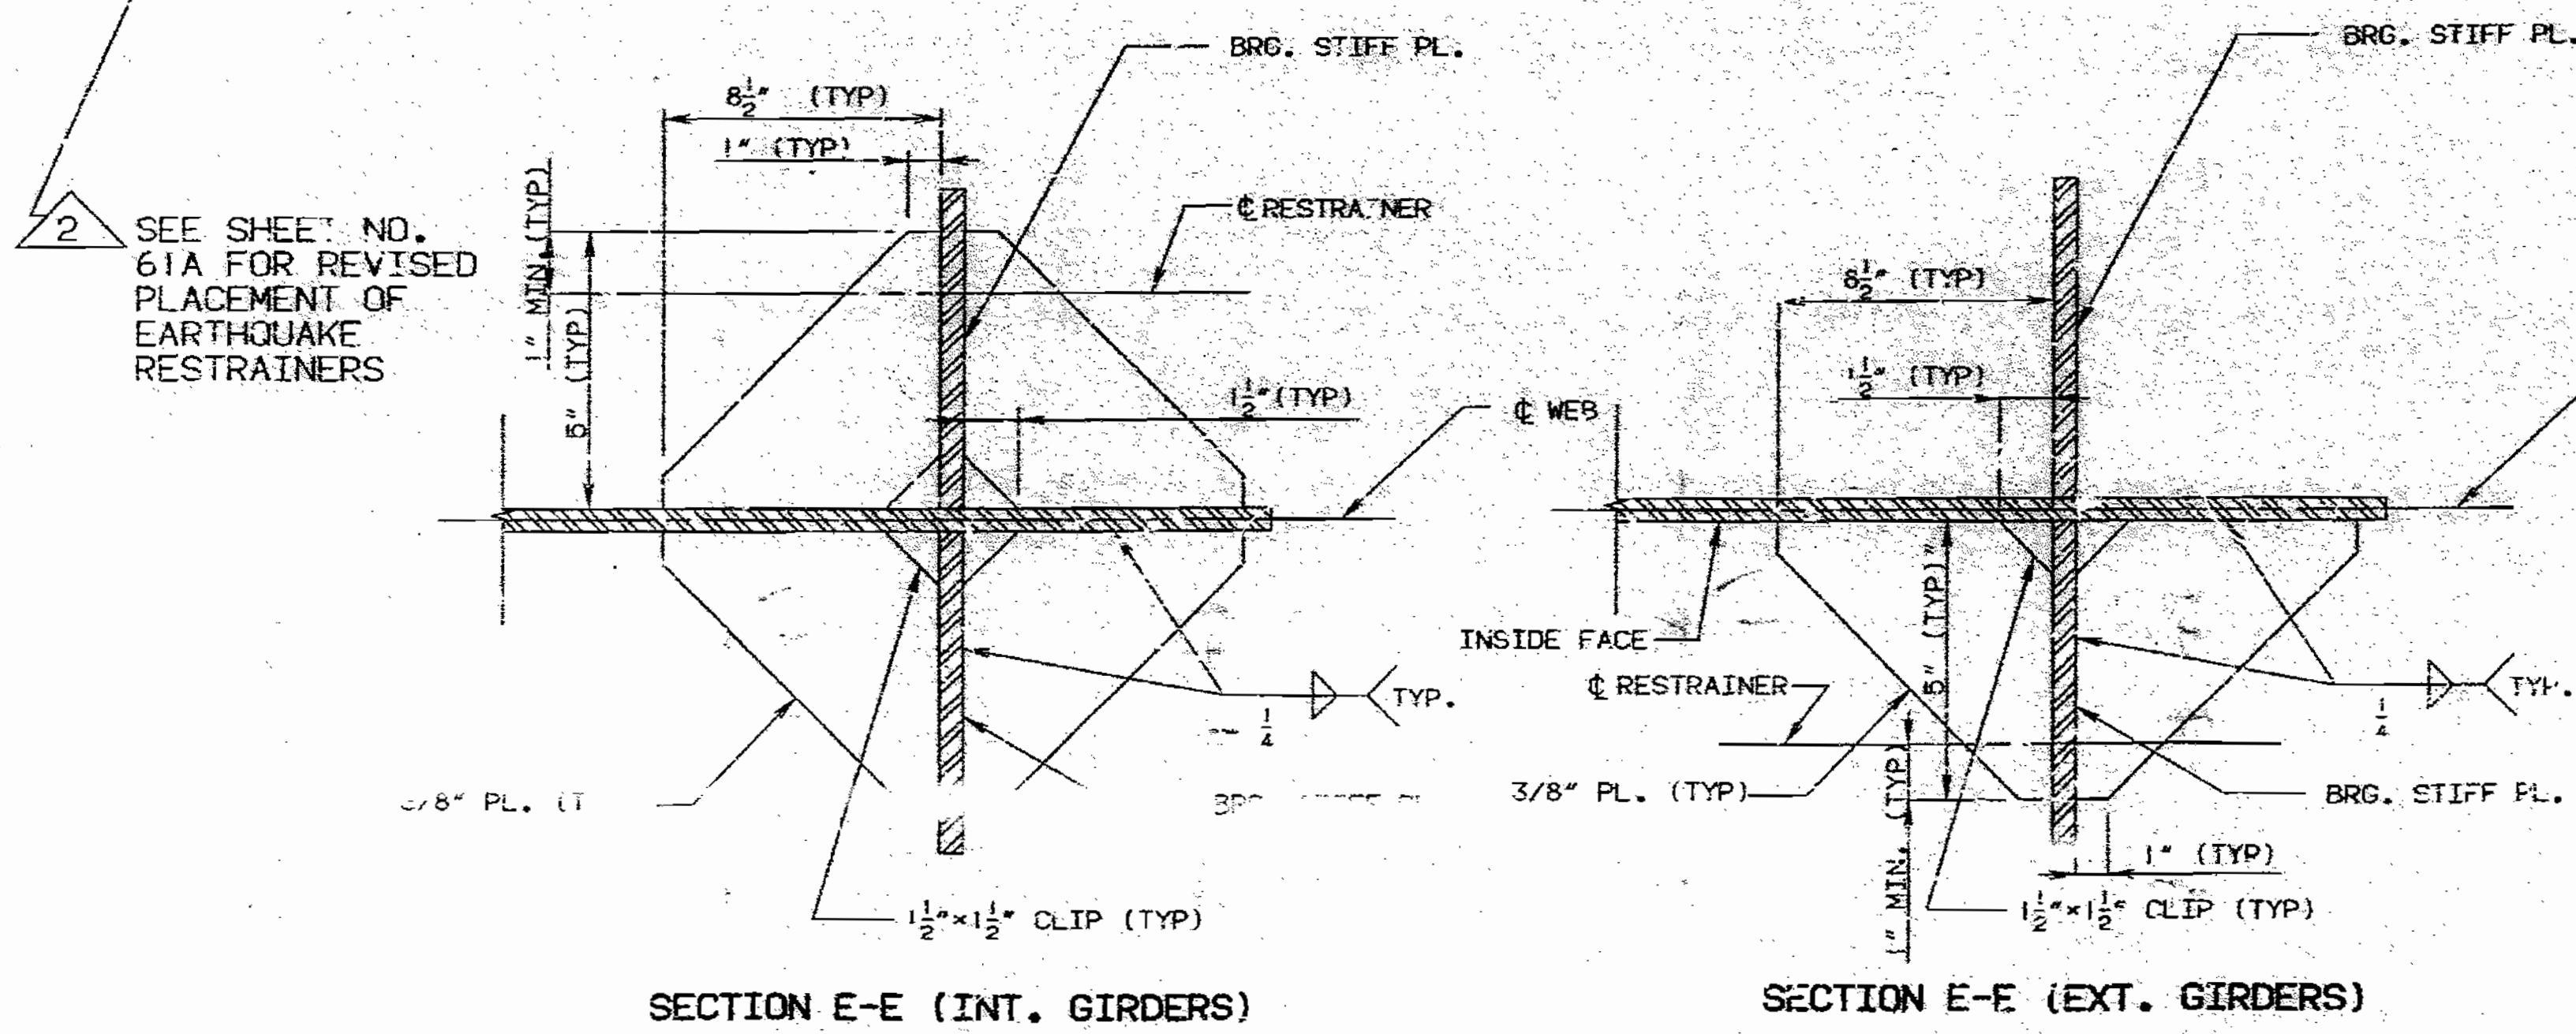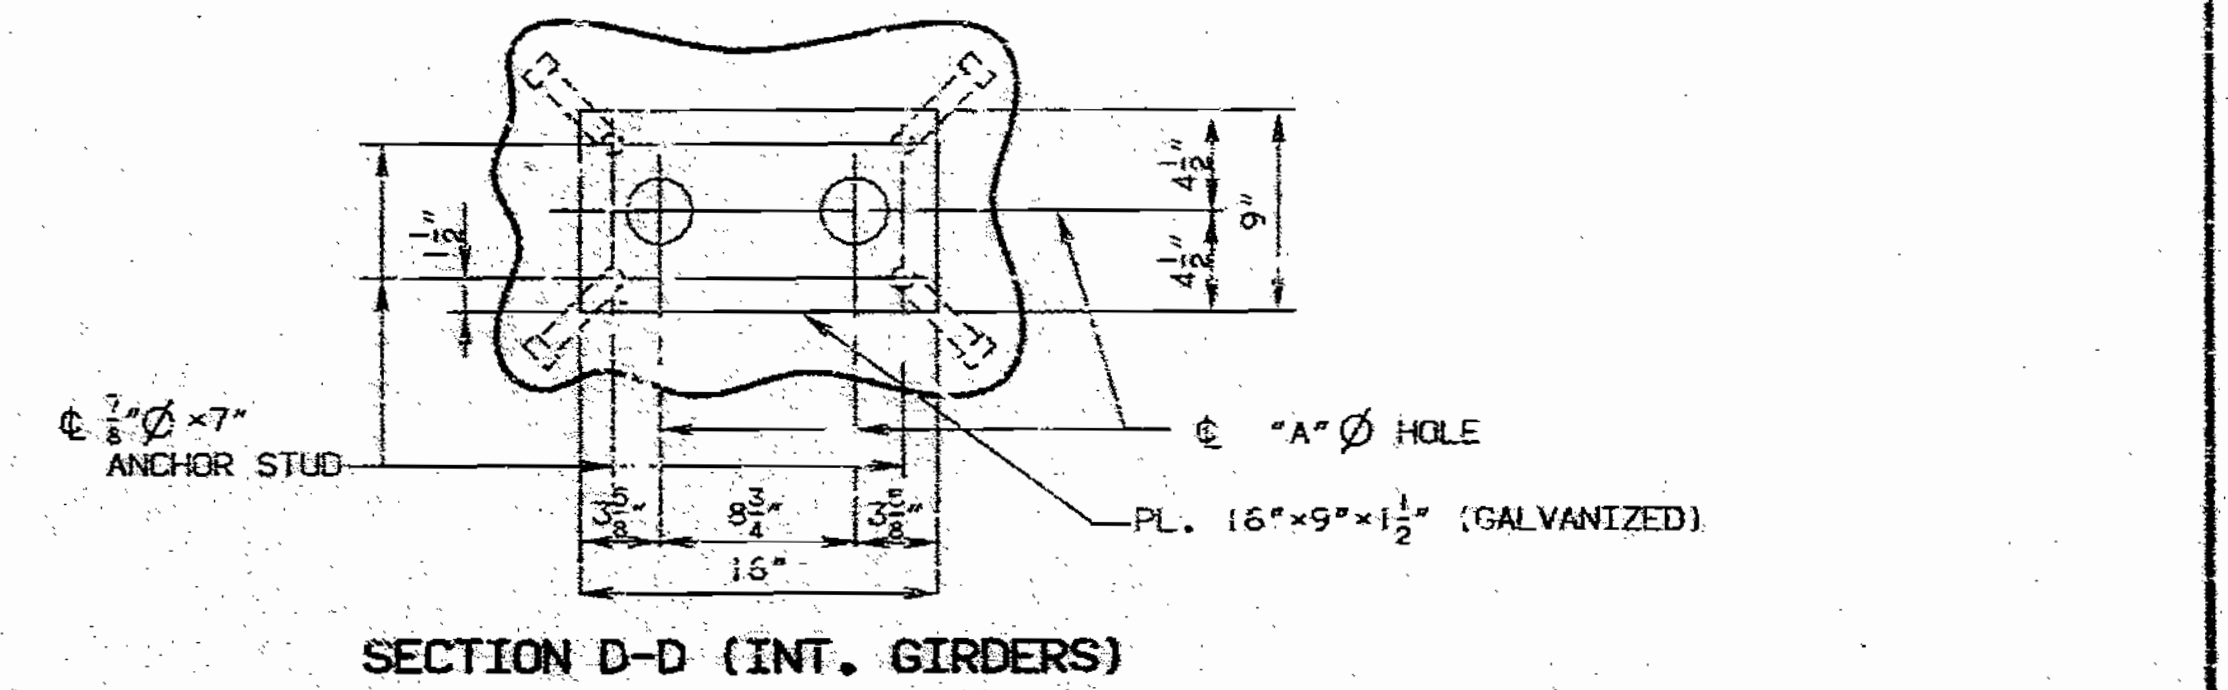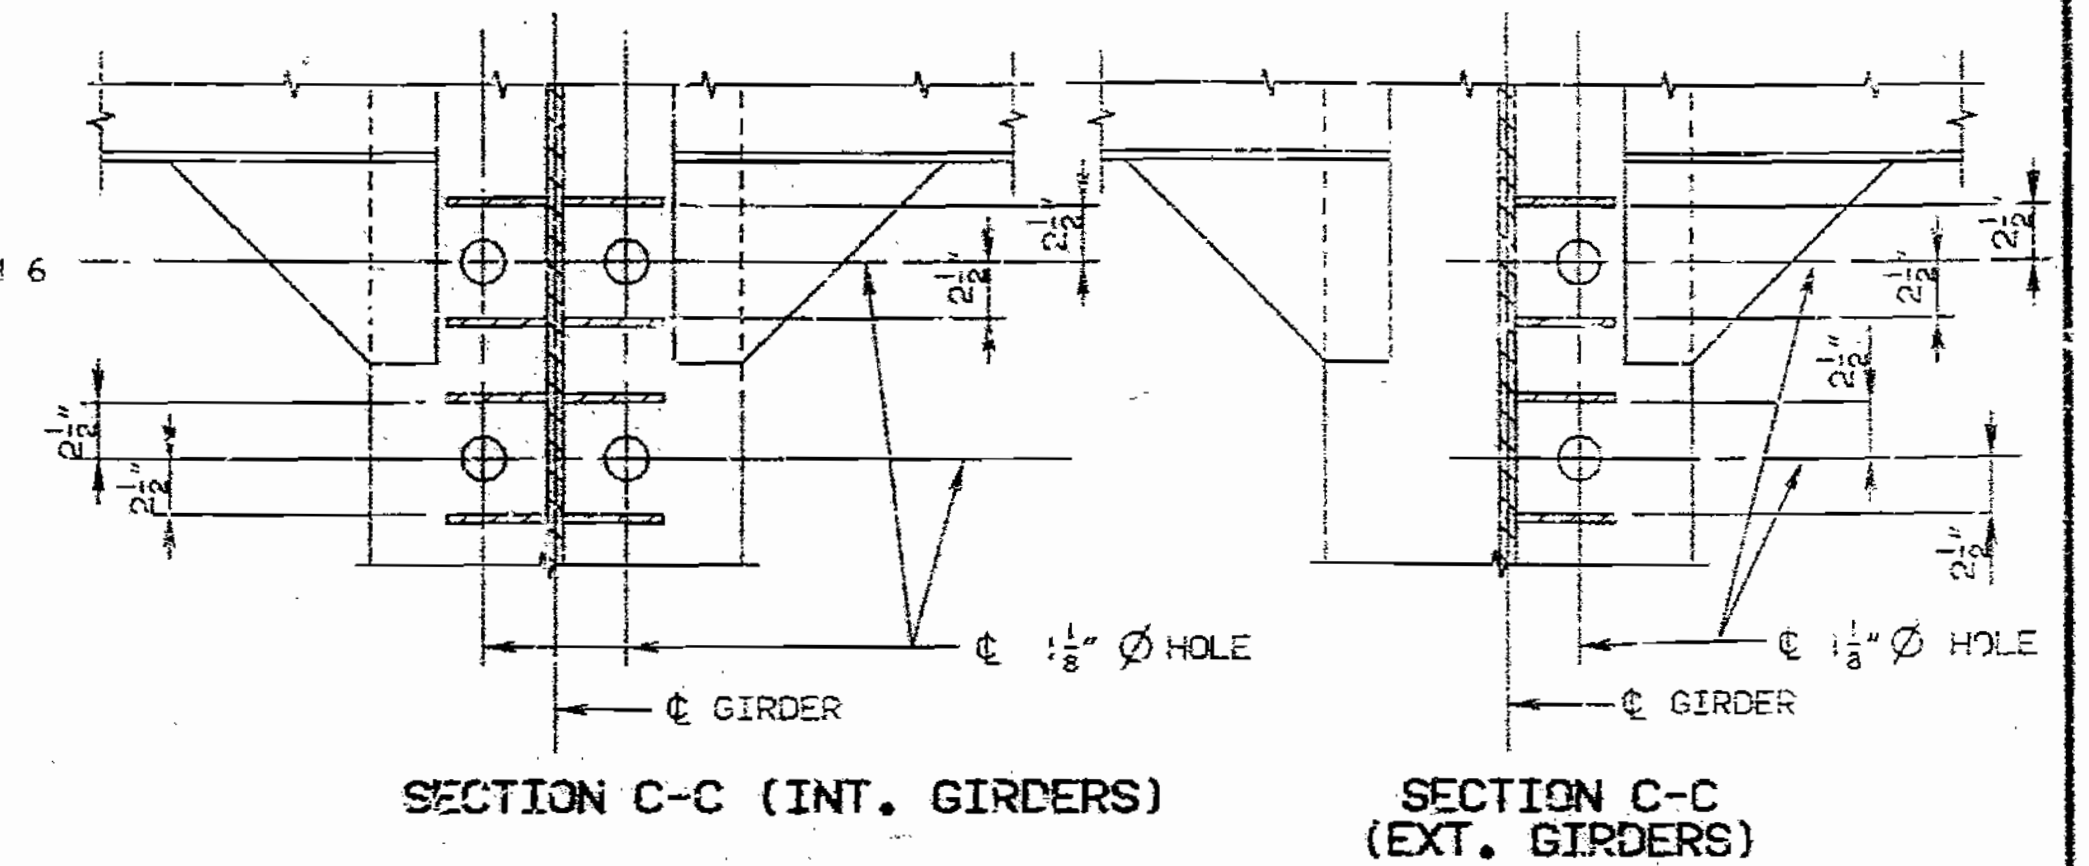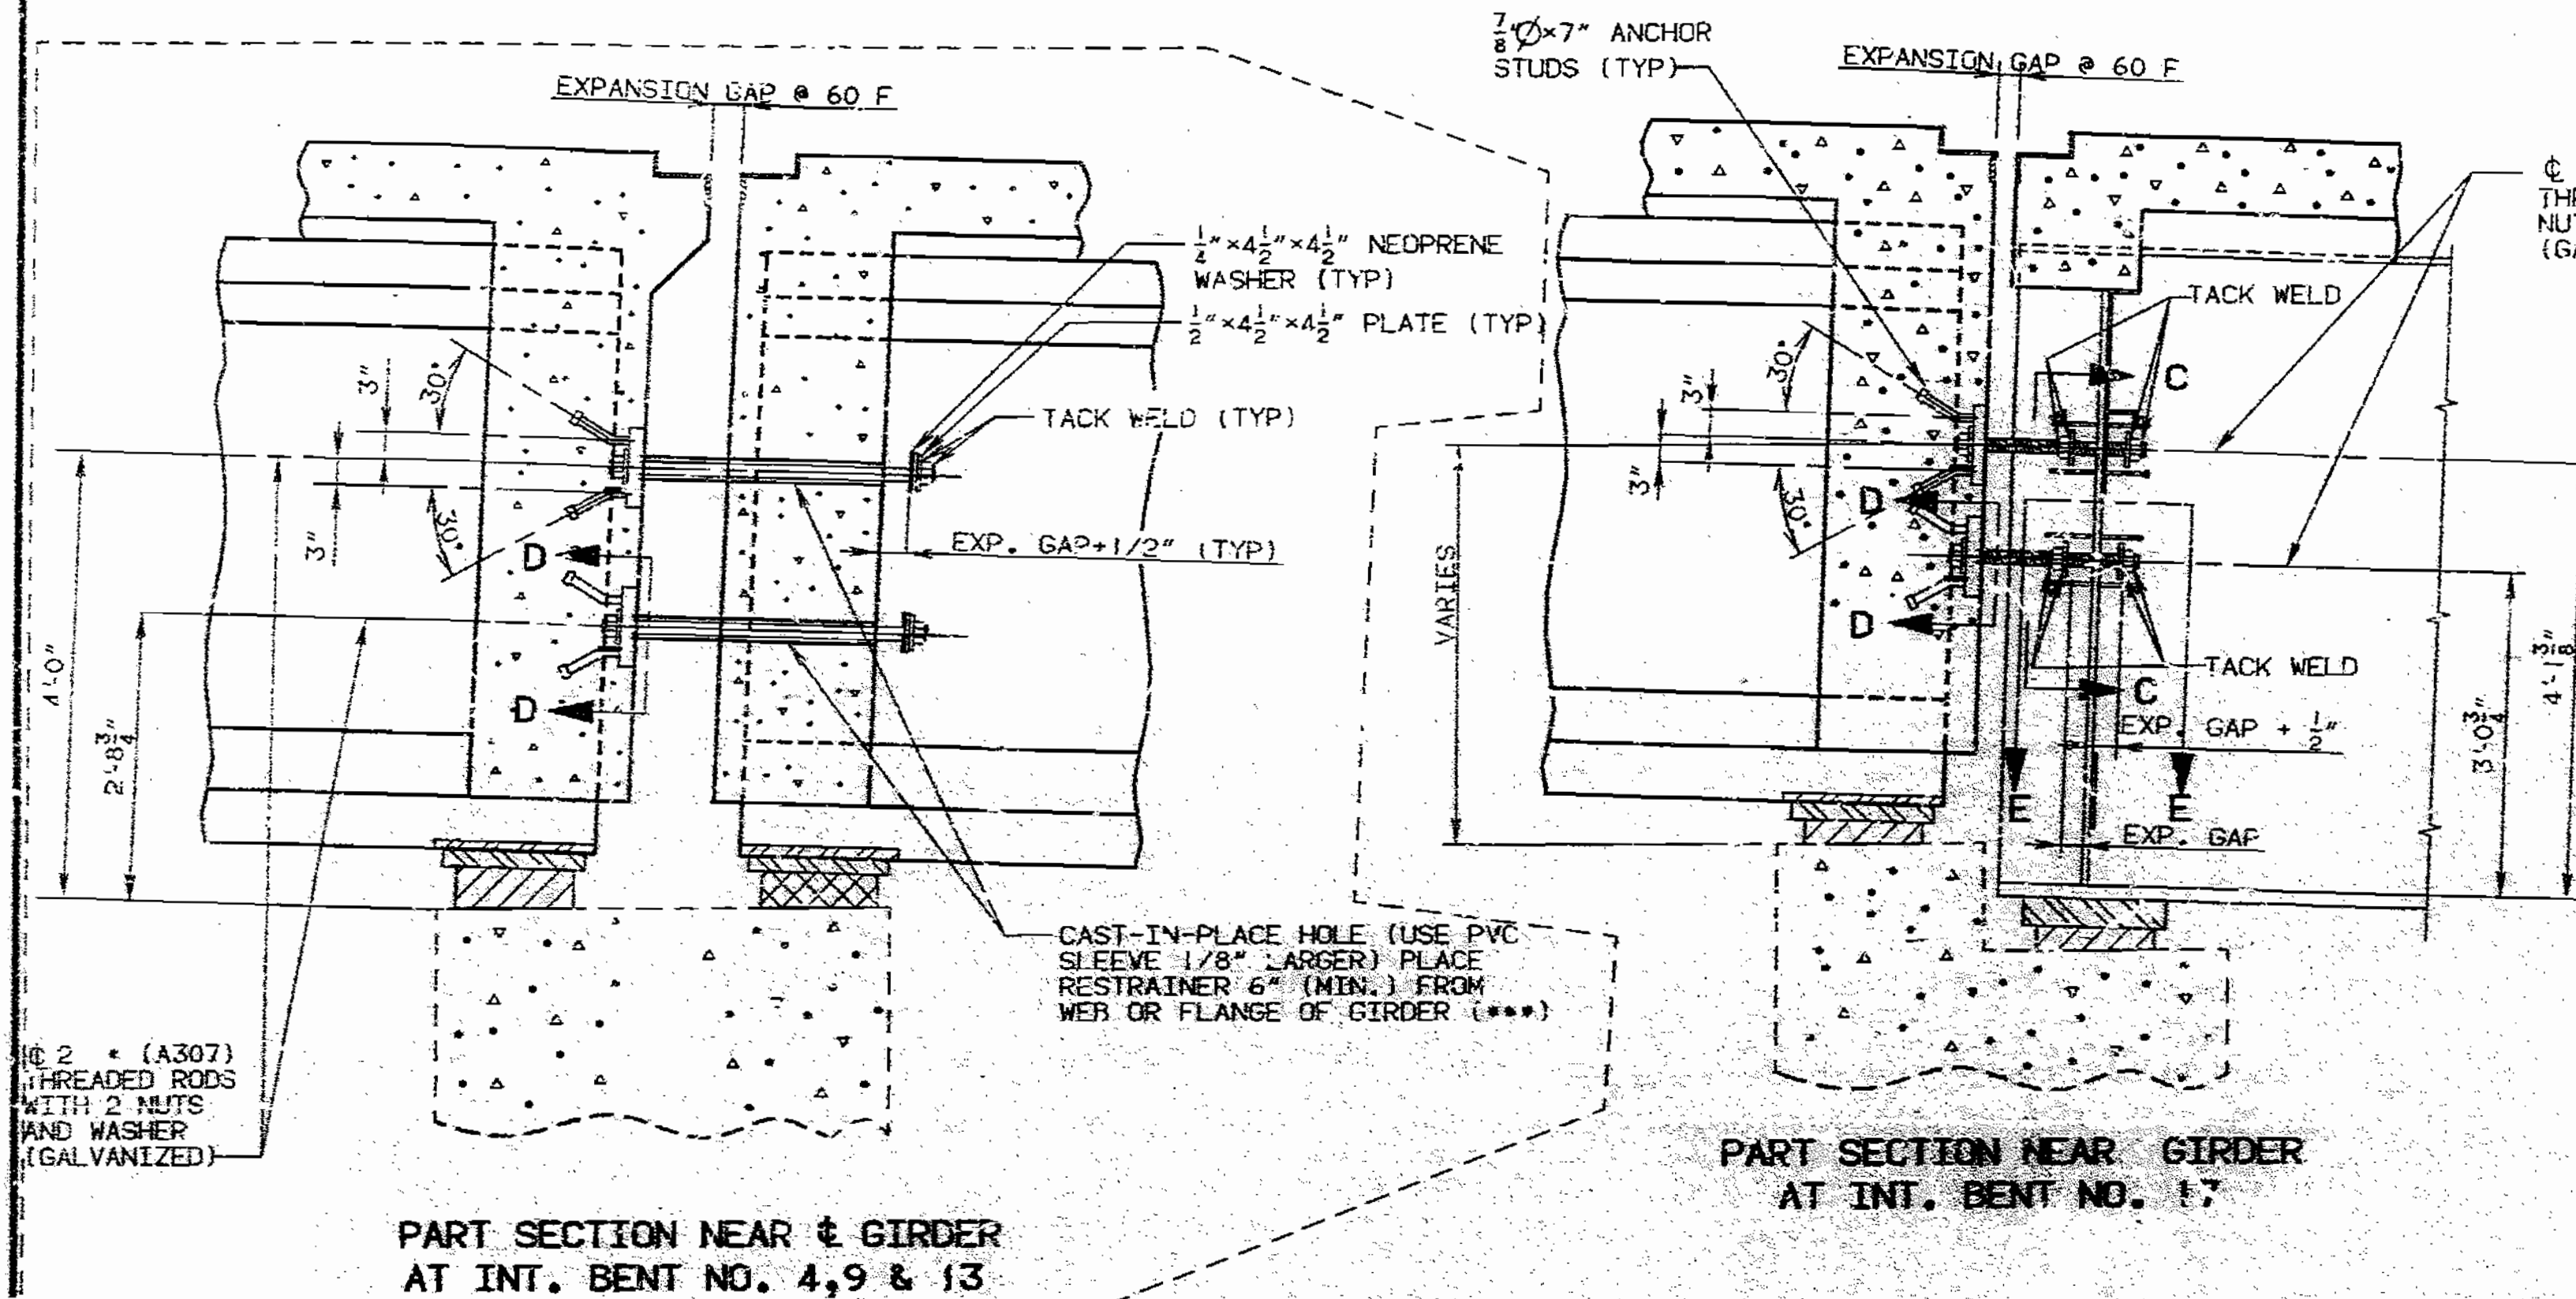

1/2" Ø BENT NO. 4

3/8" Ø BENT NO. 9

3/8" Ø BENT NO. 13

NOTE: WEIGHT OF THREADED RODS, NUTS, WASHERS AND PLATES IS INCLUDED IN FABRICATED STRUCTURAL CARBON STEEL (PLATE GIRDER)

GALVANIZING TO BE DONE IN ACCORDANCE TO ASTM A123.


BT.#4=1 5/8"

BT.#9 & #13=1 1/2"

BT.#19=1 1/2"

BT.#17=1 1/8"

PL. 16"x9"x1/2" (GALVANIZED)

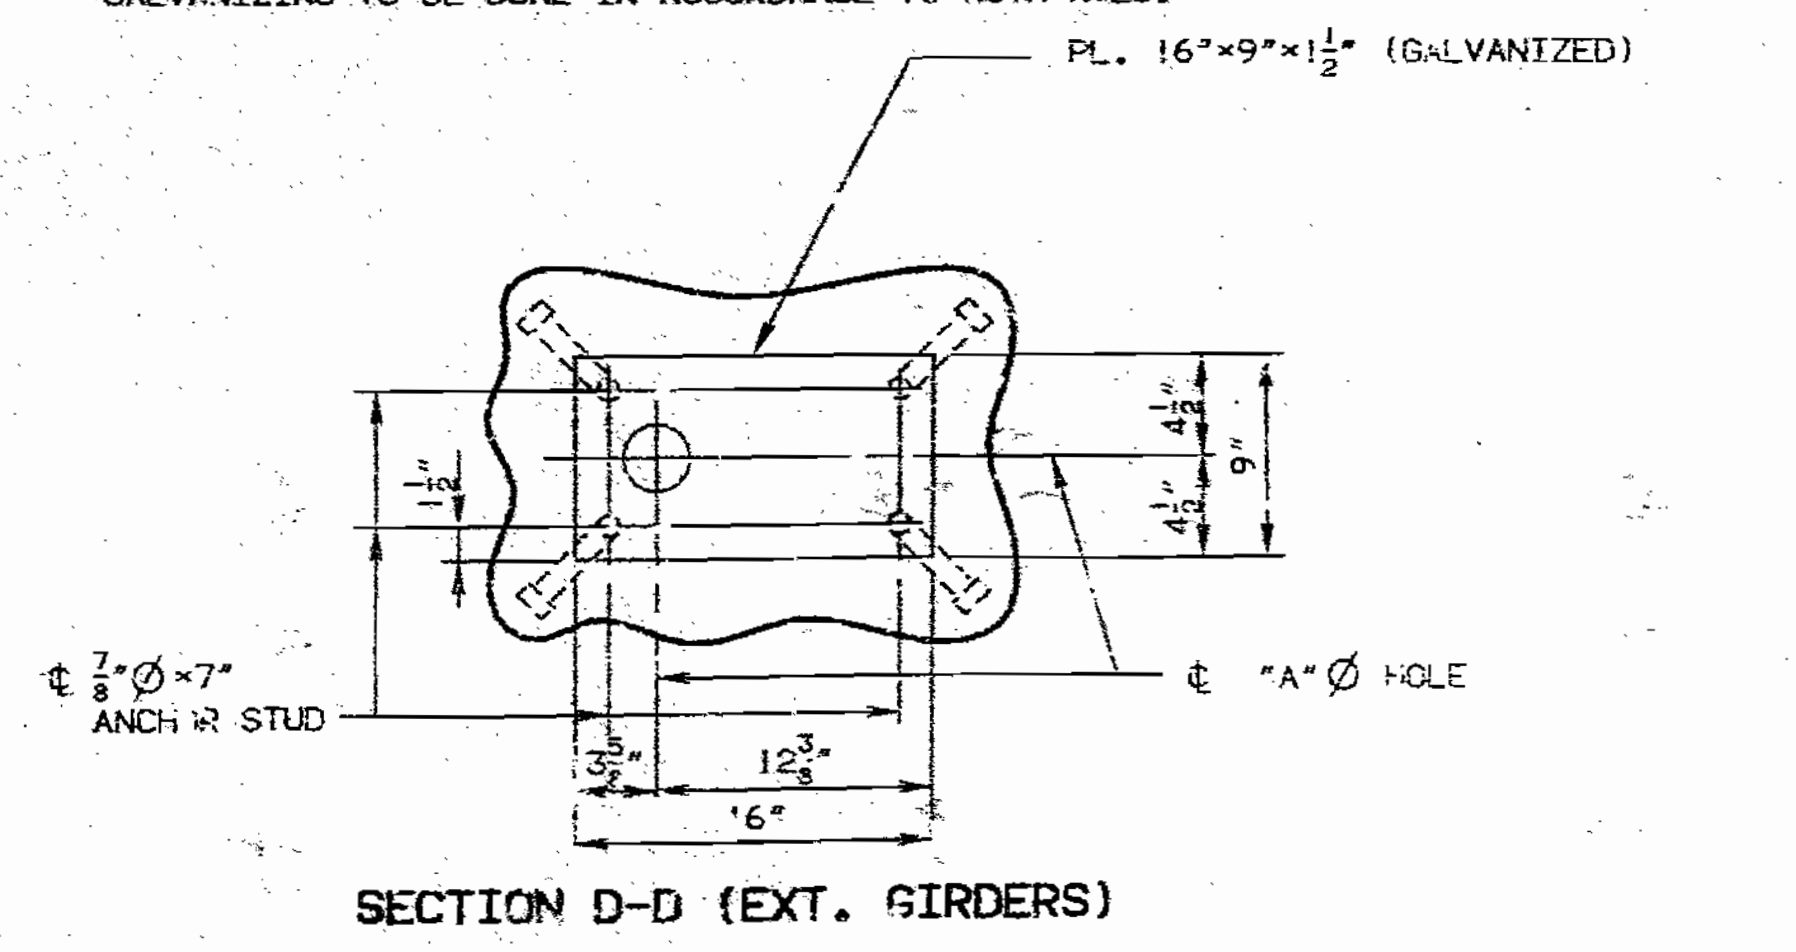

DETAILS OF EARTHQUAKE RESTRAINERS AT BENTS NO. 4, 9, 13 & 17




DETAILED AUG. 1988  
CHECKED FEB 1989

NOTE: THIS DRAWING IS NOT TO SCALE. FOLLOW DIMENSIONS.

REVISOR 5/31/90  
REVISOR 4/10/90 JACKSON COUNTY

A-2745


STATE	PROJ. NO.	SHEET NO.
MO.		123

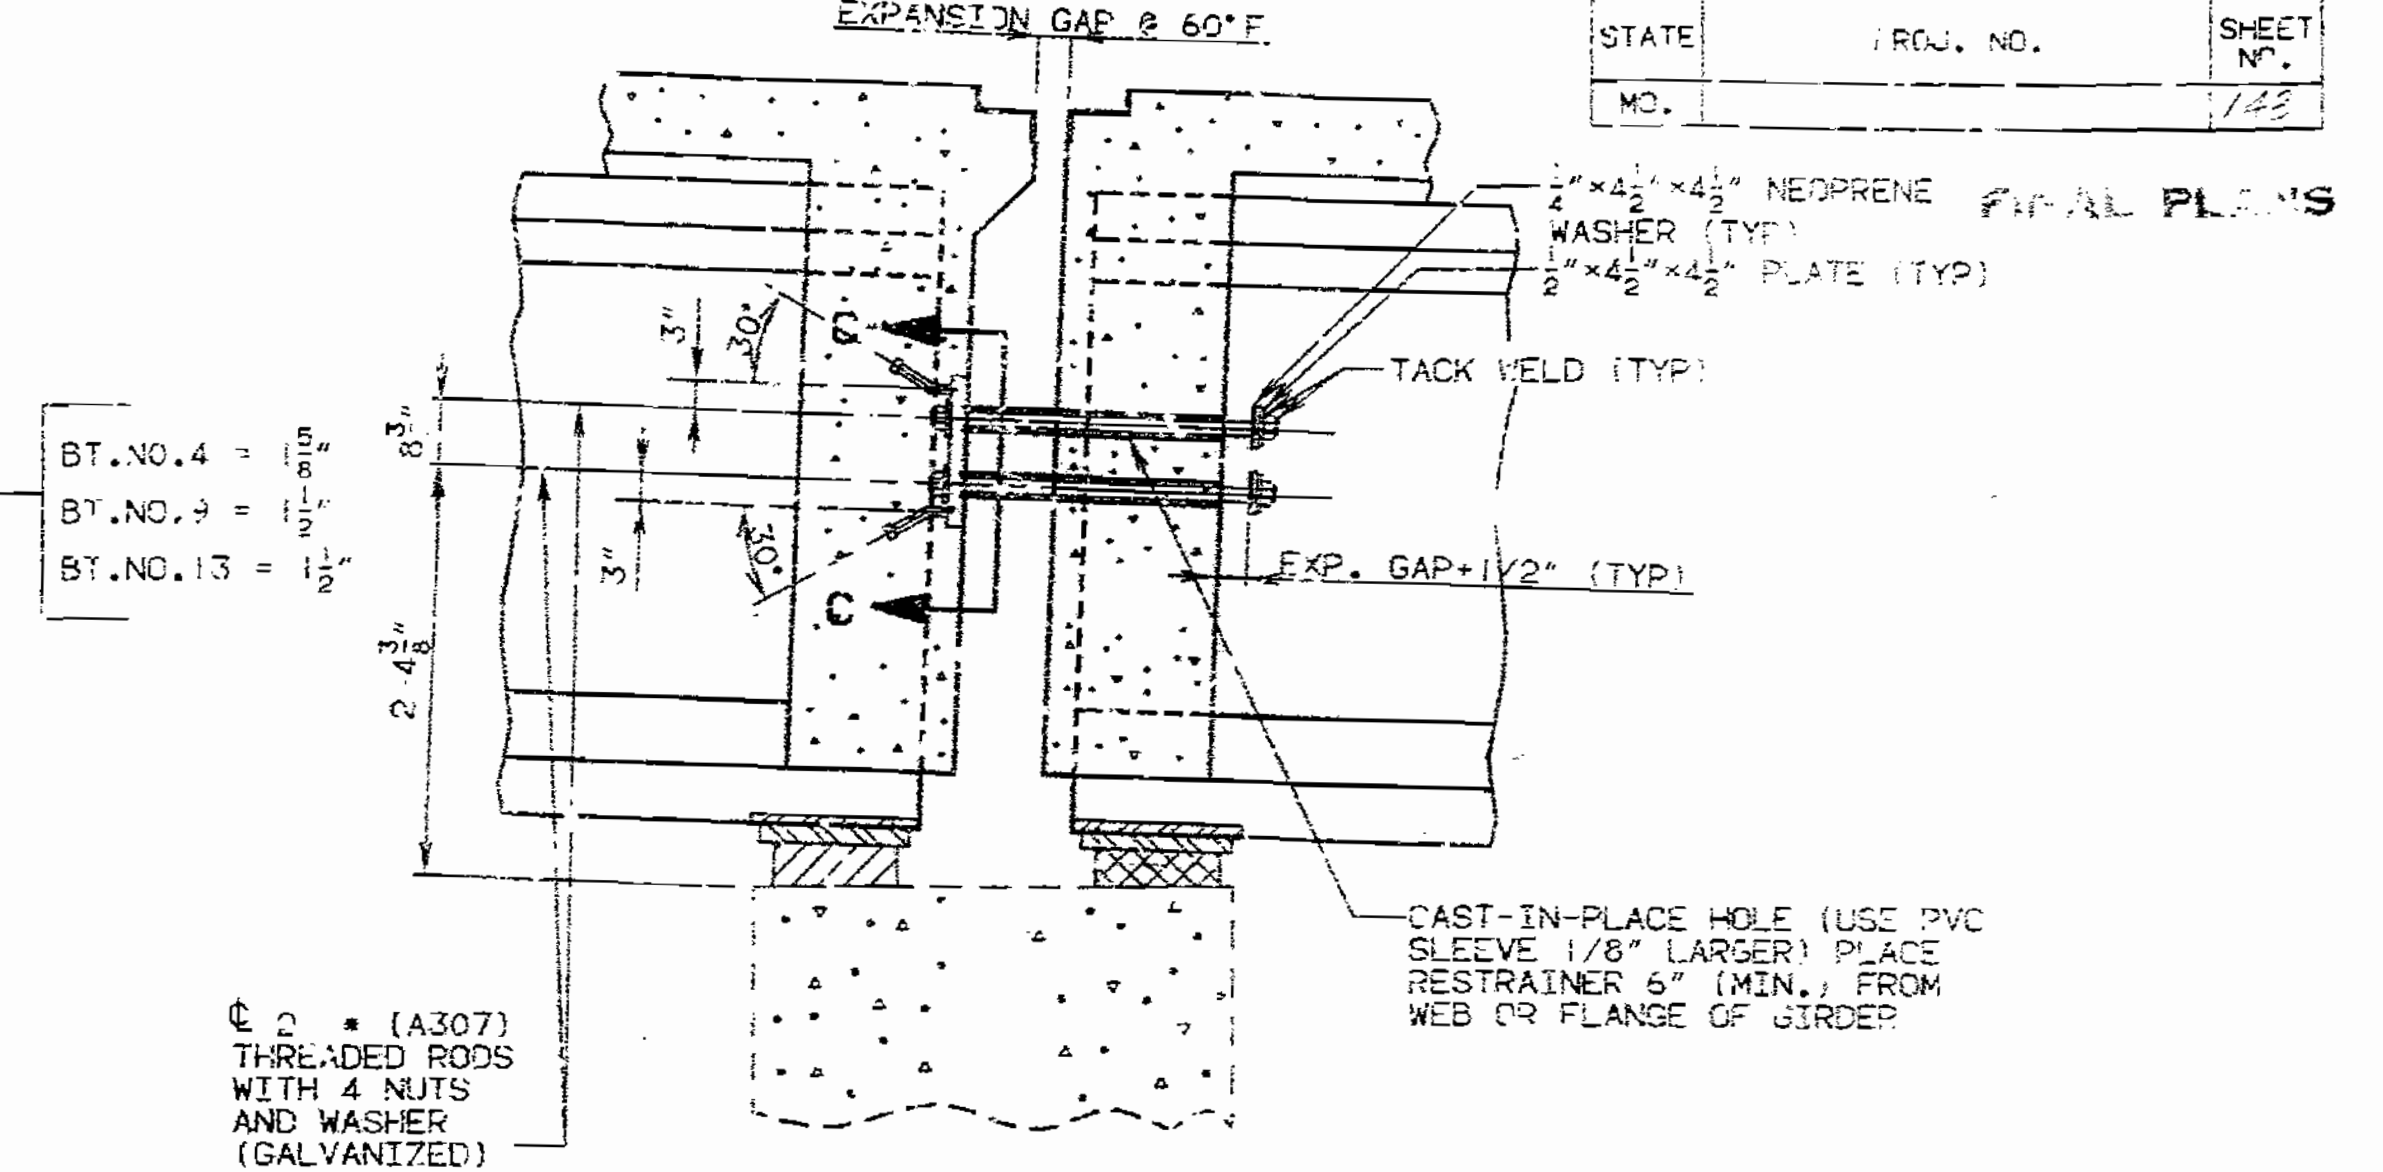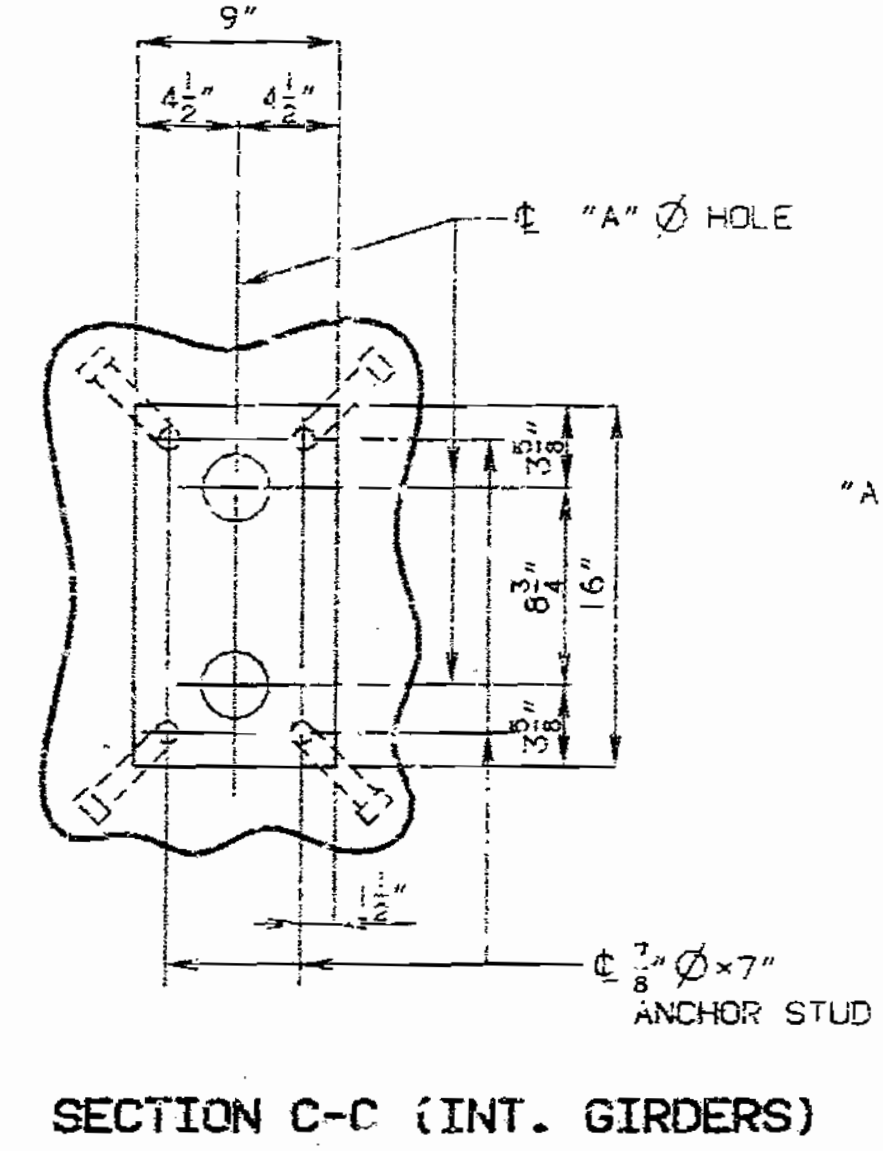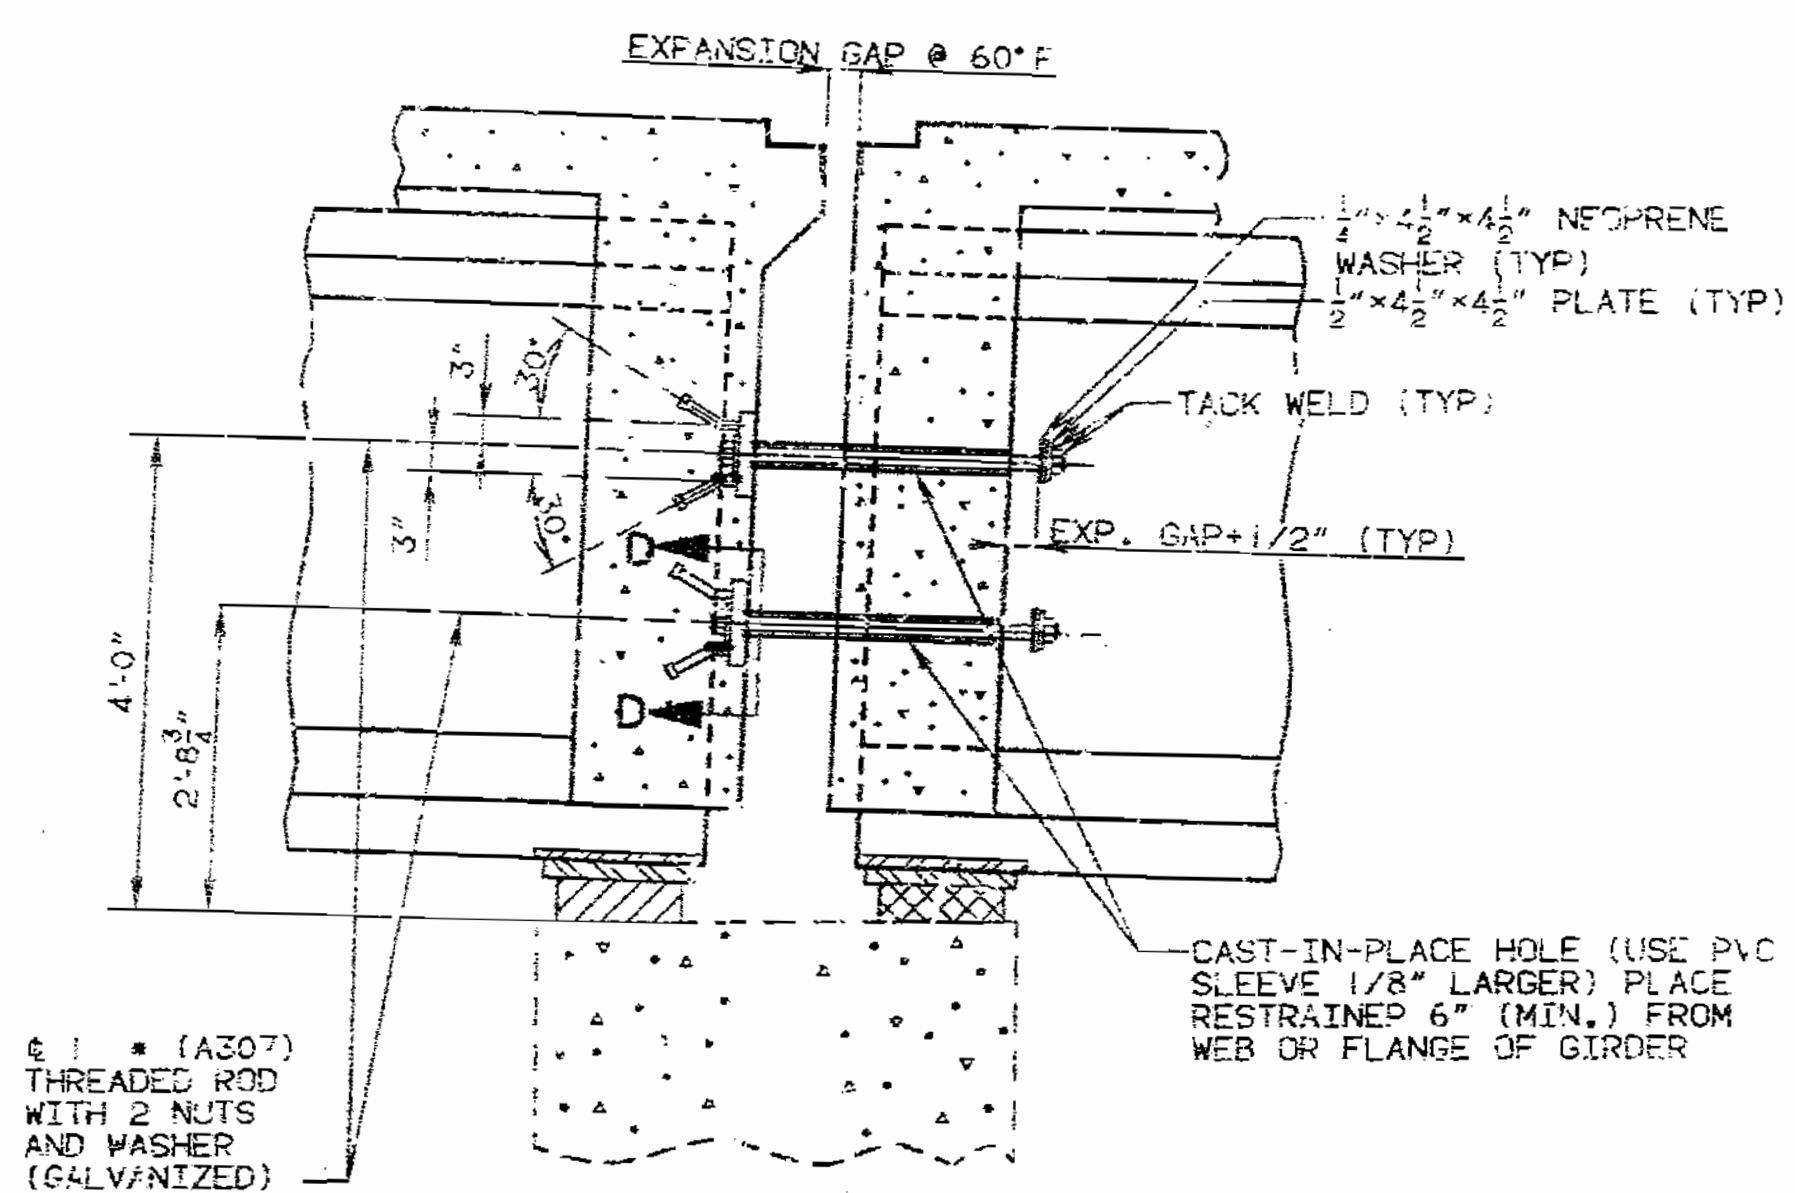

PART SECTION A-A  
AT INT. BENT NO. 4, 9 & 13

PART SECTION B-B  
AT INT. BENT NO. 4, 9 & 13

- 1 1/2" Ø BENT NO. 4
- \* 1 3/8" Ø BENT NO. 9
- 1 3/8" Ø BENT NO. 13

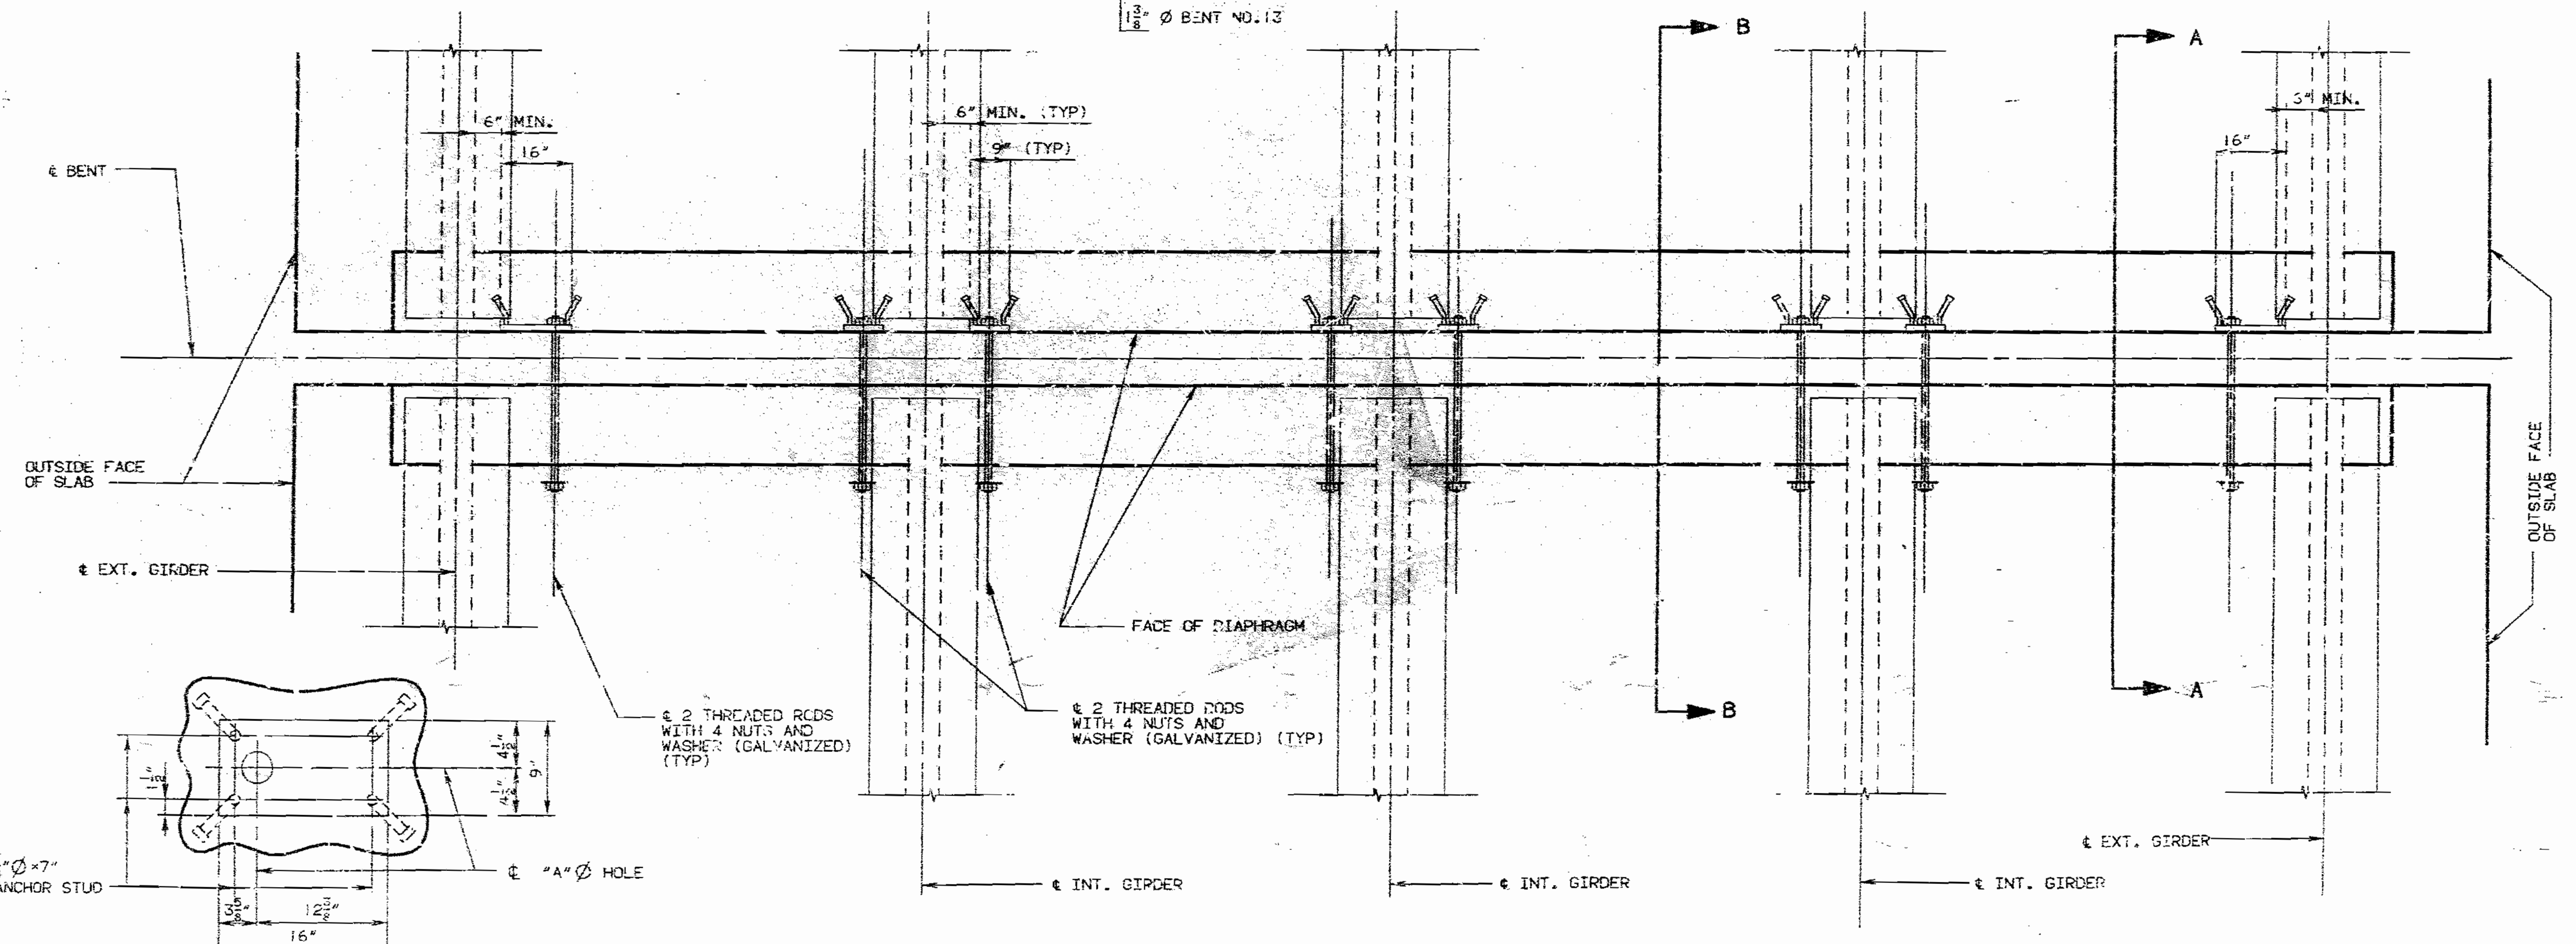

SECTION D-D (EXT. GIRDERS)

TYPICAL PLAN OF RESTRAINER PLACEMENT AT BT. NO. 4, 9 & 13

DETAILED MAY 1990  
CHECKED MAY 1990

NOTE: THIS DRAWING IS NOT TO SCALE. FOLLOW DIMENSIONS.

61A-A of 98  
SHEET NO. 61A OF 98

JACKSON

COUNTY

A-2745

Final Plans